



FED. ROAD DIST. NO.	STATE	FED. AID PROJ. NO.	FISCAL YEAR	SHEET NO.	TOTAL SHEETS
HAWAII	HAW.	STP-065-1(9)	2003	ADD. 32	114

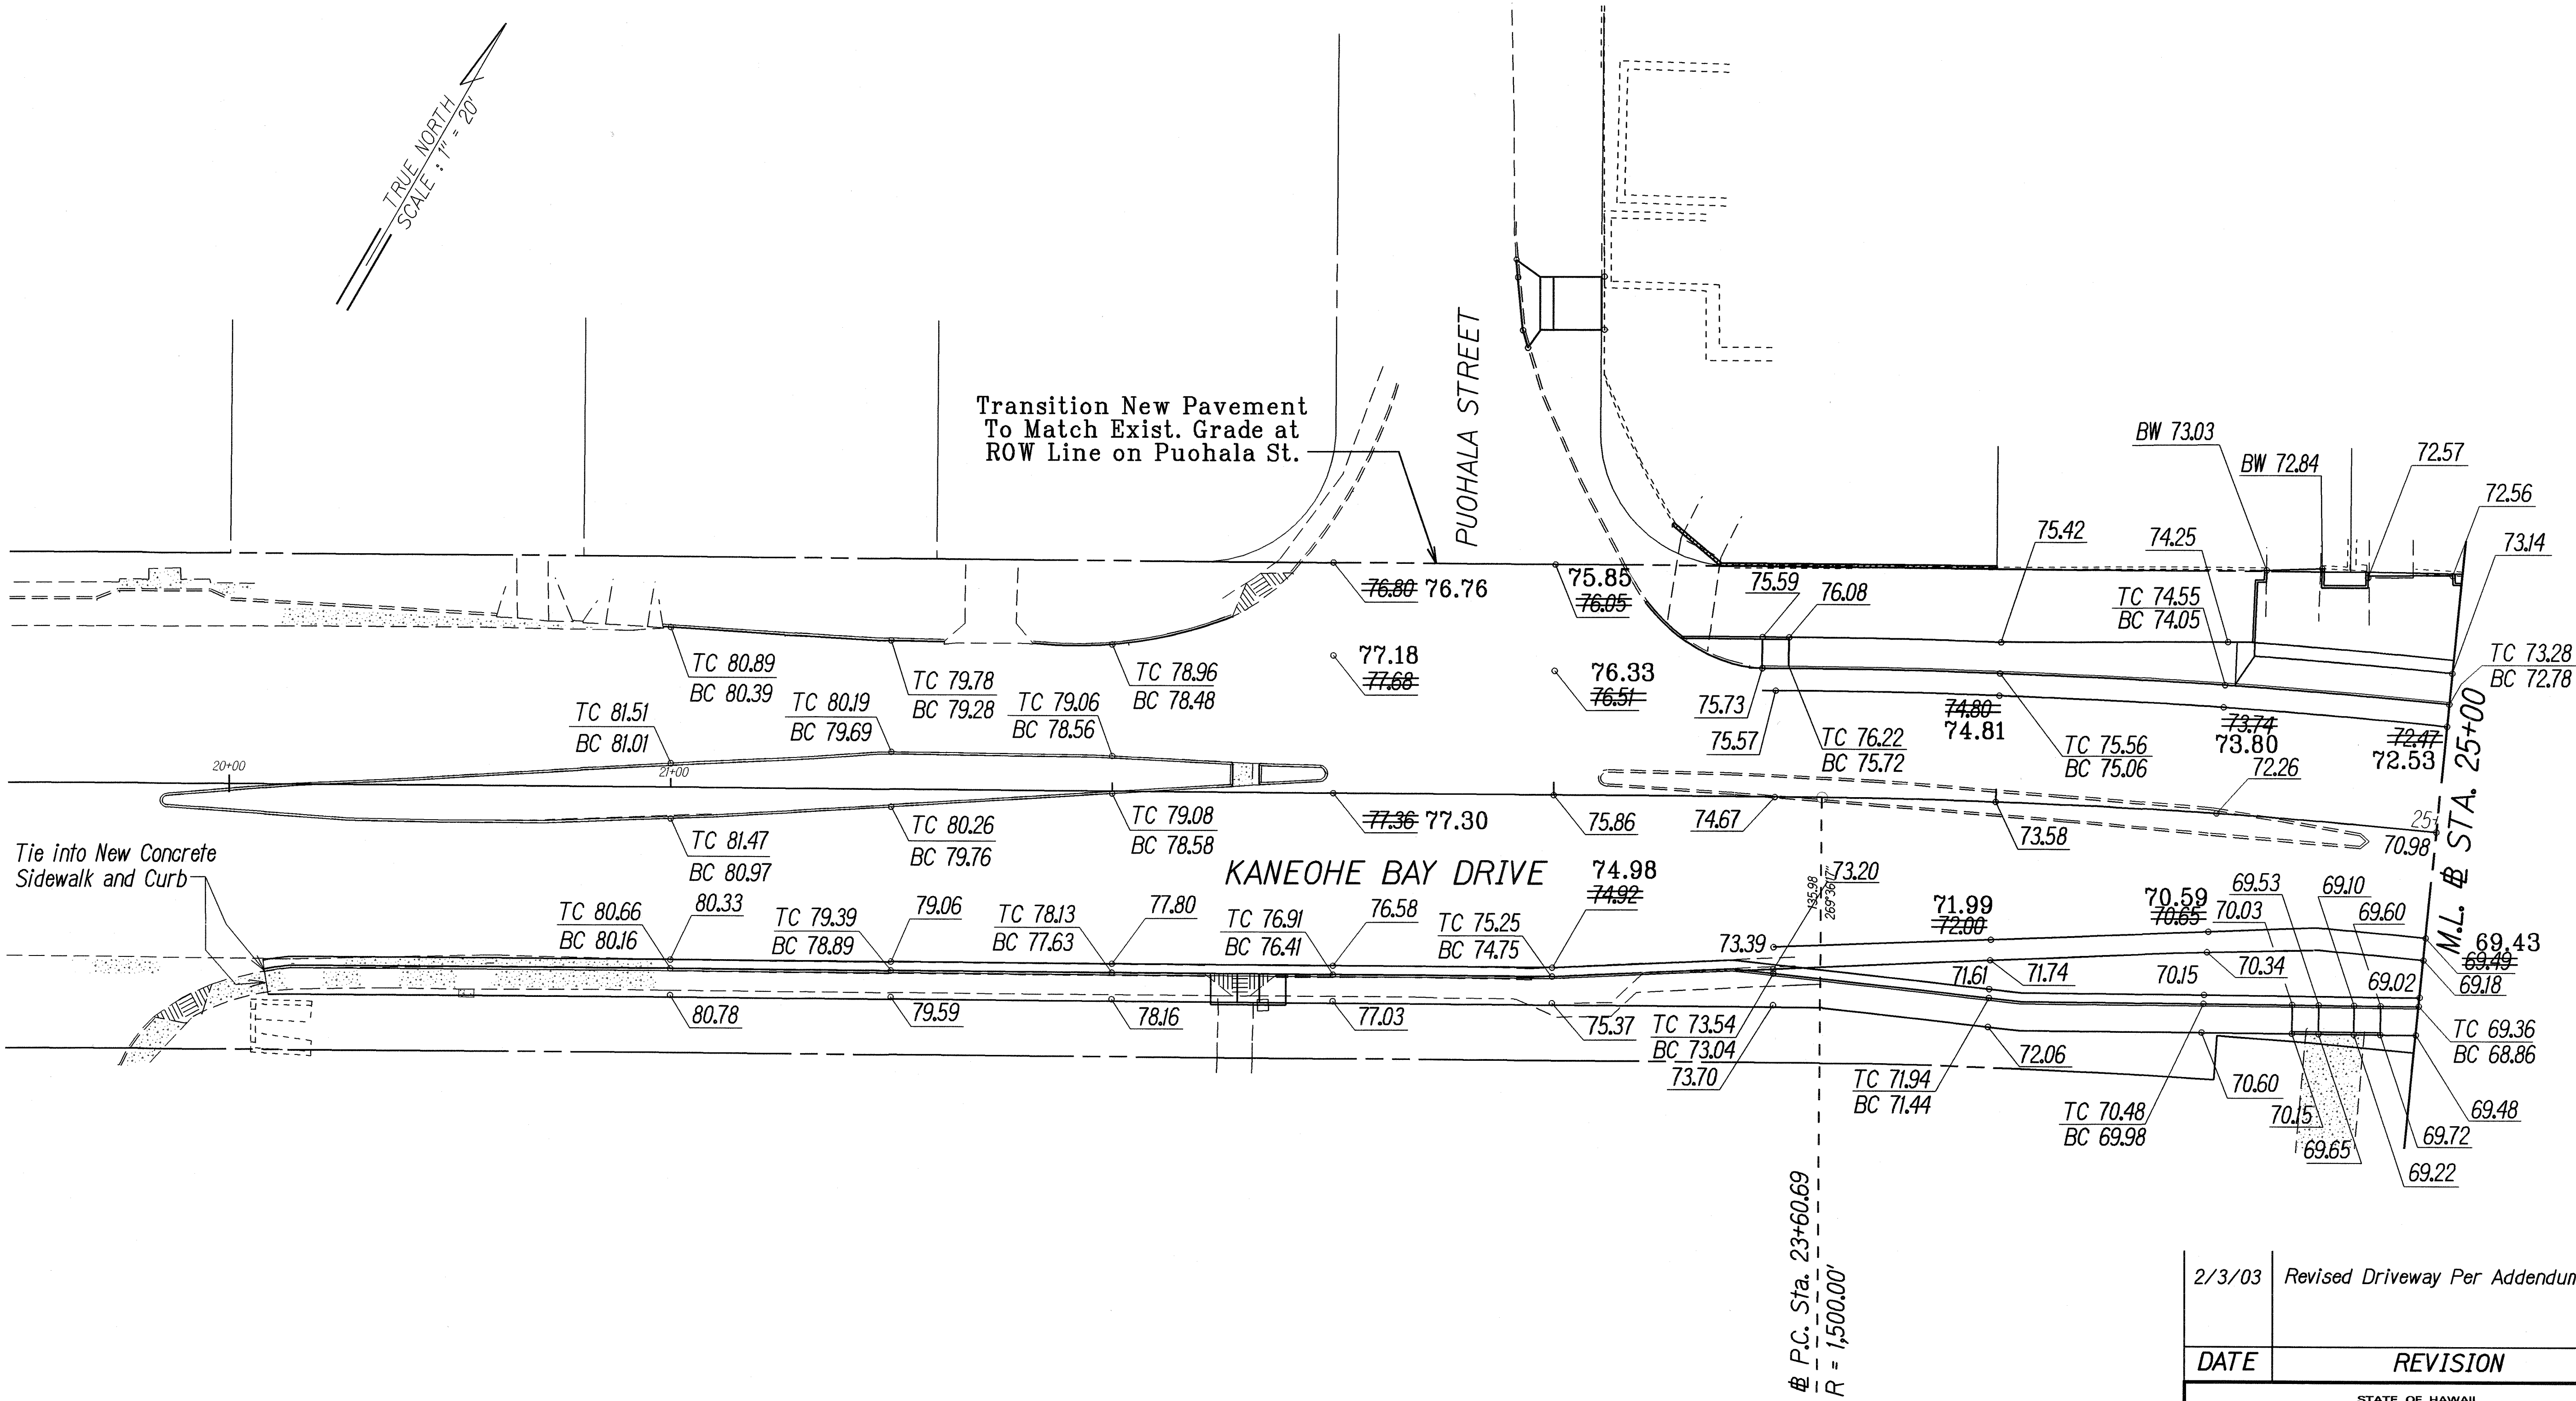

FED. ROAD DIST. NO.	STATE	FED. AID PROJ. NO.	FISCAL YEAR	SHEET NO.	TOTAL SHEETS
HAWAII	HAW.	STP-065A-1(9)	2003	ADD. 33	114

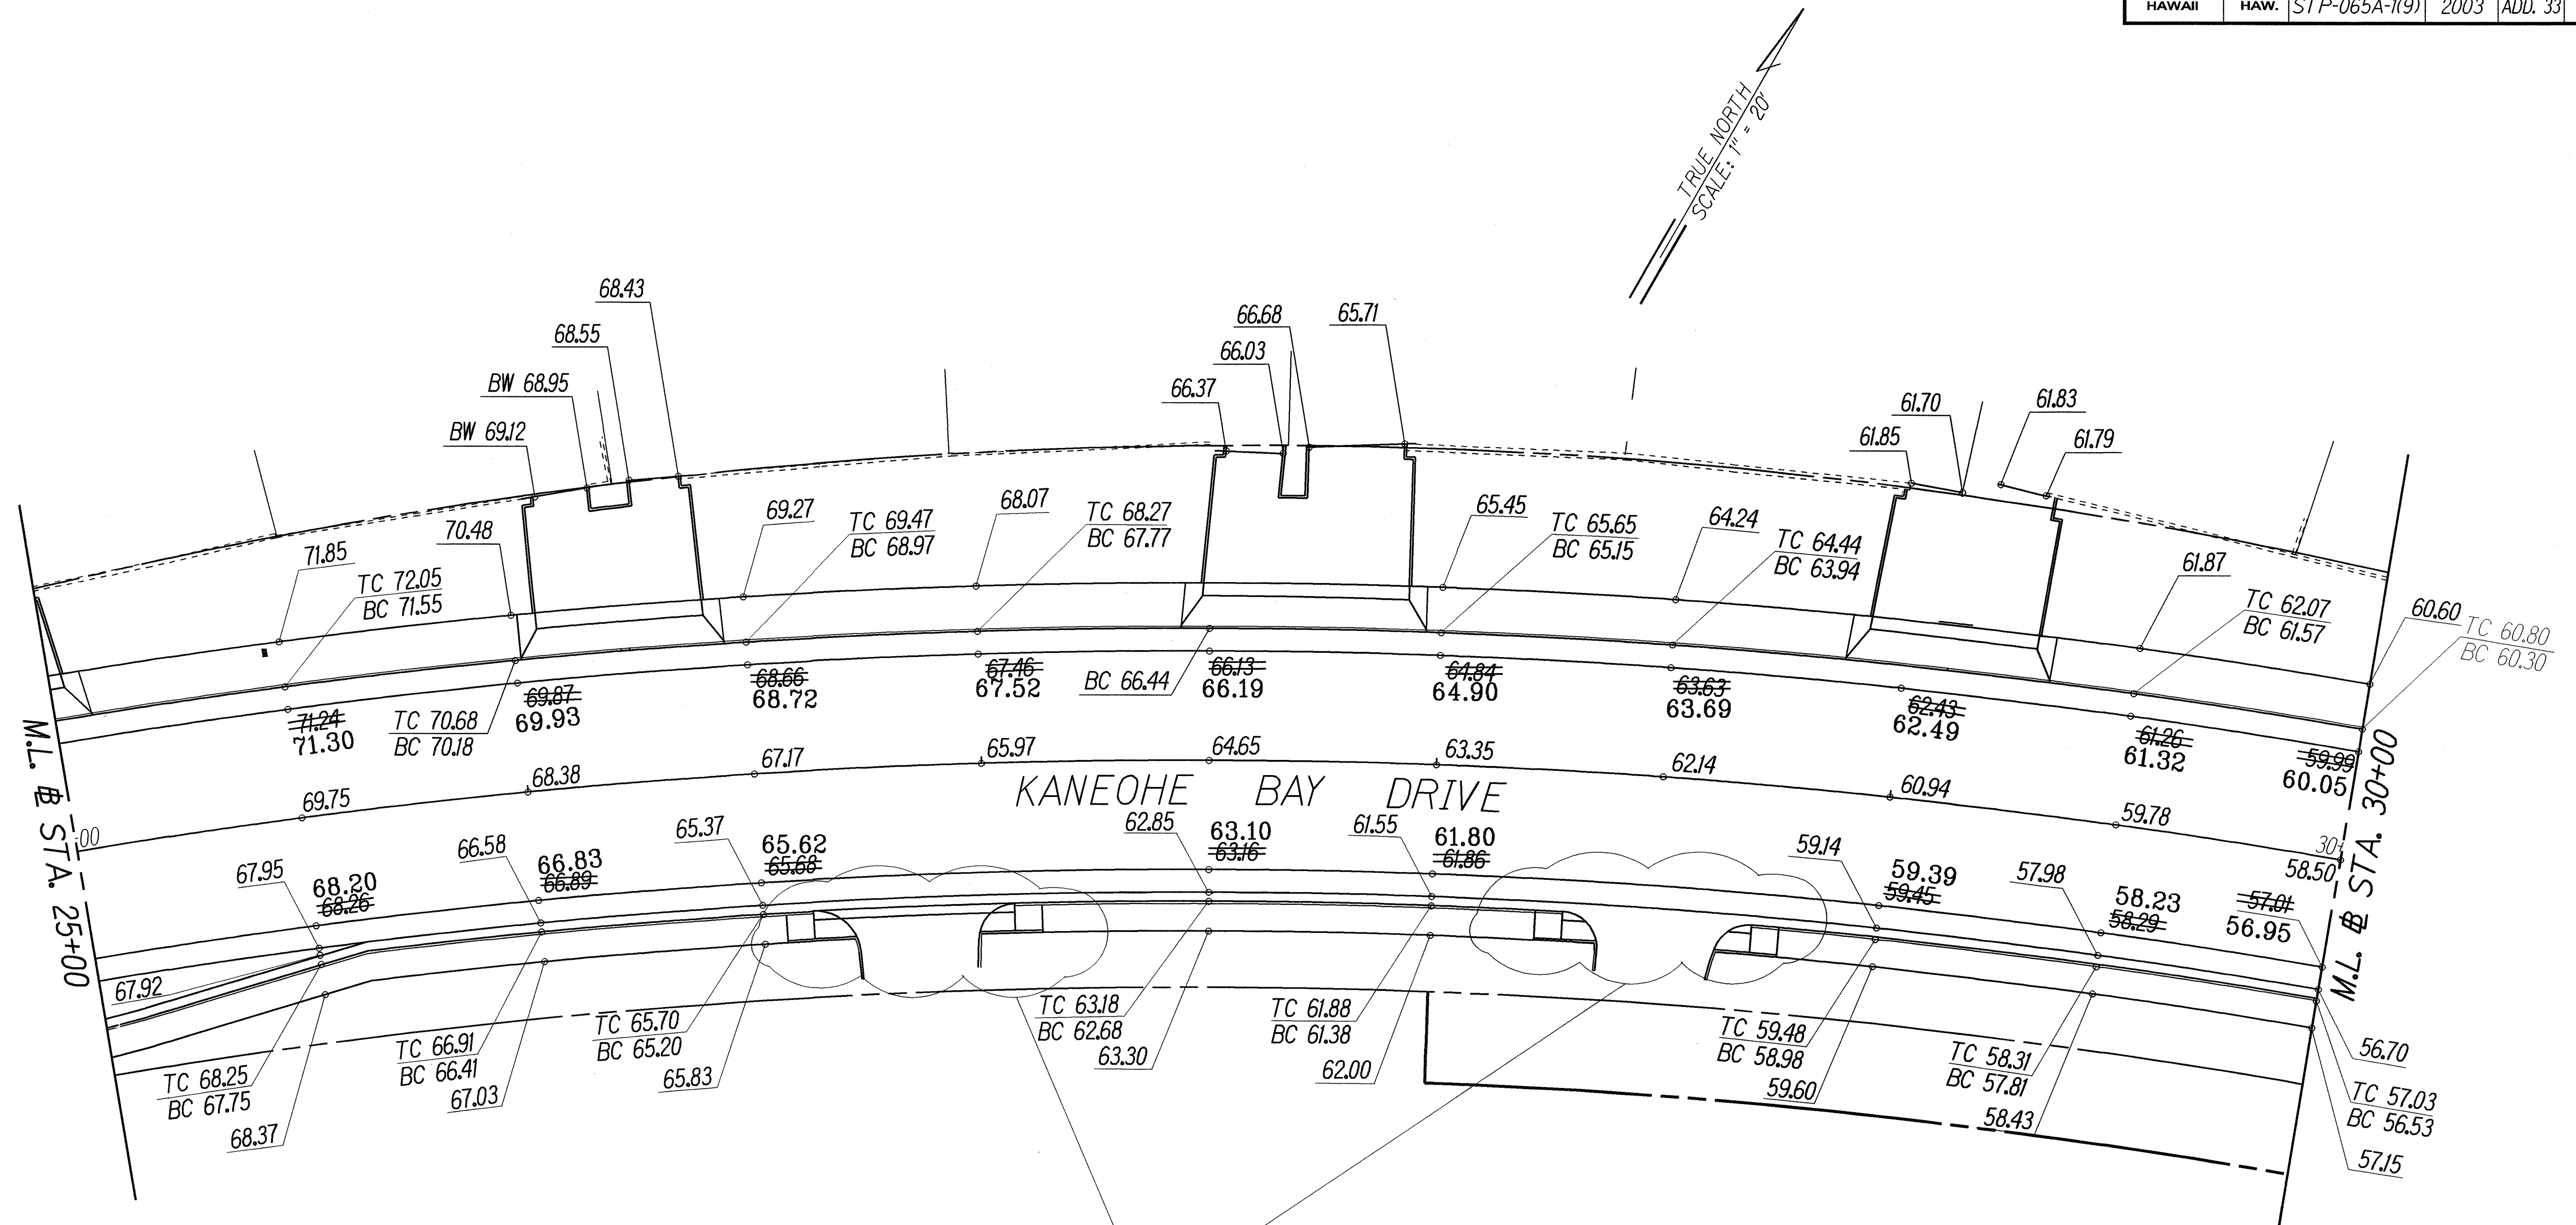

For Curb Ramp Elevations
See Sheet No. Add 33 S-1

LEGEND FOR AS-BUILT POSTINGS	
	Squiggly line for as-built deletion
	Double line for as-built deletion
Roadway	Text for as-built posting

2/3/03	Revised Driveway and Added Curb Ramp Elevations
DATE	REVISION
STATE OF HAWAII DEPARTMENT OF TRANSPORTATION HIGHWAYS DIVISION PAVEMENT GRADING PLAN KANEOHE BAY DRIVE IMPROVEMENTS <i>Vicinity of Puohala Street to Kawa Bridge</i> <i>Federal Aid Project No. STP-065-1(9)</i> Scale: 1"=20' Date: June, 2002	
SHEET No. 2 OF 3 SHEETS	


"AS-BUILT"

ADD. 33

ORIGINAL PLAN	DATE
NOTE BOOK	DESIGNED BY
QUANTITIES BY	CHECKED BY
ASBUILT	

asbuilt.addkandpg02

FED. ROAD DIST. NO.	STATE	FED. AID PROJ. NO.	FISCAL YEAR	SHEET NO.	TOTAL SHEETS
HAWAII	HAW.	STP-065A-1(9)	2003	ADD. 33 S-1	114

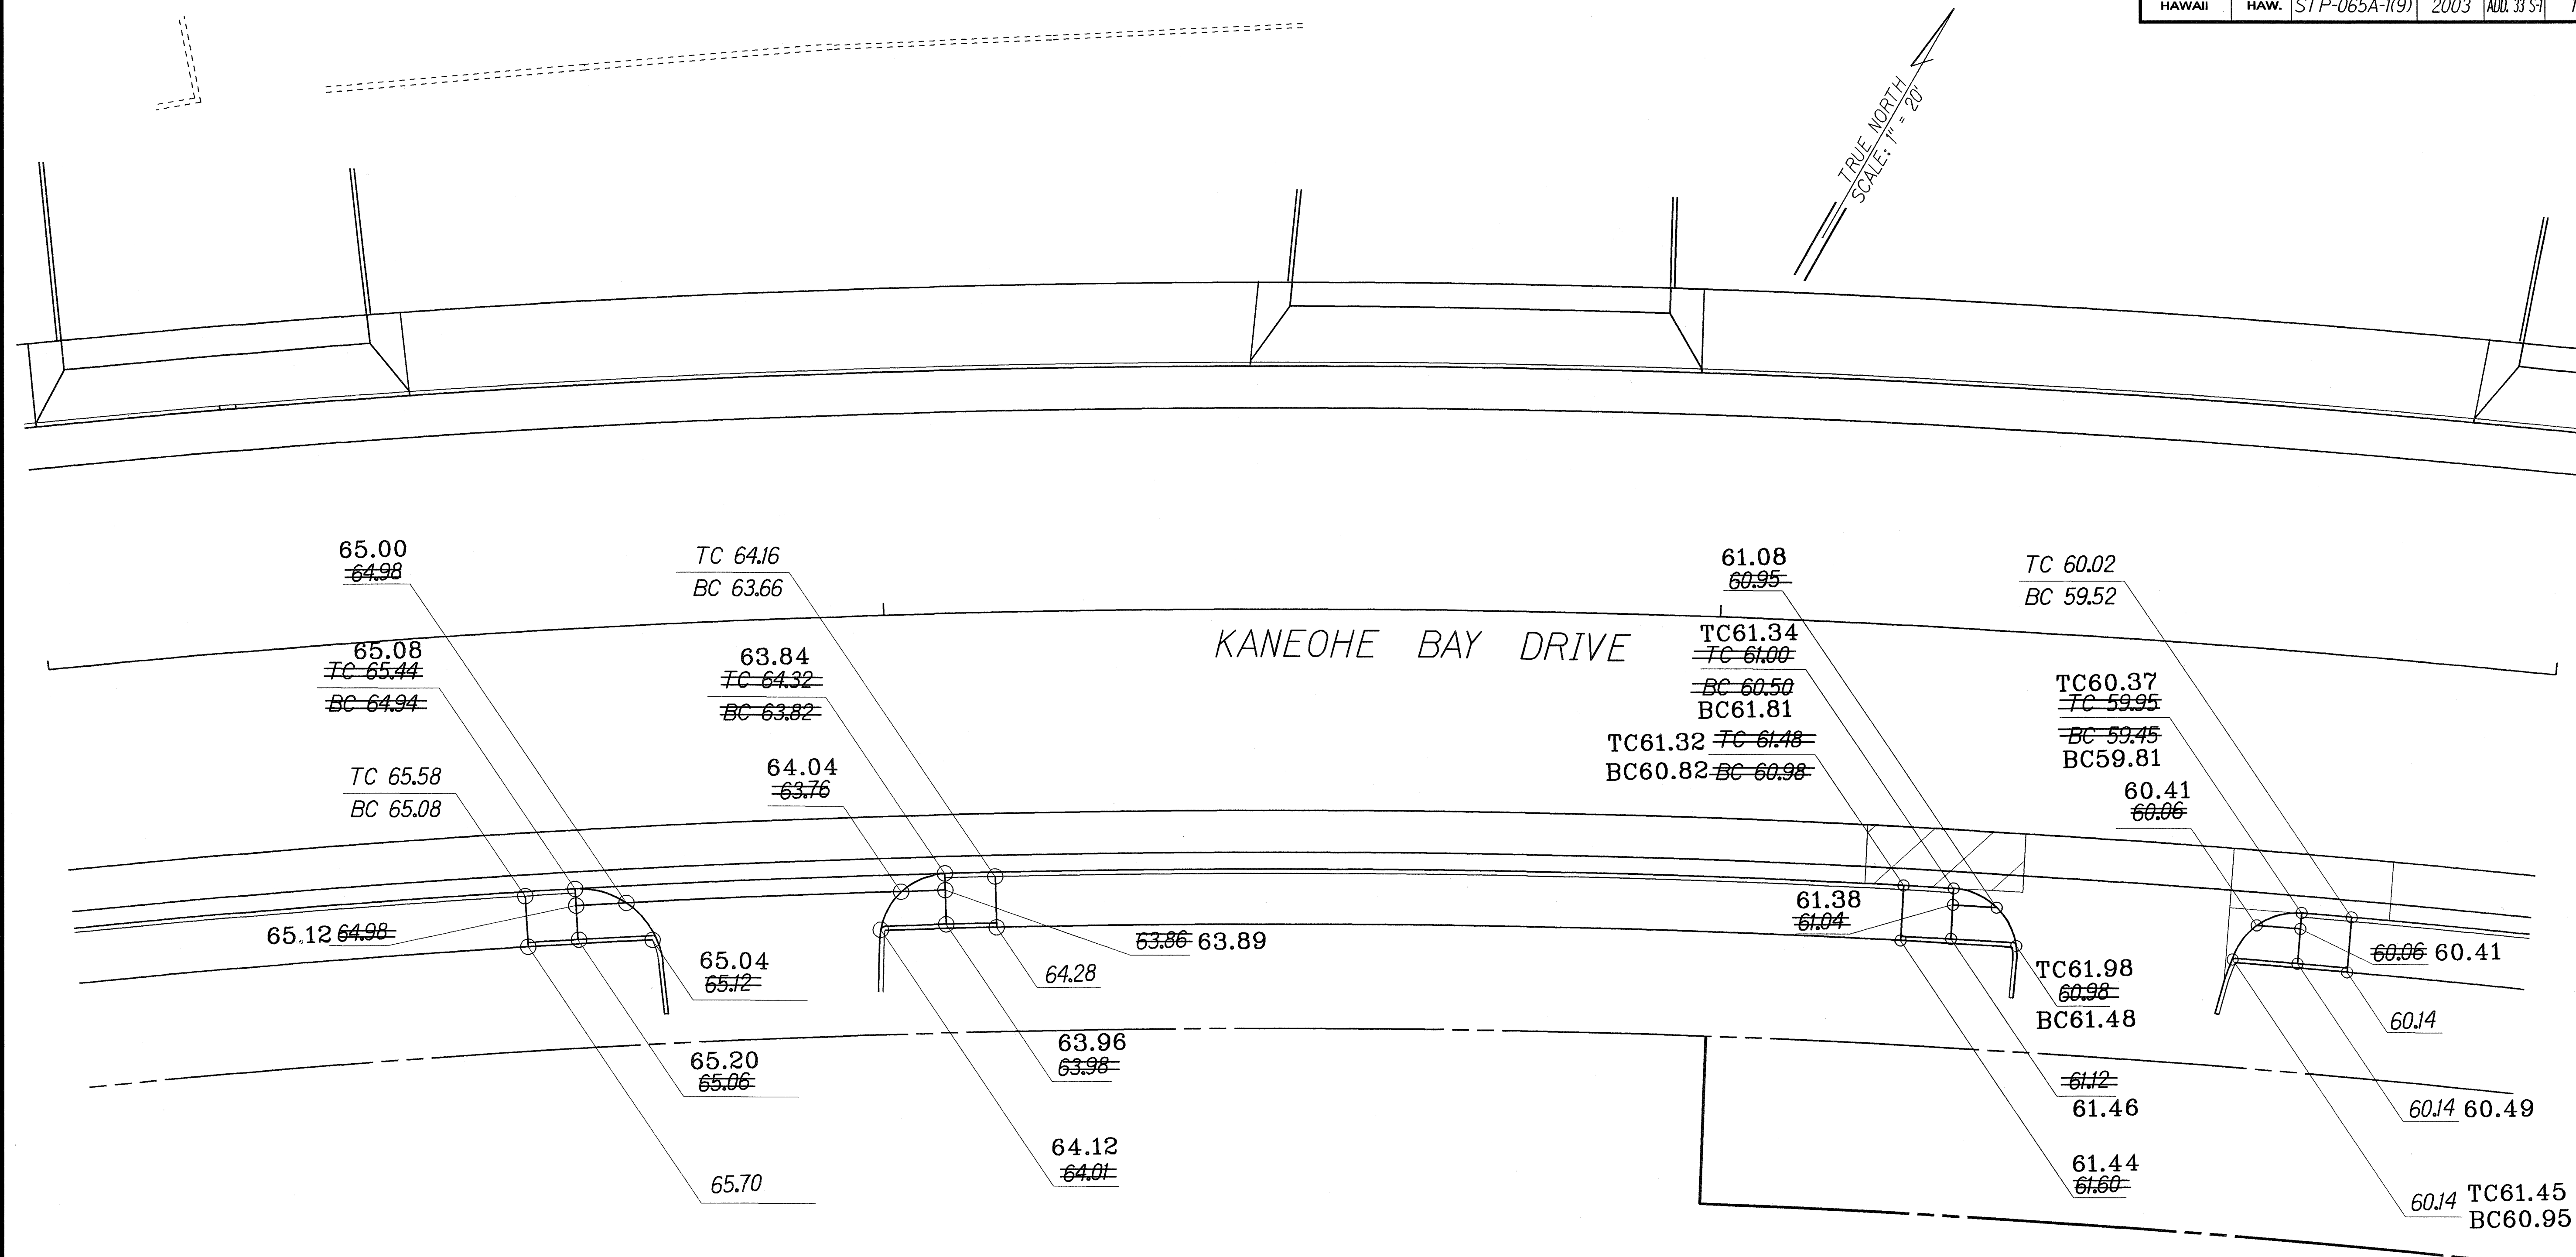

Castle High School Driveway @ Sta. 26+80 and 28+50
Scale: 1"=10'

2/3/03	New Sheet
--------	-----------

<i>DATE</i>	<i>REVISION</i>
-------------	-----------------

STATE OF HAWAII
DEPARTMENT OF TRANSPORTATION
HIGHWAYS DIVISION

PAVEMENT GRADING PLAN

KANEOHE BAY DRIVE IMPROVEMENTS
Vicinity of Puohala Street to Kawa Bridge
Federal Aid Project No. STP-065-1(9)

Scale: 1"=10' Date: June, 2002

SHEET No. 2 OF 3 SHEETS

ADD. 33 S-1

ORIGINAL PLAN	SURVEY PLOTTED BY _____ DATE _____
NOTE BOOK	DRAWN BY _____
	TRACED BY _____
	DESIGNED BY _____
	QUANTITIES BY _____
No. _____	CHECKED BY _____

asbuilt.add4kandp02S-1


LEGEND FOR AS-BUILT POSTINGS

	Squiggly line for as-built deletion
100.00	Double line for as-built deletion
Roadway	Text for as-built posting

"AS-BUILT"

ADD. 33 S-1

FED. ROAD DIST. NO.	STATE	FED. AID PROJ. NO.	FISCAL YEAR	SHEET NO.	TOTAL SHEETS
HAWAII	HAW.	STP-065-1(9)	2003	ADD. 34	114

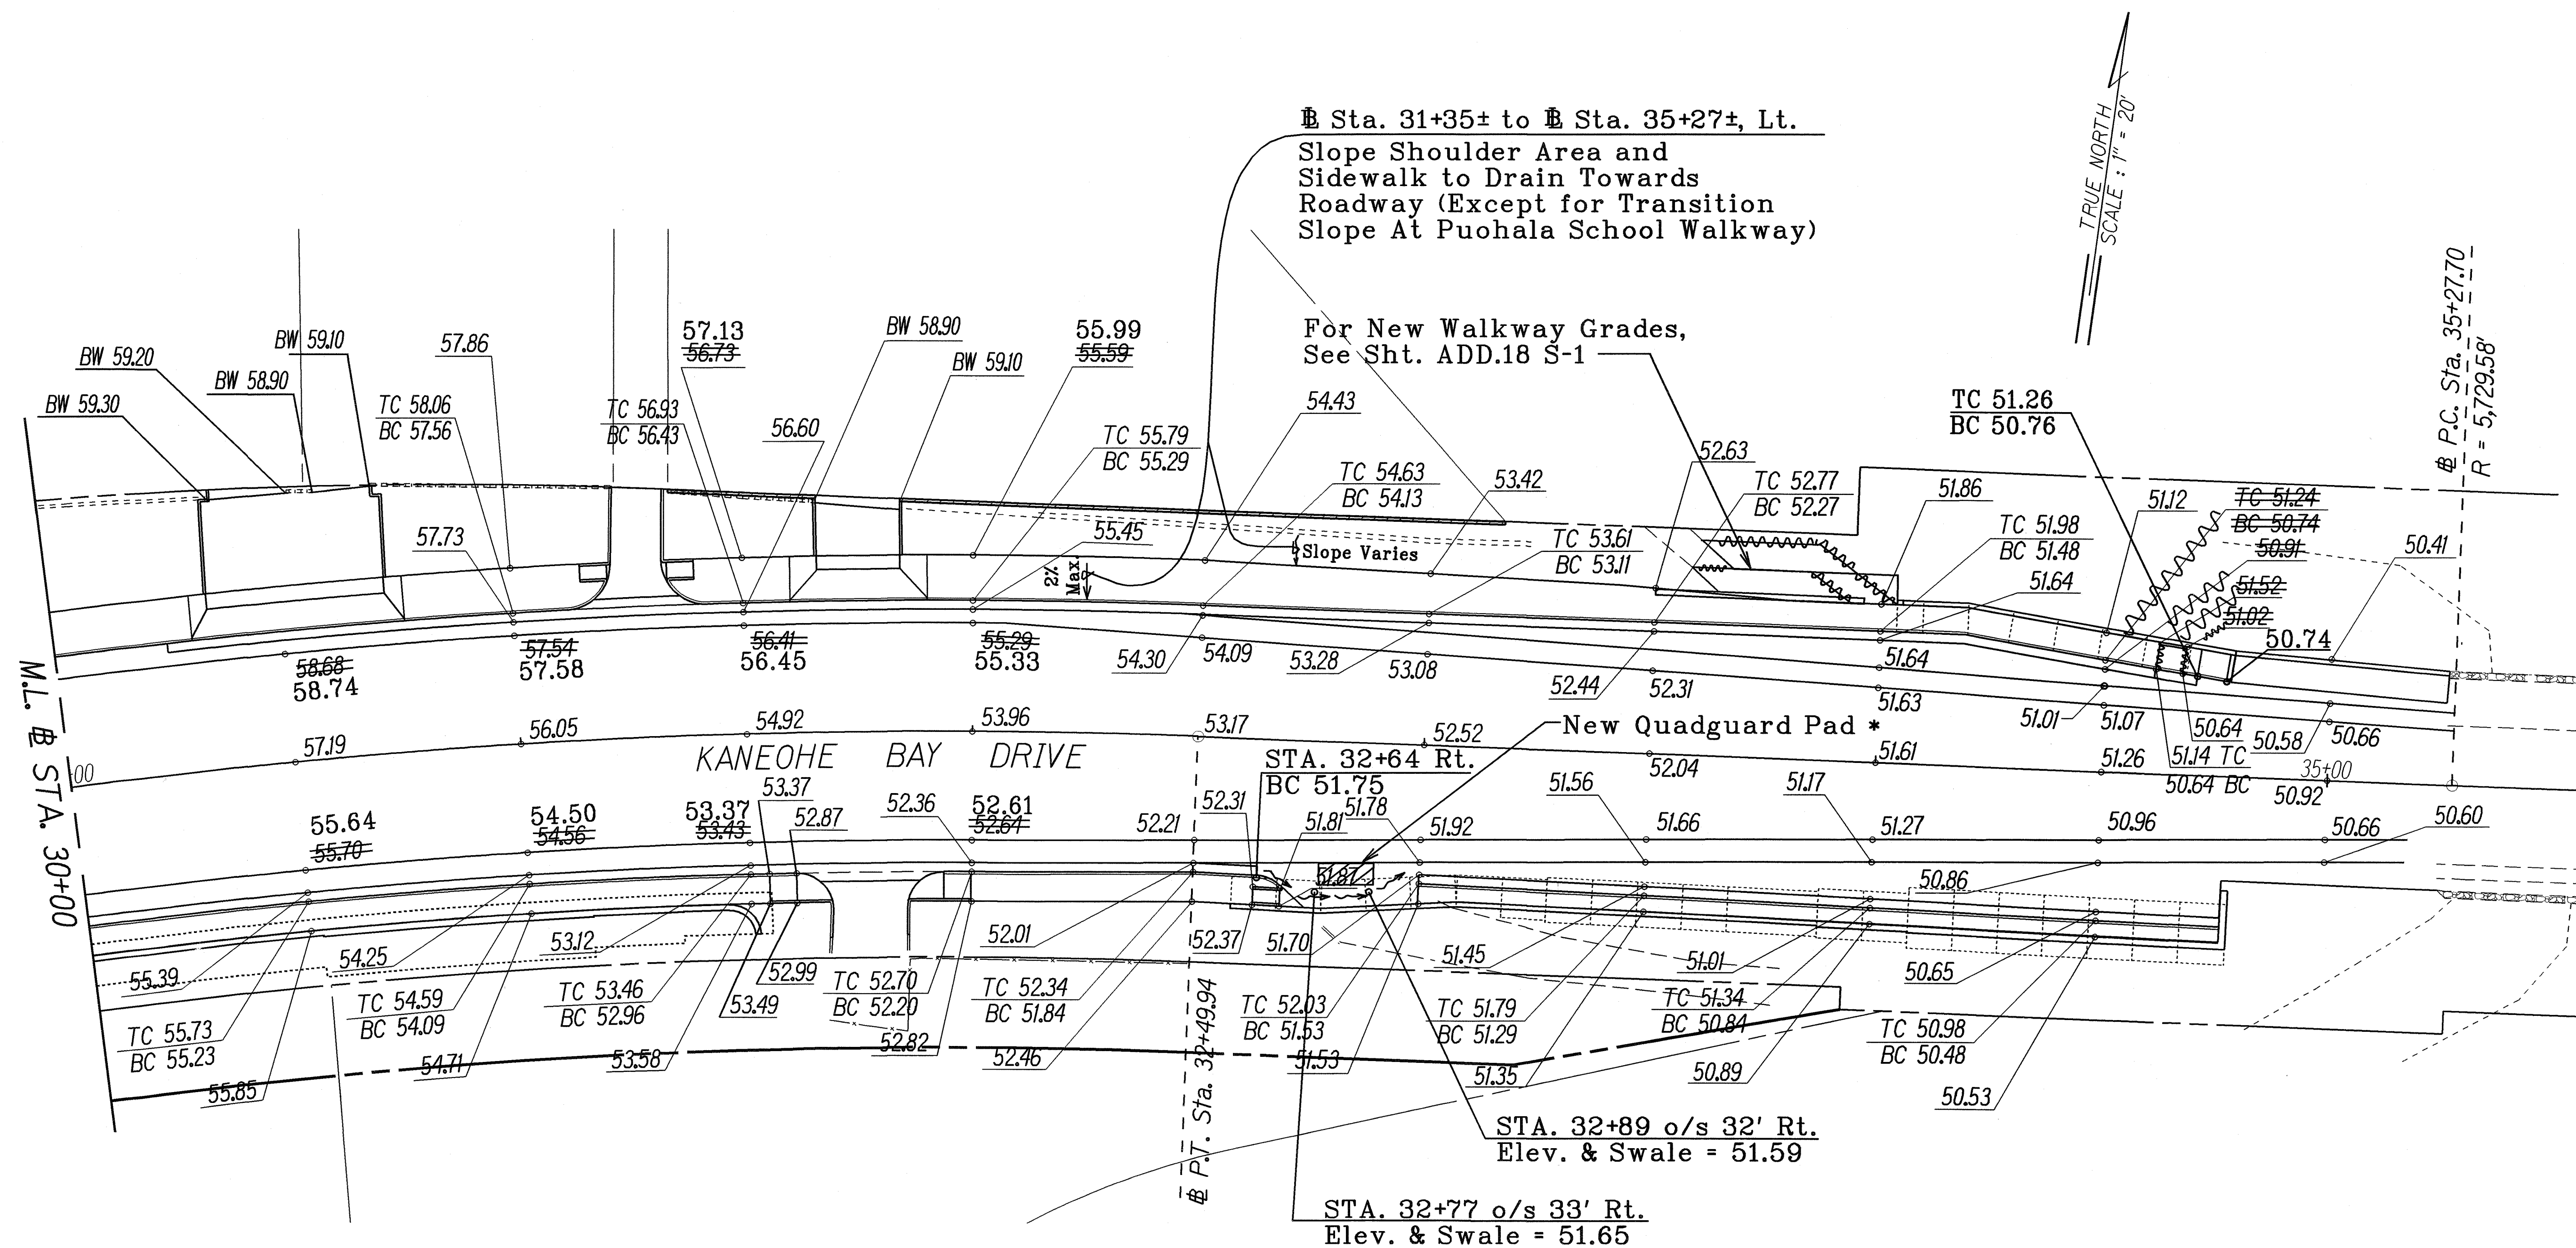

* New Quadguard Pad
Sta. 32+77 to Sta. 32+89 o/s 27', Rt.

Route New AC Swale to Drain Around Quadguard Pad. Warp Pavement to Match Adjacent Gutter and Shoulder Grades At Sta. 32+64 Rt. & Sta. 33+00 Rt.

LEGEND FOR AS-BUILT POSTINGS

	Squiggly line for as-built deletion
	Double line for as-built deletion
Roadway	Text for as-built posting

2/3/03 Revised Driveway Per Addendum No. 1

DATE REVISION

STATE OF HAWAII
DEPARTMENT OF TRANSPORTATION
HIGHWAYS DIVISION

PAVEMENT GRADING PLAN

KANEOHE BAY DRIVE IMPROVEMENTS
Vicinity of Puohala Street to Kawa Bridge
Federal Aid Project No. STP-065-1(9)

Scale: 1" = 20' Date: June, 2002

SHEET No. 3 OF 3 SHEETS

"AS-BUILT"

ADD. 34

ORIGINAL PLAN	DATE
DRAWN BY S.T. GIL	5/23/01
DESIGNED BY T.W. B.H.	
QUANTITIES BY S. KANDOGI	
CHECKED BY S. KANDOGI	

asbuilt.ADD.kandog03