

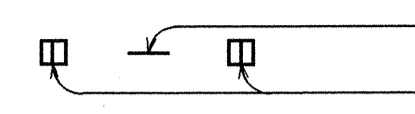
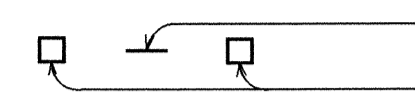



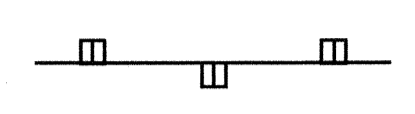



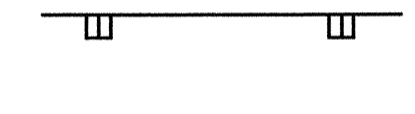
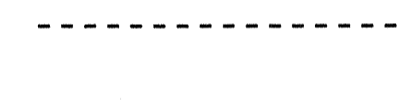
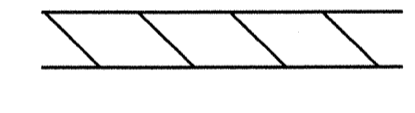
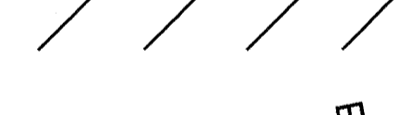


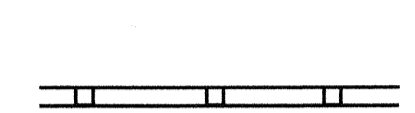



FED. ROAD DIST. NO.	STATE	FED. AID PROJ. NO.	FISCAL YEAR	SHEET NO.	TOTAL SHEETS
HAWAII	HAW.	STP-065-1(9)	2003	87	114

LEGEND

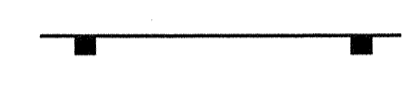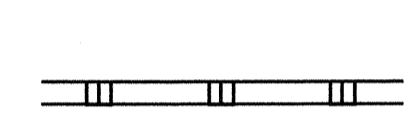-  4 each Type A Raised Pavement Markers
Type C Raised Pavement Markers @ 40'-0" o.c.
-  4 each Type J Raised Pavement Markers
Type D Raised Pavement Markers @ 40'-0" o.c.
-  8" White Stripe with Type C Raised Pavement Markers @ 20'-0" o.c. (Tape, Type I or Thermoplastic Extrusion)
-  4" Double Solid Yellow with Type D Raised Pavement Markers @ 20'-0" o.c. (Tape, Type I or Thermoplastic Extrusion))
-  4" Double Solid Yellow Stripes with Type H Raised Pavement Markers @ 20'-0" o.c. (Tape, Type II or Thermoplastic Extrusion))
-  4" Yellow Edge Stripe with Type H Raised Pavement Markers @ 40'-0" o.c. (Tape, Type II or Thermoplastic Extrusion))
-  4" Double Solid White Stripes with Type C Raised Pavement Markers @ 20'-0" o.c. (Tape, Type I or Thermoplastic Extrusion)
-  Lane Change Restriction Marking
4 each Type A Raised Pavement Markers
Type C Raised Pavement Markers @ 20'-0" o.c.
4" White Stripe (Tape, Type I or Thermoplastic Extrusion)
-  4" or 8" White Edge Stripe with Type C Raised Pavement Markers @ 40'-0" o.c. (Tape, Type II or Thermoplastic Extrusion)
-  4" White Guide Lines (Tape, Type III or Thermoplastic Extrusion except for bus bays)
-  Transverse Median Marking (Tape, Type II or Thermoplastic Extrusion)
-  Transverse Shoulder Marking (Tape, Type II or Thermoplastic Extrusion)
-  Channelizing Island or Deceleration Lane Gore (Tape, Type II or Thermoplastic Extrusion)
-  Crosswalk and Stop Line. All Stop Lines shall be 10'-0" from Crosswalk unless otherwise noted. The circled number indicates the number of lanes for payment (Tape, Type III or Thermoplastic Extrusion)
-  Pavement Arrow (Tape, Type III or Thermoplastic Extrusion)
-  Pavement Word (Tape, Type III or Thermoplastic Extrusion)
-  4 Each Type J Raised Pavement Markers
Type D Raised Pavement Markers @ 40'-0" o.c.
Type H Raised Pavement Markers (Reflective Surface facing no-passing direction)
4" Single Solid Yellow Stripe (Tape, Type I or Thermoplastic Extrusion)
-  Extension of Edge Line, 4" Wide x 2'-0" Long White Stripe @ 10'-0" o.c. w/Type C Markers @ 40'-0" o.c. (Tape, Type III or Thermoplastic Extrusion)

NOTES

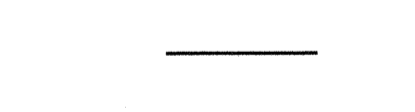
1. Layout of pavement markings and striping shall be done by the Contractor and approved by the Engineer prior to any installation work.
2. Existing pavement markings and striping not incorporated in the final traffic pattern shall be removed as directed by the Engineer. The removal of the existing pavement markings shall not be paid for separately but shall be considered incidental to the various pavement marking items.
3. Raised pavement markers shall not be installed within crosswalks.
4. Final locations of all signs shall be approved by the Engineer prior to any installation work.
5. Existing signs not shown on these plans shall remain as posted unless otherwise directed by the Engineer. Removal and disposal of existing signs and/or posts as designated on these plans or directed by the Engineer shall not be paid for and shall be considered incidental to the various signing items.
6. Final locations of all Stop Lines shall be approved by the Engineer prior to installation.
7. All pavement striping shall be as noted on the Legend or plans.
8. All preformed pavement marking tapes over existing pavement shall be applied with an approved primer as recommended by the tape manufacturer and as approved by the Engineer. The primer shall be allowed to dry to the tacky stage prior to tape application.
9. Removal of Existing Delineators and Posts as directed by the Engineer shall be considered incidental to the various signing items.
10. Existing signs that are to be replaced shall not be removed until new signs are installed as replacements, or the messages are no longer necessary.
11. Backing for all new regulatory and warning signs shall not be spliced.
12. All new and relocated signs and markers installed on pipe post or light standard are to be mounted with band brackets and steel braces.
13. The Contractor shall erect at the beginning of the project and at the end of the project advance construction warning signs as indicated on the plans or as directed by the Engineer for the duration of the highway project and shall be maintained by the Contractor. These signs shall be placed in addition to the required traffic control signs called for in Section 645-Traffic Control. The advance construction warning signs shall be new and become the property of the State. The Contractor shall remove, clean, and deliver the signs and posts to the Oahu District Baseyard or as directed by the Engineer at the end of the project.
14. The Contractor shall notify the Oahu Transit Services Inc. (OTS), Ed Sniffen, at 848-4571 or Lowell Tom at 848-4578 two weeks prior to beginning any work, informing them of location, scope of work, proposed closure of any street or traffic lanes, and the need to relocate any bus stop.

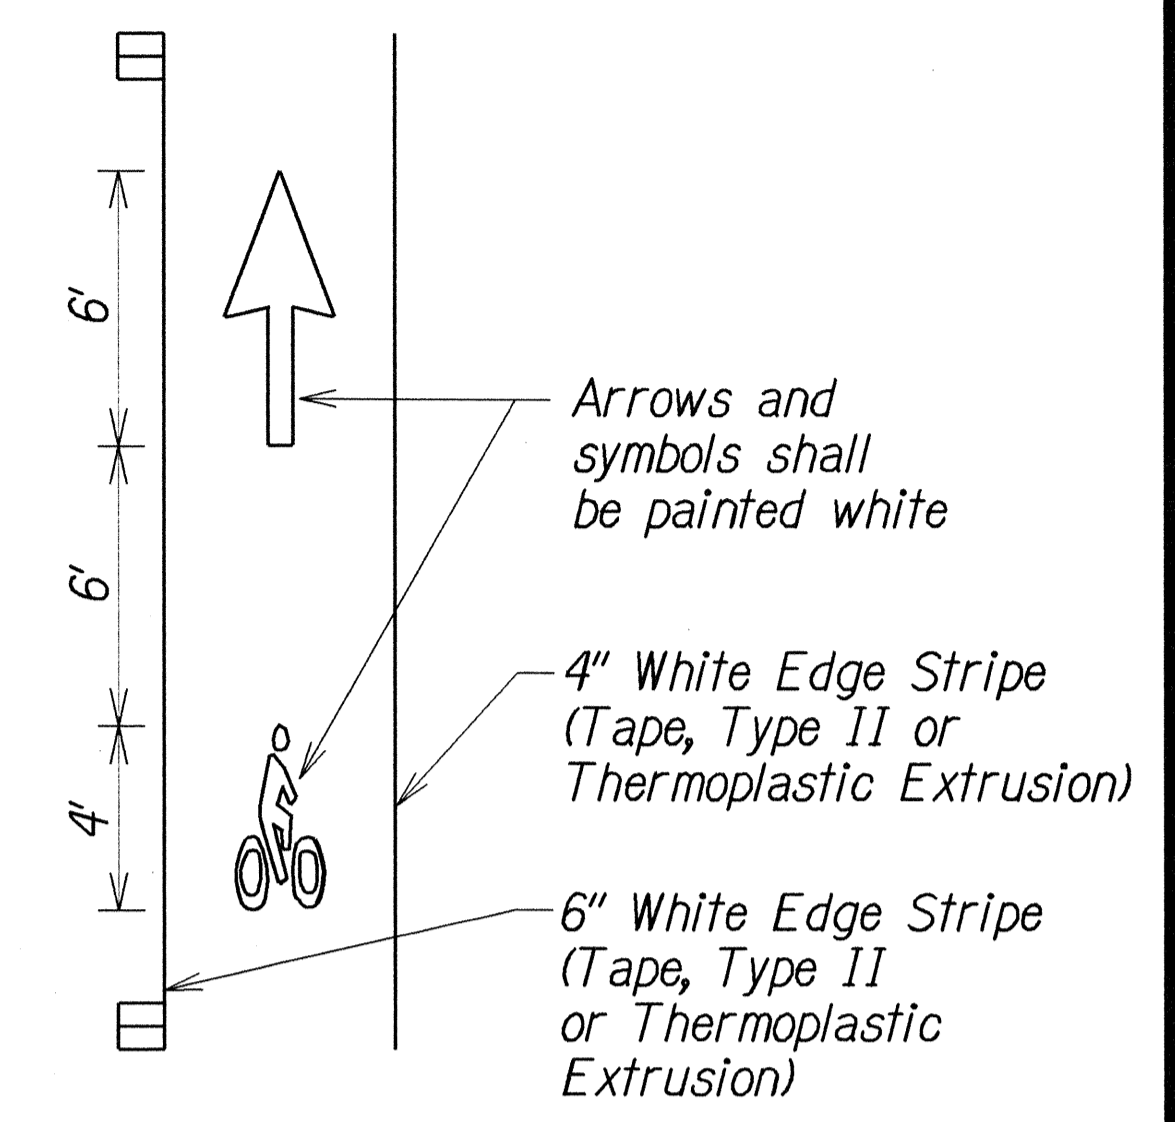

BIKE LANE MARKINGS

Not to Scale

NOTE: Bike Lane Markings - Pavement Arrows and Symbol shall be paid for as one complete set.

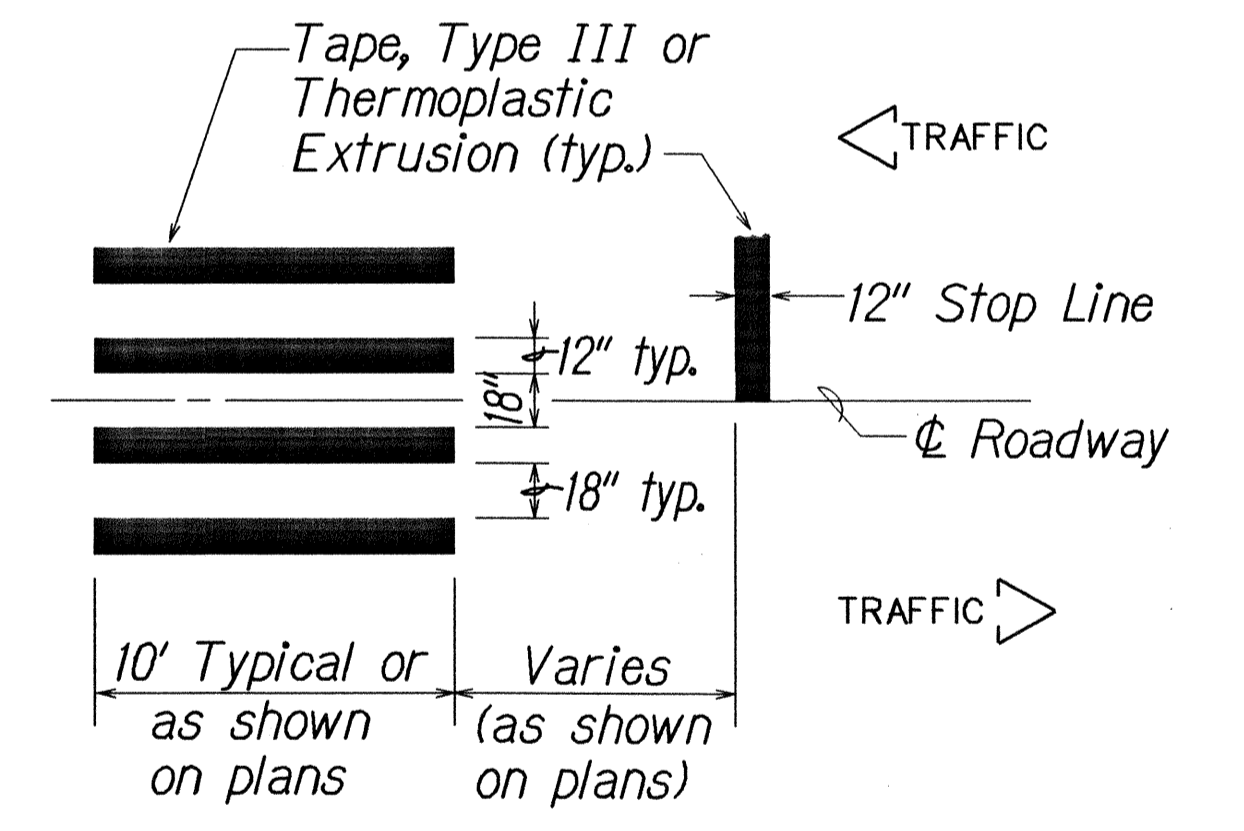

DETAIL "A"

CROSSWALK STRIPING DETAIL

Not to Scale

DATE	2/27/03
DESIGNED BY	...
CHECKED BY	...
DATE	...
DESIGNED BY	...
CHECKED BY	...
DATE	...
DESIGNED BY	...
CHECKED BY	...

STATE OF HAWAII
DEPARTMENT OF TRANSPORTATION
HIGHWAYS DIVISION

**PAVEMENT MARKING
LEGEND, DETAILS & NOTES**


**KANEIHE BAY DRIVE IMPROVEMENTS
Vicinity of Puohala St. to Kawa Bridge
F.A. Project No. STP-065-1(9)**

Scale: As Noted Date: Jan. 2002

SHEET No. 71 OF 4 SHEETS

FED. ROAD DIST. NO.	STATE	FED. AID PROJ. NO.	FISCAL YEAR	SHEET NO.	TOTAL SHEETS
HAWAII	HAW.	STP-065-1(9)	2003	88	114

NOTE: Location of Fire Hydrant Pavement Marker to be determined in the field by the Engineer.

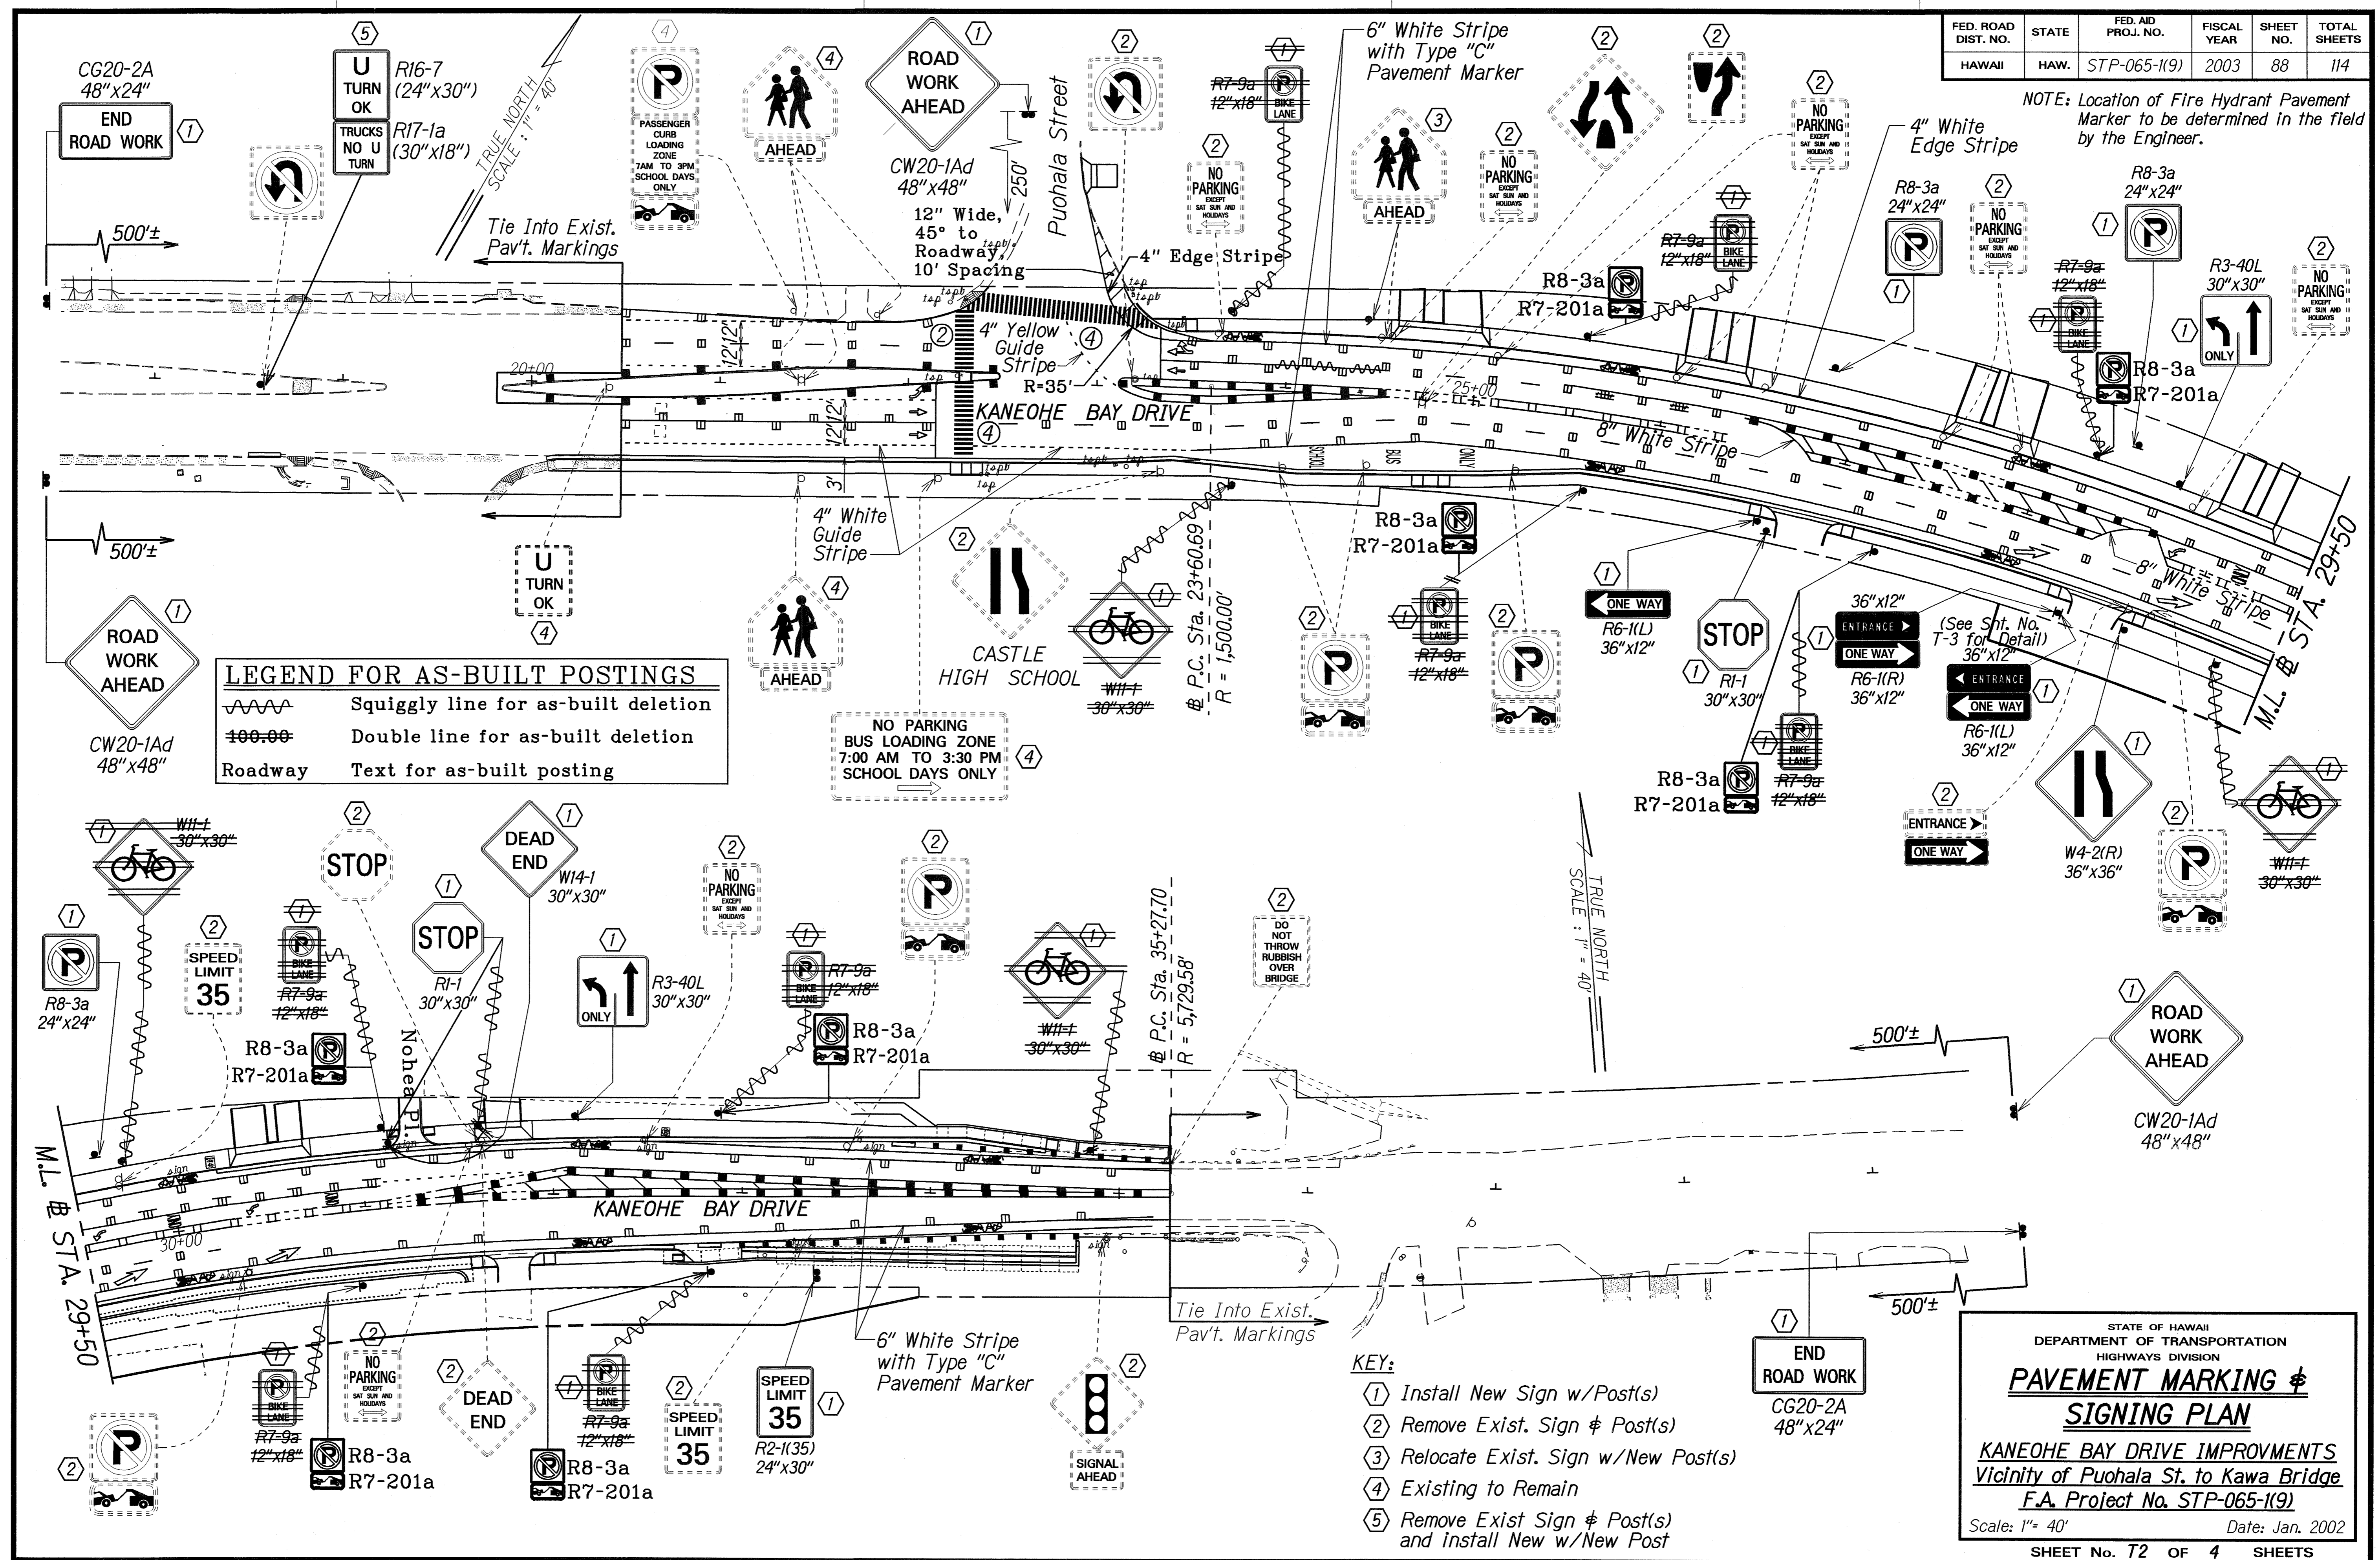

LEGEND FOR AS-BUILT POSTINGS

	Squiggly line for as-built deletion
	Double line for as-built deletion
Roadway	Text for as-built posting

- KEY:**
- ① Install New Sign w/Post(s)
 - ② Remove Exist. Sign & Post(s)
 - ③ Relocate Exist. Sign w/New Post(s)
 - ④ Existing to Remain
 - ⑤ Remove Exist Sign & Post(s) and Install New w/New Post

STATE OF HAWAII
DEPARTMENT OF TRANSPORTATION
HIGHWAYS DIVISION

PAVEMENT MARKING & SIGNING PLAN

KANEOHE BAY DRIVE IMPROVMENTS
Vicinity of Puohala St. to Kawa Bridge
F.A. Project No. STP-065-1(9)

Scale: 1" = 40' Date: Jan. 2002

SHEET No. T2 OF 4 SHEETS

DATE: 02/28/02
SURVEY OBTAINED BY: [Name]
PLAN TRACED BY: [Name]
DESIGNED BY: [Name]
CHECKED BY: [Name]

"AS-BUILT"



FED. ROAD DIST. NO.	STATE	FED. AID PROJ. NO.	FISCAL YEAR	SHEET NO.	TOTAL SHEETS
HAWAII	HAW.	STP-065-1(9)	2003	89	114

PAVEMENT MARKING SUMMARY	
DESCRIPTION	QUANTITY
PAVEMENT MARKERS	
TYPE A _____	108 EA.
TYPE C _____	112 EA.
TYPE D _____	21 EA.
TYPE DB _____	1 EA.
TYPE H _____	81 EA.
TAPE - TYPE I OR THERMOPLASTIC EXTRUSION	
4-INCH PAVEMENT STRIPE (WHITE) _____	170 L.F.
8-INCH PAVEMENT STRIPE (WHITE) _____	320 L.F.
DOUBLE 4-INCH PAVEMENT STRIPE (YELLOW) _____	420 L.F.
TAPE - TYPE II OR THERMOPLASTIC EXTRUSION	
4-INCH PAVEMENT STRIPE (YELLOW) _____	300 L.F.
4-INCH PAVEMENT STRIPE (WHITE) _____	2780 L.F.
6-INCH PAVEMENT STRIPE (WHITE) _____	2,400 L.F.
8-INCH PAVEMENT STRIPE (WHITE) _____	80 L.F.
12-INCH PAVEMENT STRIPE (YELLOW) _____	120 L.F.
DOUBLE 4-INCH PAVEMENT STRIPE (YELLOW) _____	1,500 L.F.
TAPE - TYPE III OR THERMOPLASTIC EXTRUSION	
4-INCH PAVEMENT STRIPE (WHITE) _____	620 L.F.
4-INCH PAVEMENT STRIPE (YELLOW) _____	60 L.F.
CROSSWALK MARKING _____	10 LANE
12-INCH PAVEMENT STRIPE (WHITE) _____	90 L.F.
PAVEMENT ARROW _____	12 EA.
PAVEMENT SYMBOL _____	12 EA.
PAVEMENT WORD _____	6 EA.

TRAFFIC SIGN SUMMARY				
SIGN NO.	MESSAGE	QUANTITY		
		10 SQ. FT. OR LESS		RELOCATE 10 SQ. FT. OR LESS
		W/POST	W/O POST	W/POST
R1-1	STOP	2	-	-
R2-1(35)	SPEED LIMIT 35	1	-	-
R3-40L	ONLY ↑	2	-	-
R6-1(L)	ONE WAY	2	-	-
R6-1(R)	ONE WAY	-	1	-
R7-9a R7-201a	BIKE LANE TOW AWAY SYMBOL	9	8	-
R8-3a	NO PARKING SYMBOL	3 11	-	-
R16-7	U TURN OK	1	-	-
R17-1a	TRUCKS NO U TURN	-	1	-
W4-2(R)		1	-	-
W11-1	🚲	4 0	-	-
W14-1	DEAD END	-	1	-
	◁ ENTRANCE	-	1	-
	ENTRANCE ▷	-	1	-
SI-1 (EXIST.)	SCHOOL CROSSING	-	-	1
	TOTAL	25 20	5 13	1

CONSTRUCTION SIGN SUMMARY				
SIGN NO.	LOCATION	MESSAGE	W/POSTS	W/O POST
CW20-1Ad	Ⓜ Sta. 14+00± Rt.	ROAD WORK AHEAD	1	-
CG20-2A	Ⓜ Sta. 14+00± Lt.	END ROAD WORK	1	-
CW20-1Ad	Ⓜ Sta. 40+00± Lt.	ROAD WORK AHEAD	1	-
CG20-2A	Ⓜ Sta. 40+00± Rt.	END ROAD WORK	1	-
	TOTAL		4	-

DATE: 7/27/03
 SURVEY PLOTTED BY: L. Hengalis
 DRAWN BY: L. Hengalis
 NOTE BOOK: 10/1/03
 QUANTITIES BY: L. Hengalis
 CHECKED BY: S. Hengalis

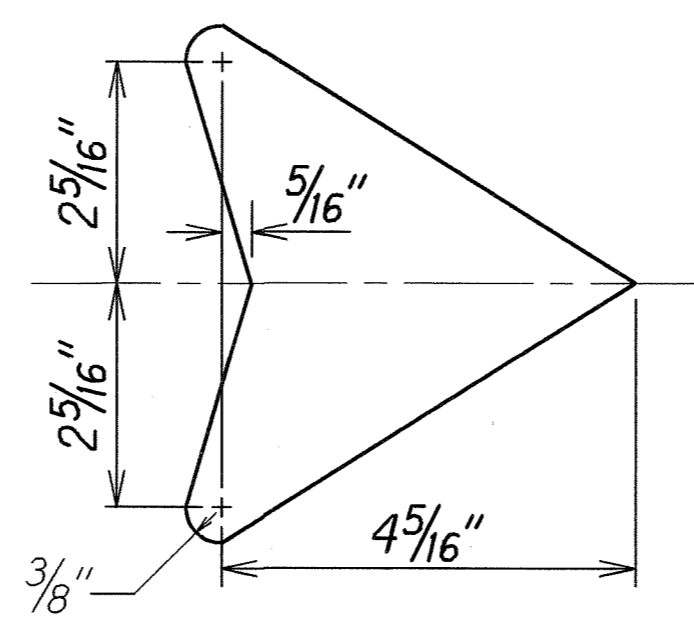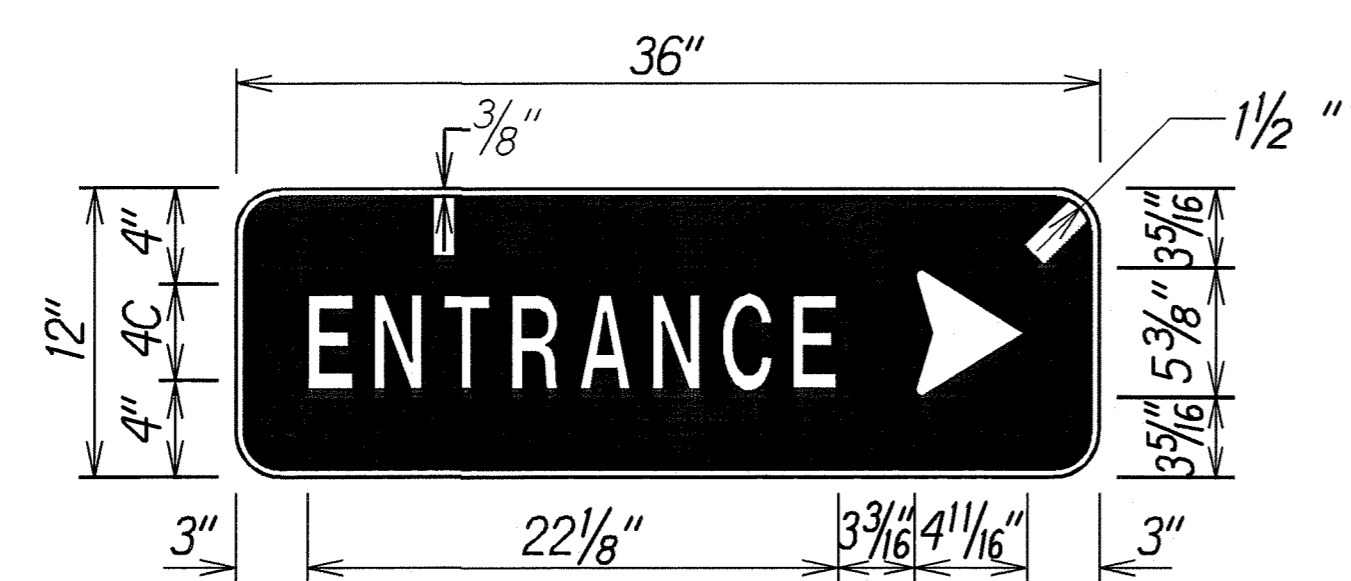

COLORS:
 LEGEND: White (Reflective)
 BACKGROUND: Green (Reflective)

LEGEND FOR AS-BUILT POSTINGS	
~~~~~	Squiggly line for as-built deletion
==	Double line for as-built deletion
Roadway	Text for as-built posting


2/20/03	Revise Traffic Sign Summary Quantities.
DATE	REVISION

STATE OF HAWAII  
 DEPARTMENT OF TRANSPORTATION  
 HIGHWAYS DIVISION  
**TRAFFIC SUMMARY**  
**Ⓜ SIGN DETAILS**  
 KANEHOE BAY DRIVE IMPROVEMENTS  
 Vicinity of Puohala St. to Kawa Bridge  
 F.A. Project No. STP-065-1(9)  
 Date: Jan. 2002  
 SHEET No. T3 OF 4 SHEETS

"AS-BUILT"

ADD. 89

FED. ROAD DIST. NO.	STATE	FED. AID PROJ. NO.	FISCAL YEAR	SHEET NO.	TOTAL SHEETS
HAWAII	HAW.	STP-065-1(9)	2003	90	114

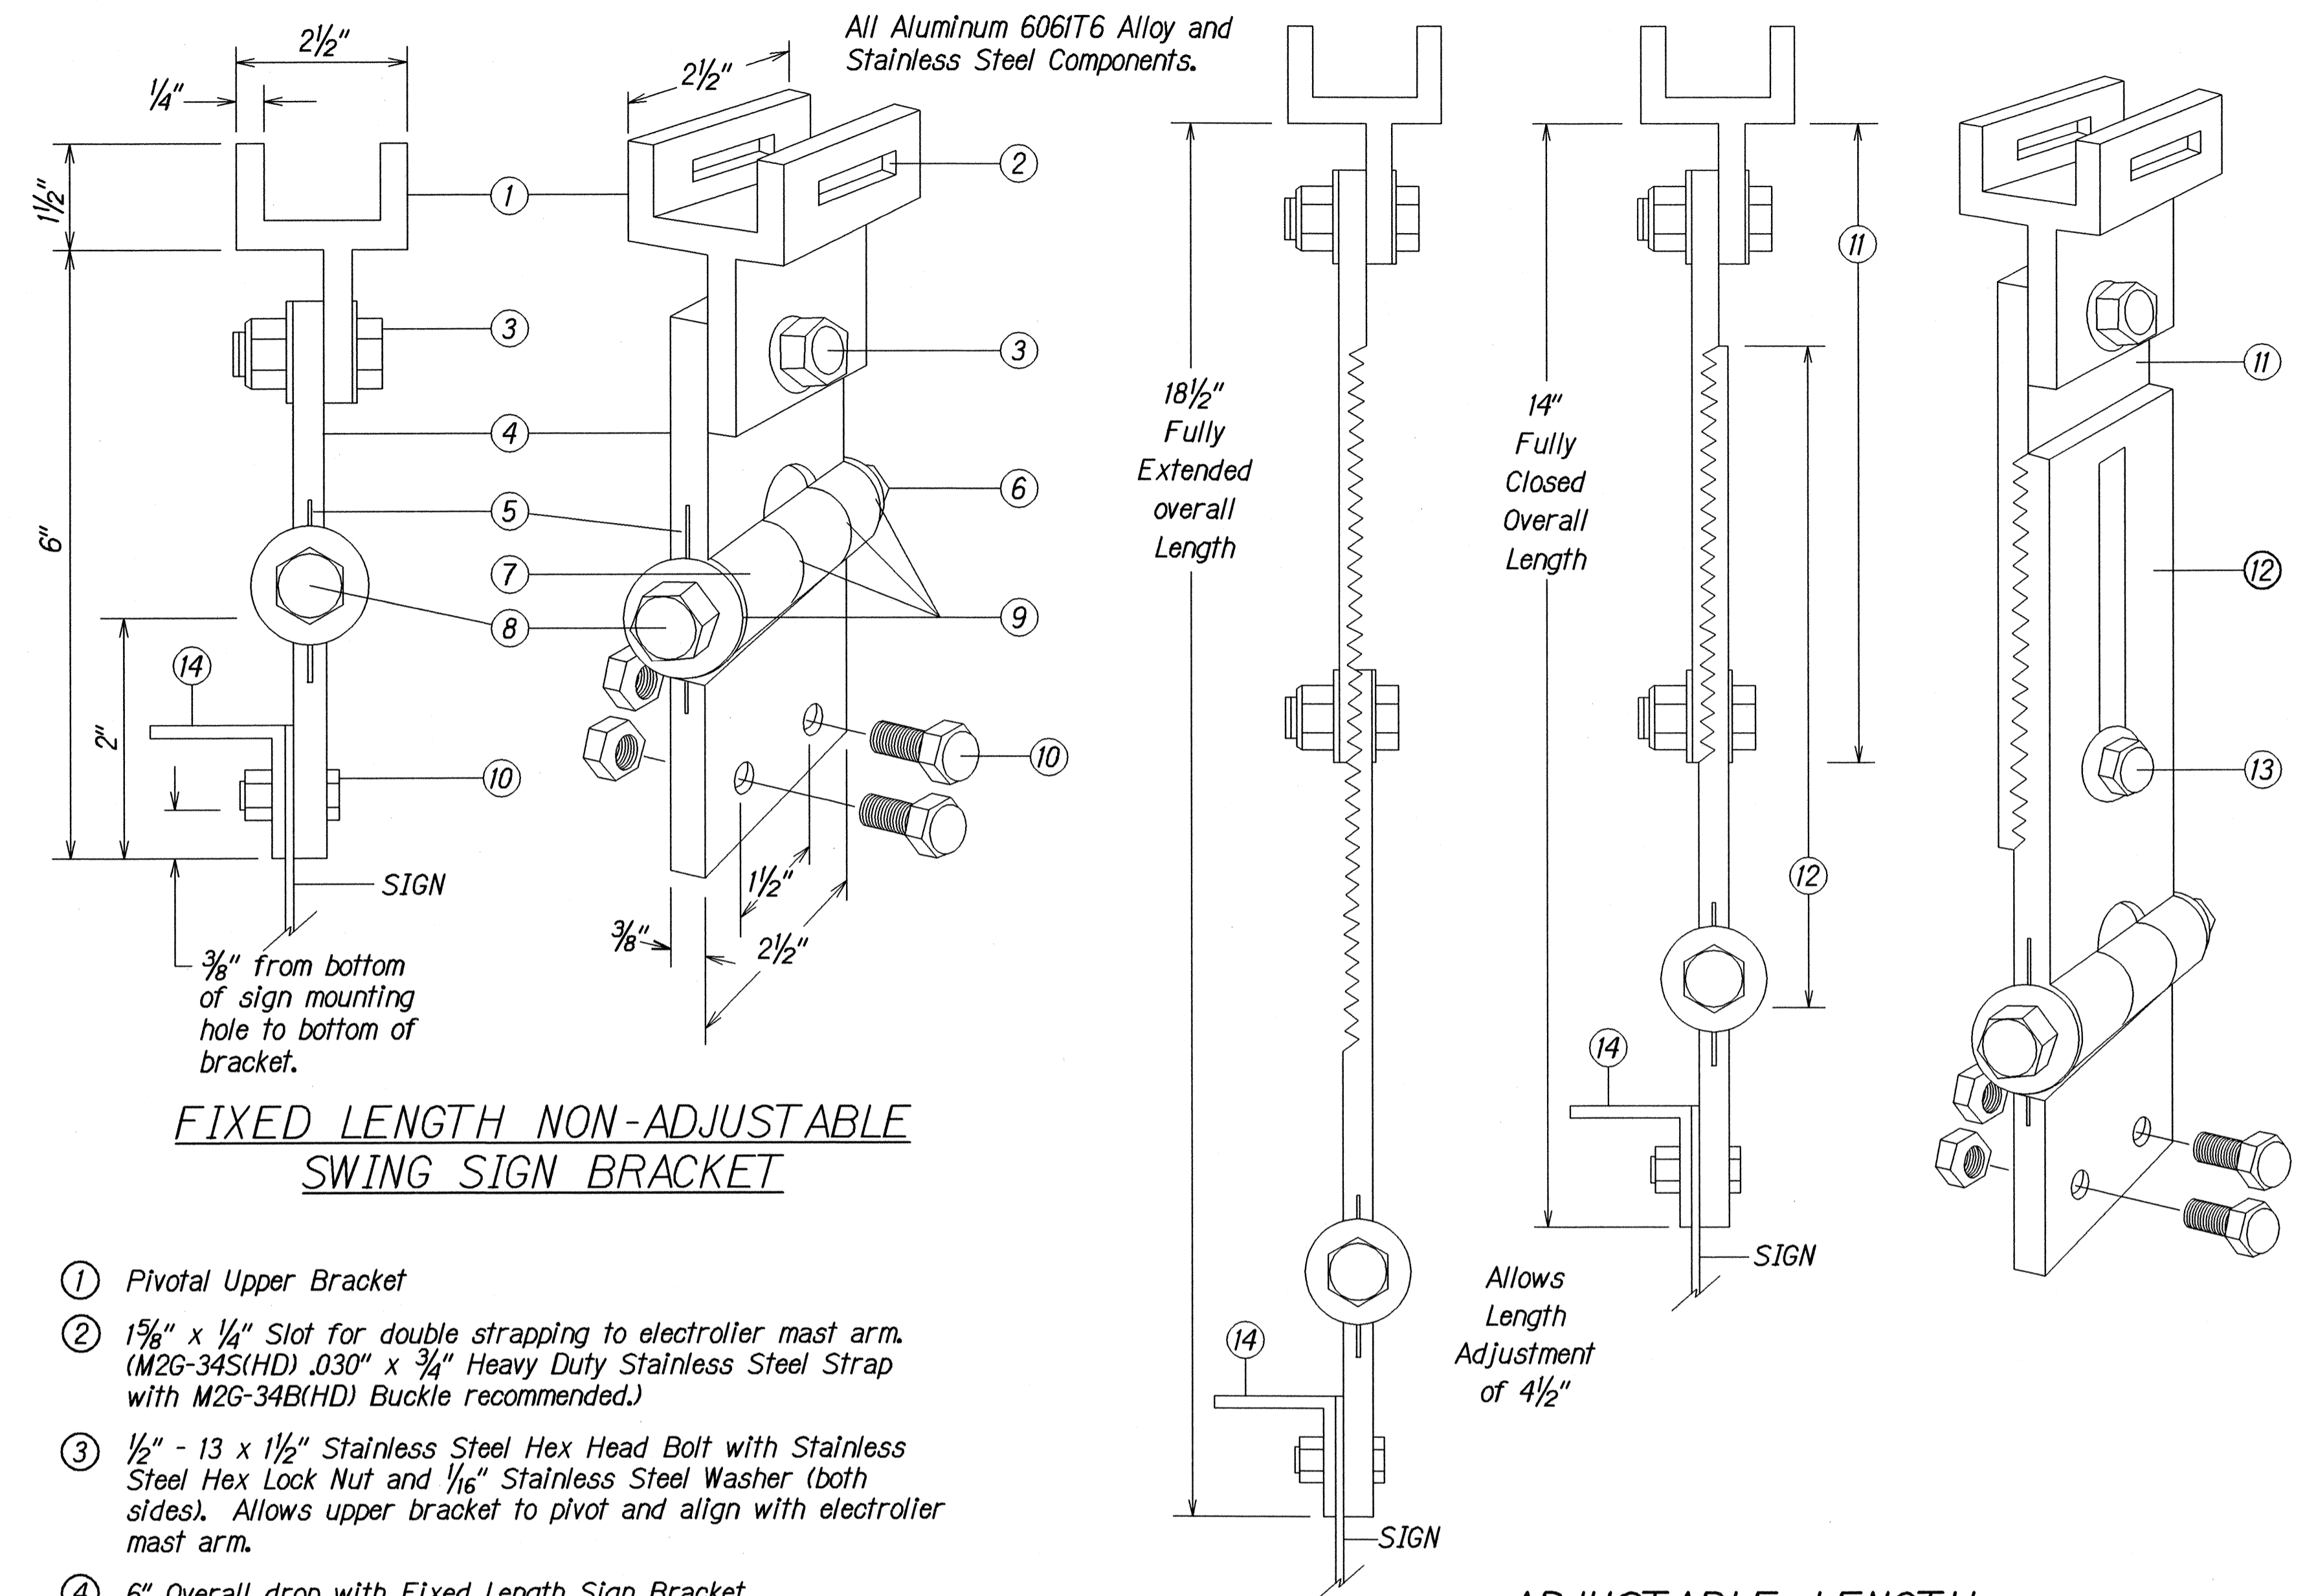


**FIXED LENGTH NON-ADJUSTABLE SWING SIGN BRACKET**

**ADJUSTABLE LENGTH SWING SIGN BRACKET**


- ① Pivotal Upper Bracket
- ② 1 5/8" x 1/4" Slot for double strapping to electroler mast arm. (M2G-34S(HD) .030" x 3/4" Heavy Duty Stainless Steel Strap with M2G-34B(HD) Buckle recommended.)
- ③ 1/2" - 13 x 1 1/2" Stainless Steel Hex Head Bolt with Stainless Steel Hex Lock Nut and 1/16" Stainless Steel Washer (both sides). Allows upper bracket to pivot and align with electroler mast arm.
- ④ 6" Overall drop with Fixed Length Sign Bracket
- ⑤ Stainless Steel Dampener Spring (Removable)
- ⑥ Stainless Steel Hex Lock Nut with 1/16" Stainless Steel Washer
- ⑦ 1" O.D. Axle Housing
- ⑧ 1/2" - 13 x 4" Stainless Steel Hex Head Bolt with 1/16" Stainless Steel Washer
- ⑨ Oilite Bushing
- ⑩ Sign Mounting Sets, consisting of two each 5/16" - 18 x 1" Stainless Steel Hex Head Bolt with Stainless Steel Hex Lock Nut. Two holes on 1/2" centers provide positive lock sign mounting to bracket.
- ⑪ 8 1/4" overall length Upper Adjustable Sign Bracket section
- ⑫ 9" overall length Lower Adjustable Sign Bracket section, including Axle Housing (8" overall length to top of Axle Housing)
- ⑬ 1/2" - 13 x 1 1/2" Stainless Steel Hex Bolt with Stainless Steel Hex Lock Nut and 1/16" Stainless Steel Washers (both sides). Loosen lock nut, adjust bracket teeth to level sign.
- ⑭ 1 1/4" x 1 1/4" x 1/8" Aluminum Angle

**STREET NAME (D3) SIGN NOTES:**

1. Sign D3-1 shall be a new Street Name Sign. The Contractor shall provide the same message on the front and back side of the sign. Payment will not be made separately but shall be considered as one unit.
2. Colors:  
Legend - White (Reflectorized)  
Background - Green (Reflectorized)
3. All panels shall be reflectorized with Type III or IV retroreflective sheeting in accordance with Section - 712.20 of the Standard Specifications.
4. All signs shall conform to section 621 of the Standard Specifications and the latest editions and amendments of the following FHWA publications:  
a. "Manual on Uniform Traffic Control Devices for Streets and Highways" (MUTCD)  
b. "Standard Highway Signs"  
c. "Standard Alphabets for Highway Signs"
5. Borders and messages shall conform to details as shown on the plans and as specified in the MUTCD.
6. Sign mounting brackets, aluminum angle, fixtures, fasteners and all necessary hardware, and equipment, tools, labor, materials and other incidentals for installation, will not be paid for separately but shall be considered incidental to street name sign installation.
7. Number of Swing Sign Brackets required per Sign Panel:  
3 Brackets - Panel length 7' or less  
4 Brackets - Panel length greater than 7' with a maximum length of 9'-6"
8. Diacritical marks for Street Name are not authorized.

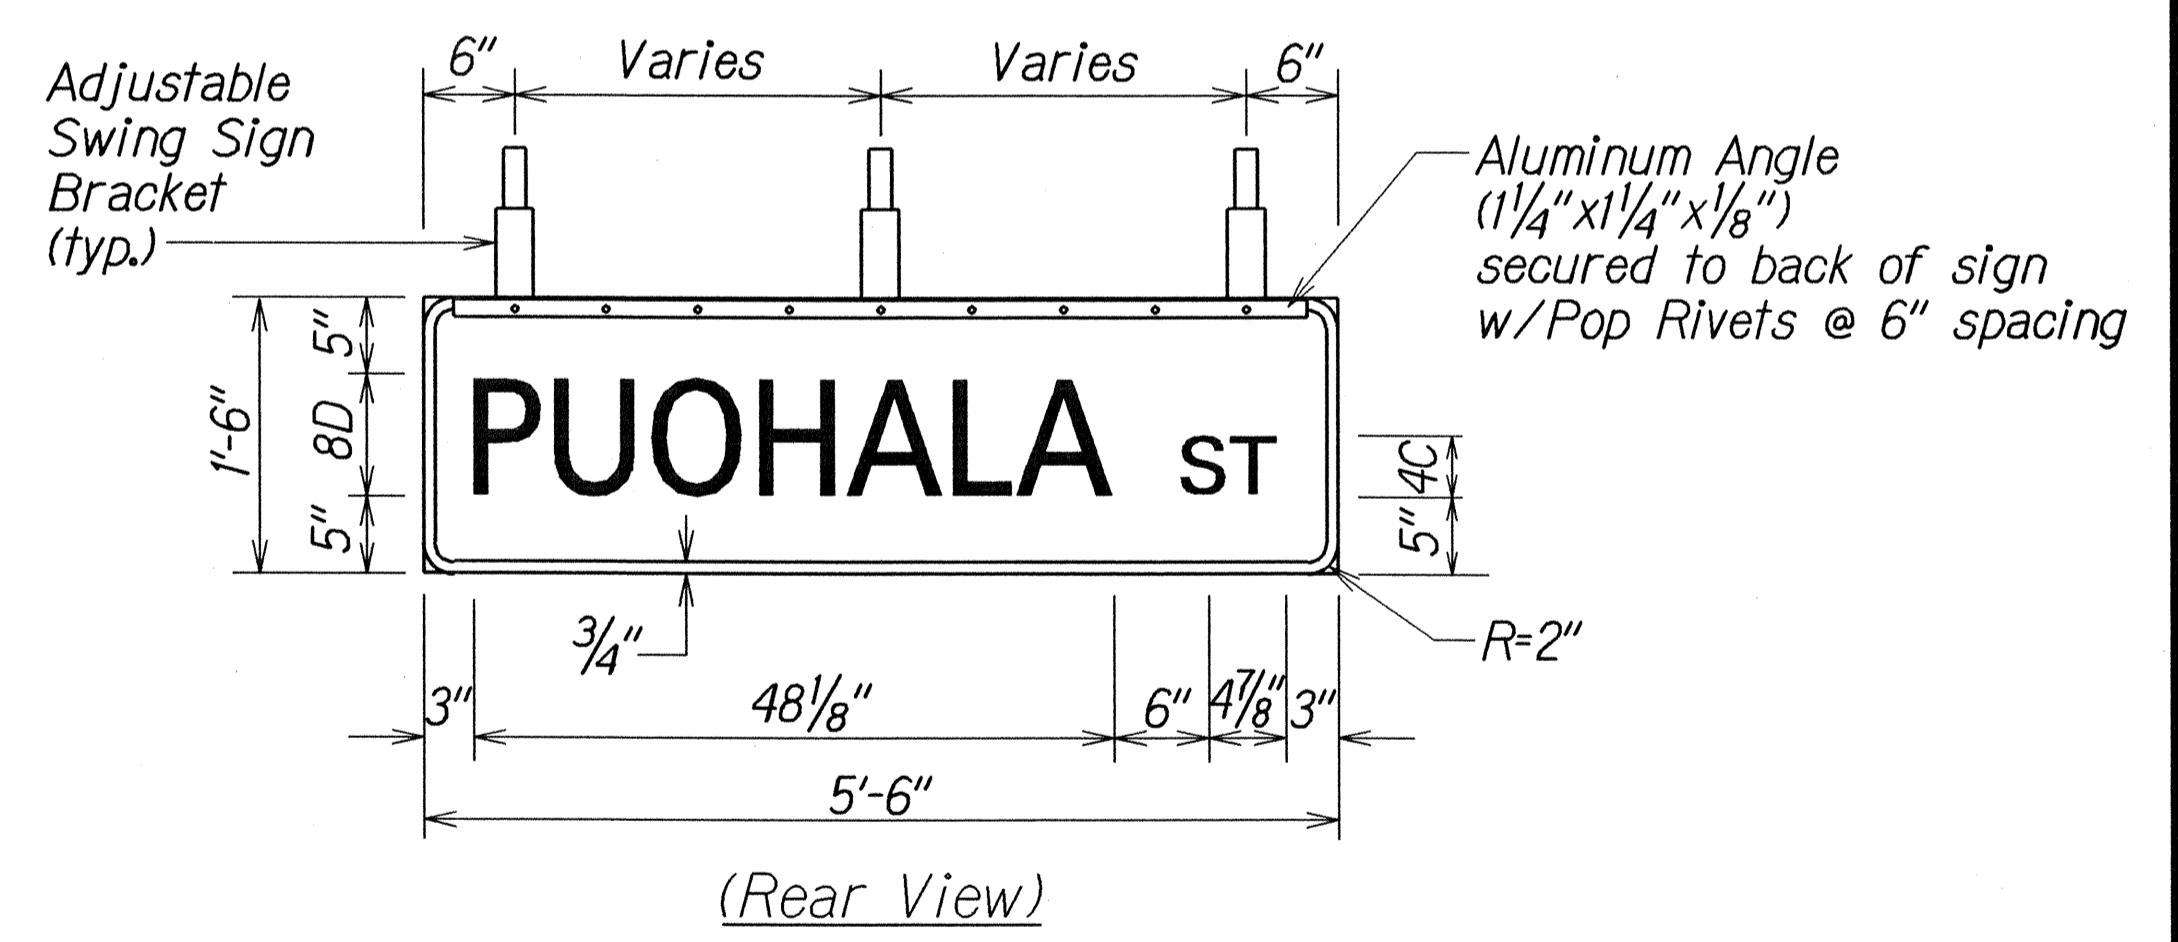

**PANEL & SWING BRACKET LAYOUT FOR STREET NAME SIGN**

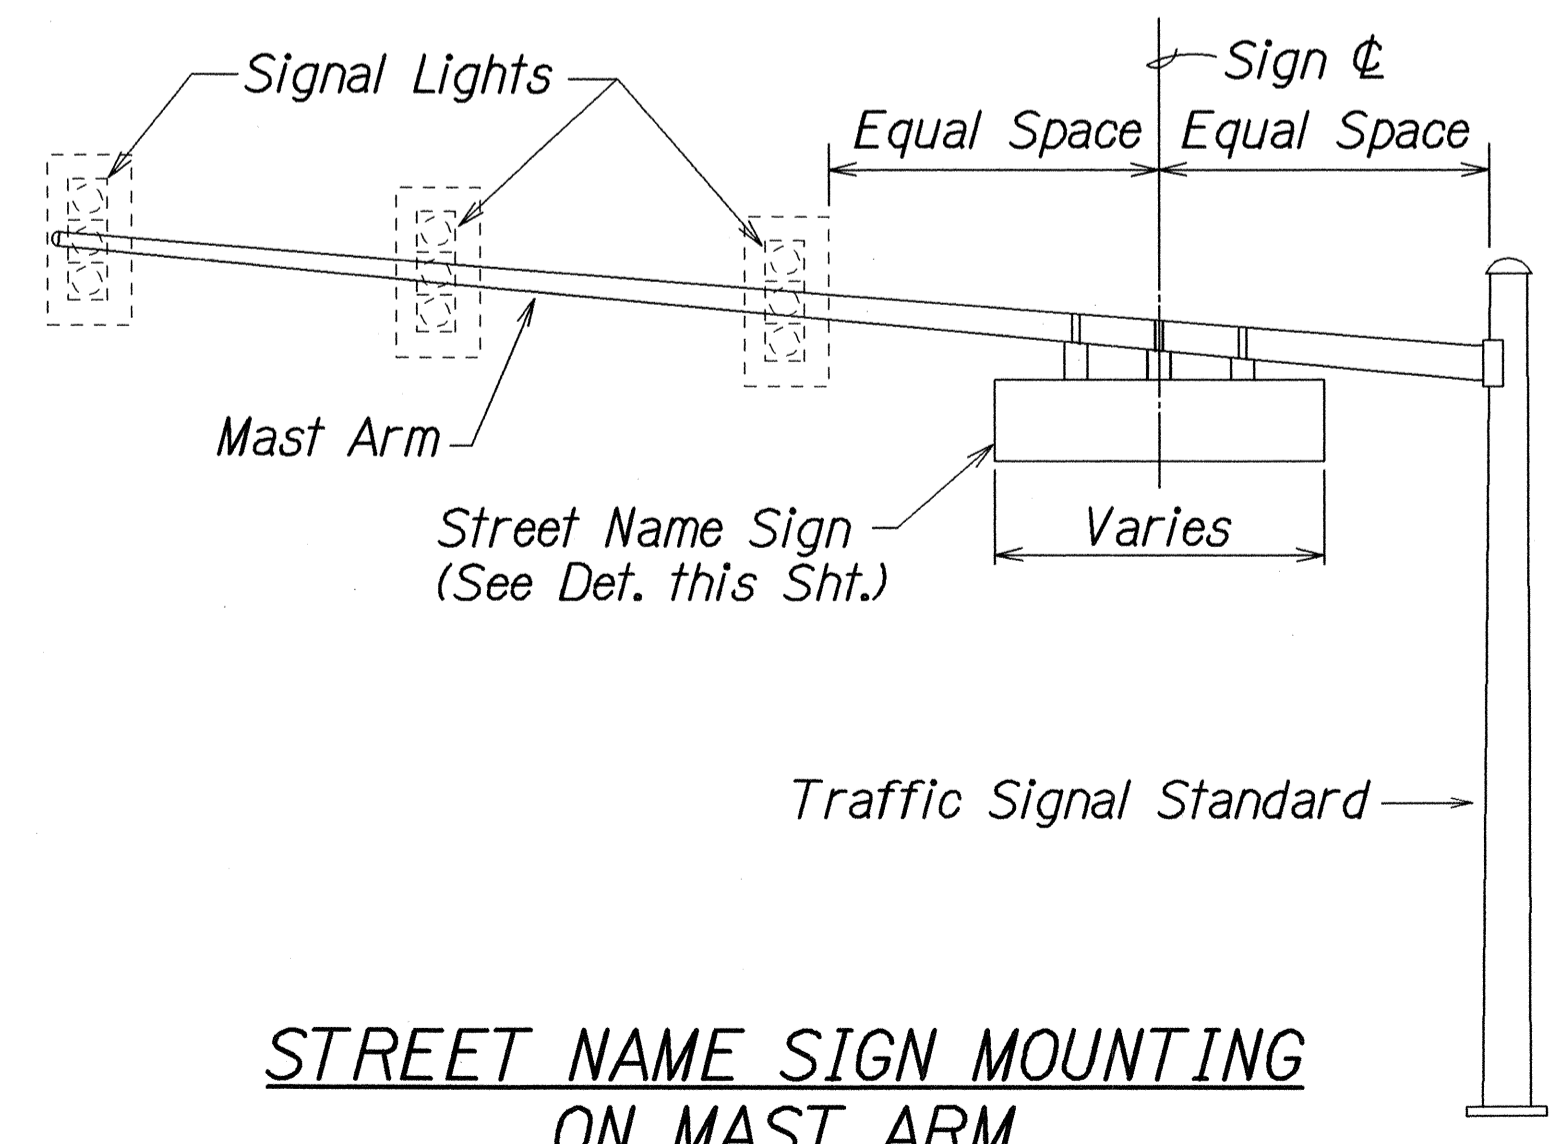

**STREET NAME SIGN MOUNTING ON MAST ARM**

Note: Dimensions may vary slightly.

ORIGINAL PLANS  
 DESIGNED BY  
 CHECKED BY  
 DATE  
 TRACED BY  
 QUANTITIES BY  
 No.

STATE OF HAWAII  
 DEPARTMENT OF TRANSPORTATION  
 HIGHWAYS DIVISION  
**SIGN MOUNTING DETAIL**  
 KANEHOE BAY DRIVE IMPROVEMENTS  
 Vicinity of Puohala St. to Kawa Bridge  
 F.A. Project No. STP-065-1(9)  
 Not to Scale Date: Jan. 2002  
 SHEET No. 74 OF 4 SHEETS

FED. ROAD DIST. NO.	STATE	FED. AID PROJ. NO.	FISCAL YEAR	SHEET NO.	TOTAL SHEETS
HAWAII	HAW.	STP-065-1(9)	2003	91	114

TRAFFIC SIGNAL NOTES

- The locations of the Traffic Signal Standards, Traffic Signal Standards w/Mast Arms, Pedestrian Push Buttons, Traffic Controller, Pullboxes, Conduits and Loop Detectors shall be staked out in the field by the Contractor and approval of the locations shall be obtained from the Engineer prior to construction and installation.
- All splicing shall be done in the pullboxes.
- Furnishing and installing the conduit stubouts (pullboxes to edge of pavement) will not be paid for separately but shall be considered incidental to the various contract items.
- A solid #8 bare copper wire shall be pulled with the traffic signal control cable for equipment ground. Cost shall be incidental to the installation of the control cable.
- All Traffic signal controller equipment shall be completely wired in the cabinet and shall control the traffic signals as called for in the plans.
- The loop amplifier units furnished for this project shall be capable of operating the loop detector configurations shown on the plans. Cost for the loop amplifier shall be incidental to the installation of the loop detector.
- Should any defect be encountered during the warranty period, the manufacturer will be notified and he shall promptly correct such defect. Service call (by factory qualified representative) during the warranty period for repairs or other maintenance shall be answered within 24 hours and shall be done at no expense to the State. All repairs shall be done as soon as possible.
- All traffic signal work shall conform to the requirements of the "Manual On Uniform Traffic Control Devices For Streets And Highways", Federal Highway Administration (1988) and Amendments.
- Locations of traffic markings and markers (lane lines, Stop lines, crosswalk, etc.) shown on the plans shall be verified with the Engineer prior to the installation of the traffic signal system.
- All Conduits between pullboxes and Traffic Signal/Highway Lighting Standards shall not be paid for separately but shall be considered incidental to the various contract items.
- All Signal-Drop Cables (Type 5 Cables) from the various Types of Traffic Signal Head on the traffic signal standards and mast arms to the pullboxes shall not be paid for separately but considered incidental to the Traffic Signal Head.
- After installing all the traffic signal cables, the Contractor shall duct seal all conduits in the pullboxes, traffic signal standards and traffic signal controller cabinet concrete base. The duct seal material shall be approved by the Traffic Signal Inspector/Engineer and shall not be paid for separately but considered incidental to the direct buried and/or concrete encased conduits.
- After installing the Traffic Signal System, the Contractor shall apply grease to all parts of the Traffic Signal System (i.e. fittings, brackets, nipples, elbows, screws, signal head assemblies, bolts, hinges, etc.) as directed by the Traffic Signal Inspector, to prevent rust and corrosion. The grease material shall be approved by the Signal Inspector, and shall not be paid for separately but considered incidental to the various Traffic Signal Contract items.
- Connecting into existing traffic signal system and making all necessary adjustments shall not be paid for separately, but considered incidental to the various traffic signal contract items.
- The Contractor shall notify the Traffic Signal Branch, Department of Transportation Services, City & County of Honolulu, (phone no. 523-4589) two weeks prior to commencing any work on the traffic signal system.
- The Department of Transportation Services, City & County of Honolulu, will assist the Engineer in construction inspection for the traffic signal system. The Contractor shall notify the Electrical and Maintenance Services Division, Department of Transportation Services, three (3) working days prior to commencing work on the traffic signal system (phone no. 523-4589).

- The concrete jacket for the Conduit By-Pass Details shown on Plan Sheet No. 95, shall not be paid for separately but considered incidental to the various contract items. The Engineer shall determine if a concrete jacket is required.
- Removal and disposal of existing conduit will not be paid for separately but shall be considered incidental to the various Traffic Signal Contract Items.
- Any temporary traffic signal work required for the existing traffic signal system to be operational, shall be considered incidental to the various Traffic Signal Contract items.

TRAFFIC SIGNAL LEGEND

NEW	EXISTING	
—————	-----	Traffic Signal Conduit
△ 1 △ 2 △ 3	△ 1 △ 2 △ 3	Conduit Run Numbers
(A) (B) (C)	(A) (B) (C)	Equipment description, installation or item no.
Ⓜ	Ⓜ	Traffic Signal Master Controller Door Indicates Front of Cabinet
ⓐ	ⓐ	Traffic Signal Controller Door Indicates Front of Cabinet
ⓐⓐ	ⓐⓐ	Meter Pedestal
←	←	12" RYG Traffic Signal Head
←	←	12" RY↑ Traffic Signal Head
←↑	←↑	12" RY← Traffic Signal Head
←↑	←↑	12" RY← Traffic Signal Head (Programmed Visibility)
←←↑	←←↑	12" RYG ← ₆ Fiber Optic Traffic Signal Head
←	←	Type I Standard and Attached Signals
← ^{24'}	← ^{24'}	Type II Standard with Signal Mast Arm and Attached Signals (Nos. indicates mast arm length & distance between signal heads as specified on plans)
← ^{8'}	← ^{8'}	Type III Standard with Luminaire and Signal Mast Arm and Attached Signals (Nos. indicates mast arm lengths & distance between signal heads as specified on plans)
← ^Y	← ^Y	Flashing Beacon, One Signal Section, "Y" indicates 12" Yellow Lens
←⊗	←⊗	Opticom Receiver (Arrow indicates direction detector faces)
•	•	Pipe Guard
Ⓜ	Ⓜ	Pedestrian Signal Head
□	□ _{tspt}	Type A Pullbox
⊗	⊗ _{tspt}	Type B Pullbox
⊗	⊗ _{tspt}	Type C Pullbox
□	□	Loop Detectors

HIGHWAY LIGHTING LEGEND

NEW	EXISTING	
— HL —	----- HL -----	Highway Lighting Conduit
■	□ _{HL}	Type A Pullbox (Hwy. Ltg.)
●	○	Highway Lighting Standard

ORIGINAL PLAN	DATE
REVISION	
DESIGNED BY	
CHECKED BY	
DATE	

R4-1-97

STATE OF HAWAII  
DEPARTMENT OF TRANSPORTATION  
HIGHWAYS DIVISION

**TRAFFIC SIGNAL LEGEND  
AND NOTES**


**KANEQHE BAY DRIVE IMPROVEMENTS  
Vicinity of Puohala St. to Kawa Bridge  
F.A. Project No. STP-065-1(9)**

Date: Jan. 2002


SHEET No. **TSI** OF 7 SHEETS



FED. ROAD DIST. NO.	STATE	FED. AID PROJ. NO.	FISCAL YEAR	SHEET NO.	TOTAL SHEETS
HAWAII	HAW.	STP-065-1(9)	2003	93	114

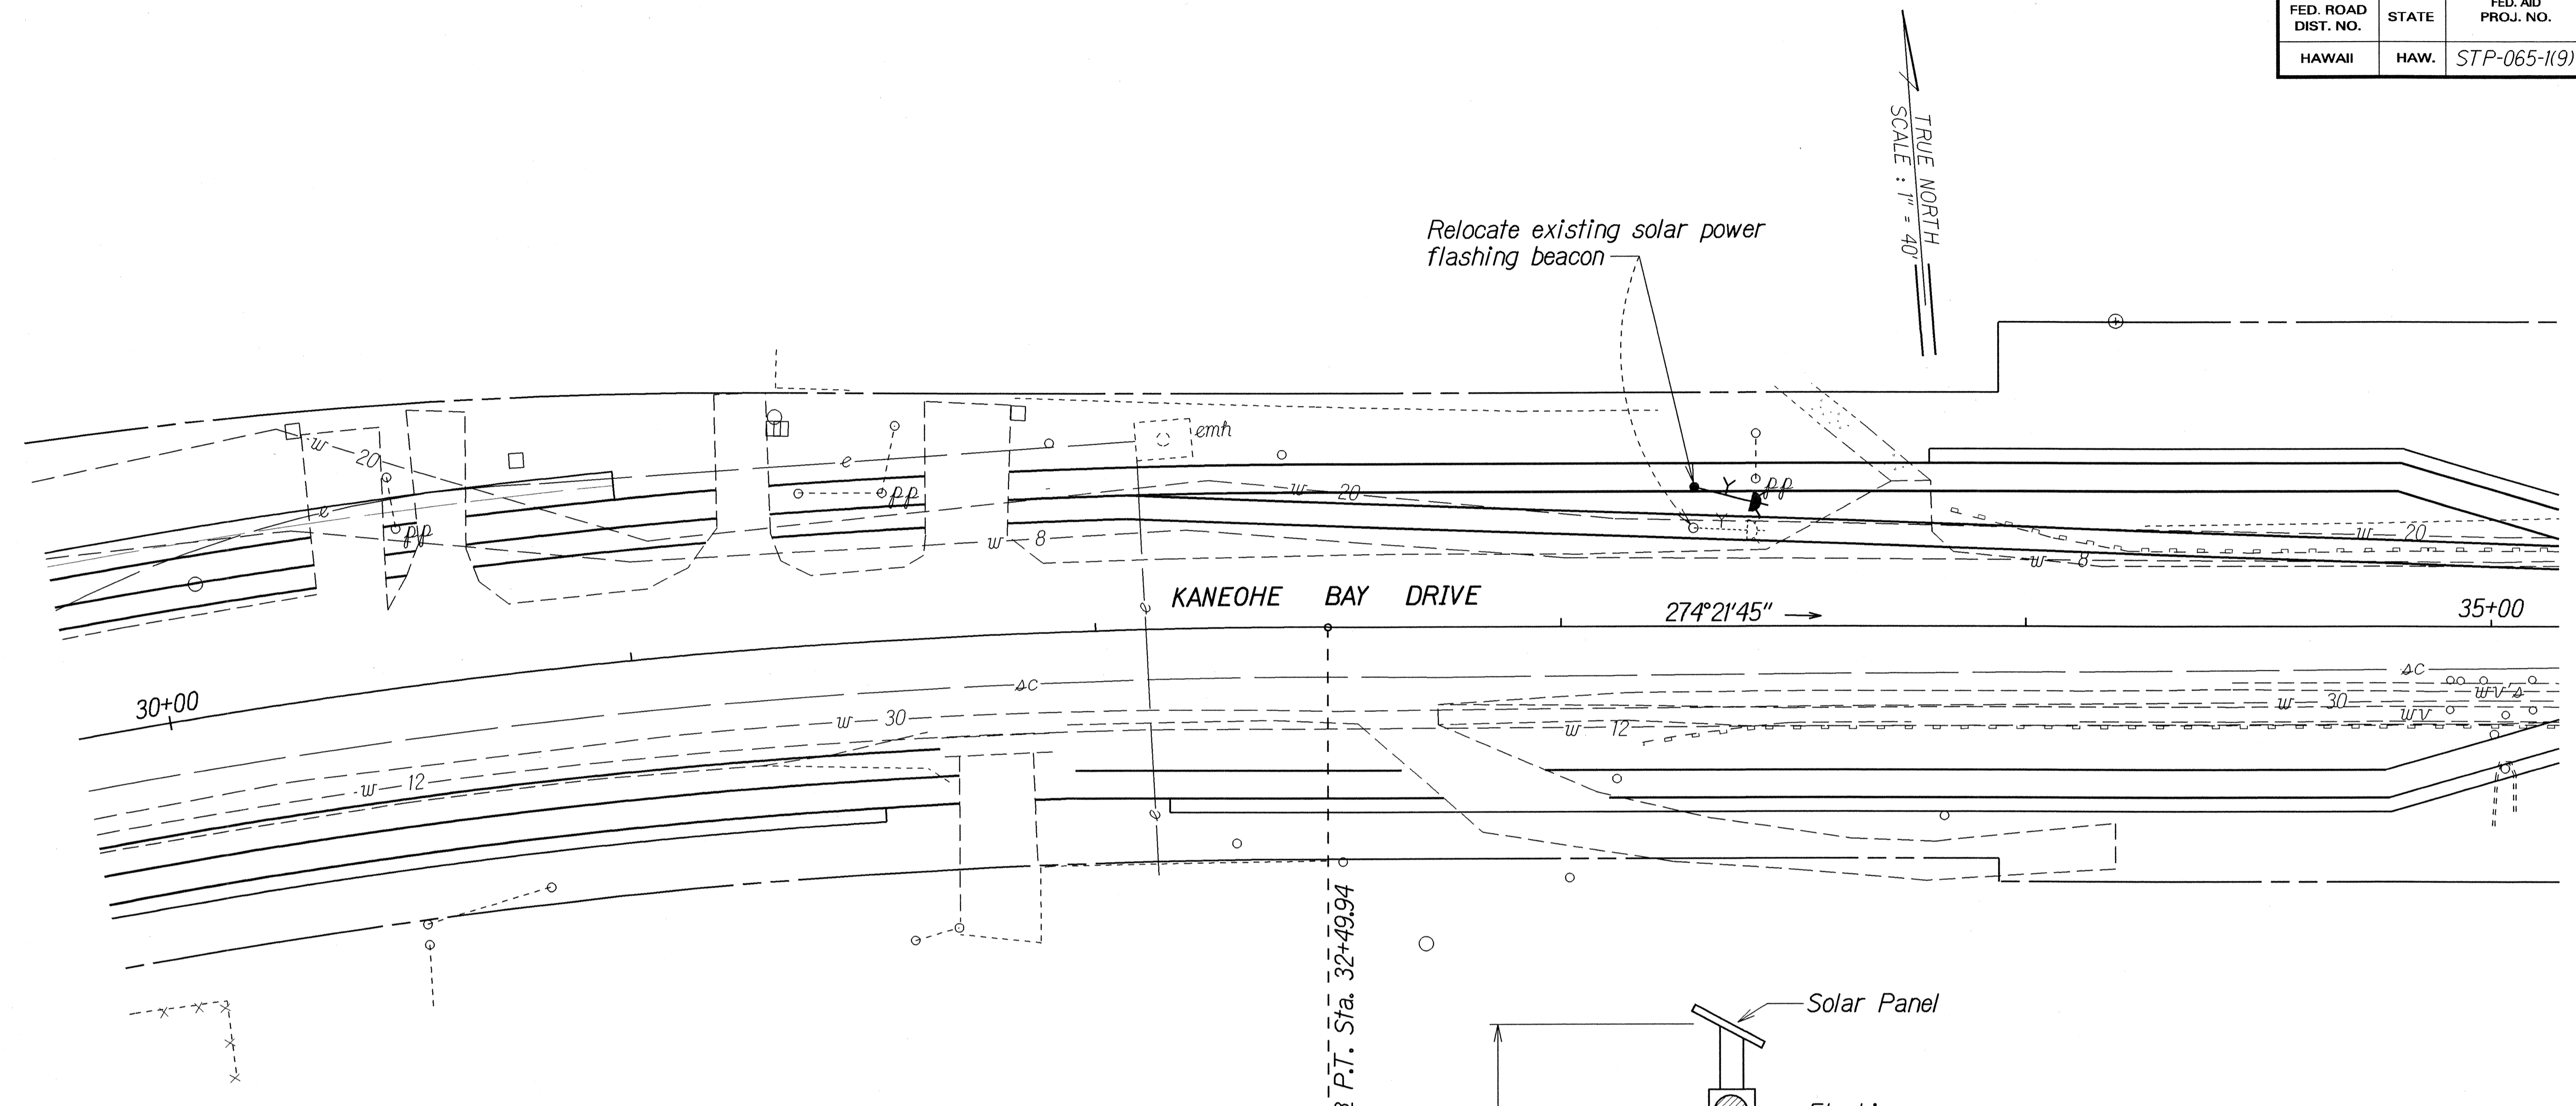

± P.T. Sta. 32+49.94

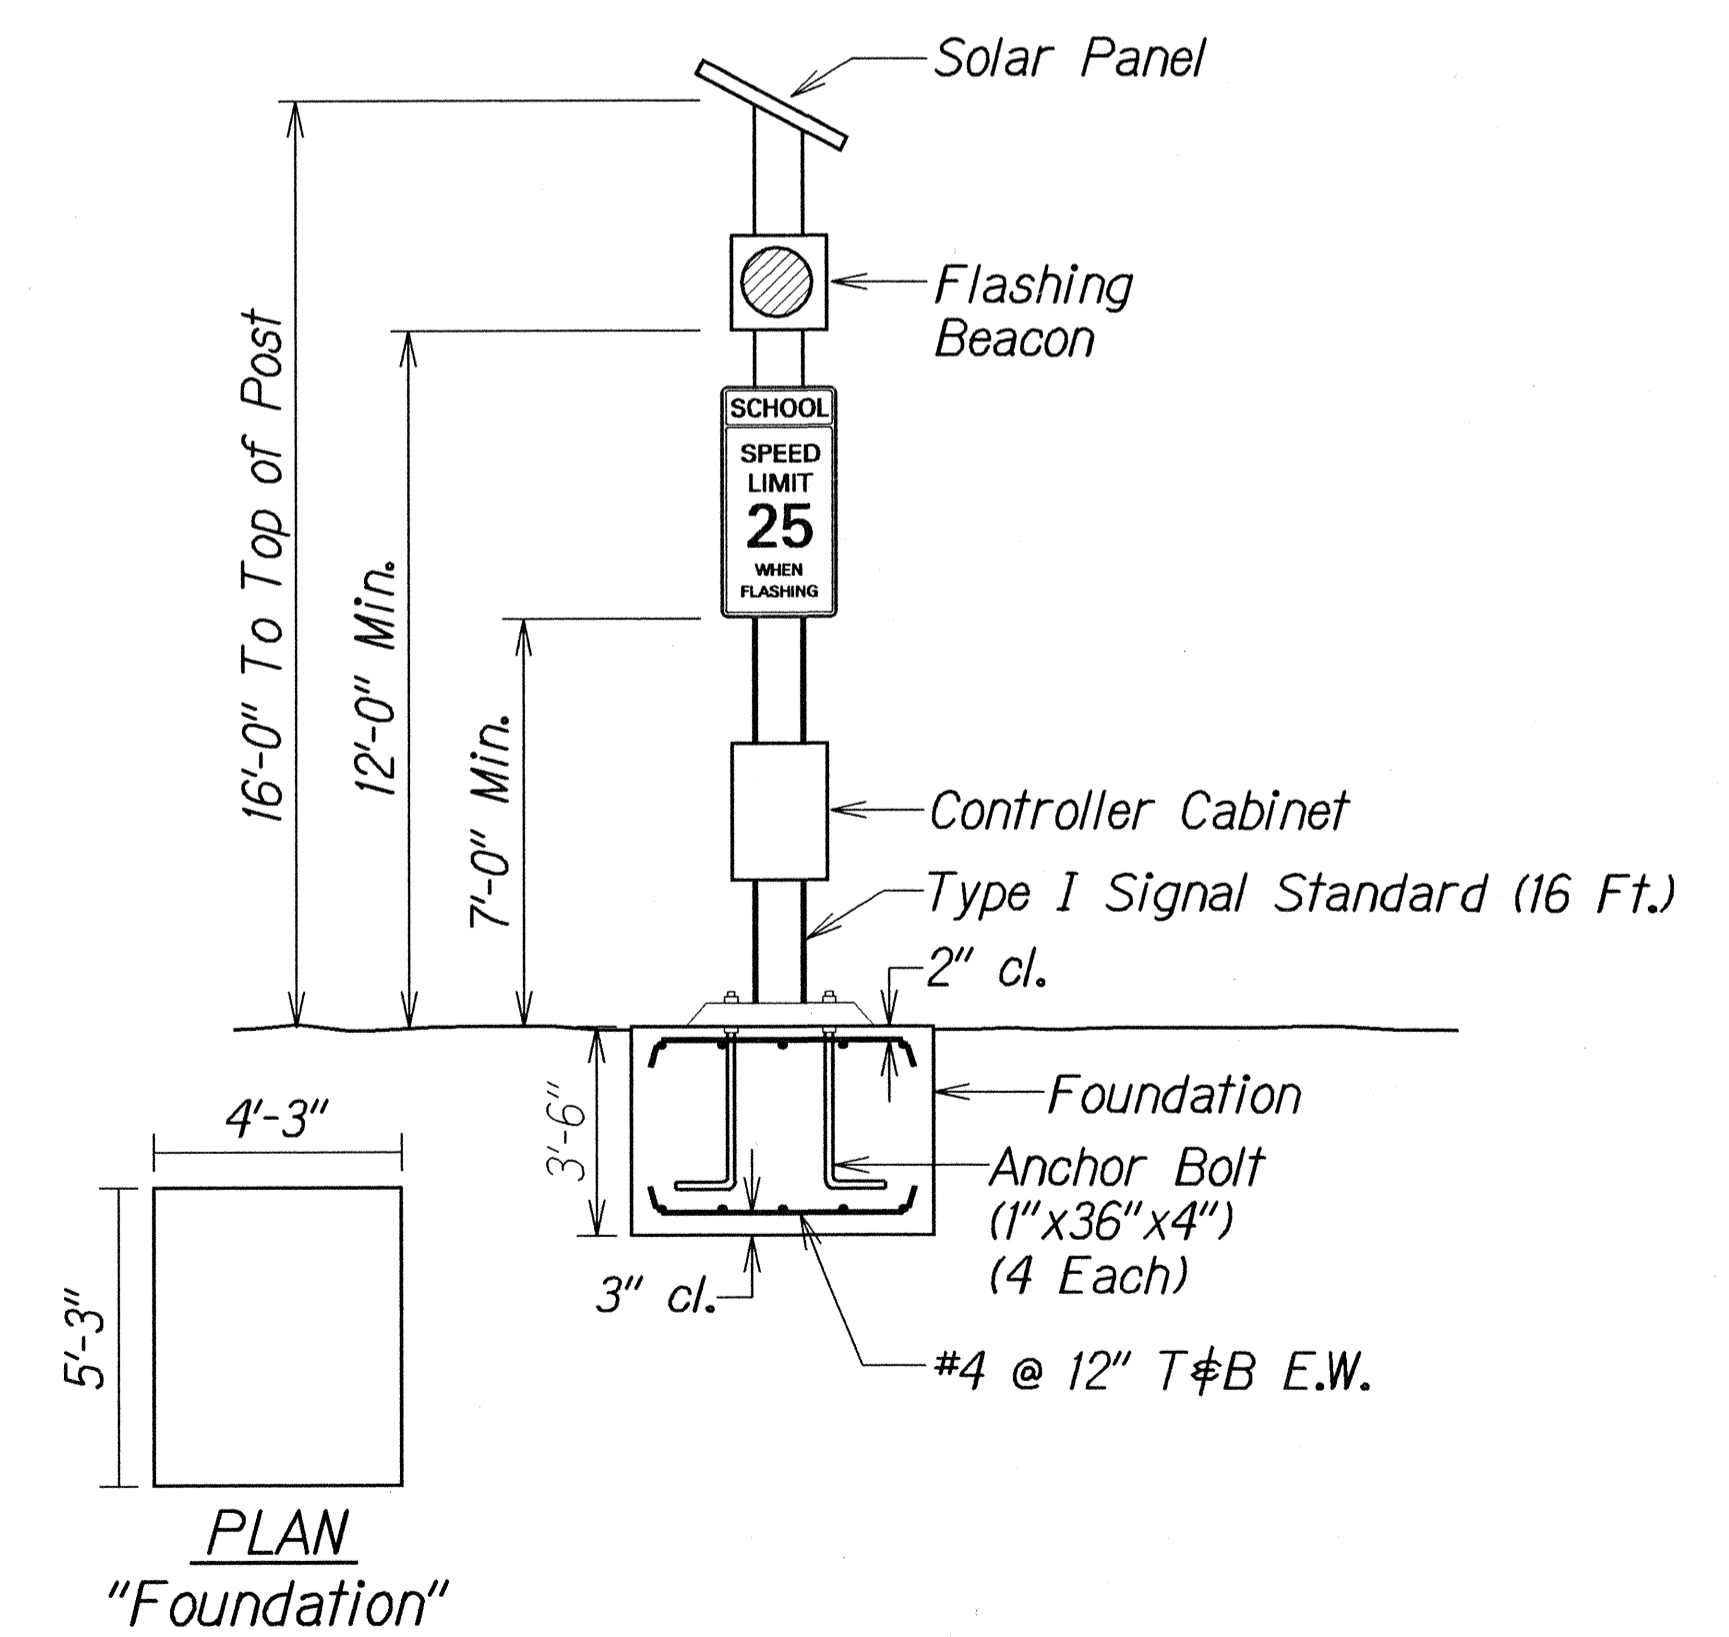

PLAN  
"Foundation"

**SOLAR POWERED SIGNAL  
ON POLE**  
Not to Scale


CHECKED BY: _____ DATE: 2/17/02  
 DRAWN BY: L. THOMAS  
 DESIGNED BY: H. ALLEN  
 QUANTITIES BY: _____  
 CHECKED BY: _____  
 ORIGINAL PLAN NO. 41801152


STATE OF HAWAII  
 DEPARTMENT OF TRANSPORTATION  
 HIGHWAYS DIVISION  
**TRAFFIC SIGNAL PLAN**  
 KANEOHE BAY DRIVE IMPROVEMENTS  
 Vicinity of Puohala St. to Kawa Bridge  
 F.A. Project No. STP-065-1(9)  
 Scale: 1" = 20' Date: Jan. 2002



FED. ROAD DIST. NO.	STATE	FED. AID PROJ. NO.	FISCAL YEAR	SHEET NO.	TOTAL SHEETS
HAWAII	HAW.	STP-065-1(9)	2003	95	114


**STATE RIGHT-OF-WAY BACKFILL NOTES**

 Trench Backfill Material "A"  
Beach Sand, Earth, or Earth and Gravel. If Earth and Gravel used, the maximum shall contain not more than 50% by volume of rock particles. Maximum 8" loose fill per lift. Obtain 95% compaction for each lift.

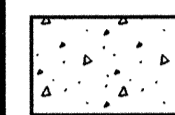 Concrete  
3000 psi compressive strength @ 3 days.


NOTE: Base Course & Sub-Base Course per 1994 State Standard Specifications for Highway Construction.

Sawcut through and remove all existing material bound by asphalt or portland cement

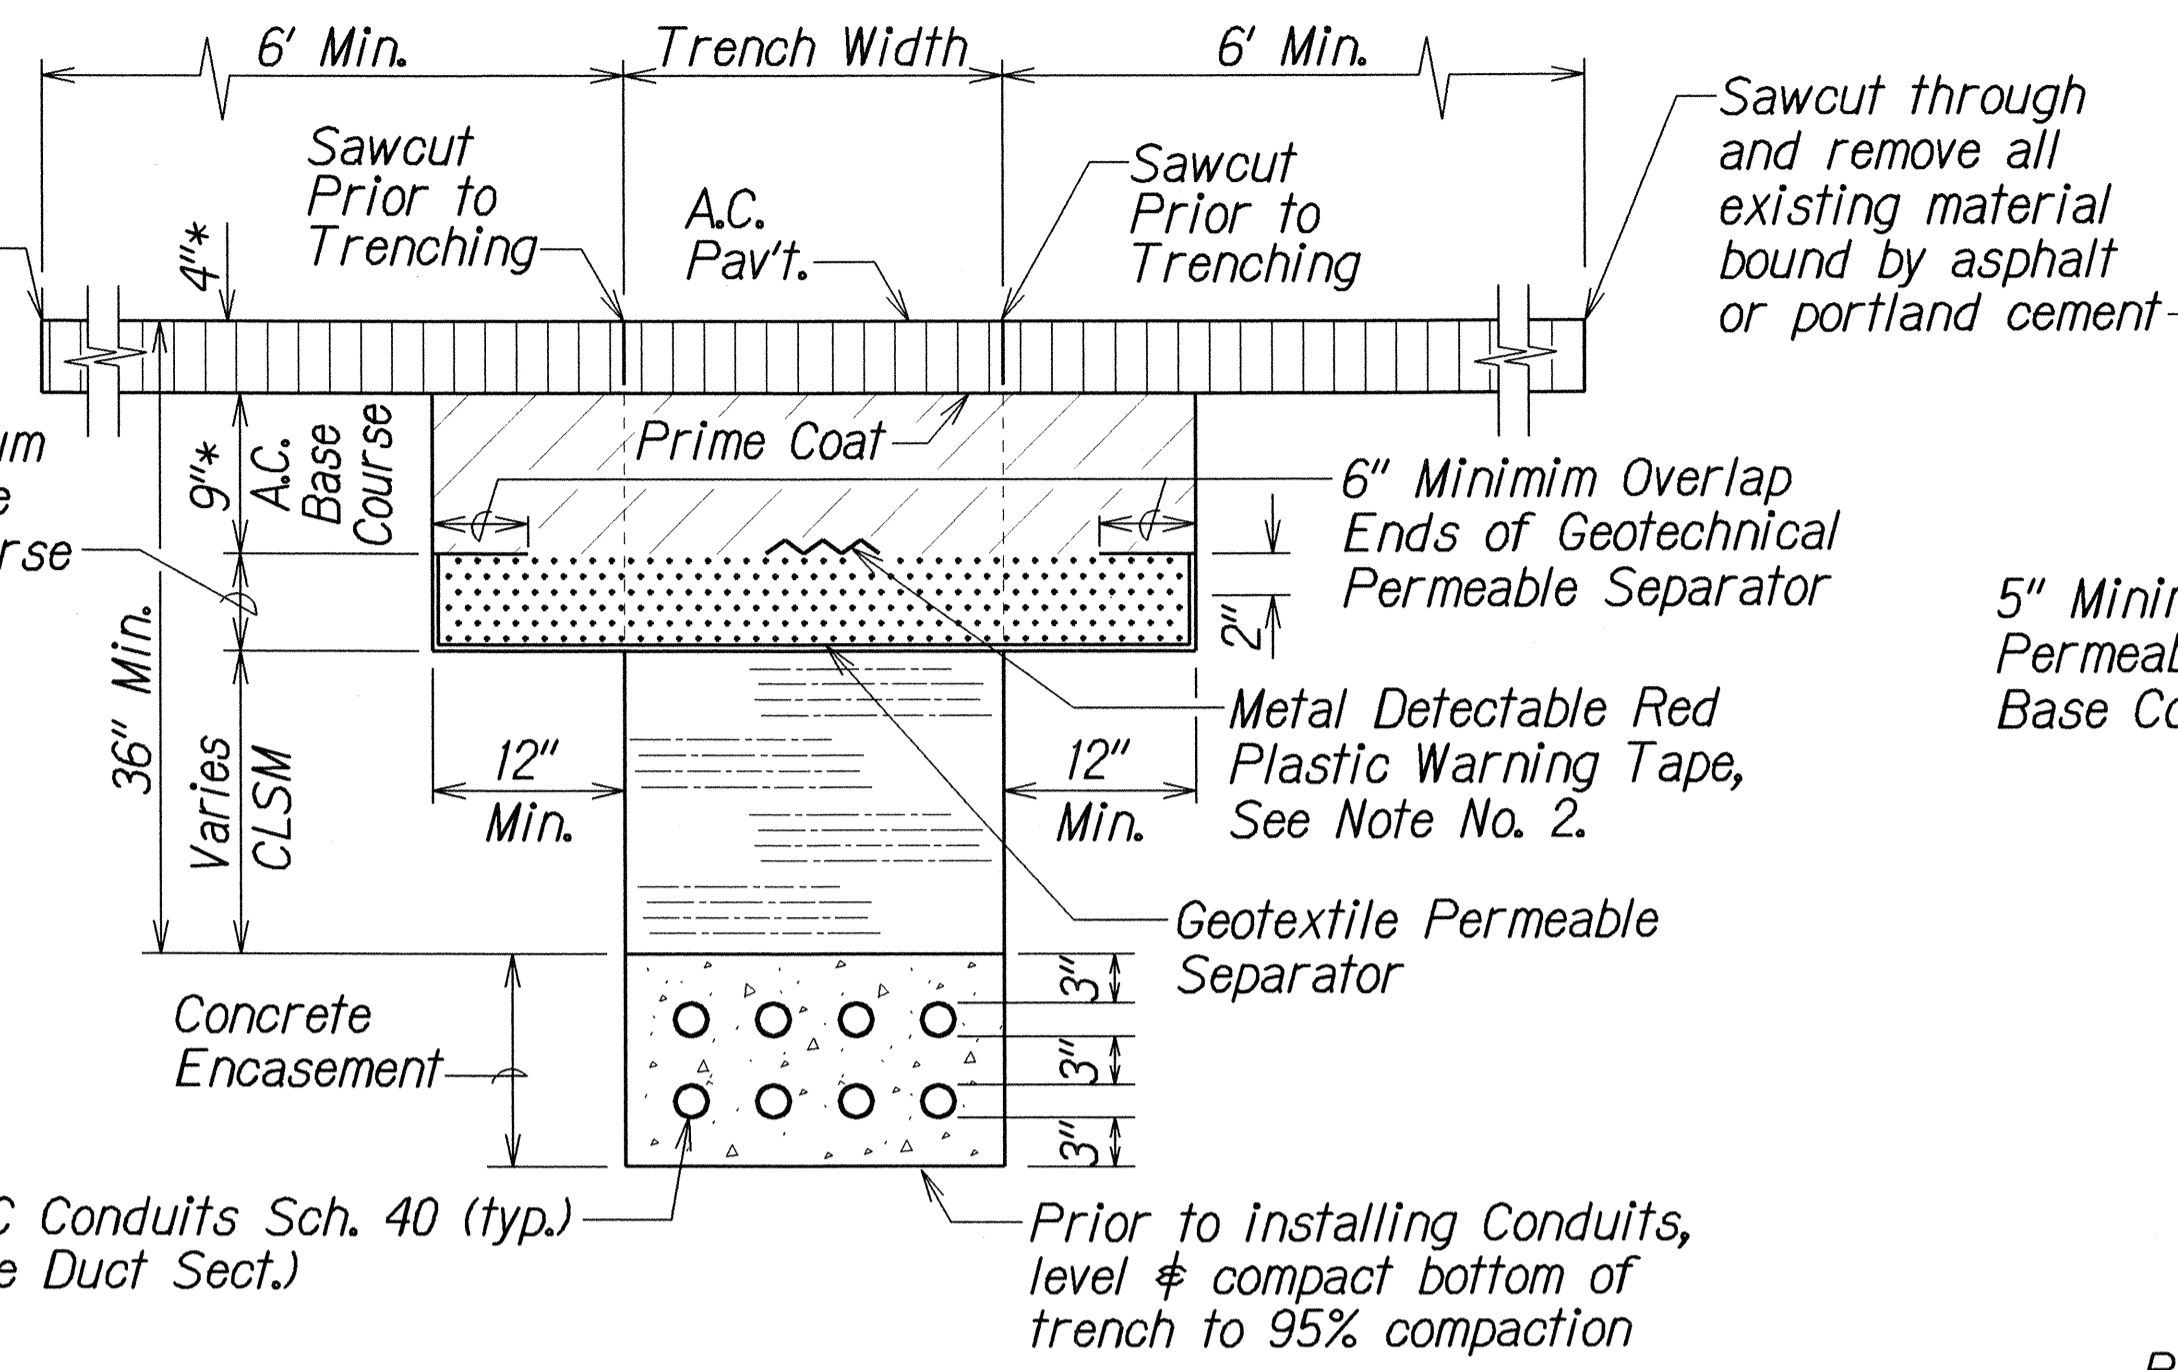

① TYPICAL BACKFILL SECTION WITH CONCRETE ENCASED DUCTS


Sawcut through and remove all existing material bound by asphalt or portland cement

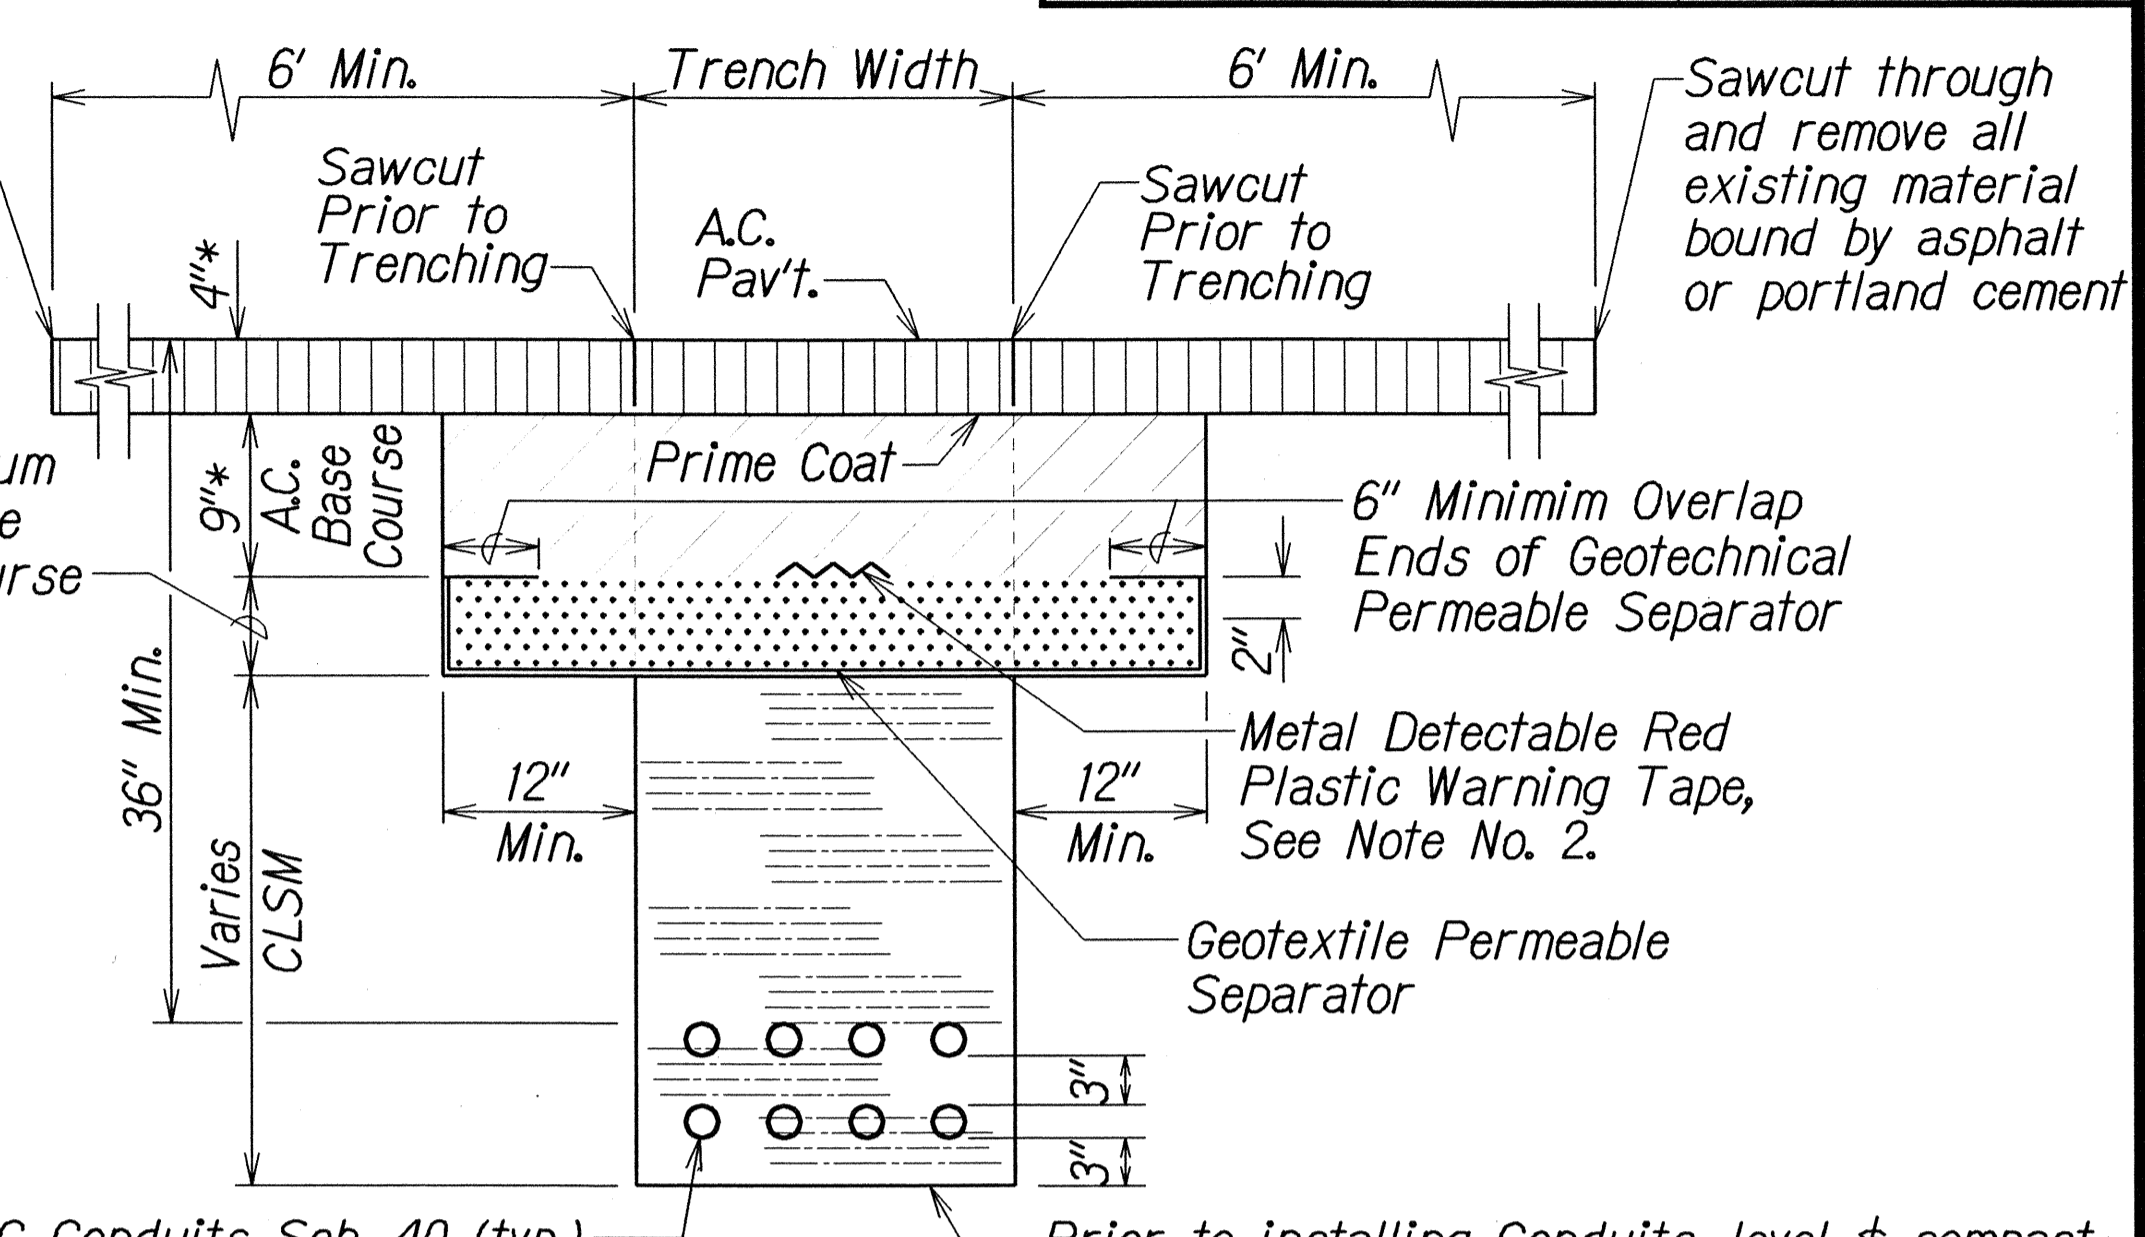

② TYPICAL BACKFILL SECTION DIRECT BURIED DUCTS

**GENERAL NOTES**


- If trench is located on unpaved area, the Contractor shall replace 10" A.C. Base Course and 4" A.C. Pavement with Type "A" backfill material.
- The Metal Detectable Red Plastic Warning Tape shall be a minimum 5 mils thick and 4" wide with a continuous metallic backing and corrosion resistant 1± mil thick foil core. The message on the tape shall read, "CAUTION - STATE TRAFFIC SIGNAL AND/OR HWY LIGHTING BURIED BELOW," utilizing 1½ inches series "C" black lettering. The message will be repeated with a 4¼" spacing between top line of message and start of next repeat.
- The Contractor may begin backfilling the conduit trench when the concrete reaches 3000 psi compressive strength after 3 days.
- Maximum four (4) Conduits per row for multiple conduit duct section.
- For direct buried duct sections, the concrete jacket required at the conduit by-pass for various utilities, shall not be paid for separately but considered incidental to the direct buried conduits.
- After installing all the traffic signal cables, the Contractor shall duct seal all conduits in the pullboxes, traffic signal standards and traffic signal controller cabinet concrete base. The duct seal material shall be approved by the Traffic Signal Inspector/Engineer and shall not be paid for separately but considered incidental to the direct buried and/or concrete encased conduits.

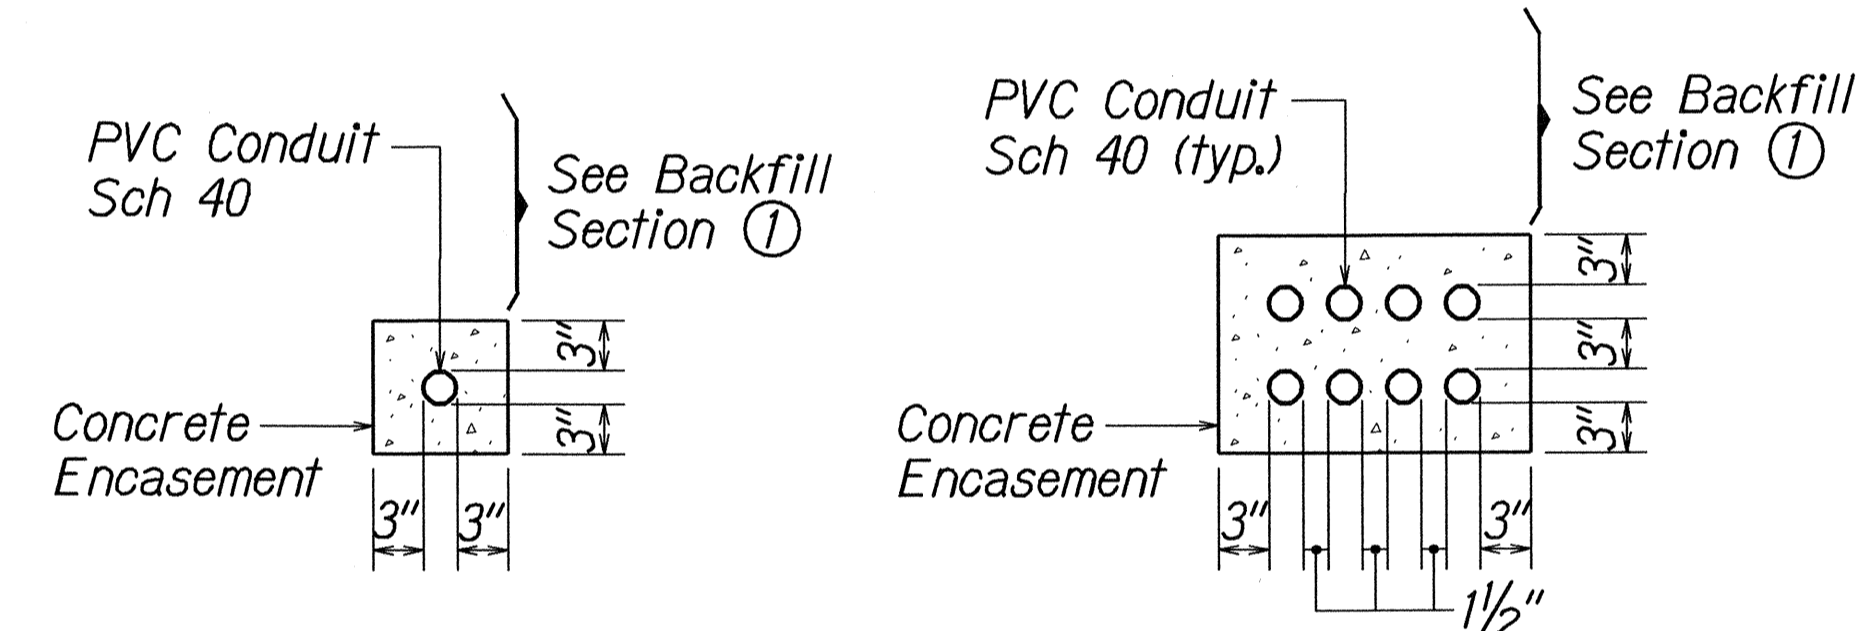


DUCT SECTIONS - CONC. ENCASED

UTILITY	CLEARANCE
Water	** See Note
Sewer	24" Min. or Provide 6" Thick Reinforced Conc. Jacket
Drain	12" Min.
HECO/HTCO/CATV	3" Min.
AT & T	12" Min.

**At the electrical/signal ductline water crossing, install all electrical/signal ductline elevations to maintain 6" vertical clear separation from all waterlines (12" clear for all electrical/signal ductline structures larger than 16") at no cost to the Board of Water Supply.

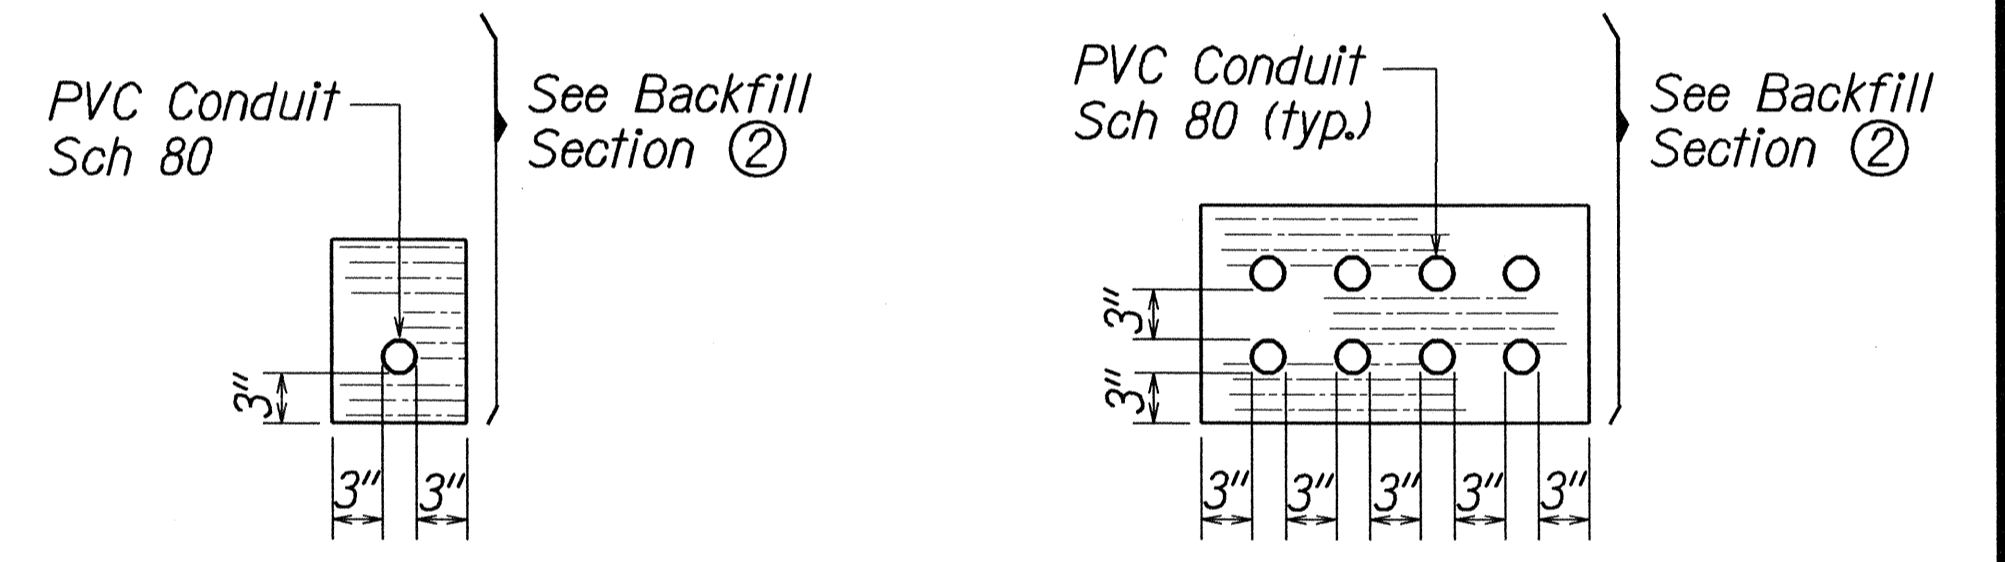


DUCT SECTIONS - DIRECT BURIED

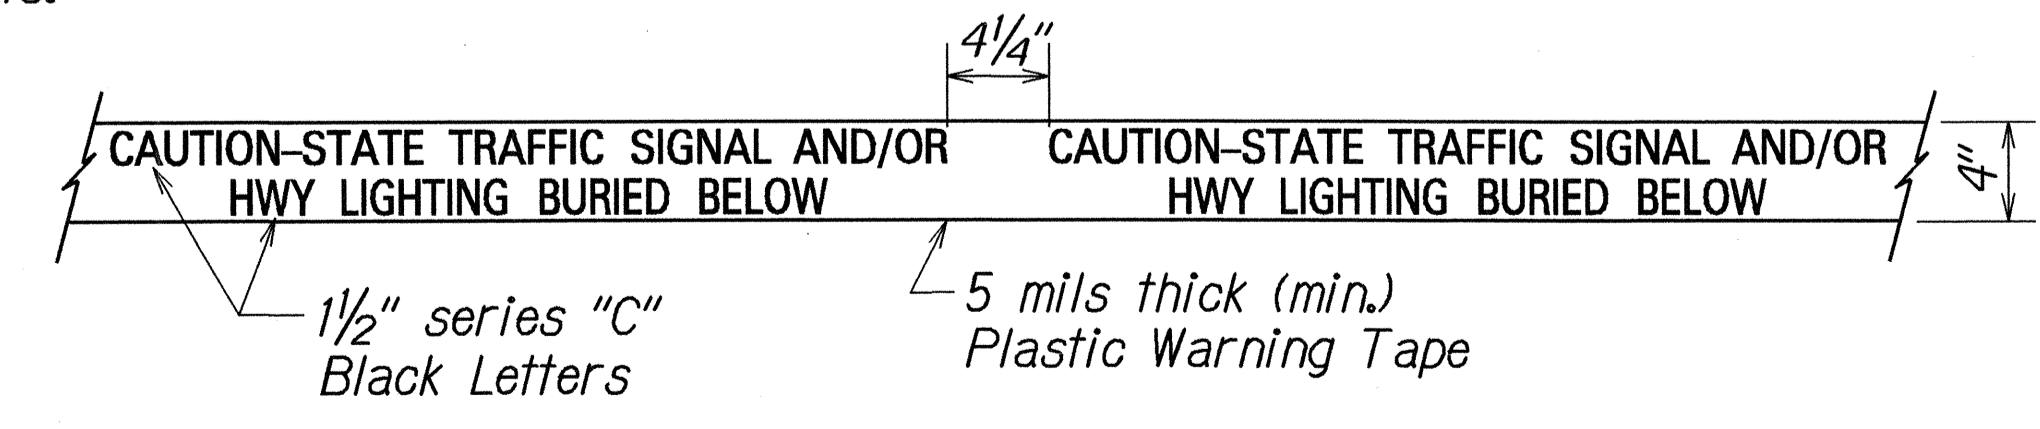

METAL DETECTABLE RED PLASTIC WARNING TAPE

For additional information see note no. 2.

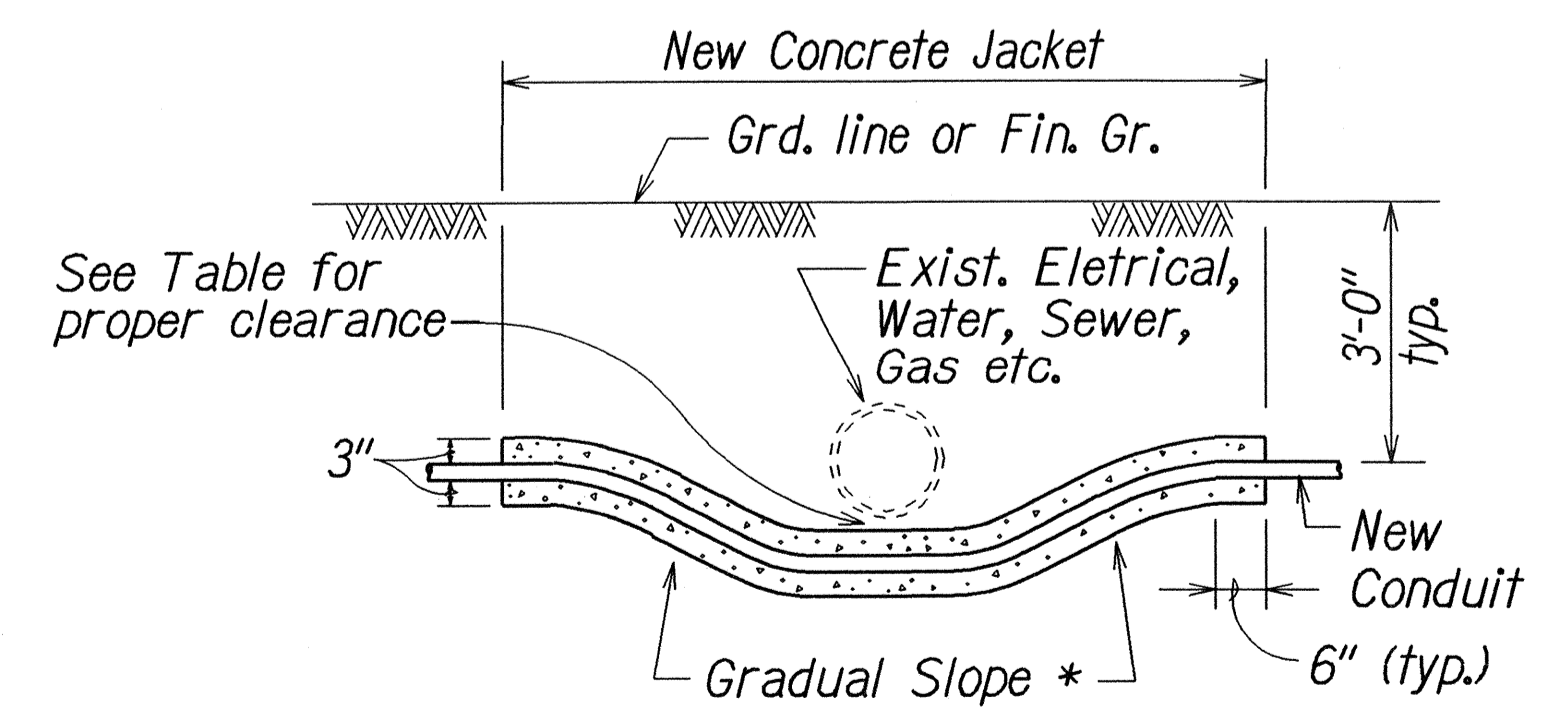

CONDUIT BY-PASS DETAIL AT VARIOUS UTILITIES

* To be determined by County Electrical Inspector/Engineer

Not to Scale

ORIGINAL PLAN  
 DESIGNED BY  
 CHECKED BY  
 DATE  
 2/27/03

STATE OF HAWAII  
DEPARTMENT OF TRANSPORTATION  
HIGHWAYS DIVISION

**TRAFFIC SIGNAL DETAILS**

KANEOHE BAY DRIVE IMPROVEMENTS  
Vicinity of Puohala St. to Kawa Bridge  
F.A. Project No. STP-065-1(9)




Not to Scale Date: Jan. 2002

SHEET No. TS5 OF 7 SHEETS




FED. ROAD DIST. NO.	STATE	FED. AID PROJ. NO.	FISCAL YEAR	SHEET NO.	TOTAL SHEETS
HAWAII	HAW.	STP-065-(9)	2003	96	114

**GENERAL NOTES**




1. Provide a minimum of one 16  $\phi$  x 2.5m Copperweld Ground Rod in each pullbox. When directed by the Traffic Signal Inspector/Engineer, install additional Ground Rods. Cost of Ground Rods shall be incidental to the pullboxes.
2. All pre-cast concrete pullboxes shall be manufactured in two pieces.
3. The pullbox with cover shall be capable of supporting an MS 18 Loading.
4. The maximum weight of the pullbox cover shall not exceed 27 kilograms.
5. The openings for the conduits on all pullboxes shall be pre-cast concrete knockouts.
6. After installing the conduits in the openings of the pullboxes, the Contractor shall fill the excess opening in the pre-cast knockouts with concrete mortar.
7. Prior to installing the pullboxes, the Contractor shall level the bottom of the trench and achieve a minimum of 95% relative compaction of the bottom of the trench.
8. All concrete shall be Class A (21 MPa (3,000 psi), min.)
9. Rebars shall be Grade 300 and all lapped splices shall be 360mm minimum.
10. The #57 or #67 size aggregate shall conform to latest version of AASHTO M43 (ASTM D 448).
11. Type "C" Pullbox shall be installed in a location protected from vehicular traffic (i.e. raised sidewalk, behind A.C. curbs, traffic signal standard or pipe guards).

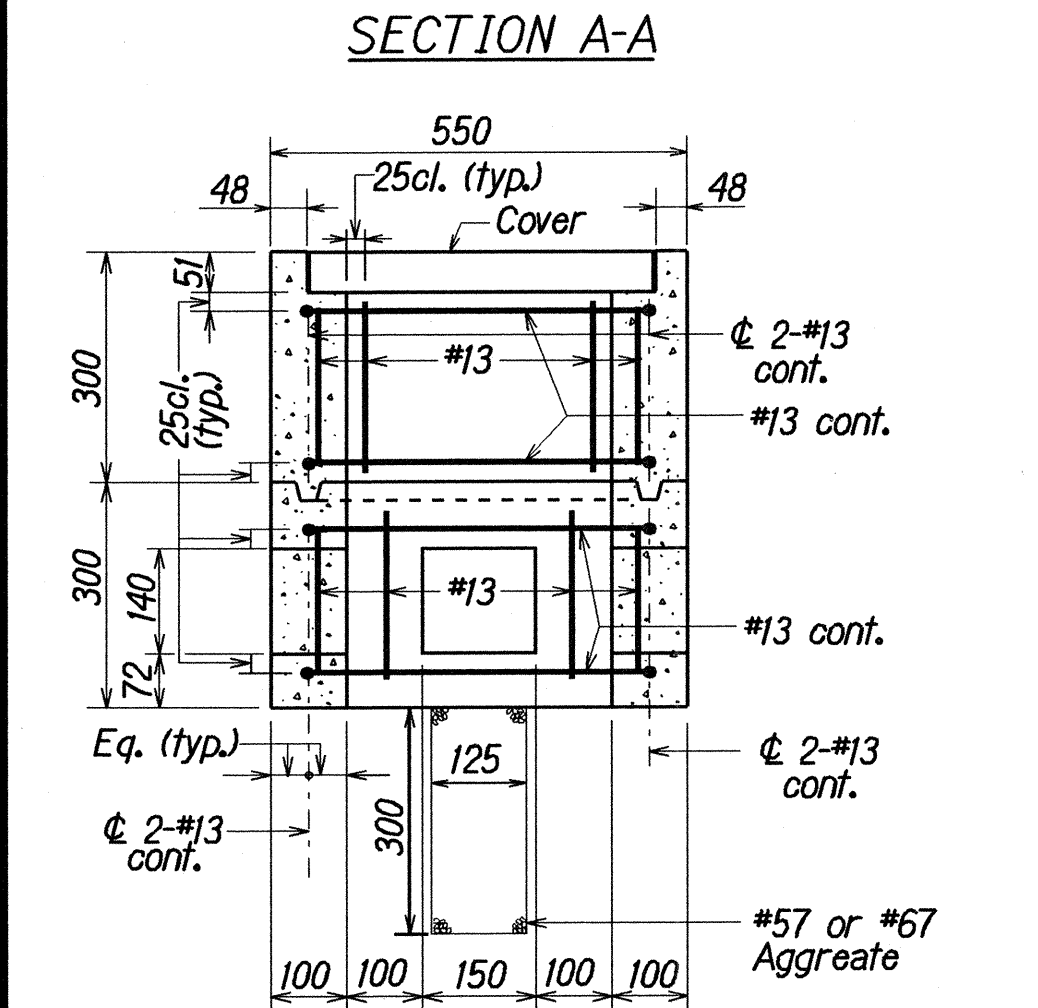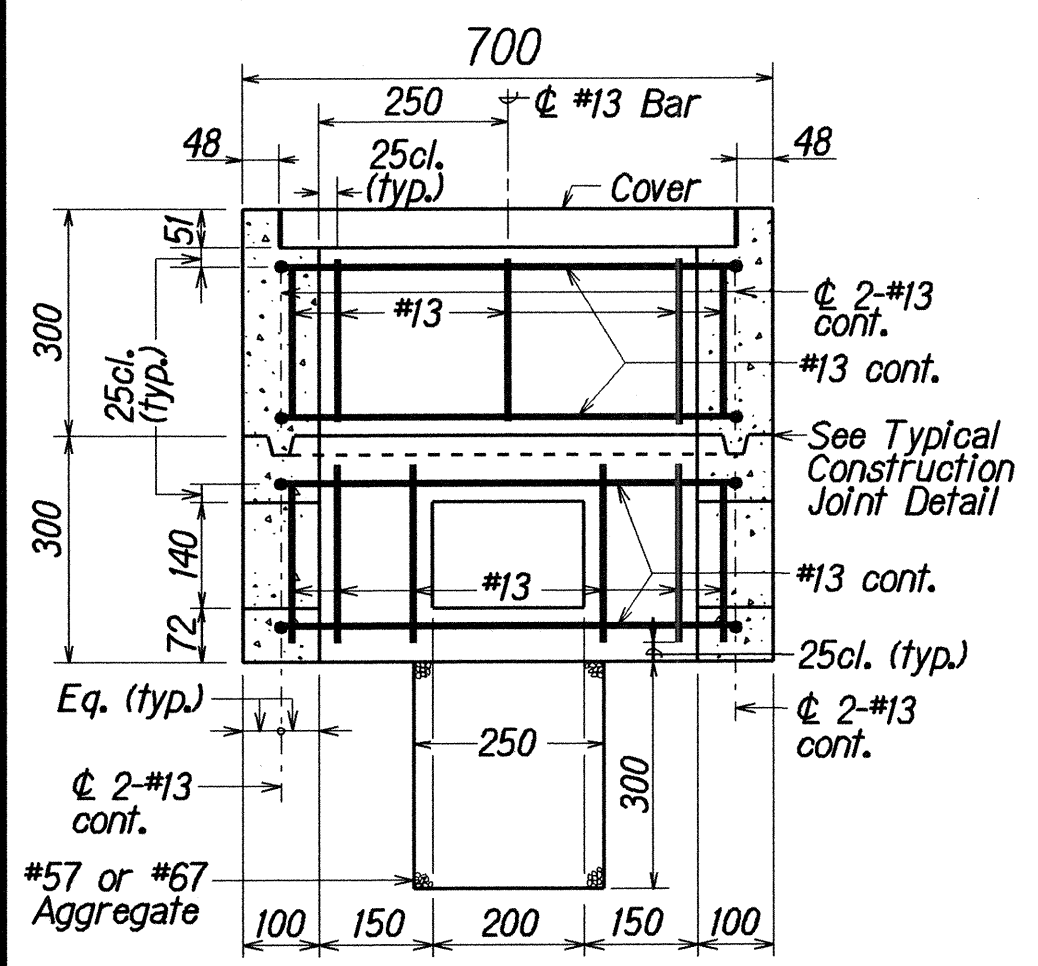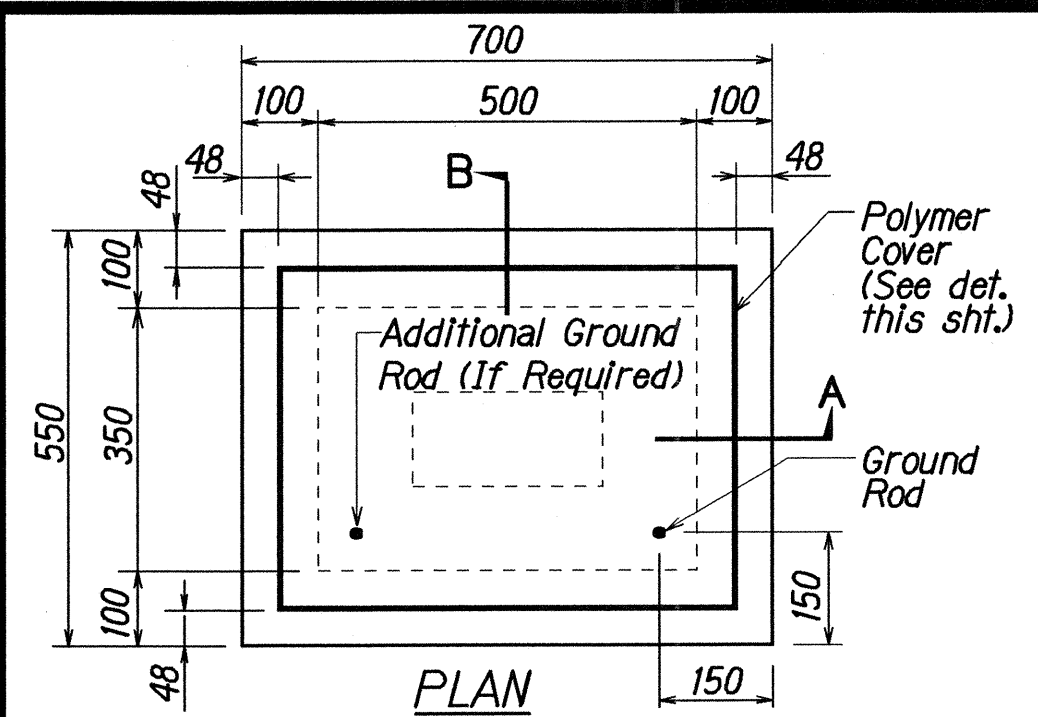


**SECTION A-A**  
**SECTION B-B**  
**TYPE "A" PULLBOX**  
*(Old Type "B")*  
Scale: 1:10

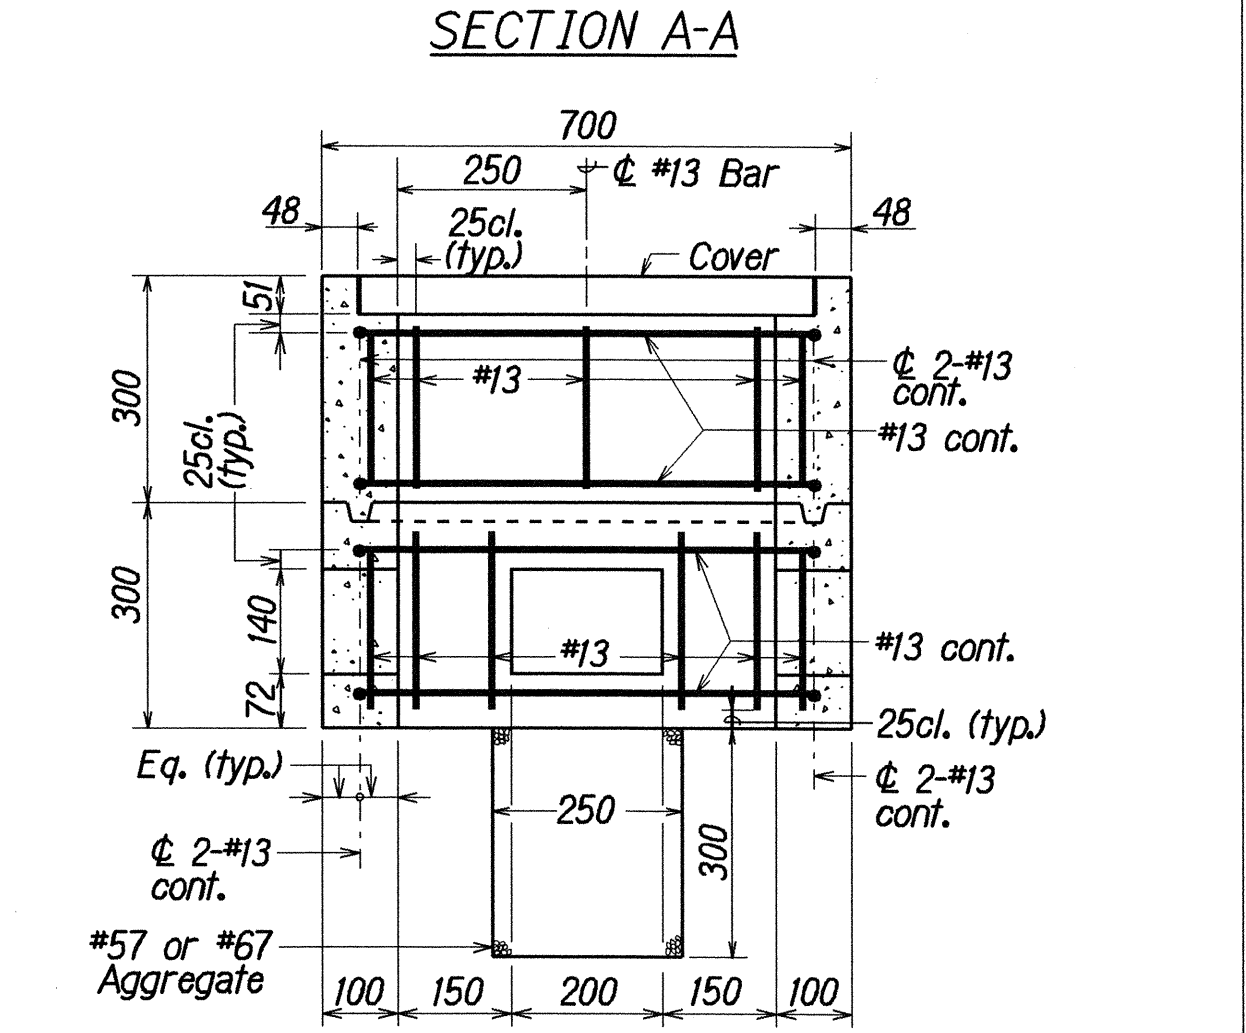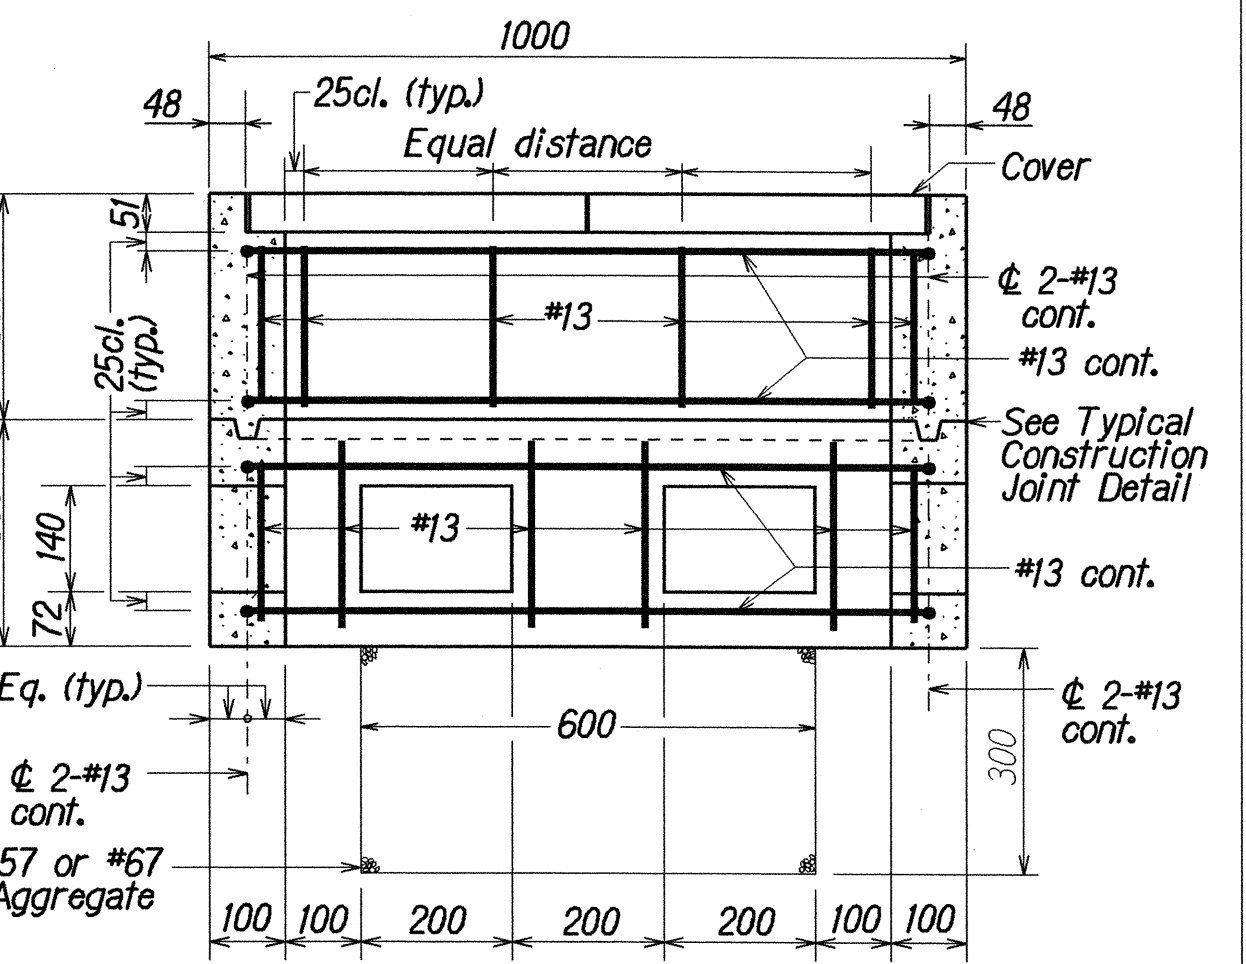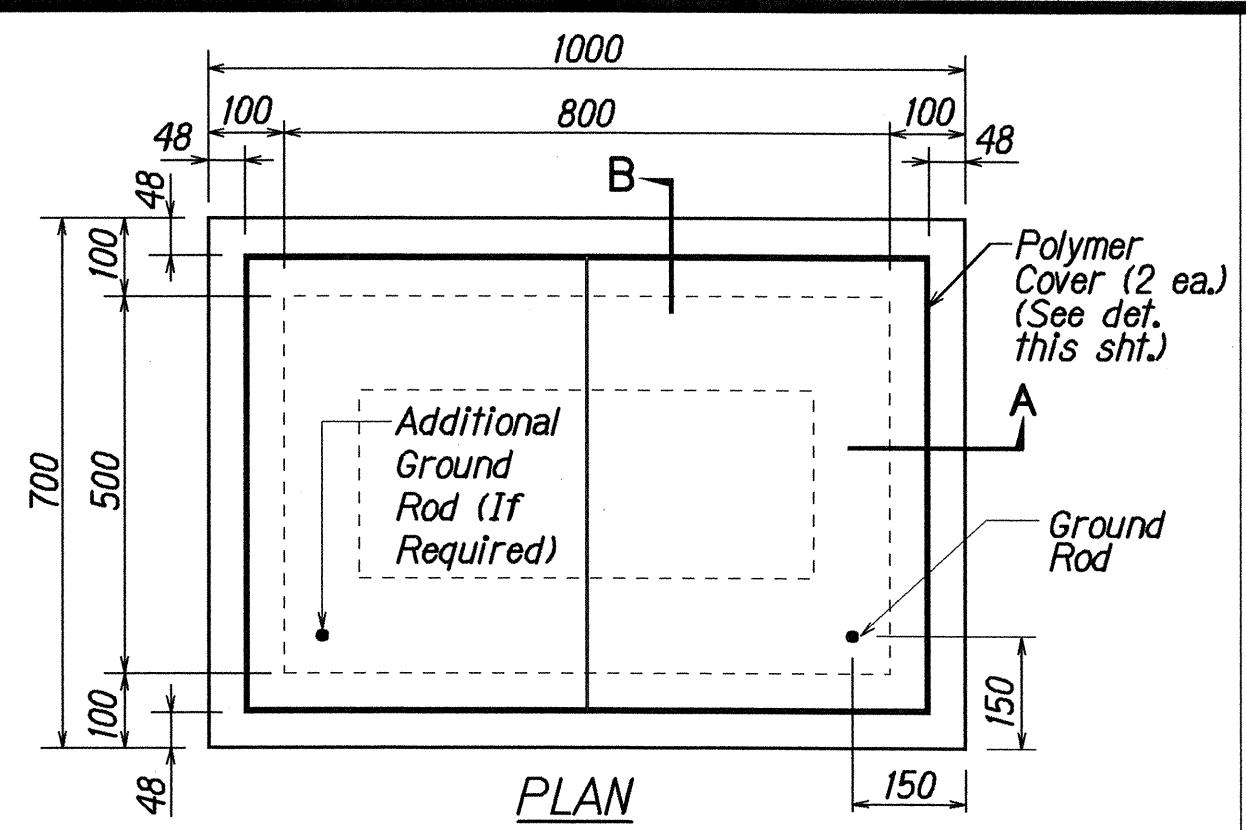


**SECTION A-A**  
**SECTION B-B**  
**TYPE "B" PULLBOX (Old Type "C")**  
Scale: 1:10

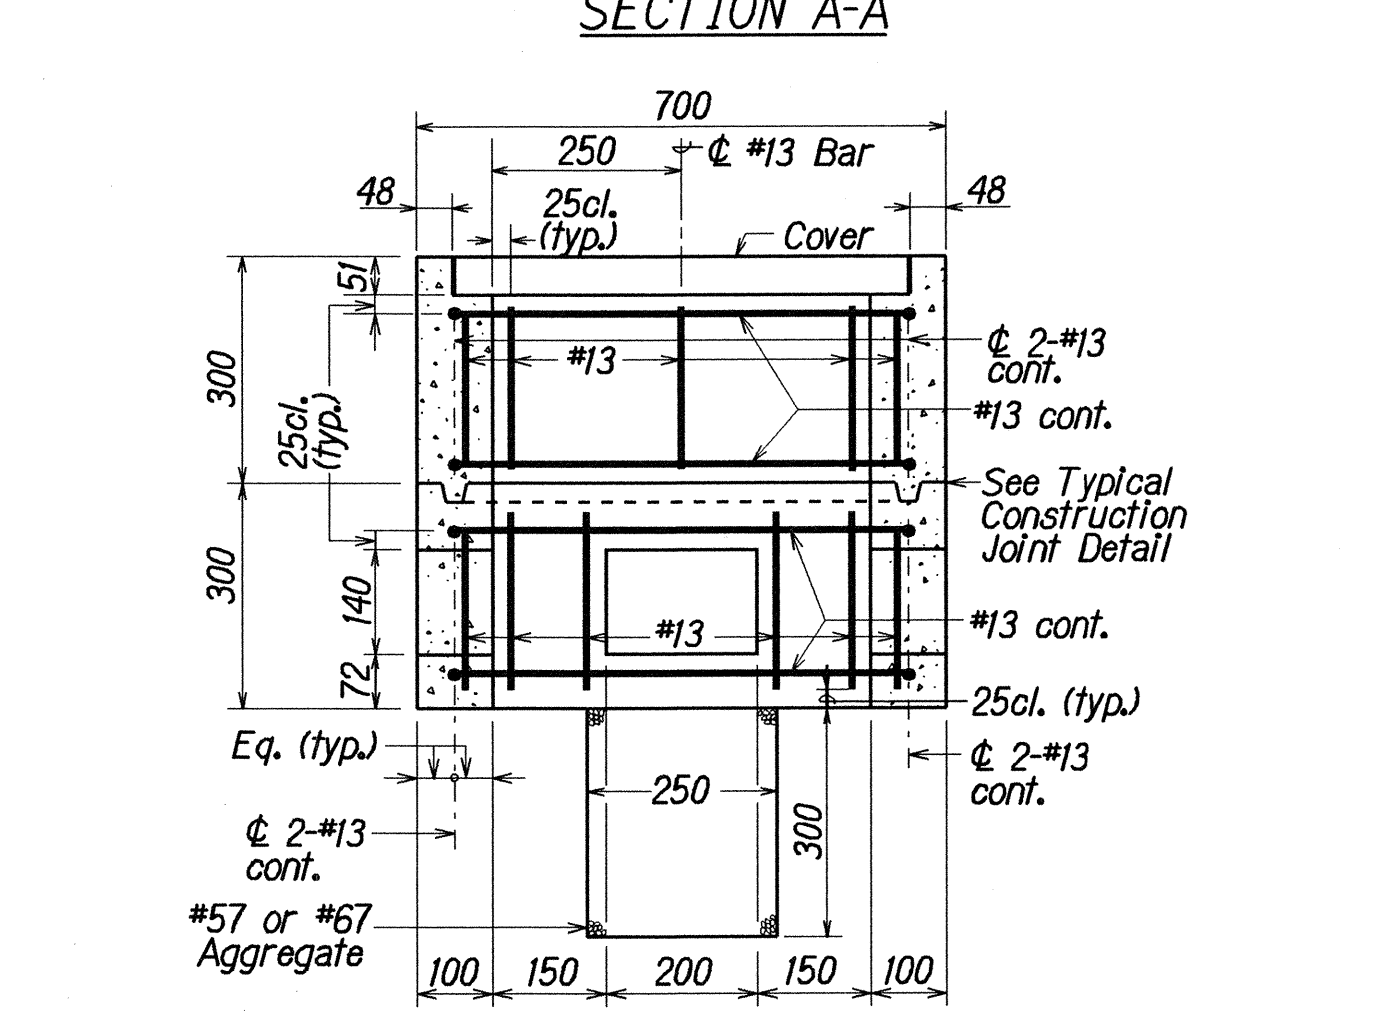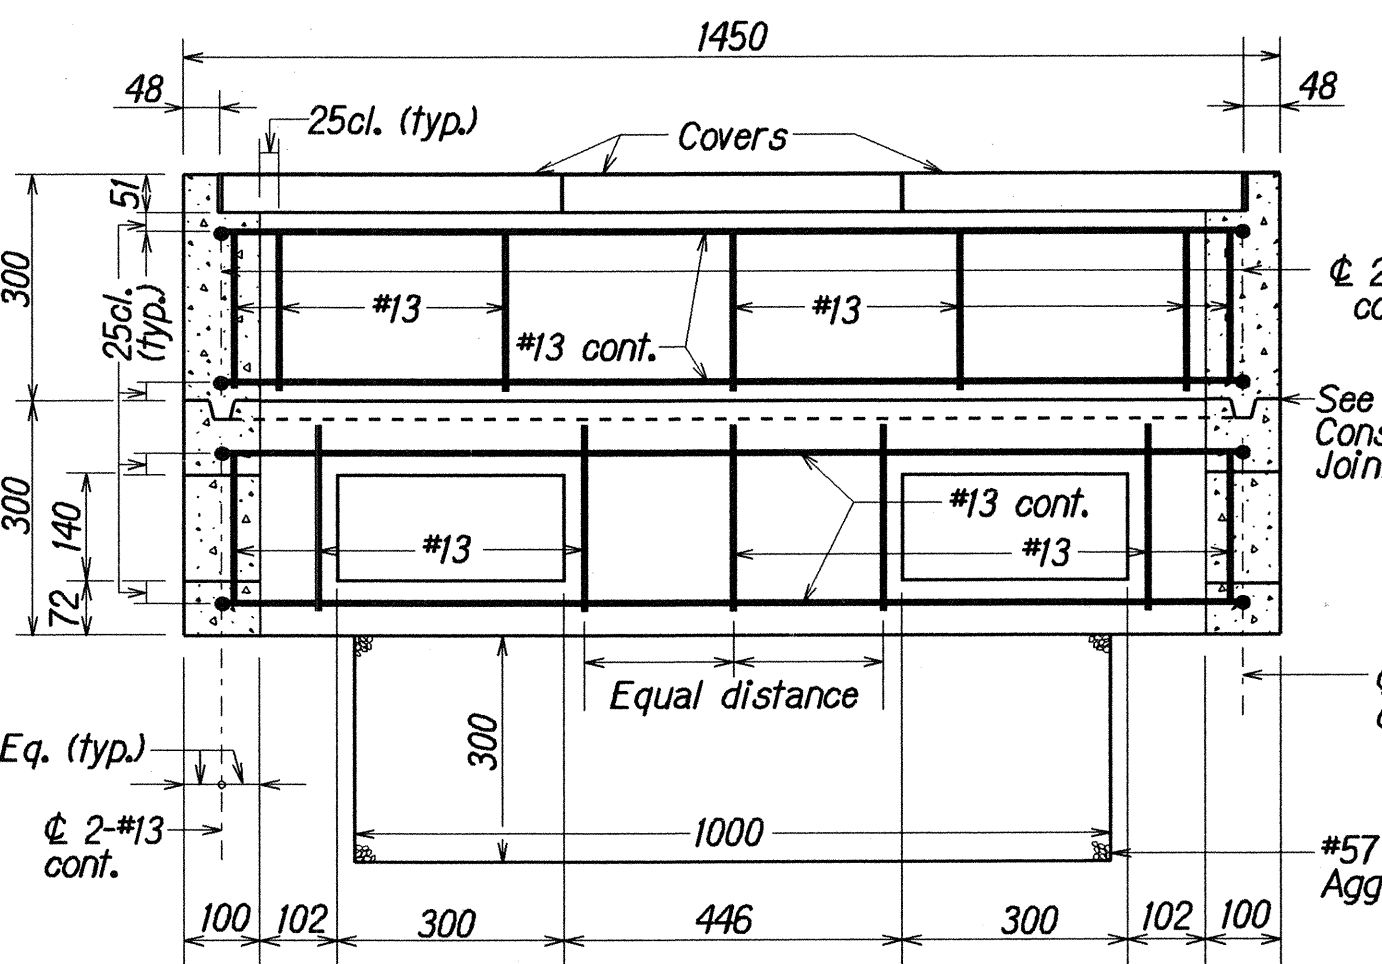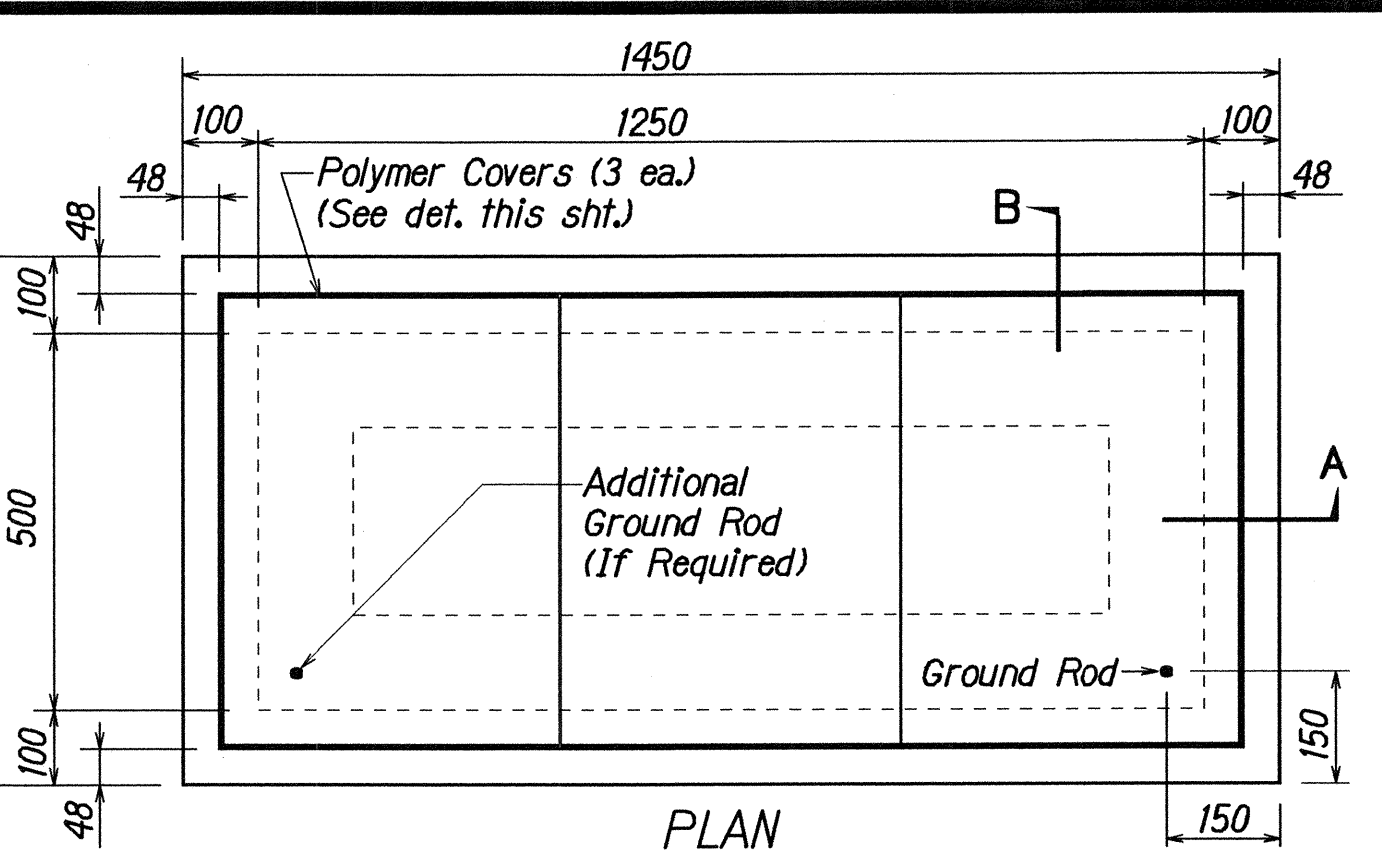


**SECTION A-A**  
**SECTION B-B**  
**TYPE "C" PULLBOX (Old Type "D")**  
Scale: 1:10

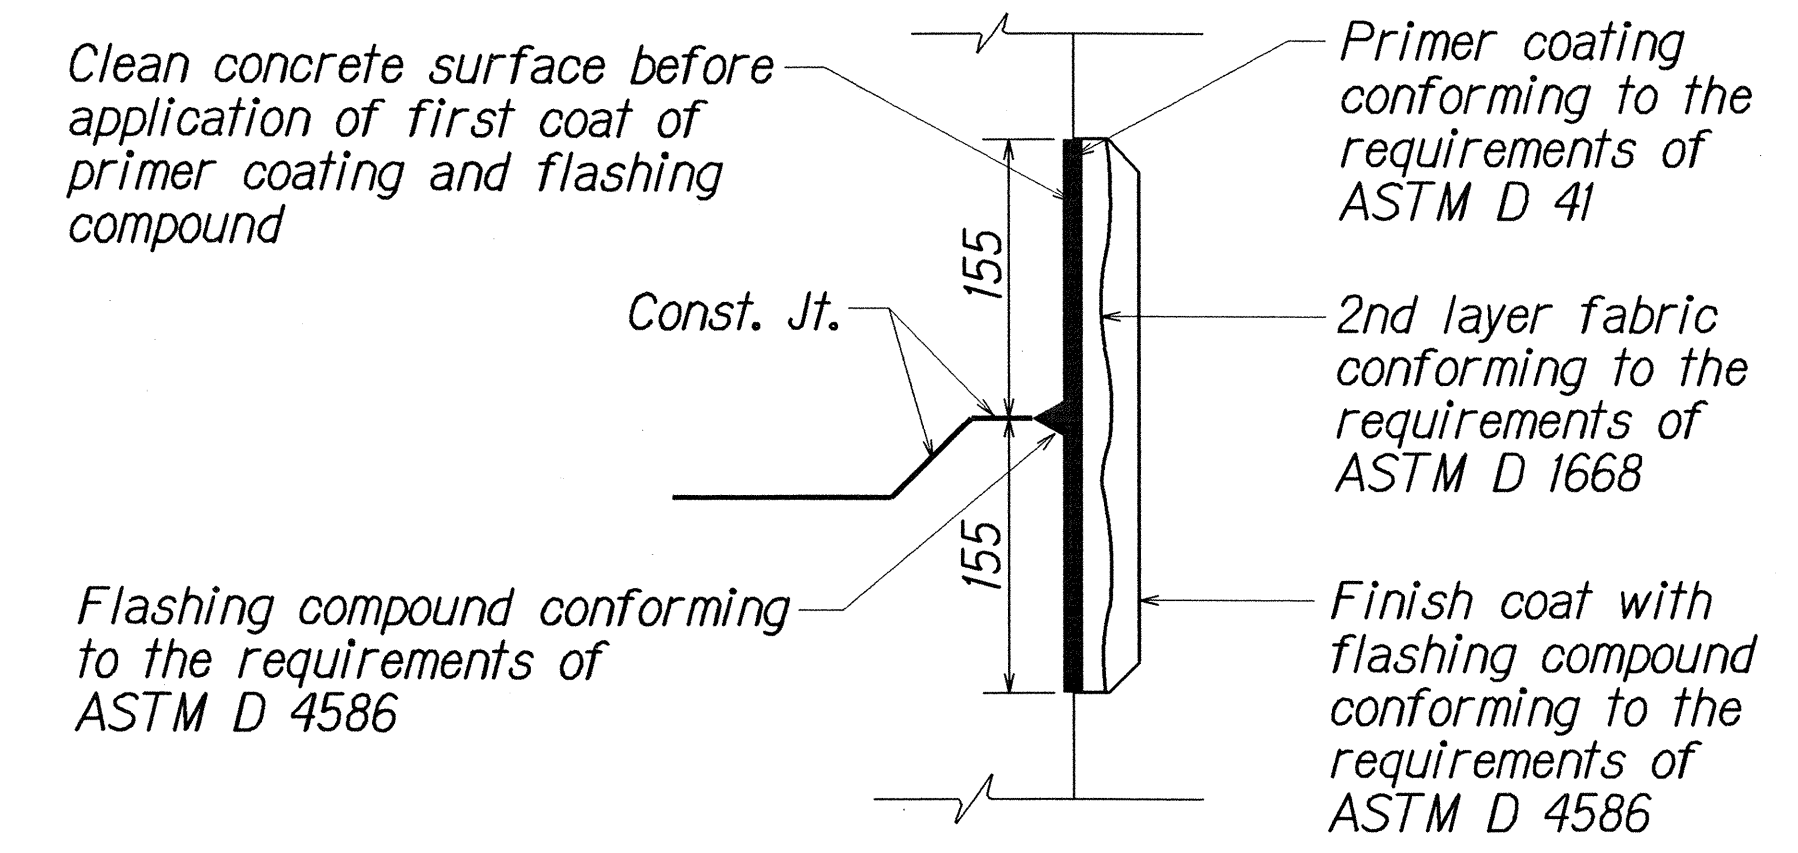

**TYPICAL FLASHING COMPOUND WATERPROOFING DETAILS**  
Not to Scale

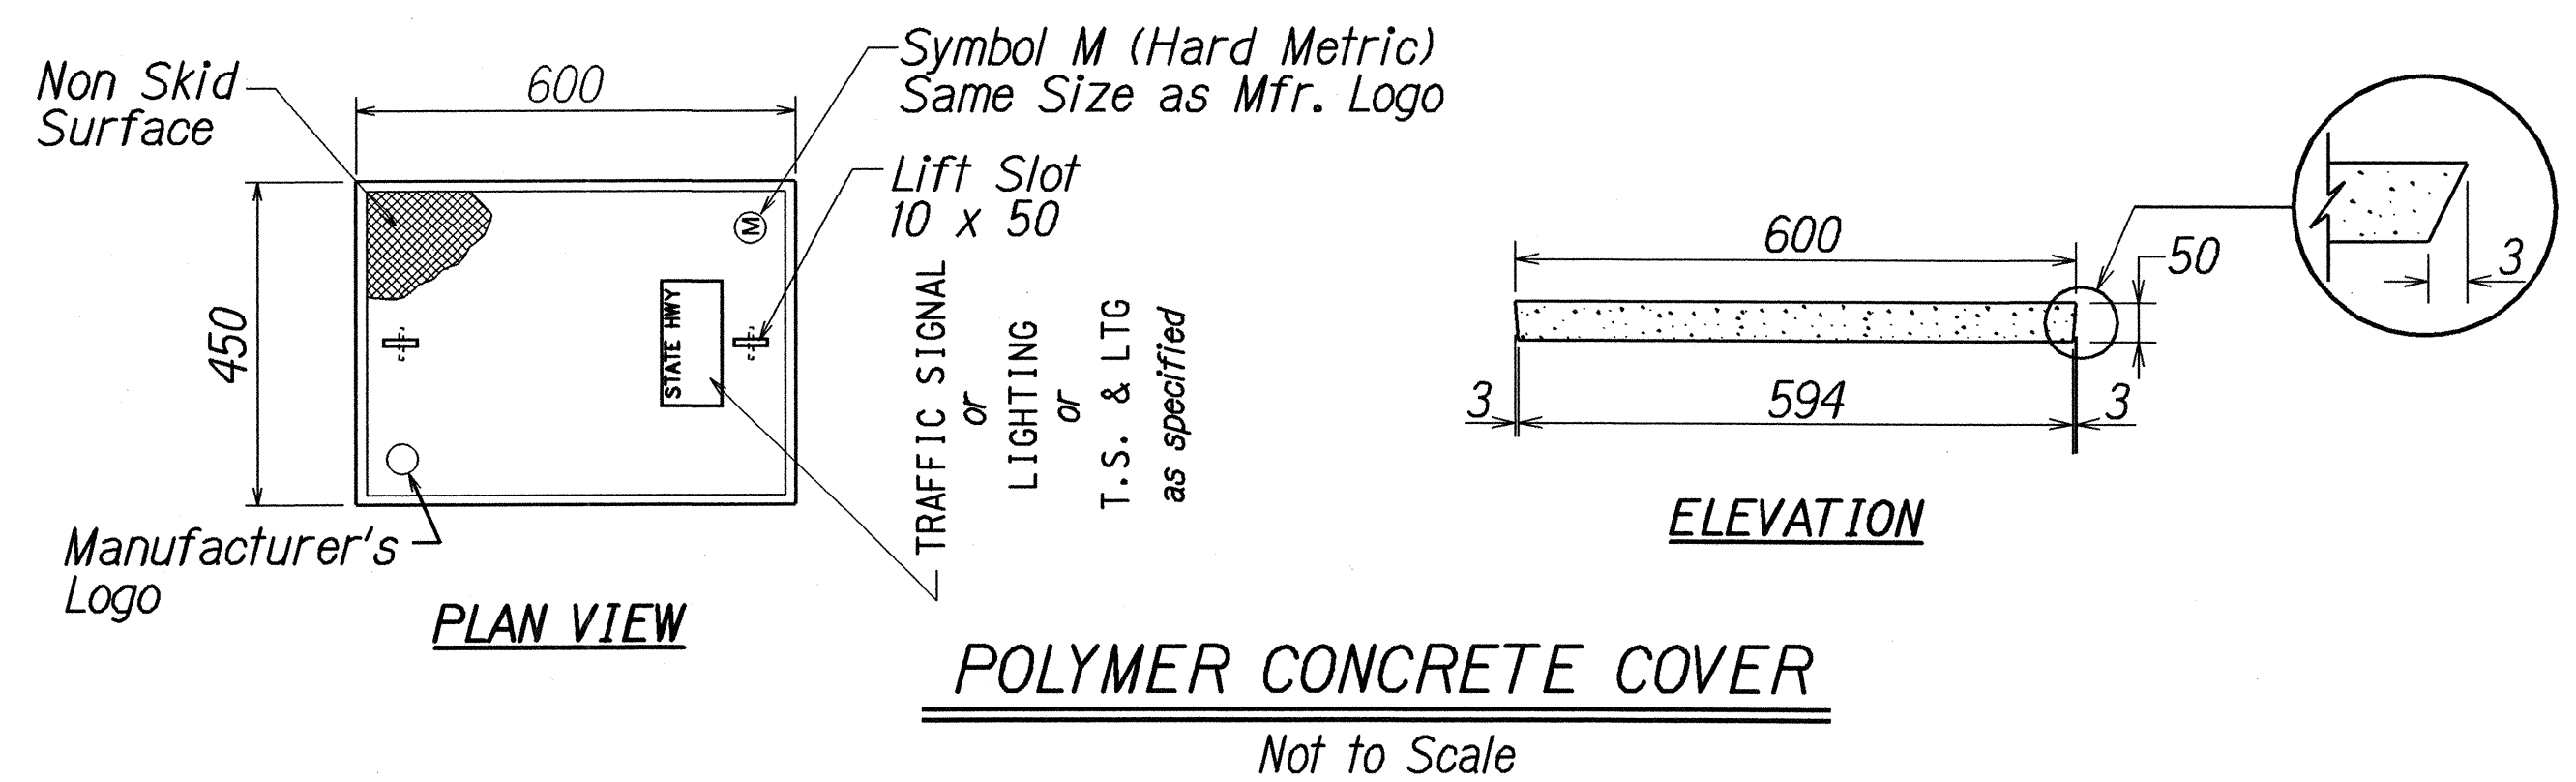

**POLYMER CONCRETE COVER**  
Not to Scale

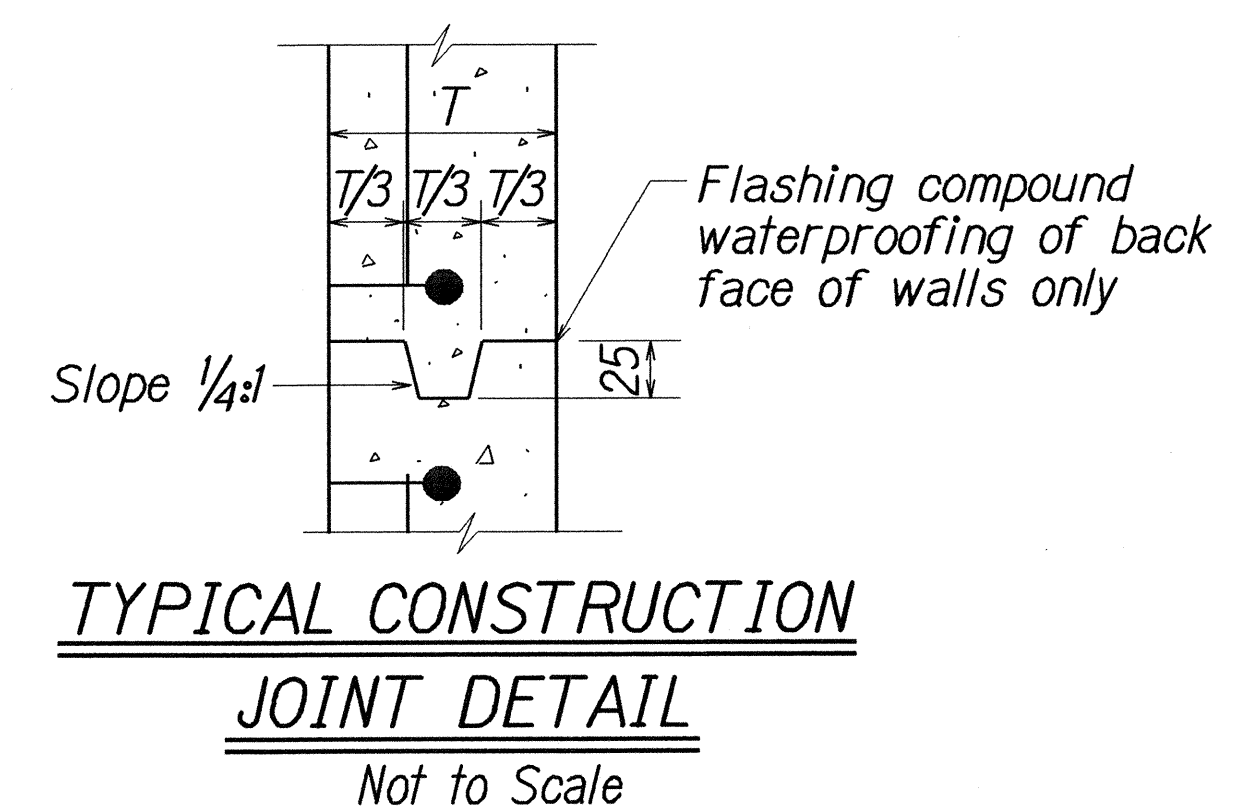

**TYPICAL CONSTRUCTION JOINT DETAIL**  
Not to Scale

ALL DIMENSIONS ARE IN MILLIMETERS UNLESS OTHERWISE SHOWN

STATE OF HAWAII  
DEPARTMENT OF TRANSPORTATION  
HIGHWAYS DIVISION

**PULLBOX & COVER DETAILS**

KANEHOE BAY DRIVE IMPROVEMENTS  
Vicinity of Puohala St. to Kawa Bridge  
F.A. Project No. STP-065-(9)


Scale: As Shown Date: Jan. 2002

SHEET No. TS6 OF 7 SHEETS

SURVEY PLANNED BY: DATE: 2/7/01  
 DRAWN BY: L. Howells  
 CHECKED BY: G. Akers  
 DESIGNED BY: J. Akers  
 QUANTITY BY: J. Akers  
 ORIGINAL PLAN NO. 48412021


04/01/08 TE-41

FED. ROAD DIST. NO.	STATE	FED. AID PROJ. NO.	FISCAL YEAR	SHEET NO.	TOTAL SHEETS
HAWAII	HAW.	STP-065-1(9)	2003	97	114

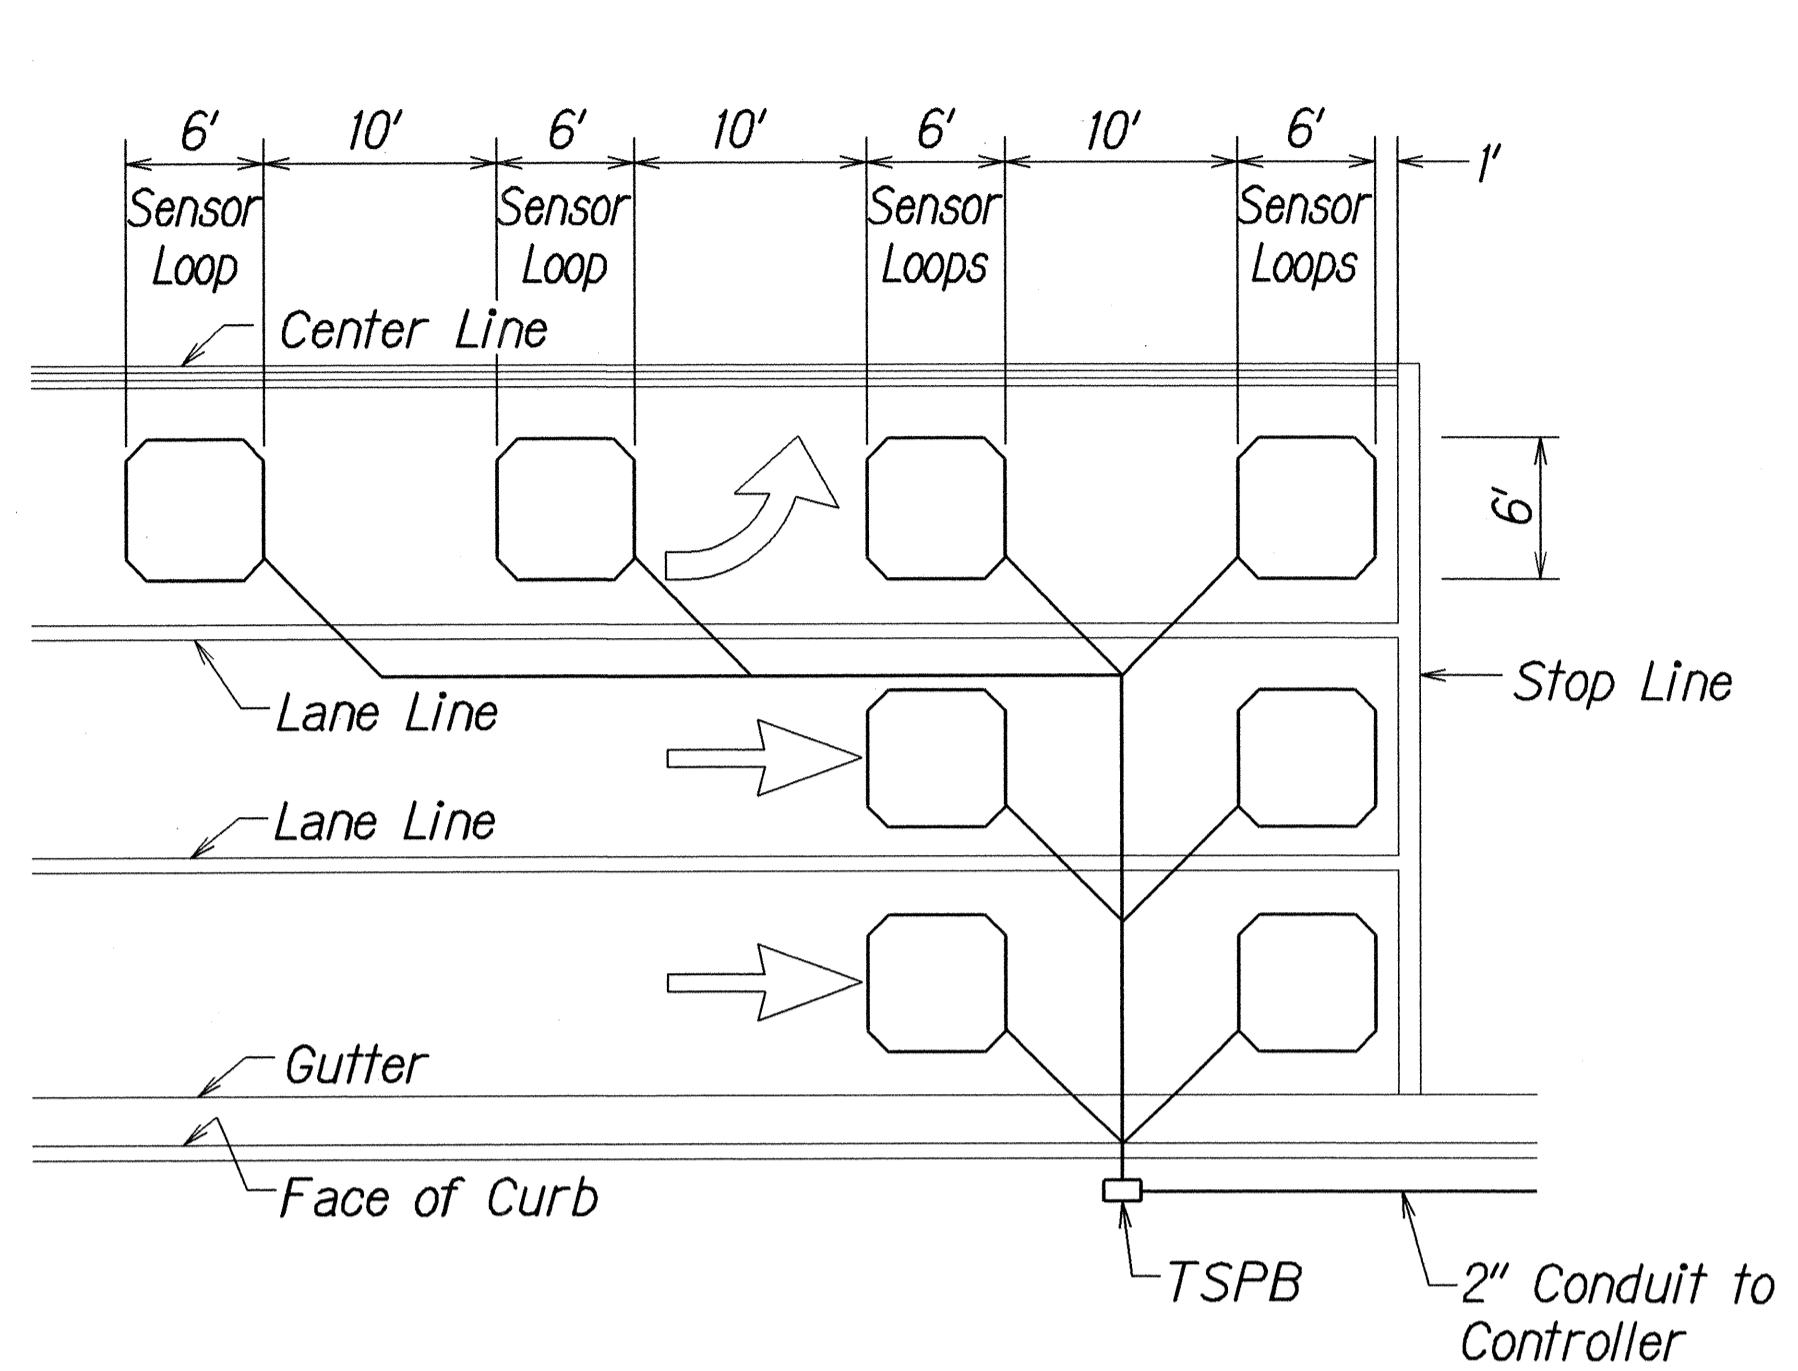


- NOTES:**
- Center sensor loops in lanes.
  - Collector cables shall be twisted 2 turns per foot.
  - Number of loops and locations vary. See project plans.
  - Number and locations of collector sawcuts may be varied in the field to suit.

TYPICAL SENSOR LOOP LAYOUT

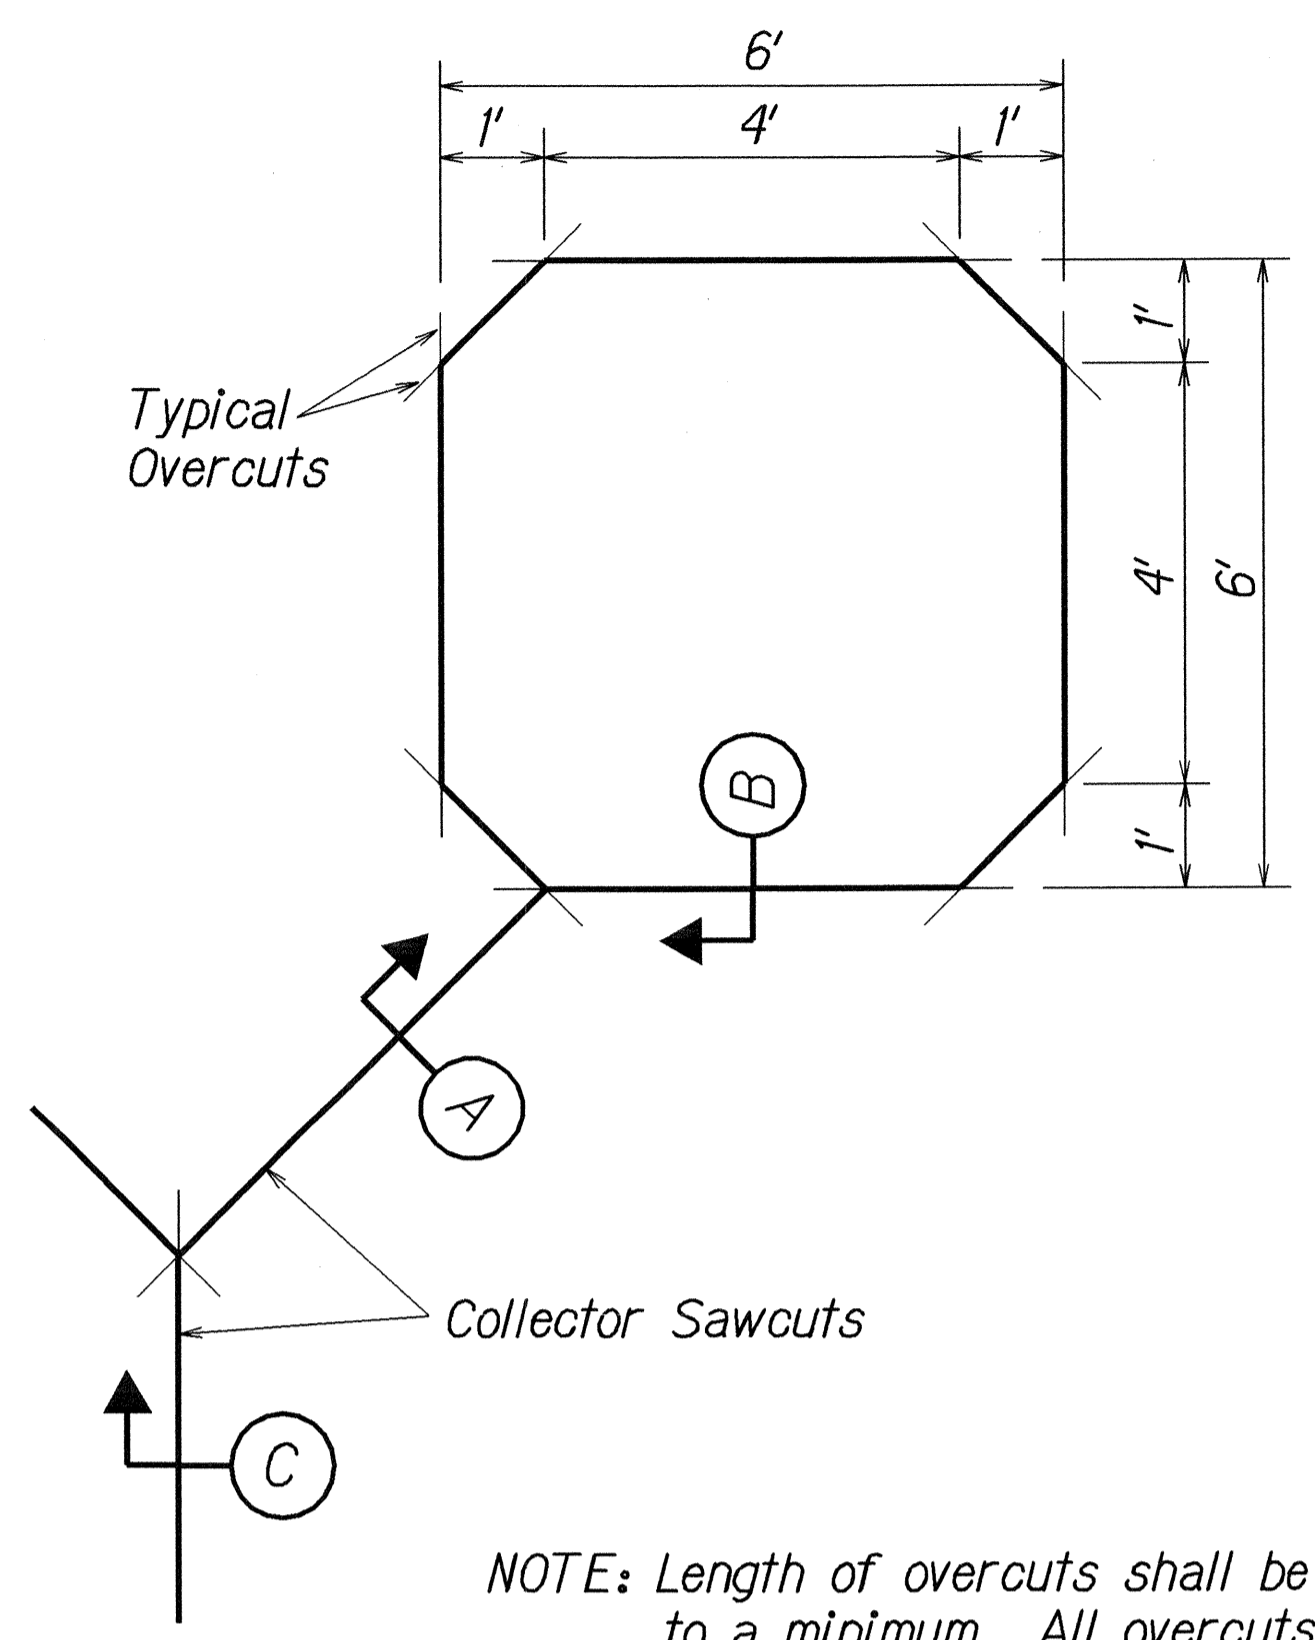


NOTE: Length of overcuts shall be kept to a minimum. All overcuts shall be back filled with hot tar.

TYPICAL SENSOR LOOP SAWCUT DETAIL

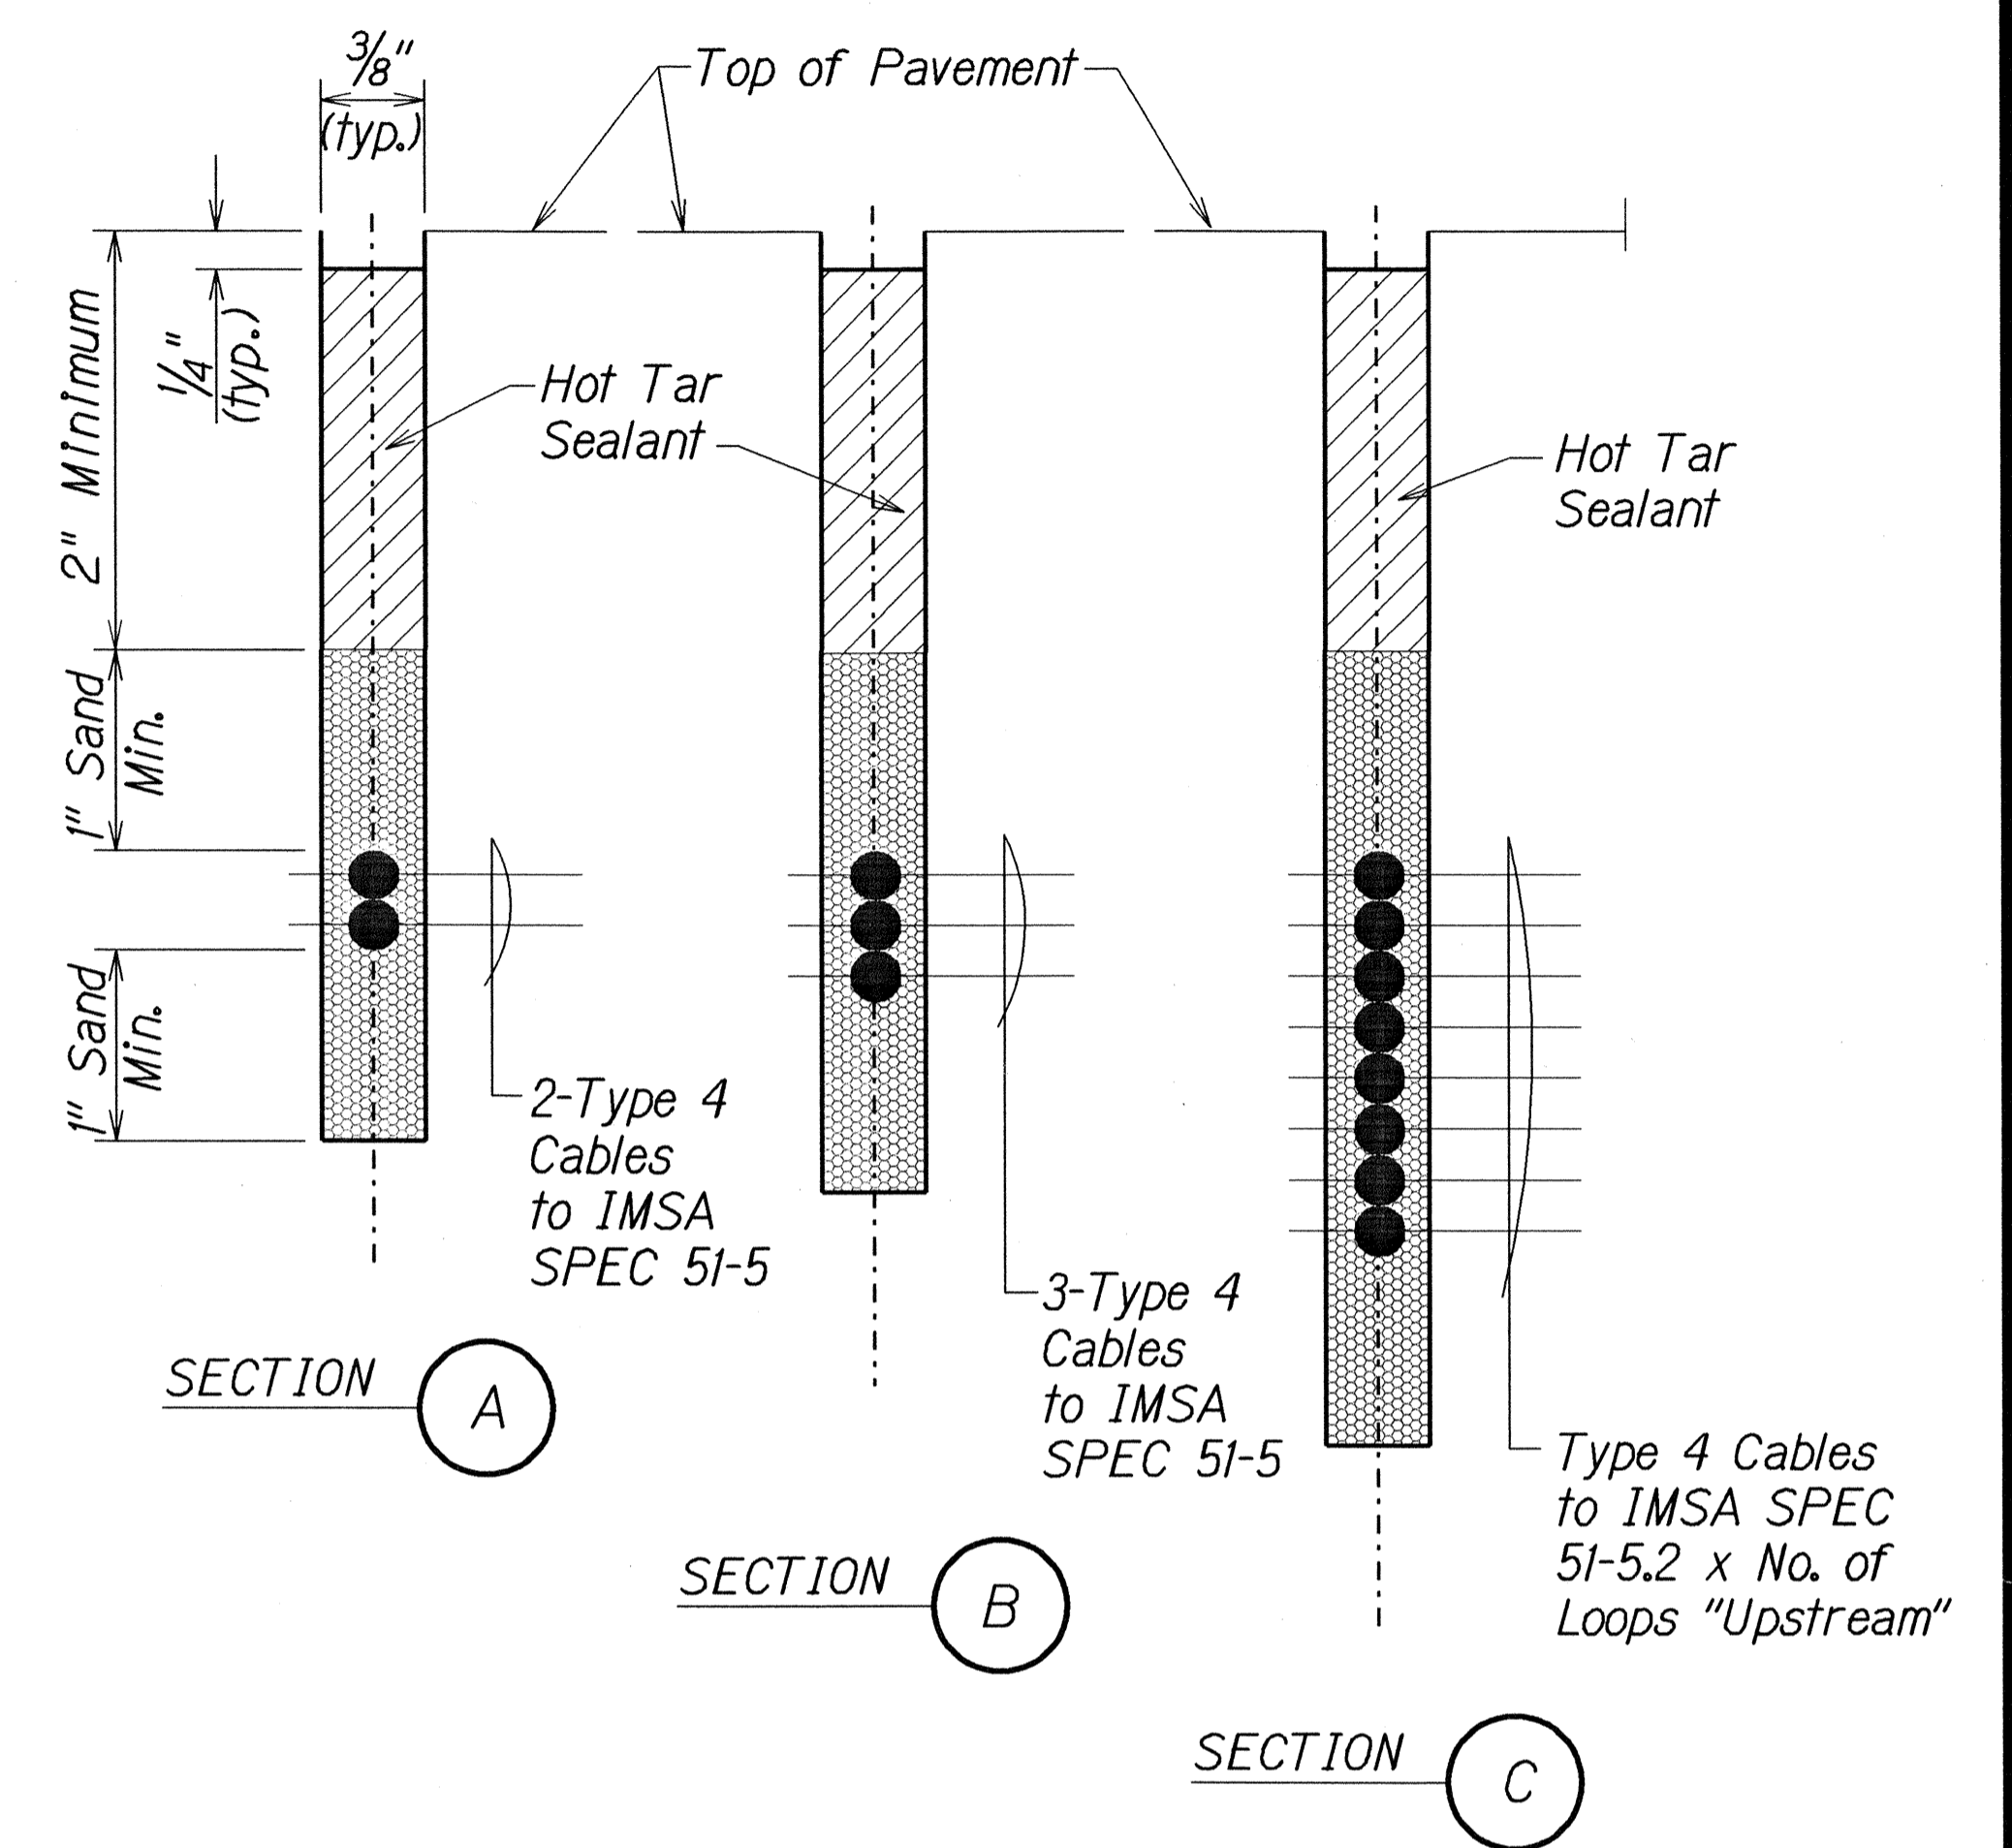


TYPICAL SECTION THROUGH SENSOR LOOP

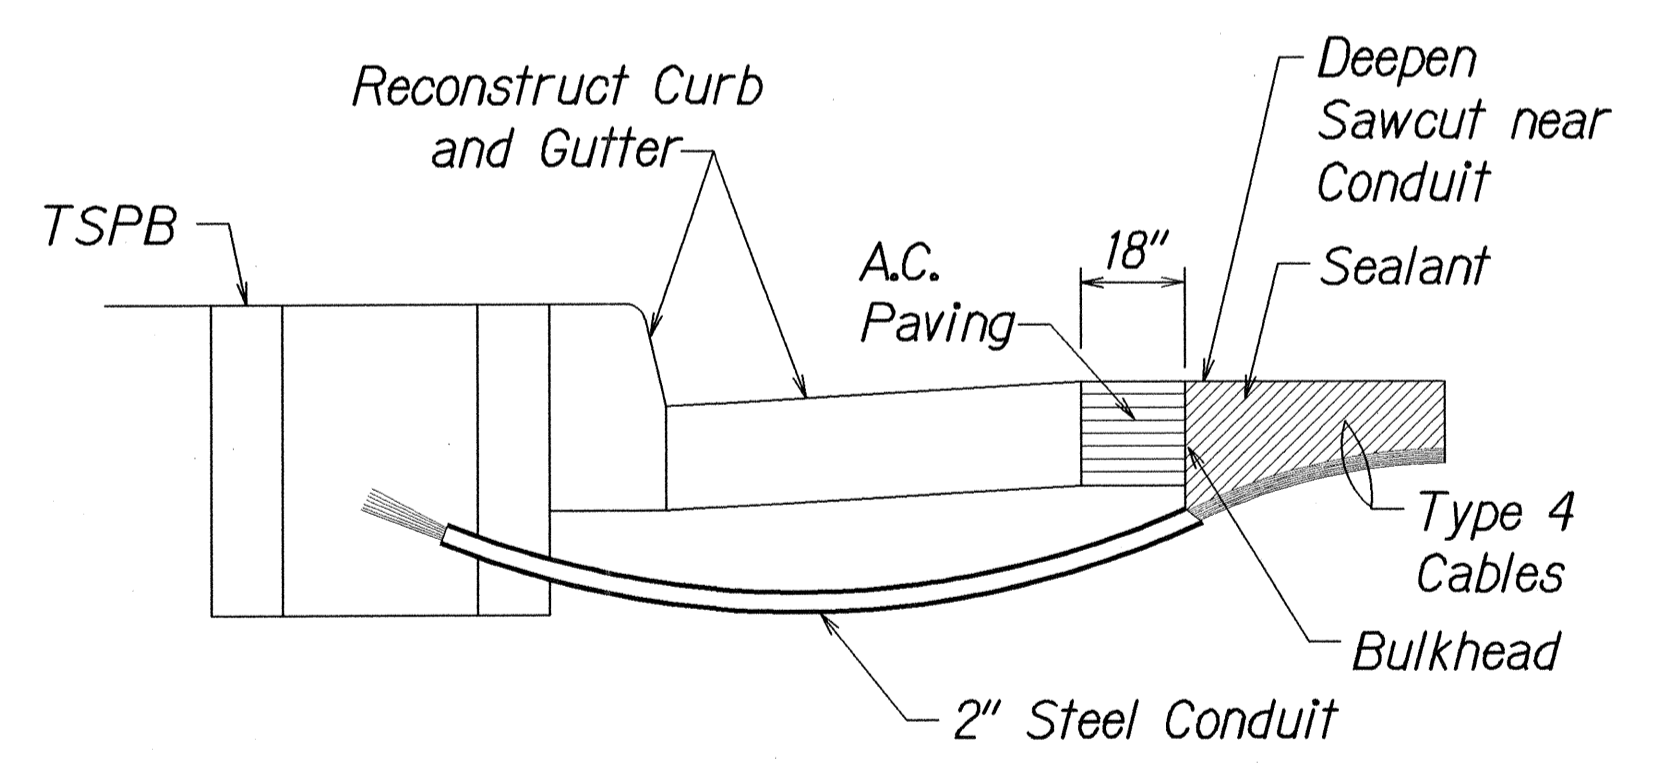

- NOTES ON CONSTRUCTION AT END OF SAWCUT**
- Seal roadway end of conduit after installation of conductors.
  - Install bulkhead across conduit trench.
  - Place hot tar in sawcut.
  - Backfill over conduit with new A.C.
  - Reconstruct curb and gutter as required.

DETAIL OF SENSOR LOOP INSTALLATION AT EDGE OF ROADWAY

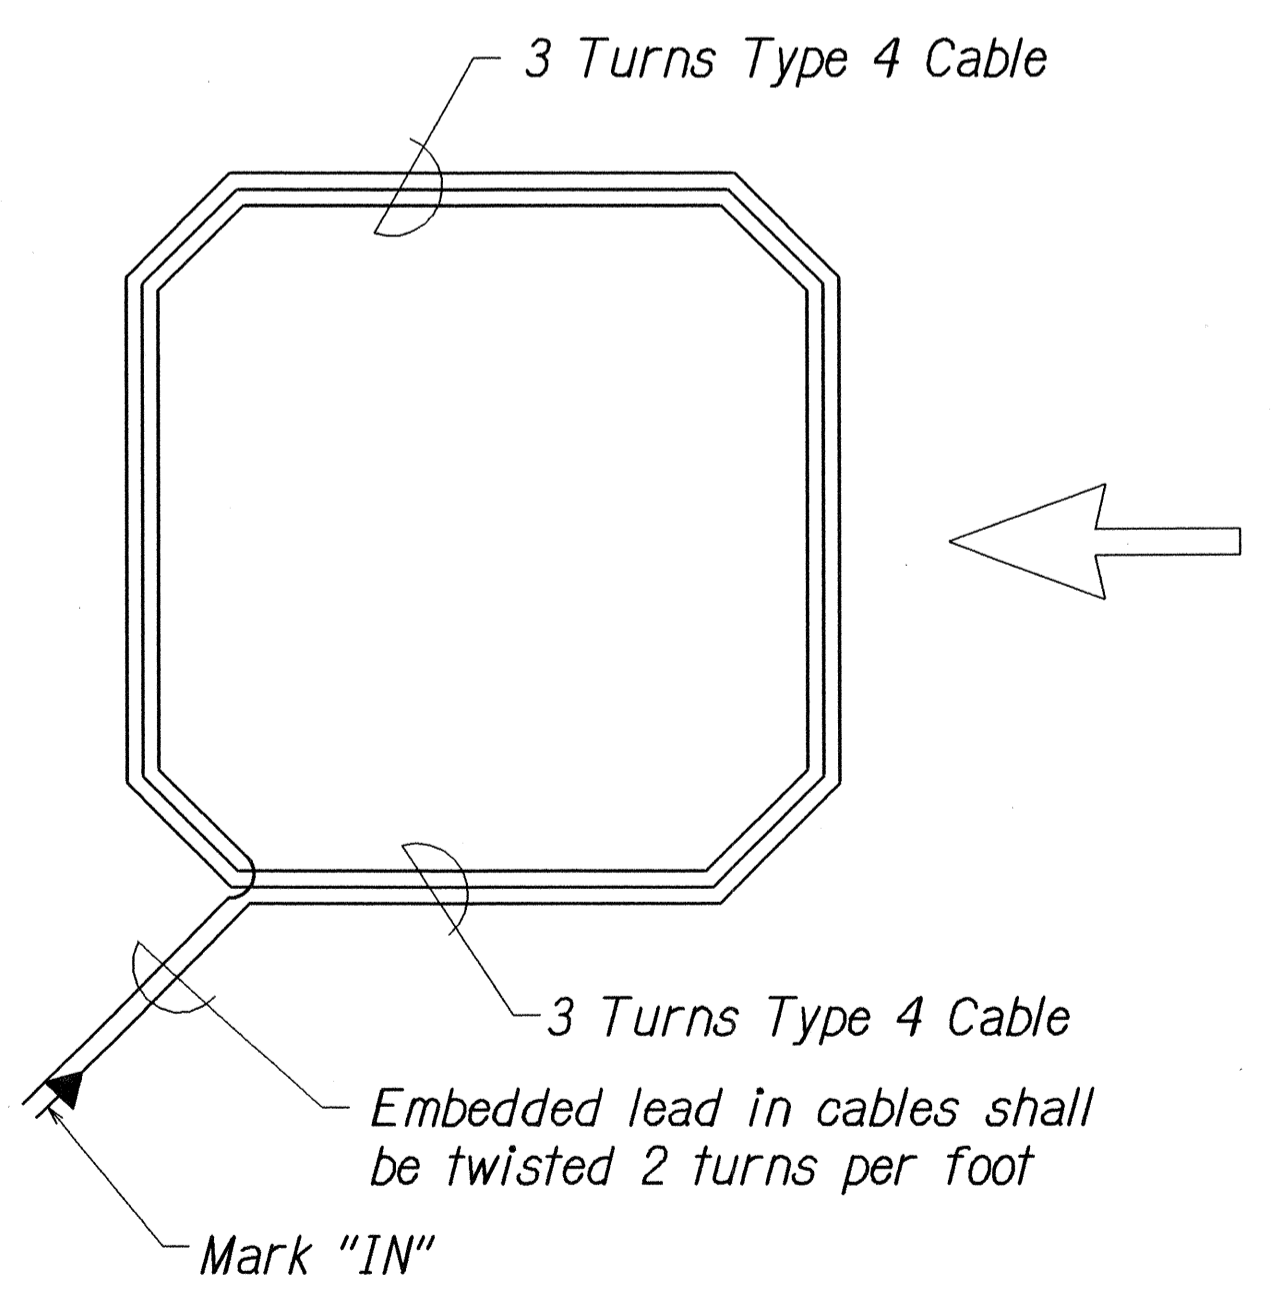

TYPICAL SENSOR LOOP WIRING DIAGRAM

DESIGNED BY	DATE
DRAWN BY	2/7/02
CHECKED BY	
IN CHARGE	

STATE OF HAWAII  
DEPARTMENT OF TRANSPORTATION  
HIGHWAYS DIVISION


**LOOP DETECTOR DETAILS**

KANEIHE BAY DRIVE IMPROVEMENTS  
Vicinity of Puohala St. to Kawa Bridge  
F.A. Project No. STP-065-1(9)


Not to Scale Date: Jan. 2002

SHEET No. **TS7** OF 7 SHEETS

FED. ROAD DIST. NO.	STATE	FED. AID PROJ. NO.	FISCAL YEAR	SHEET NO.	TOTAL SHEETS
HAWAII	HAW.	STP-065-1(9)	2002	98	114

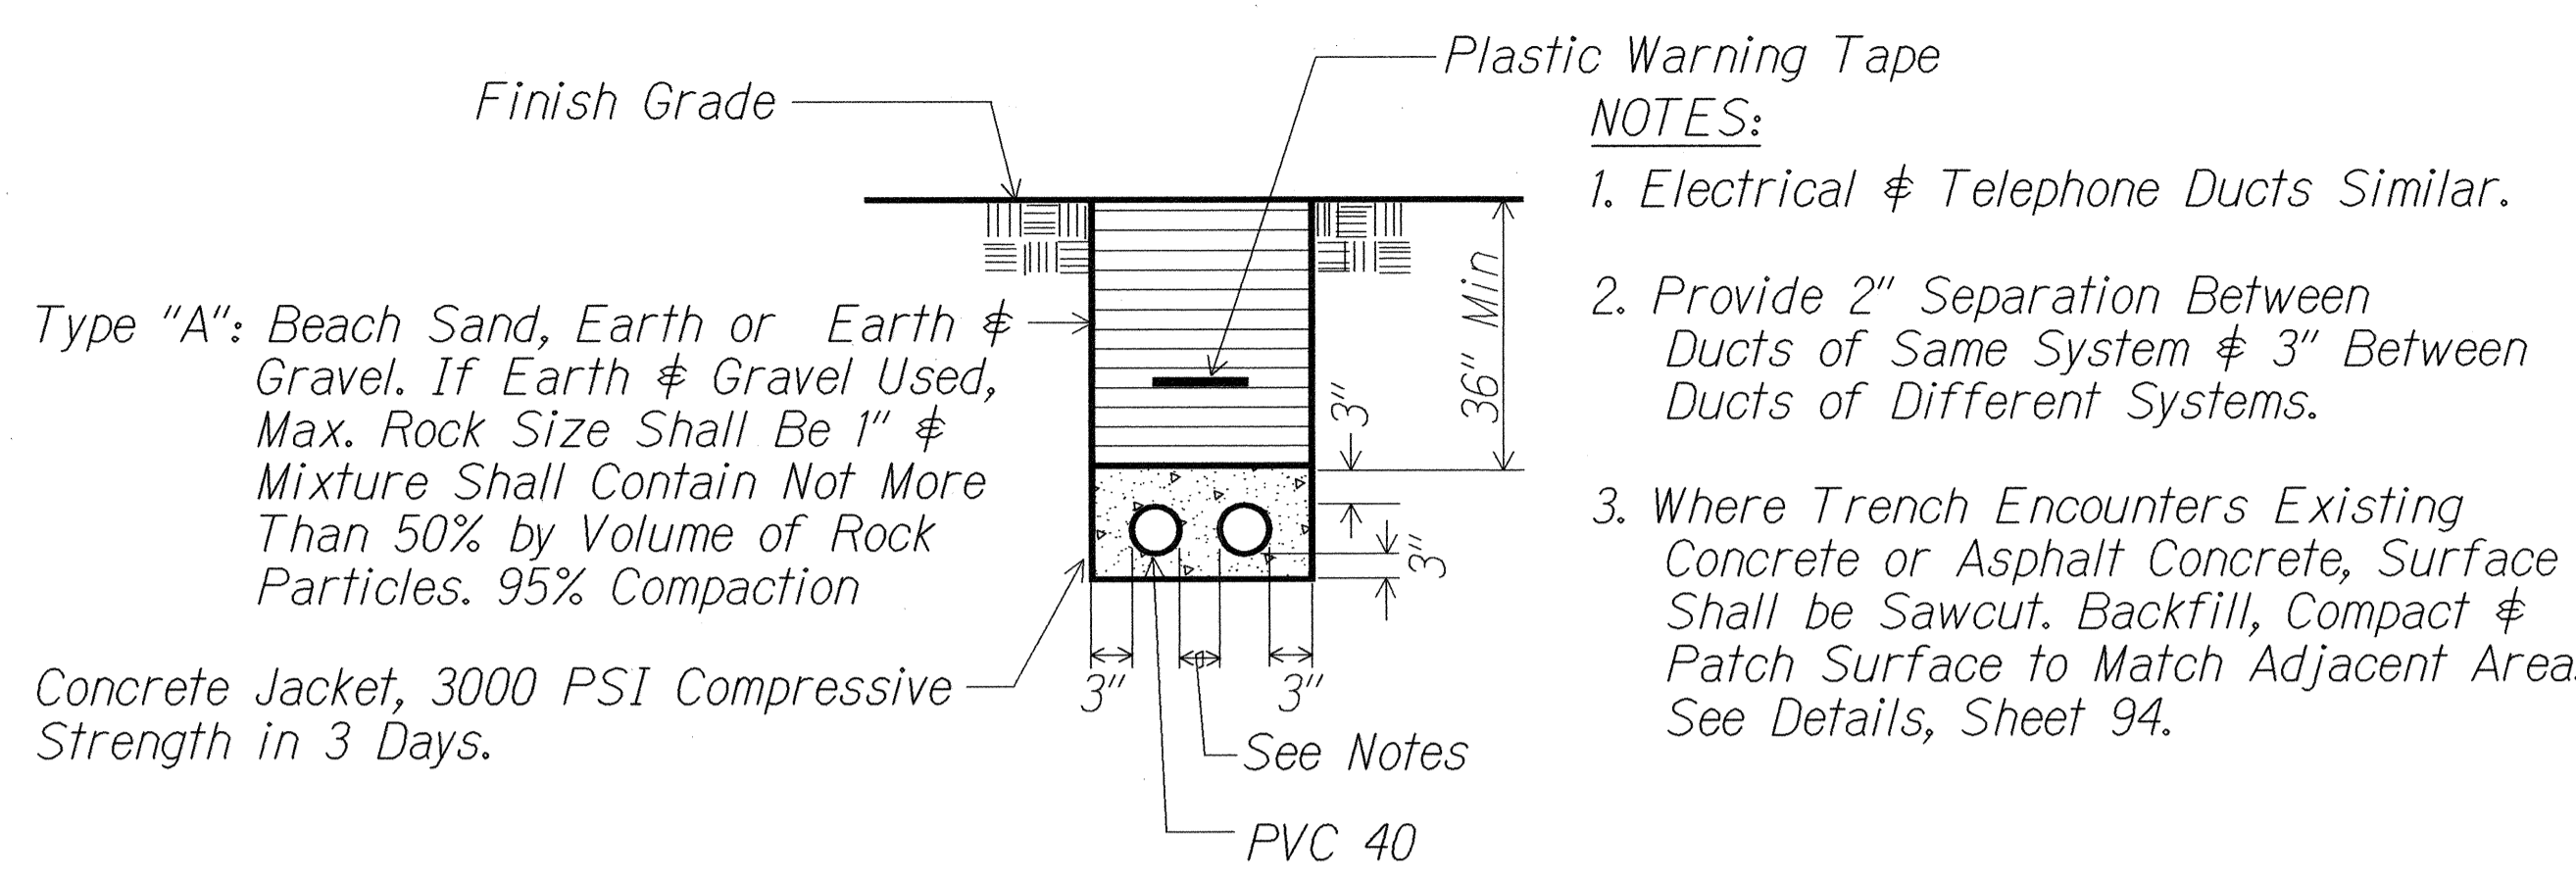

**A** TYPICAL DUCT SECTION (CONCRETE ENCASED)  
E-1 | E-1 Not to Scale 01401-D3

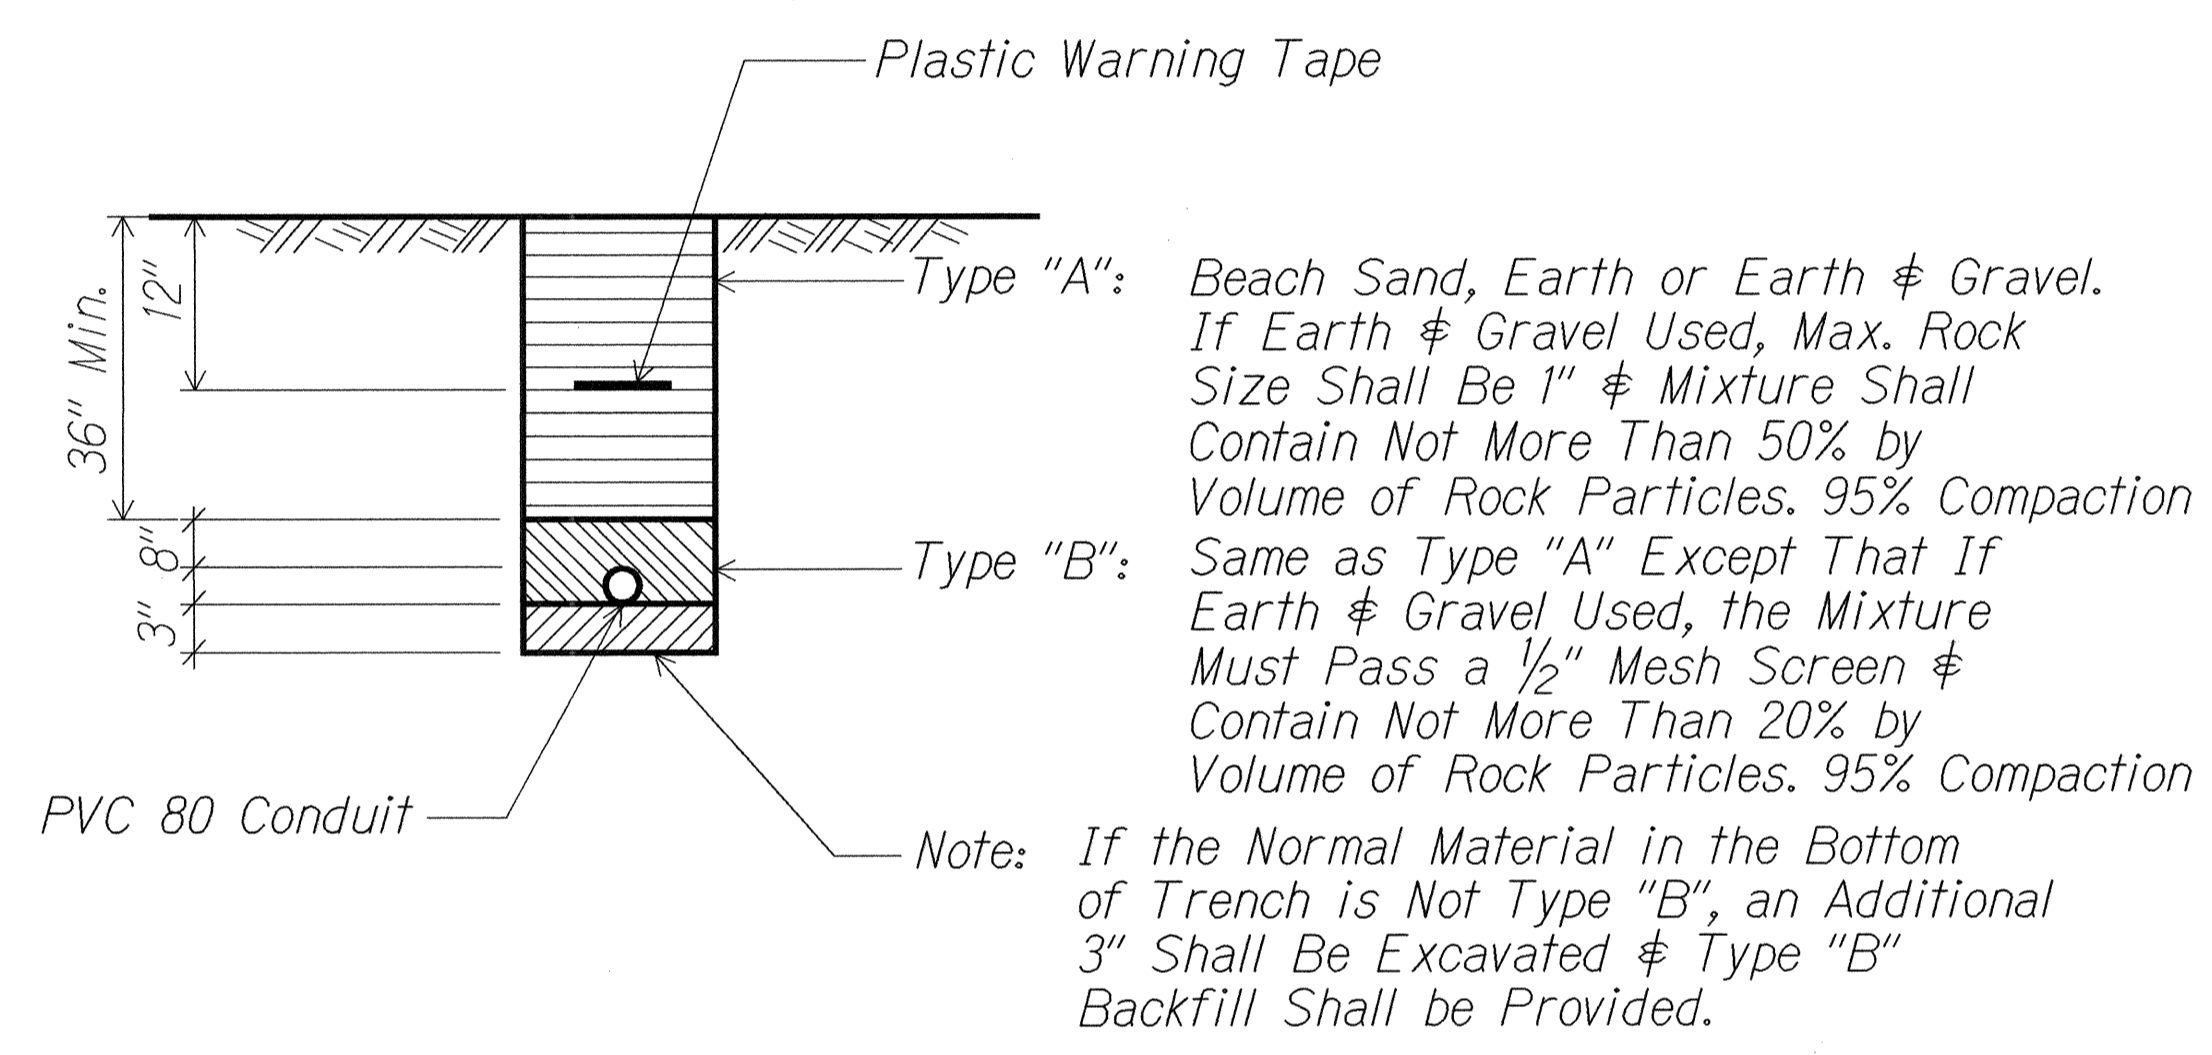

**B** TYPICAL DUCT SECTION (DIRECT BURIED)  
E-1 | E-1 Not to Scale 01401-D3



**GENERAL NOTES**

- Obtain all standards and drawings related to this project from the utility companies. Verify that the HECO, Verizon and Oceanic Cablevision project drawings are the same as the contract drawings. Notify the engineer of any differences between them. If differences exist, obtain a resolution prior to proceeding with the work which is affected.
- Prior to starting work, notify the utility companies in writing when work will start, and provide them with a construction schedule. Coordinate all work with utility companies.
- LIGHTING CALCULATION SUBMITTAL** - The Contractor shall submit computerized point-to-point iso-footcandle calculations of the roadway (curb-to-curb) for approval. The following requirements and parameters shall be used:  
Minimum average maintained illuminance level- 0.9 footcandles  
Uniformity ratio (average to minimum)- 6:1 maximum  
Lamp lumen output- 28,500 lumens  
Light loss factor- 0.75

**ELECTRICAL SYMBOLS**


- Manhole (Existing)
- Handhole, Verizon #435TB
- 250W HPS Street Light Fixture Mounted on Joint-Use Pole, See Sht E-9 for Details
- 250W HPS Street Light Fixture with House-side Light Shield Mounted on Joint-Use Pole, See Sht E-9 for Details
- Joint-Use Pole with Guy Anchor Assembly (By HECO/Verizon as Noted)
- Existing Ductline
- Ductline, See Duct Sections
- Street Light Tag
- Aerial Line
- 12KV,46KV: HECO Lines, Voltage as Indicated
- S : Electrical Secondary &/or Common Neutral
- T : Telephone
- C : Cable Television
- L : Street Light
- G : Span Guy
- X X X** Indicates Aerial Line Removal by Utility Company

**DUCT DESIGNATION**

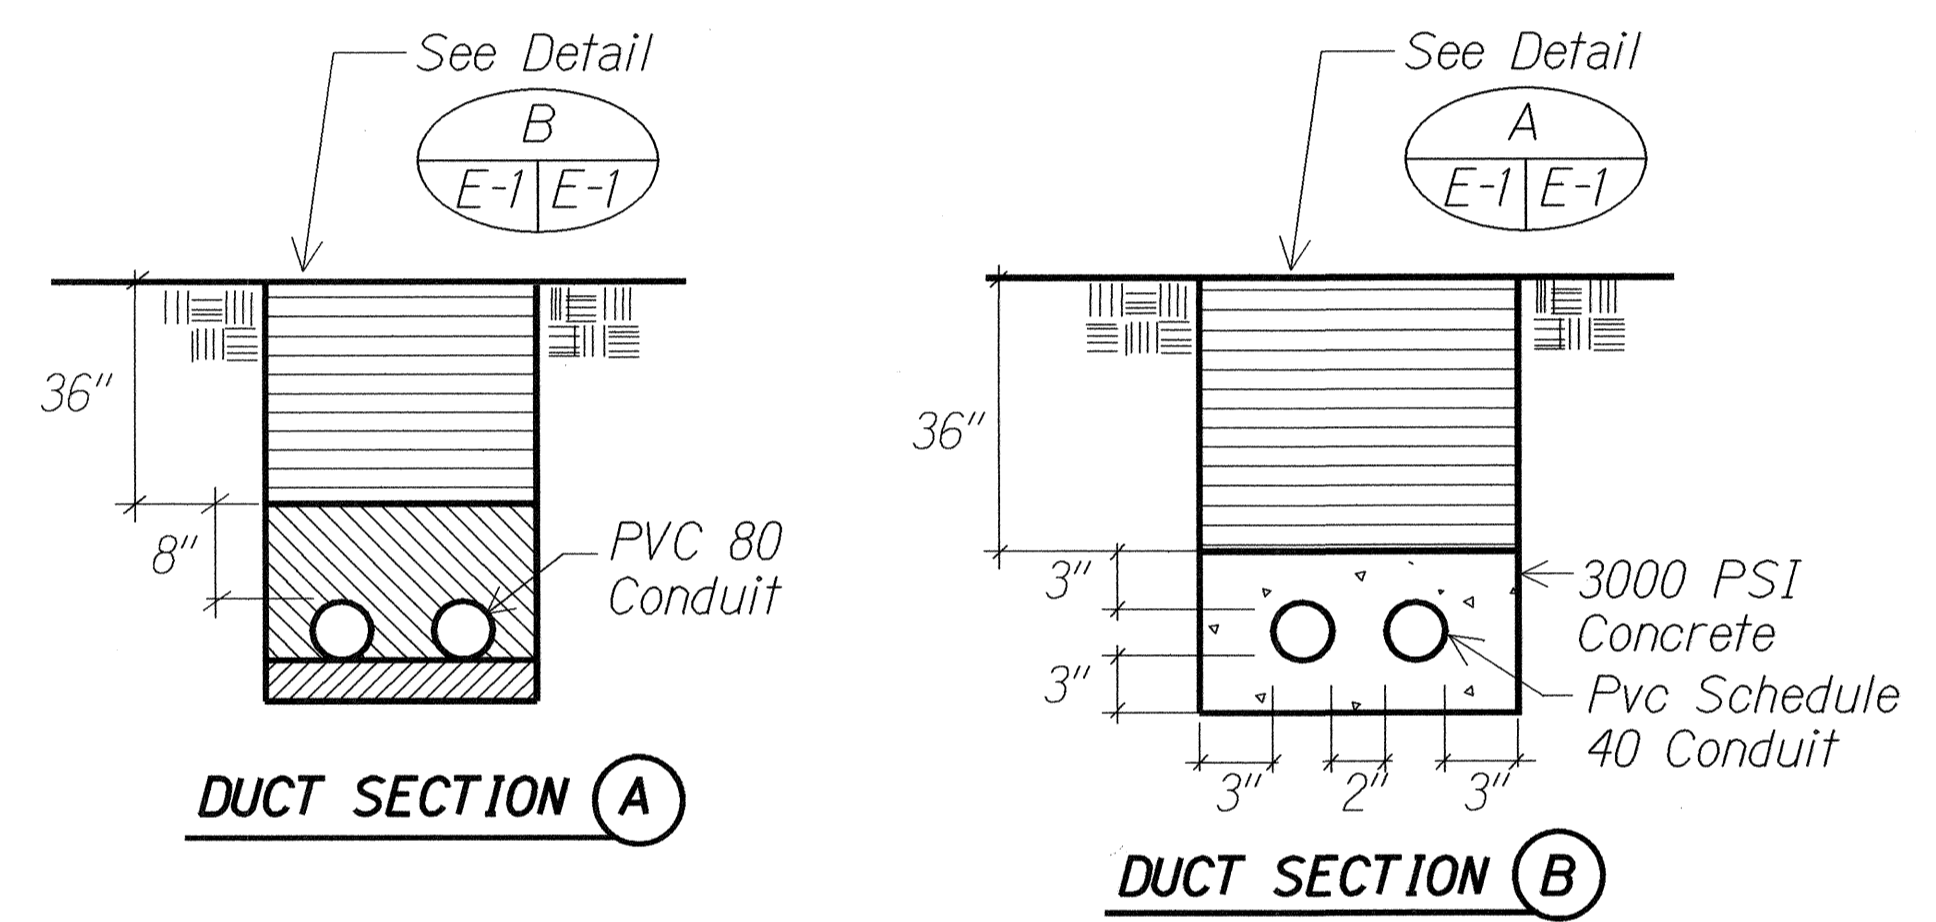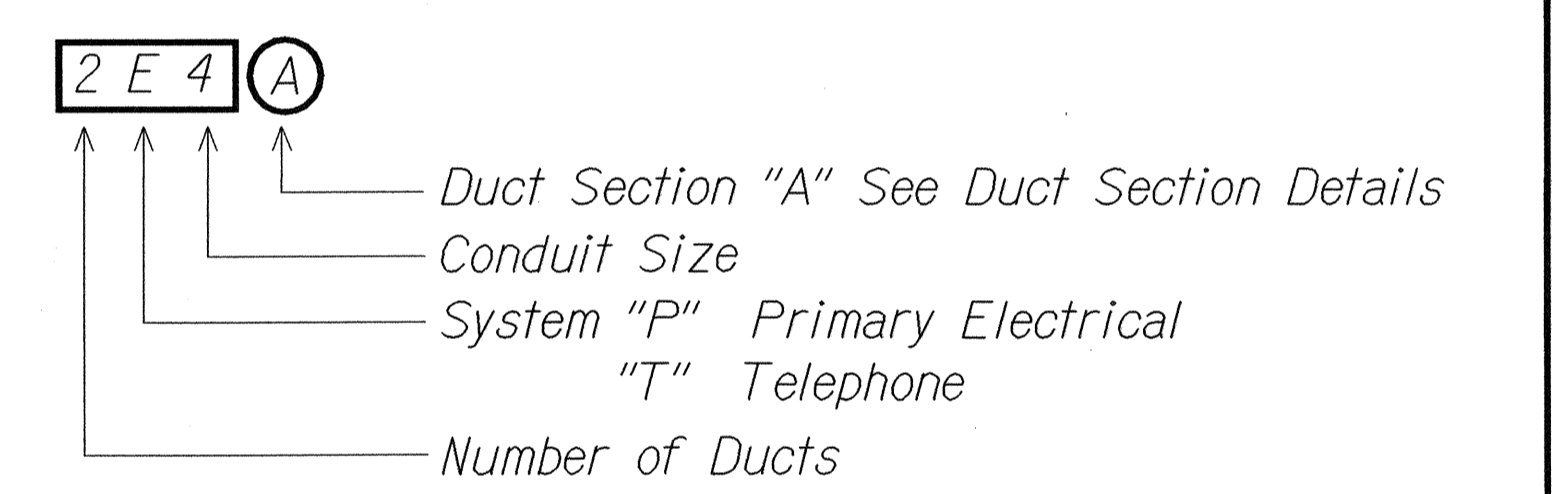

DUCT SECTION (A)

DUCT SECTION (B)

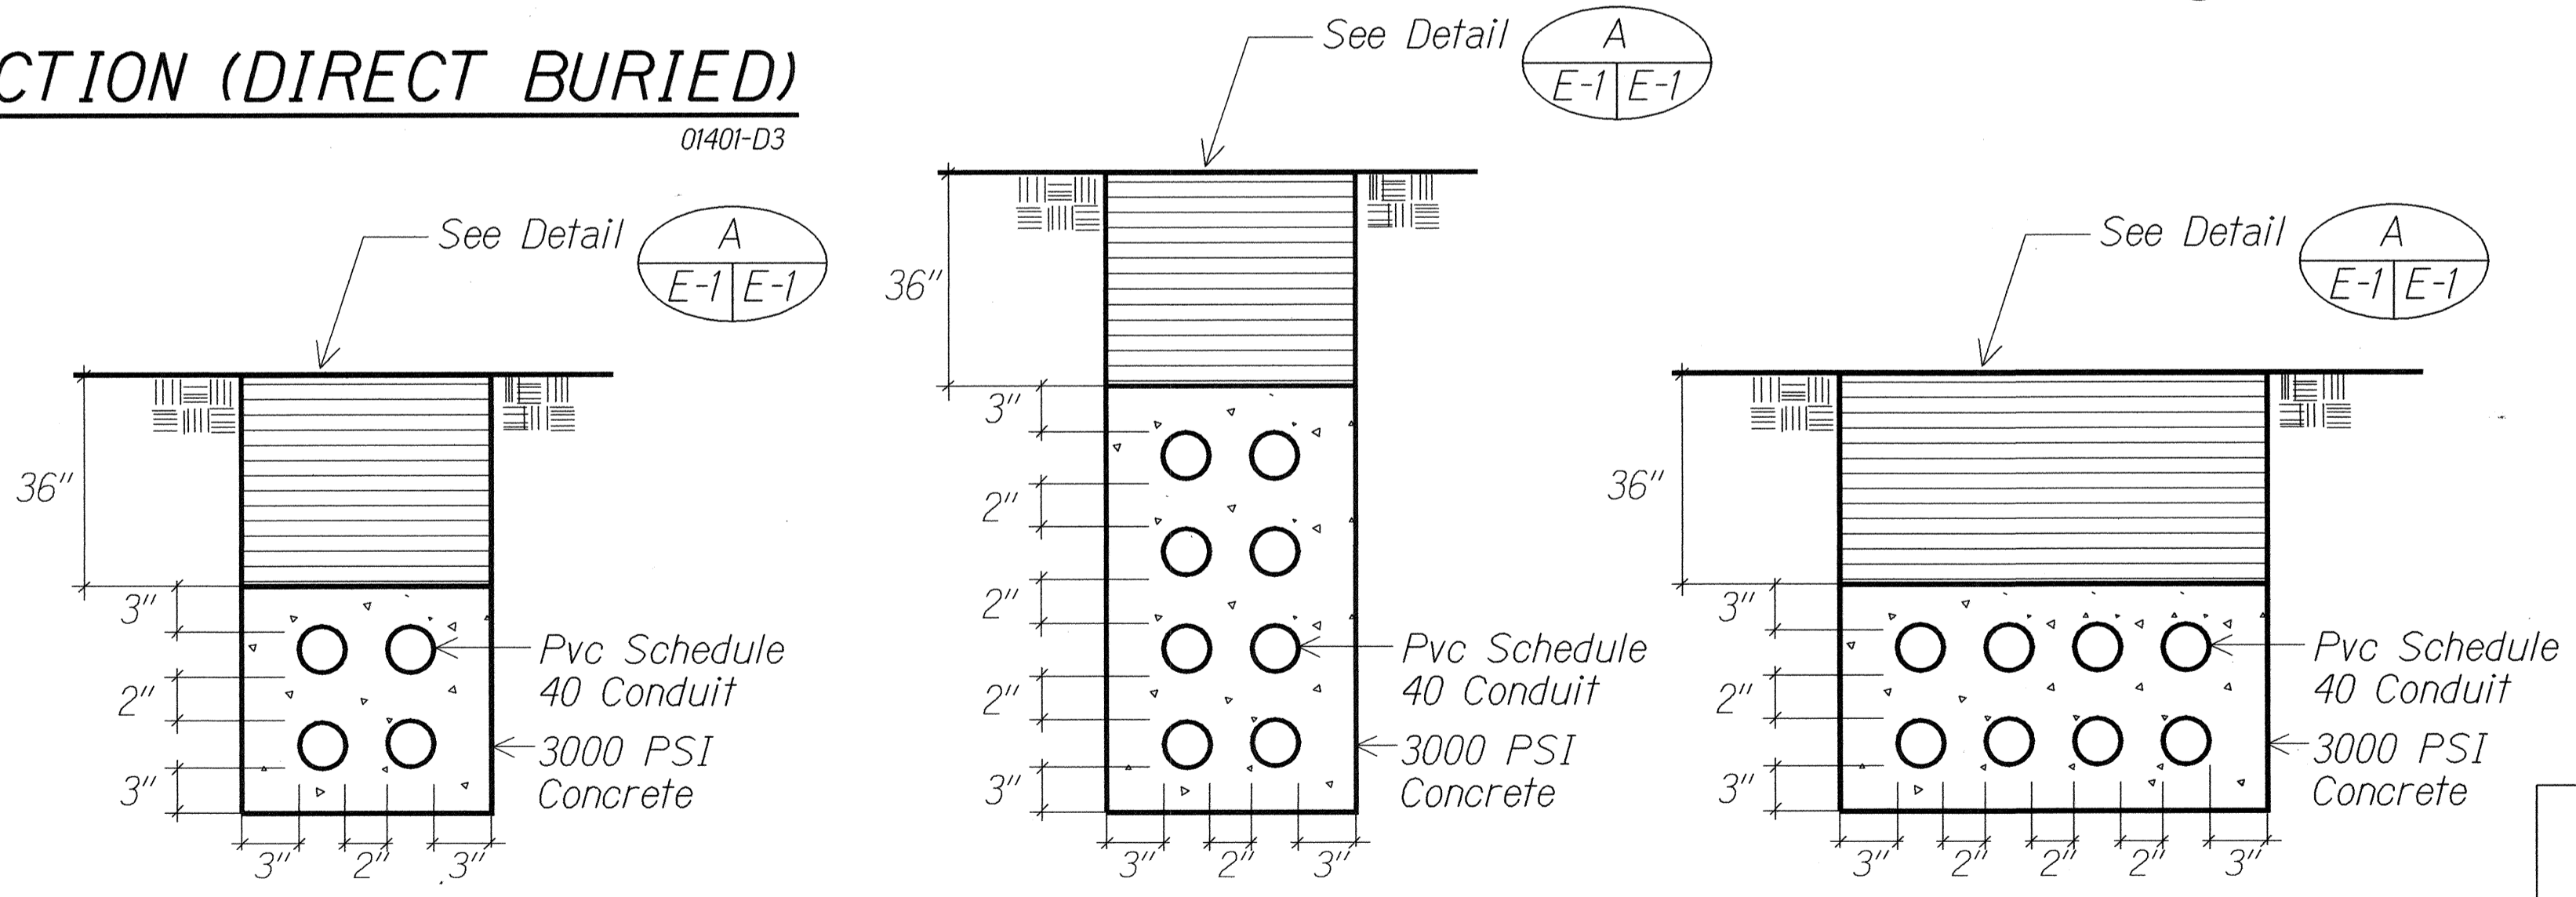

DUCT SECTION (C)

DUCT SECTION (D)

DUCT SECTION (E)

**DUCT SECTION DETAILS**

01401-D3

**DRAWING REVIEW**  
Reviewed for HECO's Facilities Only  
Date 7/18/02 By [Signature]  
Engineering Department  
Hawaiian Electric Company, Inc.  
HECO's review of these drawings shall in no way relieve the Customer, its Consultant, its Contractor or anyone acting on the Customer's behalf from the responsibility for engineering, design, materials and any other liability associated with this project.


**APPROVED:**  
[Signature] 7/22/02 DATE  
HAWAIIAN TELEPHONE COMPANY  
VERIZON HAWAII, INC.  
**APPROVED:**  
[Signature] 07-26-02 DATE  
OCEANIC CABLEVISION

R.G. KATAHARA  
LICENSED PROFESSIONAL ENGINEER  
No. 3181-E  
HAWAII, U.S.A.  
This work was prepared by me or under my supervision.  
[Signature] 7/12/02  
MK ENGINEERS, LTD.

STATE OF HAWAII  
DEPARTMENT OF TRANSPORTATION  
HIGHWAYS DIVISION  
**ELECTRICAL SYMBOLS, NOTES & DETAILS**  
KANEOHE BAY DRIVE IMPROVEMENTS  
Vicinity of Puohala Street to Kawa Bridge  
Federal Aid Project No. STP-065-1(9)  
Scale: As Noted Date: June, 2002  
SHEET No. E-1 OF 10 SHEETS

SURVEY PLOTTED BY	DATE
DRAWN BY	
DESIGNED BY	
CHECKED BY	
QUANTITIES BY	
ORIGINAL PLAN	
NOTE BOOK	
No.	

FED. ROAD DIST. NO.	STATE	FED. AID PROJ. NO.	FISCAL YEAR	SHEET NO.	TOTAL SHEETS
HAWAII	HAW.	STP-065-119	2002	99	114

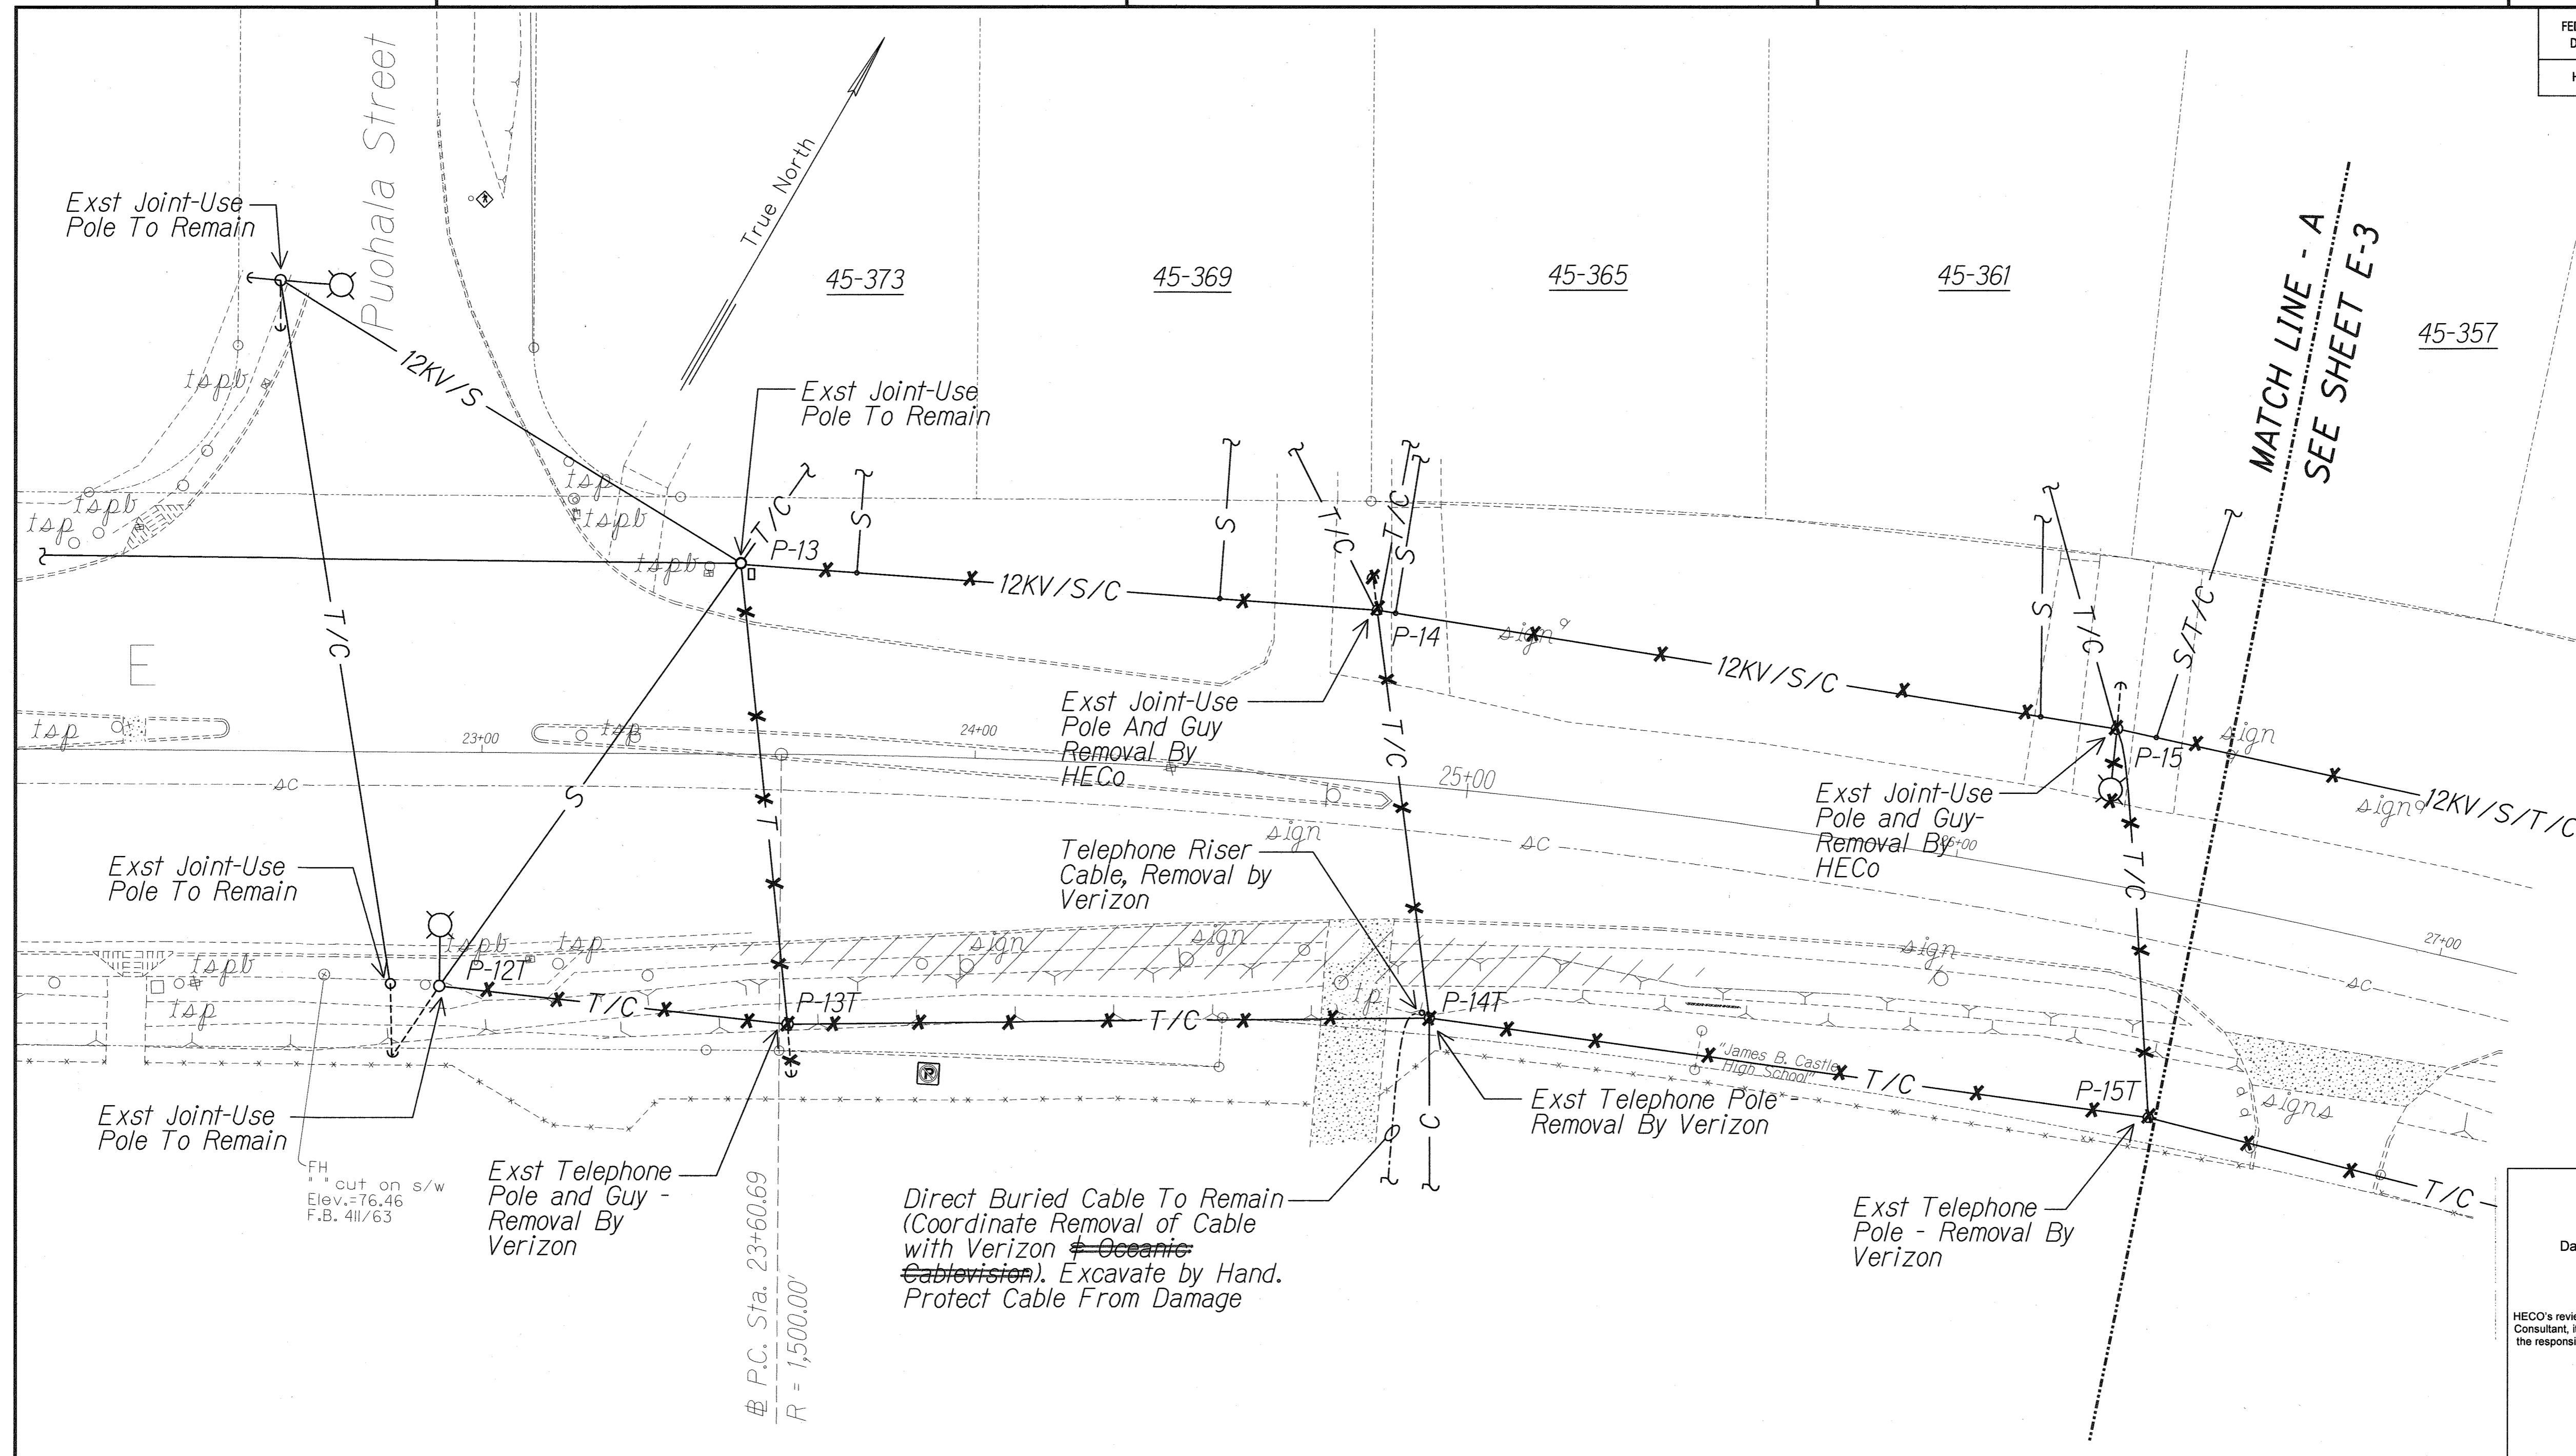


**DRAWING REVIEW**  
Reviewed for HECO's Facilities Only  
Date 7/18/02 By [Signature]  
Engineering Department  
Hawaiian Electric Company, Inc.  
HECO's review of these drawings shall in no way relieve the Customer, its Consultant, its Contractor or anyone acting on the Customer's behalf from the responsibility for engineering, design, materials and any other liability associated with this project.

**PARTIAL ELECTRICAL DEMOLITION SITE PLAN - A**  
Scale: 1" = 20'-0" 01401-S1

**Notes:**  
1. Light Lines Denote Existing Condition.  
"x" Items Denote Removal Work.

APPROVED: [Signature] 7/22/02 DATE  
HAWAIIAN TELEPHONE COMPANY - VERIZON HAWAII INC.  
APPROVED: [Signature] 07-26-02 DATE  
OCEANIC CABLEVISION


SURVEY PLOTTED BY	DATE
DRAWN BY	
RECHECKED BY	
QUANTITIES BY	
CHECKED BY	
ORIGINAL PLAN	
NOTE BOOK	
No.	

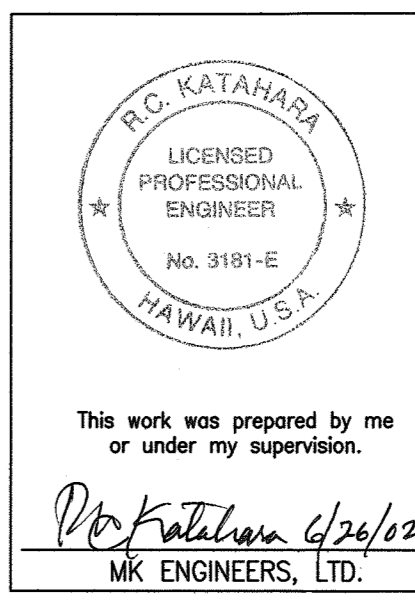

STATE OF HAWAII  
DEPARTMENT OF TRANSPORTATION  
HIGHWAYS DIVISION  
**PARTIAL ELECTRICAL DEMOLITION**  
**SITE PLAN - A**  
KANEIOHE BAY DRIVE IMPROVEMENTS  
Vicinity of Puohala Street to Kawa Bridge  
Federal Aid Project No. STP-065-119  
Scale: As Noted Date: June, 2002  
SHEET No. E-2 OF 10 SHEETS

"AS-BUILT"

FED. ROAD DIST. NO.	STATE	FED. AID PROJ. NO.	FISCAL YEAR	SHEET NO.	TOTAL SHEETS
HAWAII	HAW.	STP-065-1(9)	2002	100	114

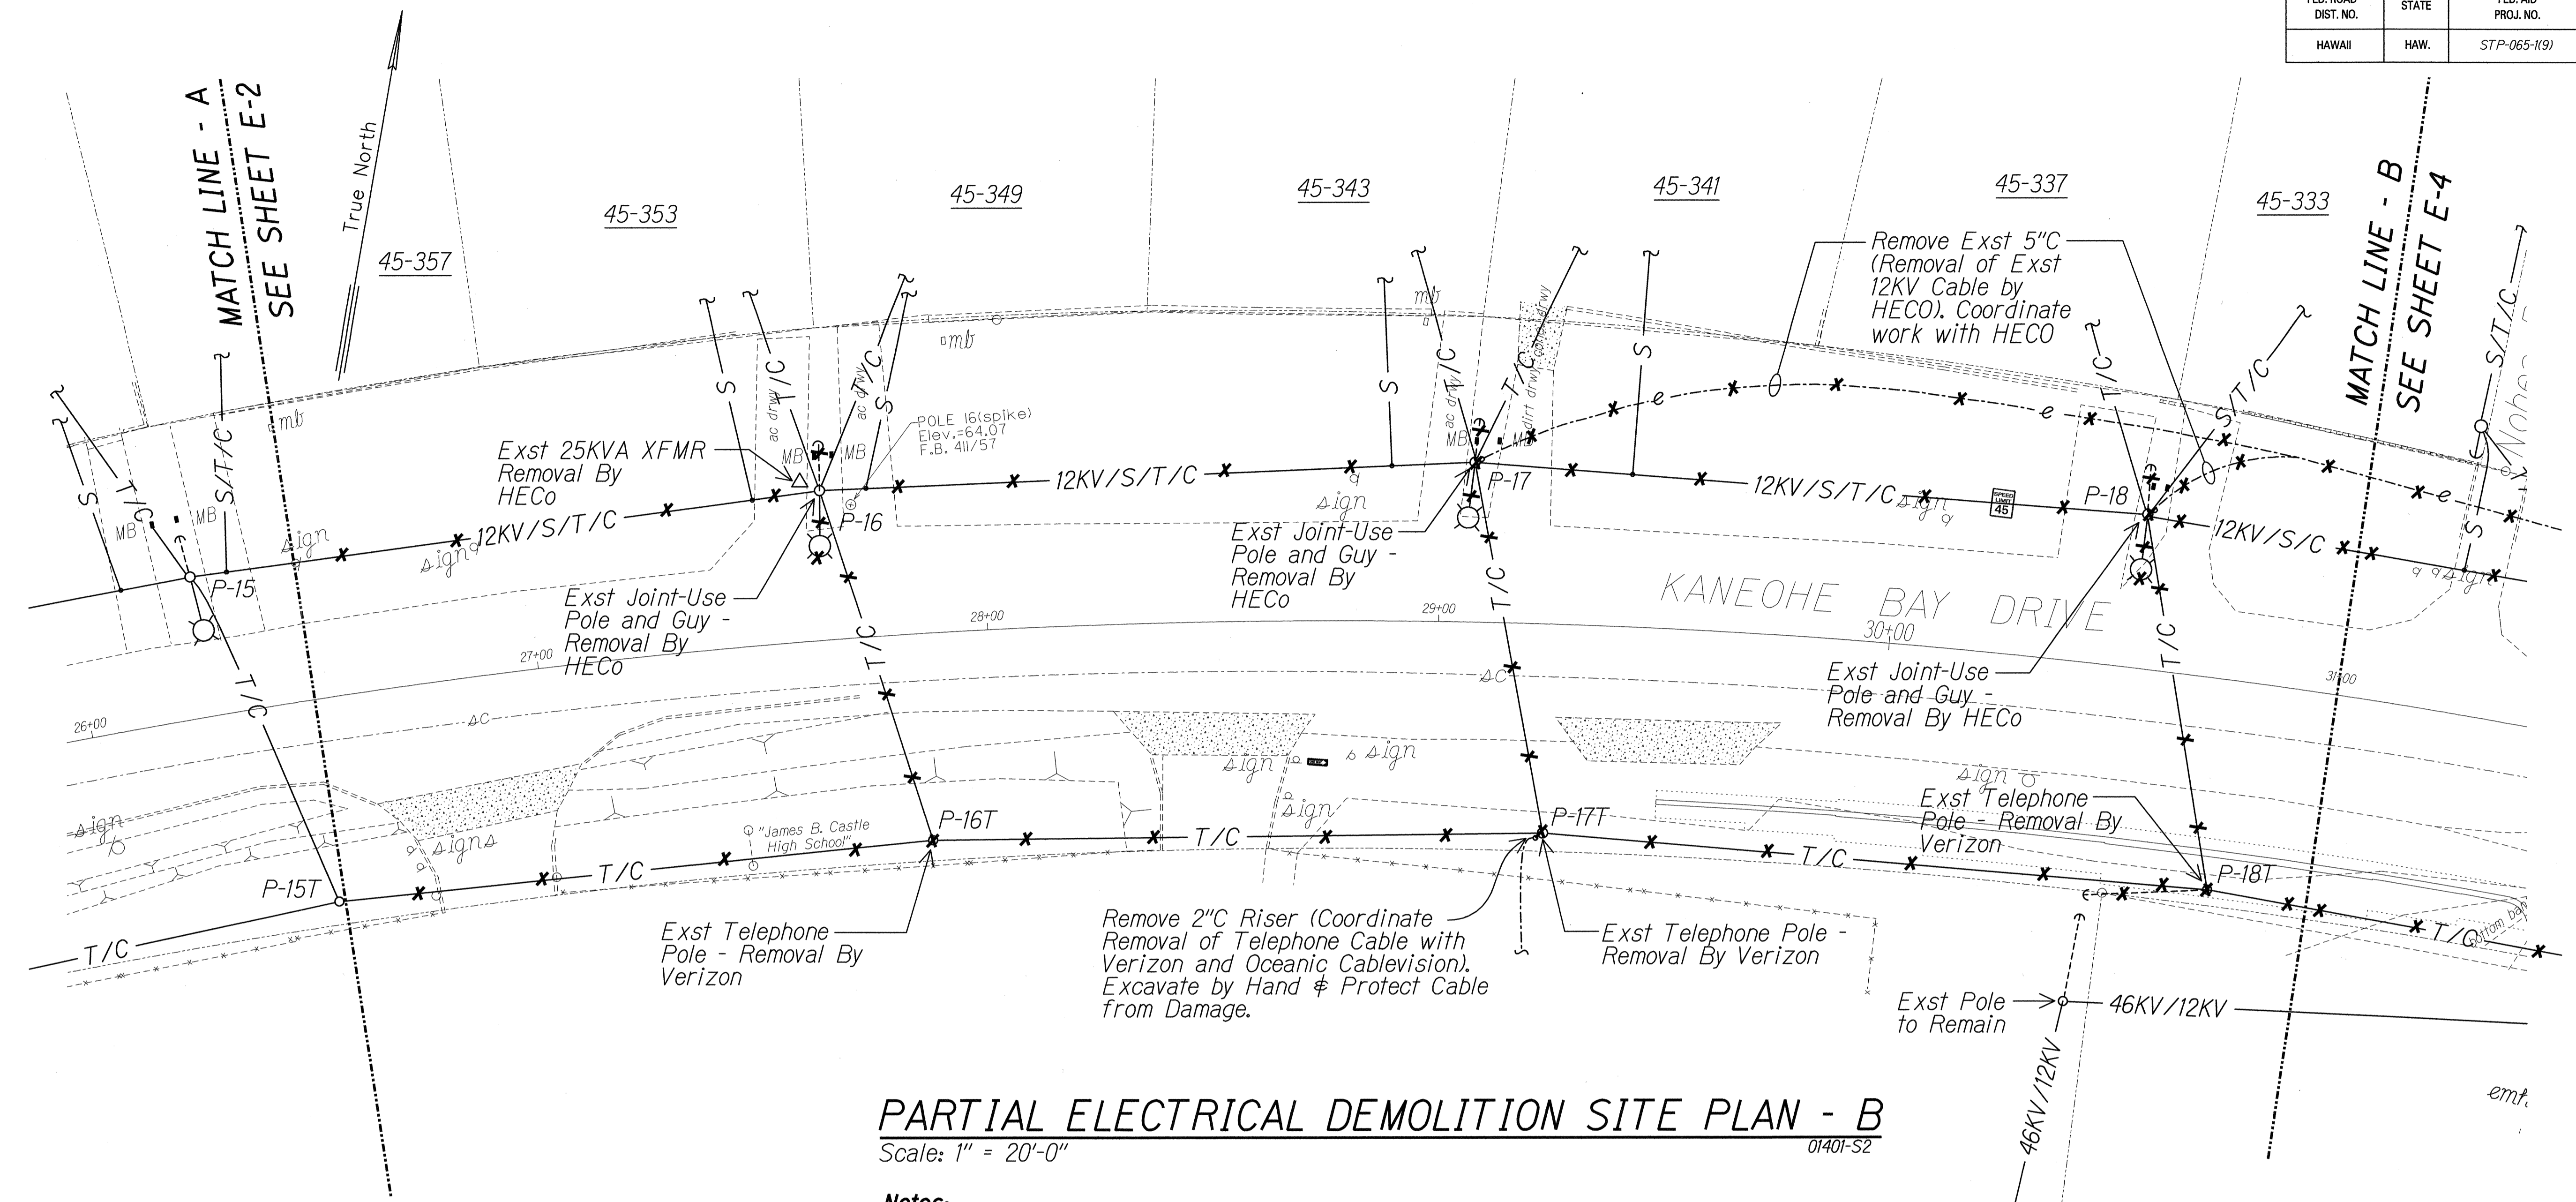


**PARTIAL ELECTRICAL DEMOLITION SITE PLAN - B**  
 Scale: 1" = 20'-0" 01401-S2

**Notes:**  
 1. Light Lines Denote Existing Condition.  
 *-*-* "X" Items Denote Removal Work.

SURVEY PLOTTED BY	DATE
DRAWN BY	
REVISIONS	
QUANTITIES BY	
CHECKED BY	
ORIGINAL PLAN	
NOTE BOOK	
No.	

**DRAWING REVIEW**  
 Reviewed for HECO's Facilities Only  
 Date 7/16/02 By *AKL*  
 Engineering Department  
 Hawaiian Electric Company, Inc.  
 HECO's review of these drawings shall in no way relieve the Customer, its Consultant, its Contractor or anyone acting on the Customer's behalf from the responsibility for engineering, design, materials and any other liability associated with this project.


APPROVED: *Ken M. Fee* 7/16/02  
 HAWAIIAN TELEPHONE COMPANY  
 VERIZON, INC.  
 APPROVED: *David D. ...* 07-16-02  
 OCEANIC CABLEVISION

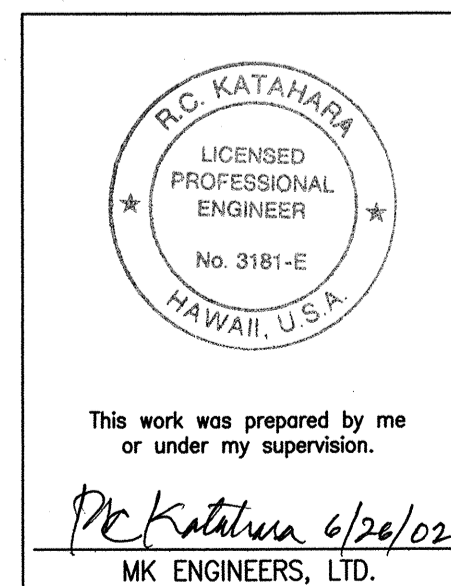

STATE OF HAWAII  
 DEPARTMENT OF TRANSPORTATION  
 HIGHWAYS DIVISION  
**PARTIAL ELECTRICAL DEMOLITION**  
**SITE PLAN - B**  
 KANEOHE BAY DRIVE IMPROVEMENTS  
 Vicinity of Puohala Street to Kawa Bridge  
 Federal Aid Project No. STP-065-1(9)  
 Date: June, 2002  
 Scale: As Noted  
 SHEET No. E-3 OF 10 SHEETS

m:\dgn\201401\101401-s2.dgn Jun. 26, 2002 06:45:30

FED. ROAD DIST. NO.	STATE	FED. AID PROJ. NO.	FISCAL YEAR	SHEET NO.	TOTAL SHEETS
HAWAII	HAW.	STP-065-1(9)	2002	101	114

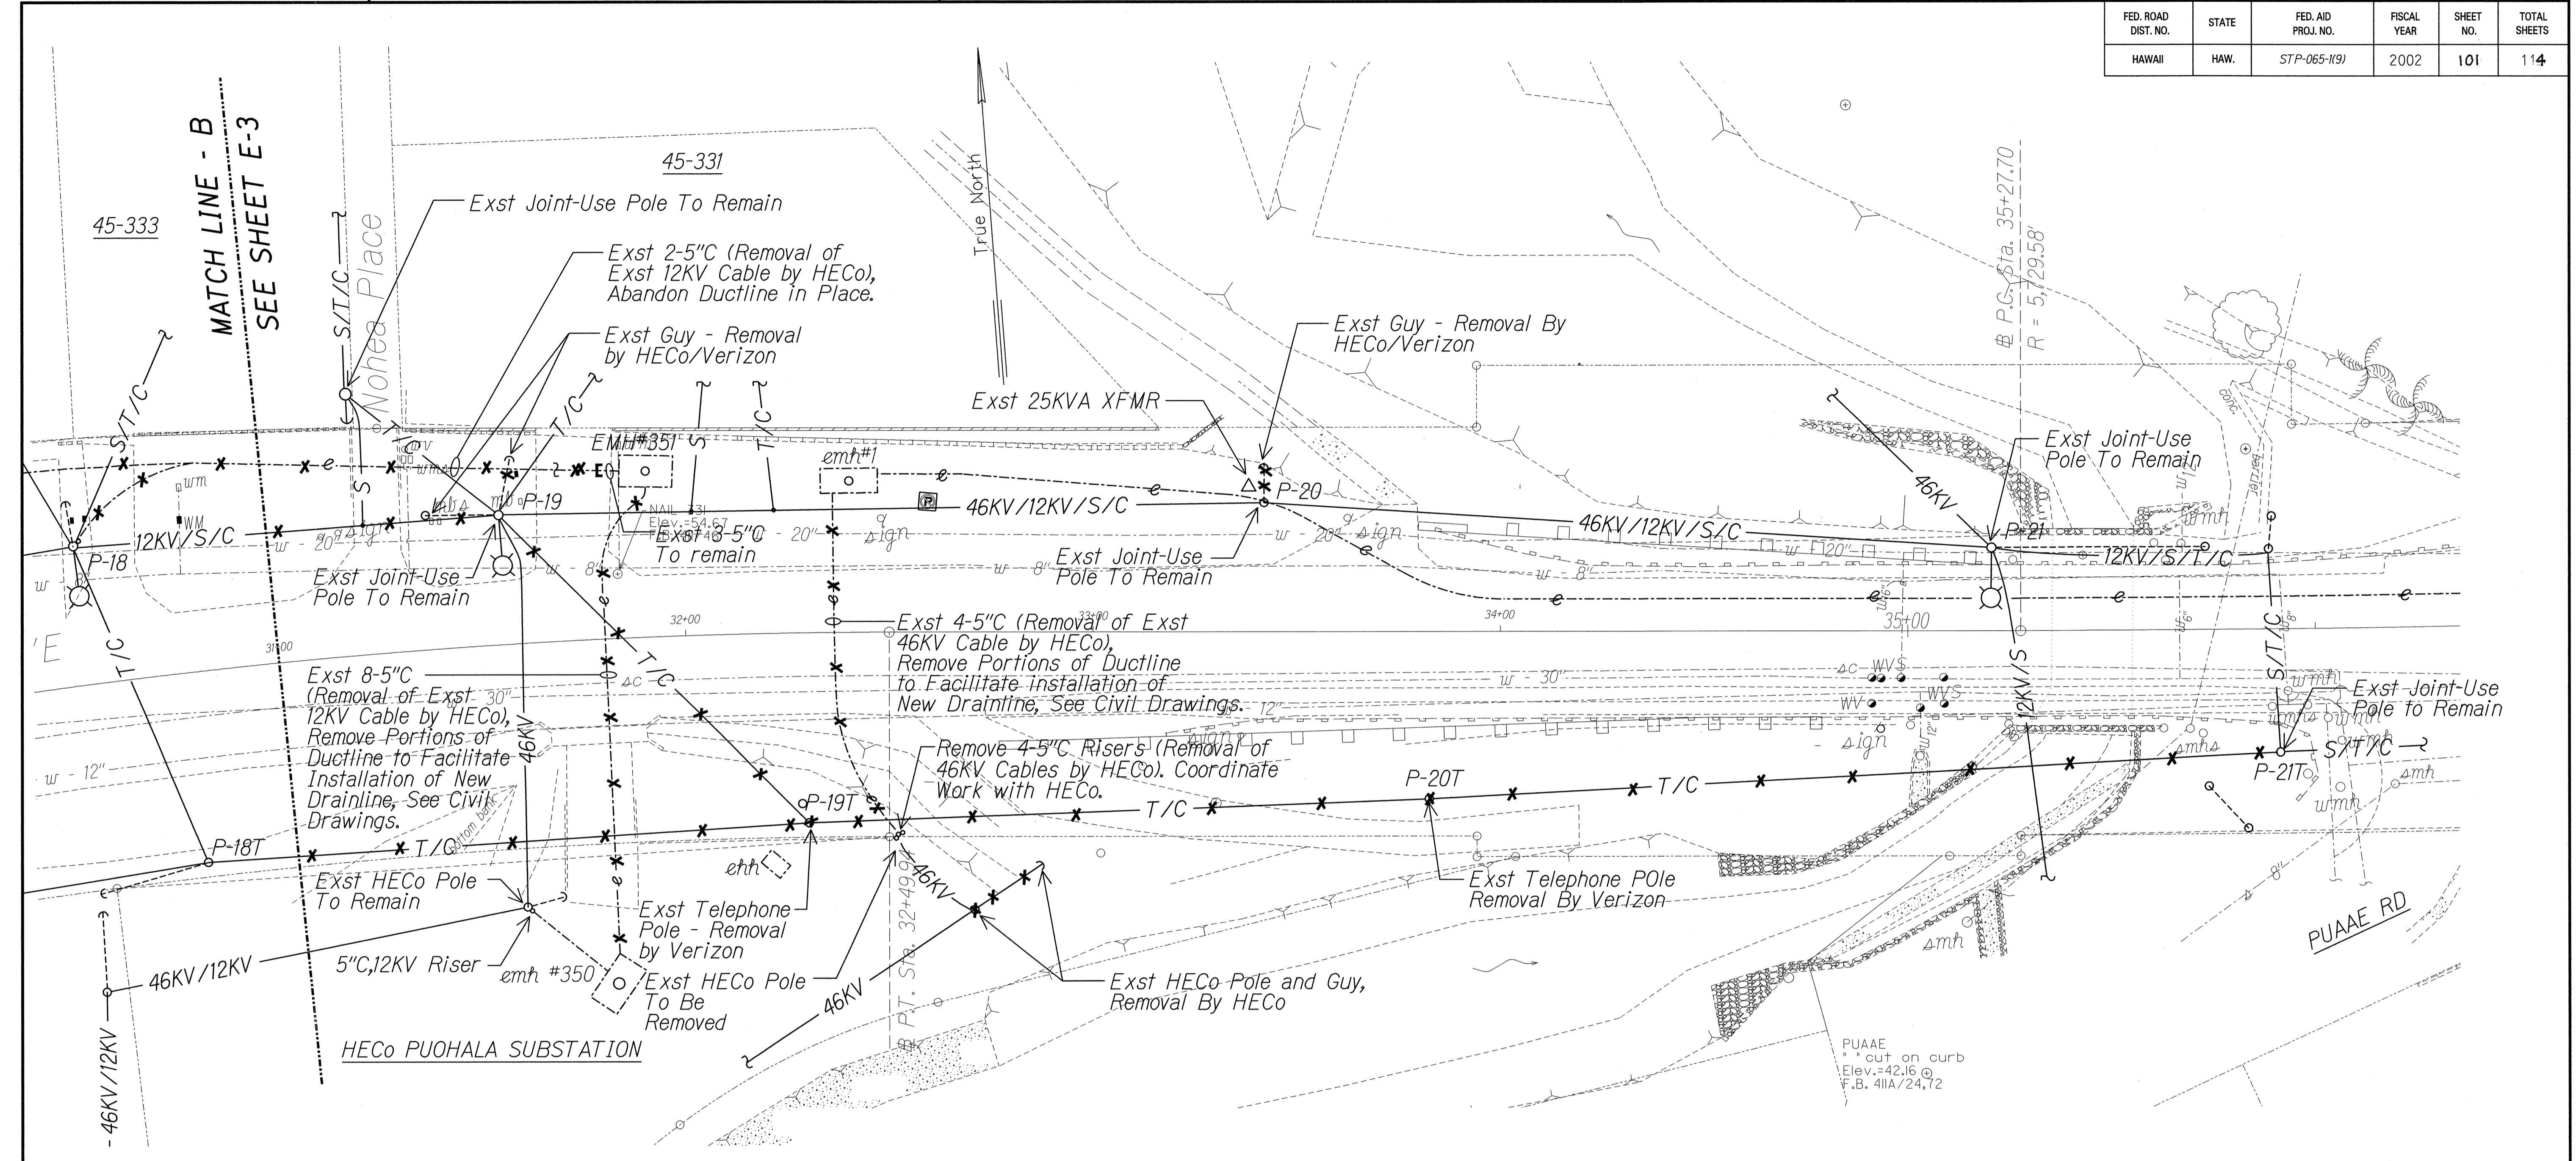


**PARTIAL ELECTRICAL DEMOLITION SITE PLAN - C**  
 Scale: 1" = 20'-0"  
 01401-S3

**Notes:**  
 1. ——— Light Lines Denote Existing Condition.  
 * * * "x" Items Denote Removal Work.

SURVEY PLOTTED BY	DATE
DRAWN BY	
DESIGNED BY	
QUANTITIES BY	
CHECKED BY	
NOTE BOOK No.	


**DRAWING REVIEW**  
 Reviewed for HECO's Facilities Only  
 Date 7/18/02 By [Signature]  
 Engineering Department  
 Hawaiian Electric Company, Inc.  
HECO's review of these drawings shall in no way relieve the Customer, its Consultant, its Contractor or anyone acting on the Customer's behalf from the responsibility for engineering, design, materials and any other liability associated with this project.

APPROVED: [Signature] DATE 7/22/02  
 HAWAIIAN TELEPHONE COMPANY  
 VERIZON HAWAII, INC.  
 APPROVED: [Signature] DATE 07-20-02  
 OCEANIC CABLEVISION

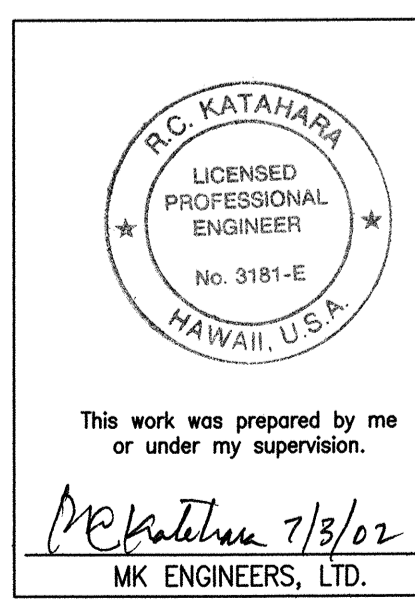

STATE OF HAWAII  
 DEPARTMENT OF TRANSPORTATION  
 HIGHWAYS DIVISION  
**PARTIAL ELECTRICAL DEMOLITION**  
**SITE PLAN - C**  
 KANEOHE BAY DRIVE IMPROVEMENTS  
 Vicinity of Puohala Street to Kawa Bridge  
 Federal Aid Project No. STP-065-1(9)  
 Scale: As Noted Date: June, 2002  
 SHEET No. E-4 OF 10 SHEETS

FED. ROAD DIST. NO.	STATE	FED. AID PROJ. NO.	FISCAL YEAR	SHEET NO.	TOTAL SHEETS
HAWAII	HAW.	STP-065-1191	2002	102	114

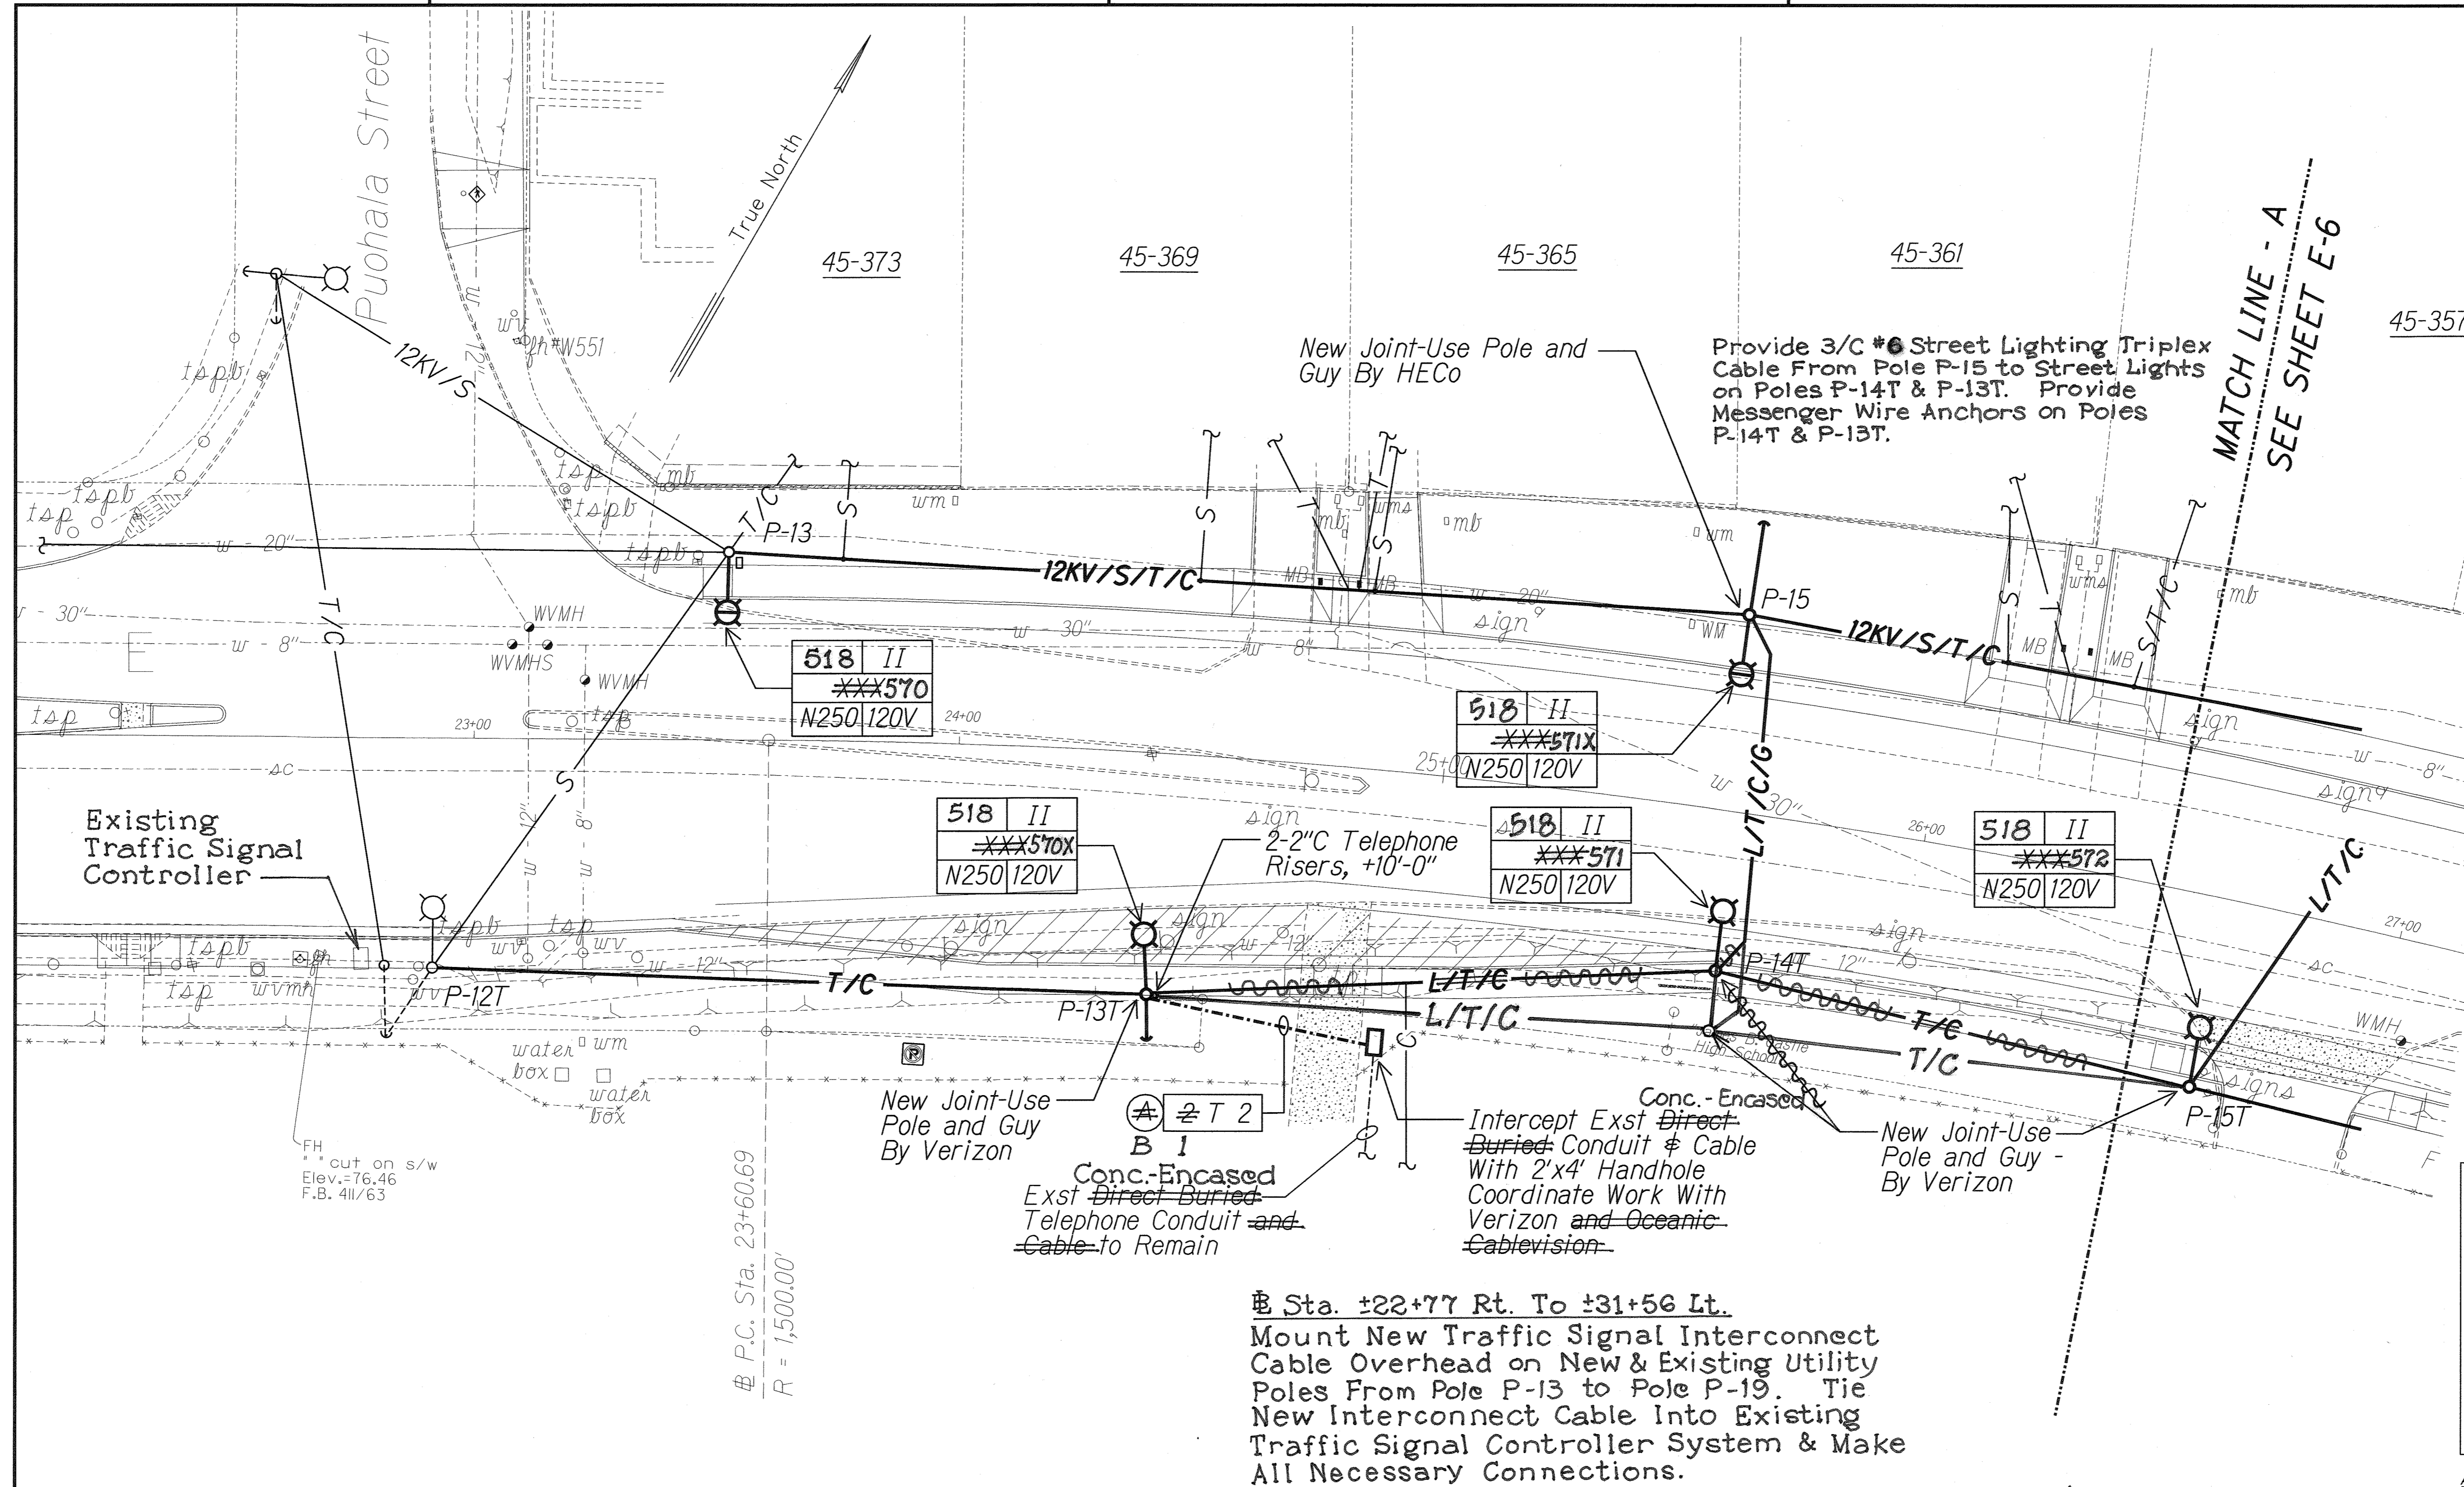

MATCH LINE - A  
SEE SHEET E-6

**DRAWING REVIEW**  
Reviewed for HECO's Facilities Only  
Date 7/18/02 By *AKH*  
Engineering Department  
Hawaiian Electric Company, Inc.

HECO's review of these drawings shall in no way relieve the Customer, its Consultant, its Contractor or anyone acting on the Customer's behalf from the responsibility for engineering, design, materials and any other liability associated with this project.

APPROVED: *[Signature]* 7/22/02  
HAWAIIAN TELEPHONE COMPANY  
VERIZON HAWAII INC. DATE

APPROVED: *[Signature]* 07-26-02  
OCEANIC CABLEVISION DATE

**PARTIAL NEW ELECTRICAL SITE PLAN - A**  
Scale: 1" = 20'-0" 01401-S4

**Notes:**  
1. Light Lines Denote Existing Condition.  
2. **Bold Lines** Denote New Work.

SURVEY PLOTTED BY	DATE
DRAWN BY	
DESIGNED BY	
CHECKED BY	
NOTE BOOK	
No.	

This work was prepared by me or under my supervision.  
*R.C. KATAHARA*  
MK ENGINEERS, LTD.

STATE OF HAWAII  
DEPARTMENT OF TRANSPORTATION  
HIGHWAYS DIVISION

**PARTIAL NEW ELECTRICAL SITE PLAN - A**


Kaneohe Bay Drive Improvements  
Vicinity of Puohala Street to Kawa Bridge  
Federal Aid Project No. STP-065-1191

Scale: As Noted Date: June, 2002

SHEET No. E-5 OF 10 SHEETS

**"AS-BUILT"**

FED. ROAD DIST. NO.	STATE	FED. AID PROJ. NO.	FISCAL YEAR	SHEET NO.	TOTAL SHEETS
HAWAII	HAW.	STP-065-1(9)	2002	C.O. 103	112

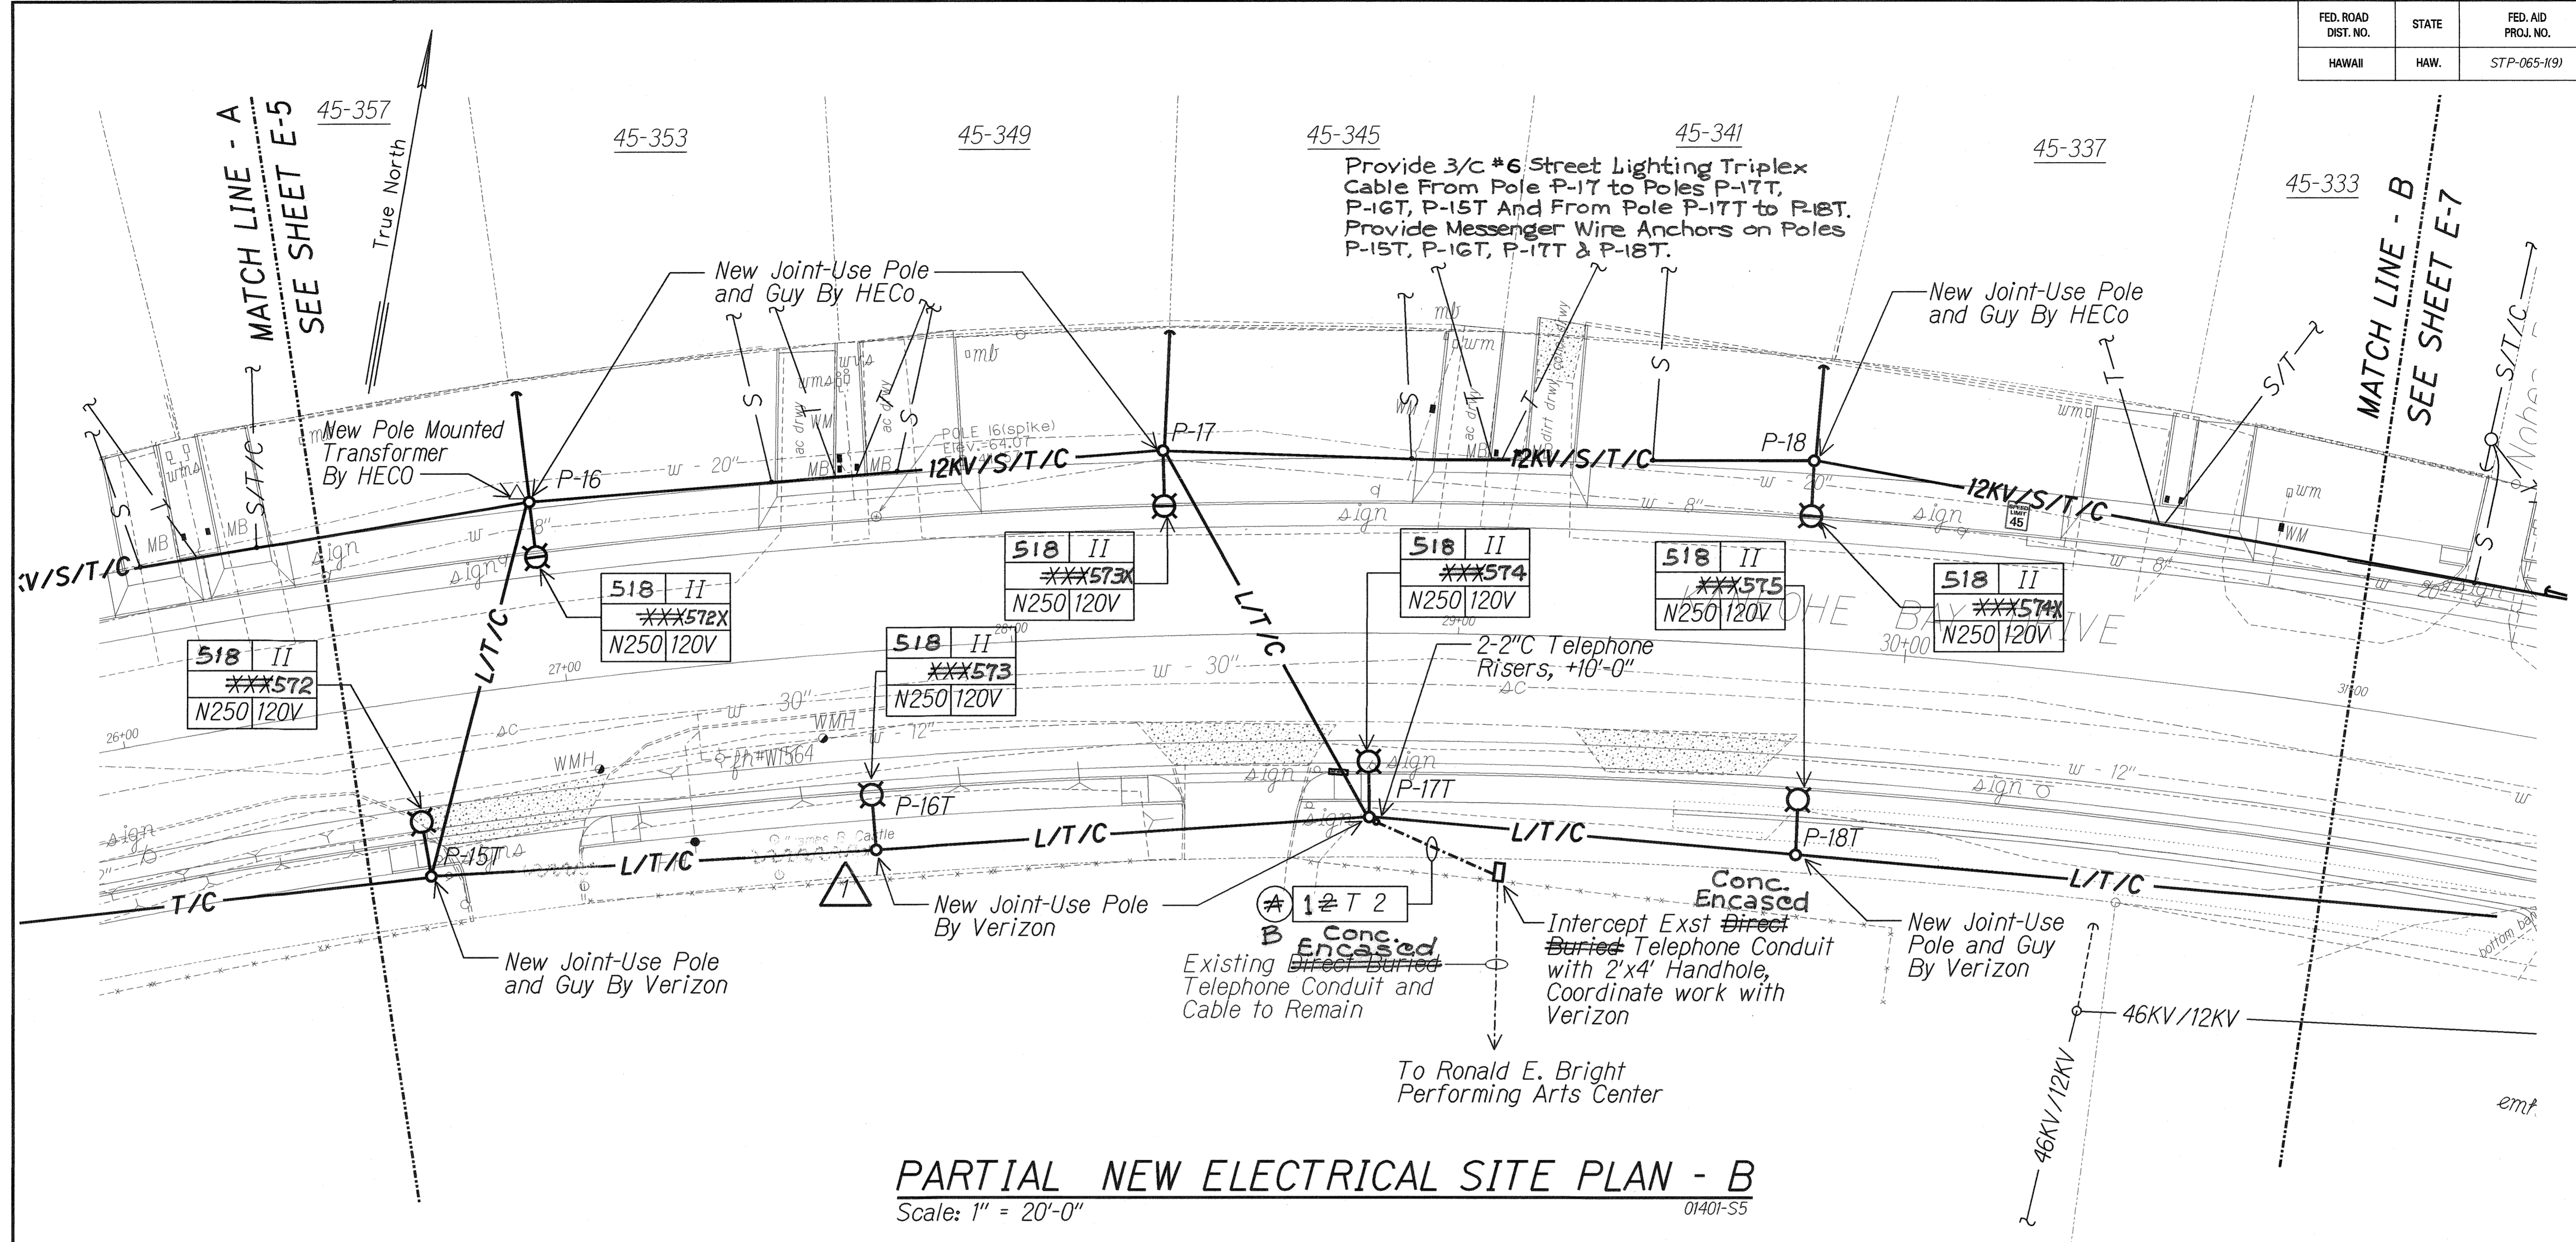

**PARTIAL NEW ELECTRICAL SITE PLAN - B**

Scale: 1" = 20'-0" 01401-S5

- Notes:**
- Light Lines Denote Existing Condition.
  - Bold Lines Denote New Work.

Sta. ±22+77 Rt. To ±31+56 Lt.  
Mount New Traffic Signal Interconnect Cable Overhead on New & Existing Utility Poles From Pole P-13 to Pole P-19.

SURVEY PLOTTED BY	DATE
DRAWN BY	
DESIGNED BY	
CHECKED BY	
NOTE BOOK	
No.	

**DRAWING REVIEW**

Reviewed for HECO's Facilities Only

Date 10/7/03 By *[Signature]*

Engineering Department  
Hawaiian Electric Company, Inc.

HECO's review of these drawings shall in no way relieve the Customer, its Consultant, its Contractor or anyone acting on the Customer's behalf from the responsibility for engineering, design, materials and any other liability associated with this project.

APPROVED: *[Signature]* 10/2/03  
DATE

APPROVED: *[Signature]* 10/14/03  
DATE

OCEANIC CABLEVISION

1	9-26-03	Revised Joint-Use Pole Location Per Verizon Hawaii
Date		Revision

STATE OF HAWAII  
DEPARTMENT OF TRANSPORTATION  
HIGHWAYS DIVISION

**PARTIAL NEW ELECTRICAL SITE PLAN - B**

KANEOHE BAY DRIVE IMPROVEMENTS  
Vicinity of Puhala Street to Kawa Bridge  
Federal Aid Project No. STP-065-1(9)


Scale: As Noted Date: June, 2002

SHEET No. C.O. E-6 OF 10 SHEETS

**"AS-BUILT"**




FED. ROAD DIST. NO.	STATE	FED. AID PROJ. NO.	FISCAL YEAR	SHEET NO.	TOTAL SHEETS
HAWAII	HAW.	STP-065-1(9)	2002	105	114

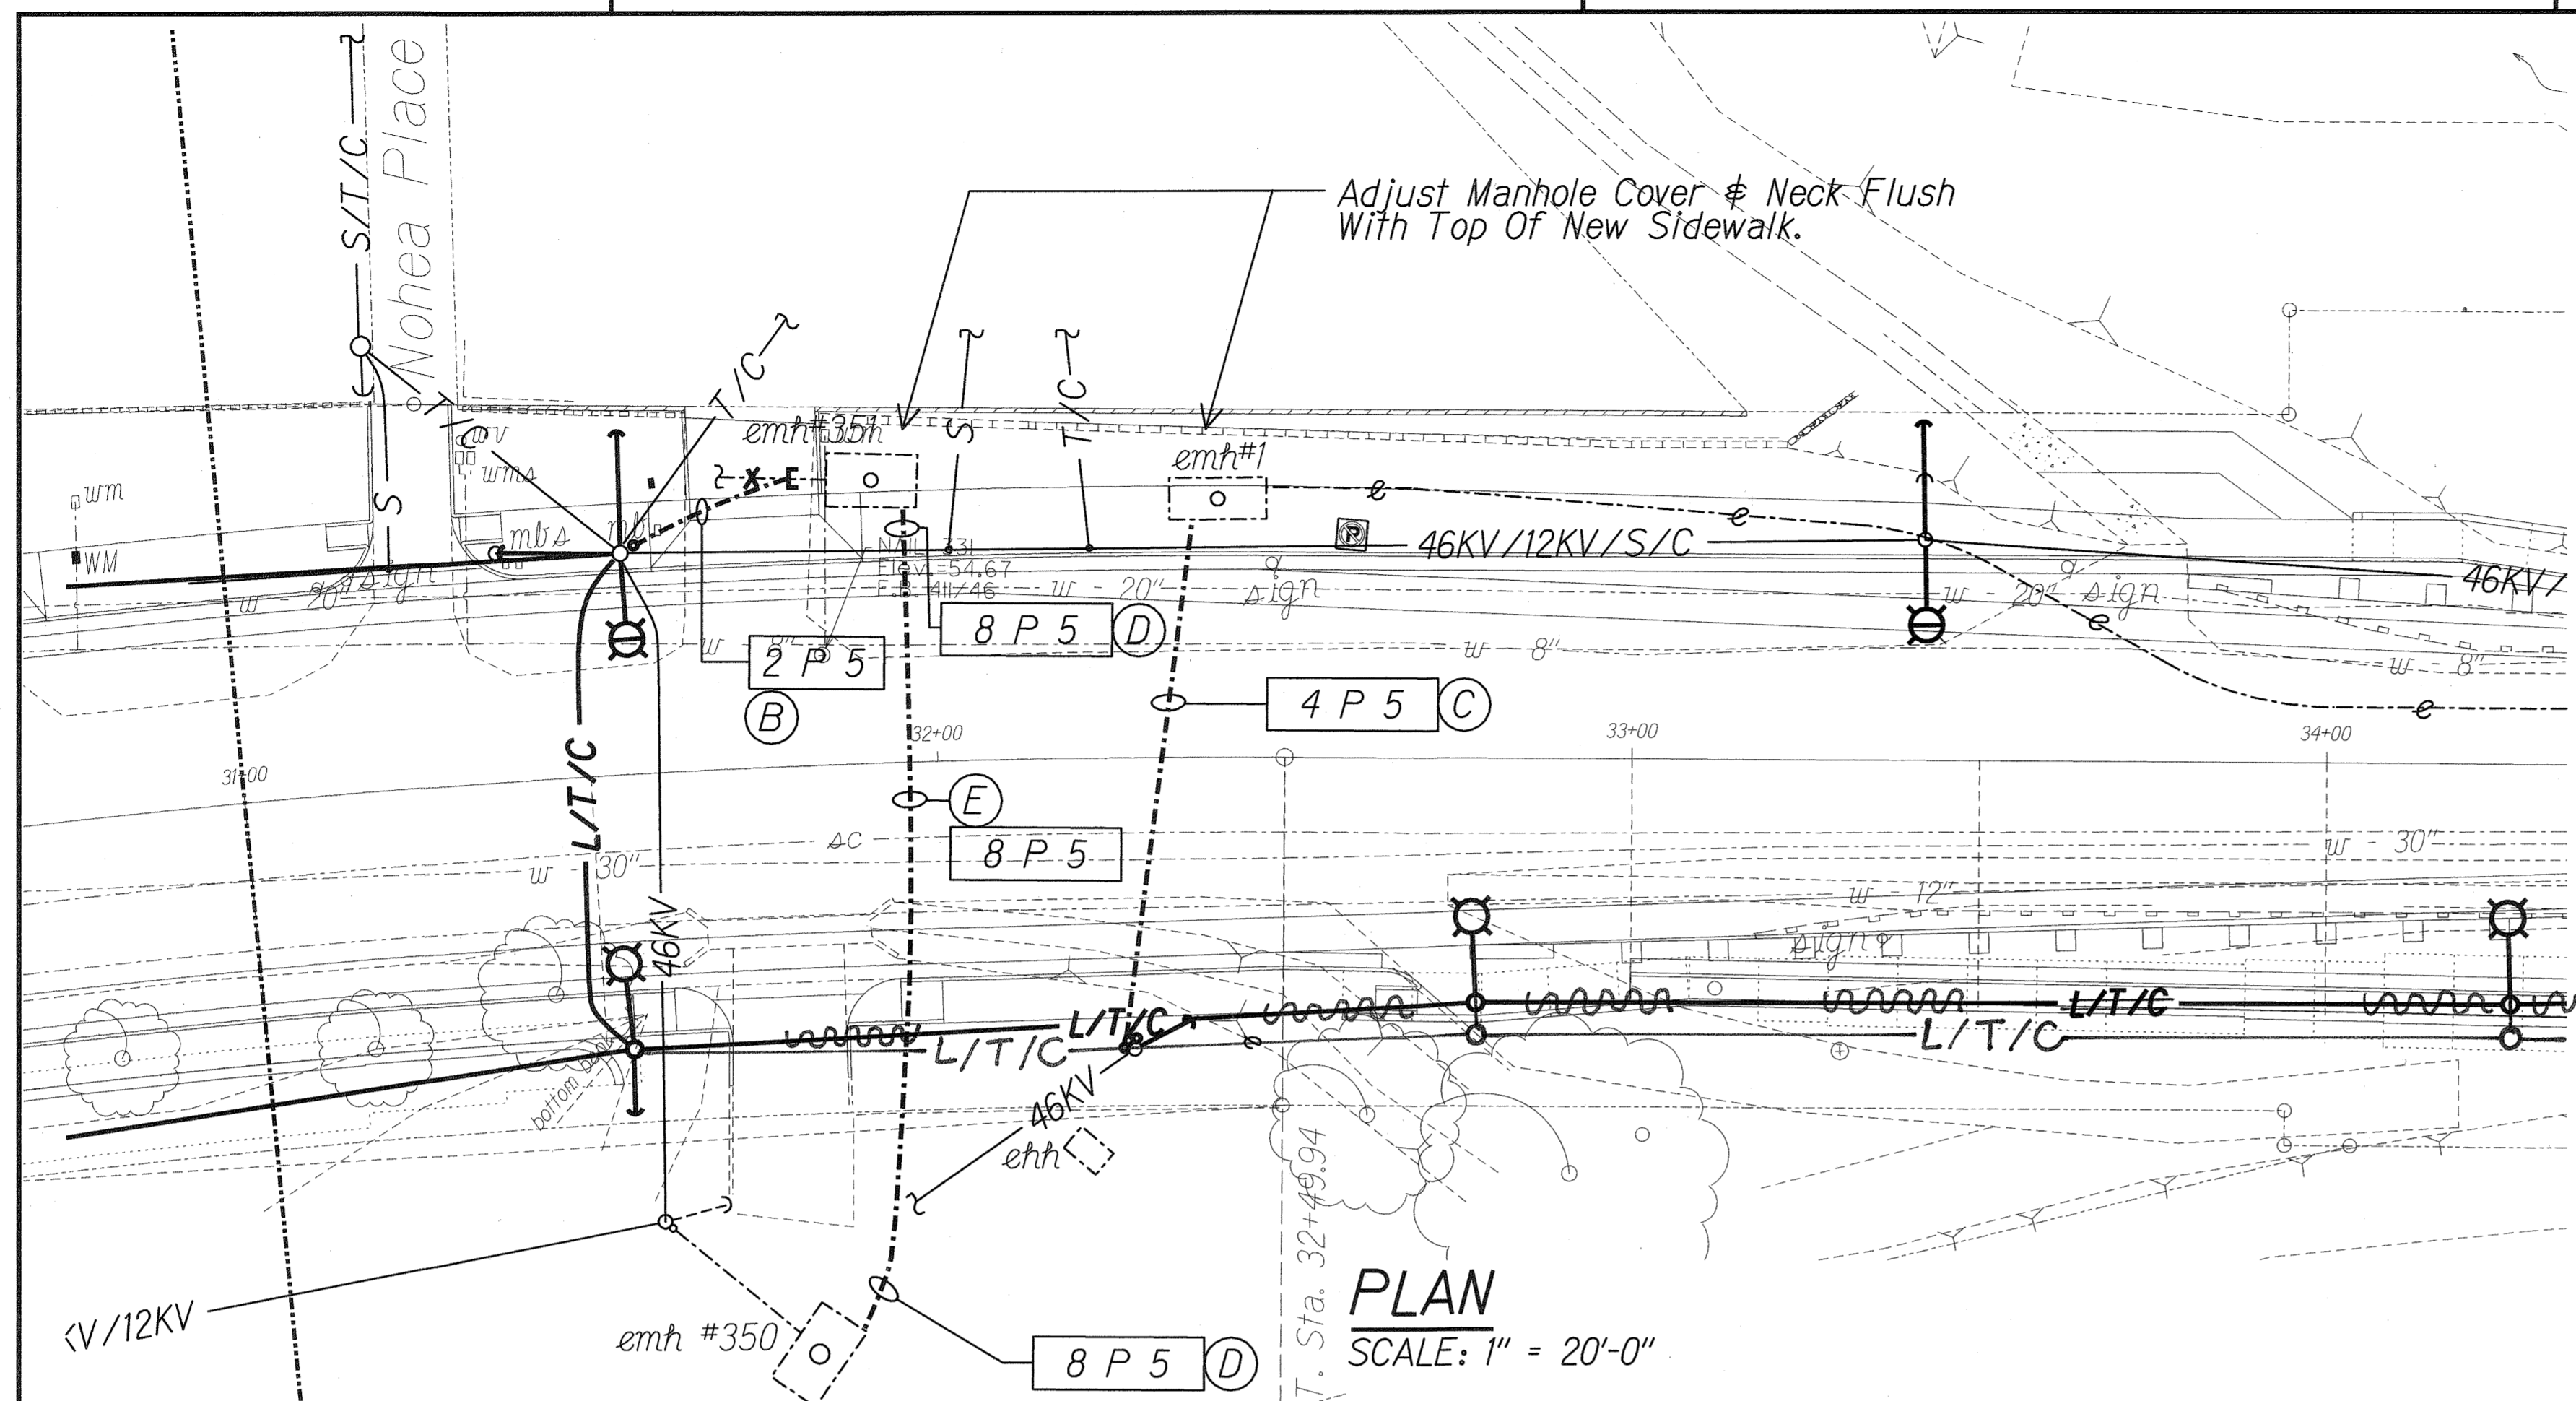

**PLAN**  
SCALE: 1" = 20'-0"

**Notes:**  
1. Reference HECO Std #30-1020, Figure 2 for Detail of Duct Roll Sections.


**DRAWING REVIEW**  
Reviewed for HECO's Facilities Only  
Date 1/8/02 By *[Signature]*  
Engineering Department  
Hawaiian Electric Company, Inc.  
HECO's review of these drawings shall in no way relieve the Customer, its Consultant, its Contractor or anyone acting on the Customer's behalf from the responsibility for engineering, design, materials and any other liability associated with this project.

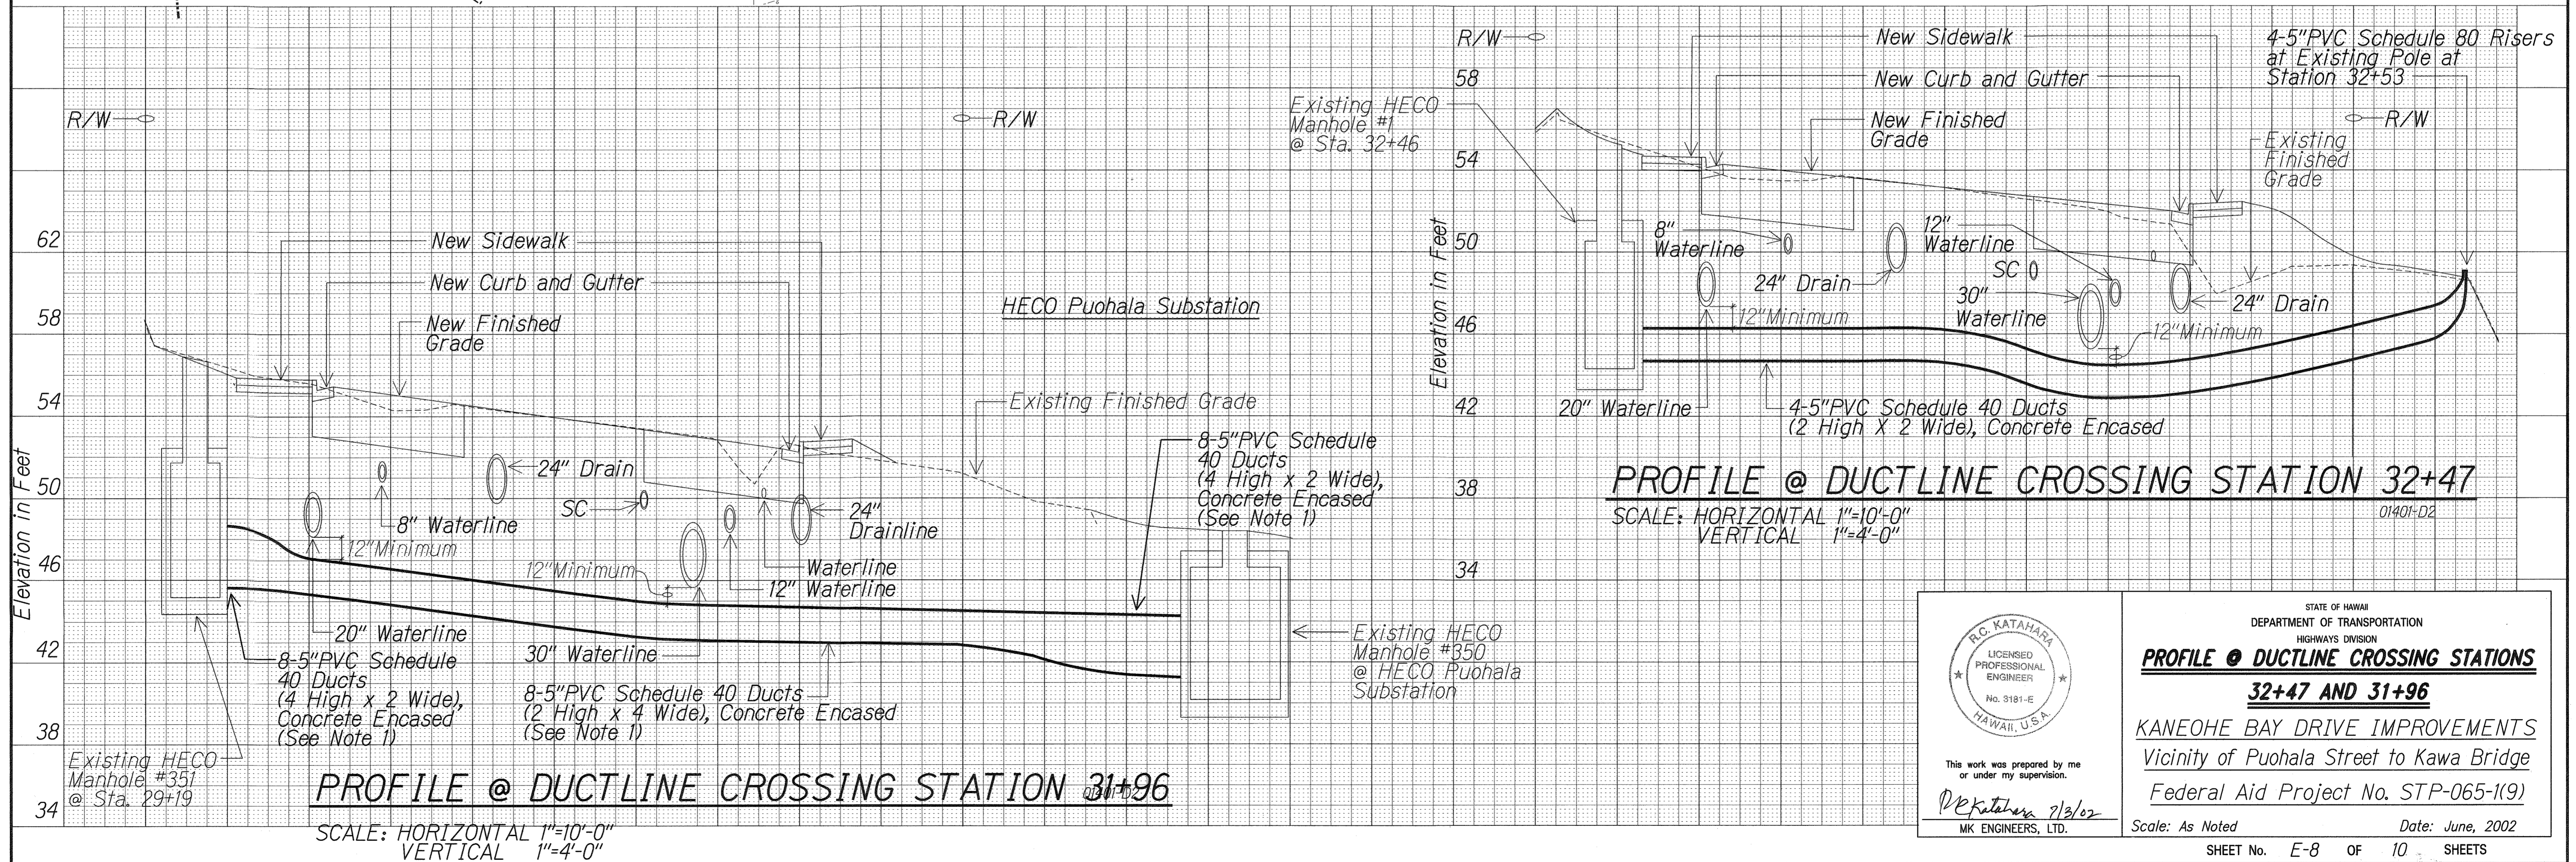

**PROFILE @ DUCTLINE CROSSING STATION 31+96**  
SCALE: HORIZONTAL 1"=10'-0"  
VERTICAL 1"=4'-0"

**PROFILE @ DUCTLINE CROSSING STATION 32+47**  
SCALE: HORIZONTAL 1"=10'-0"  
VERTICAL 1"=4'-0"

SURVEY PLOTTED BY	DATE
DRAWN BY	
DESIGNED BY	
QUANTITIES BY	
CHECKED BY	
ORIGINAL PLAN	
NOTE BOOK	
No.	

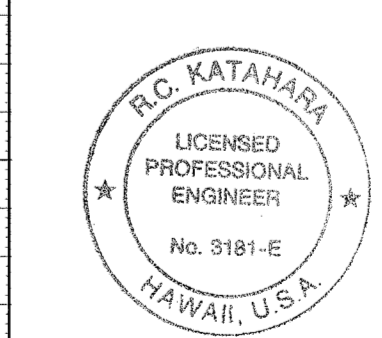


This work was prepared by me or under my supervision.  
*[Signature]*  
MK ENGINEERS, LTD.

STATE OF HAWAII  
DEPARTMENT OF TRANSPORTATION  
HIGHWAYS DIVISION  
**PROFILE @ DUCTLINE CROSSING STATIONS**  
**32+47 AND 31+96**  
KANEHOE BAY DRIVE IMPROVEMENTS  
Vicinity of Puohala Street to Kawa Bridge  
Federal Aid Project No. STP-065-1(9)  
Scale: As Noted Date: June, 2002  
SHEET No. E-8 OF 10 SHEETS


**"AS-BUILT"**




FED. ROAD DIST. NO.	STATE	FED. AID PROJ. NO.	FISCAL YEAR	SHEET NO.	TOTAL SHEETS
HAWAII	HAW.	STP-065-1(9)	2002	107	114

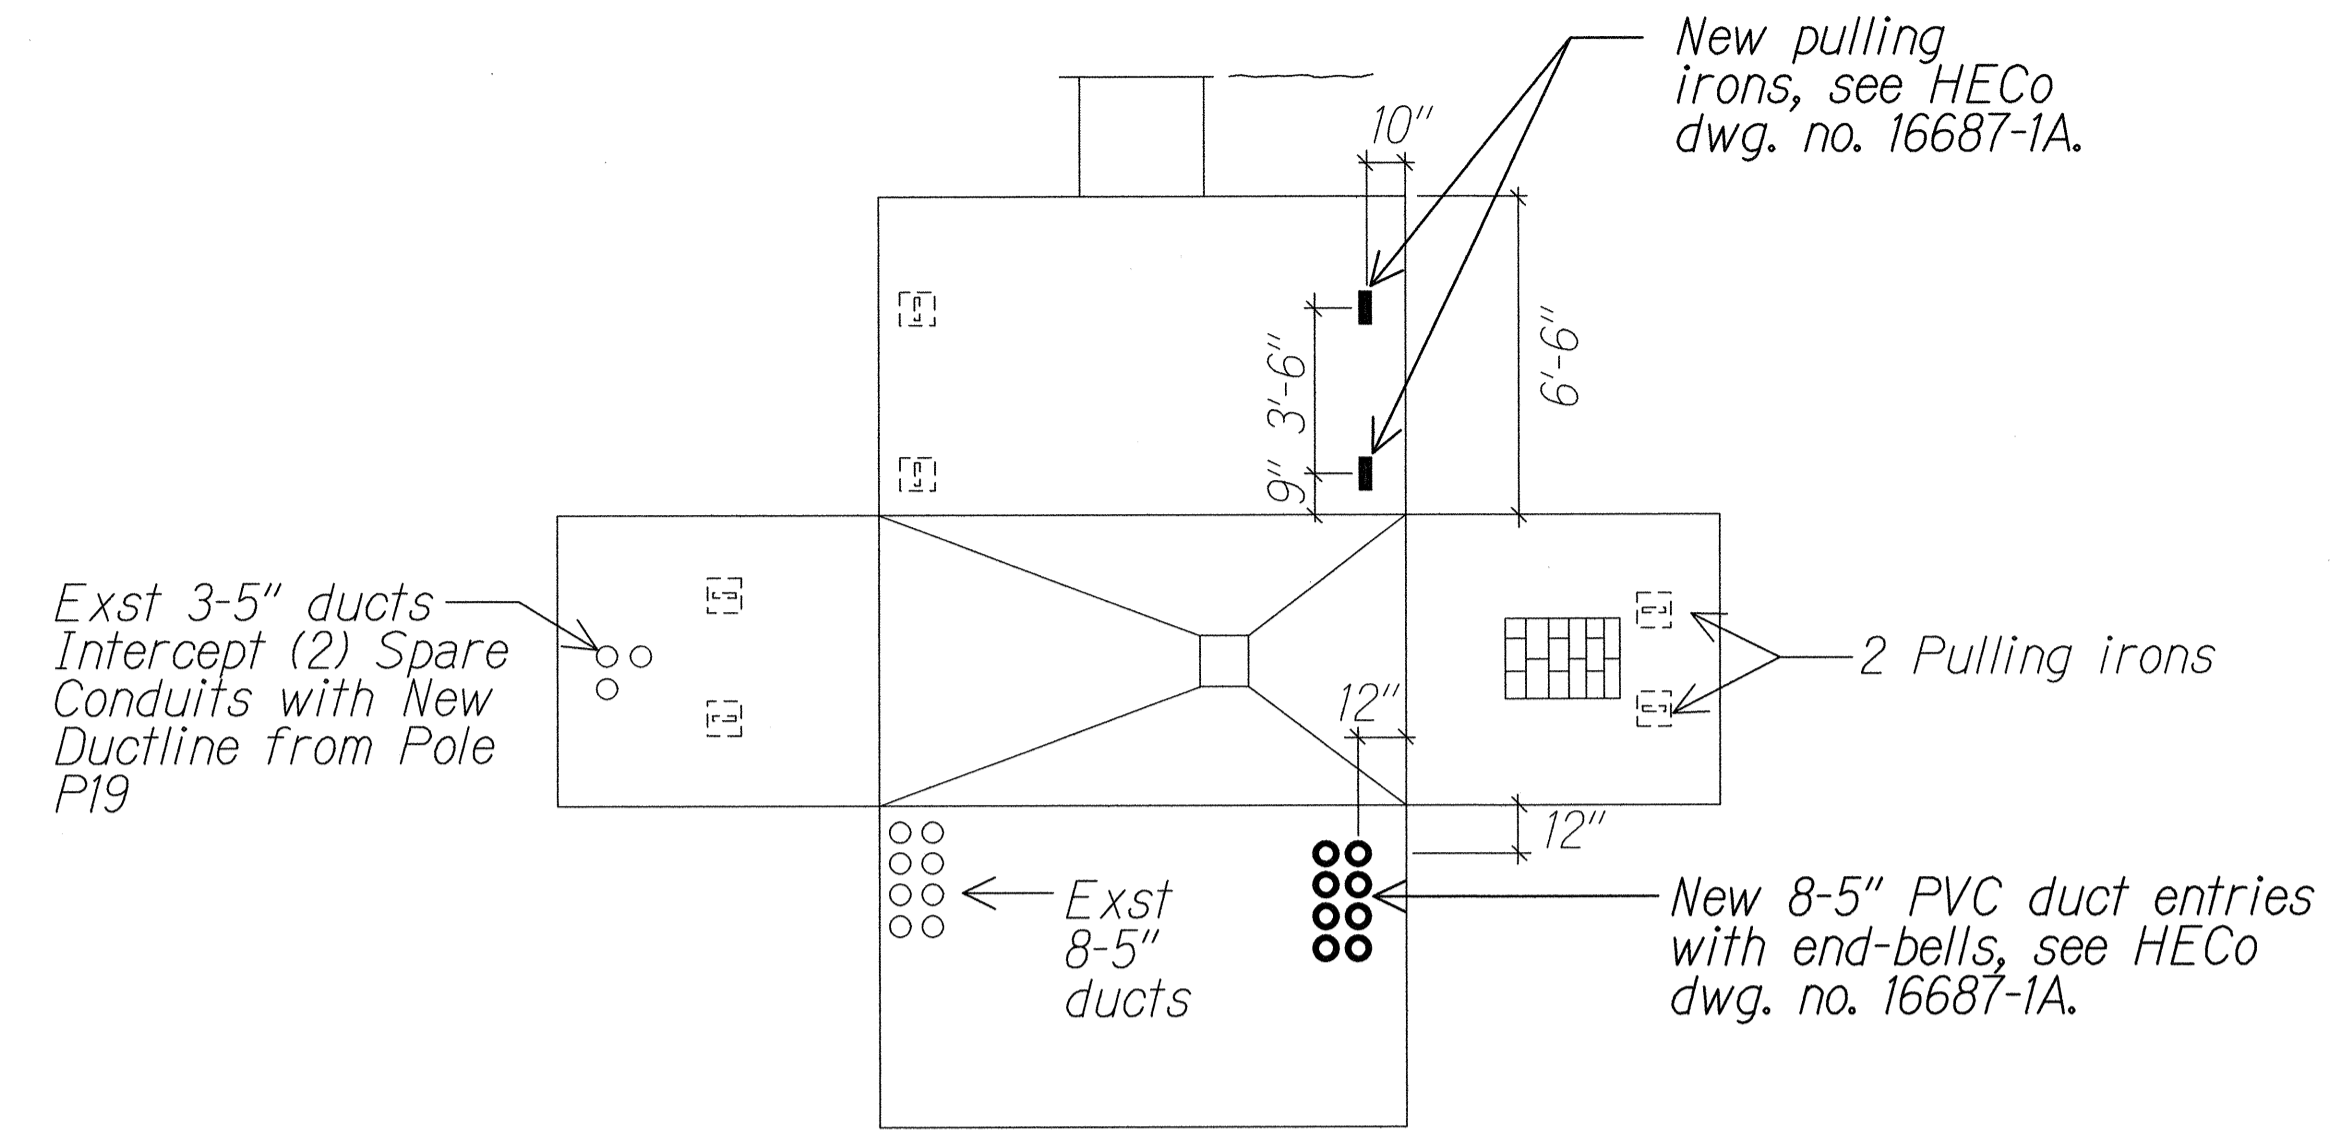

**ELECTRICAL MANHOLE #351**  
 Scale: 1/4" = 1'-0" 01401-D4

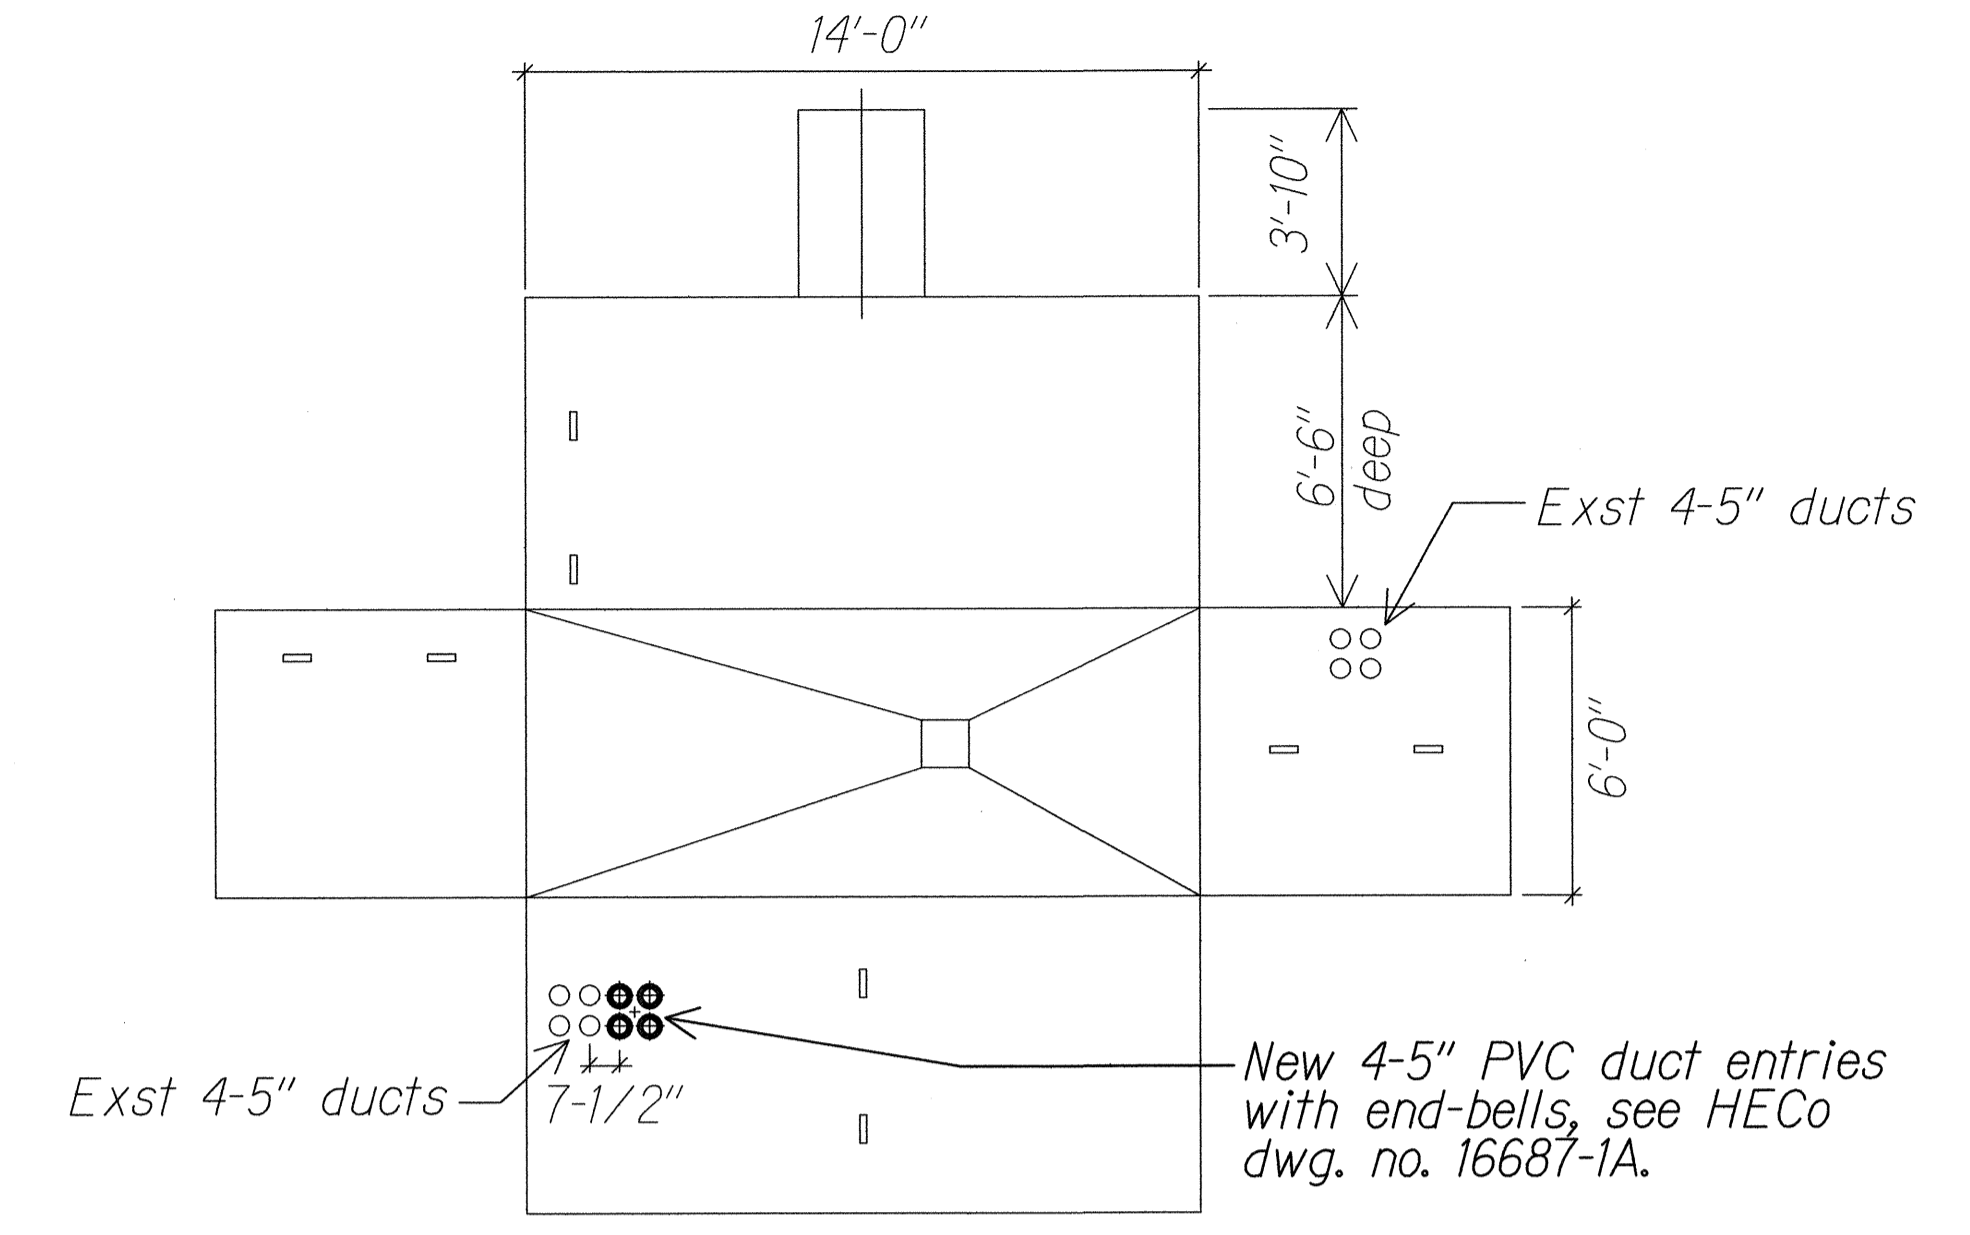

**ELECTRICAL MANHOLE #1**  
 Scale: 1/4" = 1'-0"

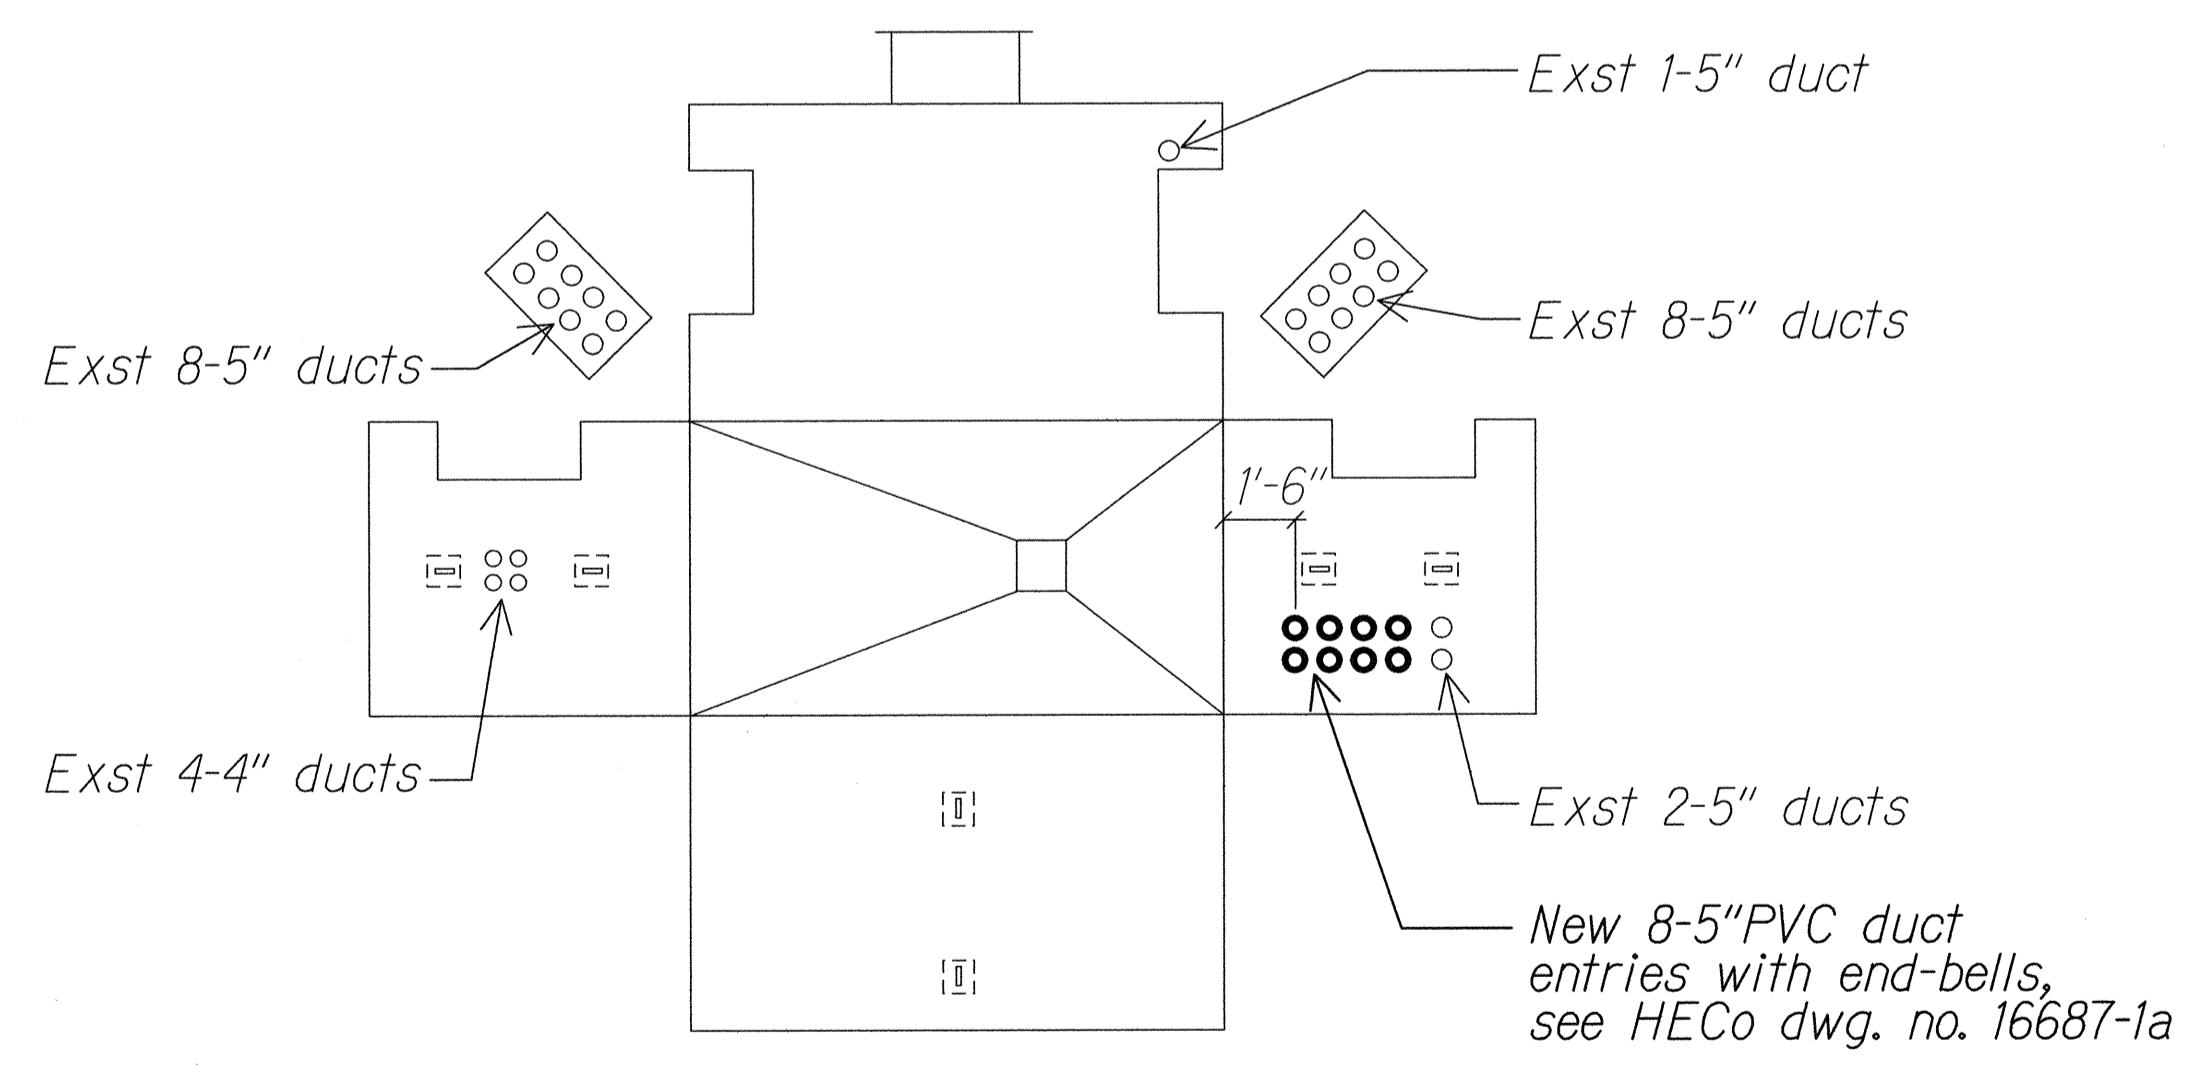

**ELECTRICAL MANHOLE #350**  
 Scale: 1/4" = 1'-0"

SURVEY PLOTTED BY	DATE
DRAWN BY	
CHECKED BY	
QUANTITIES BY	
CHECKED BY	
ORIGINAL PLAN	
NOTE BOOK	
No.	

**DRAWING REVIEW**  
 Reviewed for HECO's Facilities Only  
 Date 7/18/02 By *[Signature]*  
 Engineering Department  
 Hawaiian Electric Company, Inc.

HECO's review of these drawings shall in no way relieve the Customer, its Consultant, its Contractor or anyone acting on the Customer's behalf from the responsibility for engineering, design, materials and any other liability associated with this project.

This work was prepared by me or under my supervision.  
*[Signature]*  
 MK ENGINEERS, LTD.

STATE OF HAWAII  
 DEPARTMENT OF TRANSPORTATION  
 HIGHWAYS DIVISION  
**ELECTRICAL MANHOLE DEVELOPMENT DETAILS**  
 KANEHOE BAY DRIVE IMPROVEMENTS  
 Vicinity of Puohala Street to Kawa Bridge  
 Federal Aid Project No. STP-065-1(9)  
 Scale: As Noted Date: June, 2002  
 SHEET No. E-10 OF 10 SHEETS