
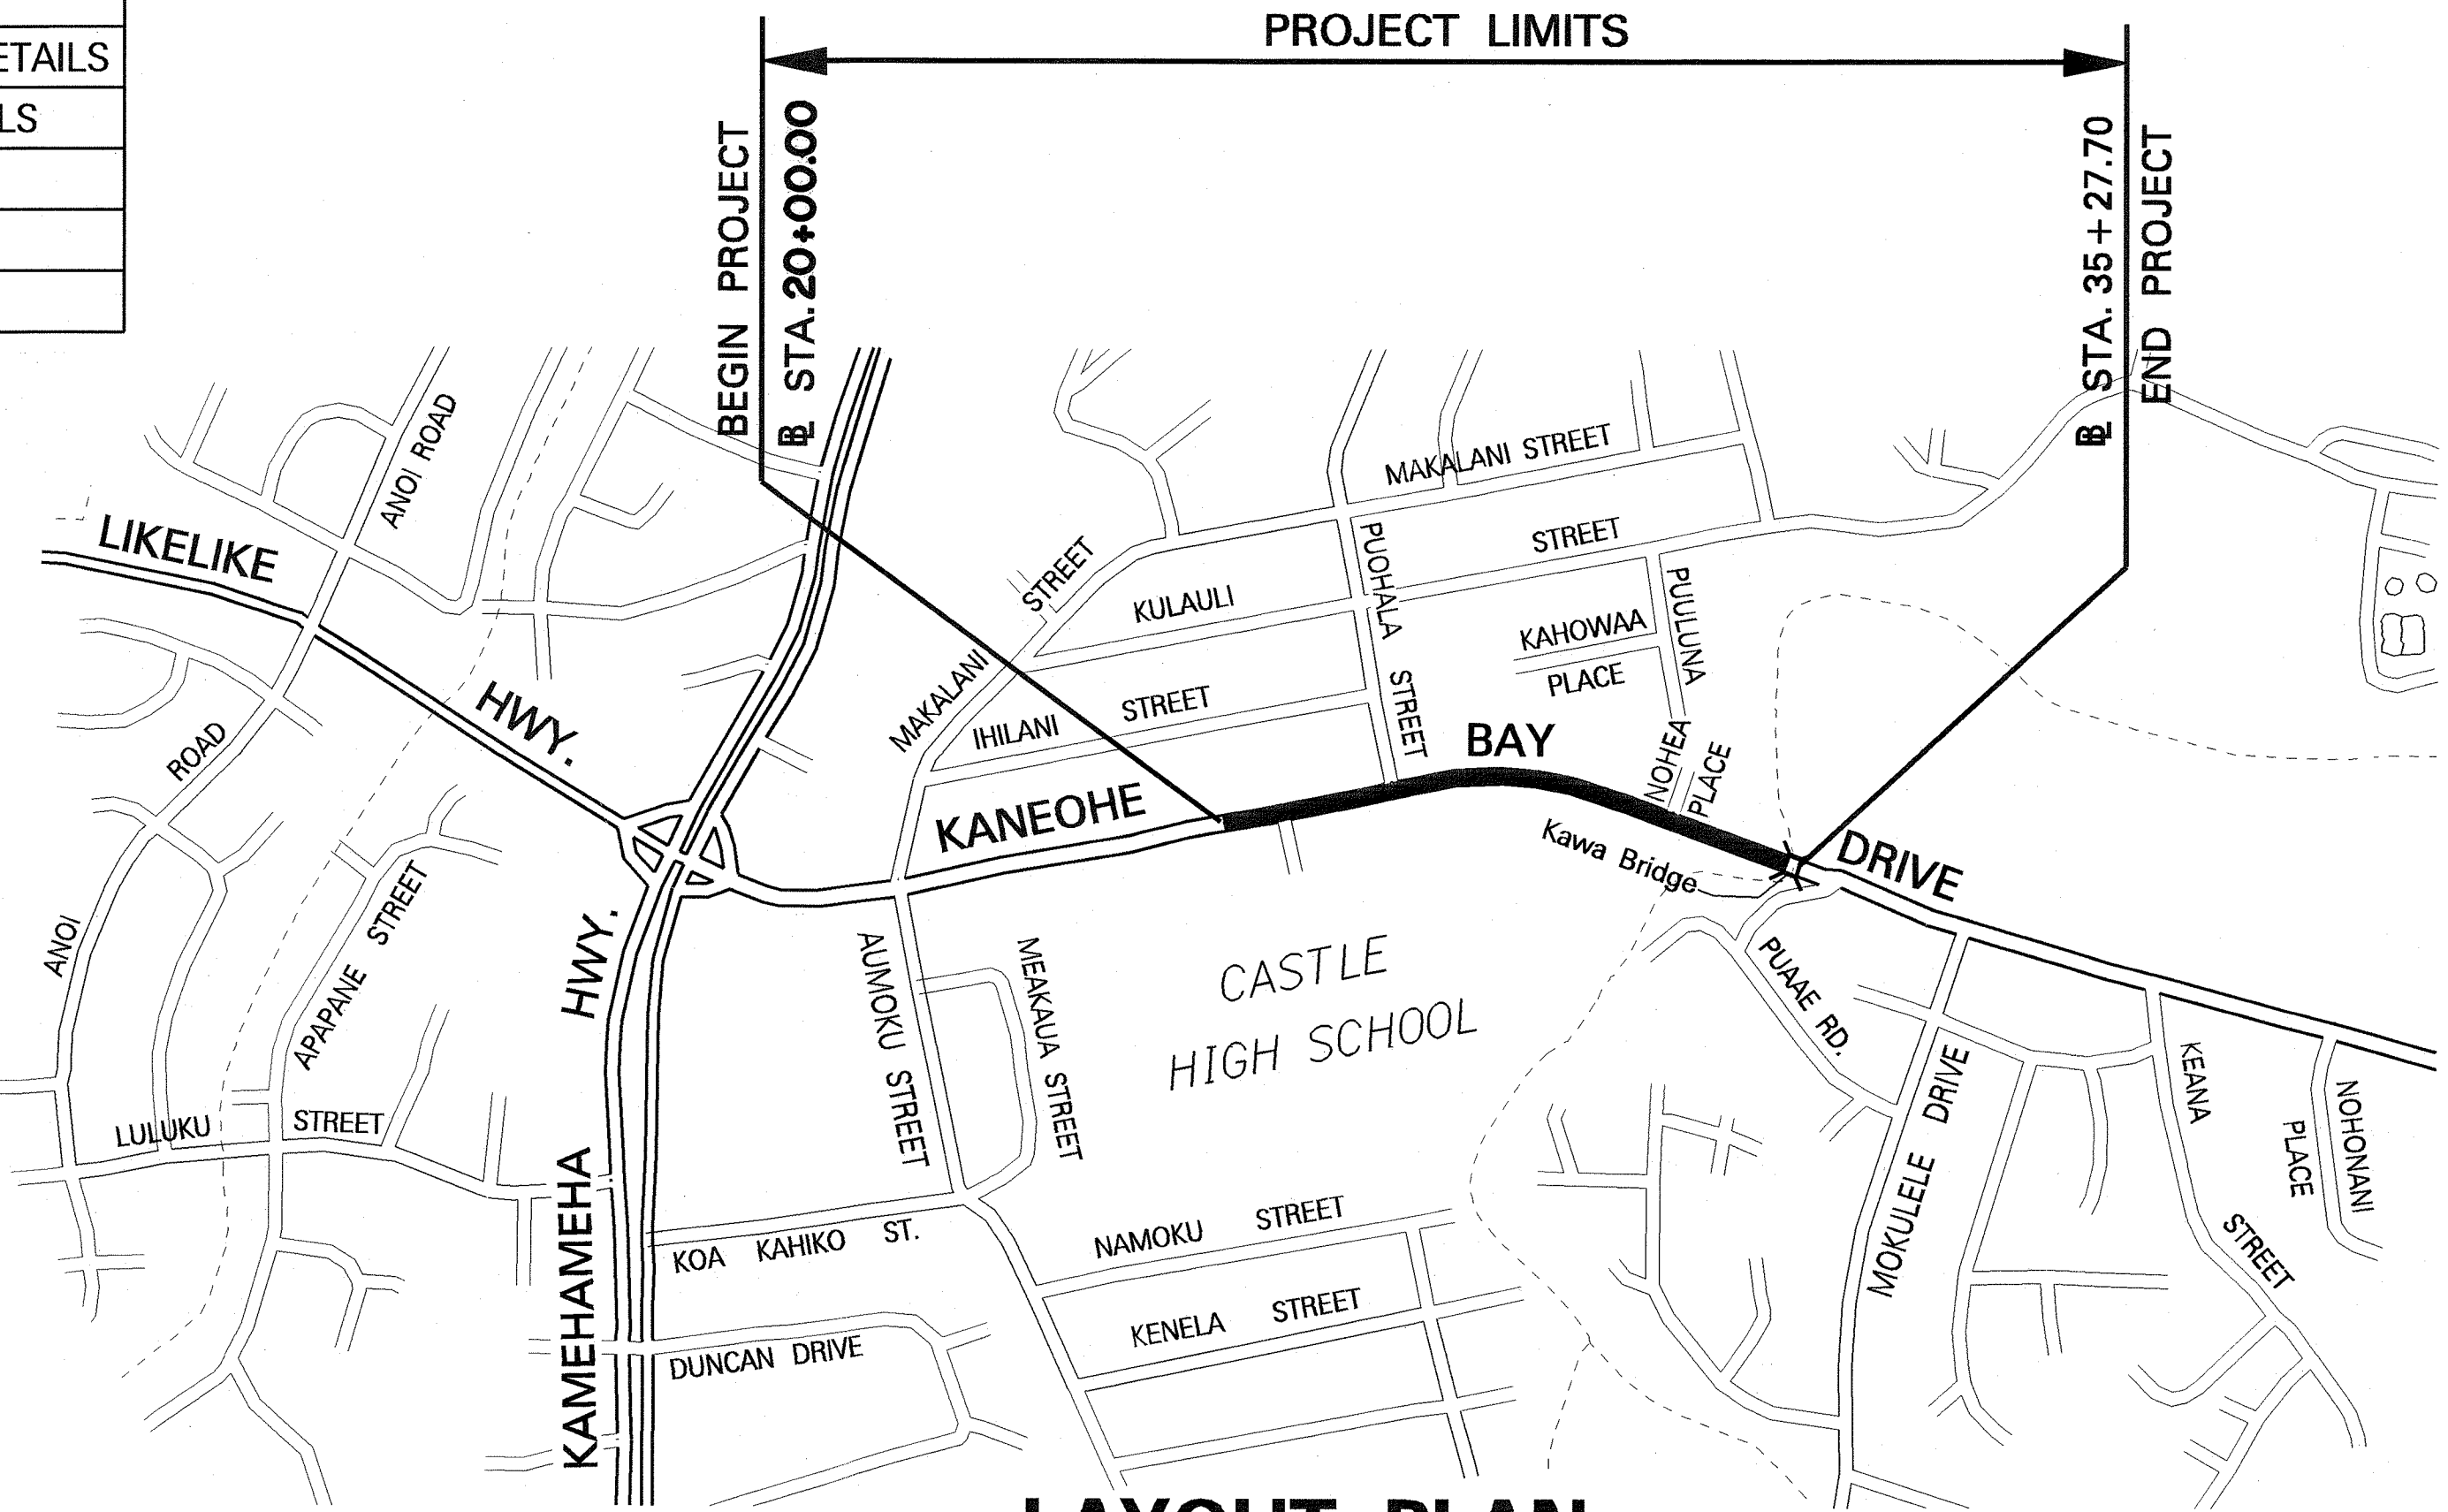
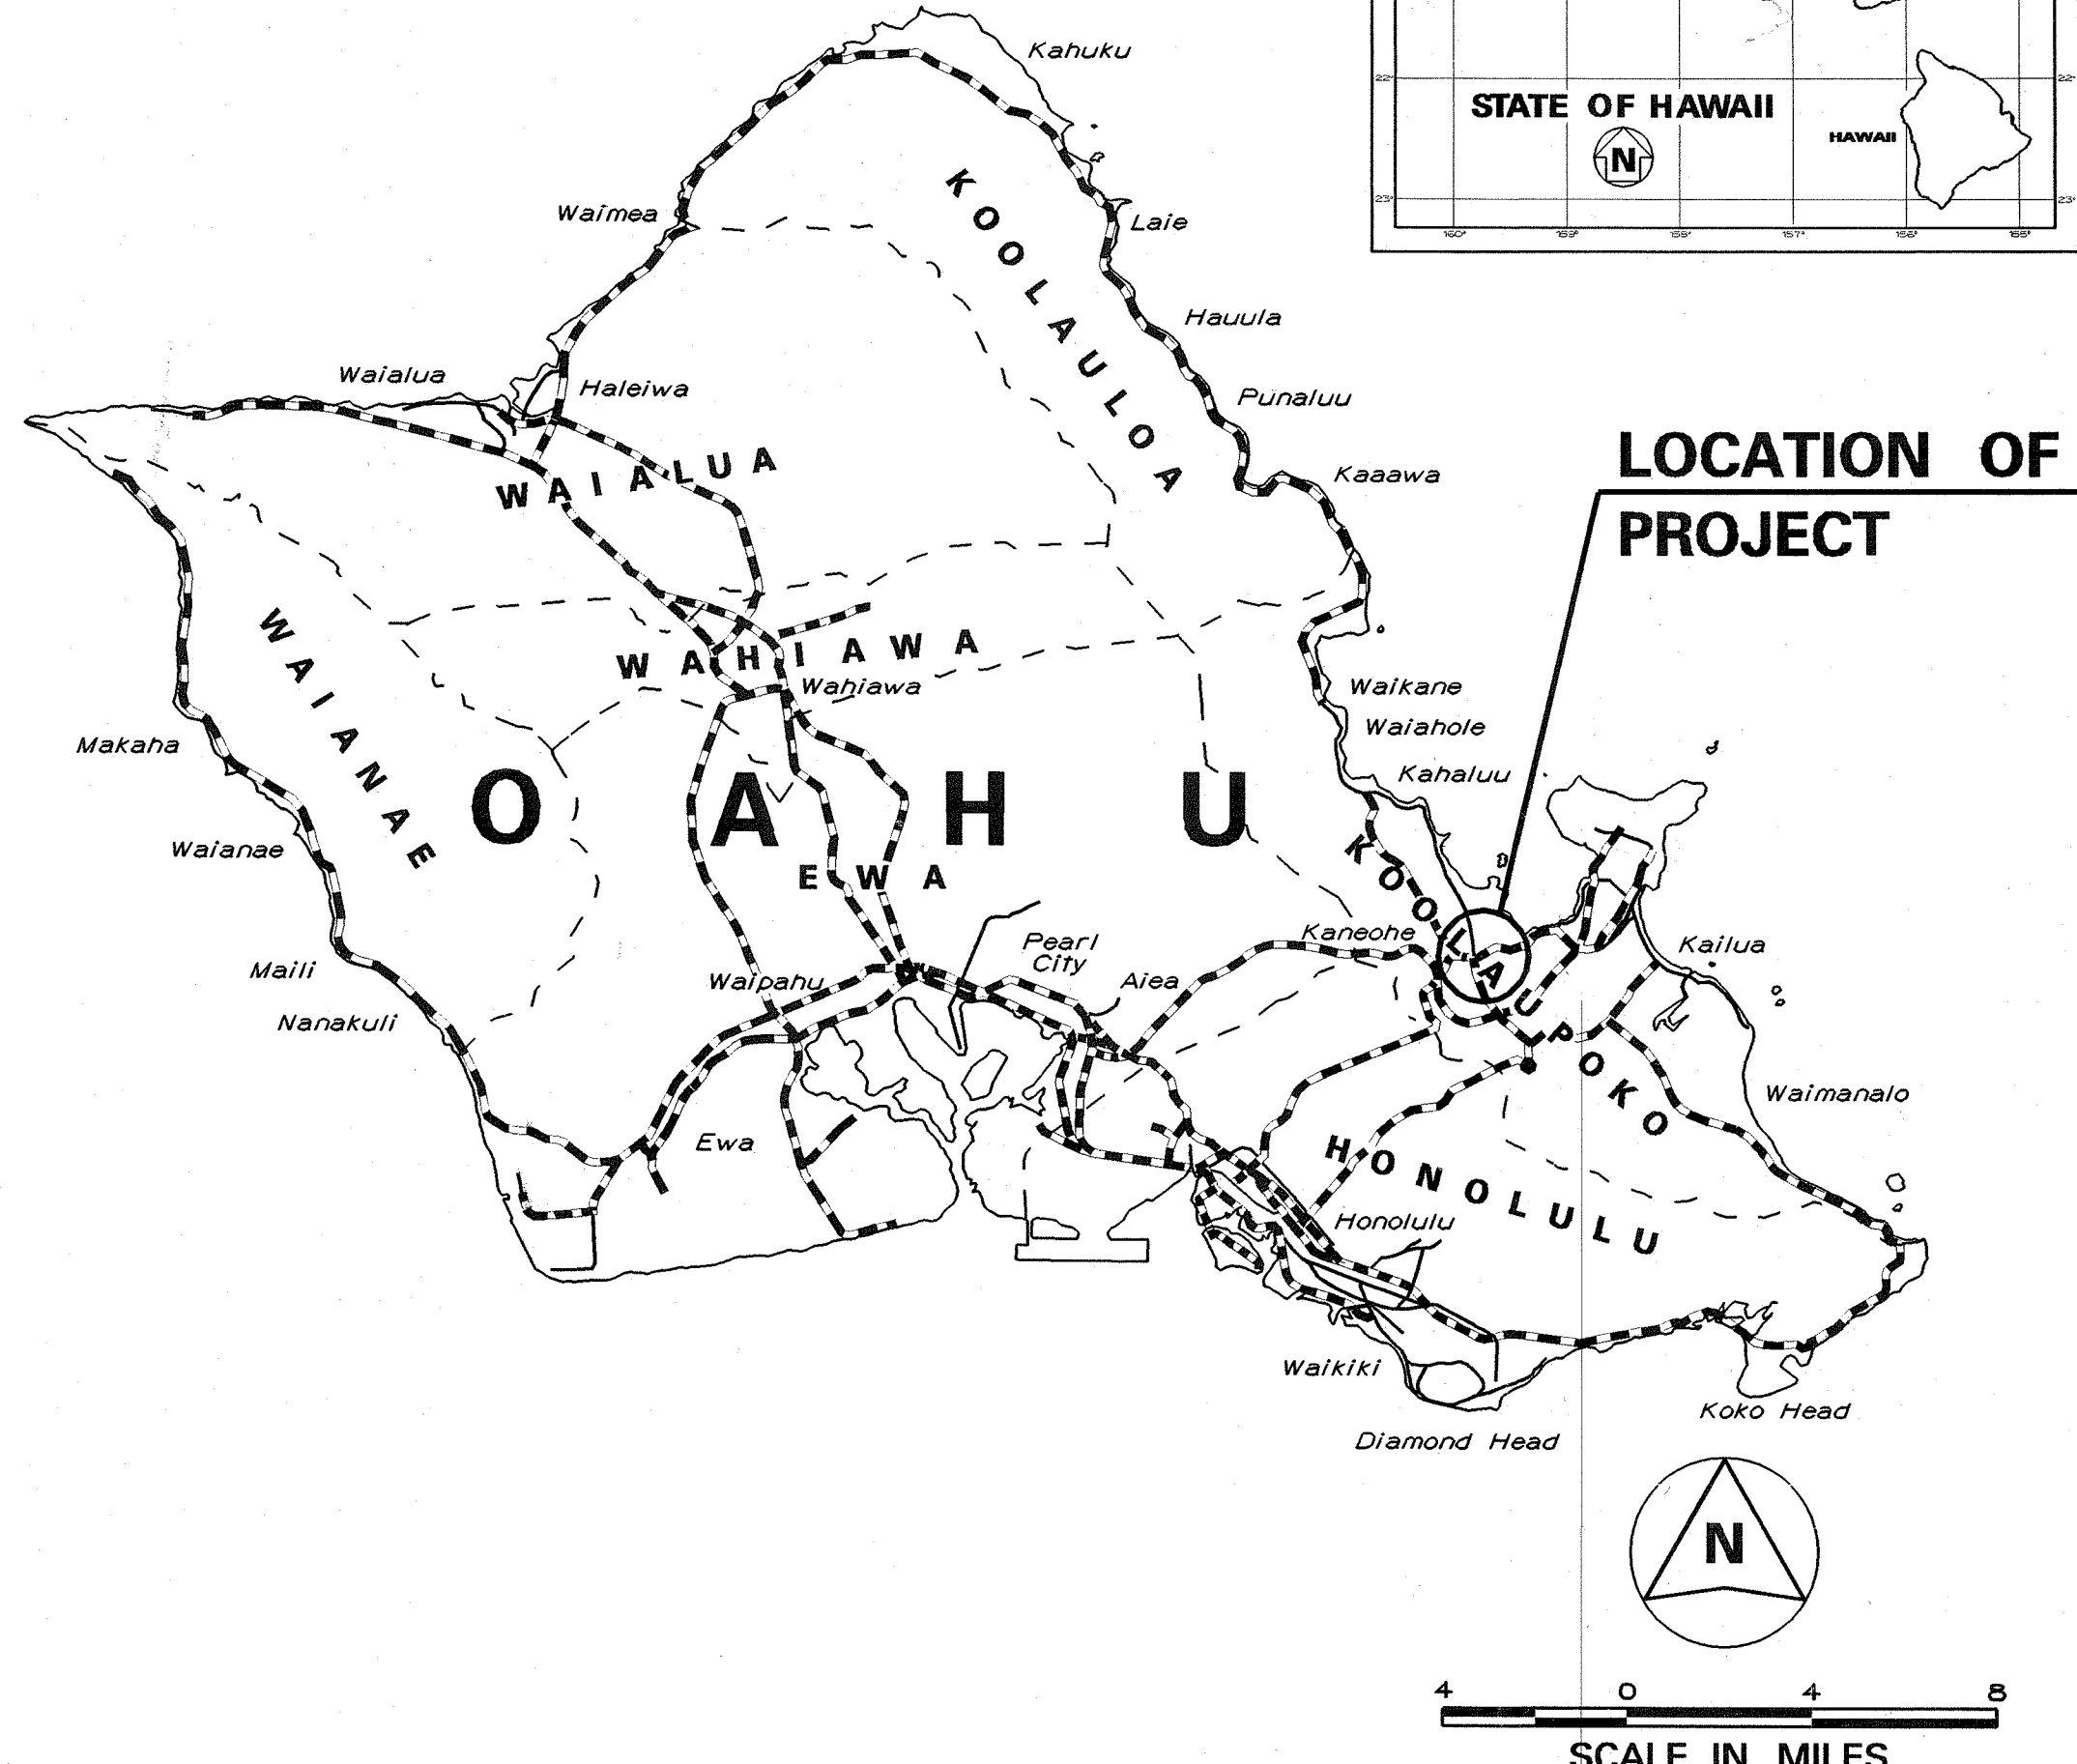
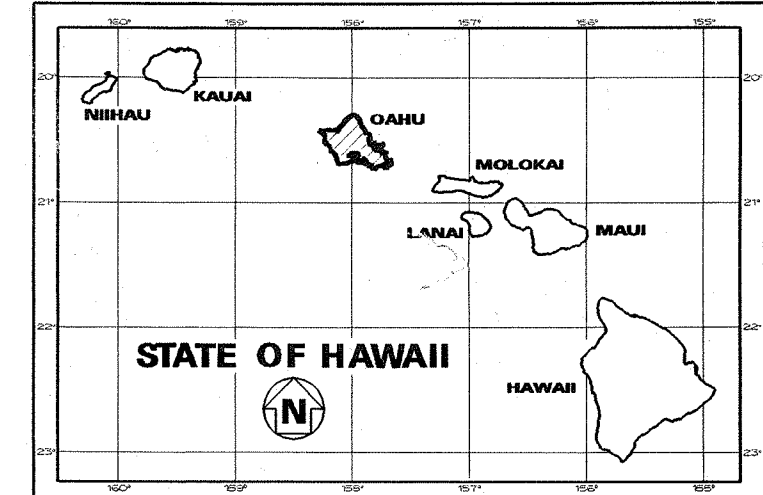


INDEX TO DRAWINGS	
SHEET NO.	DESCRIPTION
1	TITLE SHEET
2	STANDARD PLANS SUMMARY
3	LEGEND
4 - 7	GENERAL AND UTILITY NOTES
8 - 9	EROSION CONTROL NOTES
10 - 12	TYPICAL SECTIONS
13 - 19	TYPICAL SECTIONS AND DETAILS
20 - 21	MISCELLANEOUS NOTES & DETAILS
22 - 24	CURBRAMP DETAILS
25 - 26	GUARDRAIL DETAILS
27	QUADGUARD DETAILS
28 - 31	ROADWAY PLANS
32 - 34	PAVEMENT GRADE PLANS
35 - 43	DETAIL ROADWAY PLANS
44 - 48	CONSTRUCTION PHASING PLANS
49 - 54	UTILITY DETAILS
55 - 56	DRAINAGE SUMMARY
57 - 61	DRAINAGE PLANS
62 - 65	DRAINAGE PROFILES
66 - 74	DRAINAGE DETAILS
75 - 86	STRUCTURAL NOTES, PLANS AND DETAILS
87 - 90	PAVEMENT MARKING AND SIGNING PLANS
91 - 97	TRAFFIC SIGNAL PLANS AND DETAILS
98 - 107	ELECTRICAL NOTES, PLANS, DETAILS
108 - 113	CROSS SECTIONS

STATE OF HAWAII
DEPARTMENT OF TRANSPORTATION
HIGHWAYS DIVISION
HONOLULU, HAWAII
"AS-BUILT"
PLANS FOR
KANEOHE BAY DRIVE IMPROVEMENTS
VICINITY OF PUOHALA STREET TO KAWA BRIDGE
FEDERAL AID PROJECT NO. STP-065-1(9)
DISTRICT OF KOOLAUPOKO
ISLAND OF OAHU

FED. ROAD DIST. NO.	STATE	FED. AID PROJ. NO.	FISCAL YEAR	SHEET NO.	TOTAL SHEETS
HAWAII	HAW.	STP-065-1(9)	2003	1	114

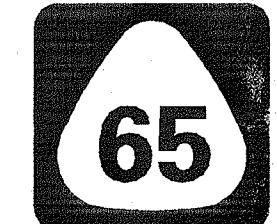


----- FEDERAL AID PROJECTS PREVIOUSLY CONSTRUCTED OR UNDER CONSTRUCTION

MILE POST 0.31 TO MILE POST 0.65

DESIGN DESIGNATION	
ADT (2002)	26,300
ADT (2022)	30,000
DHV	2,400
D	55/45
T ₂₄	2.5 %
V	35 M.P.H.

LAYOUT PLAN

GROSS LENGTH OF PROJECT..... 0.34 MILES
NET LENGTH OF PROJECT..... 0.34 MILES

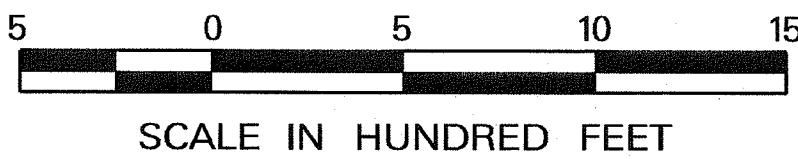

CHANGES MADE DURING CONSTRUCTION HAVE BEEN INCORPORATED ON THESE PLANS EXCEPT CHANGES IN THE ORIGINAL THEORETICAL QUANTITIES. FOR ACTUAL QUANTITIES, REFER TO PROJECT LEDGER AND/OR COMPLETION BOOK.

[Signature] 2/5/10
RESIDENT ENGINEER DATE

DEPARTMENT OF TRANSPORTATION
STATE OF HAWAII

APPROVED: *[Signature]* 9-3-02
DIR. OF TRANSPORTATION DATE

UNIT "C"
DESIGNED BY
R. HIRONAKA
P. S. & E. BY
692-7577
PHONE
AUGUST, 2002
DATE