


FED. ROAD DIST. NO.	STATE	FED. AID PROJ. NO.	FISCAL YEAR	SHEET NO.	TOTAL SHEETS
HAWAII	HAW.	STP-065-1(010)	2011	41	52

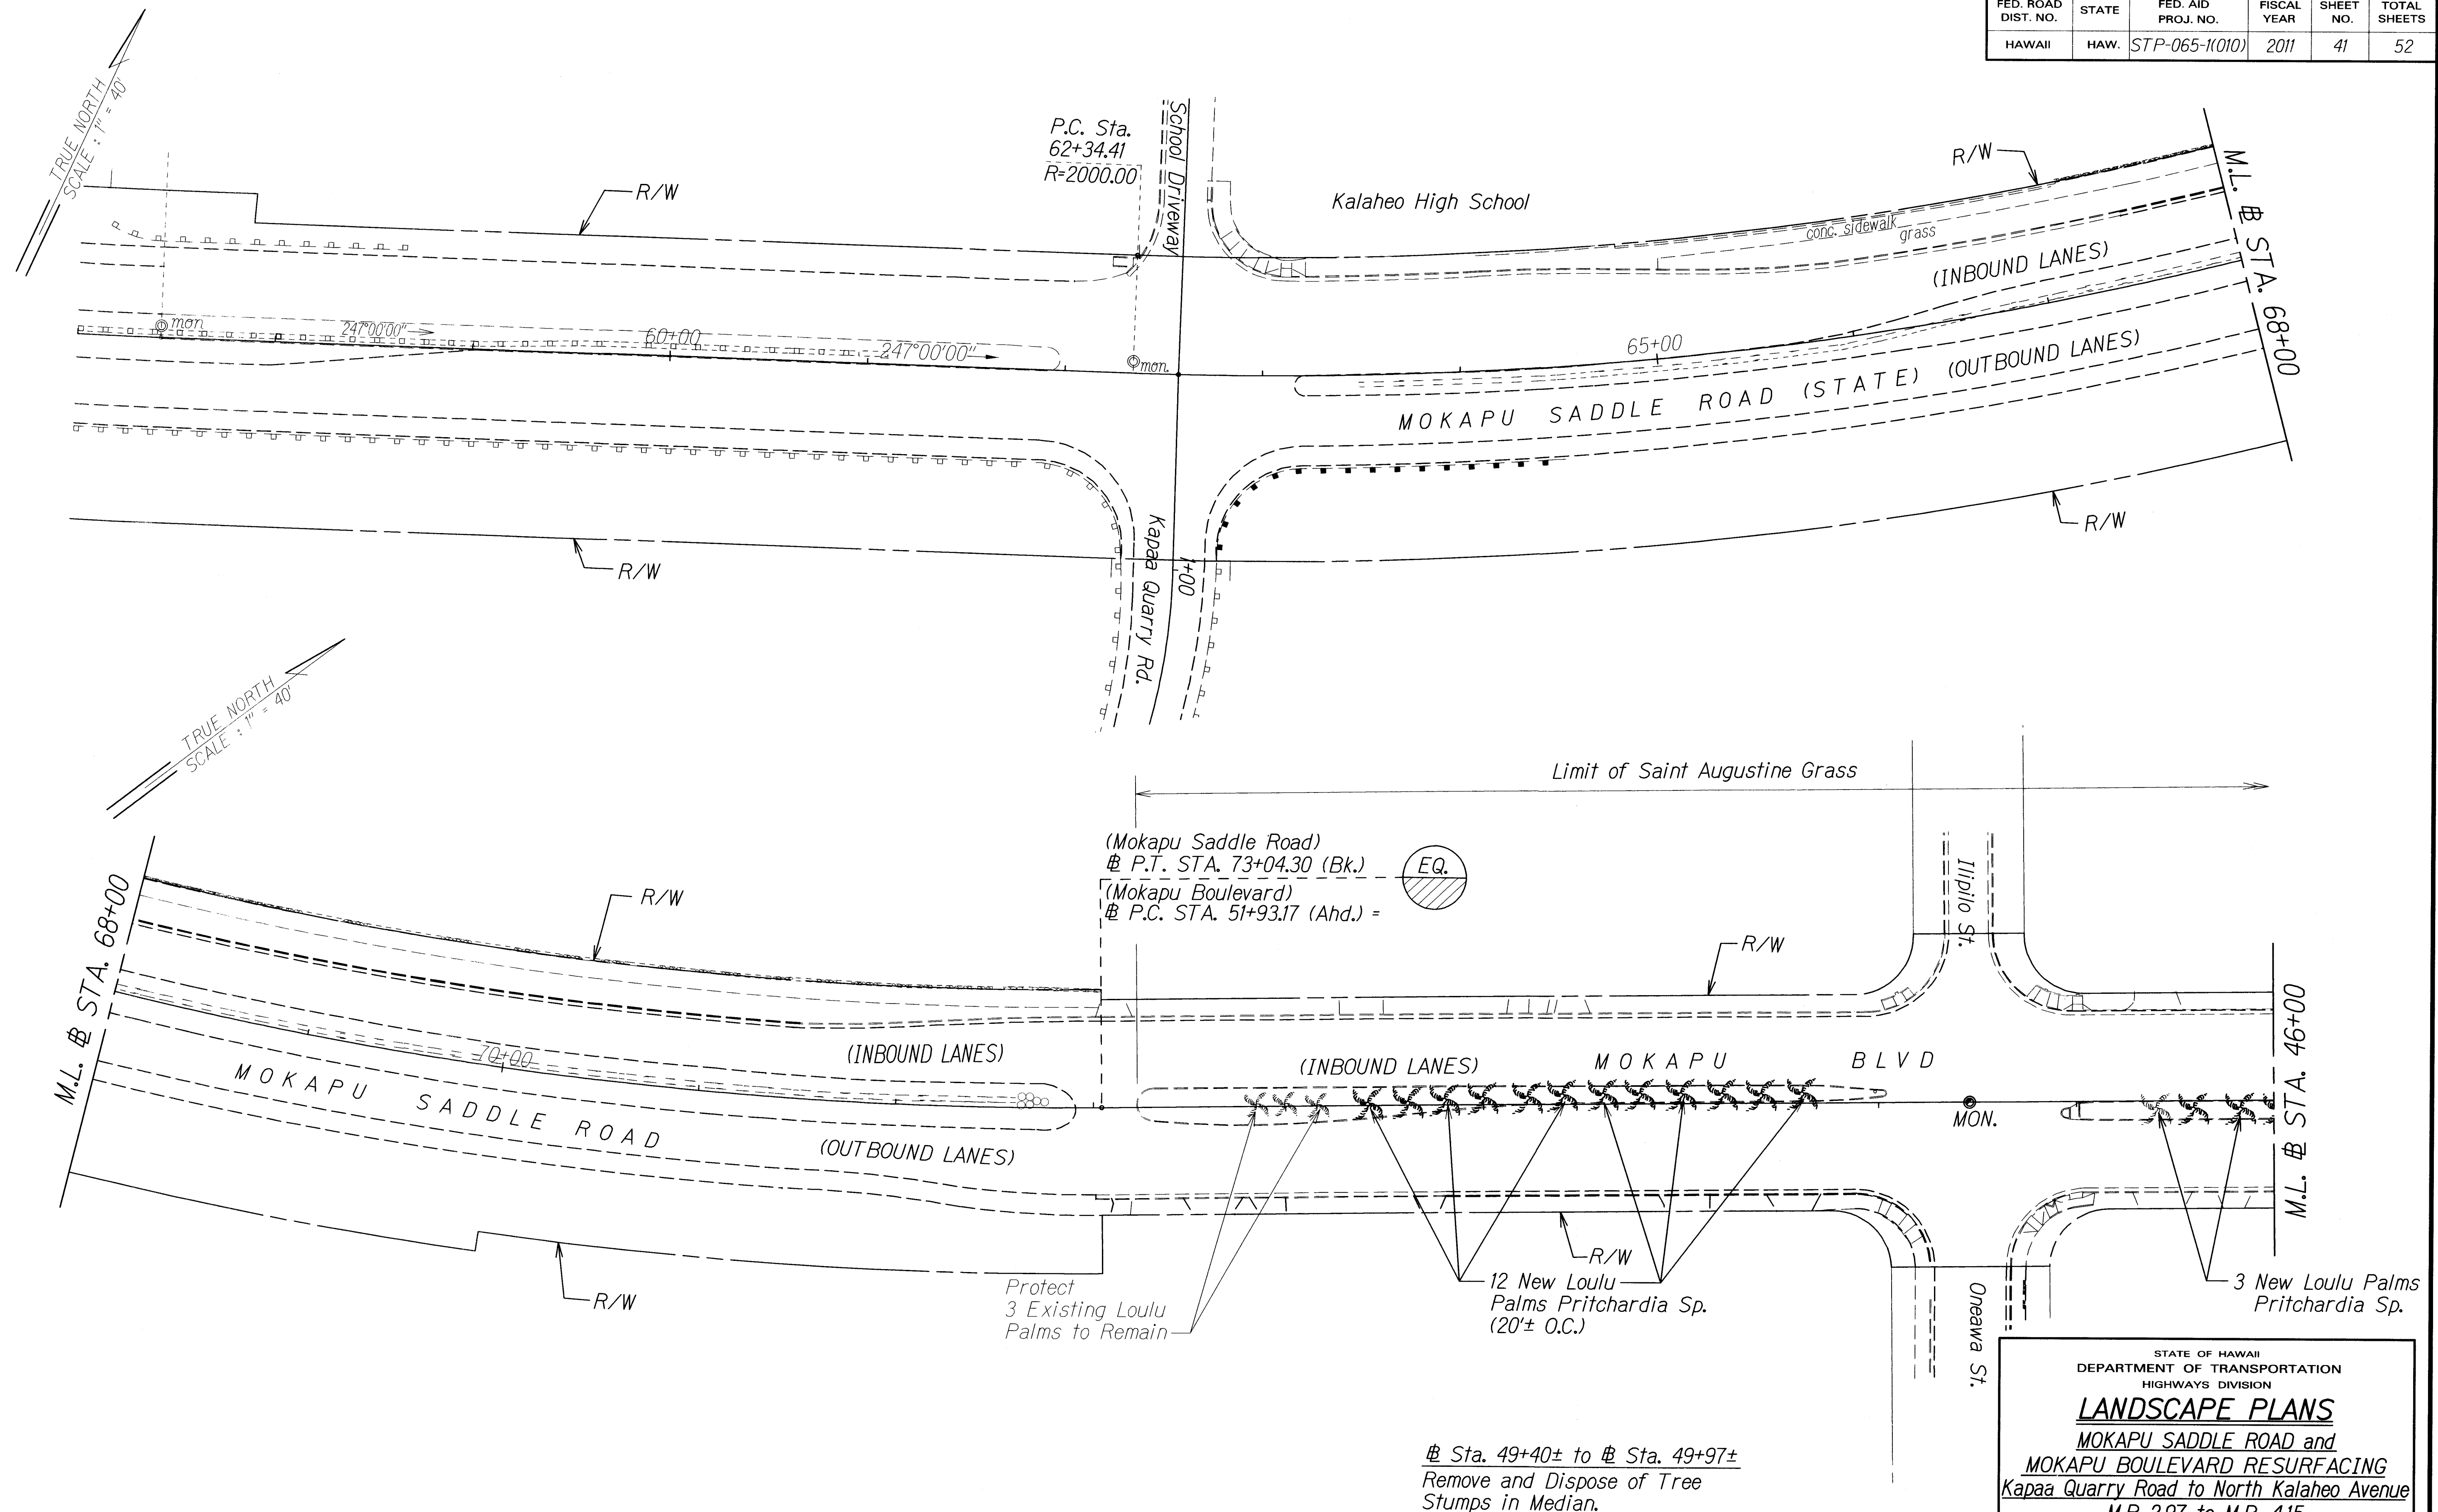

ORIGINAL PLAN	SURVEY PLOTTED BY	DATE
NOTE BOOK	TRACED BY	
DESIGNED BY		
QUANTITIES BY		
CHECKED BY		

STATE OF HAWAII
DEPARTMENT OF TRANSPORTATION
HIGHWAYS DIVISION

LANDSCAPE PLANS

**MOKAPU SADDLE ROAD and
MOKAPU BOULEVARD RESURFACING**
Kapaa Quarry Road to North Kalaheo Avenue
M.P. 2.97 to M.P. 4.15
Federal Aid Project No. STP-065-1(010)

Scale: 1"=40' Date: April, 2011

SHEET No. 1 OF 3 SHEETS

Limit of Saint Augustine Grass

Sta. 46+00 to Sta. 35+00
Remove and Dispose of all Senna Spp, Chrysalidocarpus lutescens and All Tree Stumps in Median.

TRUE NORTH
SCALE: 1" = 40'

Remove 4 Existing Areca Palms

Remove Existing Pine Tree

Remove Existing Monkeypod Tree

Remove 3 Existing Senna Sp.

M.L. Sta. 46+00

Sta. 43+50±

R/W

INBOUND LANES

MOKAPU BLVD (OUTBOUND LANES)

45+00

40+00

36+25±

35+00

M.L. Sta. 35+00

11 New Loulu Palms Pritchardia spp. (20'± O.C.)

Existing Monkeypod to Remain

1 New Rainbow Shower Tree Cassia x nealiae

1 New Monkeypod ~~Samanea Saman~~


2 New Monkeypod ~~Samanea Saman~~

2 Existing Saman

Existing Monkeypod to Remain

Sta. 43+50± to Sta. 38+75±
Protect Existing Monkeypod Trees to Remain.



FED. ROAD DIST. NO.	STATE	FED. AID PROJ. NO.	FISCAL YEAR
HAWAII	HAW.	STP-065-1(010)	2011

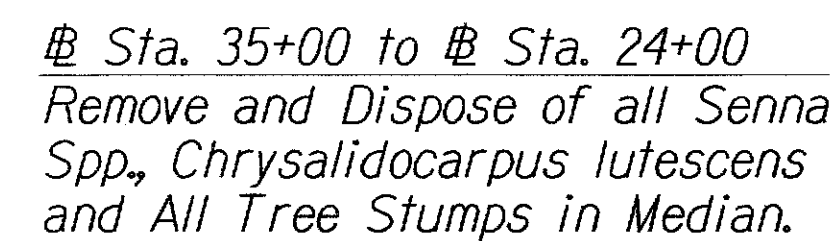

<u>LEGEND FOR</u> <u>AS-BUILT POSTINGS</u>	
	Squiggly line for as-built deletion
100.00	Double line for as-built deletion
Roadway	Text for as-built posting

"AS-BUILT"

FED. ROAD DIST. NO.	STATE	FED. AID PROJ. NO.	FISCAL YEAR	SHEET NO.	TOTAL SHEETS
HAWAII	HAW.	STP-065-1(010)	2011	43	52

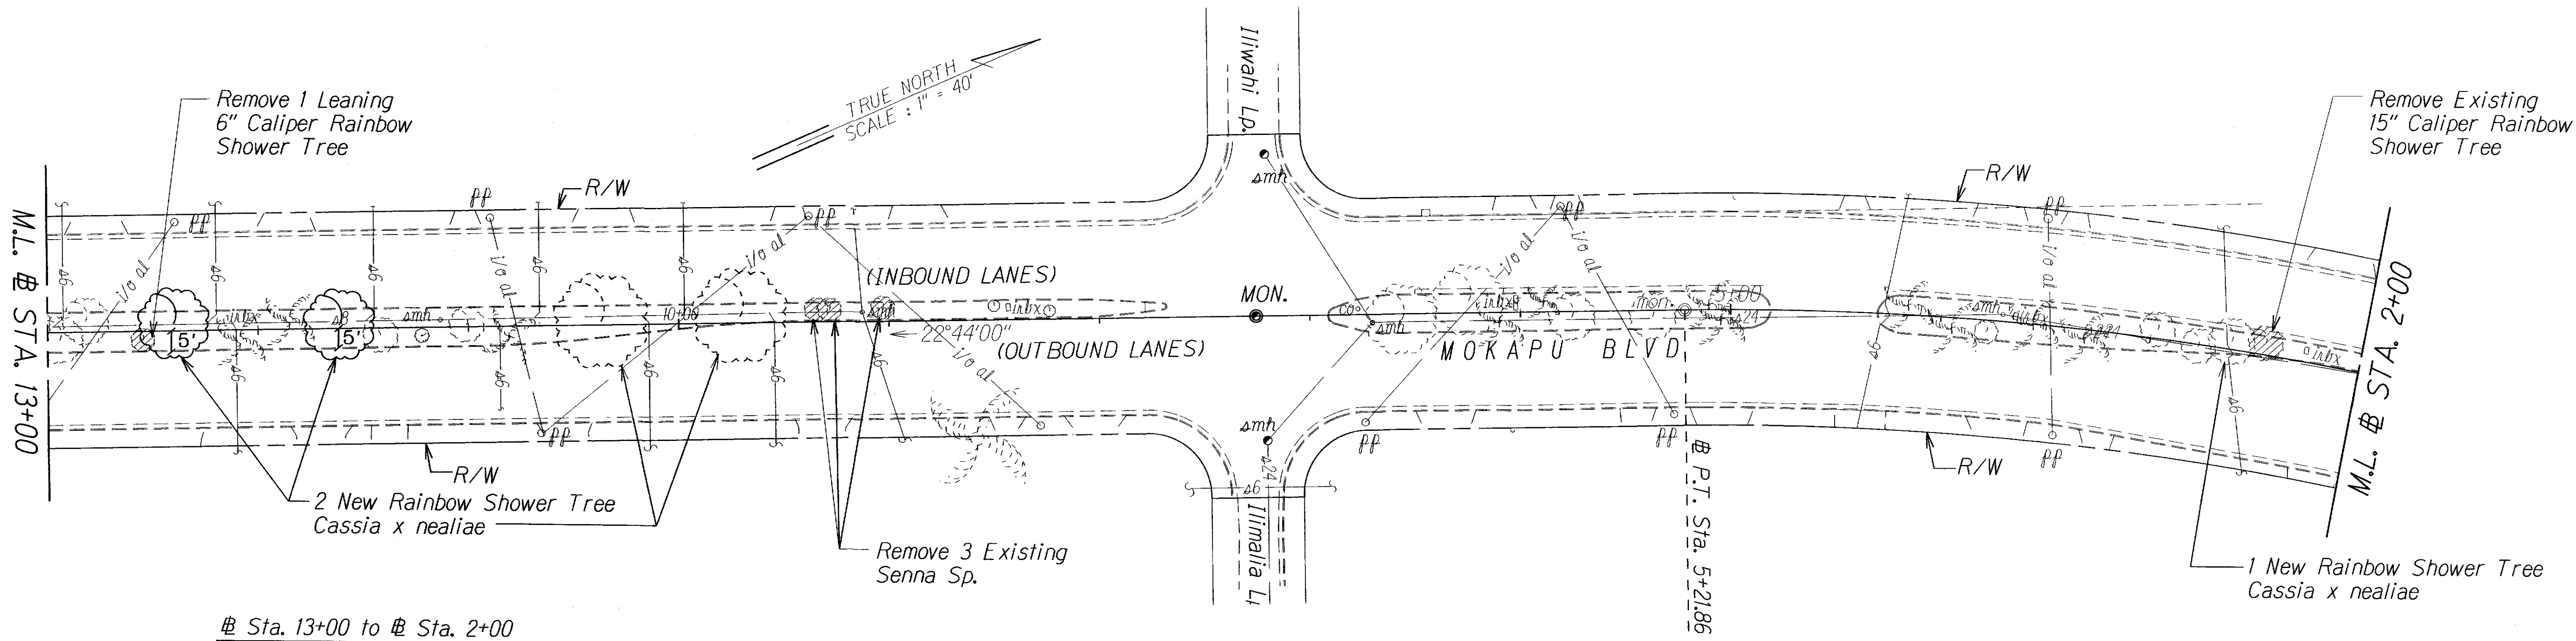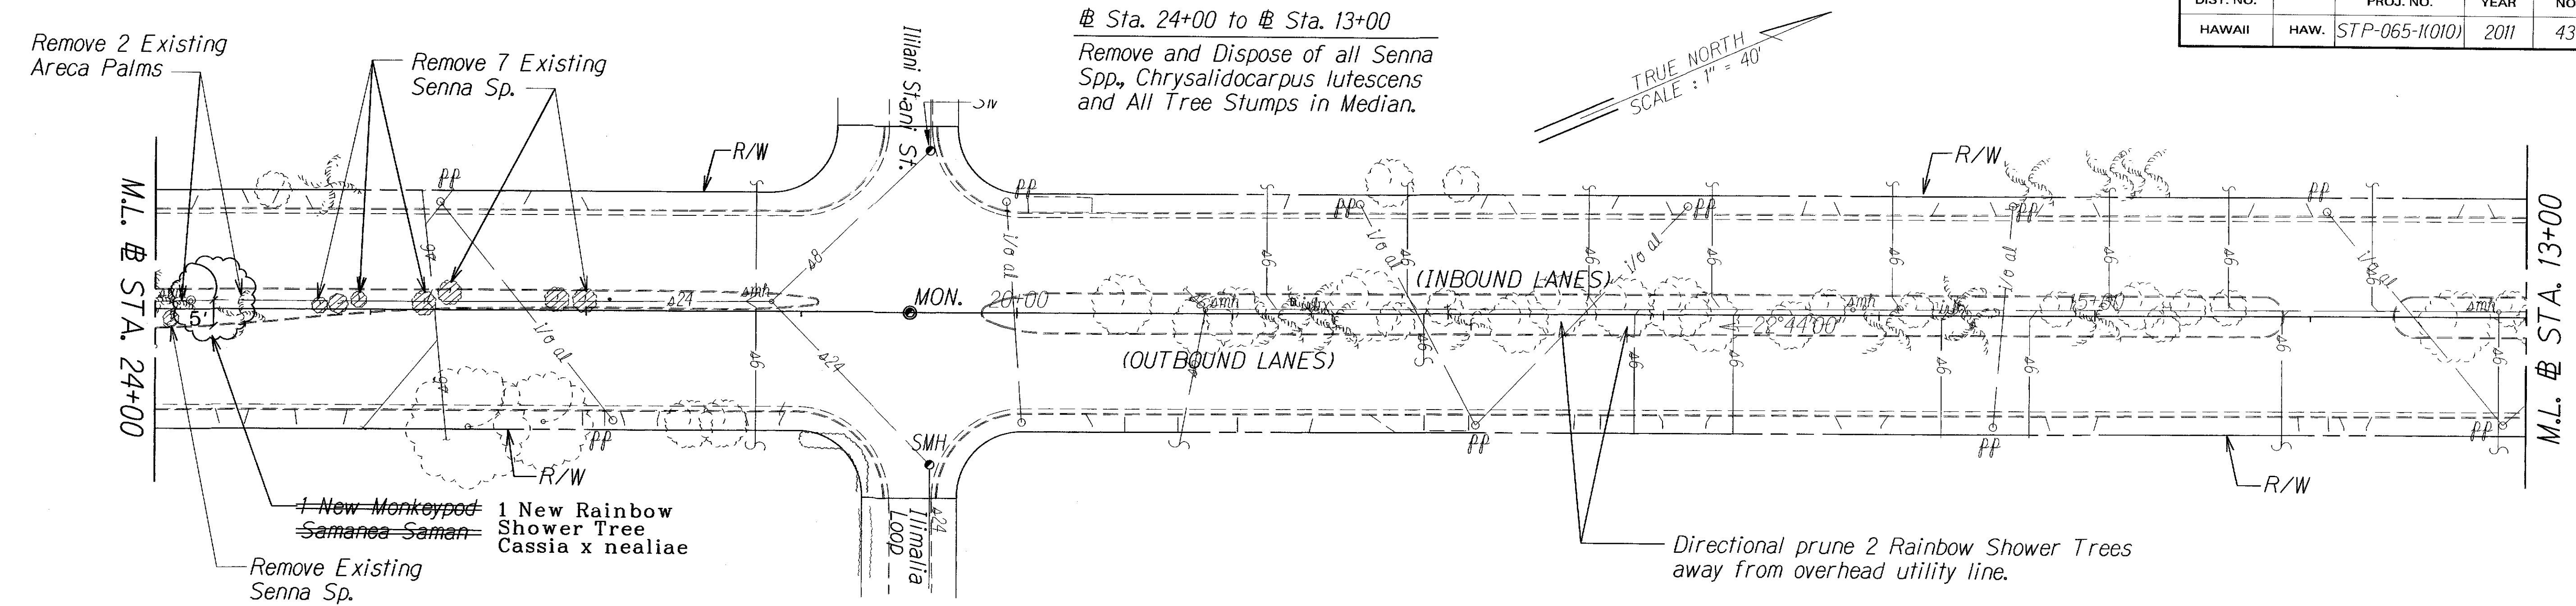

Sta. 20+00 to # Sta. 2+00

Prune all Rainbow Shower Trees (34), crown cleaning pruning to include selected live, as well as dead, dying, insect infested, diseased, brokenm or cracked branches, decayed, excessively heavy or crossing branches, vines, obstructing, and weakly attached branches & water sprouts. Provide 17 feet clearance above travel lane.

LEGEND FOR AS-BUILT POSTINGS	
	Squiggly line for as-built deletion
	Double line for as-built deletion
Roadway	Text for as-built posting

STATE OF HAWAII
DEPARTMENT OF TRANSPORTATION
HIGHWAYS DIVISION

LANDSCAPE PLANS

MOKAPU SADDLE ROAD and
MOKAPU BOULEVARD RESURFACING
Kapaa Quarry Road to Kalaheo Avenue
M.P. 2.97 to M.P. 4.15
Federal Aid Project No. STP-065-1(010)

Scale: 1"=40' Date: April, 2011

ORIGINAL PLAN	SURVEY PLOTTED BY	DATE
NOTE BOOK	DESIGNED BY	
QUANTITIES BY	CHECKED BY	
7/26/2010		

"AS-BUILT"