

INDEX TO DRAWINGS	
SHEET NO.	DESCRIPTION
1	TITLE SHEET
2	STANDARD PLANS SUMMARY
3	GENERAL NOTES AND LEGEND
4 - 5	WATER POLLUTION AND EROSION CONTROL NOTES
6	STANDARD BEST MANAGEMENT PRACTICES NOTES
7 - 10	UTILITY NOTES
① 11 - 12	TYPICAL SECTIONS
13 - 15	GUARDRAIL NOTES AND DETAILS
16 - 22	CURB RAMP AND SIDEWALK
23 - 26	ROADWAY PLANS
27	DRAINAGE DETAIL
28 - 38	TRAFFIC PLANS
39 - 40	LANDSCAPING NOTES AND DETAILS
41 - 43	LANDSCAPING PLANS
44 - 47	IRRIGATION NOTES AND DETAILS
48 - 52②	IRRIGATION PLANS

Sheet Nos. ① ADD 11S-1 and ② 52S-1 are Supplementary Sheets to this Project. Total Sheet Count After "AS-BUILT" Posting 54 sheets.

STATE OF HAWAII

DEPARTMENT OF TRANSPORTATION

HIGHWAYS DIVISION

HONOLULU, HAWAII

"AS-BUILT"

PLANS FOR

MOKAPU SADDLE ROAD AND

MOKAPU BOULEVARD RESURFACING

KAPAA QUARRY ROAD TO NORTH KALAHEO AVENUE




M.P. 2.97 TO M.P. 4.15

FEDERAL AID PROJECT NO. STP-065-1(010)

DISTRICT OF KOOLAUPOKO

ISLAND OF OAHU

FED. ROAD DIST. NO.	STATE	FED. AID PROJ. NO.	FISCAL YEAR	SHEET NO.	TOTAL SHEETS
HAWAII	HAW.	STP-065-1(010)	2011	1	52

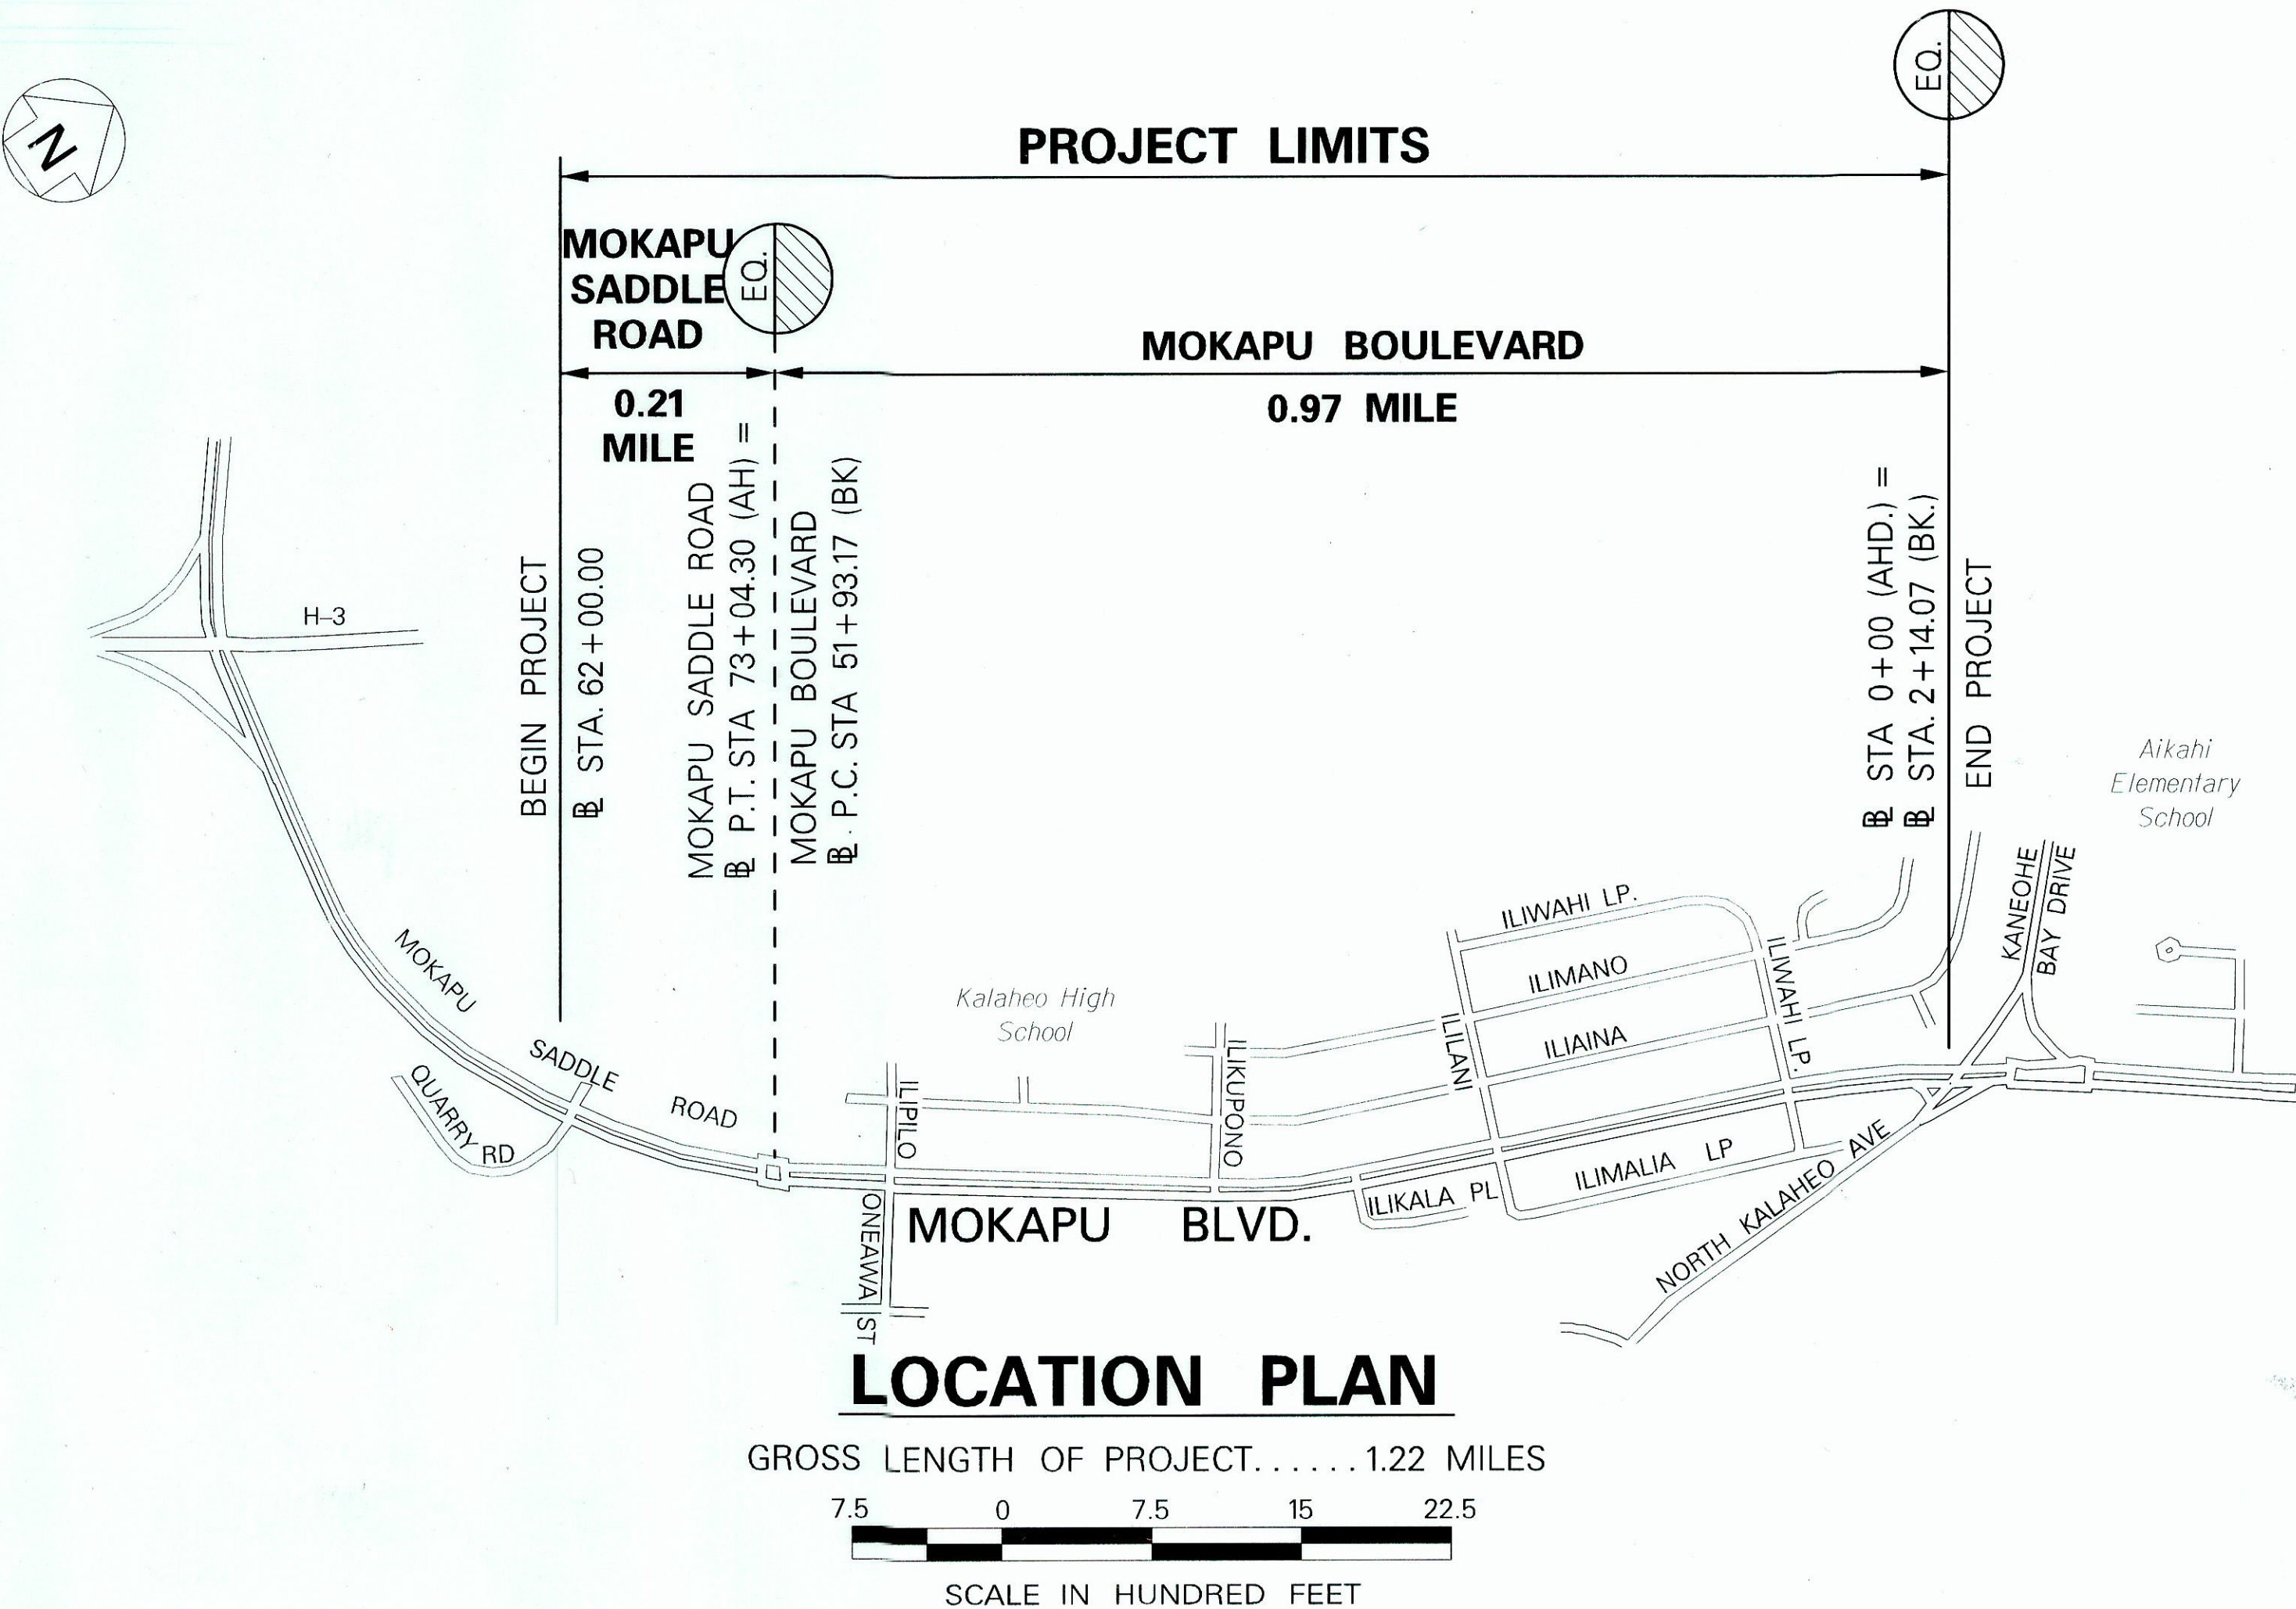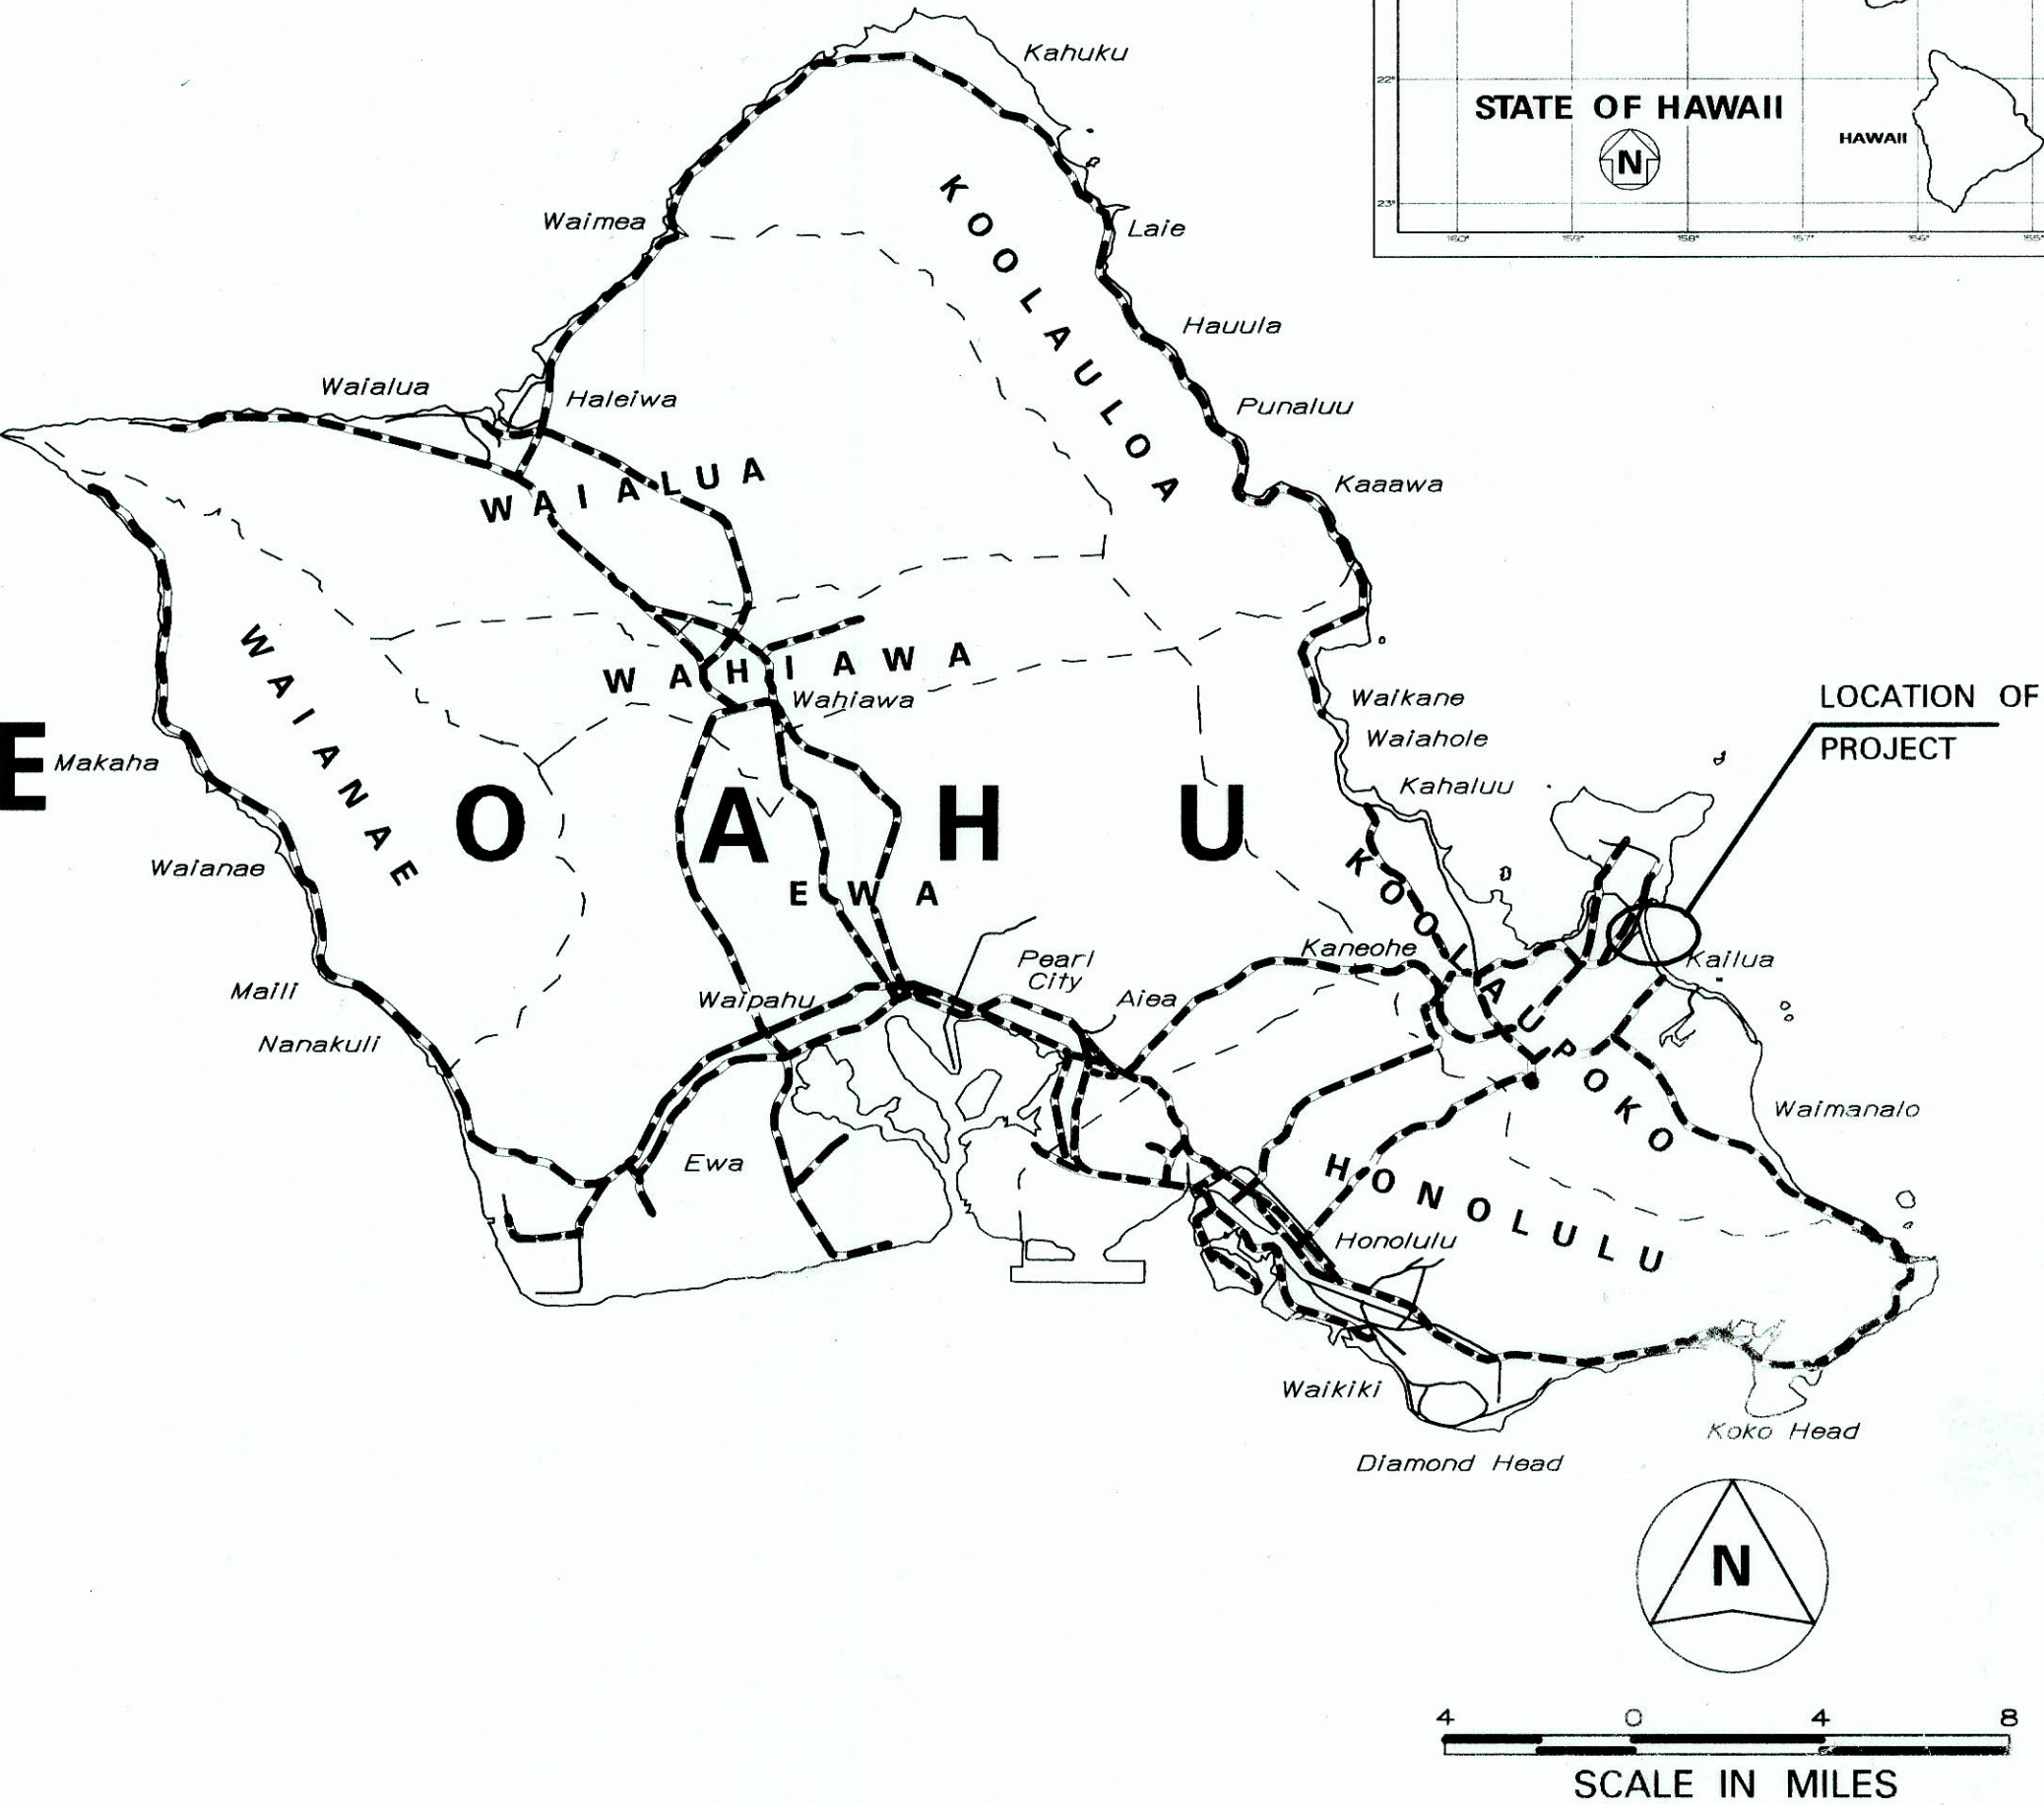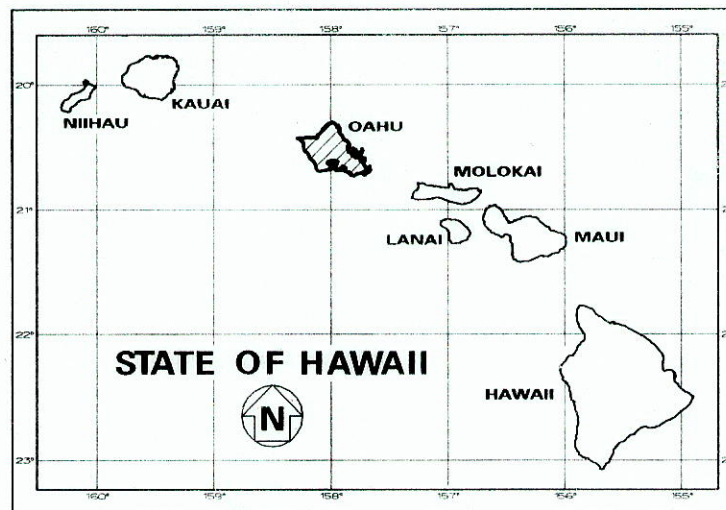

----- FEDERAL AID PROJECTS PREVIOUSLY CONSTRUCTED OR UNDER CONSTRUCTION

MOKAPU SADDLE ROAD: MILE POST 2.97 TO MILE POST 3.18

MOKAPU BOULEVARD: MILE POST 3.18 TO MILE POST 4.15

DESIGN DESIGNATION	MOKAPU SADDLE ROAD KAPAA QUARRY ROAD TO ONEAWA	MOKAPU BOULEVARD ONEAWA STREET TO NORTH KALAHEO AVE
ADT (2010).....	32,800	11,800
ADT (2020).....	36,500	13,100
DHV	3,700	1,300
D	60/40.....	55/45
T	5.5 %.....	4.5 %
V	30 M.P.H.....	30 M.P.H.....

CHANGES MADE DURING CONSTRUCTION HAVE BEEN INCORPORATED ON THESE PLANS EXCEPT CHANGES IN THE ORIGINAL THEORETICAL QUANTITIES. FOR ACTUAL QUANTITIES, REFER TO PROJECT LEDGER AND/OR COMPUTATION BOOK.

Matthew Manti
RESIDENT ENGINEER

10/27/15
DATE

DEPARTMENT OF TRANSPORTATION
STATE OF HAWAII

APPROVED:
Alan A. Johnson
DIR. OF TRANSPORTATION

11/02/11
DATE

HWY-DD
MANAGED BY

HWY-D
DESIGNED BY

692-7570
PHONE

March, 2011
DATE