



INDEX TO DRAWINGS	
SHEET NO.	DESCRIPTION
1	TITLE SHEET
2	STANDARD PLANS SUMMARY
3-4	GENERAL NOTES & LEGEND
5-6	WATER POLLUTION & EROSION CONTROL NOTES
7-11	TYPICAL SECTIONS
12-18	MISCELLANEOUS DETAILS
19-30	CURB RAMP NOTES & DETAILS
31-45	GUARDRAIL NOTES & DETAILS
46-53	DRIVEWAY DETAILS
54-62	DRAINAGE DETAILS
① 63-68	ROADWAY PLANS
69-76	PAVEMENT MARKING, SIGNING, STRIPING PLANS, & NOTES
77-81	TRAFFIC SIGNAL LEGEND, NOTES, & LOOP DETECTOR PLANS

Sheet No. ① 63-68 is a Supplementary Sheet to this Project. Total Sheet Count After "AS-BUILT" Posting 02 Sheets.

STATE OF HAWAII
DEPARTMENT OF TRANSPORTATION
HIGHWAYS DIVISION
HONOLULU, HAWAII
"AS-BUILT"
PLANS FOR
KANEOHE BAY DRIVE REHABILITATION
KAMEHAMEHA HIGHWAY TO NANAMOANA STREET
PROJECT NO. 65AB-01-04M

DISTRICT OF KOOLAUPOKO
ISLAND OF OAHU

FED. ROAD DIST. NO.	STATE	PROJ. NO.	FISCAL YEAR	SHEET NO.	TOTAL SHEETS
HAWAII	HAW.	65AB-01-04M	2012	1	81

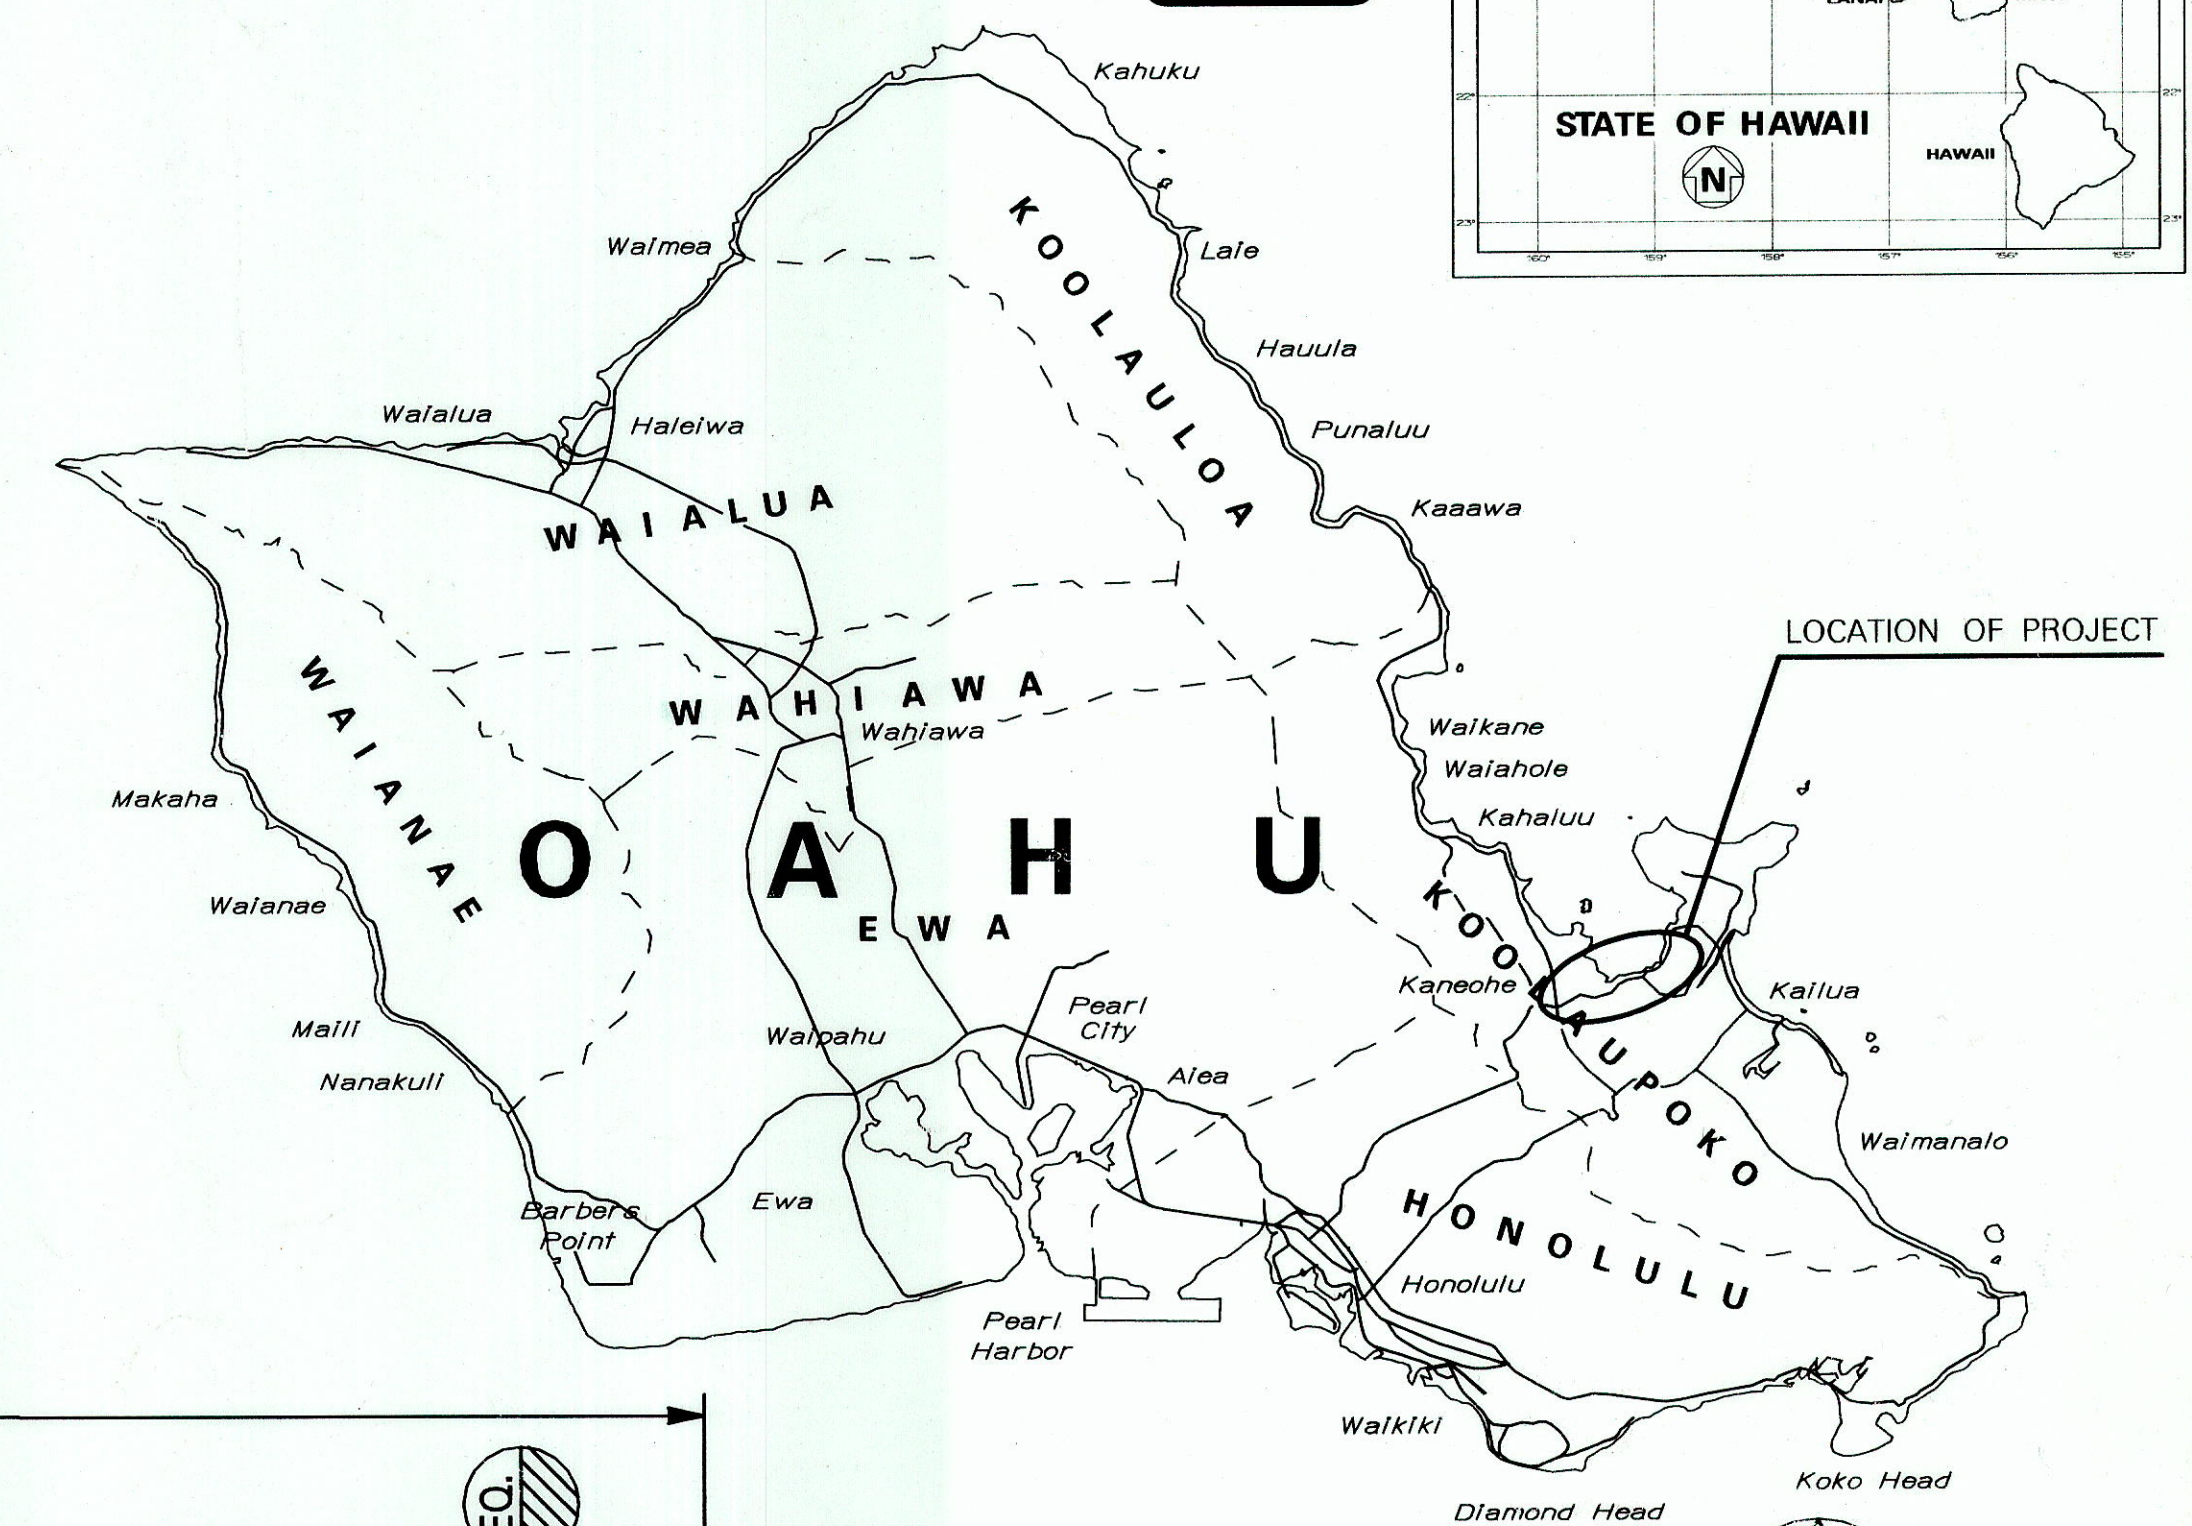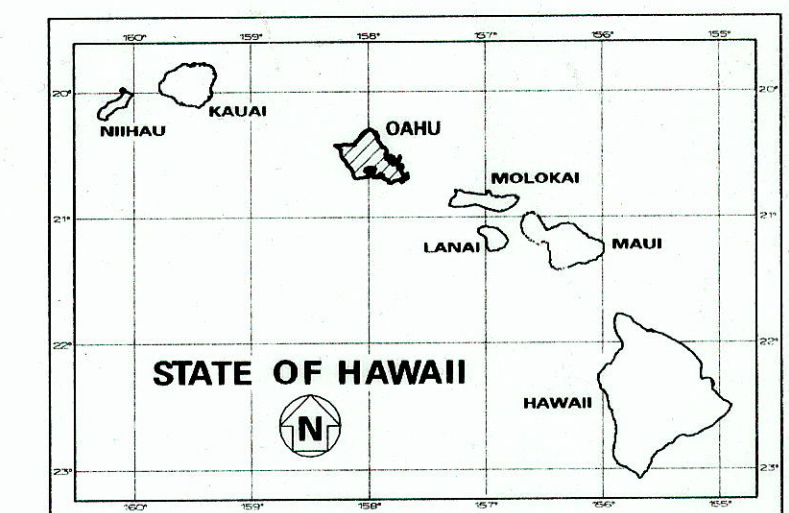

LOCATION OF PROJECT

PROJECT LIMITS

