



FED. ROAD DIST. NO.	STATE	FED. AID PROJ. NO.	FISCAL YEAR	SHEET NO.	TOTAL SHEETS
HAWAII	HAW.	65AB-01-04M	2012	7	81

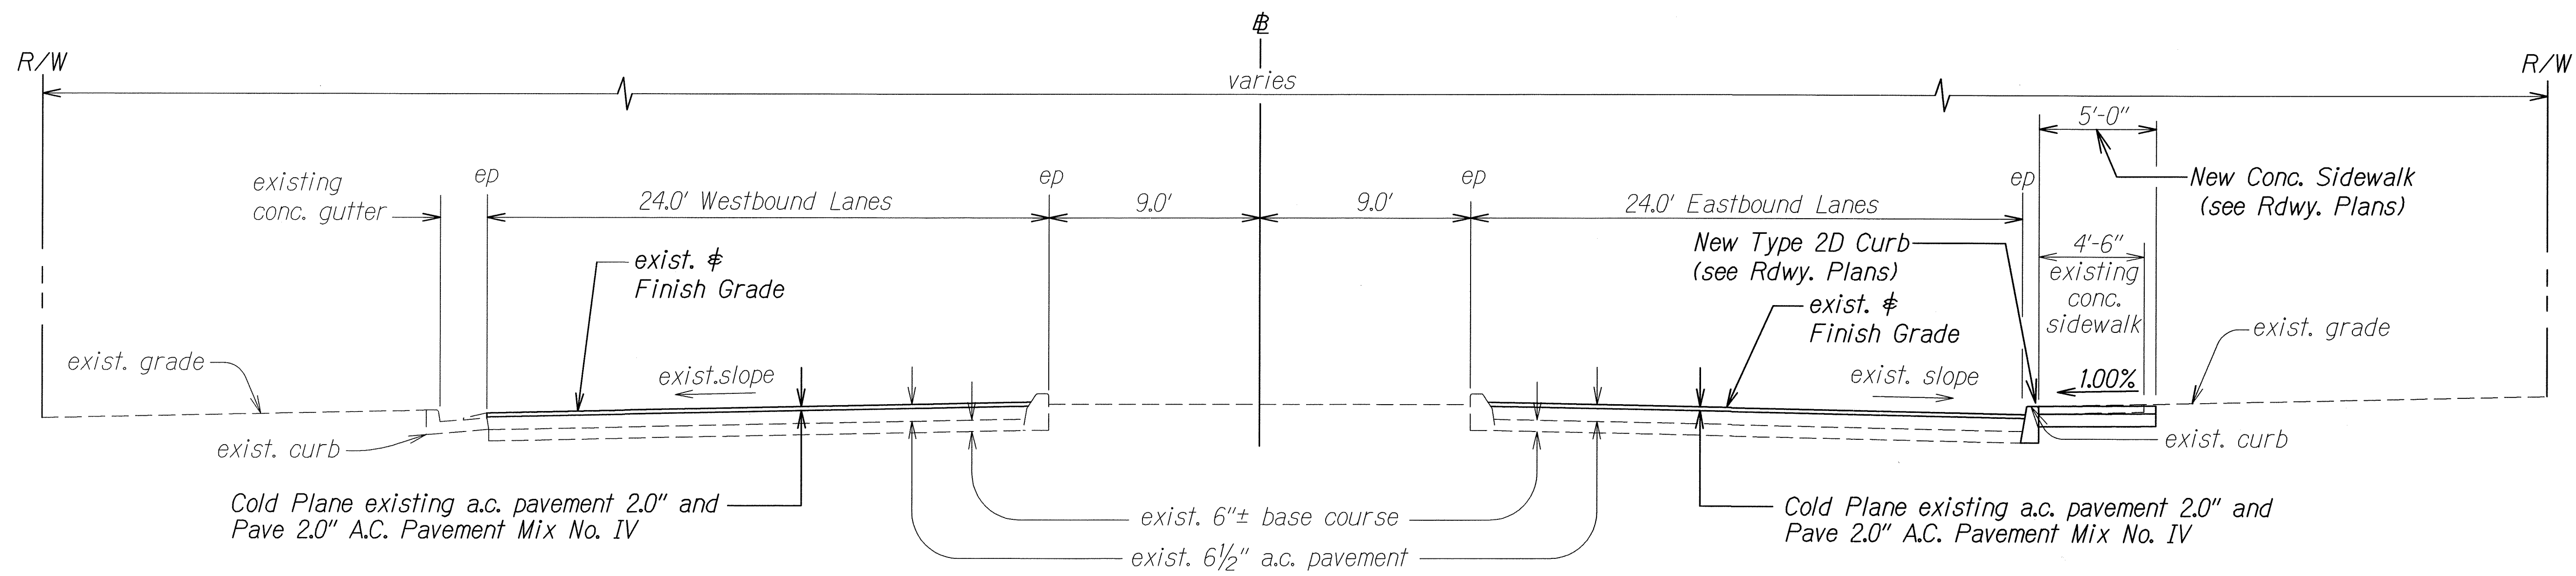

TYPICAL SECTION
 Sta. 2+90 to Sta. 16+00
 Scale: 1/4"=1'-0"

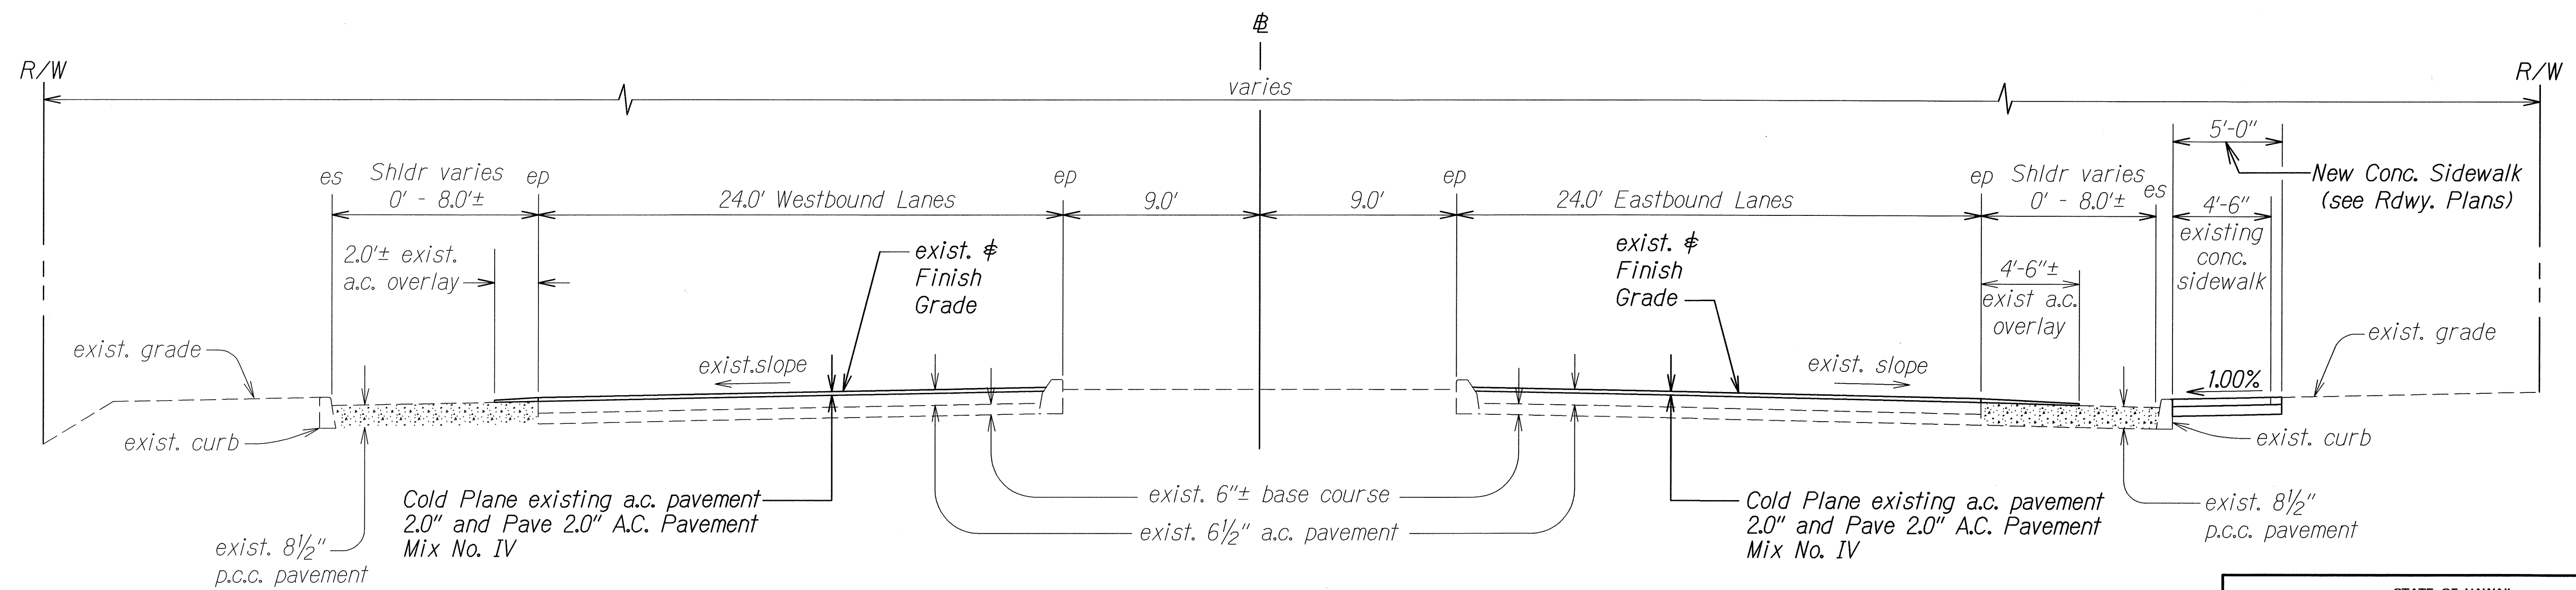


TYPICAL SECTION
 Sta. 16+00 to Sta. 21+00
 Scale: 1/4"=1'-0"

ORIGINAL PLAN	DATE
NOTED BY	DESIGNED BY
QUANTITIES BY	CHECKED BY
5/20/12	


STATE OF HAWAII
DEPARTMENT OF TRANSPORTATION
HIGHWAYS DIVISION

TYPICAL SECTION
KANEOHE BAY DRIVE REHABILITATION
Kamehameha Highway to Nanamoana Street
Project No. 65AB-01-04M
Scale: 1/4" = 1'-0" Date: May, 2012
SHEET No. 1 OF 5 SHEETS

FED. ROAD DIST. NO.	STATE	FED. AID PROJ. NO.	FISCAL YEAR	SHEET NO.	TOTAL SHEETS
HAWAII	HAW.	65AB-01-04M	2012	ADD. 8	81

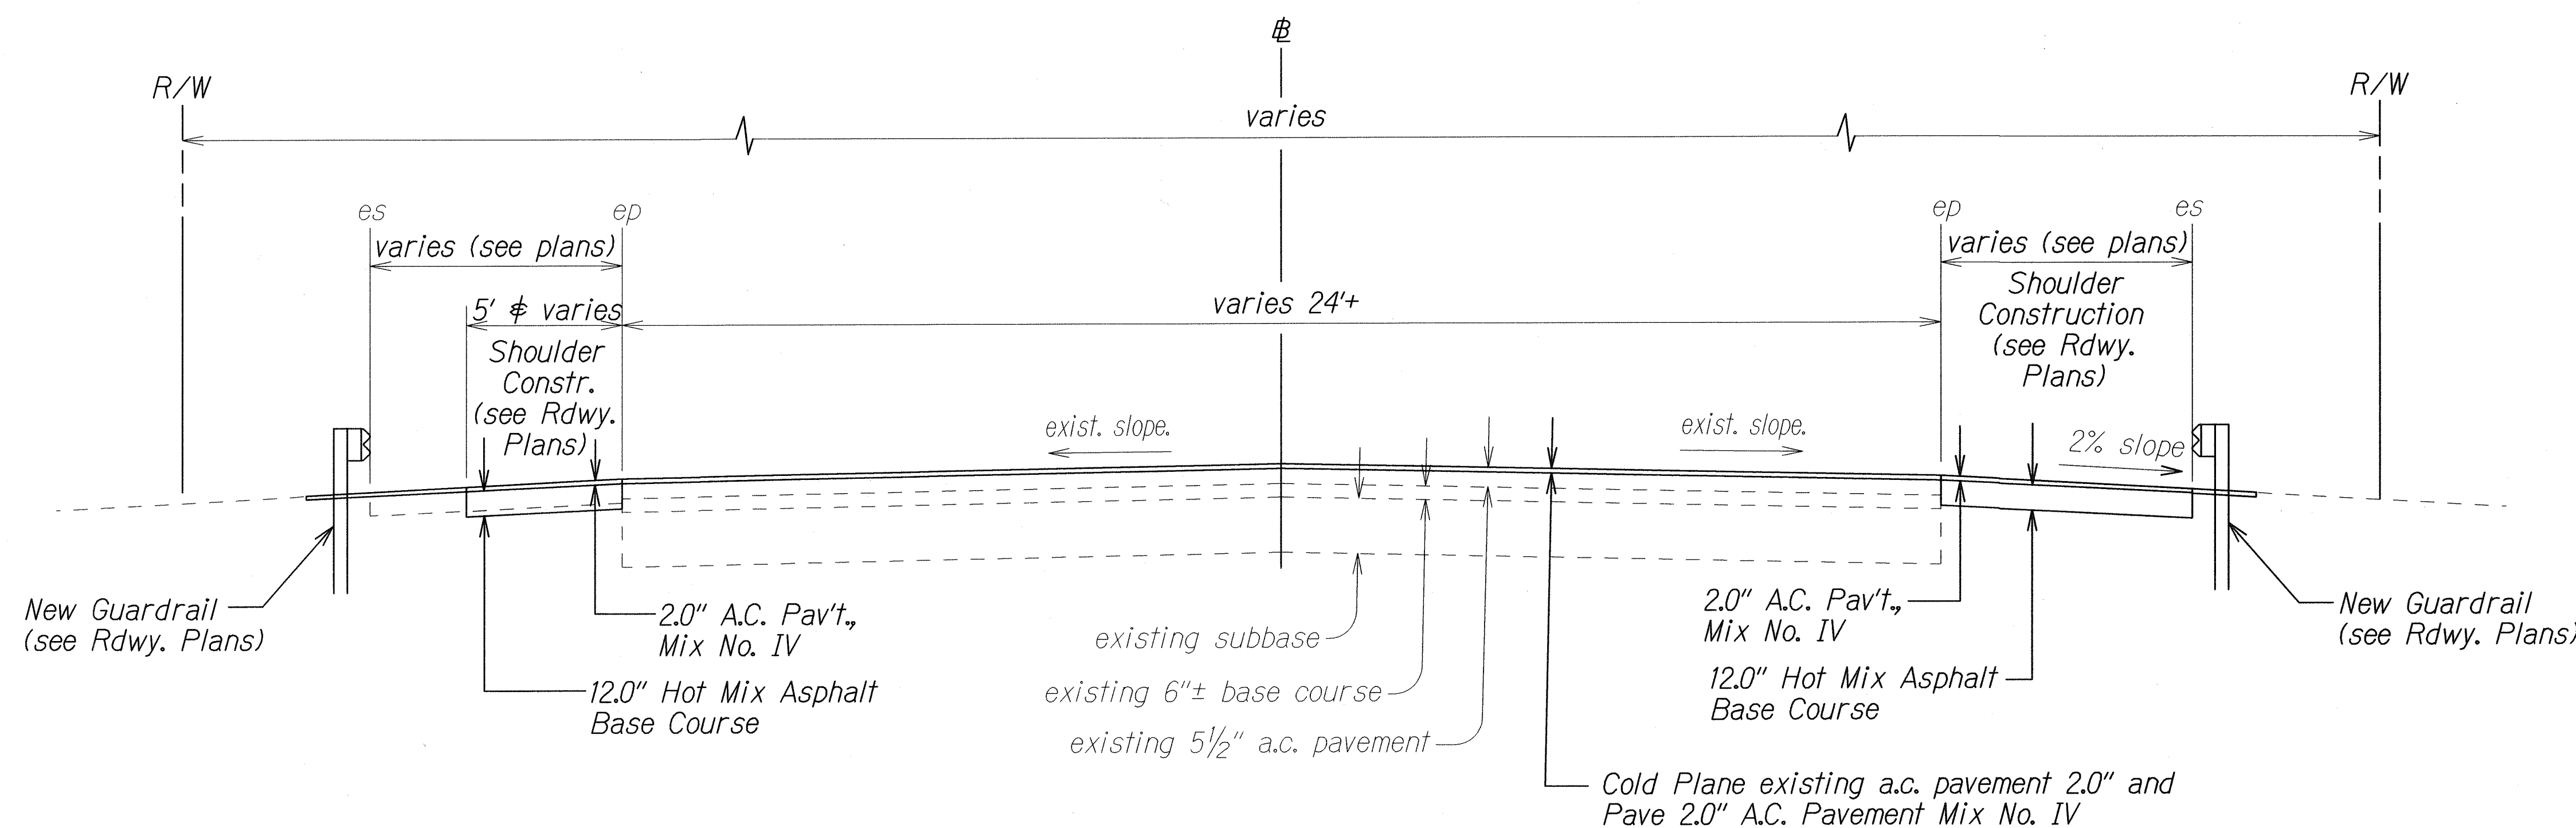

△ TYPICAL SECTION
⊥ STA. 35+27.70± TO ⊥ STA. 36+20±
 Scale: 1/4"=1'-0"

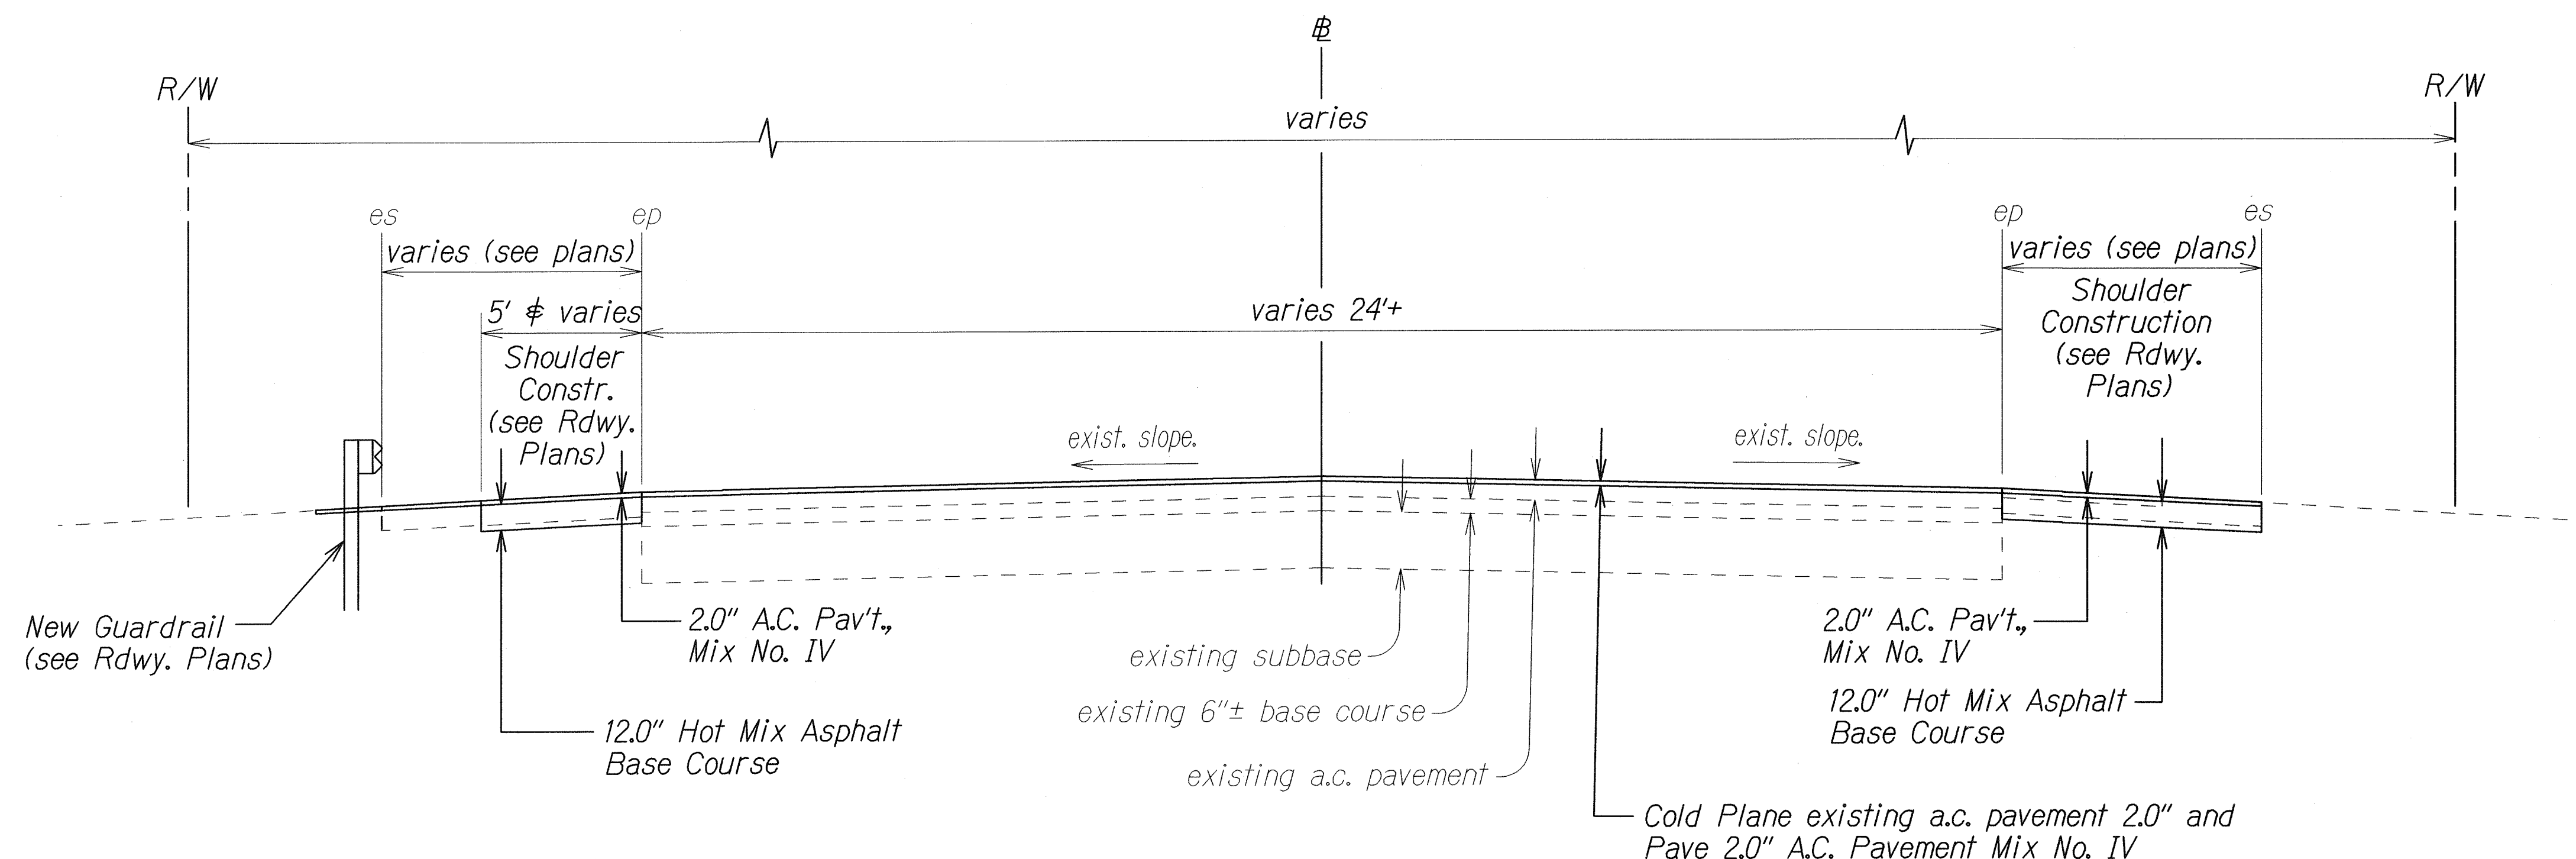


△ TYPICAL SECTION
⊥ STA. 36+20± TO ⊥ STA. 46+00±
⊥ STA. 86+20± TO ⊥ STA. 91+00±
 Scale: 1/4"=1'-0"

ORIGINAL PLAN	SURVEY PLOTTED BY	DATE
NOTED	DRAWN BY	
NOTED	DESIGNED BY	
NOTED	CHECKED BY	
NOTED	CHECKED BY	


6/8/12	△ Revised pavement structure.
DATE	REVISION

STATE OF HAWAII DEPARTMENT OF TRANSPORTATION HIGHWAYS DIVISION
TYPICAL SECTION
KANEHOE BAY DRIVE REHABILITATION Kamehameha Highway to Nanamoana Street Project No. 65AB-01-04M
Scale: 1/4" = 1'-0" Date: May, 2012
SHEET No. 2 OF 5 SHEETS

FED. ROAD DIST. NO.	STATE	FED. AID PROJ. NO.	FISCAL YEAR	SHEET NO.	TOTAL SHEETS
HAWAII	HAW.	65AB-01-04M	2012	ADD. 9	81

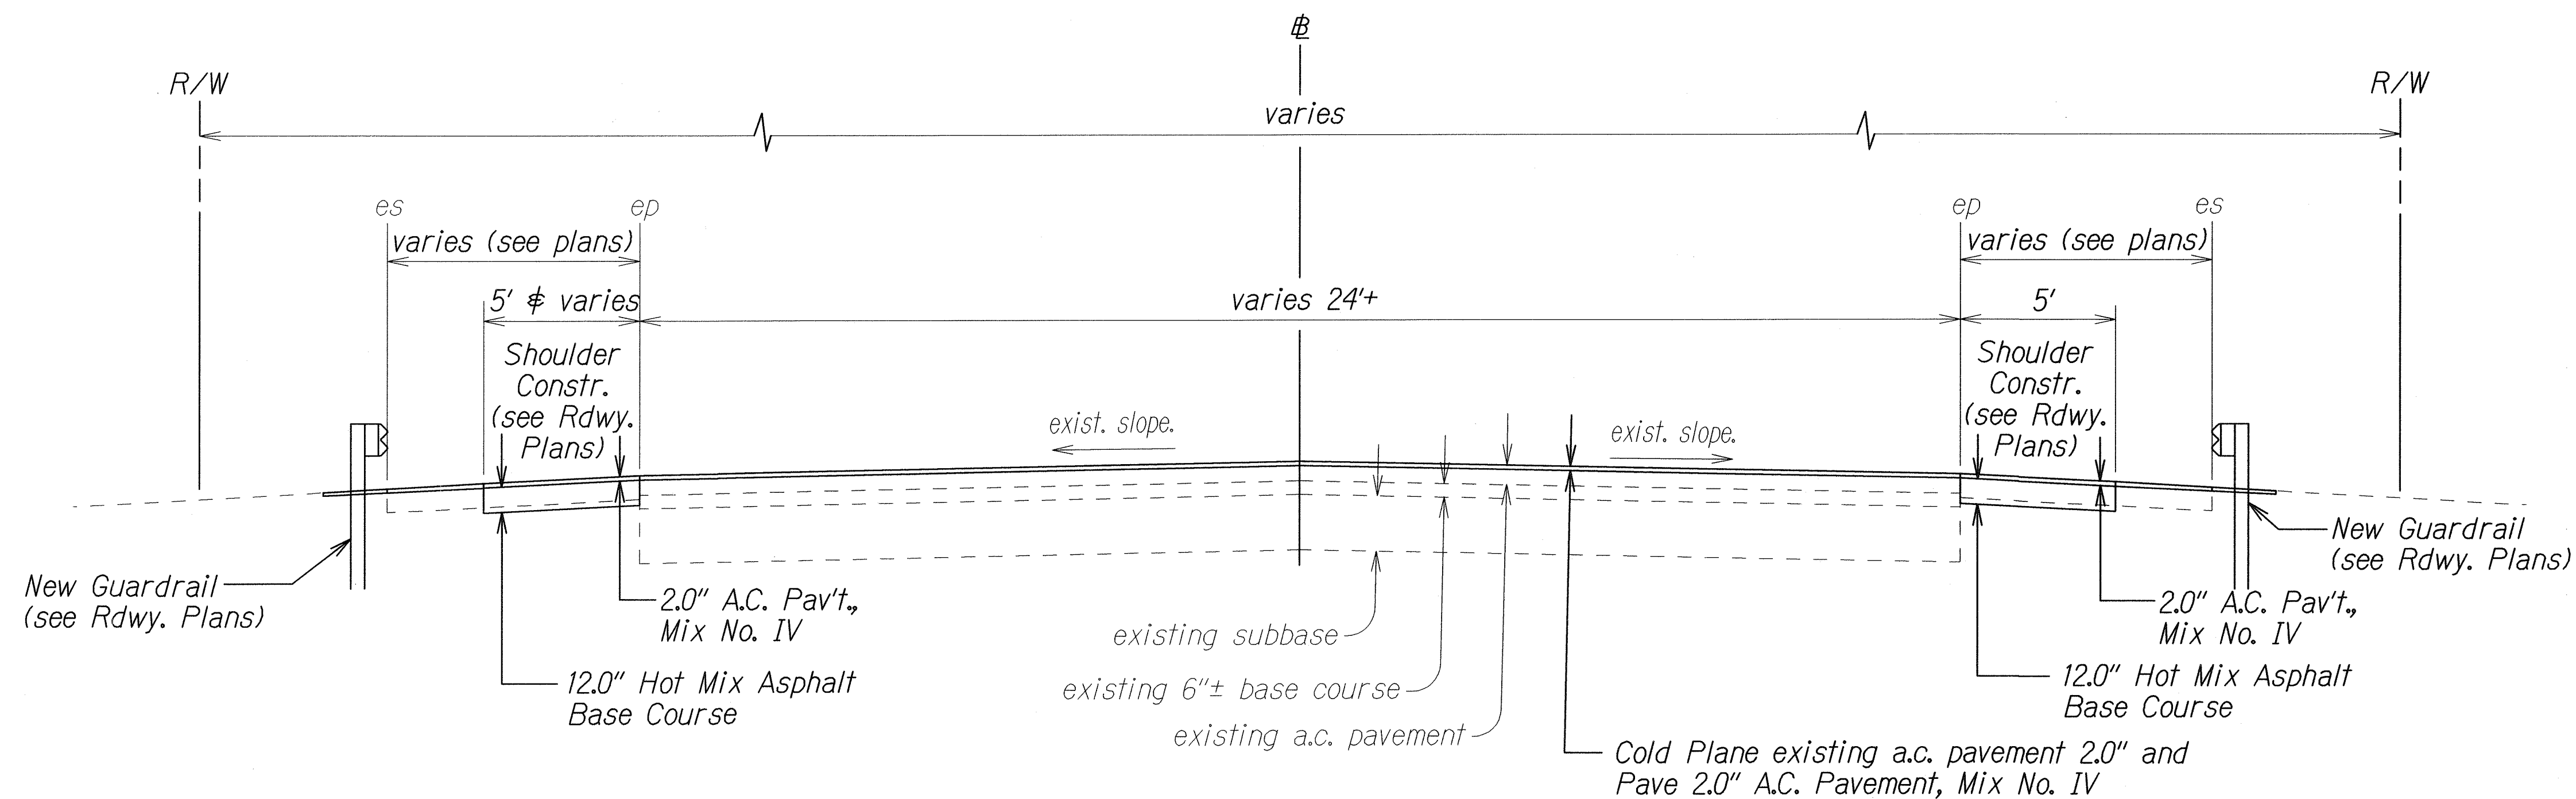

△ TYPICAL SECTION
B STA. 46+00± to B STA. 59+00±
B STA. 67+00± to B STA. 68+00±
B STA. 77+50± to B STA. 82+00±
B STA. 0+40± to B STA. 1+60±
 Scale: 1/4"=1'-0"

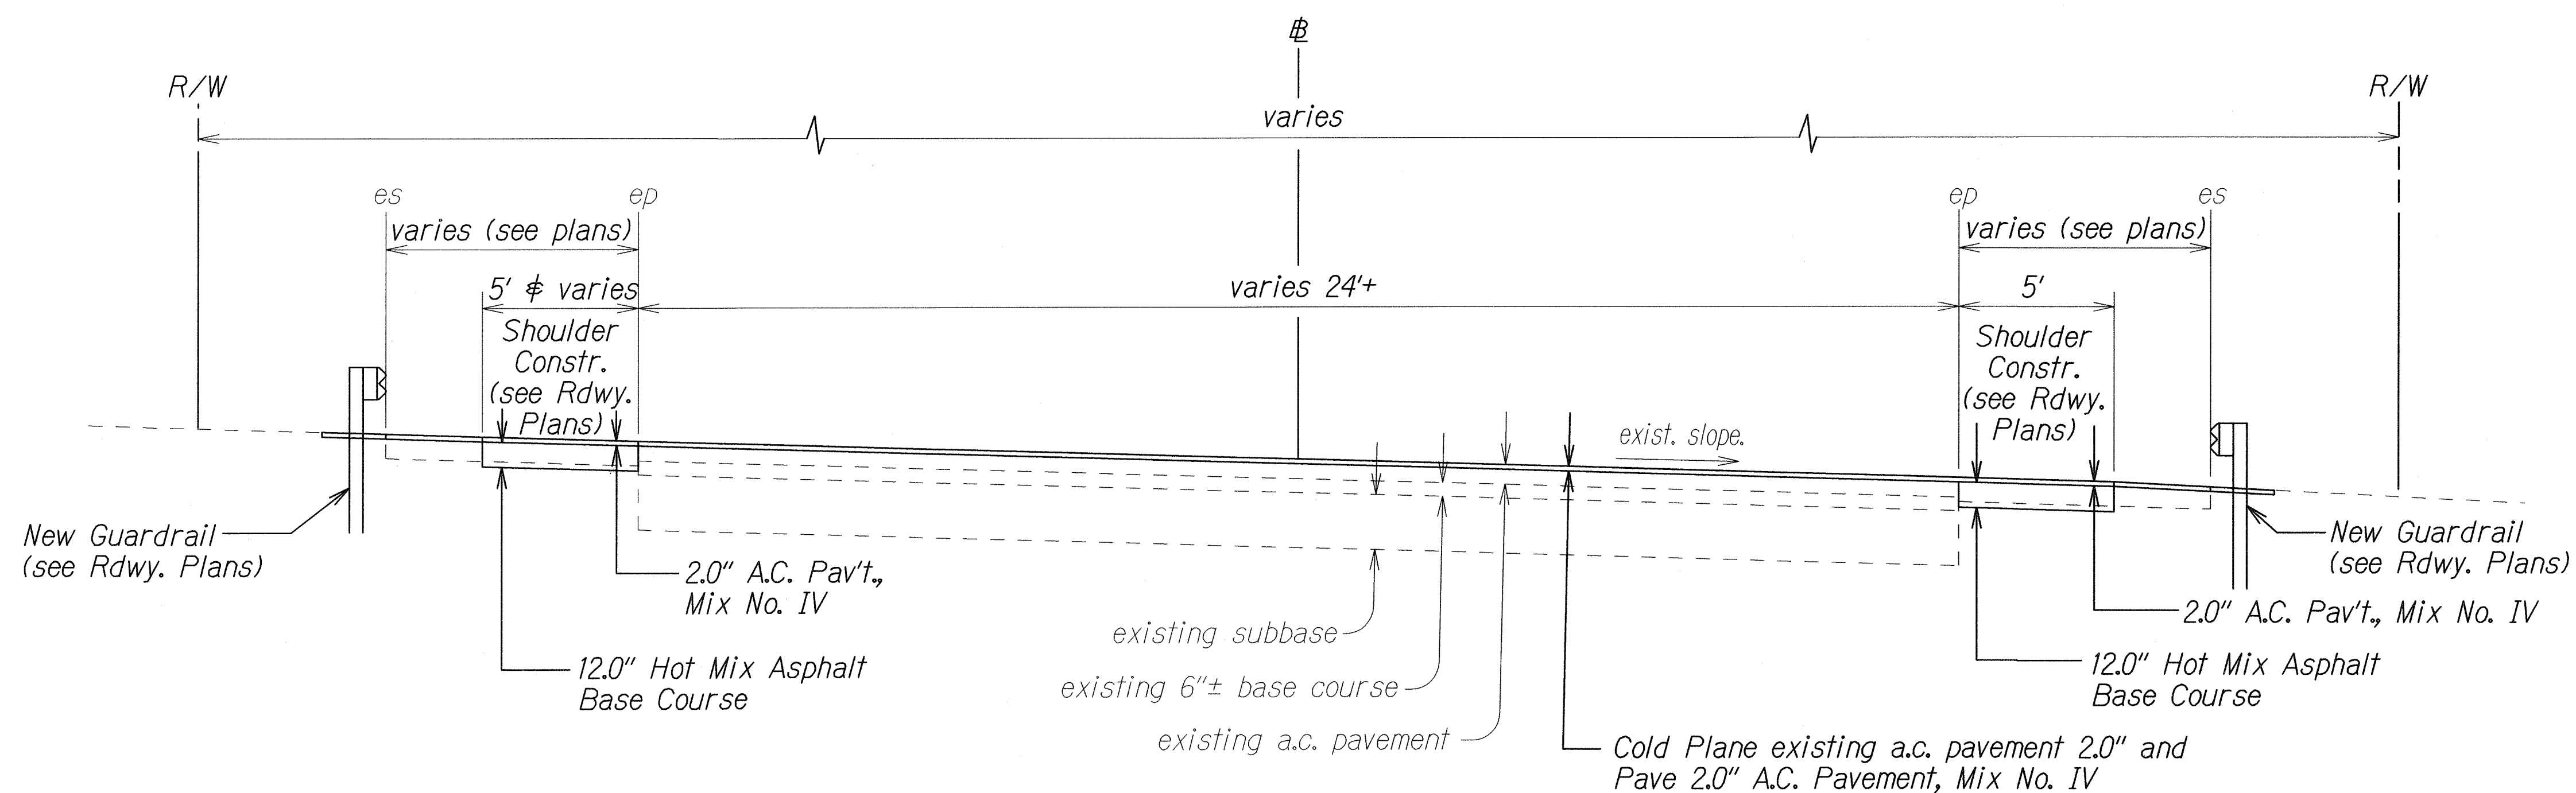


△ TYPICAL SUPERELEVATED SECTION
STA. 59+00± TO STA. 67+00±
STA. 68+00± TO STA. 77+50±
STA. 82+00± TO STA. 86+20±
 Scale: 1/4"=1'-0"


SURVEY PLOTTED BY	DATE
DRAWN BY	
TRACED BY	
QUANTITIES BY	
CHECKED BY	
ORIGINAL PLAN	
NOTE BOOK	
No. 54412103	

6/8/12	△ Revised pavement structure.
DATE	REVISION
STATE OF HAWAII DEPARTMENT OF TRANSPORTATION HIGHWAYS DIVISION	
TYPICAL SECTION	
KANEHOE BAY DRIVE REHABILITATION Kamehameha Highway to Nanamoana Street Project No. 65AB-01-04M	
Scale: 1/4" = 1'-0"	Date: May, 2012
SHEET No. 3 OF 5 SHEETS	

FED. ROAD DIST. NO.	STATE	FED. AID PROJ. NO.	FISCAL YEAR	SHEET NO.	TOTAL SHEETS
HAWAII	HAW.	65AB-01-04M	2012	10	81

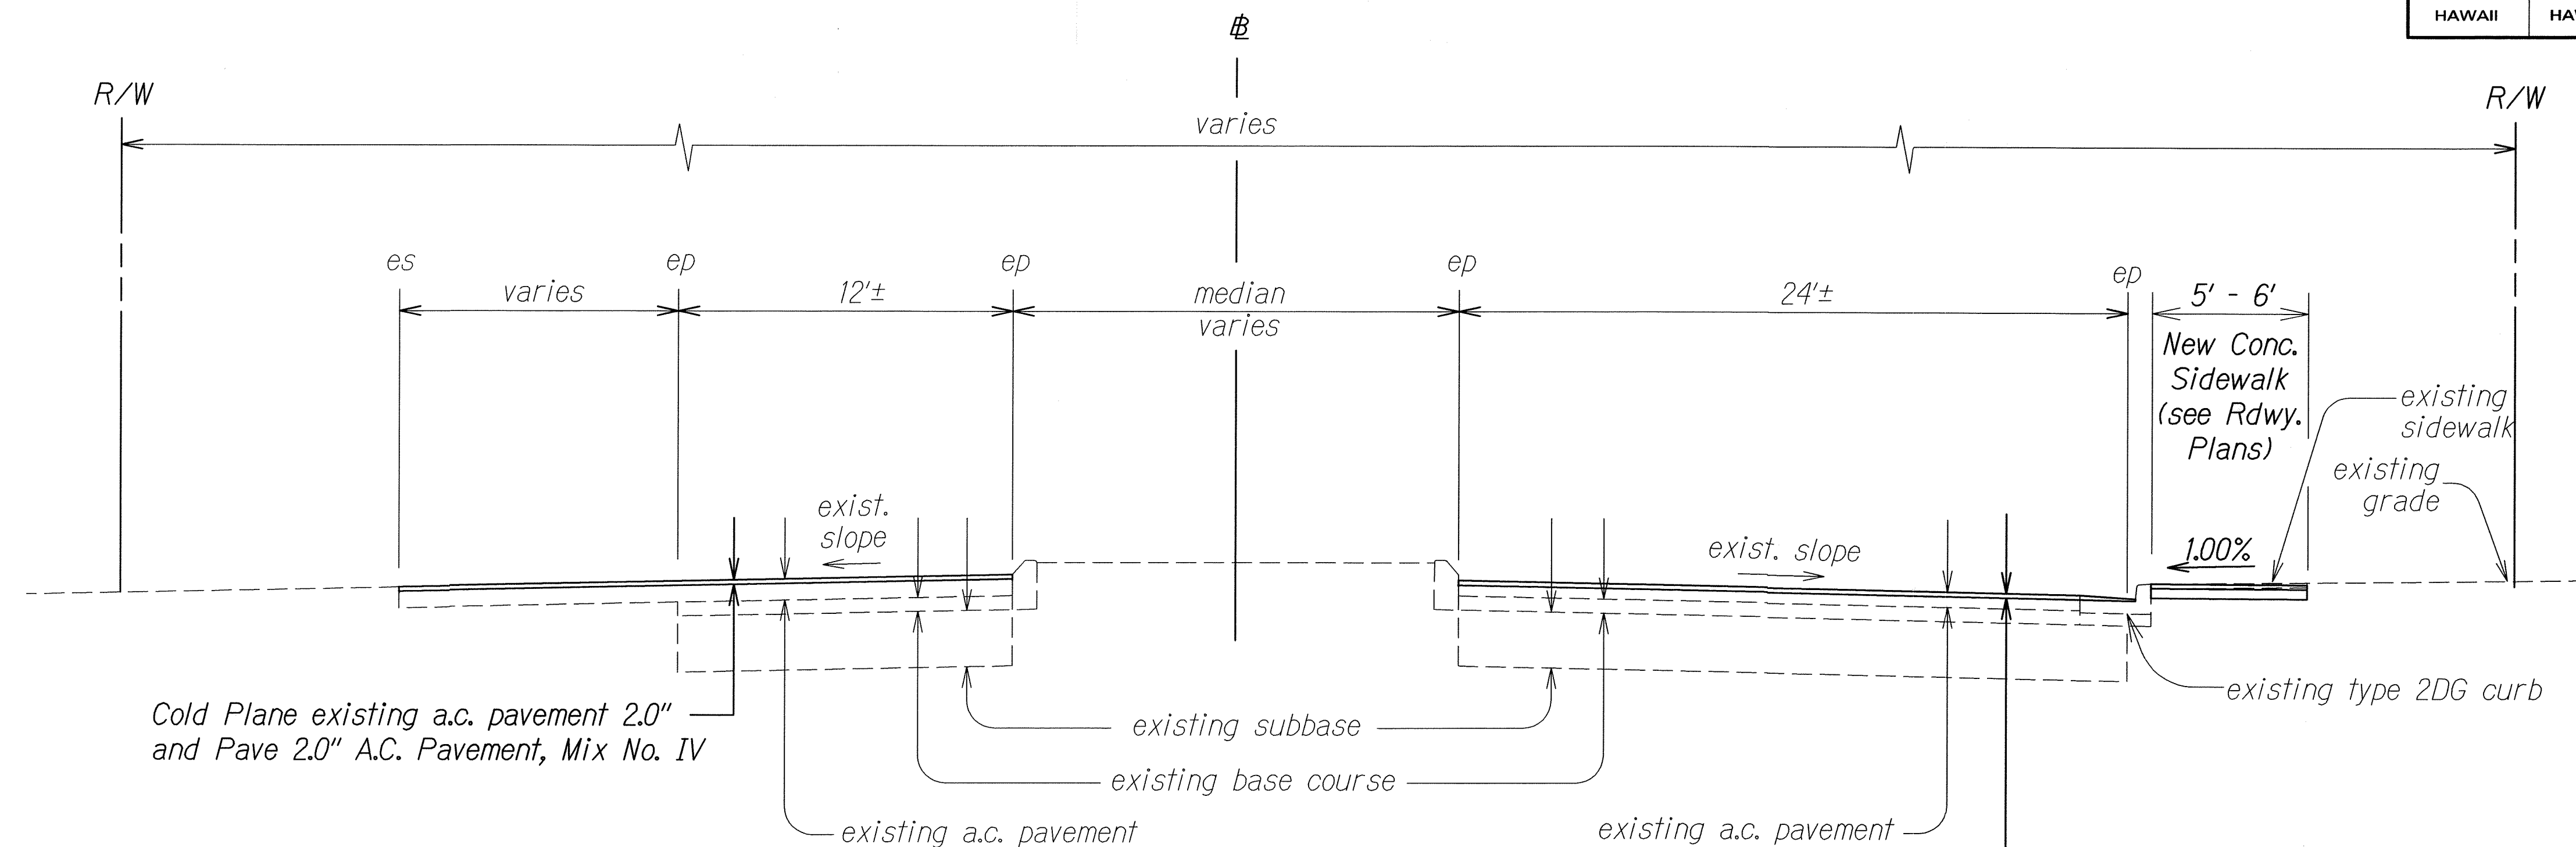

TYPICAL SECTION
 # STA. 91+00± TO # STA. 3+00±
 Scale: 1/4"=1'-0"

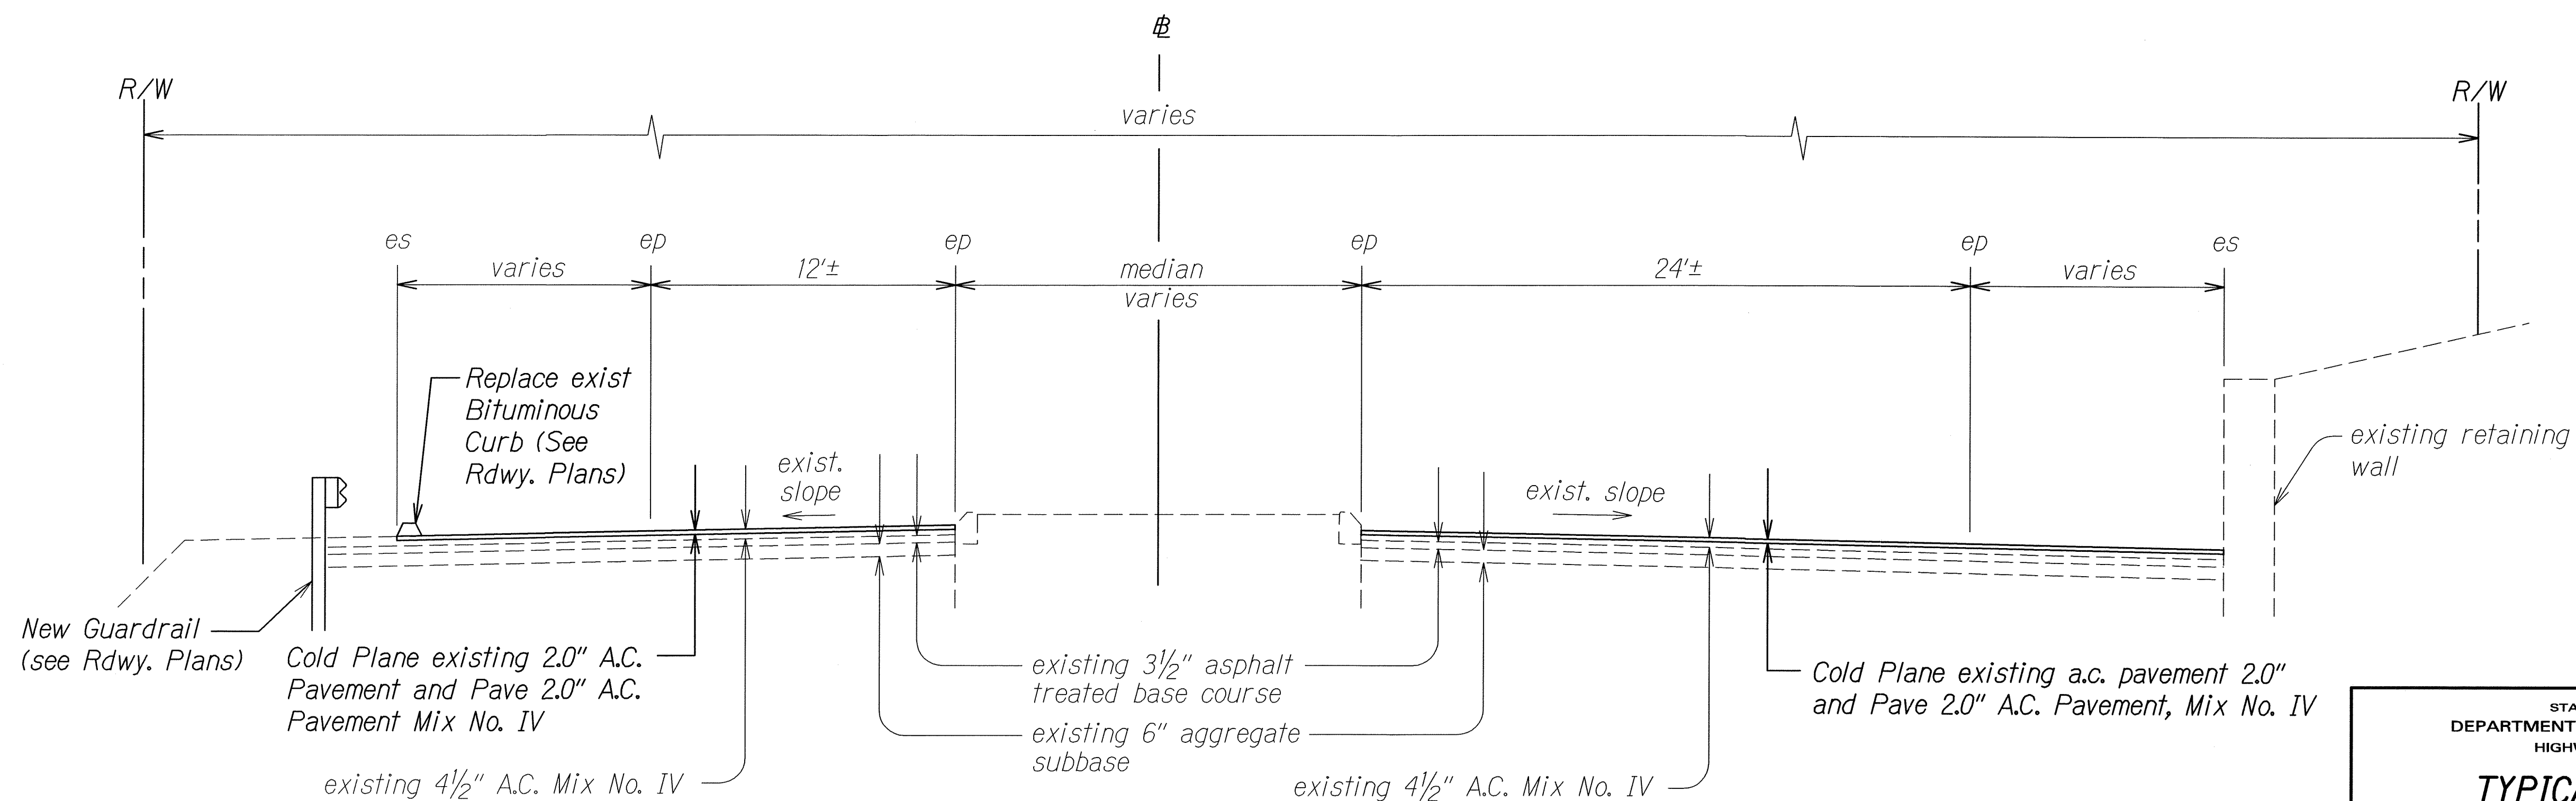

TYPICAL SECTION
 # STA. 3+00± TO # STA. 10+96±
 Scale: 1/4"=1'-0"

DESIGNED BY	DATE
TRACED BY	
NOTED BY	
CHECKED BY	
ORIGINAL PLAN	
NOTE BOOK	
QUANTITIES BY	
CHECKED BY	

STATE OF HAWAII
 DEPARTMENT OF TRANSPORTATION
 HIGHWAYS DIVISION


TYPICAL SECTION

KANEHOE BAY DRIVE REHABILITATION
 Kaneohe Highway to Nanamoa Street
 Project No. 65AB-01-04M


Scale: 1/4" = 1'-0" Date: May, 2012

SHEET No. 4 OF 5 SHEETS


FED. ROAD DIST. NO.	STATE	PROJ. NO.	FISCAL YEAR	SHEET NO.	TOTAL SHEETS
HAWAII	HAW.	65AB-01-04M	2012	ADD.11	81

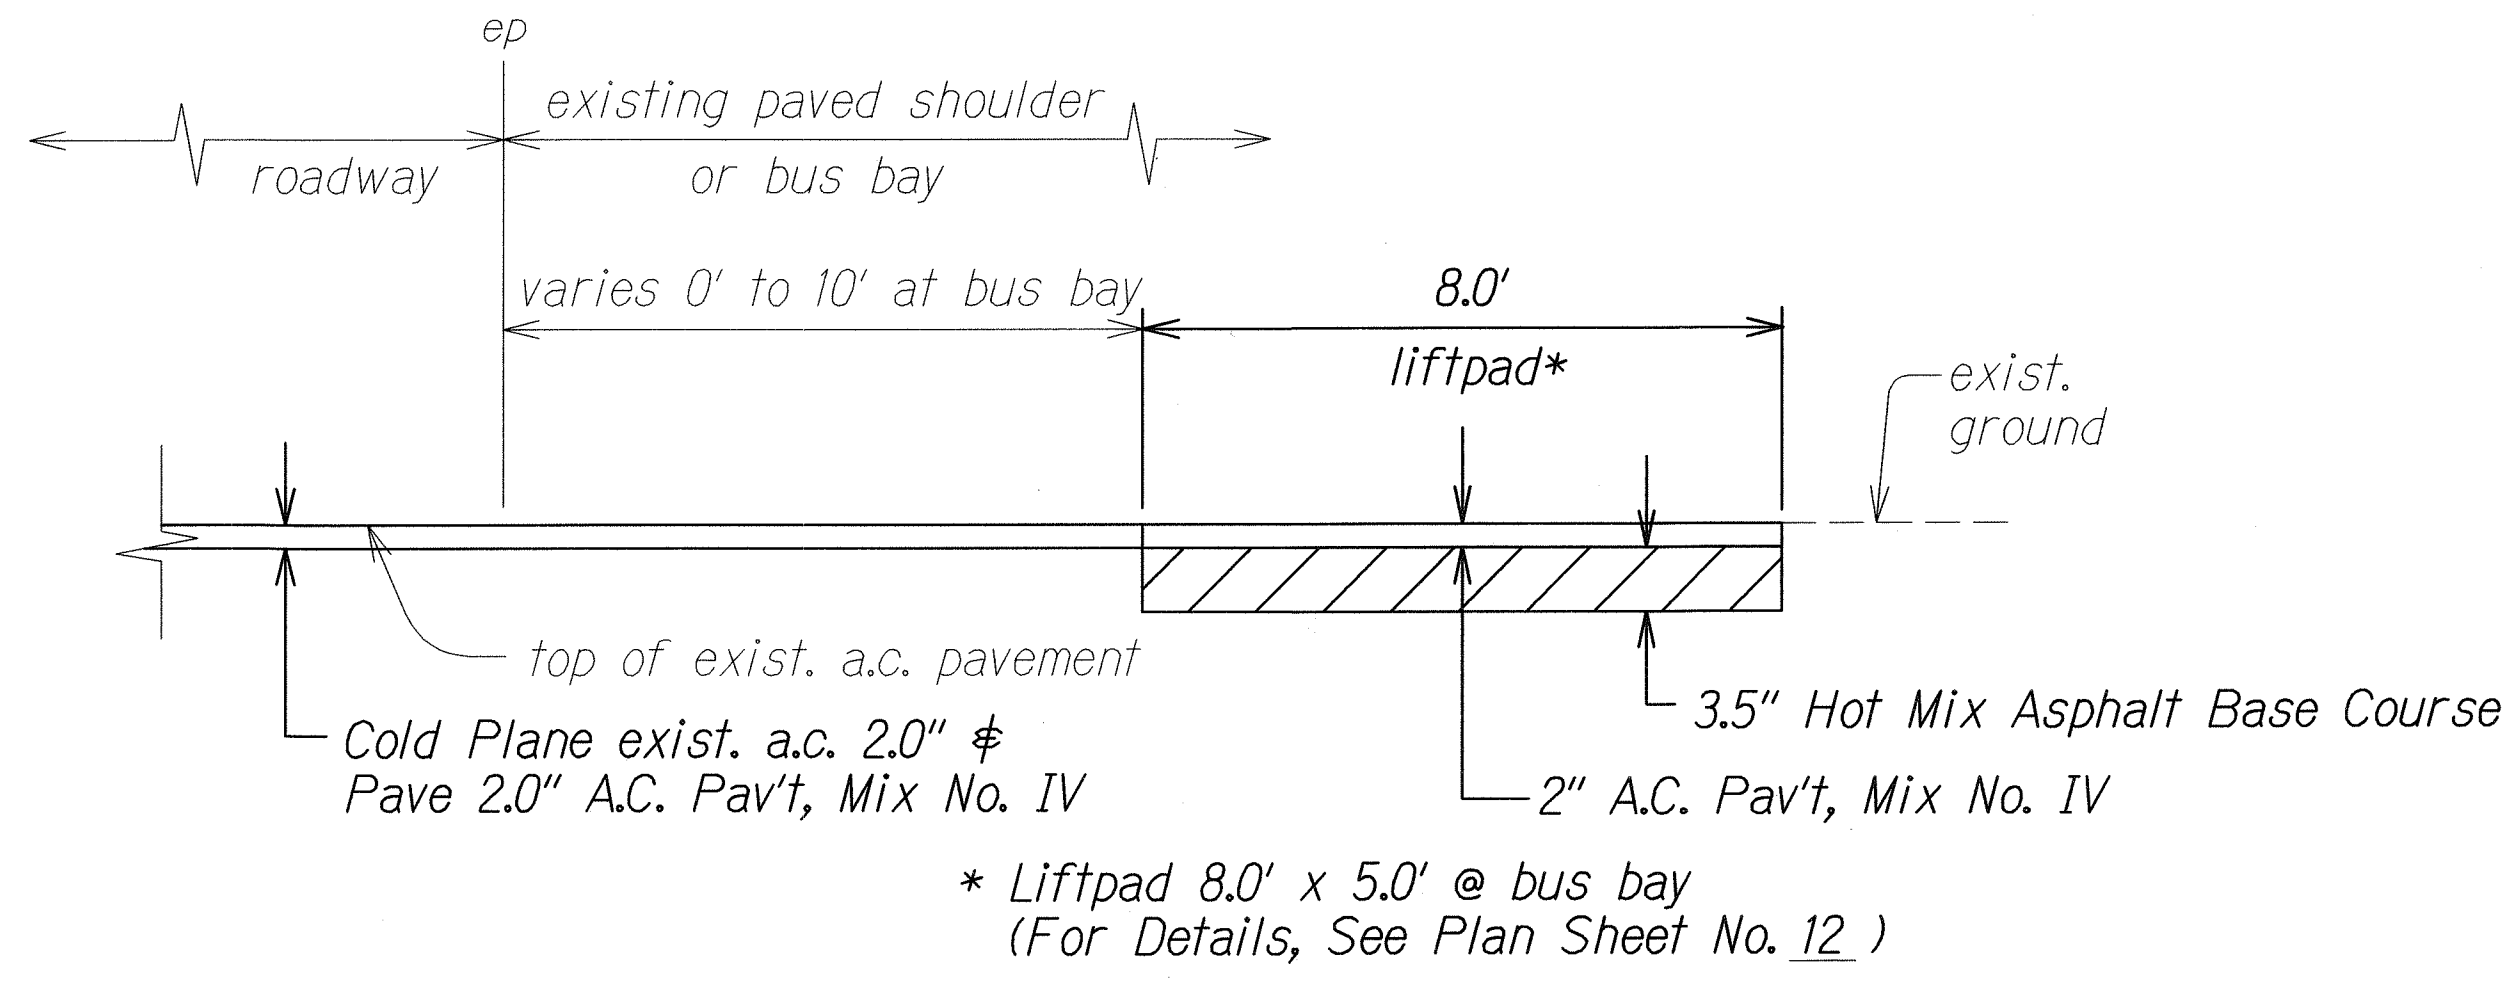


TYPICAL SECTION OF BUS BAY LIFT PAD
Scale: N.T.S.

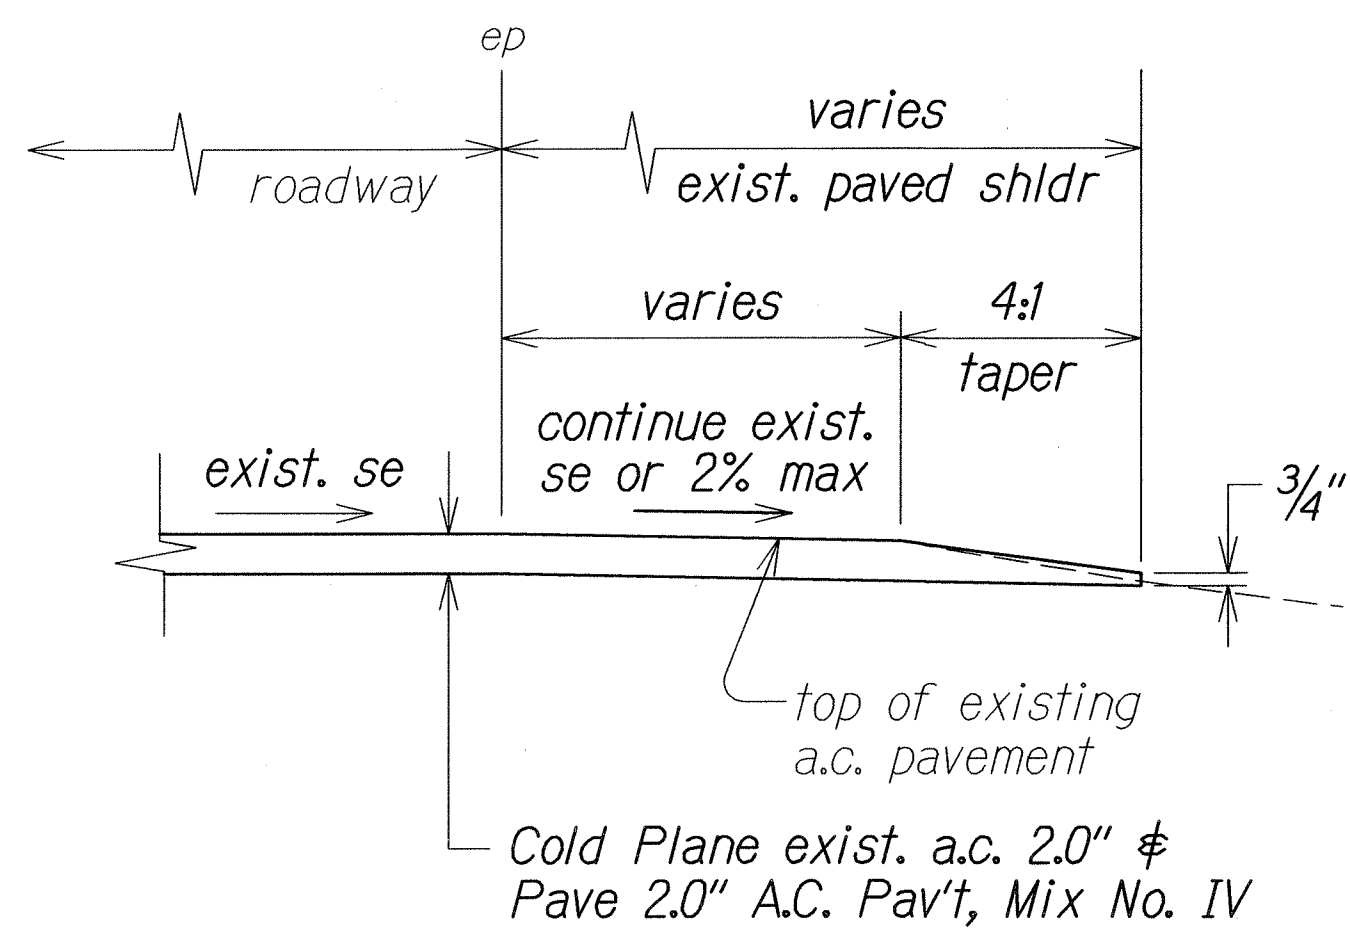


TYPICAL SECTION AT EXISTING PAVED SHOULDERS
Scale: N.T.S.

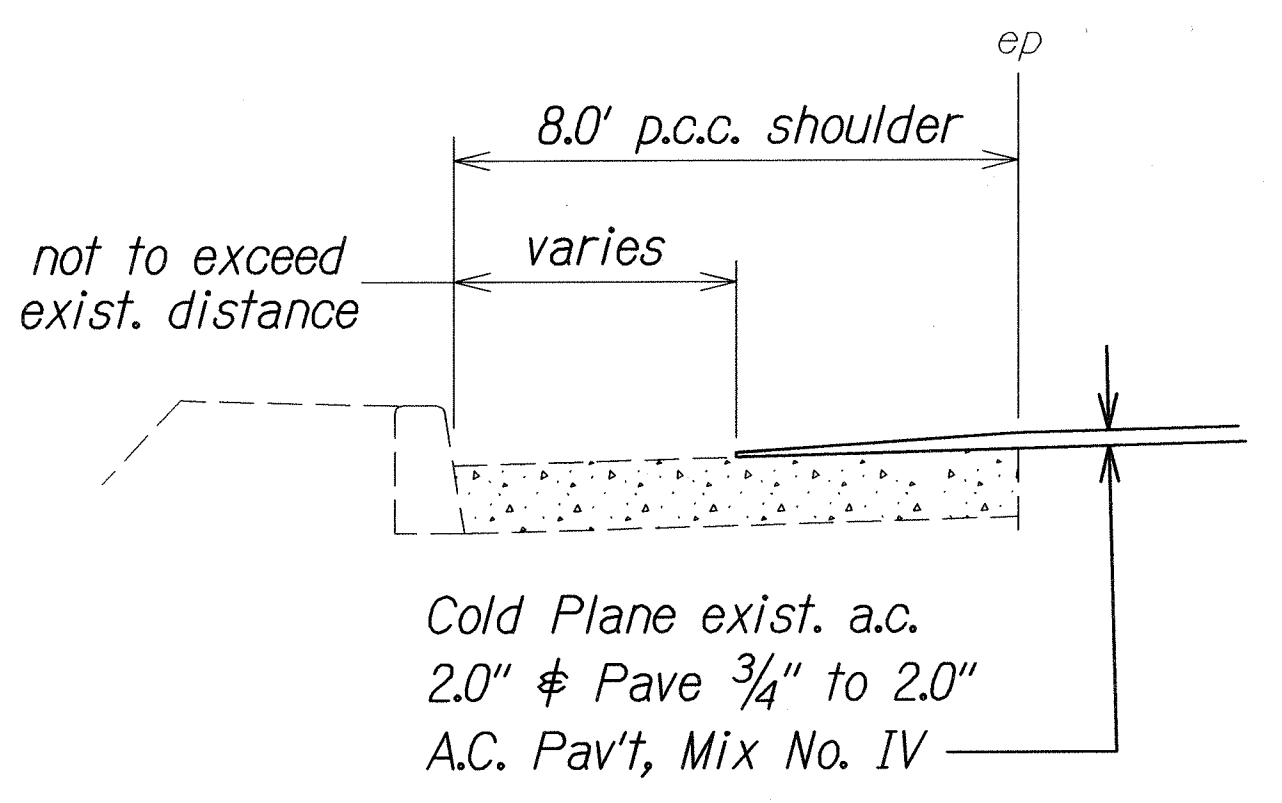


TYPICAL SECTION AC PAVEMENT @ 8' CONC. SHLDR
Scale: N.T.S.

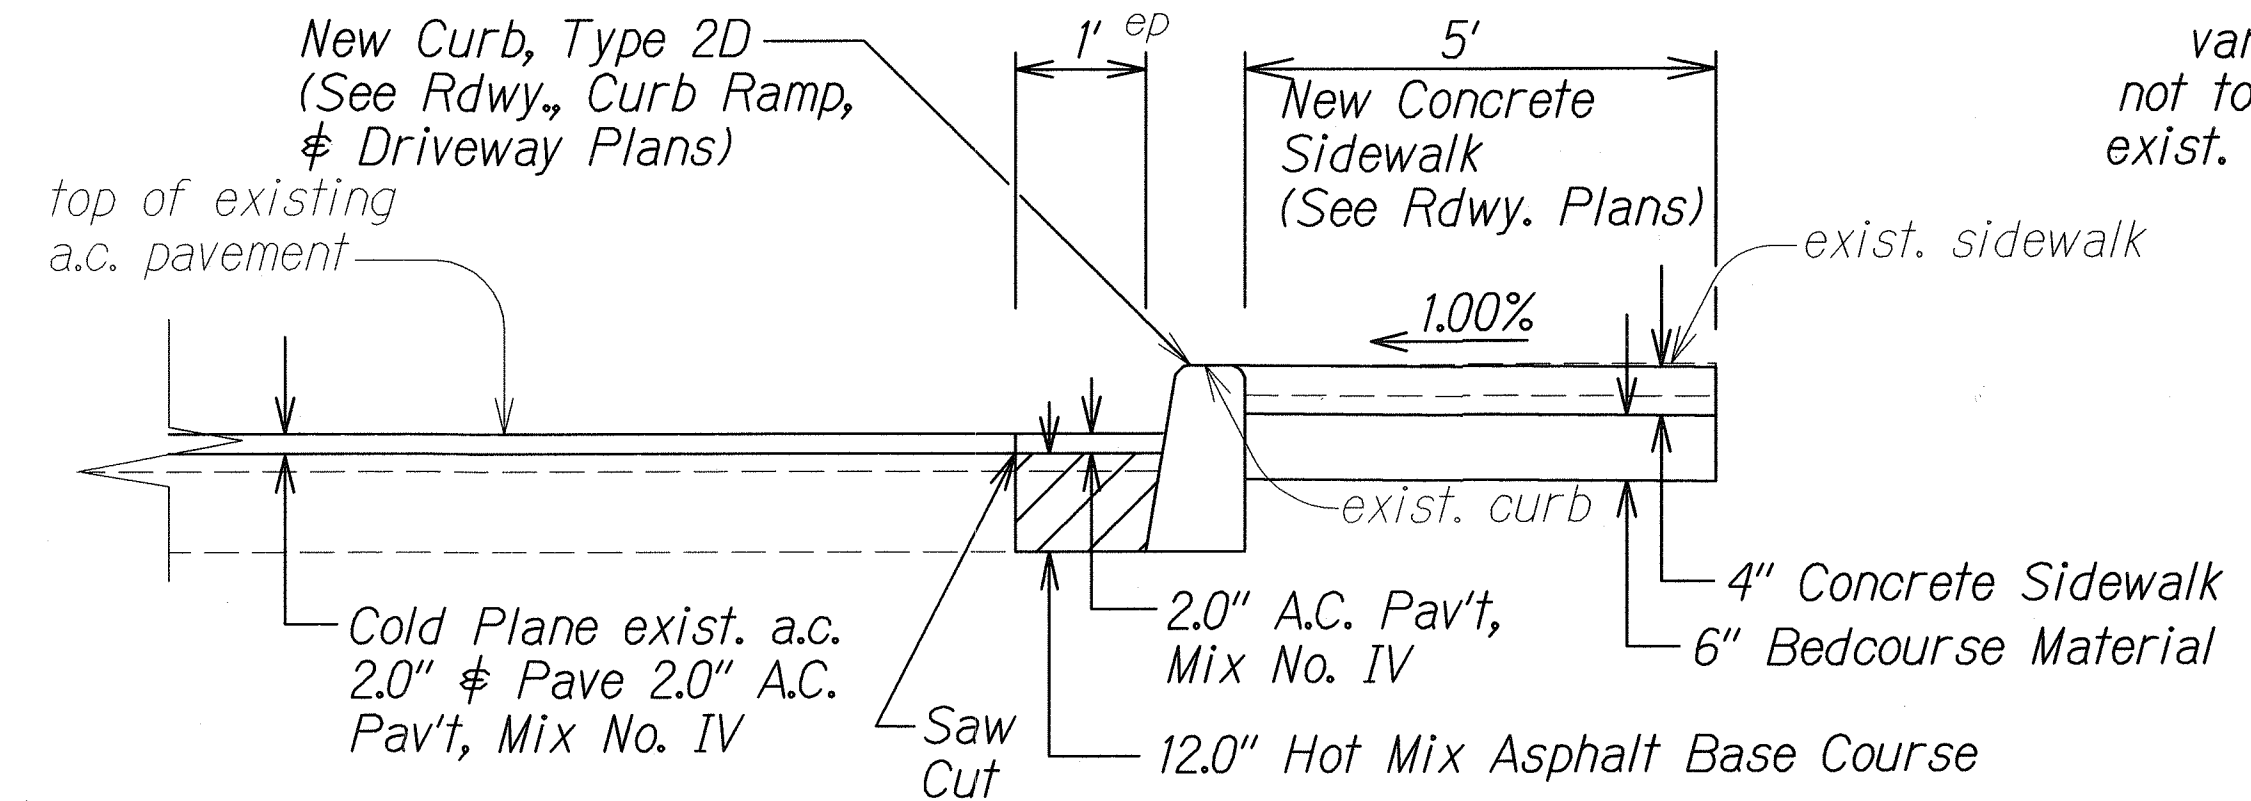


TYPICAL SECTION CURB/SIDEWALK CONSTRUCTION
STA. 2+41± TO STA. 16+00±
Scale: N.T.S.

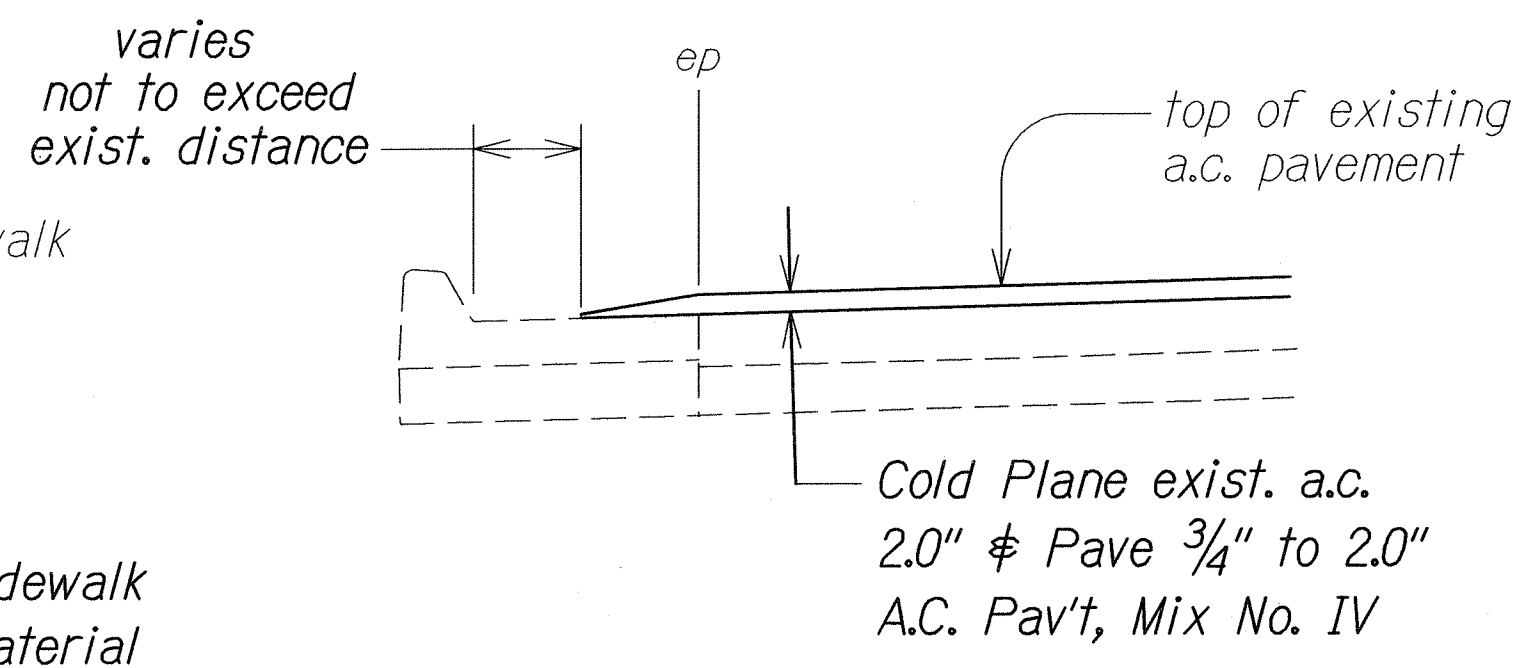

TYPICAL SECTION AC PAVEMENT @ CURB & GUTTER
Scale: N.T.S.

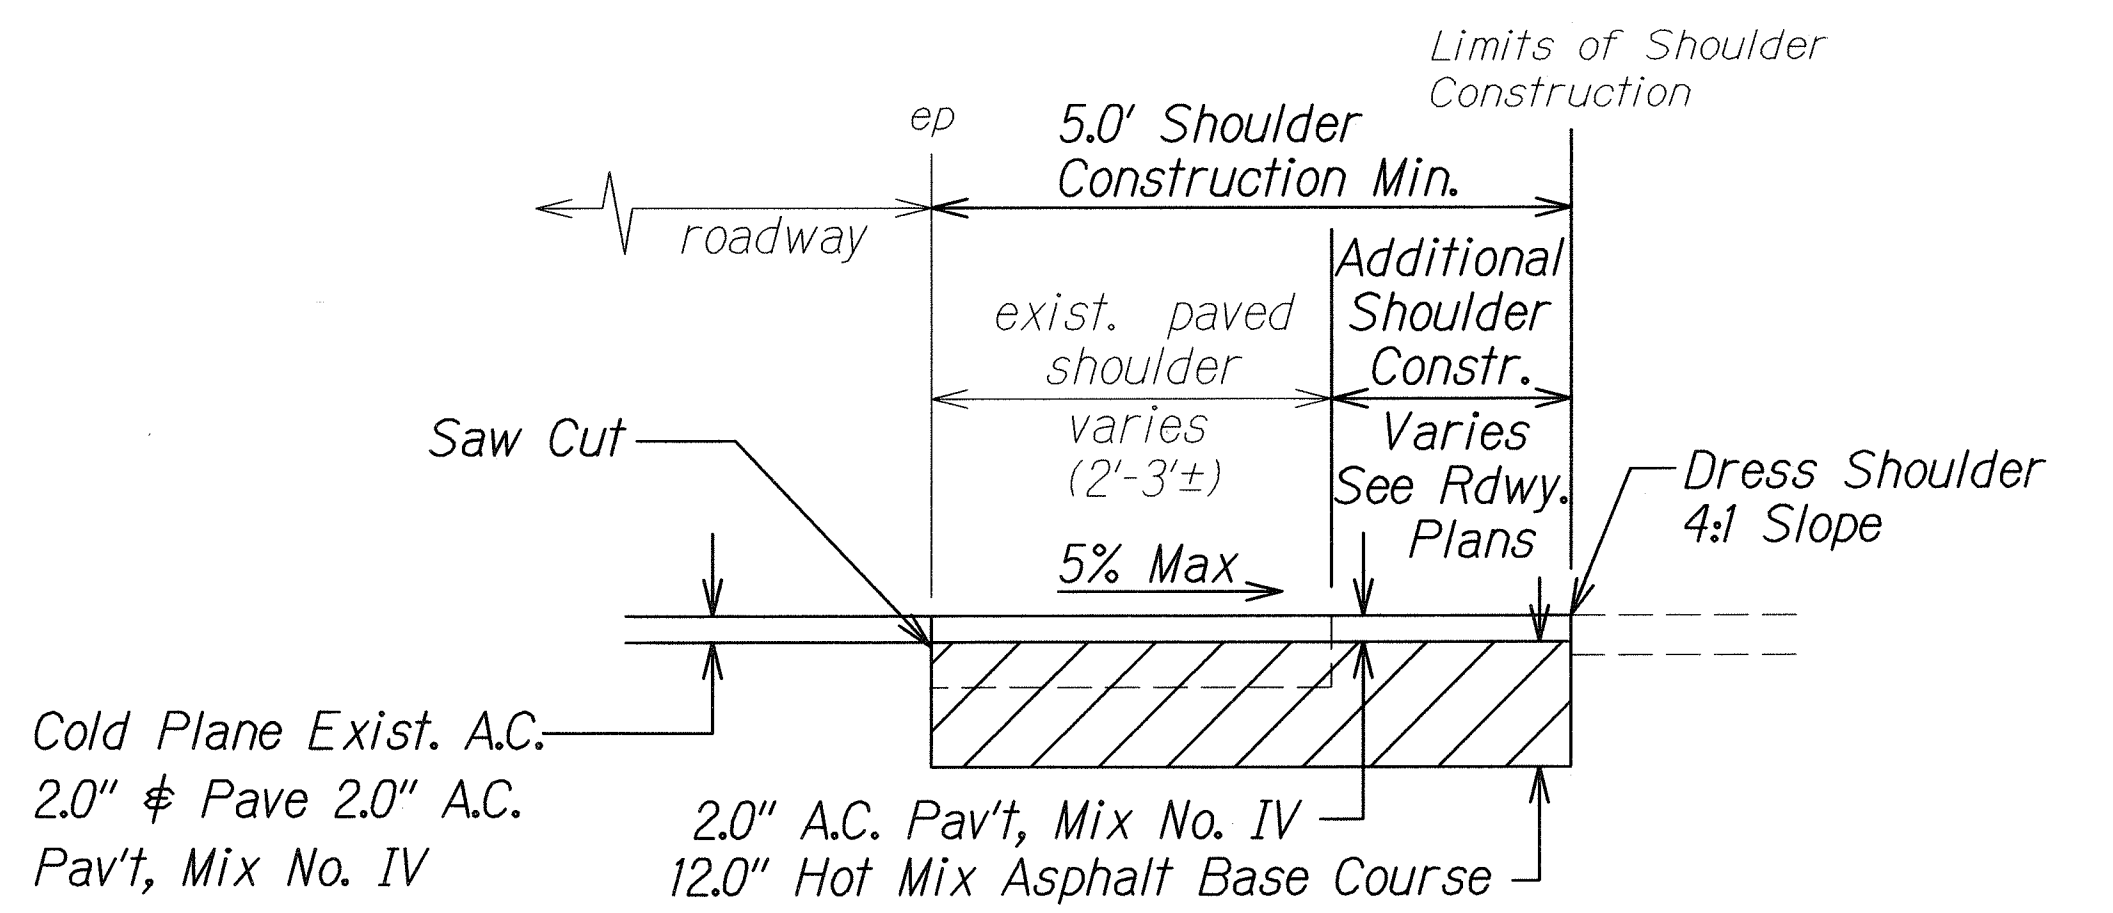

TYPICAL SECTION SHOULDER CONSTRUCTION
Scale: N.T.S.

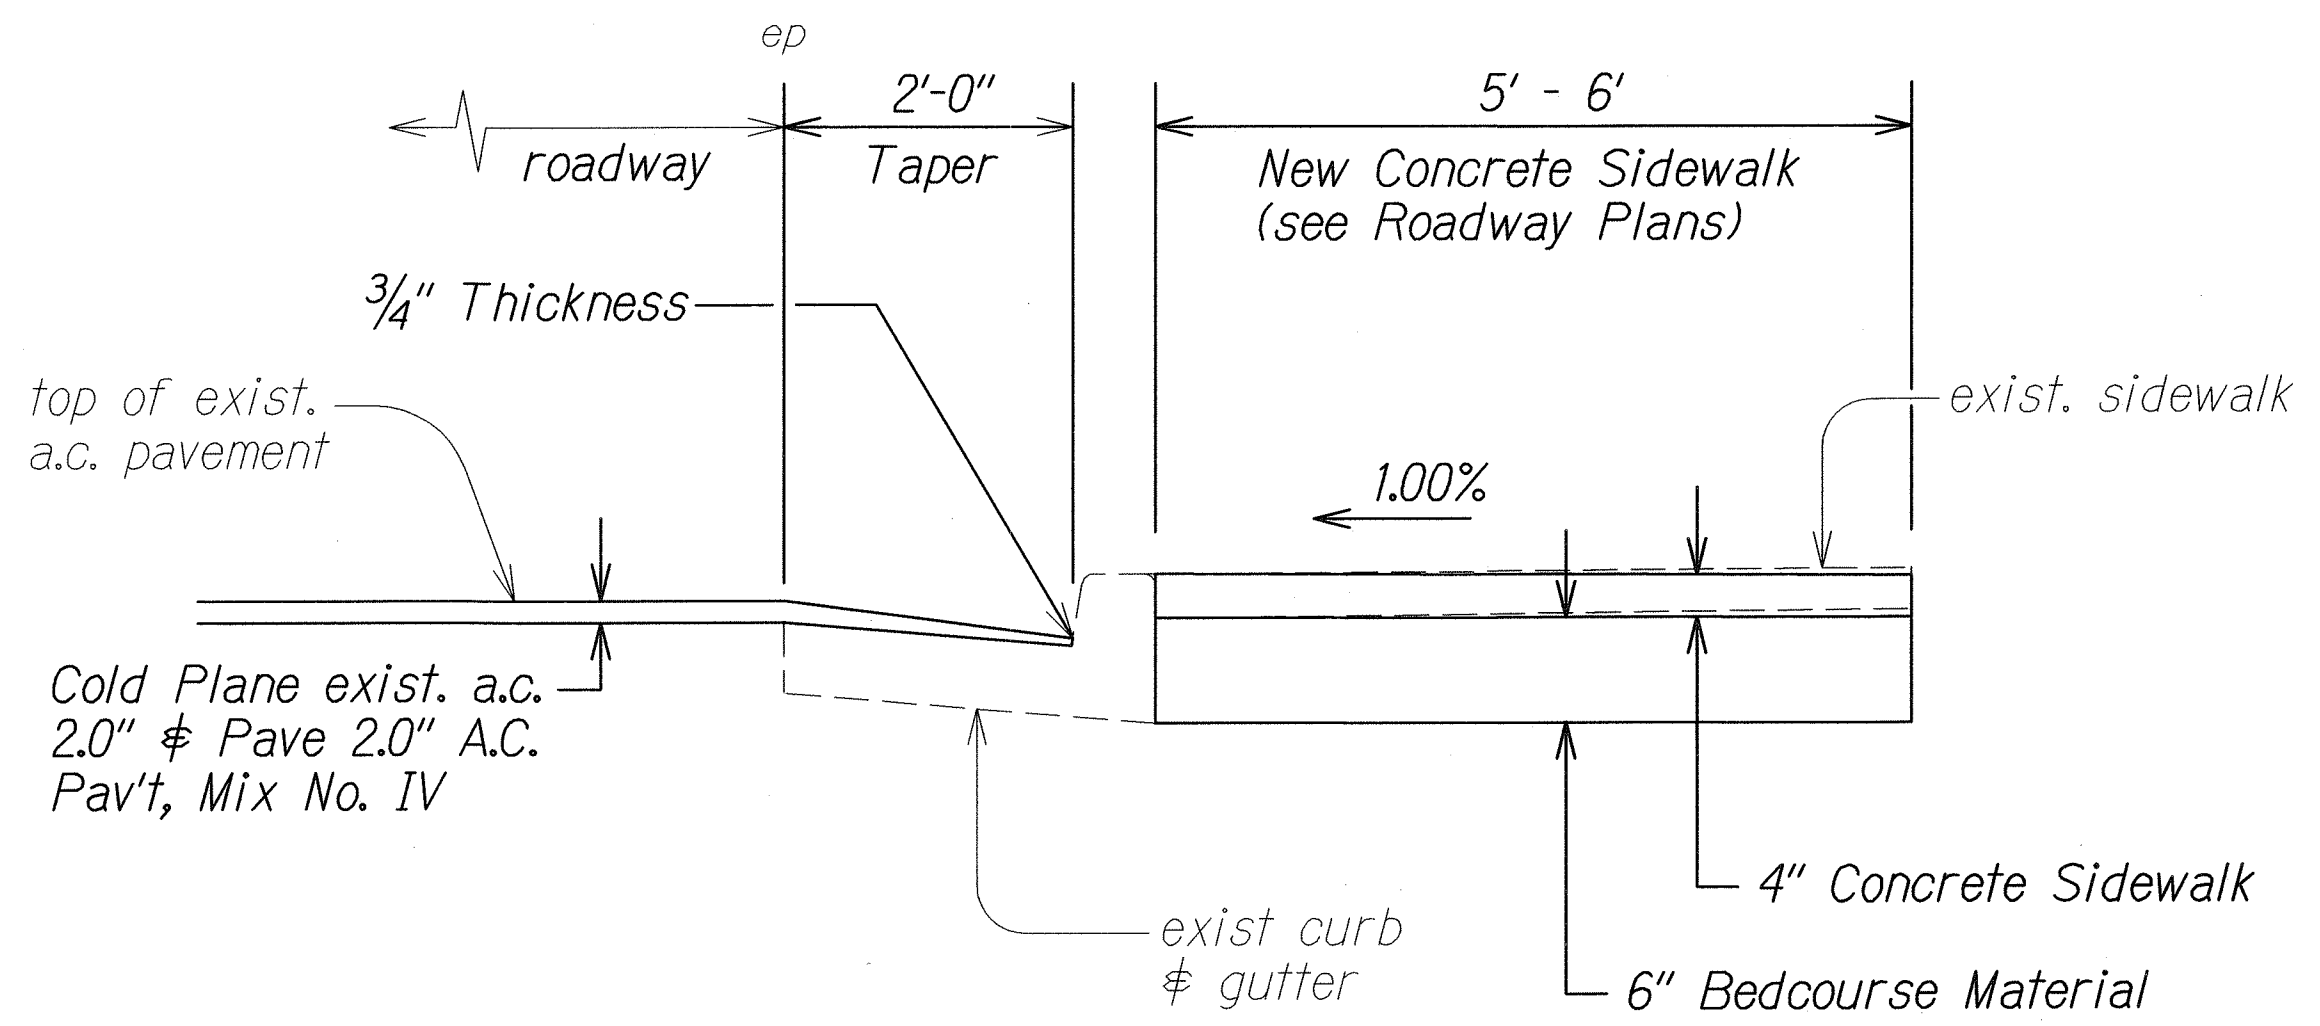

TYPICAL SECTION SIDEWALK CONSTRUCTION
STA. 90+70± TO STA. 1+46± RT.
Scale: N.T.S.

SURVEY PLOTTED BY	DATE
DRAWN BY	
DESIGNED BY	
CHECKED BY	
ORIGINAL PLAN	
NOTE BOOK	
dd	
5/15/2012	

6/8/12	Revised pavement structure
DATE	REVISION
STATE OF HAWAII DEPARTMENT OF TRANSPORTATION HIGHWAYS DIVISION	
TYPICAL SECTION	
KANEOHE BAY DRIVE REHABILITATION Kamehameha Highway to Nanamoana Street Project No. 65AB-01-04M	
Scale: NTS	Date: May, 2012
SHEET No. 5 OF 5 SHEETS	