

INDEX TO DRAWINGS	
SHEET NO.	DESCRIPTION
1	TITLE SHEET
2	STANDARD PLANS SUMMARY
3	GENERAL NOTES AND LEGEND
4	HECO NOTES
5 - 6	WATER CONTROL & EROSION CONTROL NOTES
7	DETAILS
8	GENERAL STRUCTURAL NOTES
9	SECTION AND DETAILS
10 - 11	PARTIAL PLAN AND ELEVATION

STATE OF HAWAII

DEPARTMENT OF TRANSPORTATION

HIGHWAYS DIVISION

HONOLULU, HAWAII

"AS-BUILT"

PLANS FOR


KANEOHE BAY DRIVE

KOKOKAHI OVERPASS REPAIR

PROJECT NO. 65A-01-09M

DISTRICT OF KOOLAUPOKO


ISLAND OF OAHU

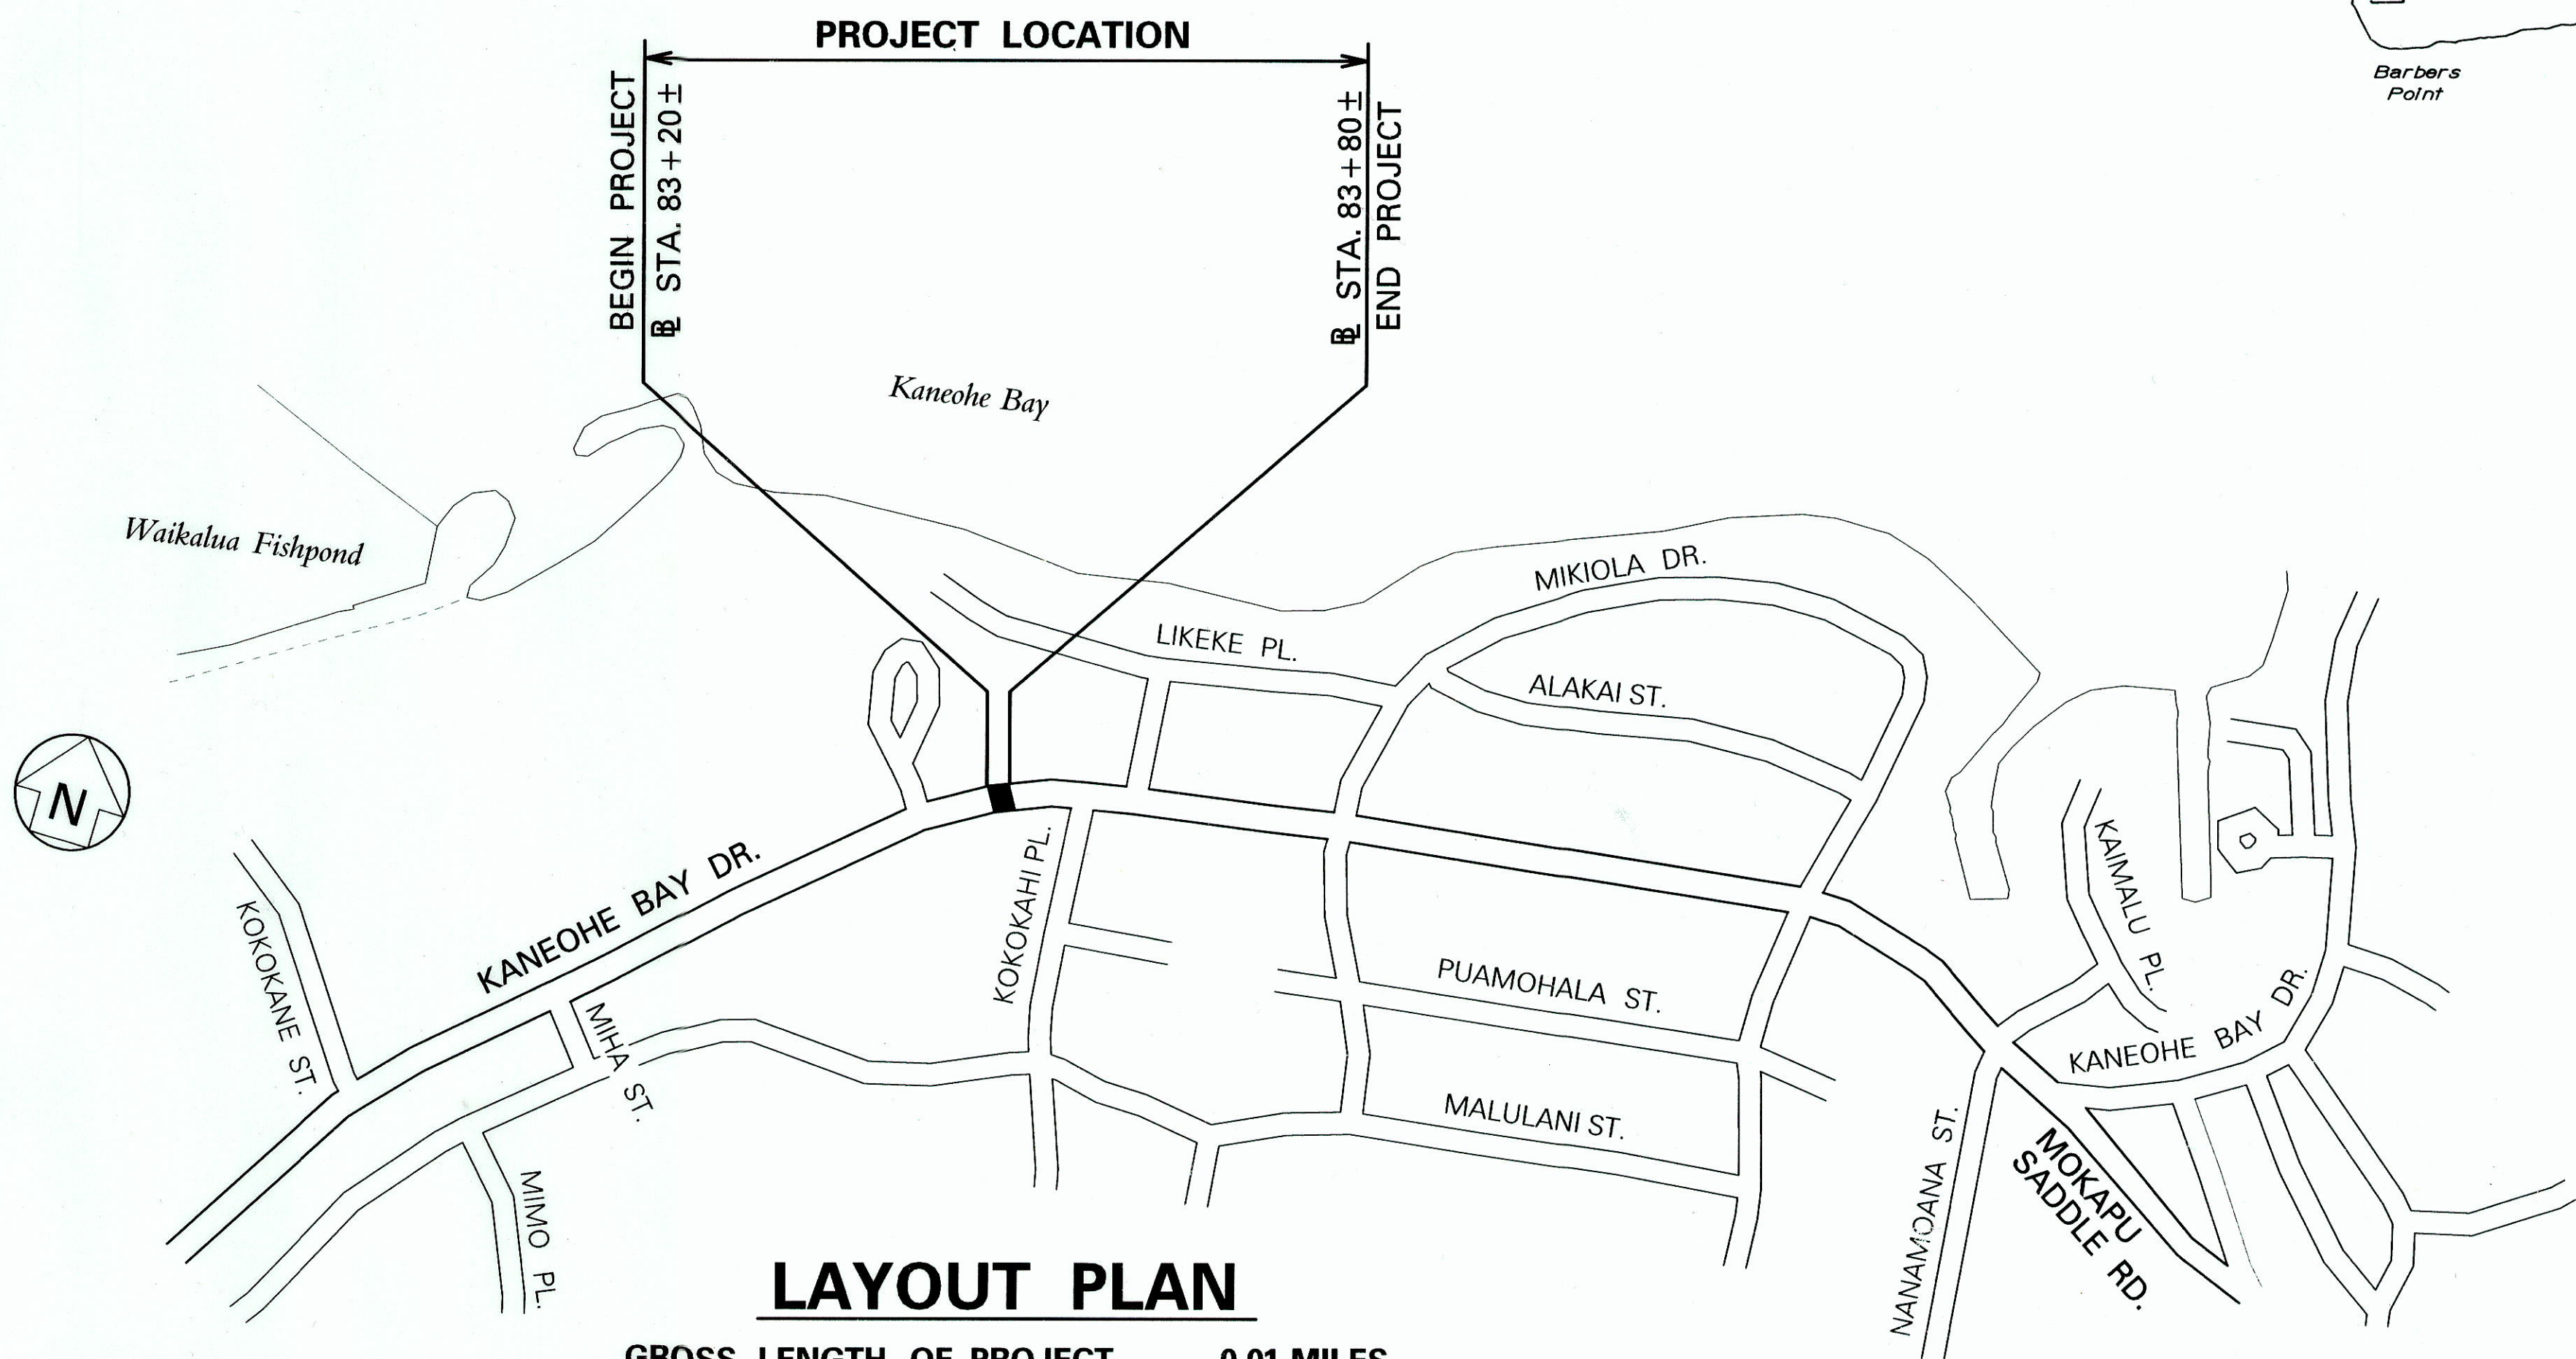



LAYOUT PLAN

GROSS LENGTH OF PROJECT..... 0.01 MILES

NET LENGTH OF PROJECT..... 0.01 MILES

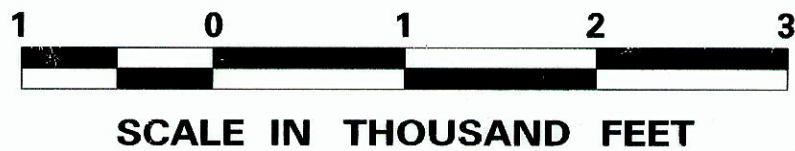

FED. ROAD DIST. NO.	STATE	PROJ. NO.	FISCAL YEAR	SHEET NO.	TOTAL SHEETS
HAWAII	HAW.	65A-01-09M	2010	1	11

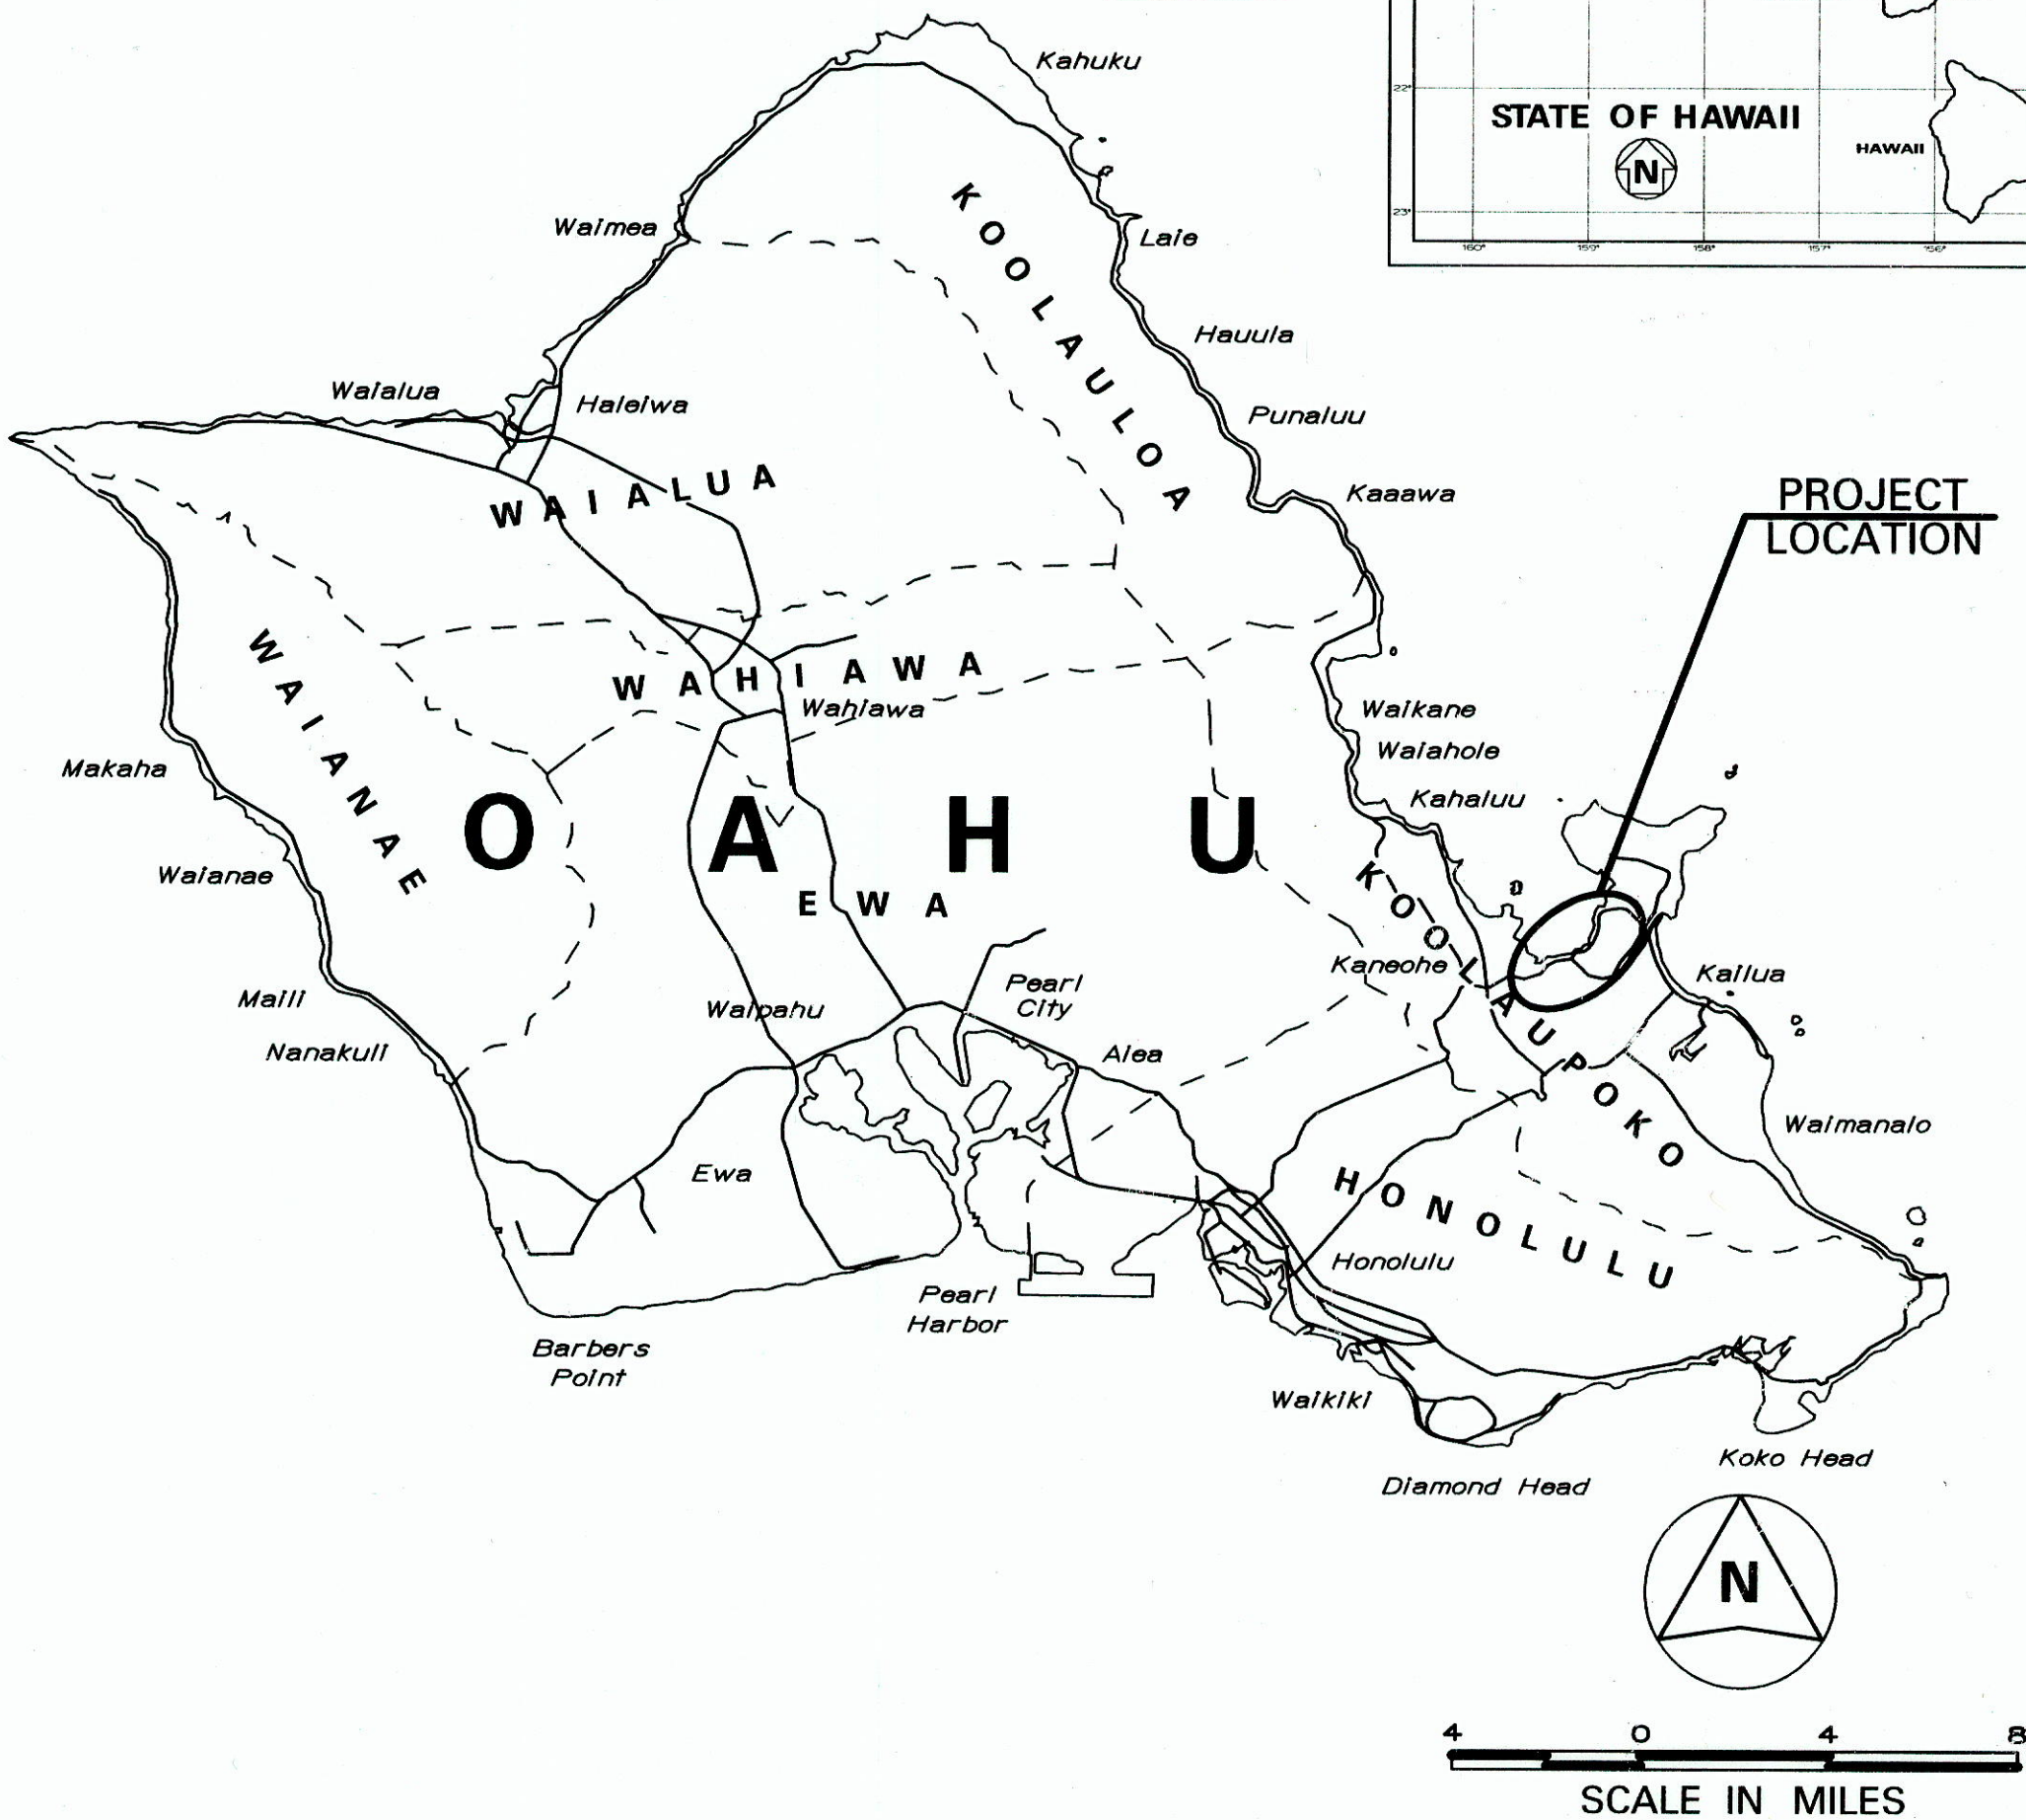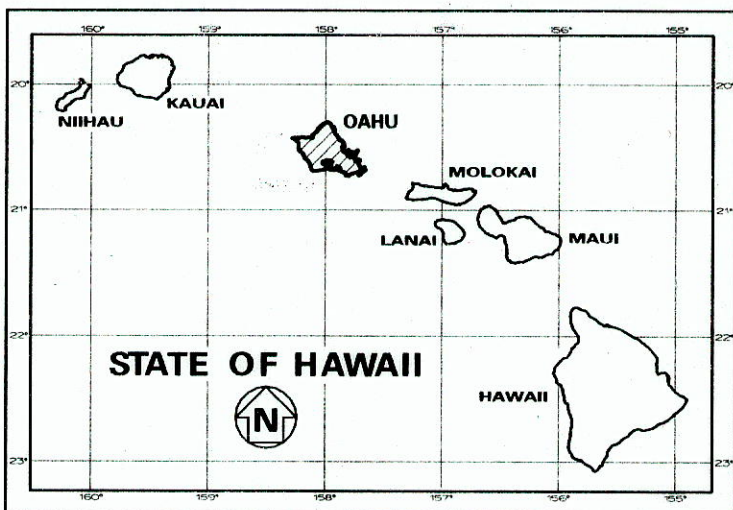

MILE POST 1.55 TO MILE POST 1.56

CHANGES MADE DURING CONSTRUCTION HAVE BEEN INCORPORATED ON THESE PLANS EXCEPT CHANGES IN THE ORIGINAL THEORETICAL QUANTITIES. FOR ACTUAL QUANTITIES, REFER TO PROJECT LEDGER AND/OR COMPUTATION BOOK.

RESIDENT ENGINEER

DATE

DEPARTMENT OF TRANSPORTATION STATE OF HAWAII	
APPROVED:	
DIR. OF TRANSPORTATION	DATE

DESIGNED BY

MANAGED BY

PHONE

DATE