



FED. ROAD DIST. NO.	STATE	FED. AID PROJ. NO.	FISCAL YEAR	SHEET NO.	TOTAL SHEETS
HAWAII	HAW.	STP-065-1(011)	2017	16	80

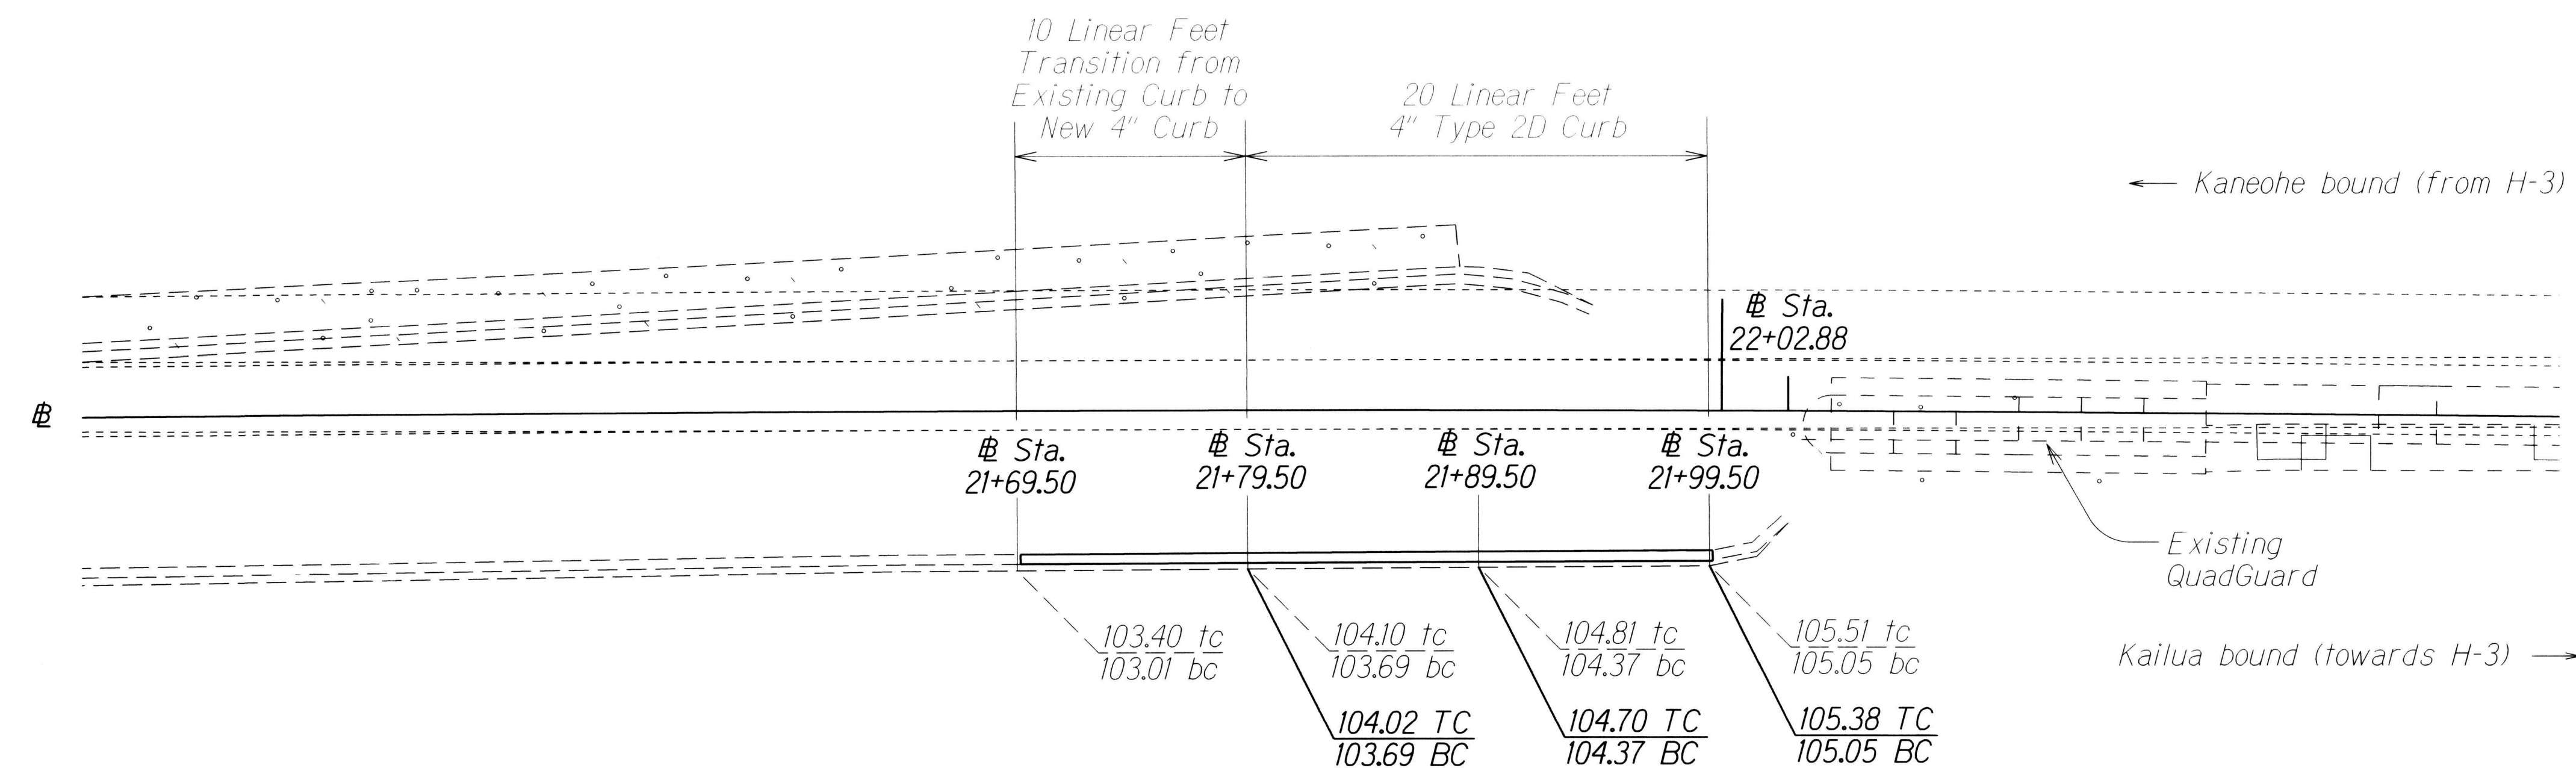


PLAN

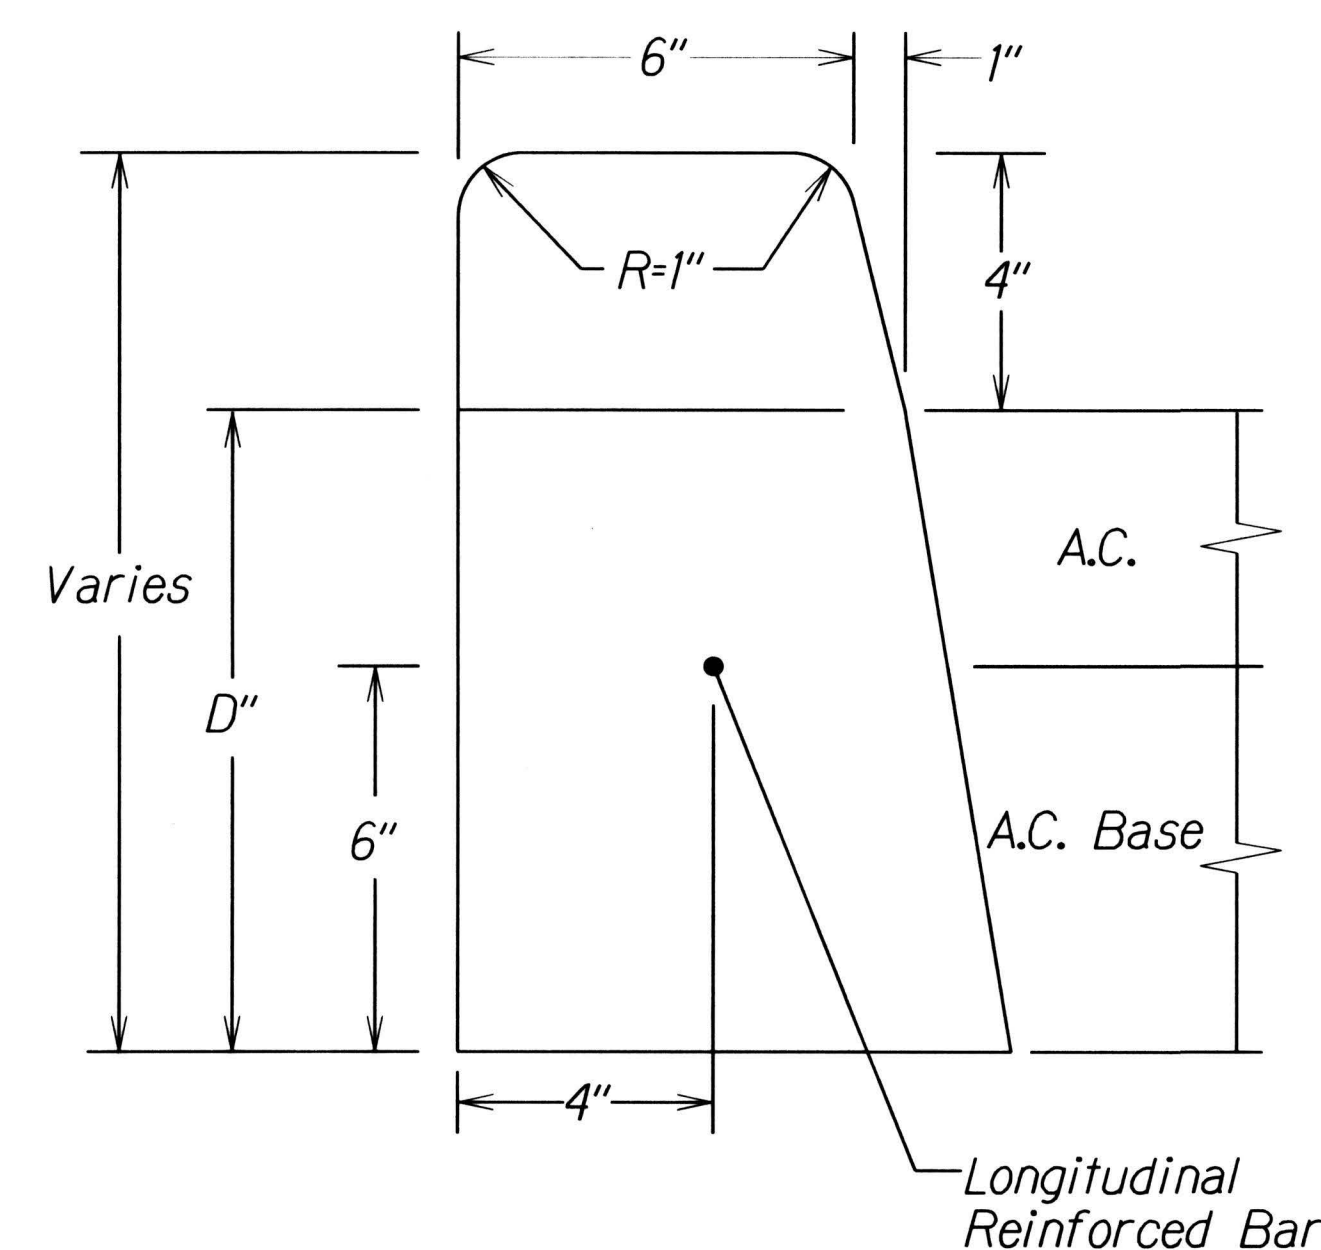

CURB, TYPE 2D 4-Inch
Scale: Not to Scale

Note

1. Refer to Standard Plan Sheet D-05 for Curb Notes.
2. Median excavations that are not backfilled by the end of the workday shall be protected during non-working hours.

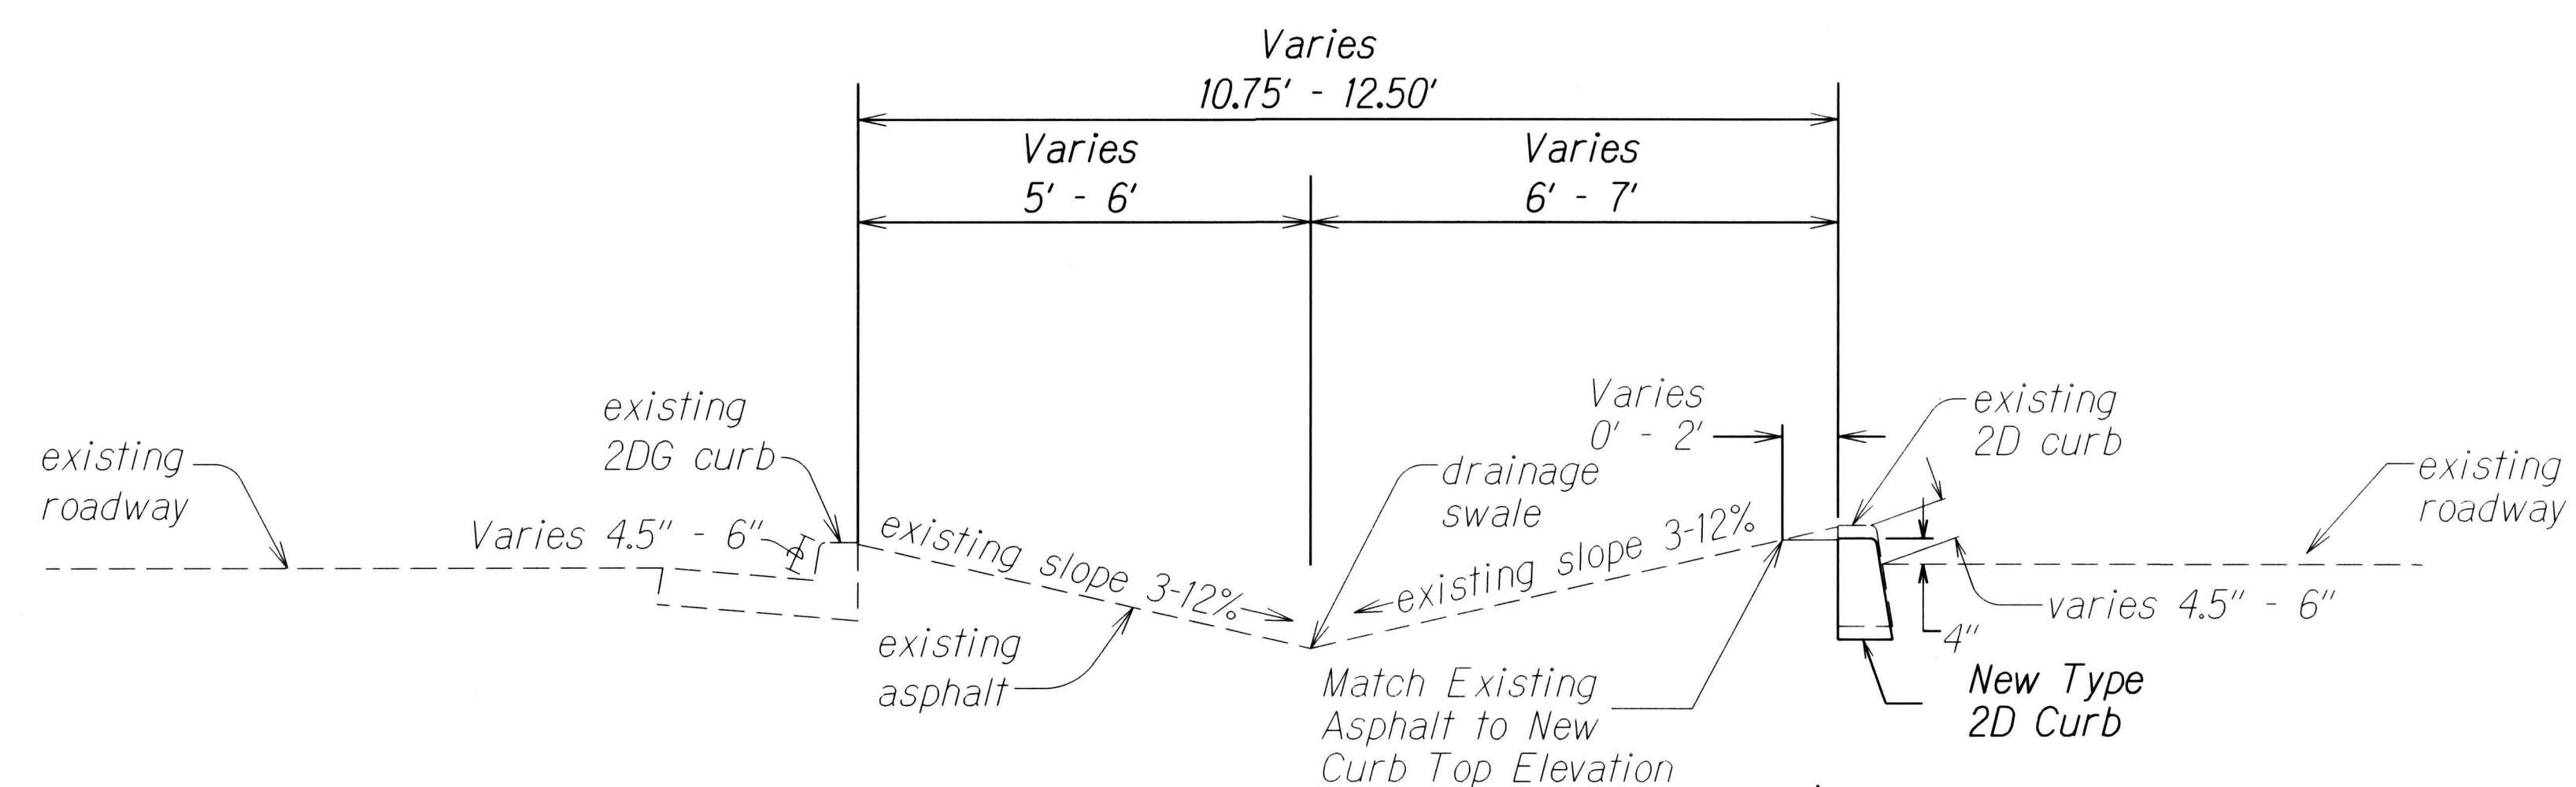

Typical Section Curbed Median
Sta. 21+64.50 to Sta. 22+02.88

Scale: Not to Scale

STATE OF HAWAII
DEPARTMENT OF TRANSPORTATION
HIGHWAYS DIVISION

CURBED MEDIAN DETAIL

MOKAPU SADDLE ROAD REHABILITATION
Nanamoana Street to Oneawa Street
Federal Aid Project No. STP-065-1(011)

Scale: Not to Scale Date: March, 2017

SHEET No. 1 OF 1 SHEETS