

FED. ROAD DIST. NO.	STATE	FED. AID PROJ. NO.	FISCAL YEAR	SHEET NO.	TOTAL SHEETS
HAWAII	HAW.	STP-065-1(011)	2017	74	80

TRAFFIC SIGNAL NOTES

- The locations of the Traffic Signal Standards, Traffic Signal Standards w/Mast Arms, Pedestrian Push Buttons, Traffic Controller, Pullboxes, Conduits and Loop Detectors shall be staked out in the field by the Contractor and approval of the locations shall be obtained from the Engineer prior to construction and installation.
- All splicing shall be done in the pullboxes.
- Furnishing and installing the conduit stubouts (pullboxes to edge of pavement) will not be paid for separately but shall be considered incidental to the various contract items.
- A solid #8 bare copper wire shall be pulled with the traffic signal control cable for equipment ground. Cost shall be incidental to the installation of the control cable.
- All Traffic signal controller equipment shall be completely wired in the cabinet and shall control the traffic signals as called for in the plans.
- The loop amplifier units furnished for this project shall be capable of operating the loop detector configurations shown on the plans. Cost for the loop amplifier shall be incidental to the installation of the loop detector.
- Should any defect be encountered during the warranty period, the manufacturer will be notified and he shall promptly correct such defect. Service call (by factory qualified representative) during the warranty period for repairs or other maintenance shall be answered within 24 hours and shall be done at no expense to the State. All repairs shall be done as soon as possible.
- All traffic signal work shall conform to the requirements of the "Manual On Uniform Traffic Control Devices For Streets And Highways", Federal Highway Administration (1988) and Amendments.
- Locations of traffic markings and markers (lane lines, Stop lines, crosswalk, etc.) shown on the plans shall be verified with the Engineer prior to the installation of the traffic signal system.
- All Conduits between pullboxes and Traffic Signal/Highway Lighting Standards shall not be paid for separately but shall be considered incidental to the various contract items.
- All Signal-Drop Cables (Type 5 Cables) from the various Types of Traffic Signal Head on the traffic signal standards and mast arms to the pullboxes shall not be paid for separately but considered incidental to the Traffic Signal Head.
- After installing all the traffic signal cables, the Contractor shall duct seal all conduits in the pullboxes, traffic signal standards and traffic signal controller cabinet concrete base. The duct seal material shall be approved by the Traffic Signal Inspector/Engineer and shall not be paid for separately but considered incidental to the direct buried and/or concrete encased conduits.
- After installing the Traffic Signal System, the Contractor shall apply grease to all parts of the Traffic Signal System (i.e. fittings, brackets, nipples, elbows, screws, signal head assemblies, bolts, hinges, etc.) as directed by the Traffic Signal Inspector, to prevent rust and corrosion. The grease material shall be approved by the Signal Inspector.
- Connecting into existing traffic signal system and making all necessary adjustments shall not be paid for separately, but considered incidental to the various traffic signal contract items.
- The Contractor shall notify the Traffic Control Branch, Department of Transportation Services, City & County of Honolulu, (Phone No. 768-8388) two weeks prior to commencing any work on the traffic signal system.

TRAFFIC SIGNAL LEGEND

NEW	EXISTING	
		Traffic Signal Conduit
		Conduit Run Numbers
		Equipment description, installation or item no.
		Traffic Signal Master Controller Door Indicates Front of Cabinet
		Traffic Signal Controller Door Indicates Front of Cabinet
		Meter Pedestal
		12" RYG Traffic Signal Head
		12" R Y G Traffic Signal Head
		12" R Y G Traffic Signal Head
		12" R Y G Traffic Signal Head (Programmed Visibility)
		12" R Y G Fiber Optic Traffic Signal Head
		Type I Standard and Attached Signals
		Type II Standard with Signal Mast Arm and Attached Signals (Nos. indicates mast arm length & distance between signal heads as specified on plans)
		Type III Standard with Luminaire and Signal Mast Arm and Attached Signals (Nos. indicates mast arm lengths & distance between signal heads as specified on plans)
		Flashing Beacon, One Signal Section, "Y" indicates 12" Yellow Lens
		Opticom Receiver (Arrow indicates direction detector faces)
		Pipe Guard
		Pedestrian Signal Head
		Type A Pullbox
		Type B Pullbox
		Type C Pullbox
		Loop Detectors


HIGHWAY LIGHTING LEGEND

NEW	EXISTING	
		Highway Lighting Conduit
		Type A Pullbox (Hwy. Ltg.)
		Highway Lighting Standard

SURVEY PLOTTED BY	DATE
DRAWN BY	
DESIGNED BY	
CHECKED BY	
ORIGINAL PLAN	
NOTE BOOK	
QUANTITIES BY	
CHECKED BY	

STATE OF HAWAII
DEPARTMENT OF TRANSPORTATION
HIGHWAYS DIVISION
**TRAFFIC SIGNAL NOTES
AND LEGEND**
MOKAPU SADDLE ROAD REHABILITATION
Nanamoana Street to Oneawa Street
Federal Aid Project No. STP-065-1(011)
Scale: As Noted Date: March 2017
SHEET No. 74 OF 17 SHEETS

FED. ROAD DIST. NO.	STATE	FED. AID PROJ. NO.	FISCAL YEAR	SHEET NO.	TOTAL SHEETS
HAWAII	HAW.	STP-065-1(011)	2017	75	80

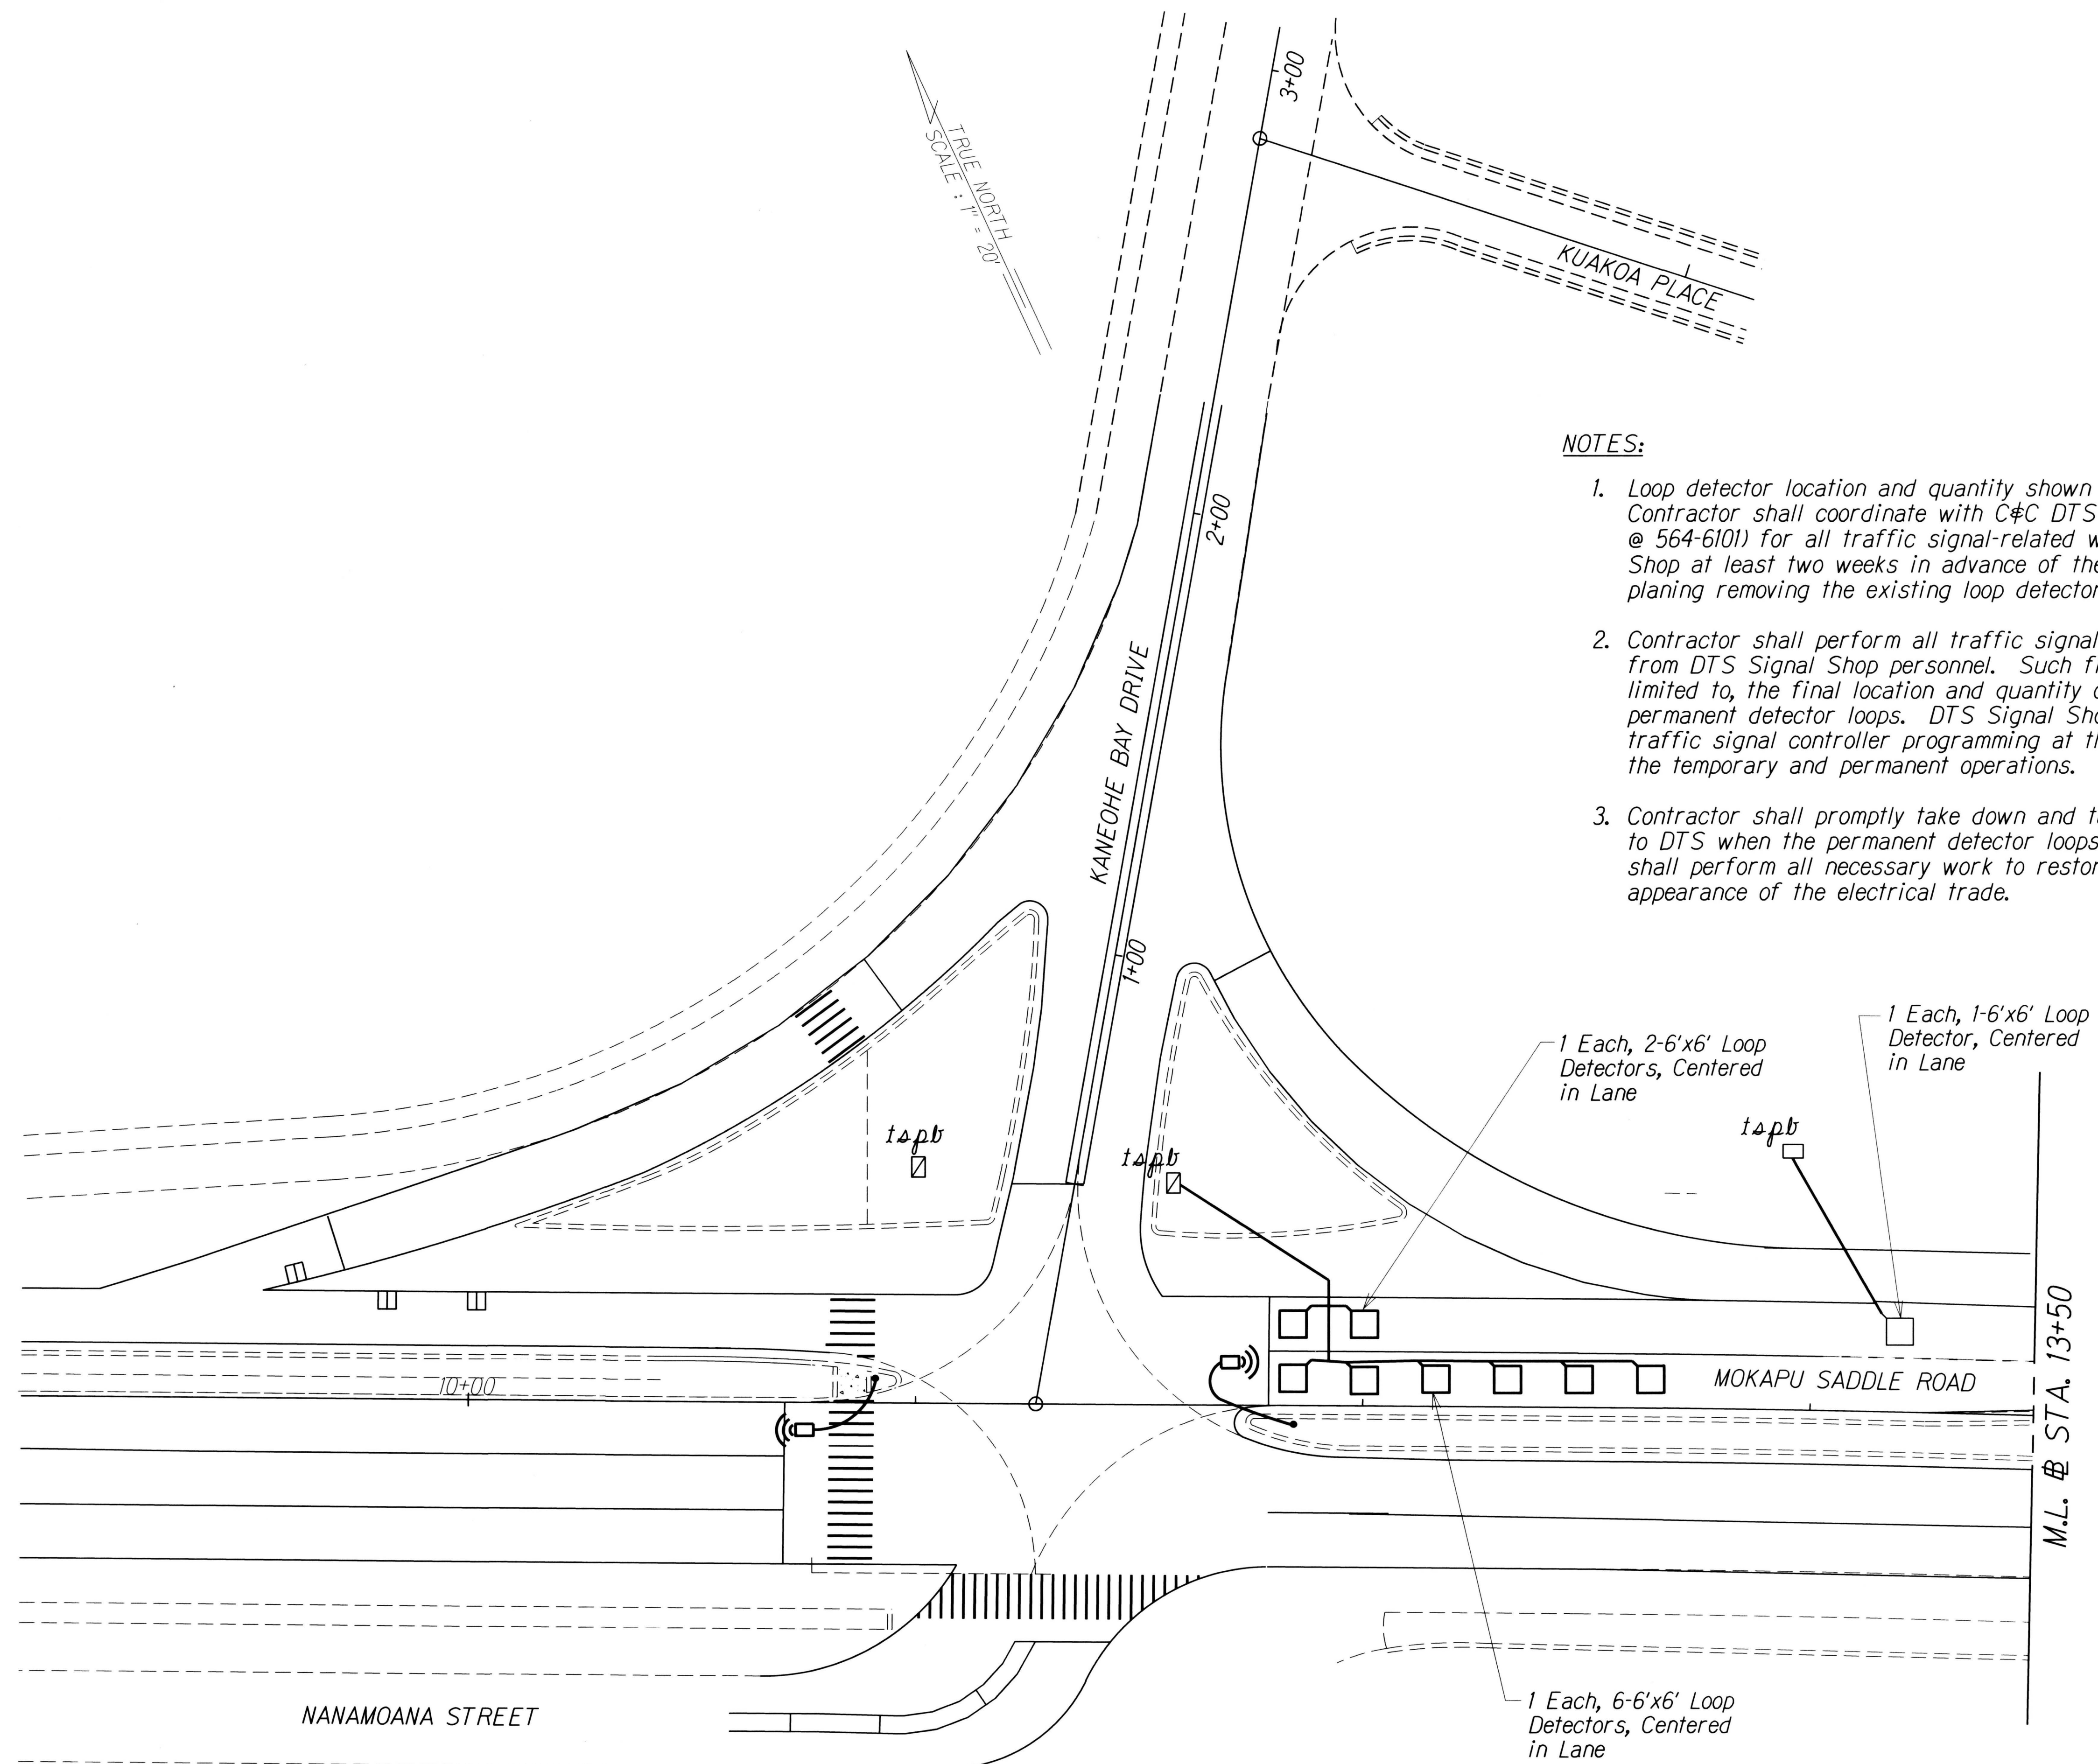

- NOTES:**
1. Loop detector location and quantity shown on this plan are only approximate. Contractor shall coordinate with C&C DTS Signal Shop (Supervisor Wally Nakihiro @ 564-6101) for all traffic signal-related work. Schedule with C&C DTS Signal Shop at least two weeks in advance of the actual work, including pavement cold planing removing the existing loop detector.
 2. Contractor shall perform all traffic signal-related work following field instructions from DTS Signal Shop personnel. Such field instructions shall include, but not limited to, the final location and quantity of the temporary microwave sensors and permanent detector loops. DTS Signal Shop personnel will be responsible for traffic signal controller programming at the traffic signal cabinet to accommodate the temporary and permanent operations.
 3. Contractor shall promptly take down and turnover the temporary microwave sensors to DTS when the permanent detector loops are in place and operational. Contractor shall perform all necessary work to restore traffic signal system back to a neat appearance of the electrical trade.


TRAFFIC SIGNAL LEGEND
 (□) Temporary Microwave Detector

ORIGINAL PLAN	SURVEY PLOTTED BY	DATE
NOTE BOOK	DRAWN BY	
7/2/20	DESIGNED BY	
N. Kanihira	CHECKED BY	

STATE OF HAWAII
DEPARTMENT OF TRANSPORTATION
HIGHWAYS DIVISION

TRAFFIC SIGNAL PLAN
MOKAPU SADDLE ROAD REHABILITATION
Nanamoana Street to Oneawa Street
Fed. Aid Project No. STP-065-1(011)
Scale: 1"=20' Date: March 2017

FED. ROAD DIST. NO.	STATE	FED. AID PROJ. NO.	FISCAL YEAR	SHEET NO.	TOTAL SHEETS
HAWAII	HAW.	STP-065-1(011)	2017	76	80

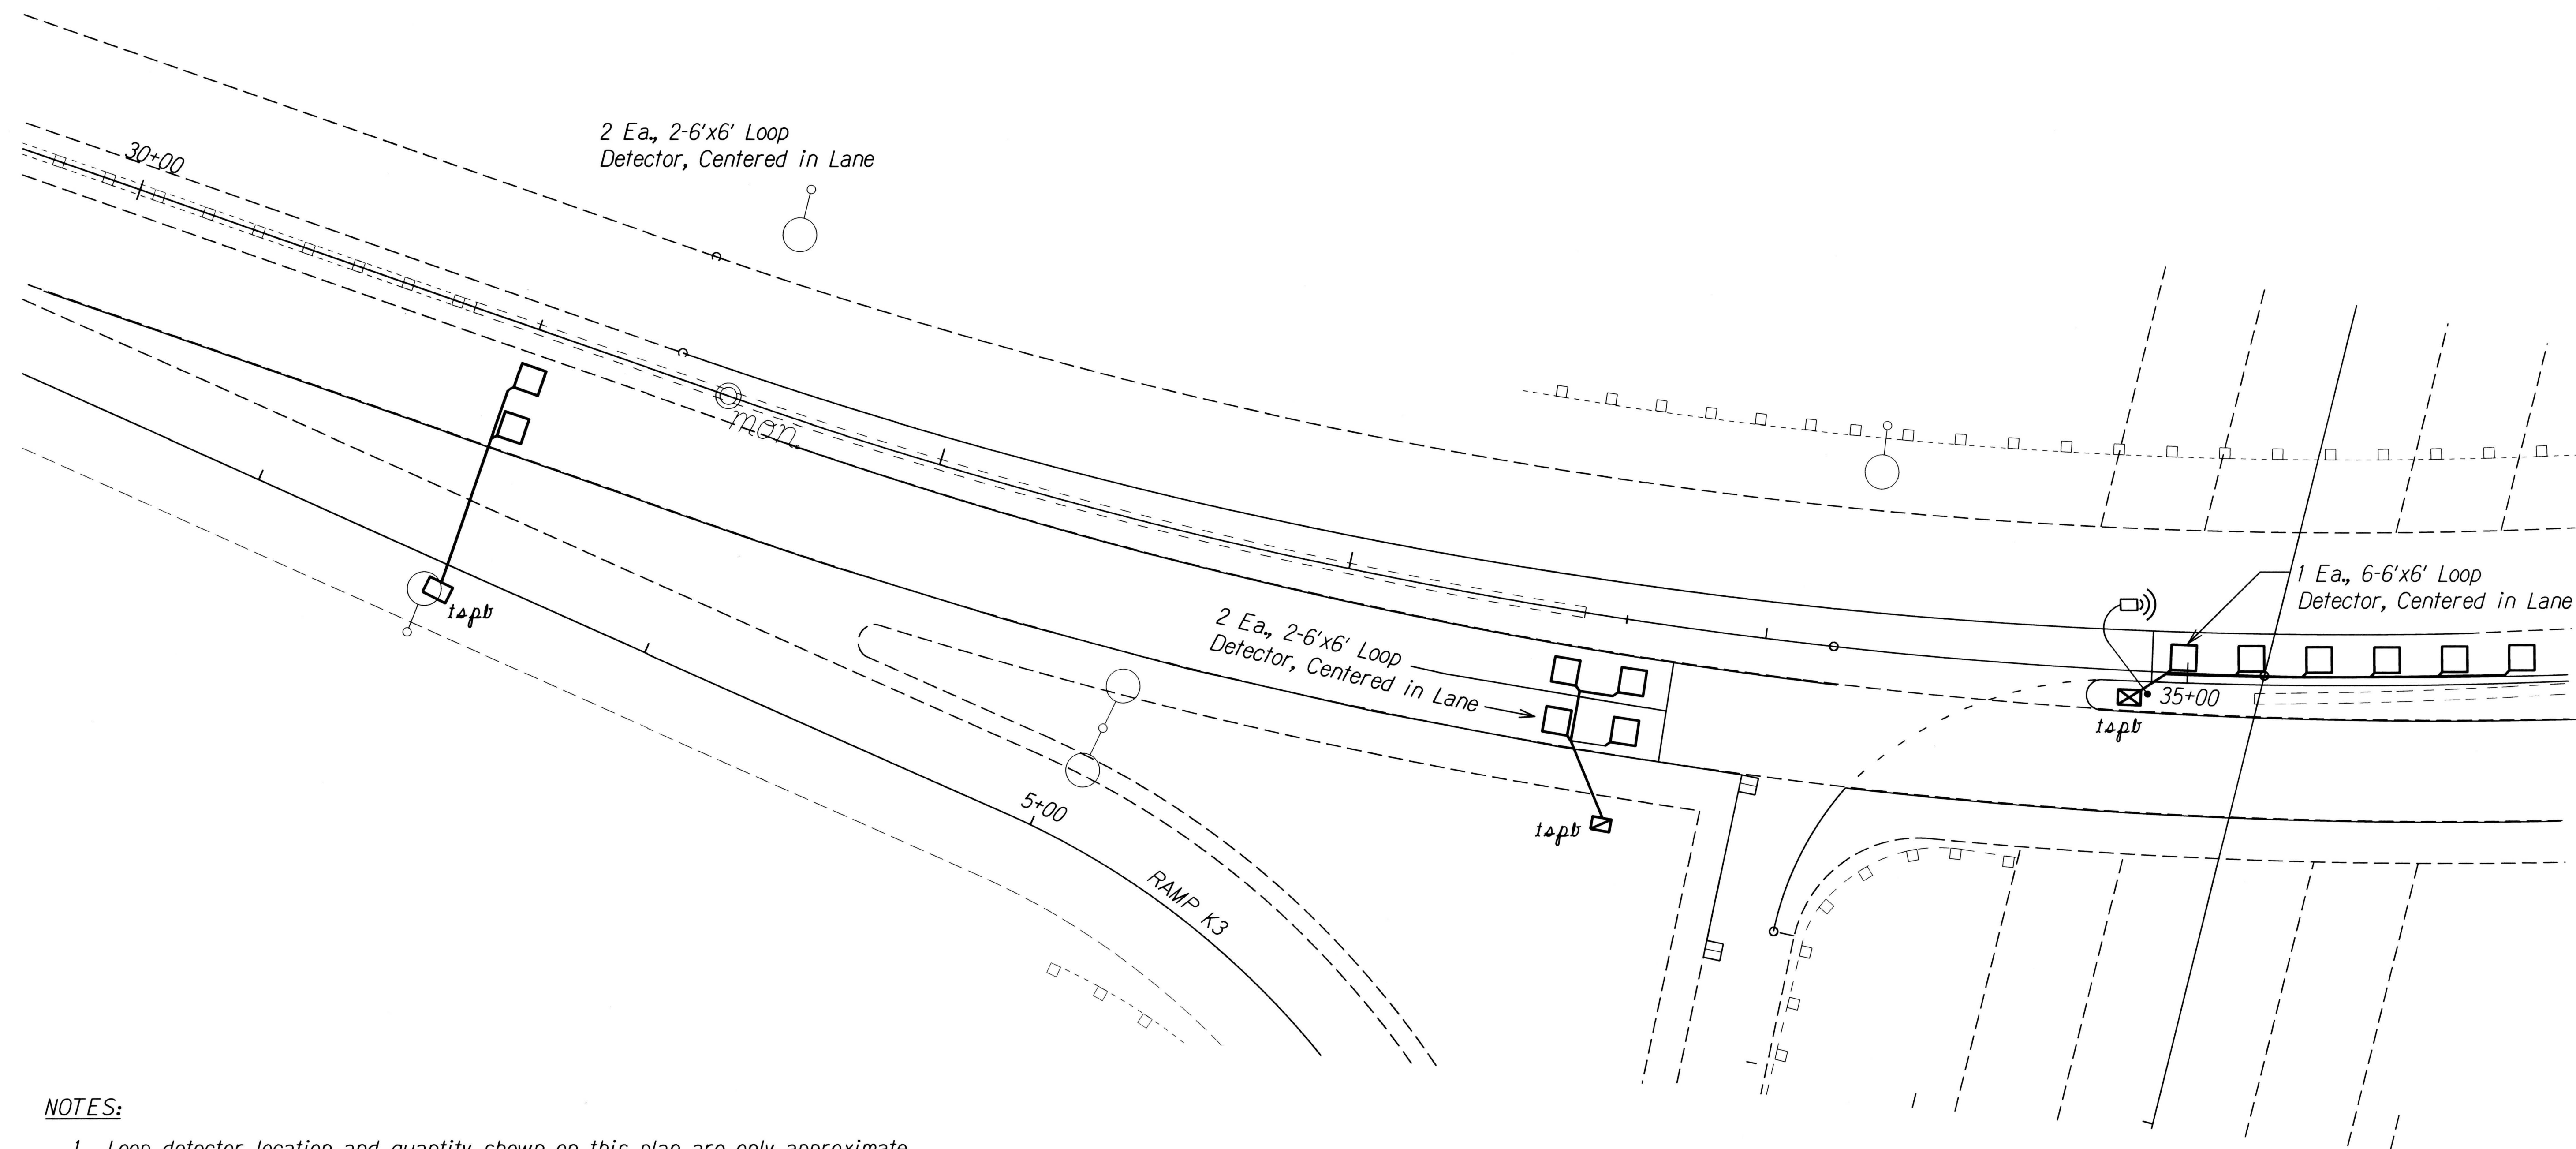

NOTES:

1. Loop detector location and quantity shown on this plan are only approximate. Contractor shall coordinate with C&C DTS Signal Shop (Supervisor Wally Nakihiro @ 564-6101) for all traffic signal-related work. Schedule with C&C DTS Signal Shop at least two weeks in advance of the actual work, including pavement cold planing removing the existing loop detector.
2. Contractor shall perform all traffic signal-related work following field instructions from DTS Signal Shop personnel. Such field instructions shall include, but not limited to, the final location and quantity of the temporary microwave sensors and permanent detector loops. DTS Signal Shop personnel will be responsible for traffic signal controller programming at the traffic signal cabinet to accommodate the temporary and permanent operations.
3. Contractor shall promptly take down and turnover the temporary microwave sensors to DTS when the permanent detector loops are in place and operational. Contractor shall perform all necessary work to restore traffic signal system back to a neat appearance of the electrical trade.

TRAFFIC SIGNAL LEGEND


Ⓜ Temporary Microwave Detector

STATE OF HAWAII
DEPARTMENT OF TRANSPORTATION
HIGHWAYS DIVISION

TRAFFIC SIGNAL PLAN
MOKAPU SADDLE ROAD REHABILITATION
Nanamoana Street to Oneawa Street
Fed. Aid Project No. STP-065-1(011)
Scale: 1"=20' Date: March 2017
SHEET No. 76 OF 80 SHEETS

ORIGINAL PLAN	SURVEY PLOTTED BY	DATE
NOTE BOOK	DRAWN BY	7/1/19
7/1/19	DESIGNED BY	
N. 7/1/19	QUANTITIES BY	
	CHECKED BY	

FED. ROAD DIST. NO.	STATE	FED. AID PROJ. NO.	FISCAL YEAR	SHEET NO.	TOTAL SHEETS
HAWAII	HAW.	STP-065-1(011)	2017	77	80

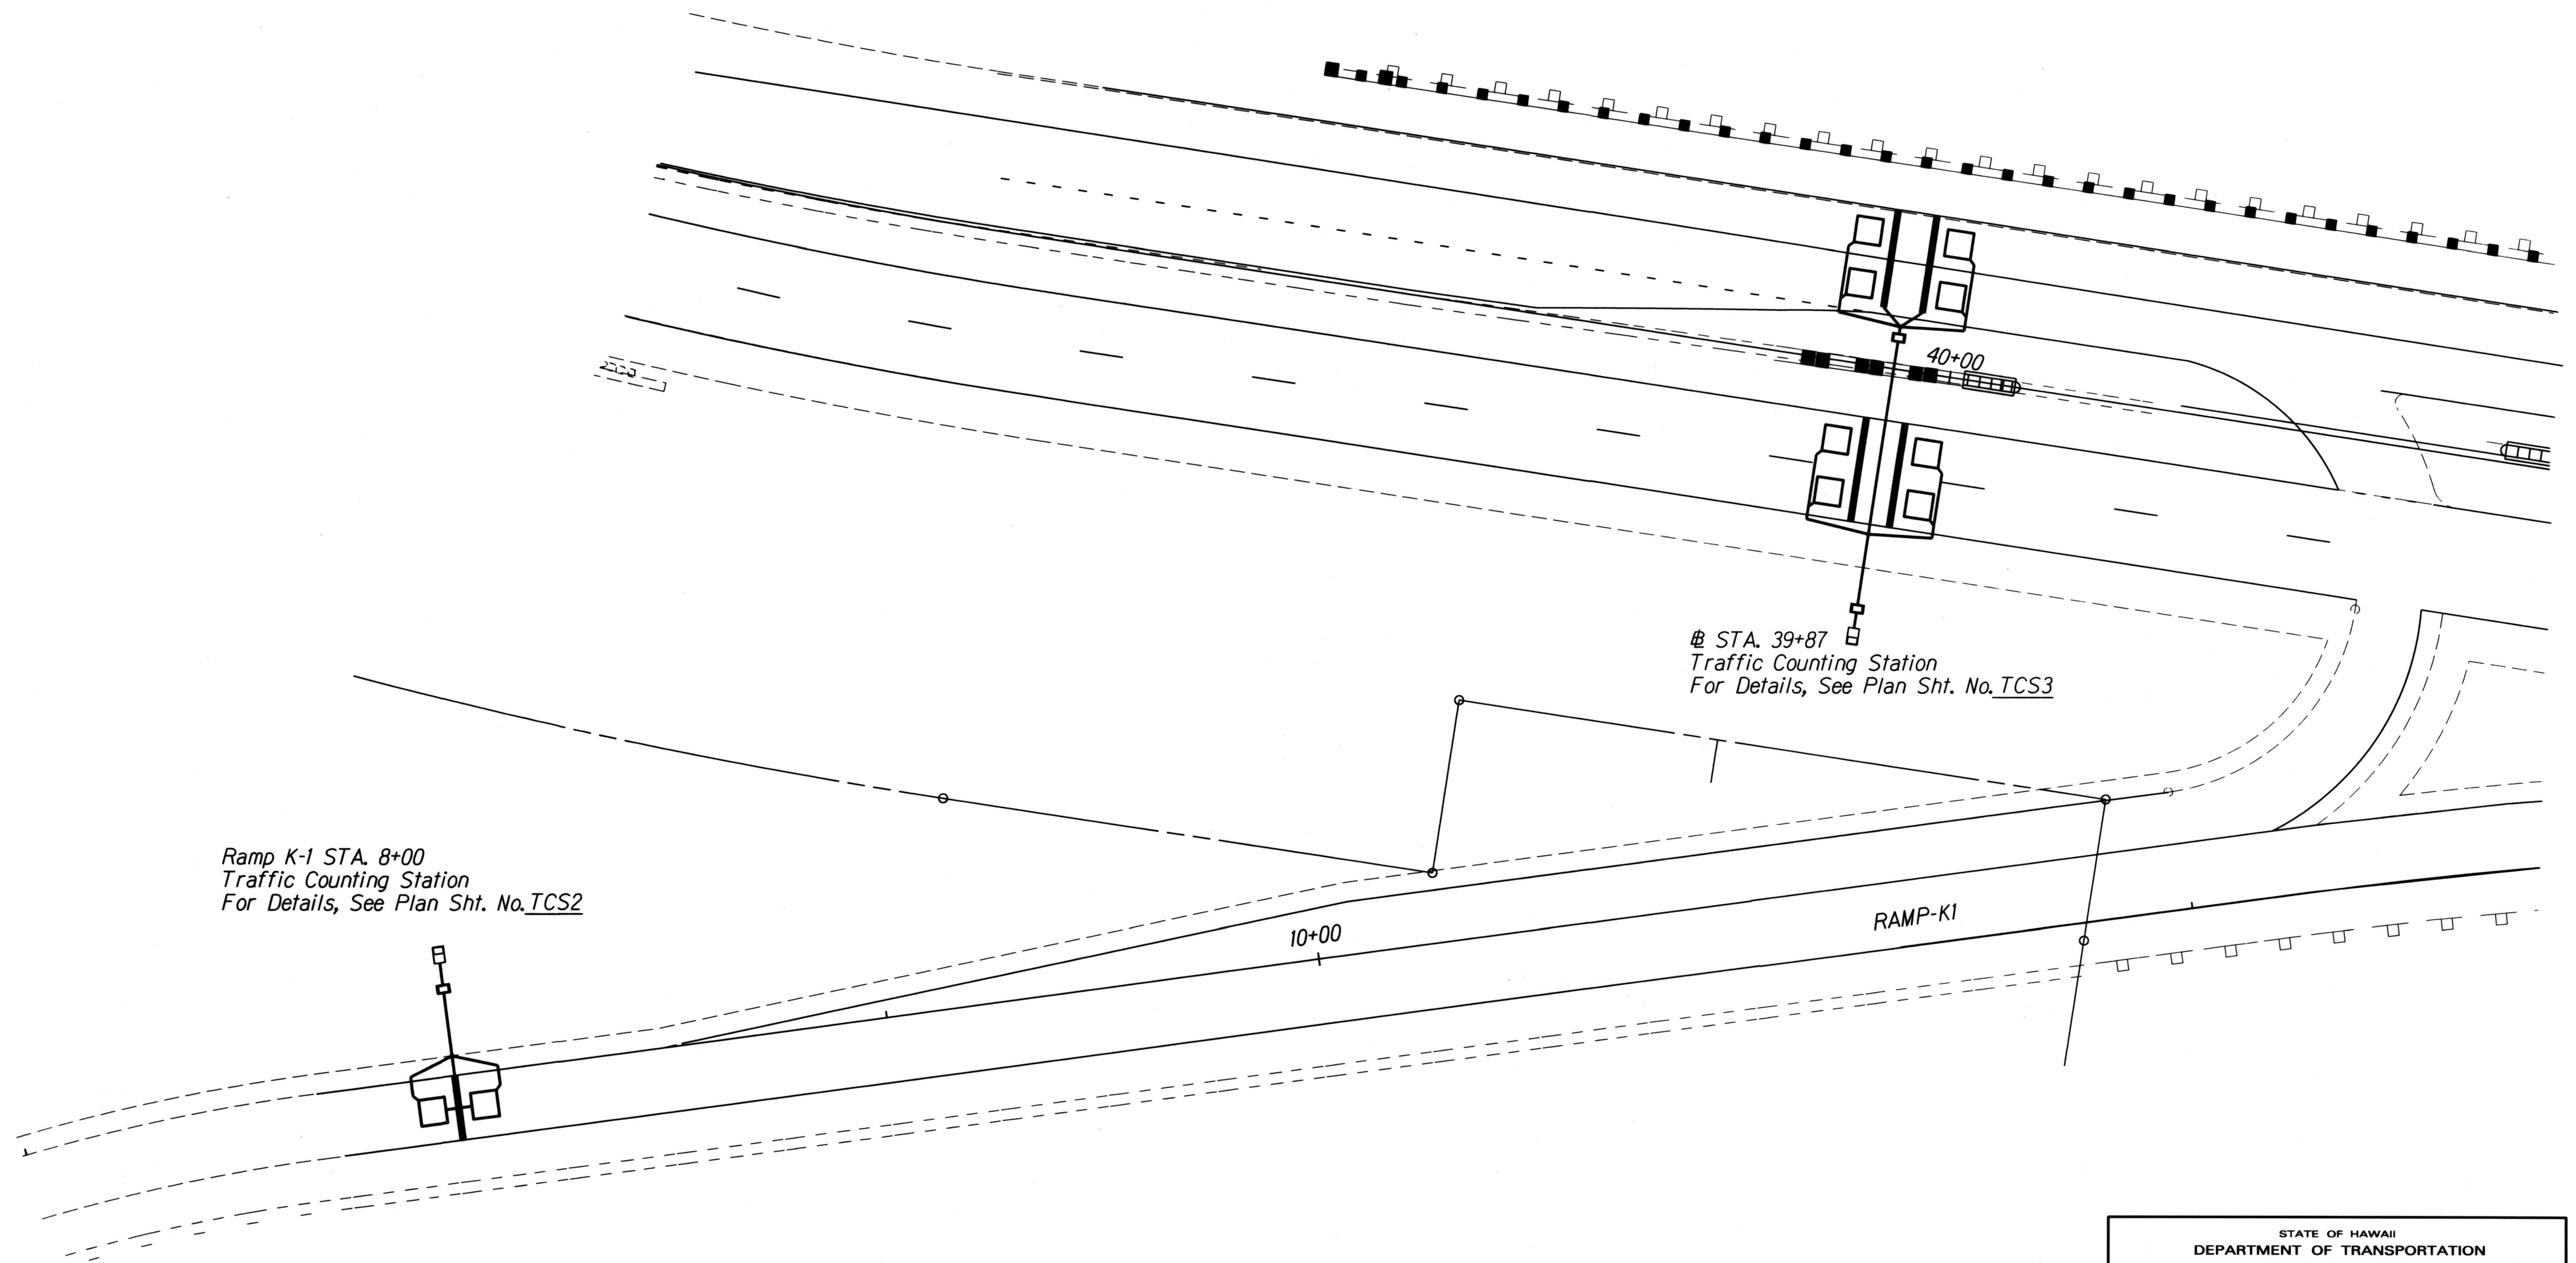

ORIGINAL PLAN	SURVEY PLOTTED BY	DATE
NOTE BOOK	DRAWN BY	
	DESIGNED BY	
	QUANTITIES BY	
	CHECKED BY	

STATE OF HAWAII
DEPARTMENT OF TRANSPORTATION
HIGHWAYS DIVISION


TRAFFIC SIGNAL PLAN

MOKAPU SADDLE ROAD REHABILITATION
Nanamoana Street to Oneawa Street
Federal Aid Project No. STP-065-1(011)

Scale: 1"=20' Date: March 2017

SHEET No. 77 OF 17 SHEETS

FED. ROAD DIST. NO.	STATE	FED. AID PROJ. NO.	FISCAL YEAR	SHEET NO.	TOTAL SHEETS
HAWAII	HAW.	STP-065-1(011)	2017	79	80

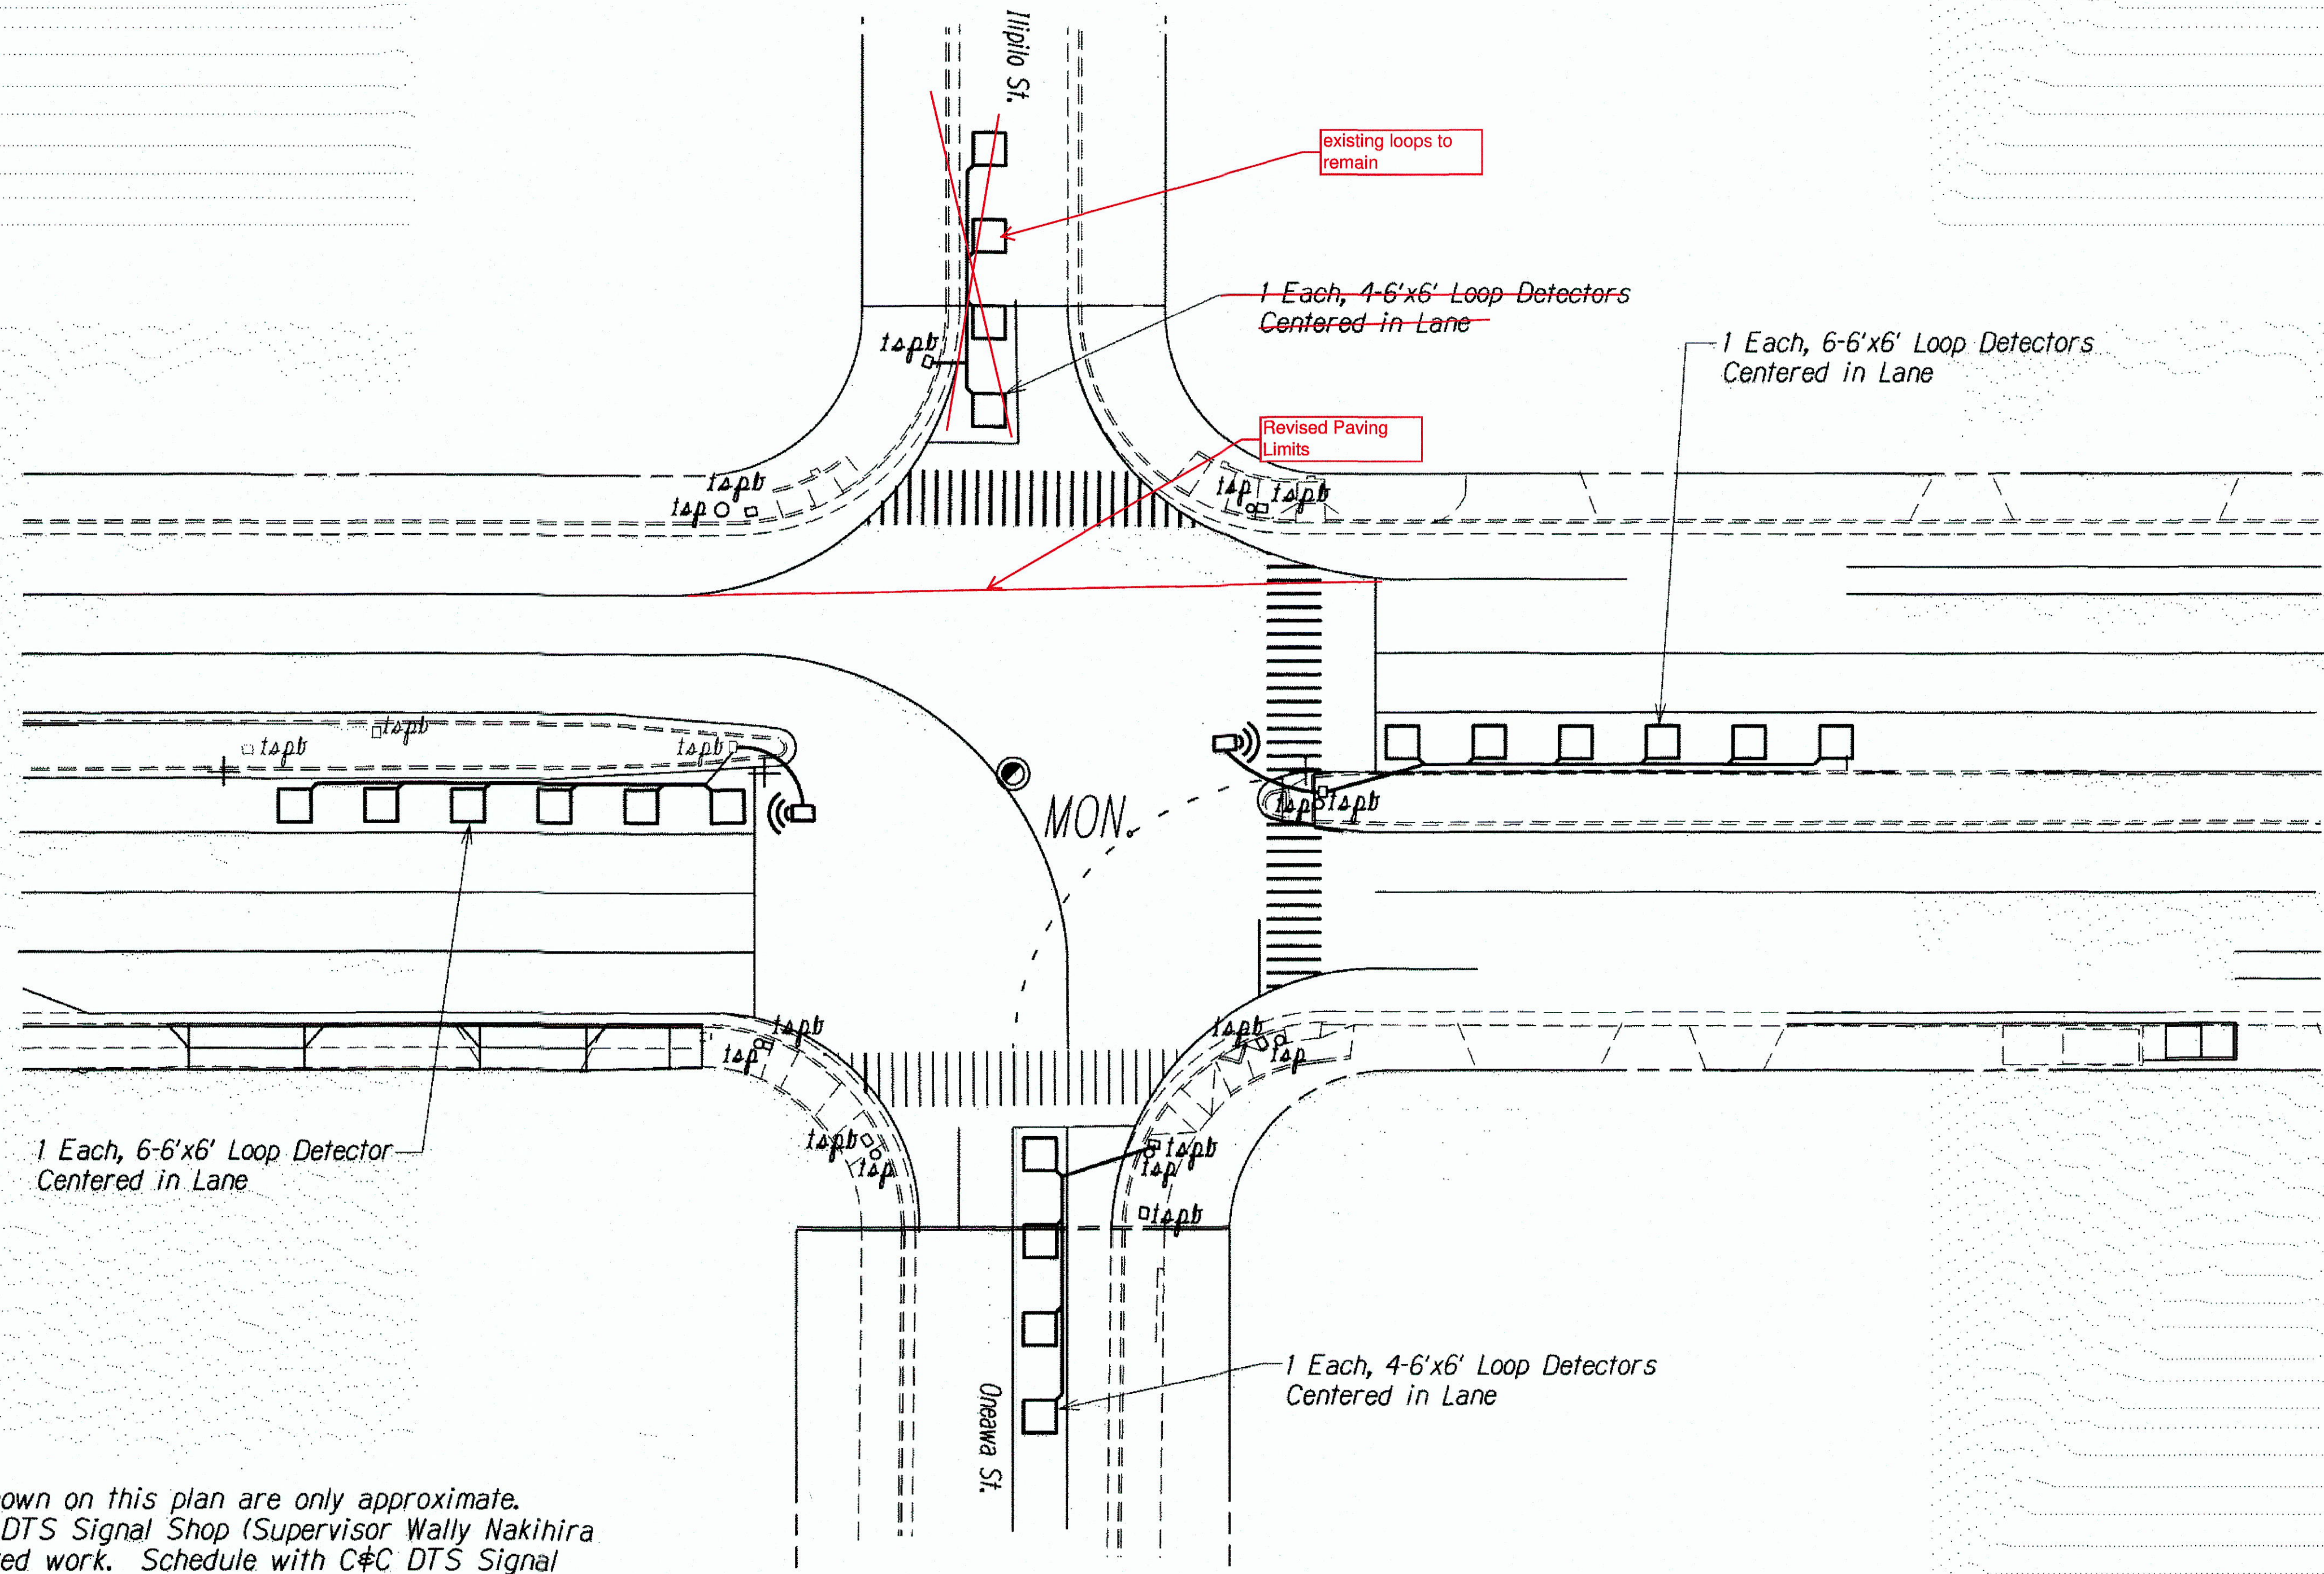

NOTES:

1. Loop detector location and quantity shown on this plan are only approximate. Contractor shall coordinate with C&C DTS Signal Shop (Supervisor Wally Nakihiro @ 564-6101) for all traffic signal-related work. Schedule with C&C DTS Signal Shop at least two weeks in advance of the actual work, including pavement cold planing removing the existing loop detector.
2. Contractor shall perform all traffic signal-related work following field instructions from DTS Signal Shop personnel. Such field instructions shall include, but not limited to, the final location and quantity of the temporary microwave sensors and permanent detector loops. DTS Signal Shop personnel will be responsible for traffic signal controller programming at the traffic signal cabinet to accommodate the temporary and permanent operations.
3. Contractor shall promptly take down and turnover the temporary microwave sensors to DTS when the permanent detector loops are in place and operational. Contractor shall perform all necessary work to restore traffic signal system back to a neat appearance of the electrical trade.

LEGEND FOR AS-BUILT POSTINGS	
	SQUIGGLY LINE FOR AS-BUILT DELETION
	DOUBLE LINE FOR AS-BUILT DELETION
Roadway	TEXT FOR AS-BUILT POSTING


TRAFFIC SIGNAL LEGEND
 Temporary Microwave Detector

STATE OF HAWAII
DEPARTMENT OF TRANSPORTATION
HIGHWAYS DIVISION

TRAFFIC SIGNAL PLAN
MOKAPU SADDLE ROAD REHABILITATION
Nanamoana Street to Oneawa Street
Fed. Aid Project No. STP-065-1(011)
Scale: 1"=20' Date: March 2017
SHEET No. 716 OF 17 SHEETS


AS-BUILT

FED. ROAD DIST. NO.	STATE	FED. AID PROJ. NO.	FISCAL YEAR	SHEET NO.	TOTAL SHEETS
HAWAII	HAW.	STP-065-1(011)	2017	80	80

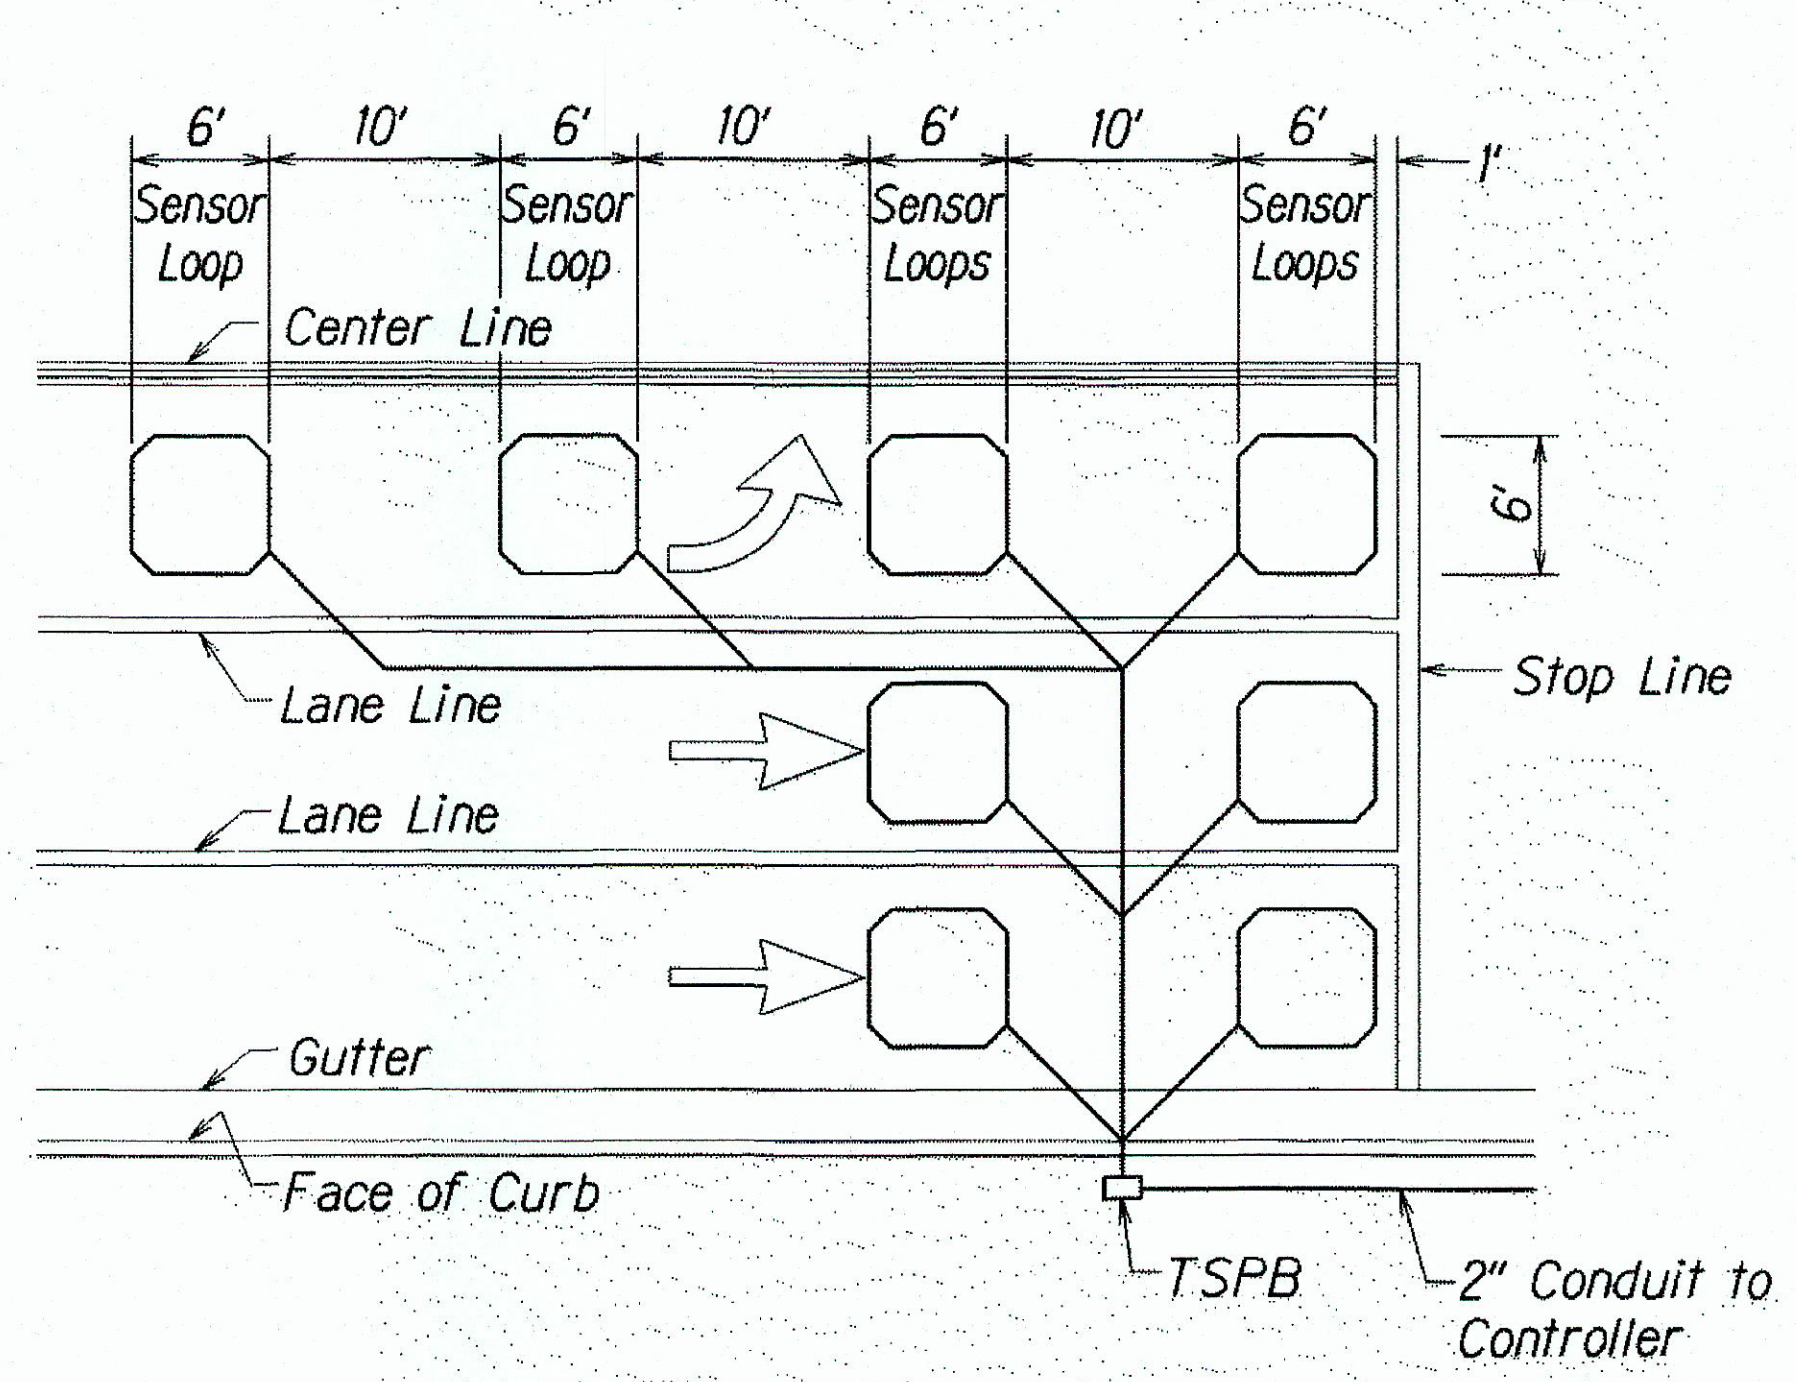


- NOTES:
- Center sensor loops in lanes.
 - Collector cables shall be twisted 2 turns per foot.
 - Number of loops and locations vary. See project plans.
 - Number and locations of collector sawcuts may be varied in the field to suit.


TYPICAL SENSOR LOOP LAYOUT

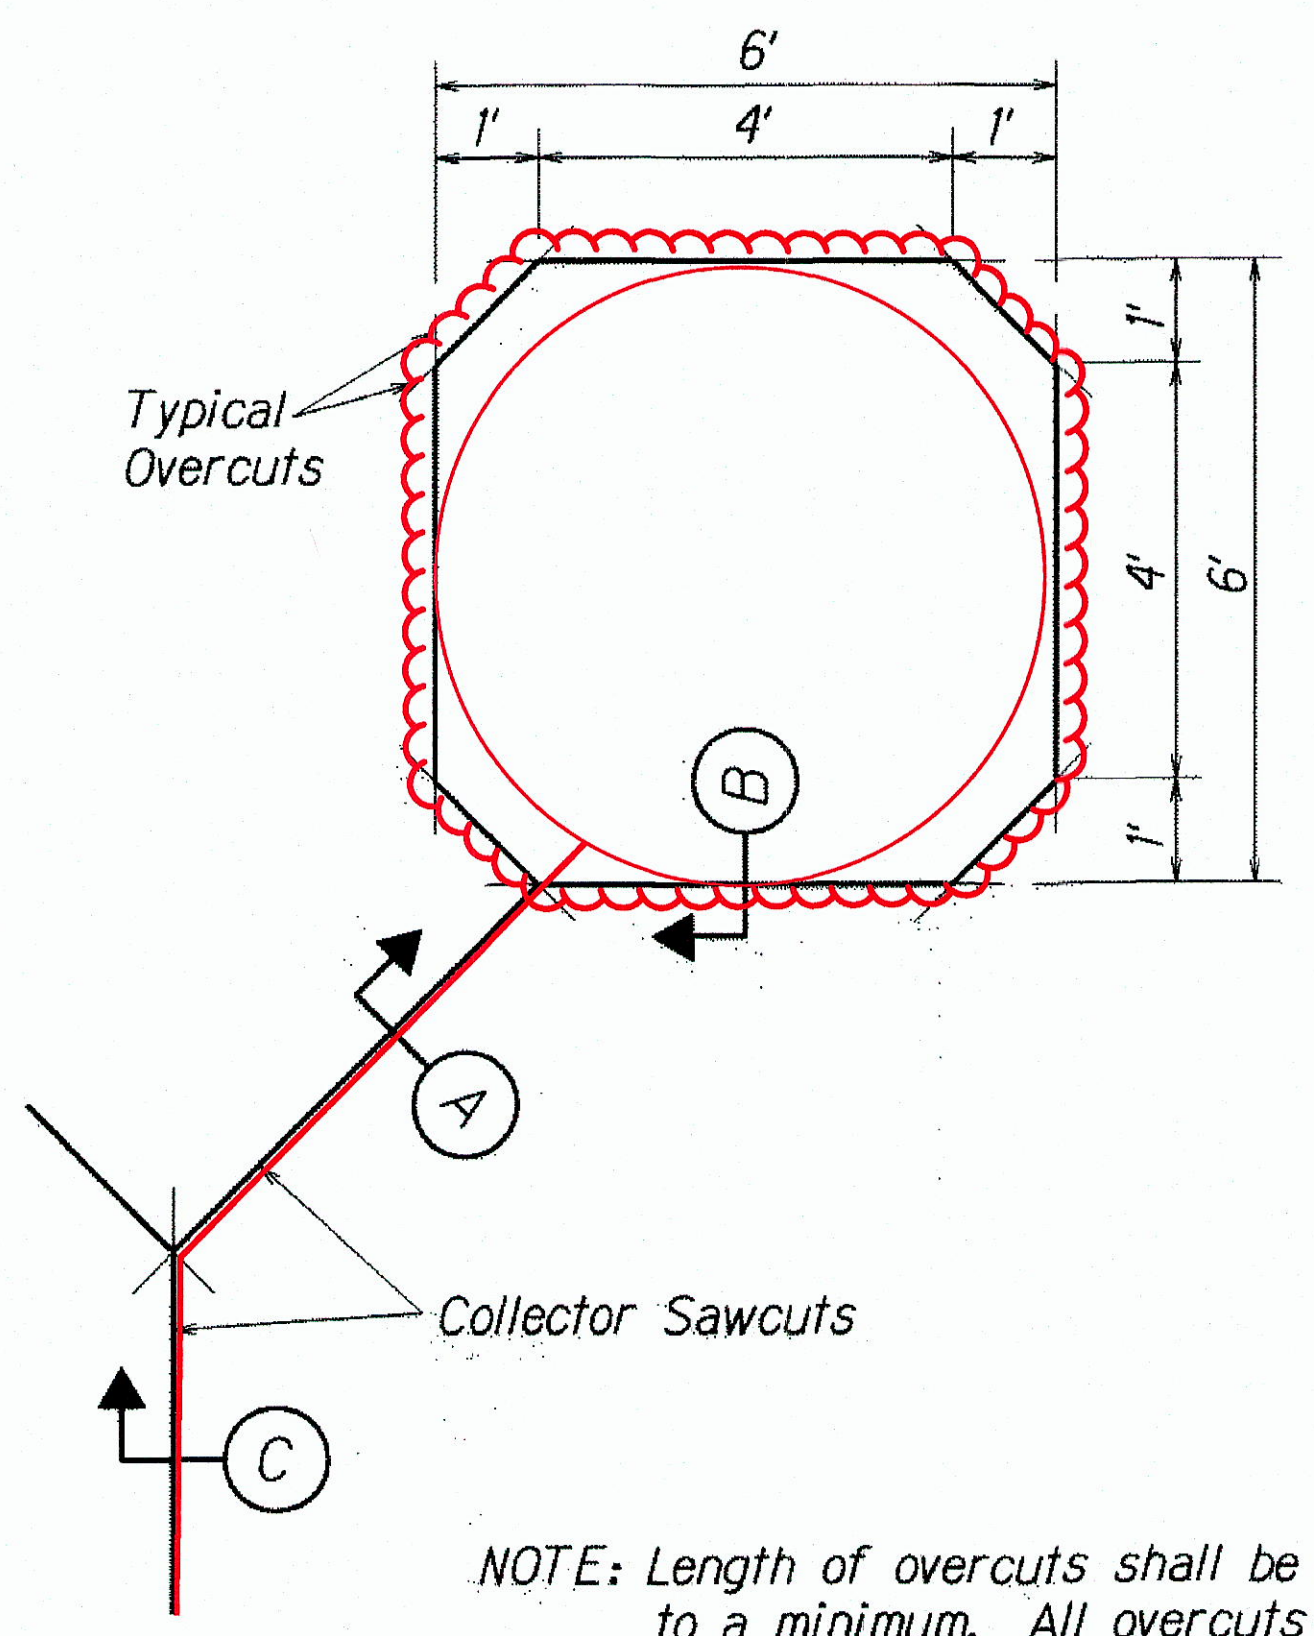

TYPICAL SENSOR LOOP SAWCUT DETAIL

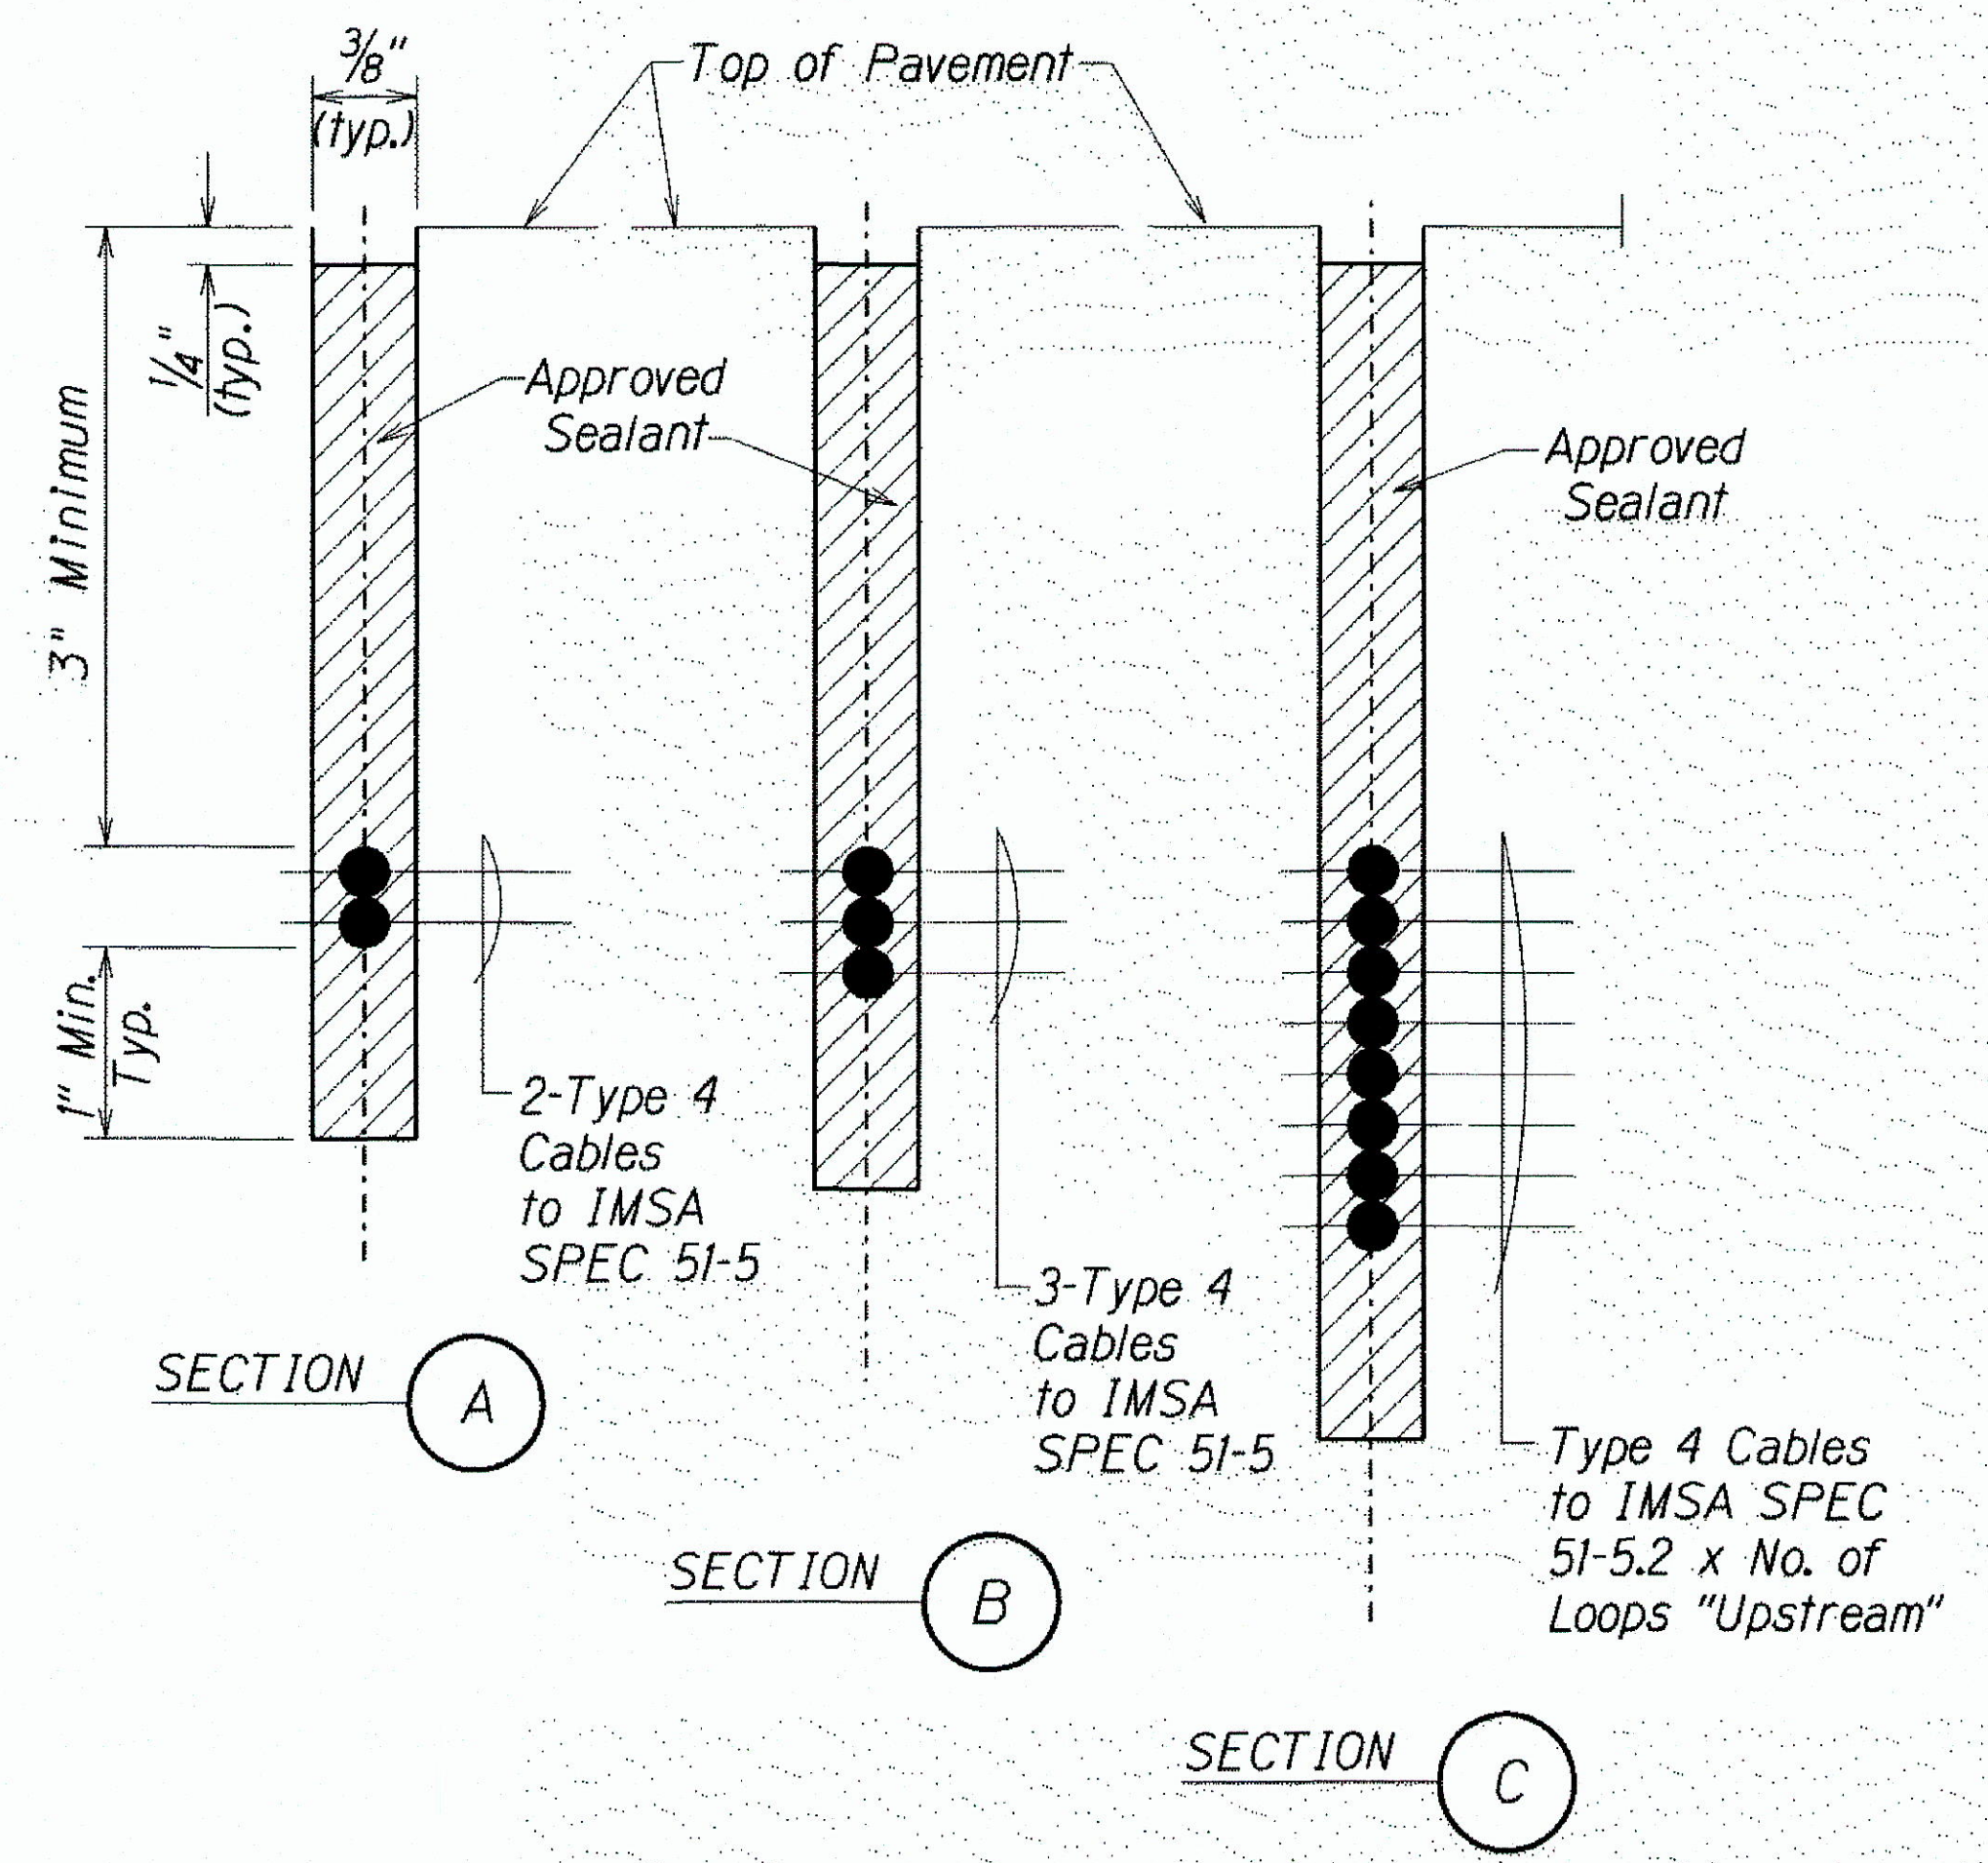


TYPICAL SECTION THROUGH SENSOR LOOP
Not to Scale

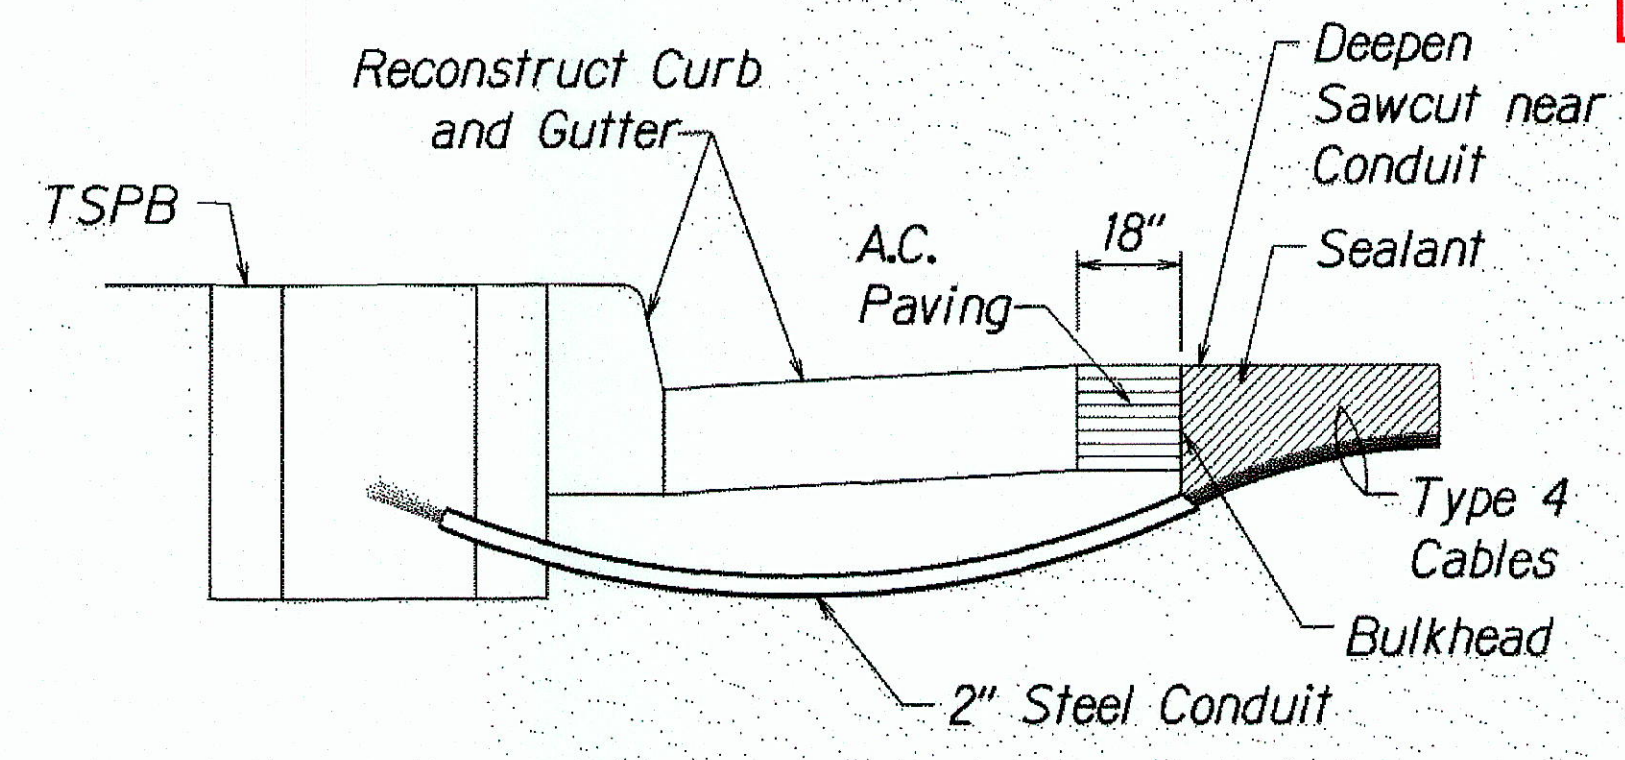

- NOTES ON CONSTRUCTION AT END OF SAWCUT
- Seal roadway end of conduit after installation of conductors.
 - Install bulkhead across conduit trench.
 - Place hot tar in sawcut.
 - Backfill over conduit with new A.C.
 - Reconstruct curb and gutter as required.

DETAIL OF SENSOR LOOP INSTALLATION
AT EDGE OF ROADWAY

APPROVED VARIANCE TO
INSTALL CIRCULAR
SENSOR LOOPS per
Submittal-JC35R

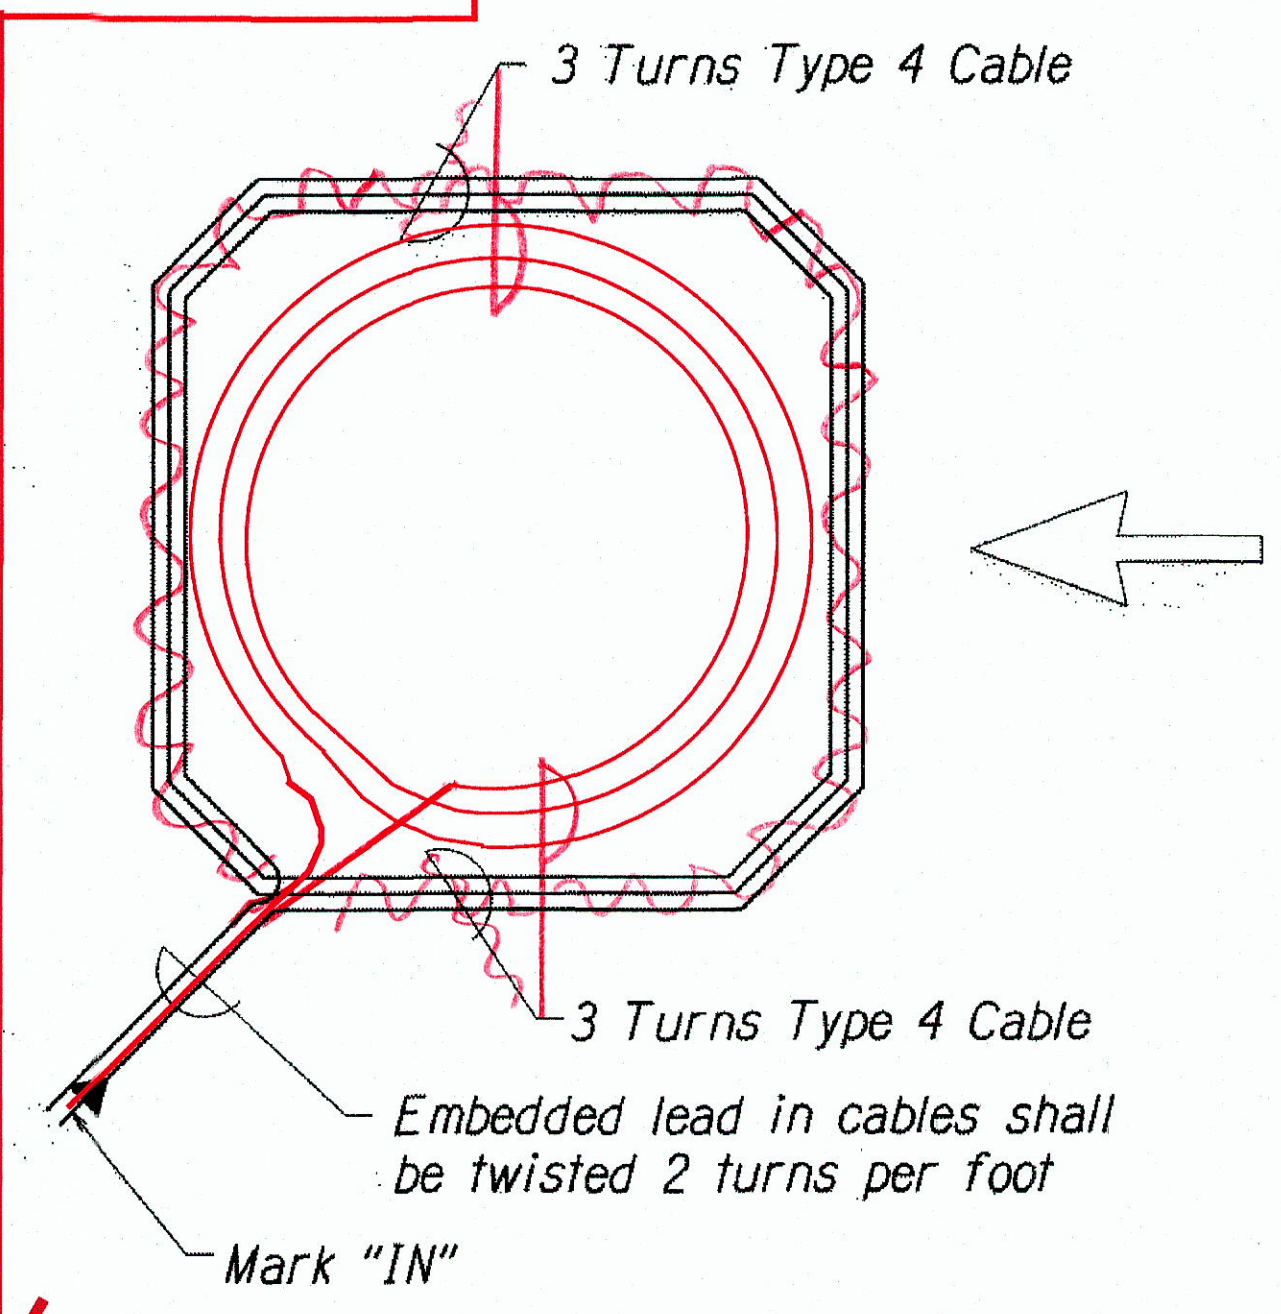

TYPICAL SENSOR LOOP WIRING DIAGRAM
Not to Scale

LEGEND FOR AS-BUILT POSTINGS	
	SQUIGGLY LINE FOR AS-BUILT DELETION
	DOUBLE LINE FOR AS-BUILT DELETION
	TEXT FOR AS-BUILT POSTING

STATE OF HAWAII
DEPARTMENT OF TRANSPORTATION
HIGHWAYS DIVISION

LOOP DETECTOR DETAILS







MOKAPU SADDLE ROAD REHABILITATION

Nanamoana Street to Oneawa Street

Federal Aid Project No. STP-065-1(011)

Scale: As Noted Date: March 2017

ORIGINAL PLAN	DATE
DRAWN BY	
NOTED BY	
CHECKED BY	
DATE	

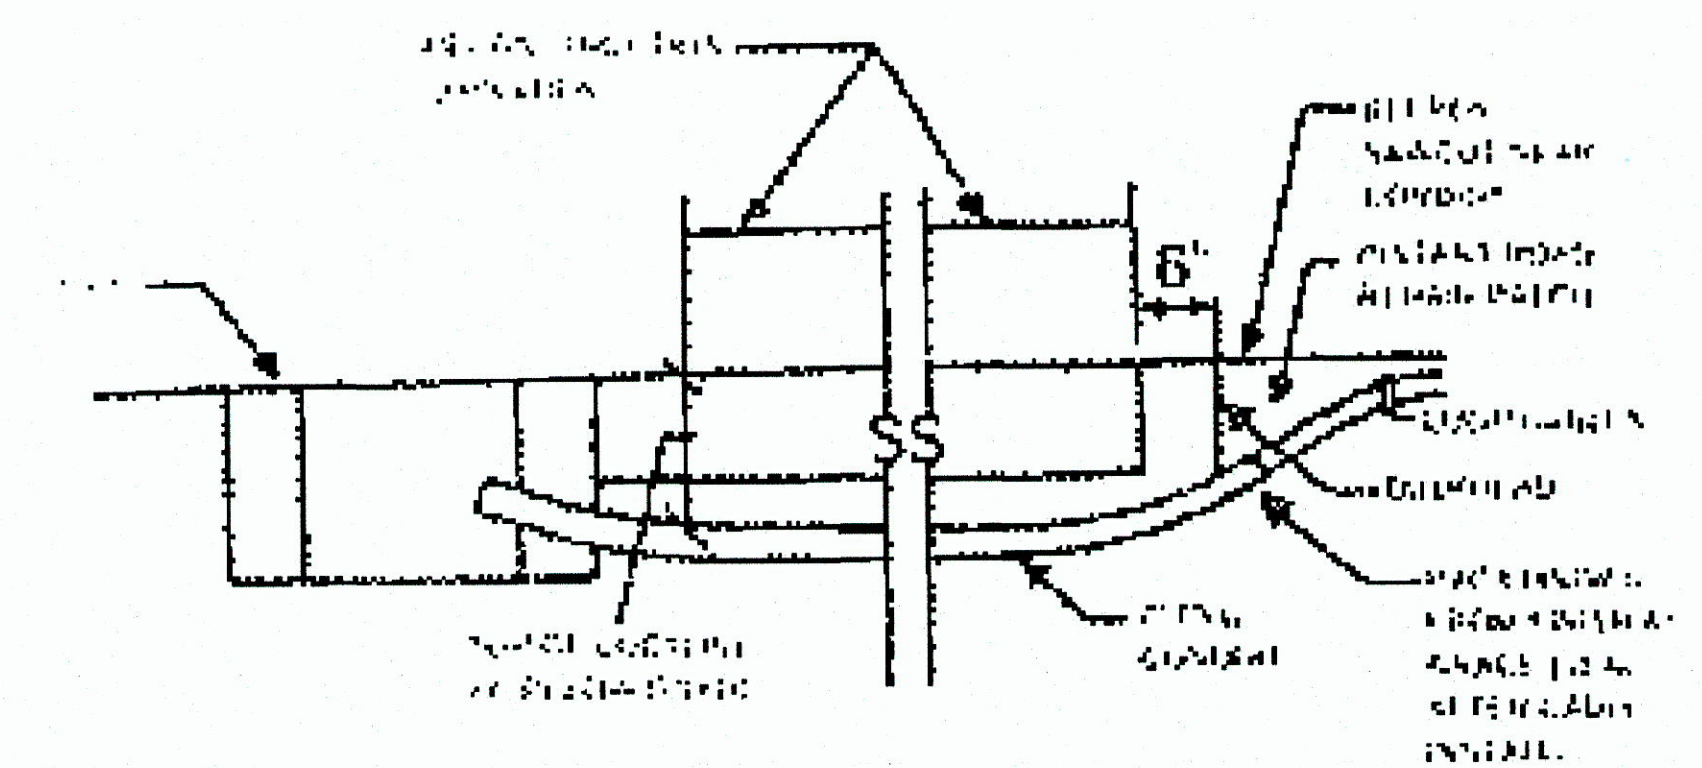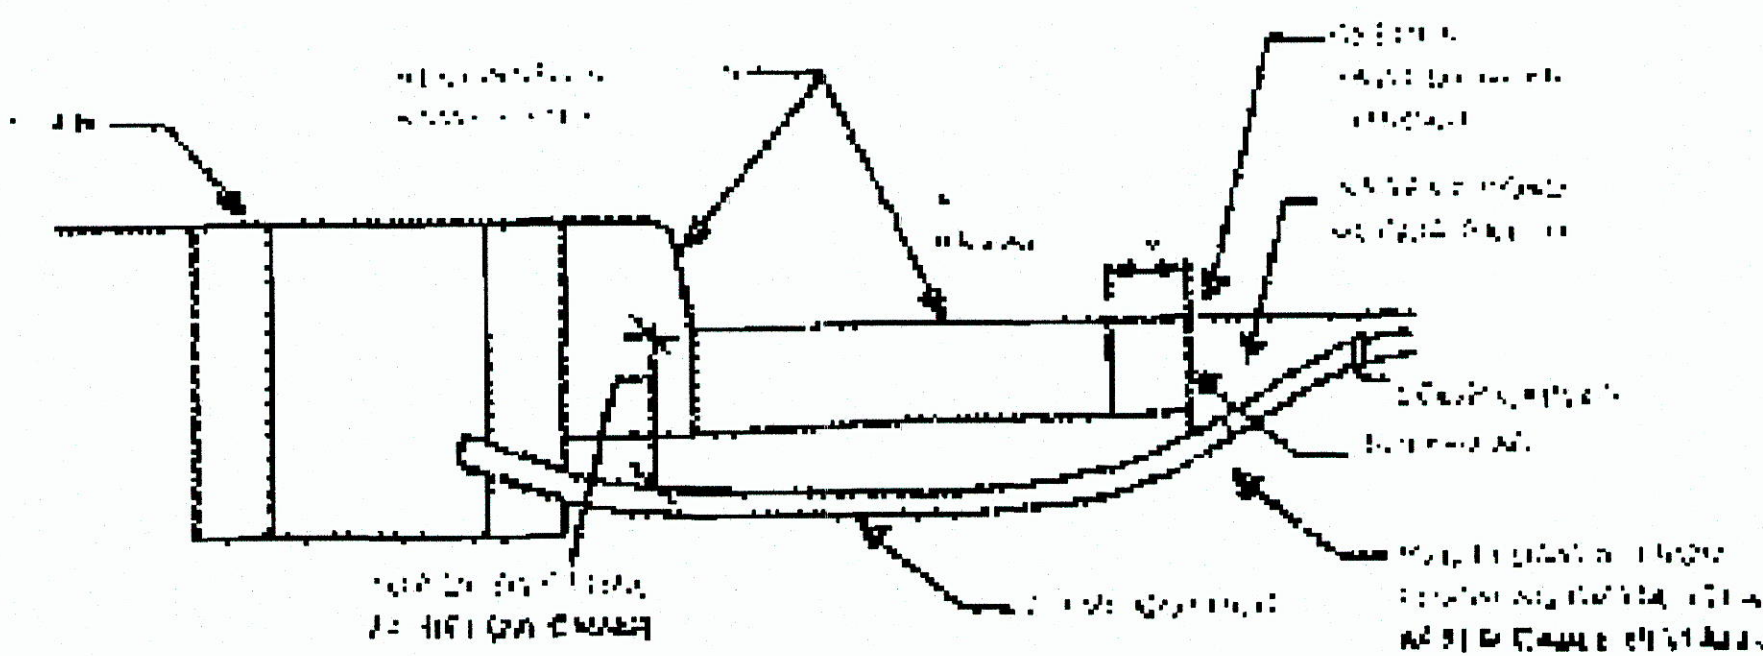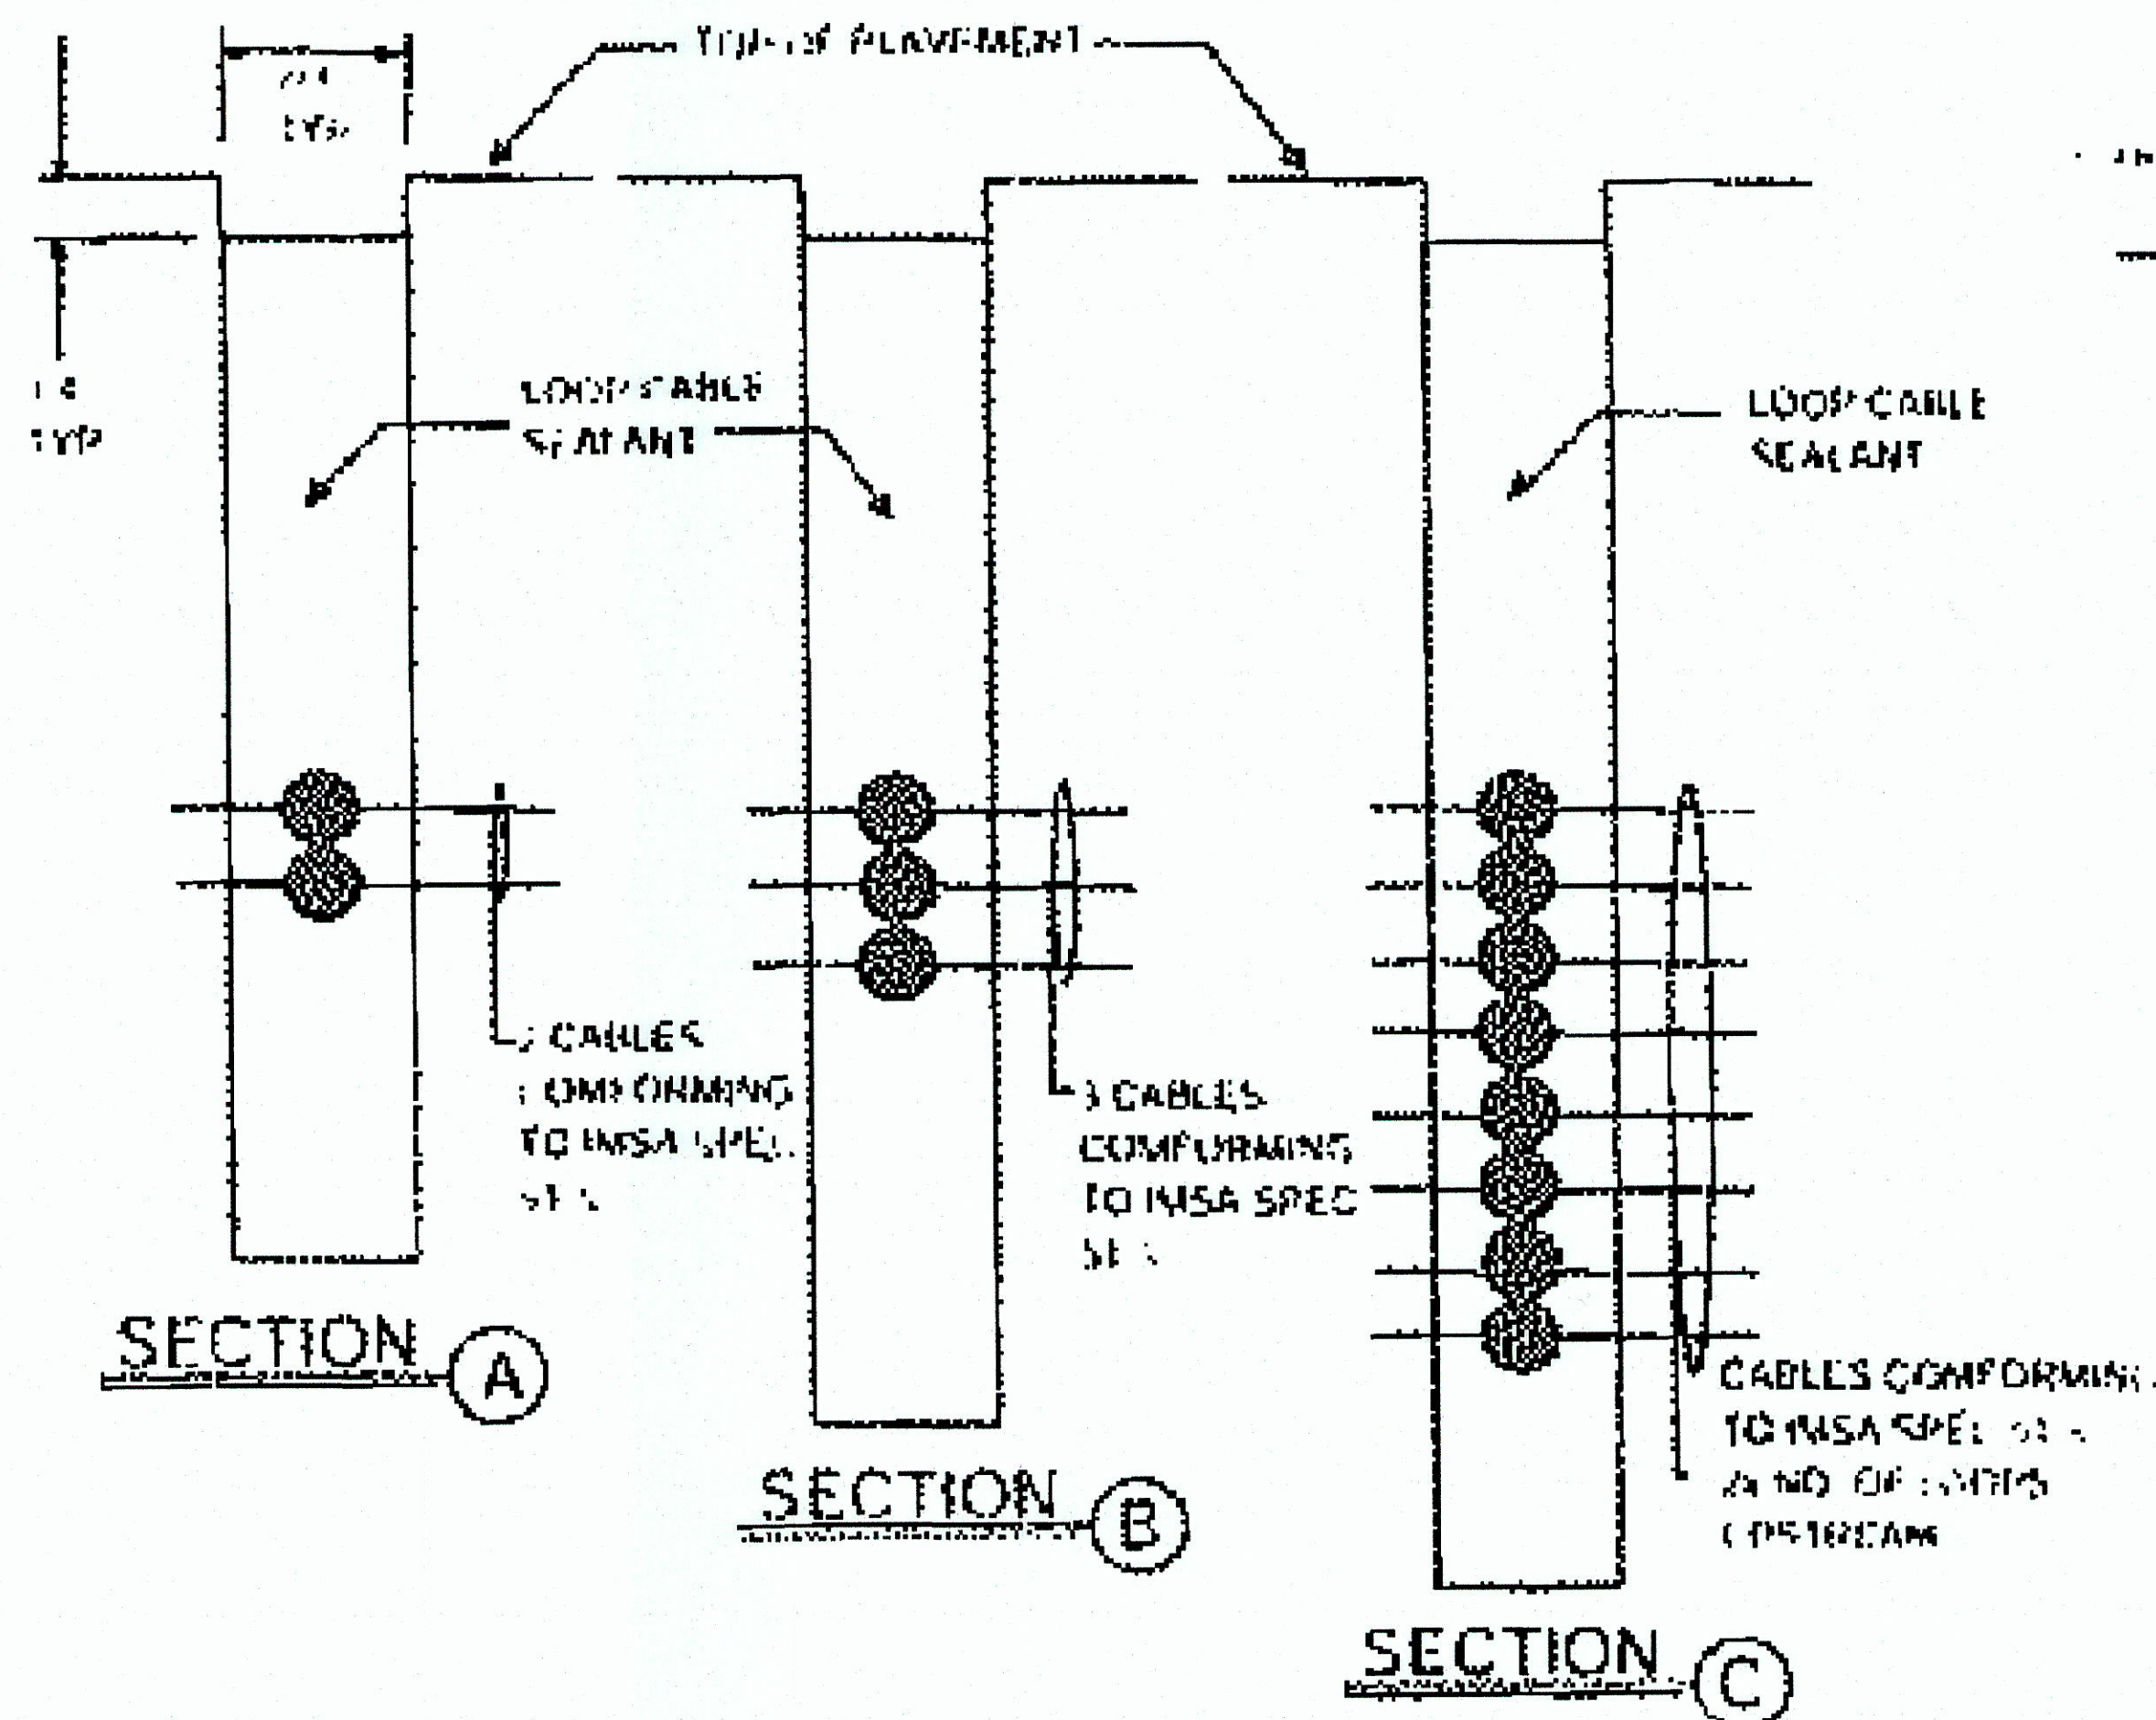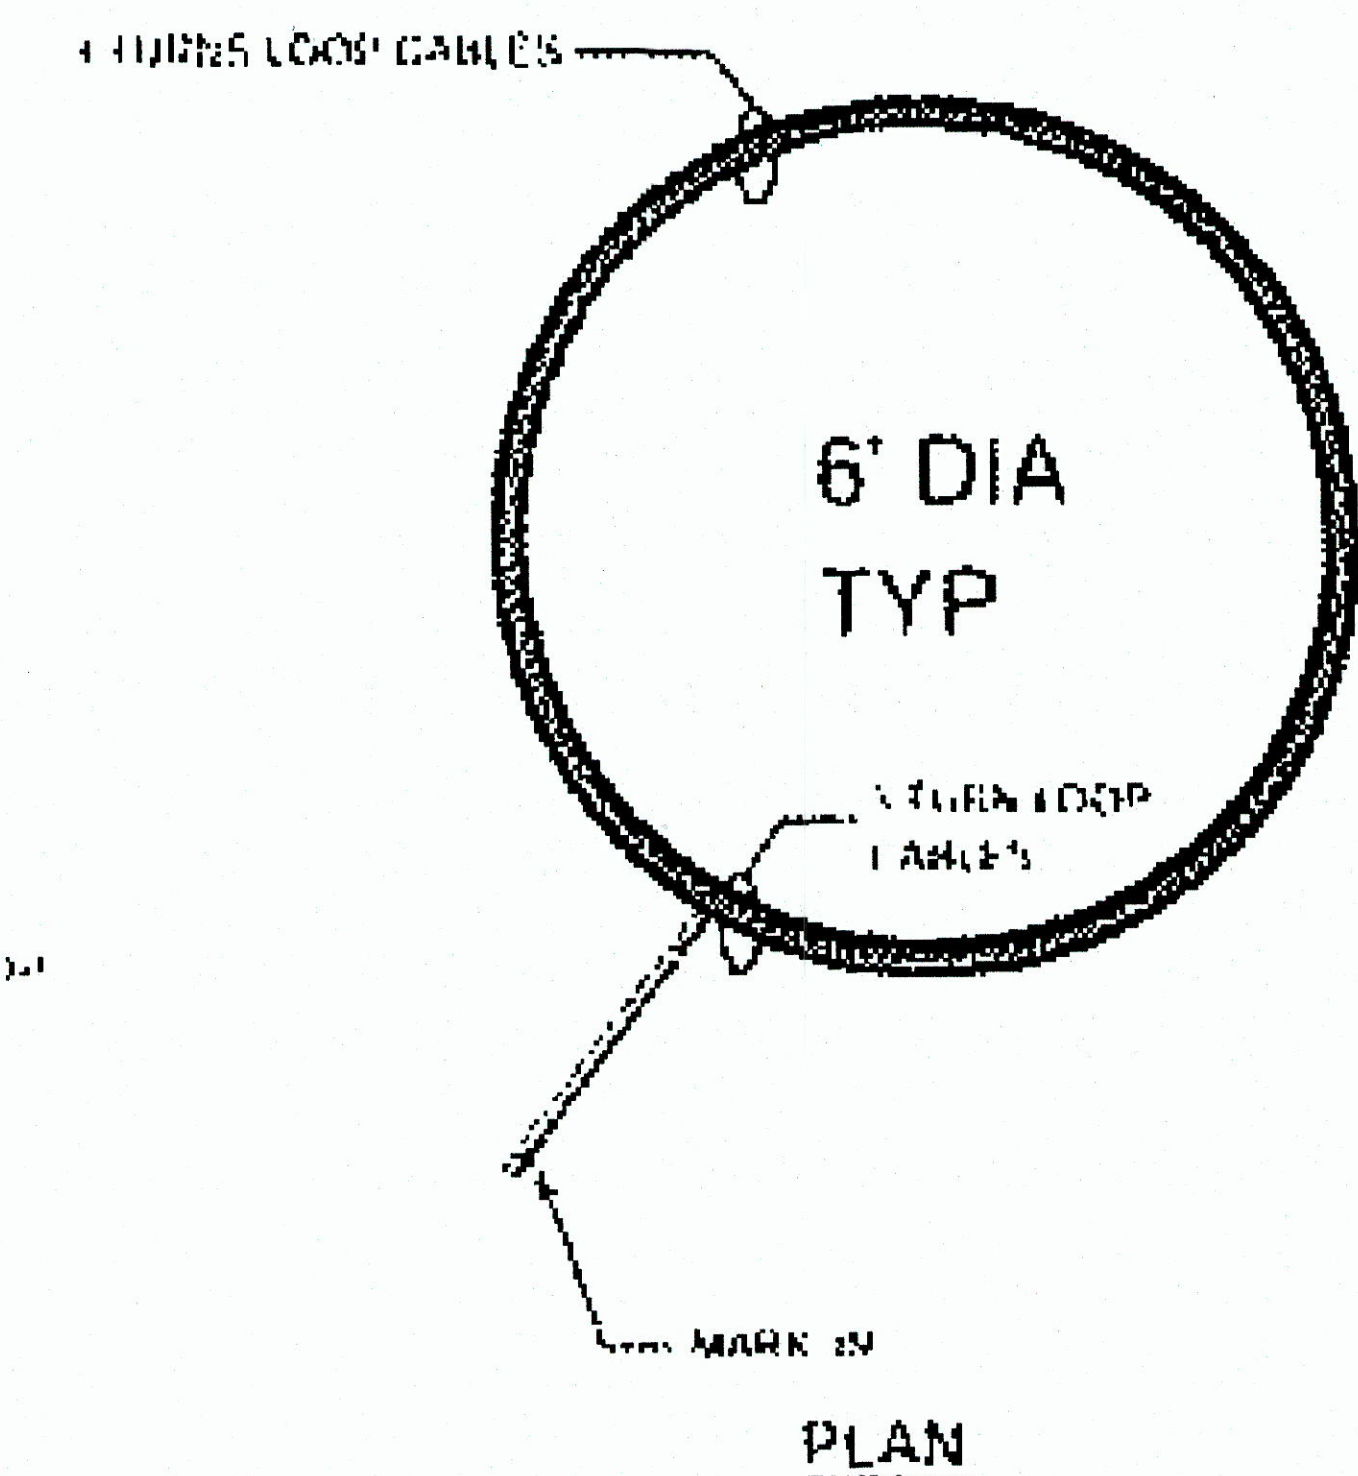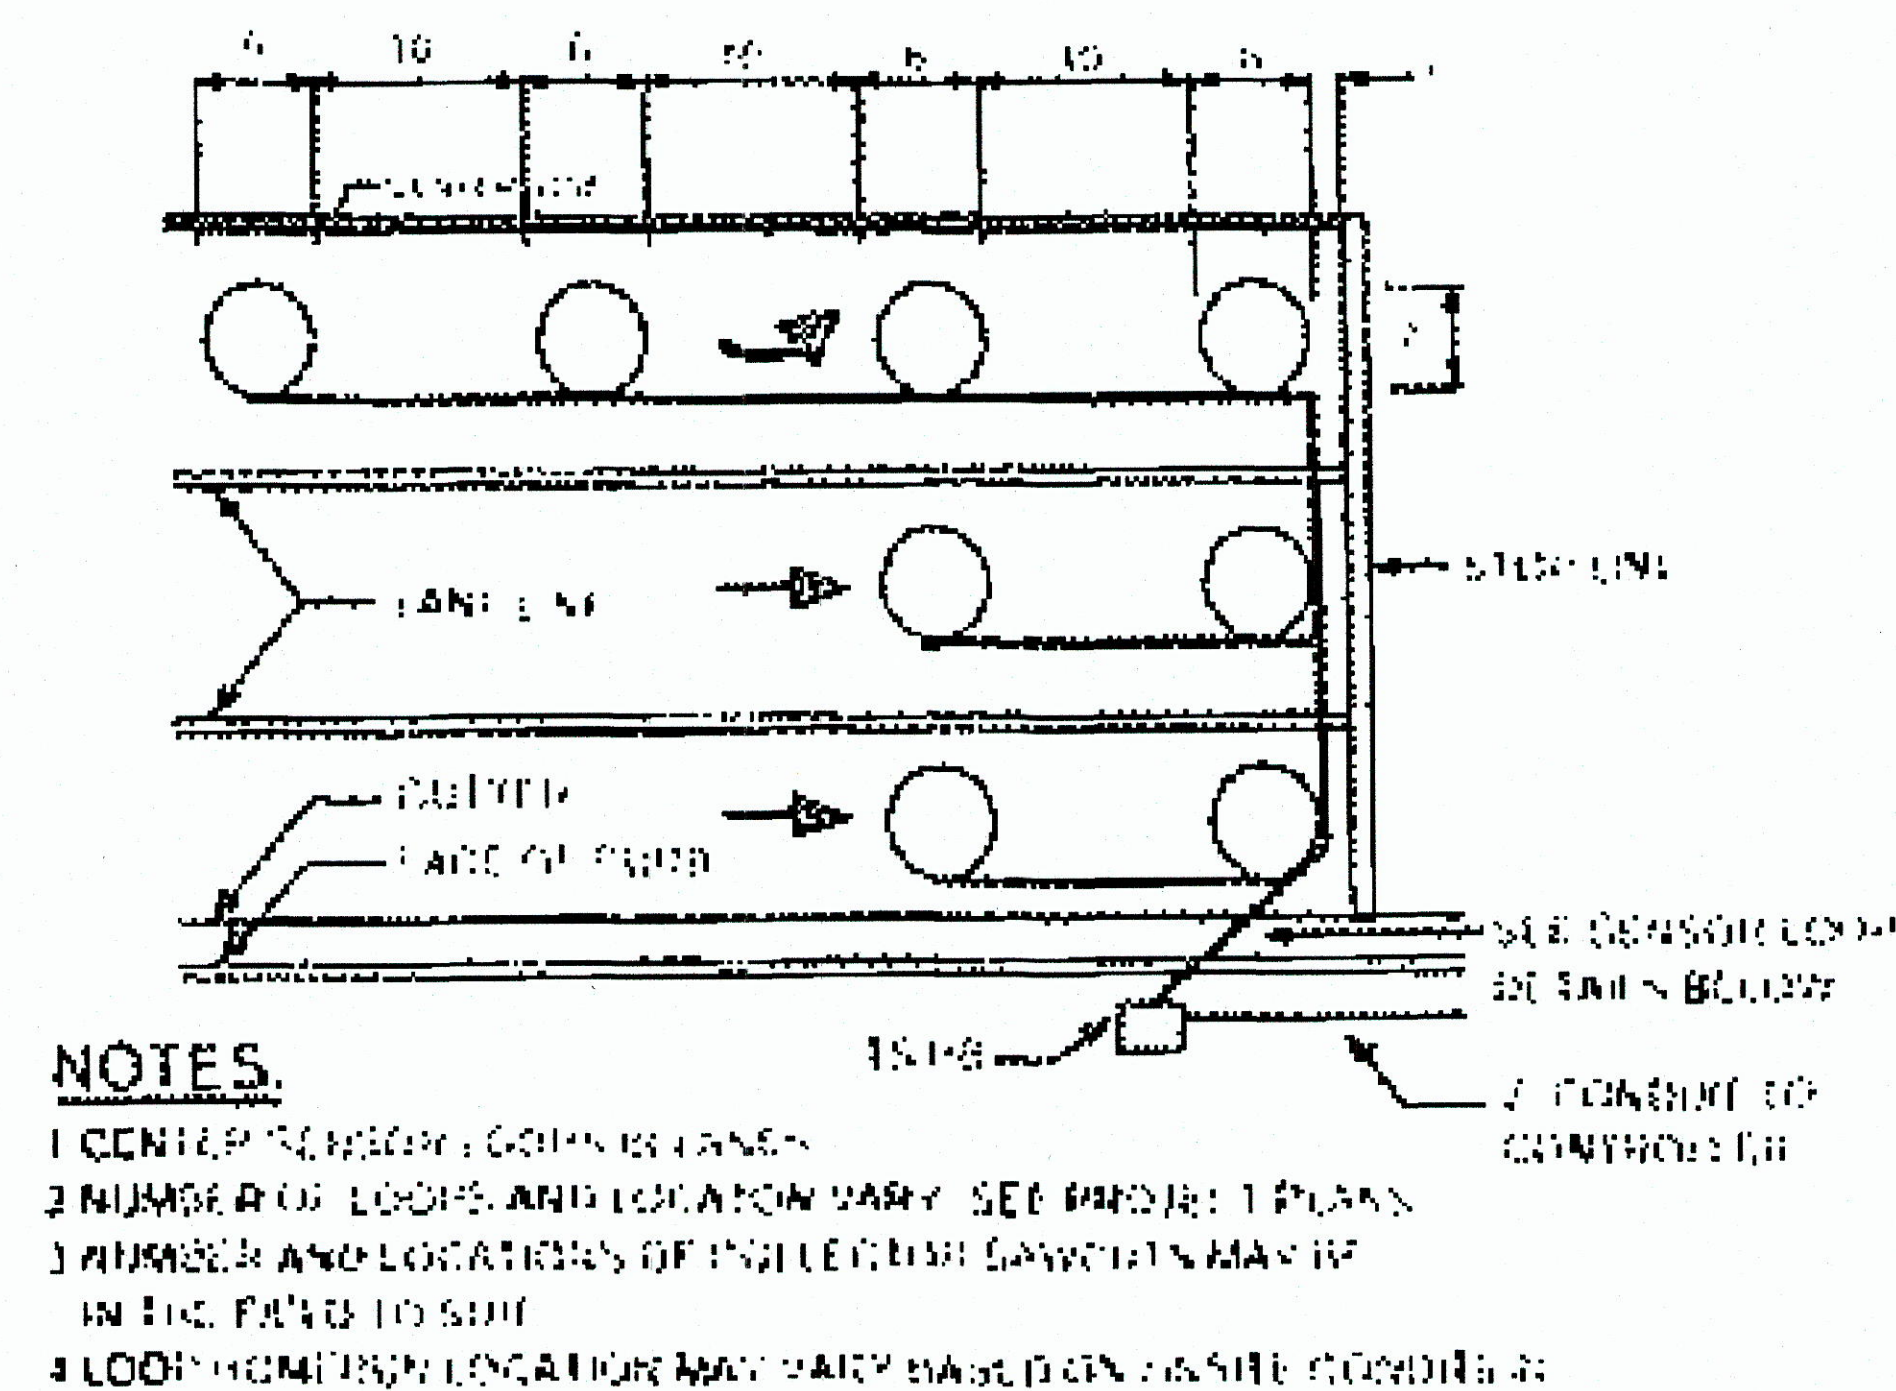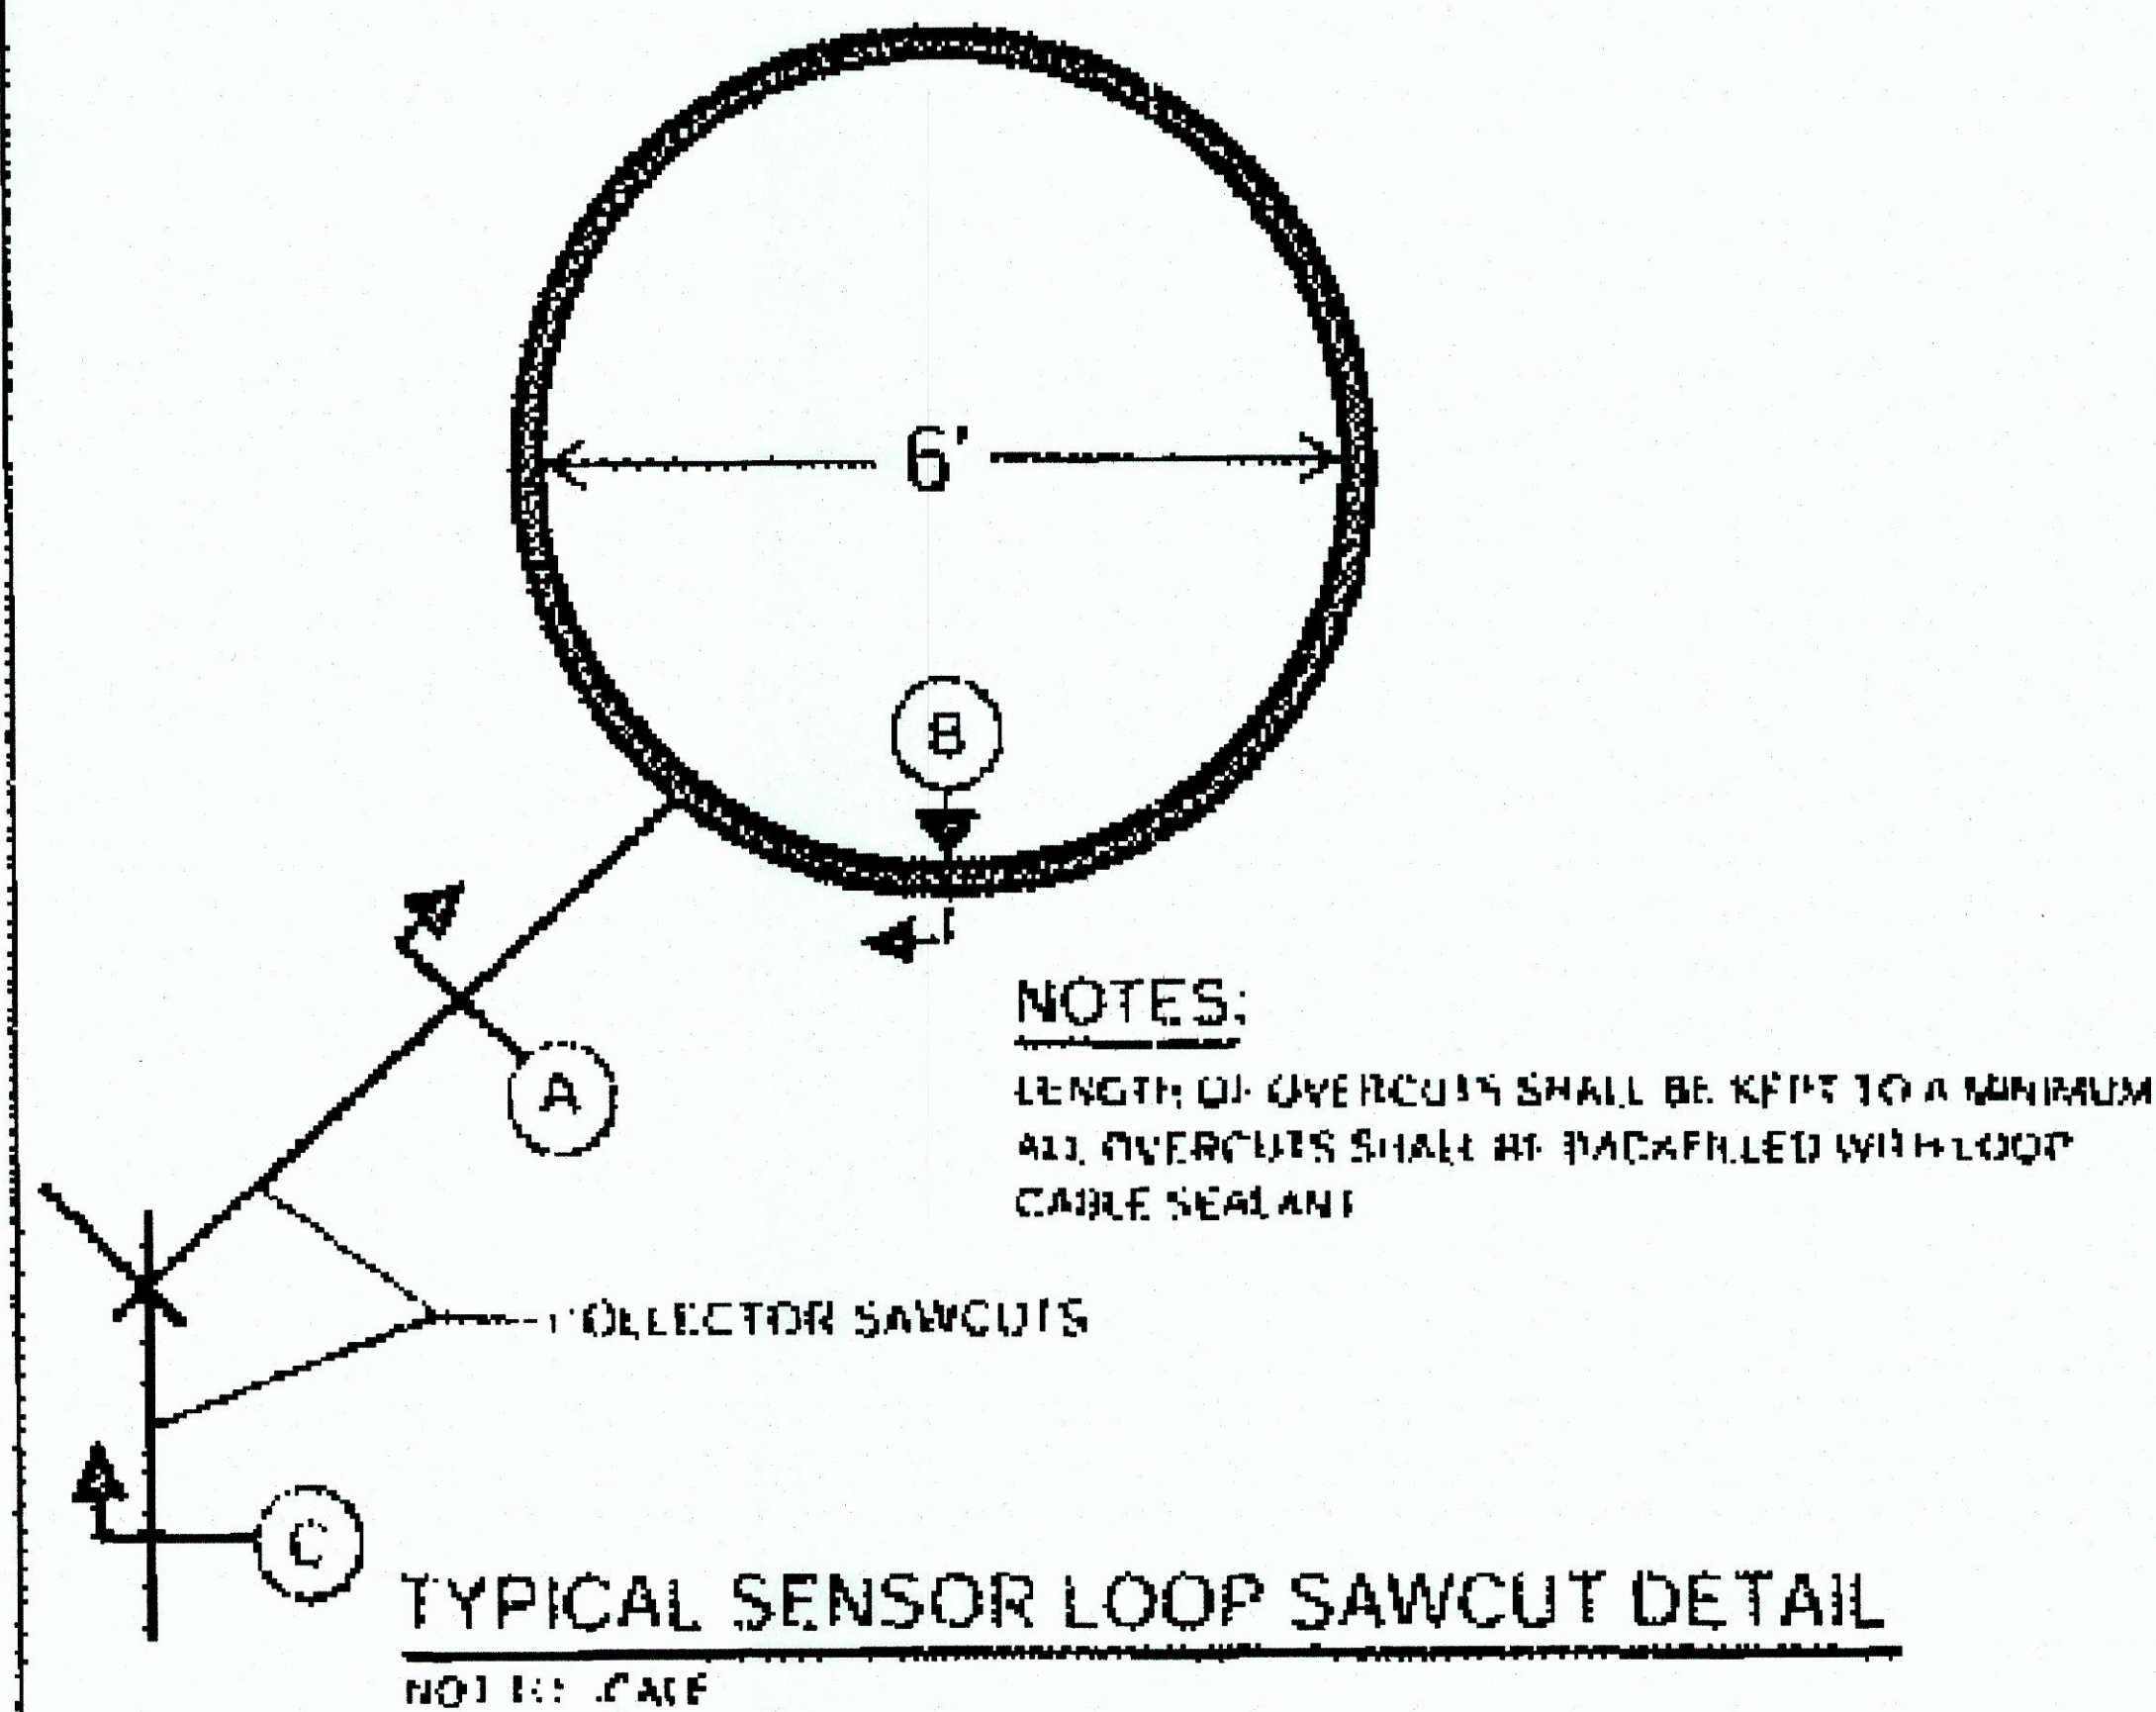

FOR REFERENCE ONLY