

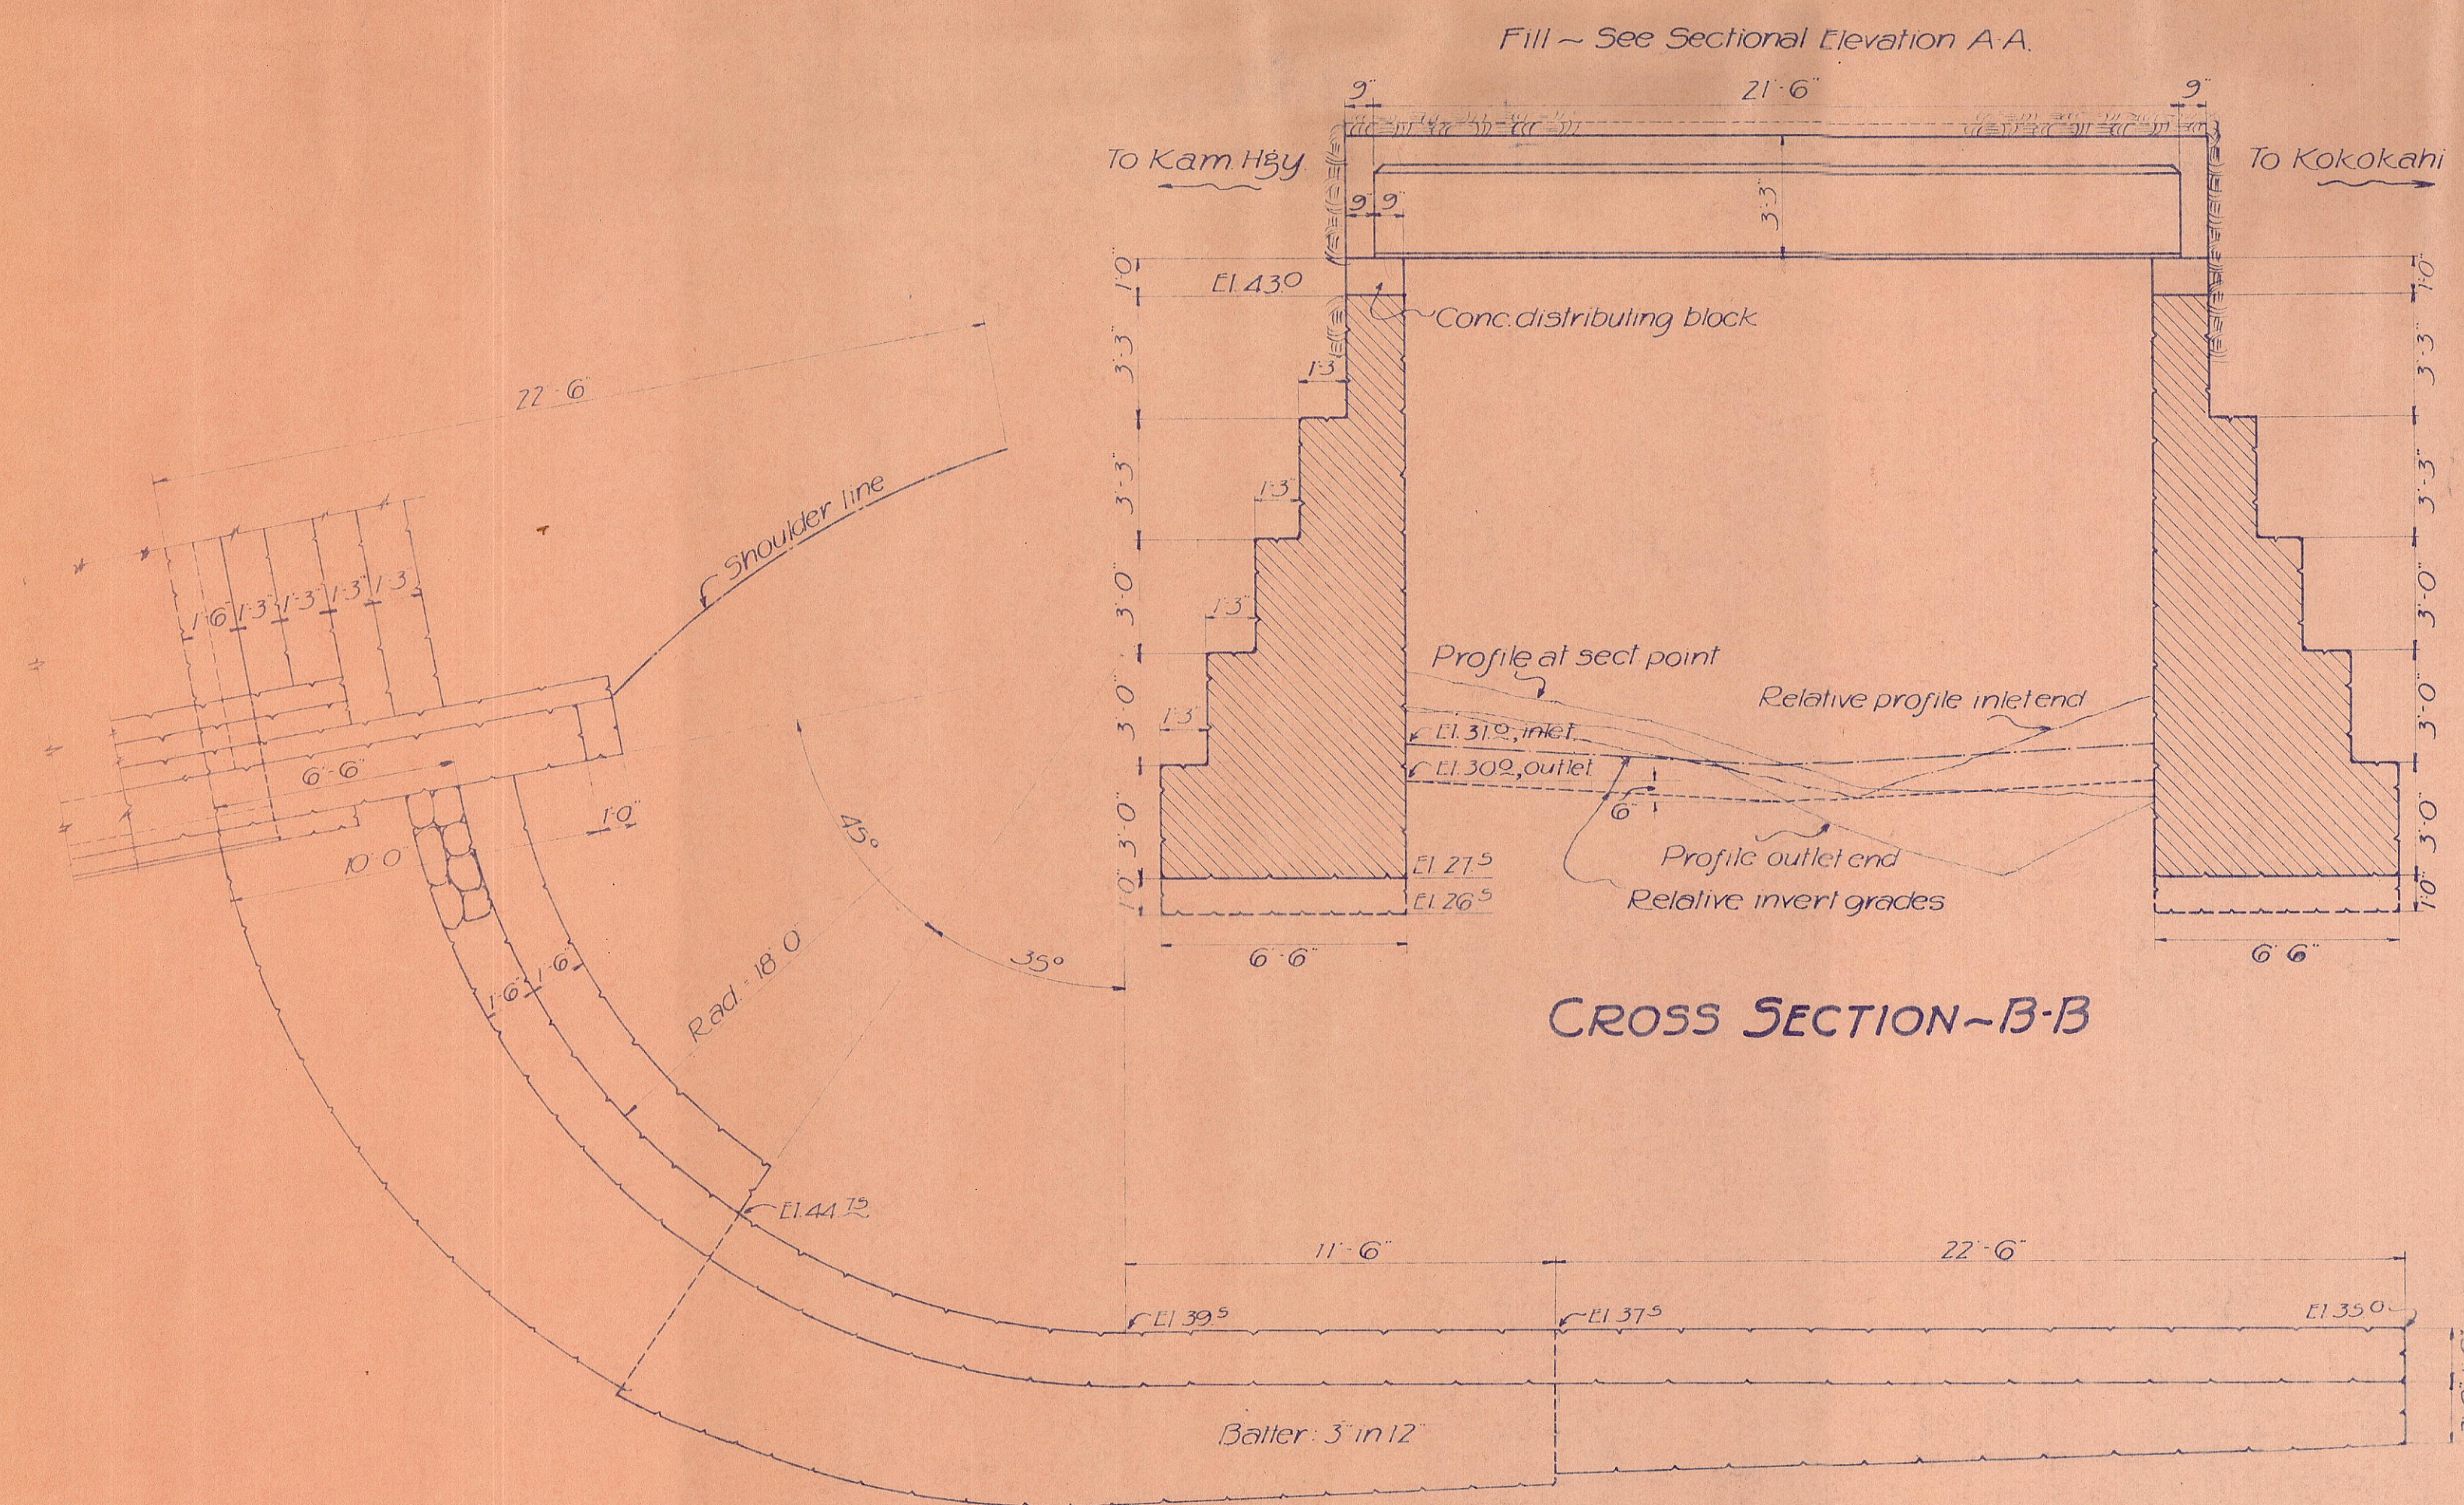


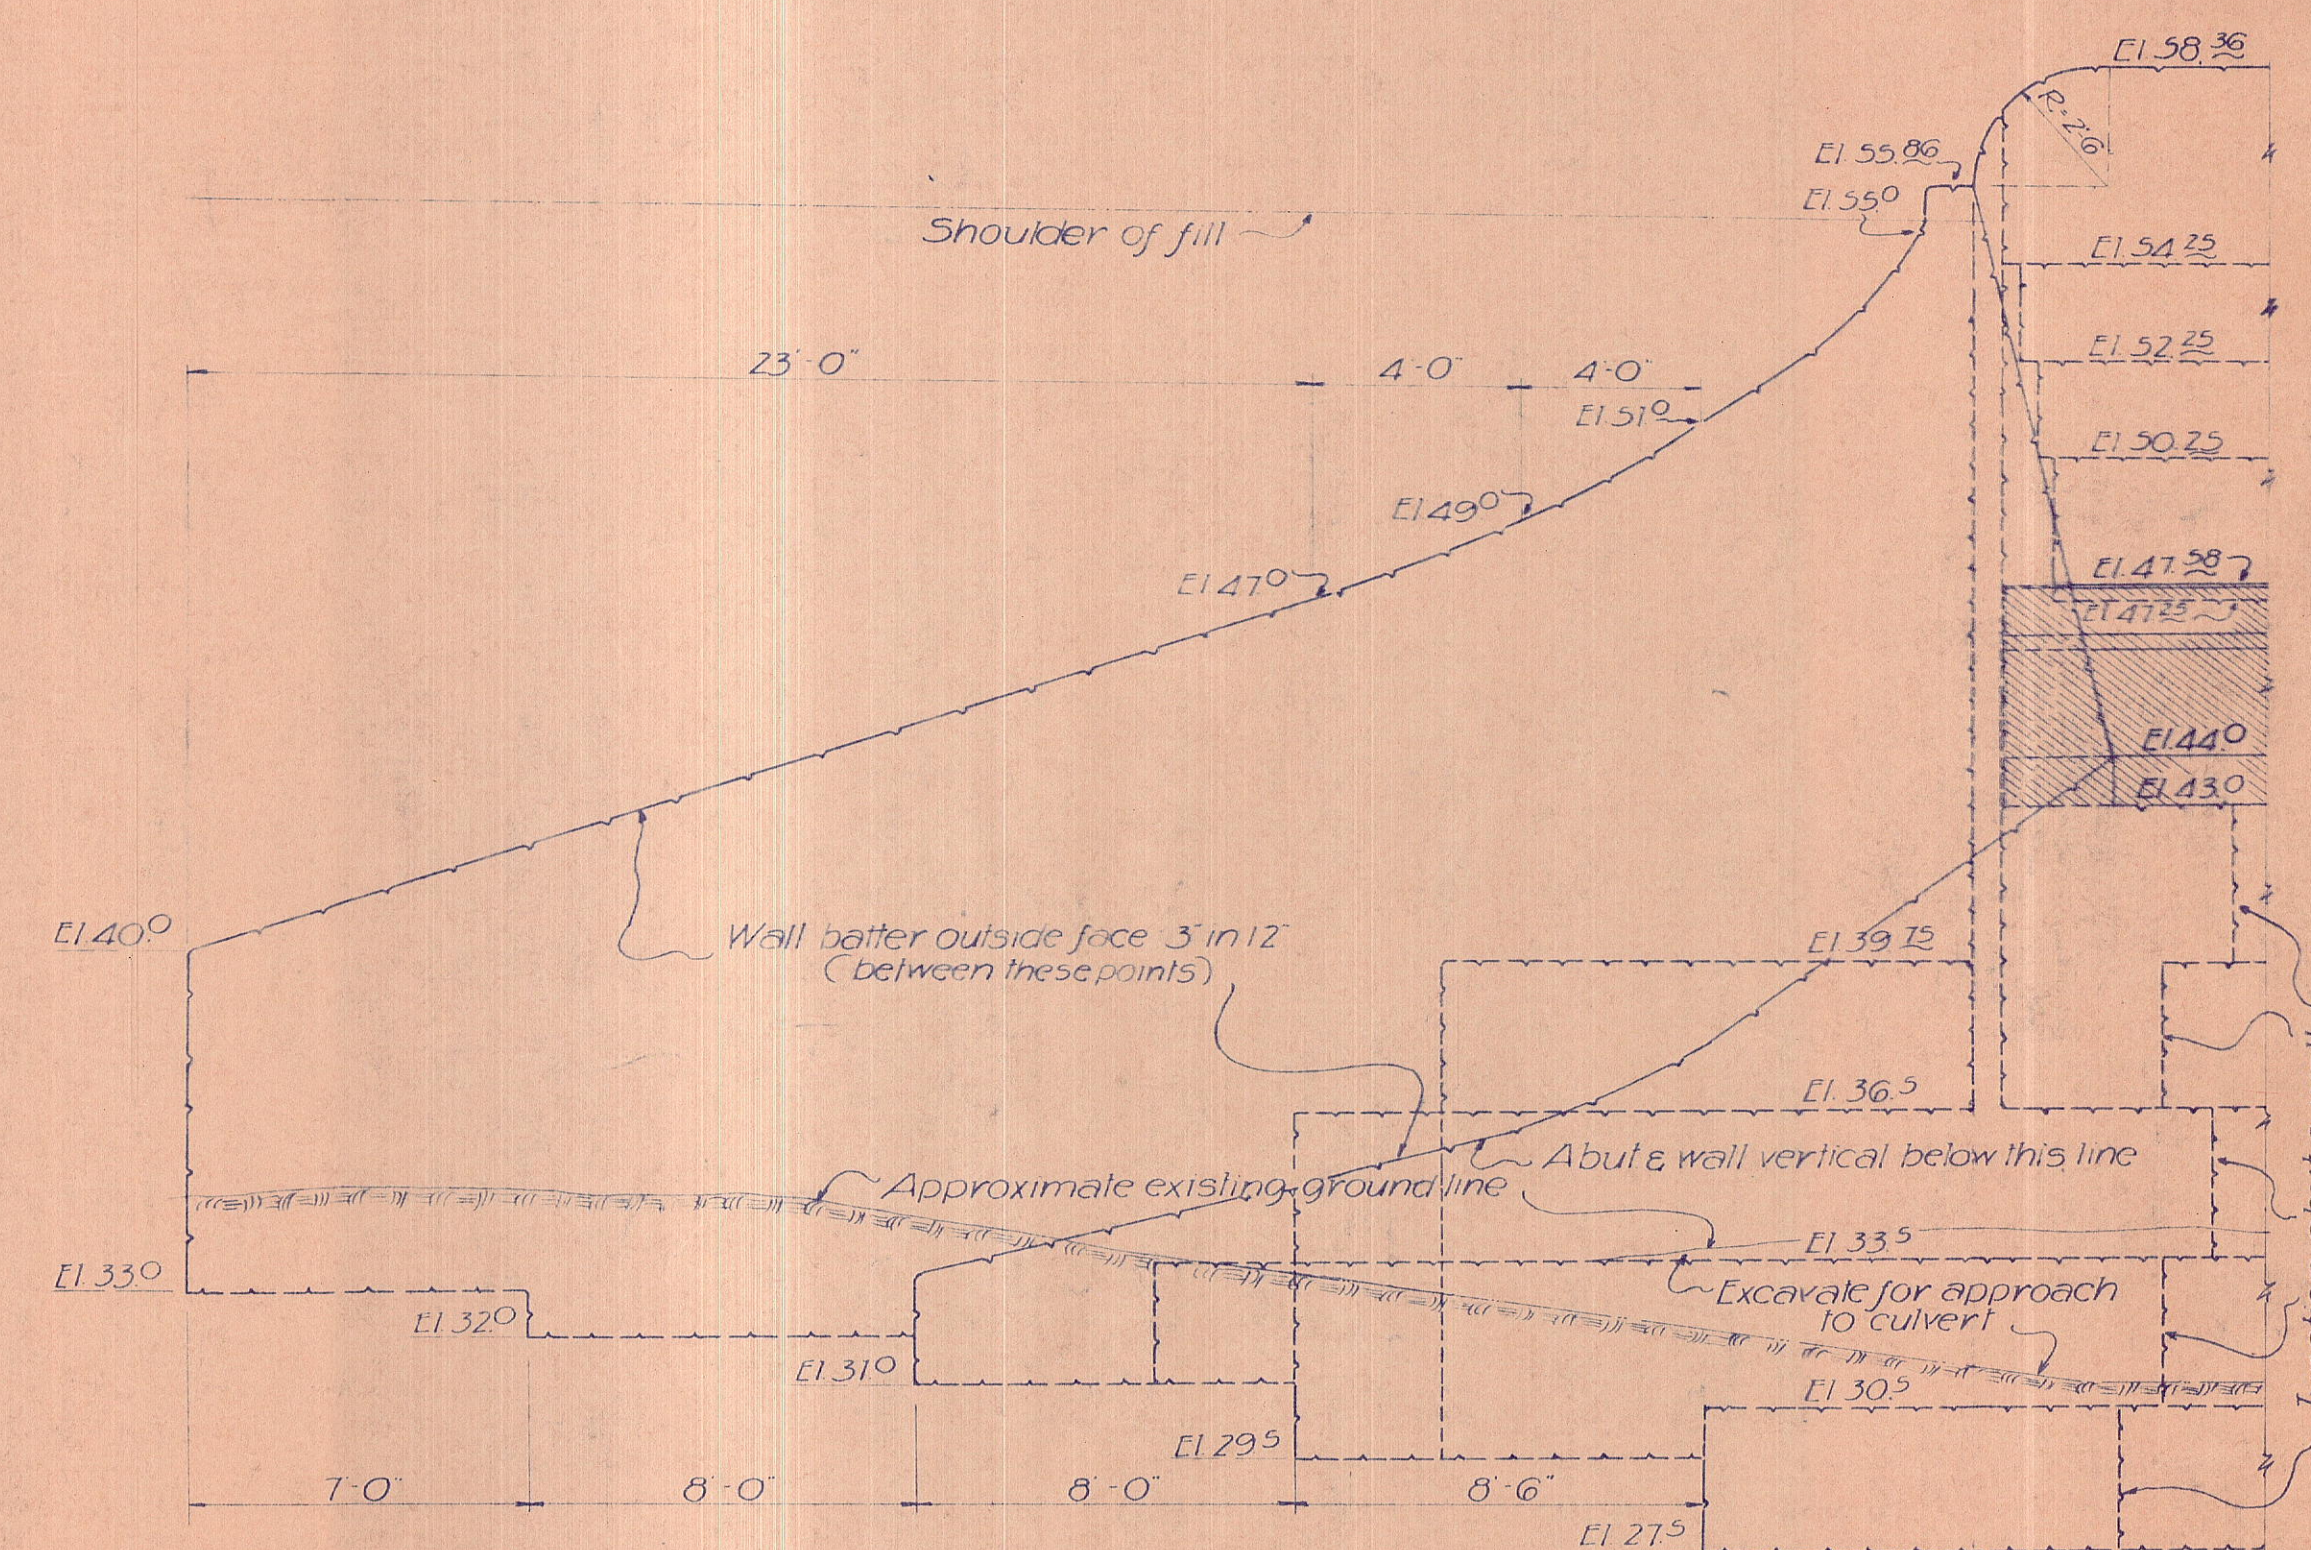

~ PLAN ~

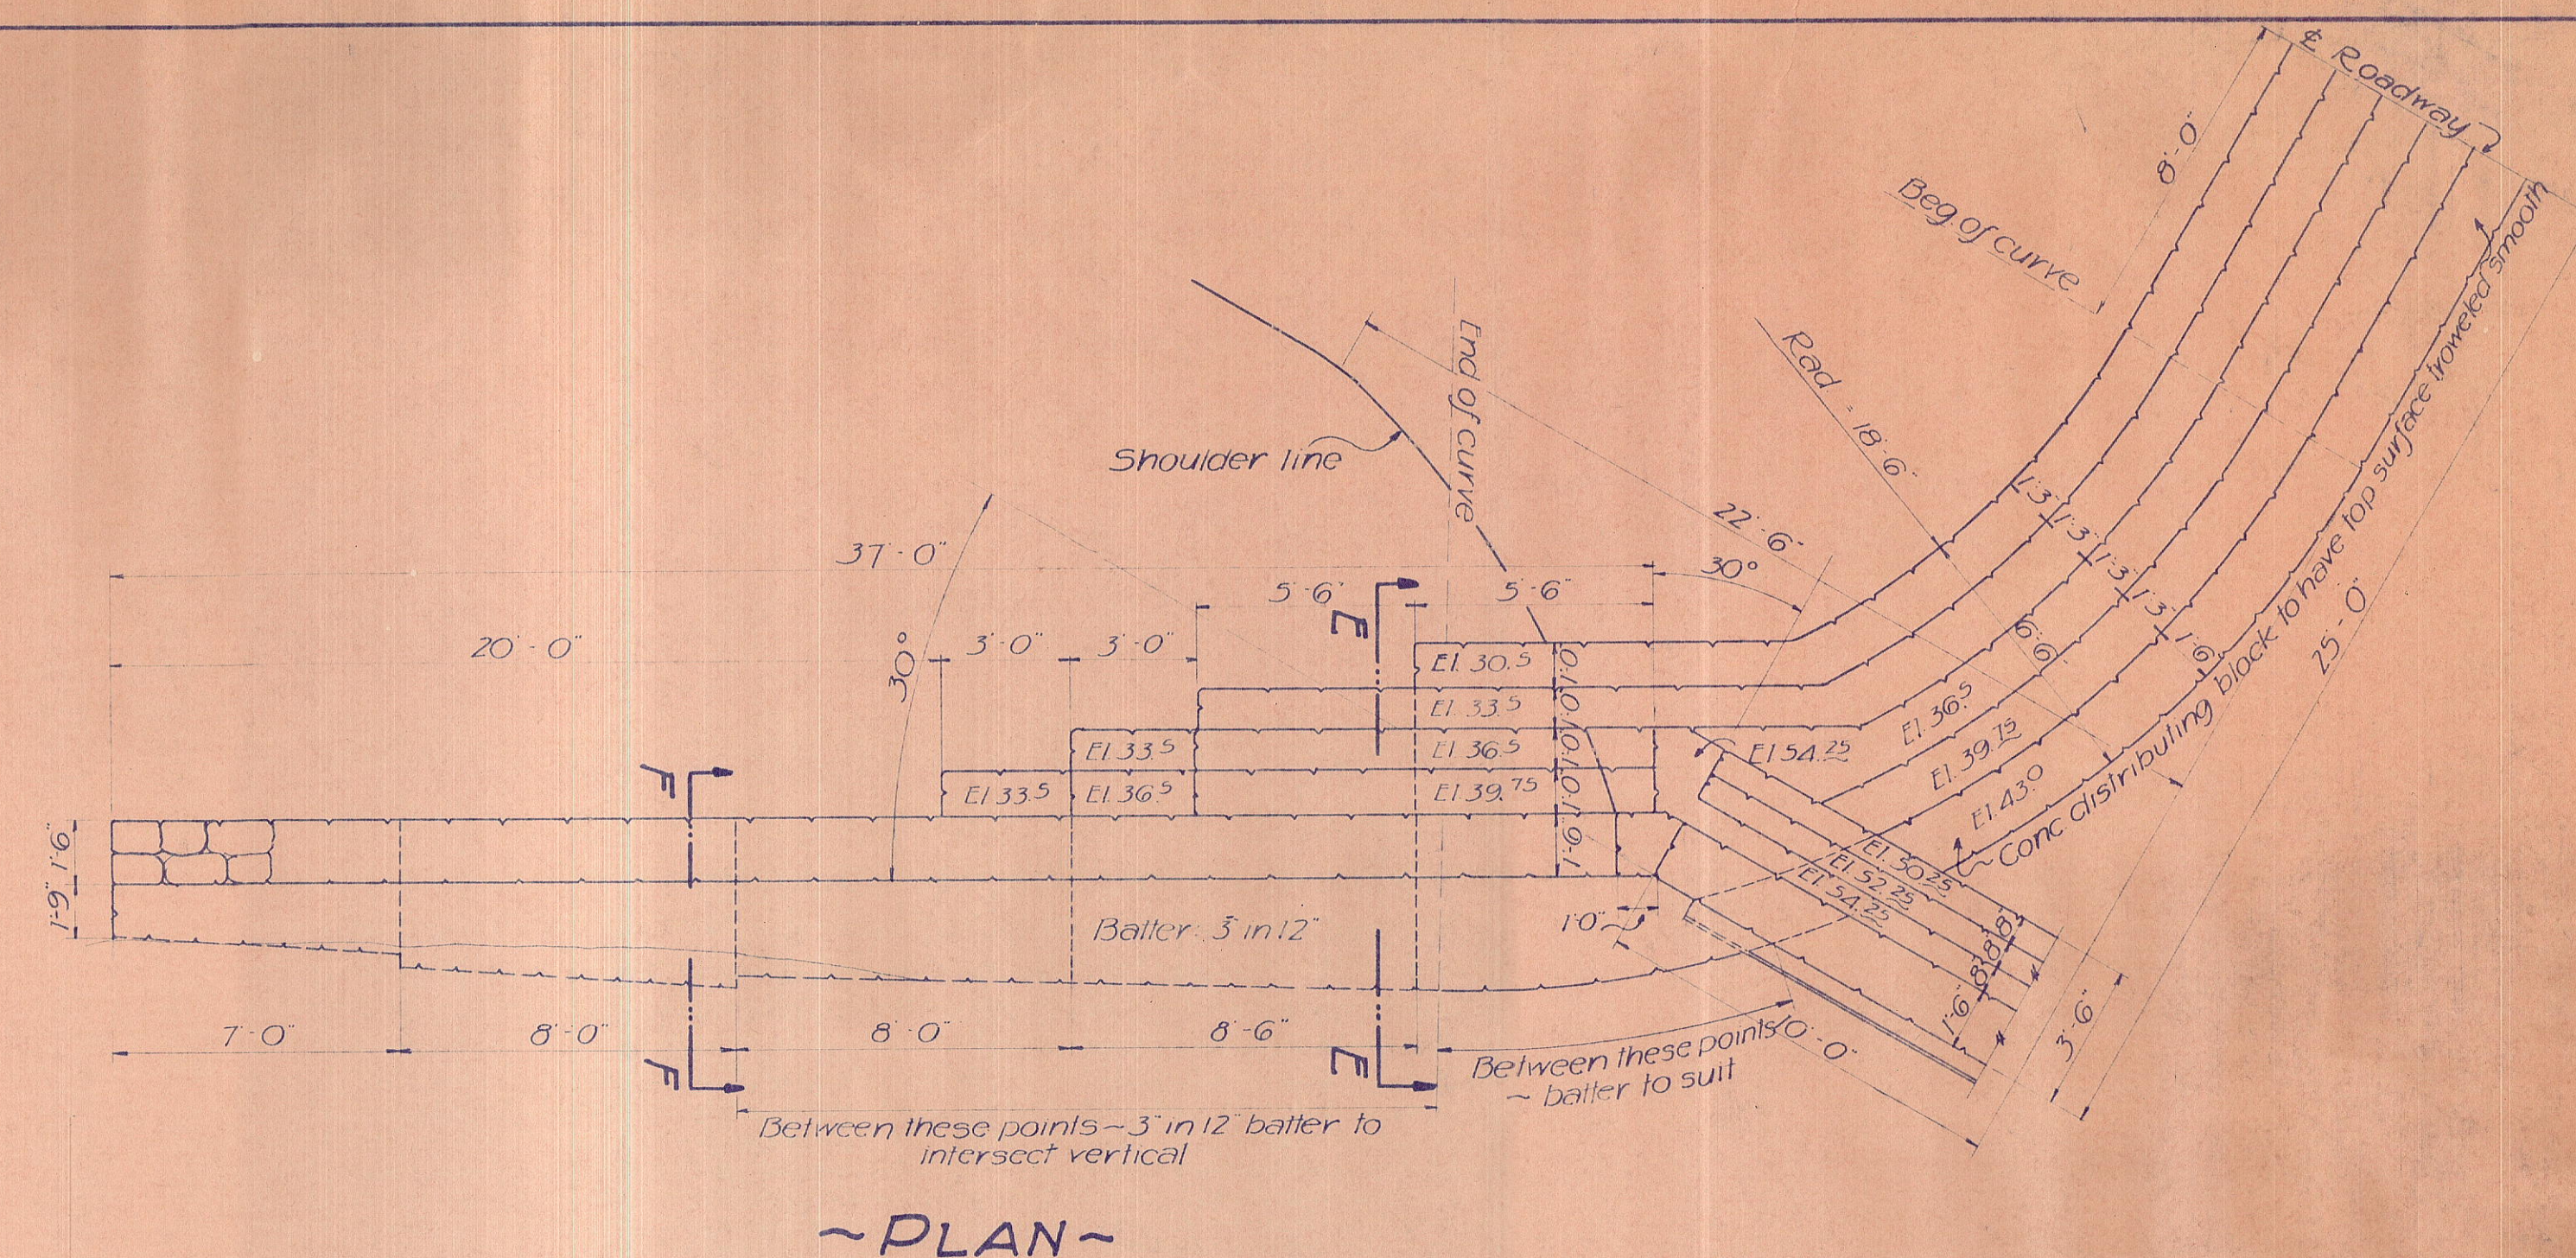

ELEVATION (INLET END)  
KAM. HIGHWAY SIDE

|                                                                                                                                                                                                                                                                                                                                                                                                                                                                                                                                                                             |                                                                                                                                                        |                                                                                                                                                      |
|-----------------------------------------------------------------------------------------------------------------------------------------------------------------------------------------------------------------------------------------------------------------------------------------------------------------------------------------------------------------------------------------------------------------------------------------------------------------------------------------------------------------------------------------------------------------------------|--------------------------------------------------------------------------------------------------------------------------------------------------------|------------------------------------------------------------------------------------------------------------------------------------------------------|
| <div style="border: 1px solid black; padding: 2px; margin-bottom: 5px;">DIVISION OF ENGINEERING</div> <div style="border: 1px solid black; padding: 5px;"> <p style="margin: 0;">DEPARTMENT OF PUBLIC WORKS</p> <p style="margin: 0;">CITY AND COUNTY OF HONOLULU</p> <p style="margin: 0; font-size: 1.2em;">BUREAU OF PLANS</p> <p style="margin: 0; font-size: 1.5em;">KANEIHOE BAY DRIVE</p> <p style="margin: 0; font-size: 1.5em;">REALIGNMENT</p> <p style="margin: 0;">FROM STA. 4+50 ~ 39+00</p> <p style="margin: 0; font-size: 1.5em;">CULVERT DETAIL</p> </div> |                                                                                                                                                        |                                                                                                                                                      |
| <p>ENGINEER <i>G.K.D.</i></p> <p>DRAFTSMAN <i>G.K.D.</i></p> <p>SCALE <i>1 in. = 4 ft.</i></p> <p>APPROVED <i>B. F. Rush</i></p> <p>CITY &amp; COUNTY ENGINEER</p>                                                                                                                                                                                                                                                                                                                                                                                                          | <p>DATE <i>Aug. 3, 1936</i></p> <p>CHECKED BY</p> <p>TRACED <i>W. J.</i></p> <p>APPROVED <i>R. S. Mowry</i></p> <p>BUREAU ENGINEER</p>                 |                                                                                                                                                      |
| <p>W. S. <span style="border: 1px solid black; display: inline-block; width: 100px; height: 1.2em; vertical-align: middle;"></span></p> <p>CH. SEC.</p>                                                                                                                                                                                                                                                                                                                                                                                                                     | <p>PROFILE <span style="border: 1px solid black; display: inline-block; width: 100px; height: 1.2em; vertical-align: middle;"></span></p> <p>P. R.</p> | <p>C. B. <span style="border: 1px solid black; display: inline-block; width: 100px; height: 1.2em; vertical-align: middle;"></span></p> <p>S. E.</p> |