
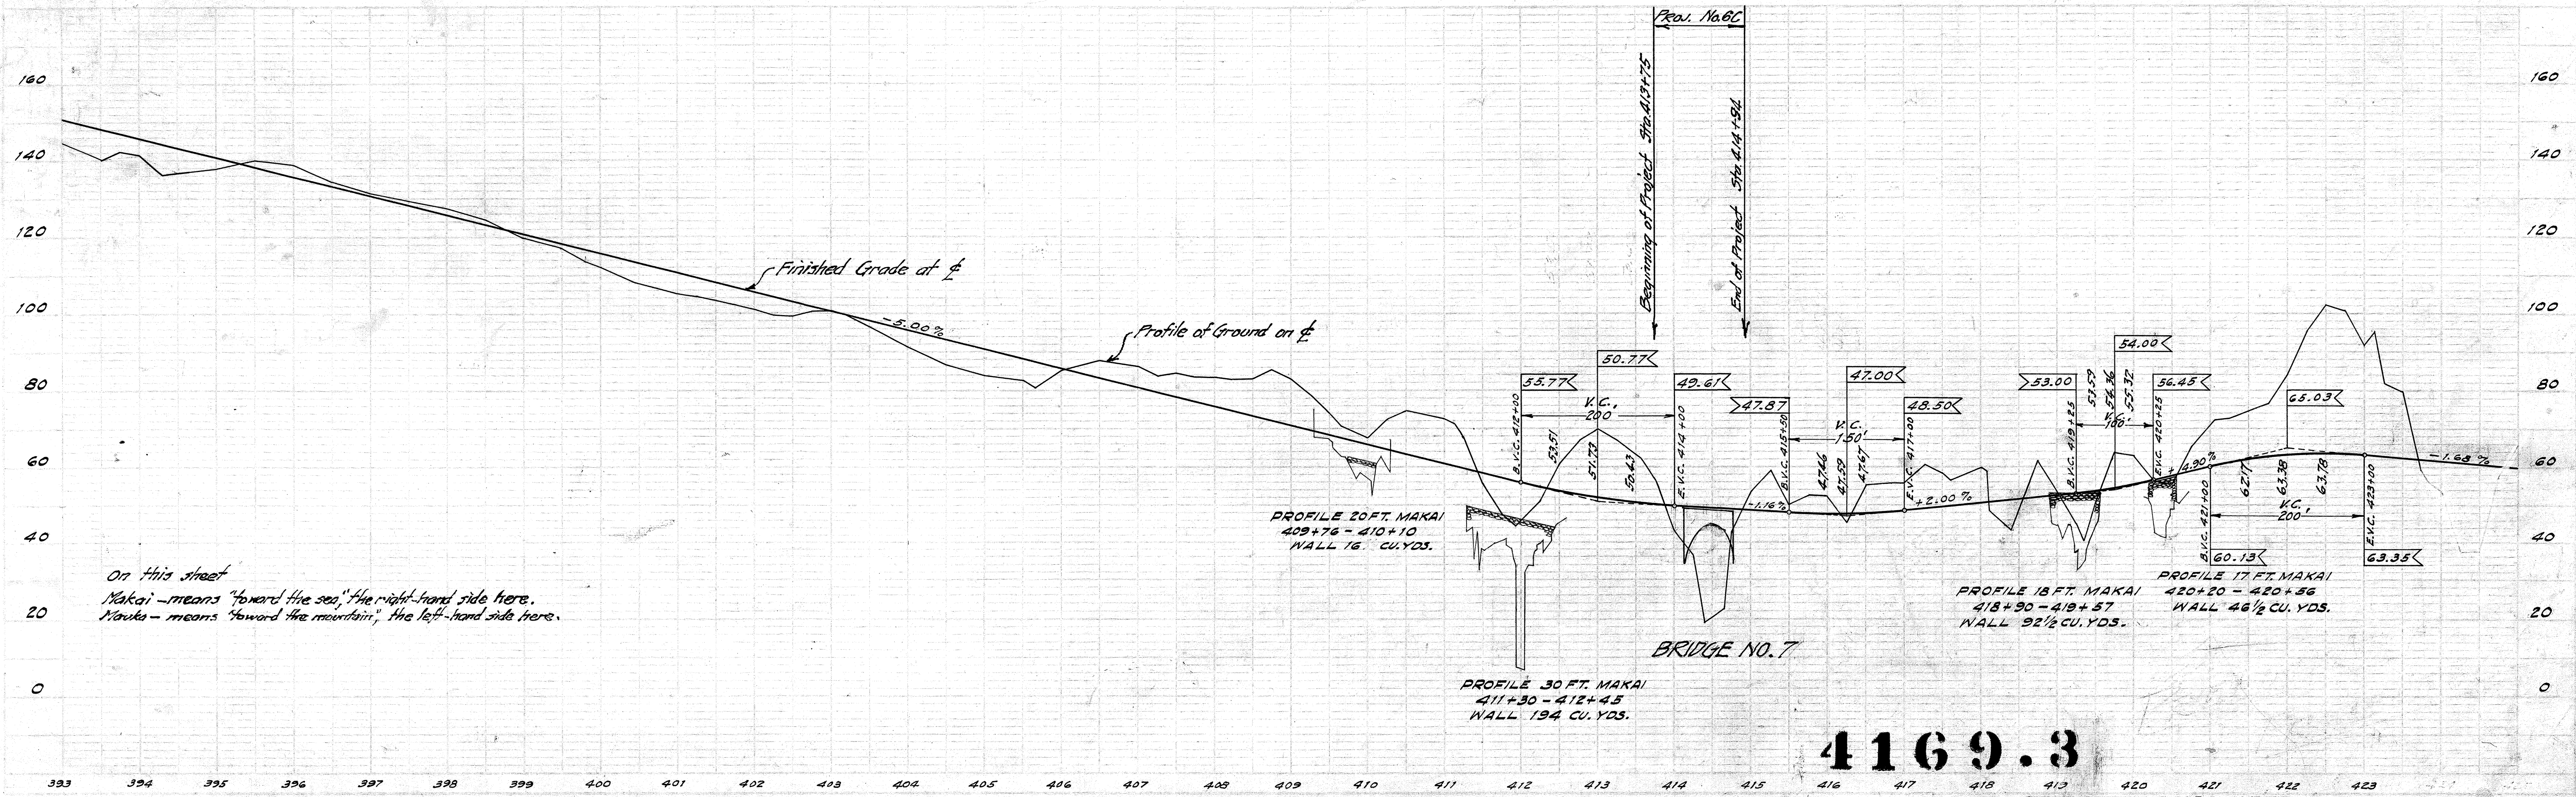


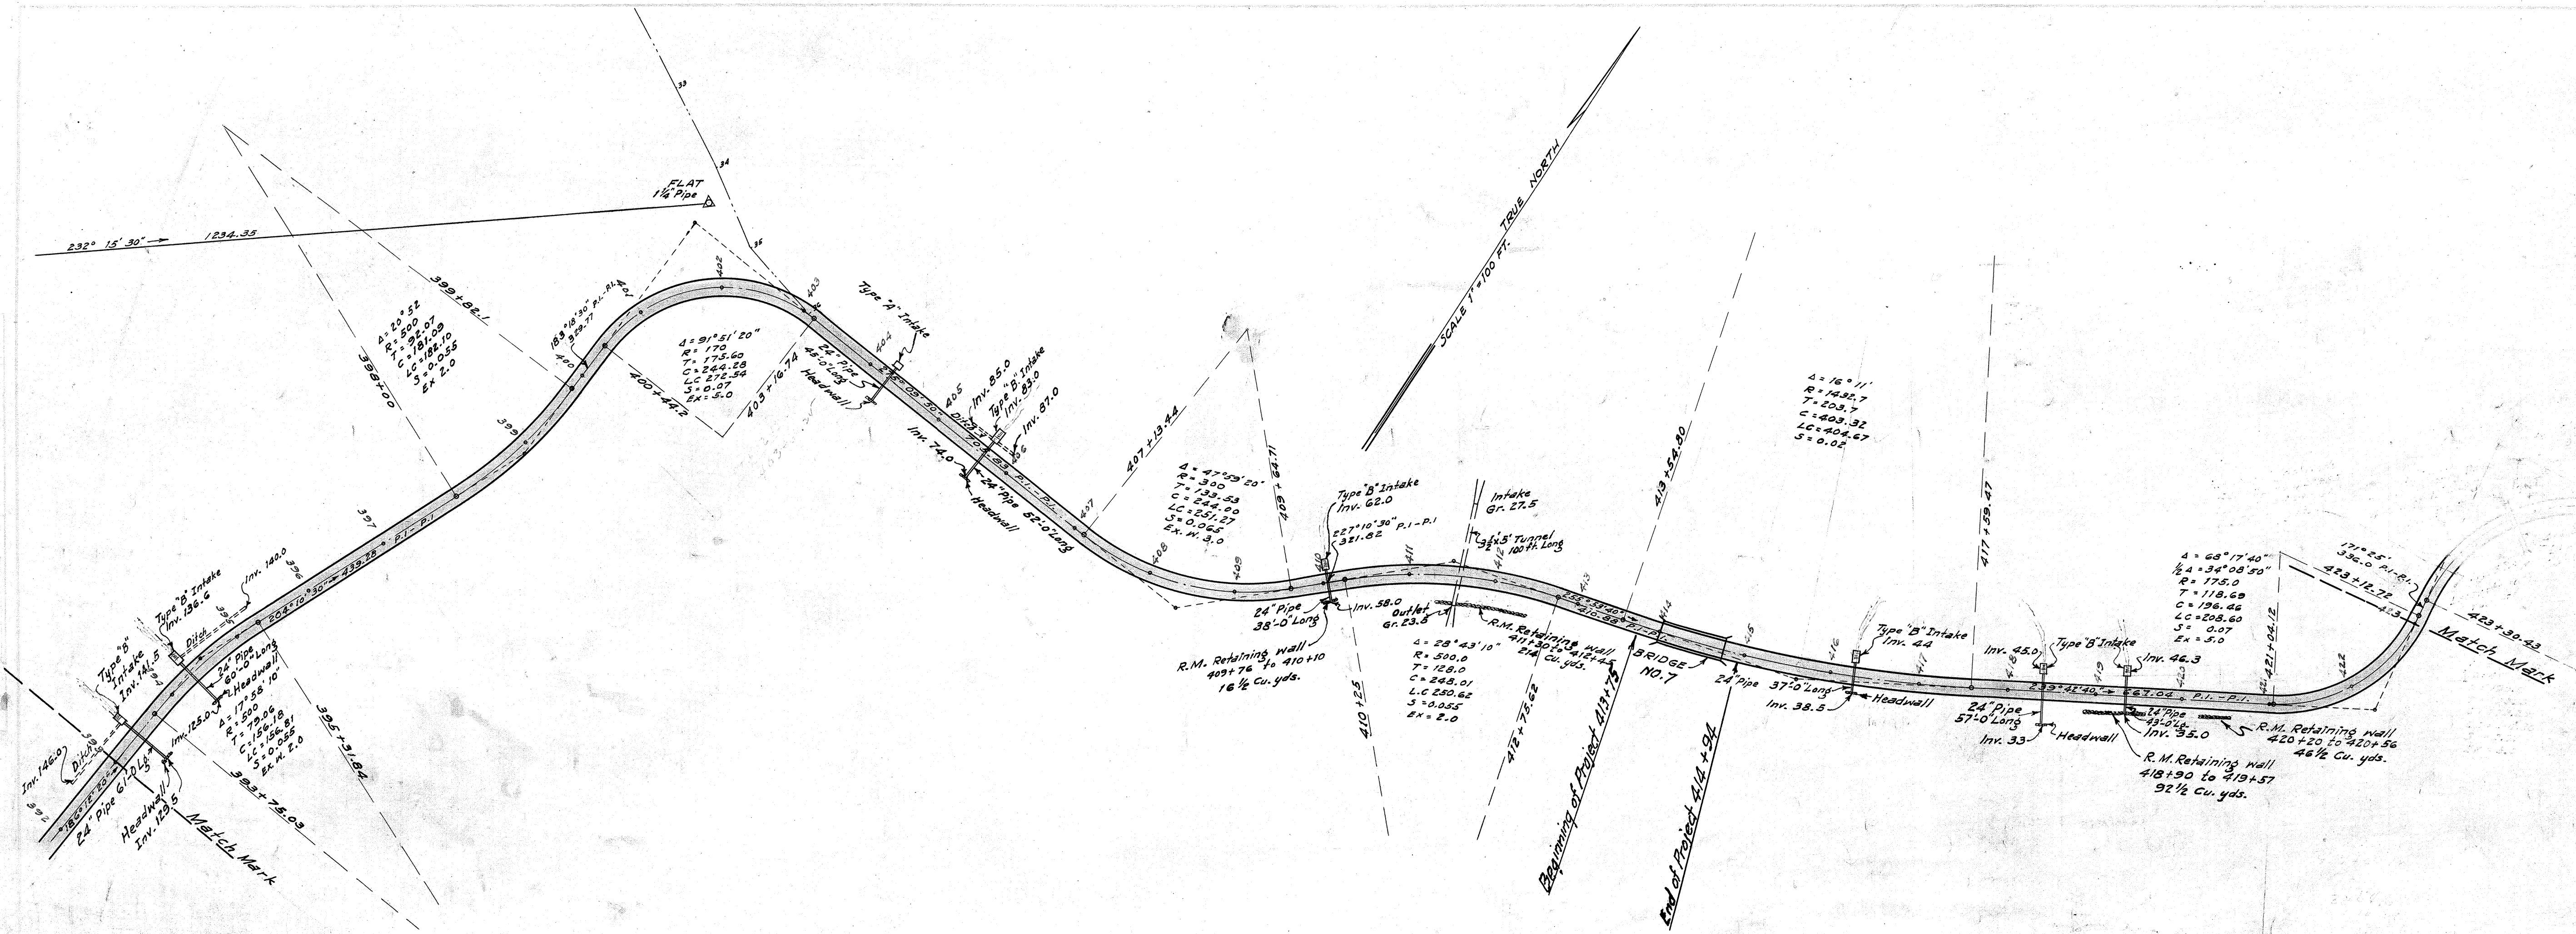

4169.3