

INDEX TO DRAWING	
SHEET No	DESCRIPTIONS
1	TITLE SHEET
2	TYPICAL ROAD SECTIONS, DETAILS & ROAD CROSS-SECTIONS
3	PLAN & PROFILE
4 & 5	BRIDGE

TERRITORY OF HAWAII

TERRITORIAL HIGHWAY DEPARTMENT

HONOLULU T.H.

PLANS OF

IHIHILAUAKEA BRIDGE

FEDERAL AID PROJECT NO. 6 C

BRIDGE NO. 7

ON KALANIANA'OLE HIGHWAY

DISTRICT OF HONOLULU

OAHU

SCALE



PLAN-----1 INCH=100 FEET

PROFILE-----HOR. 1 INCH=100 FEET

VER. 1 INCH=20 FEET

CONVENTIONAL SIGNS

Edge of existing Road	-----
Existing Fence	-----
Boundary Line (Not fenced)	-----
Existing Stone Wall	-----
Railroad	-----
Center Line	-----
Future Pavement	=====
Cement Rubble Masonry Retaining Walls (Usually marked R.M. Retaining Wall.)	=====
Bridge	=====

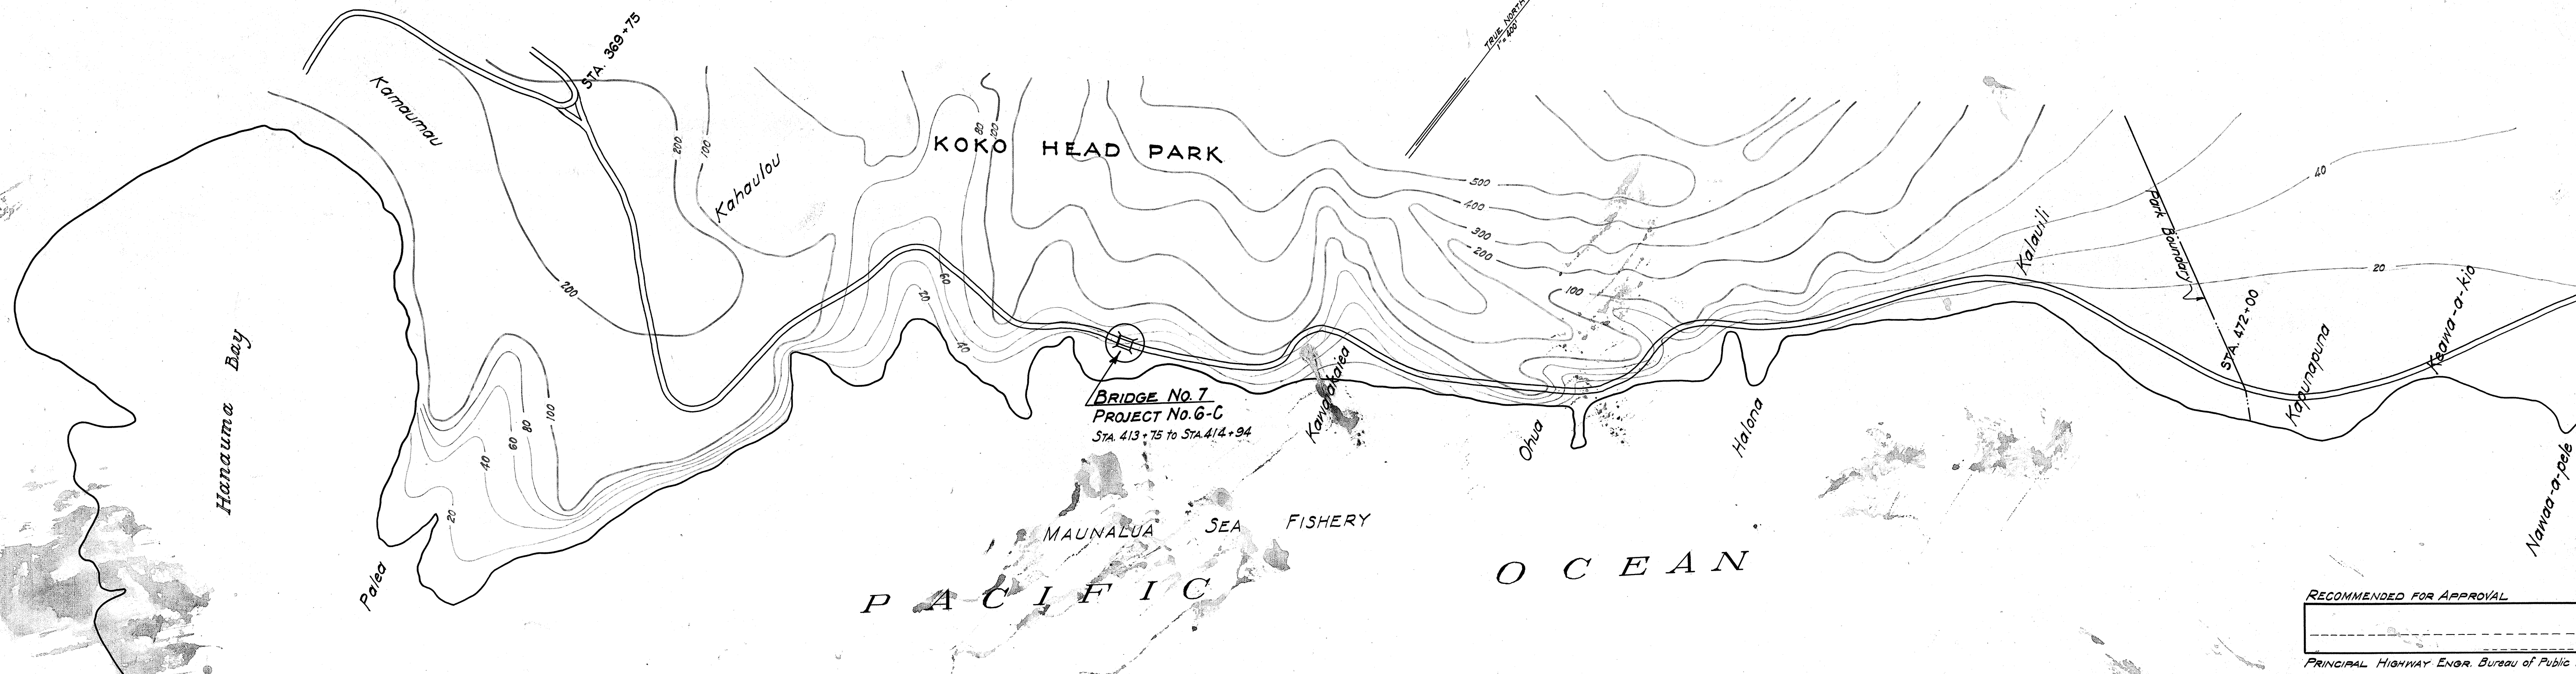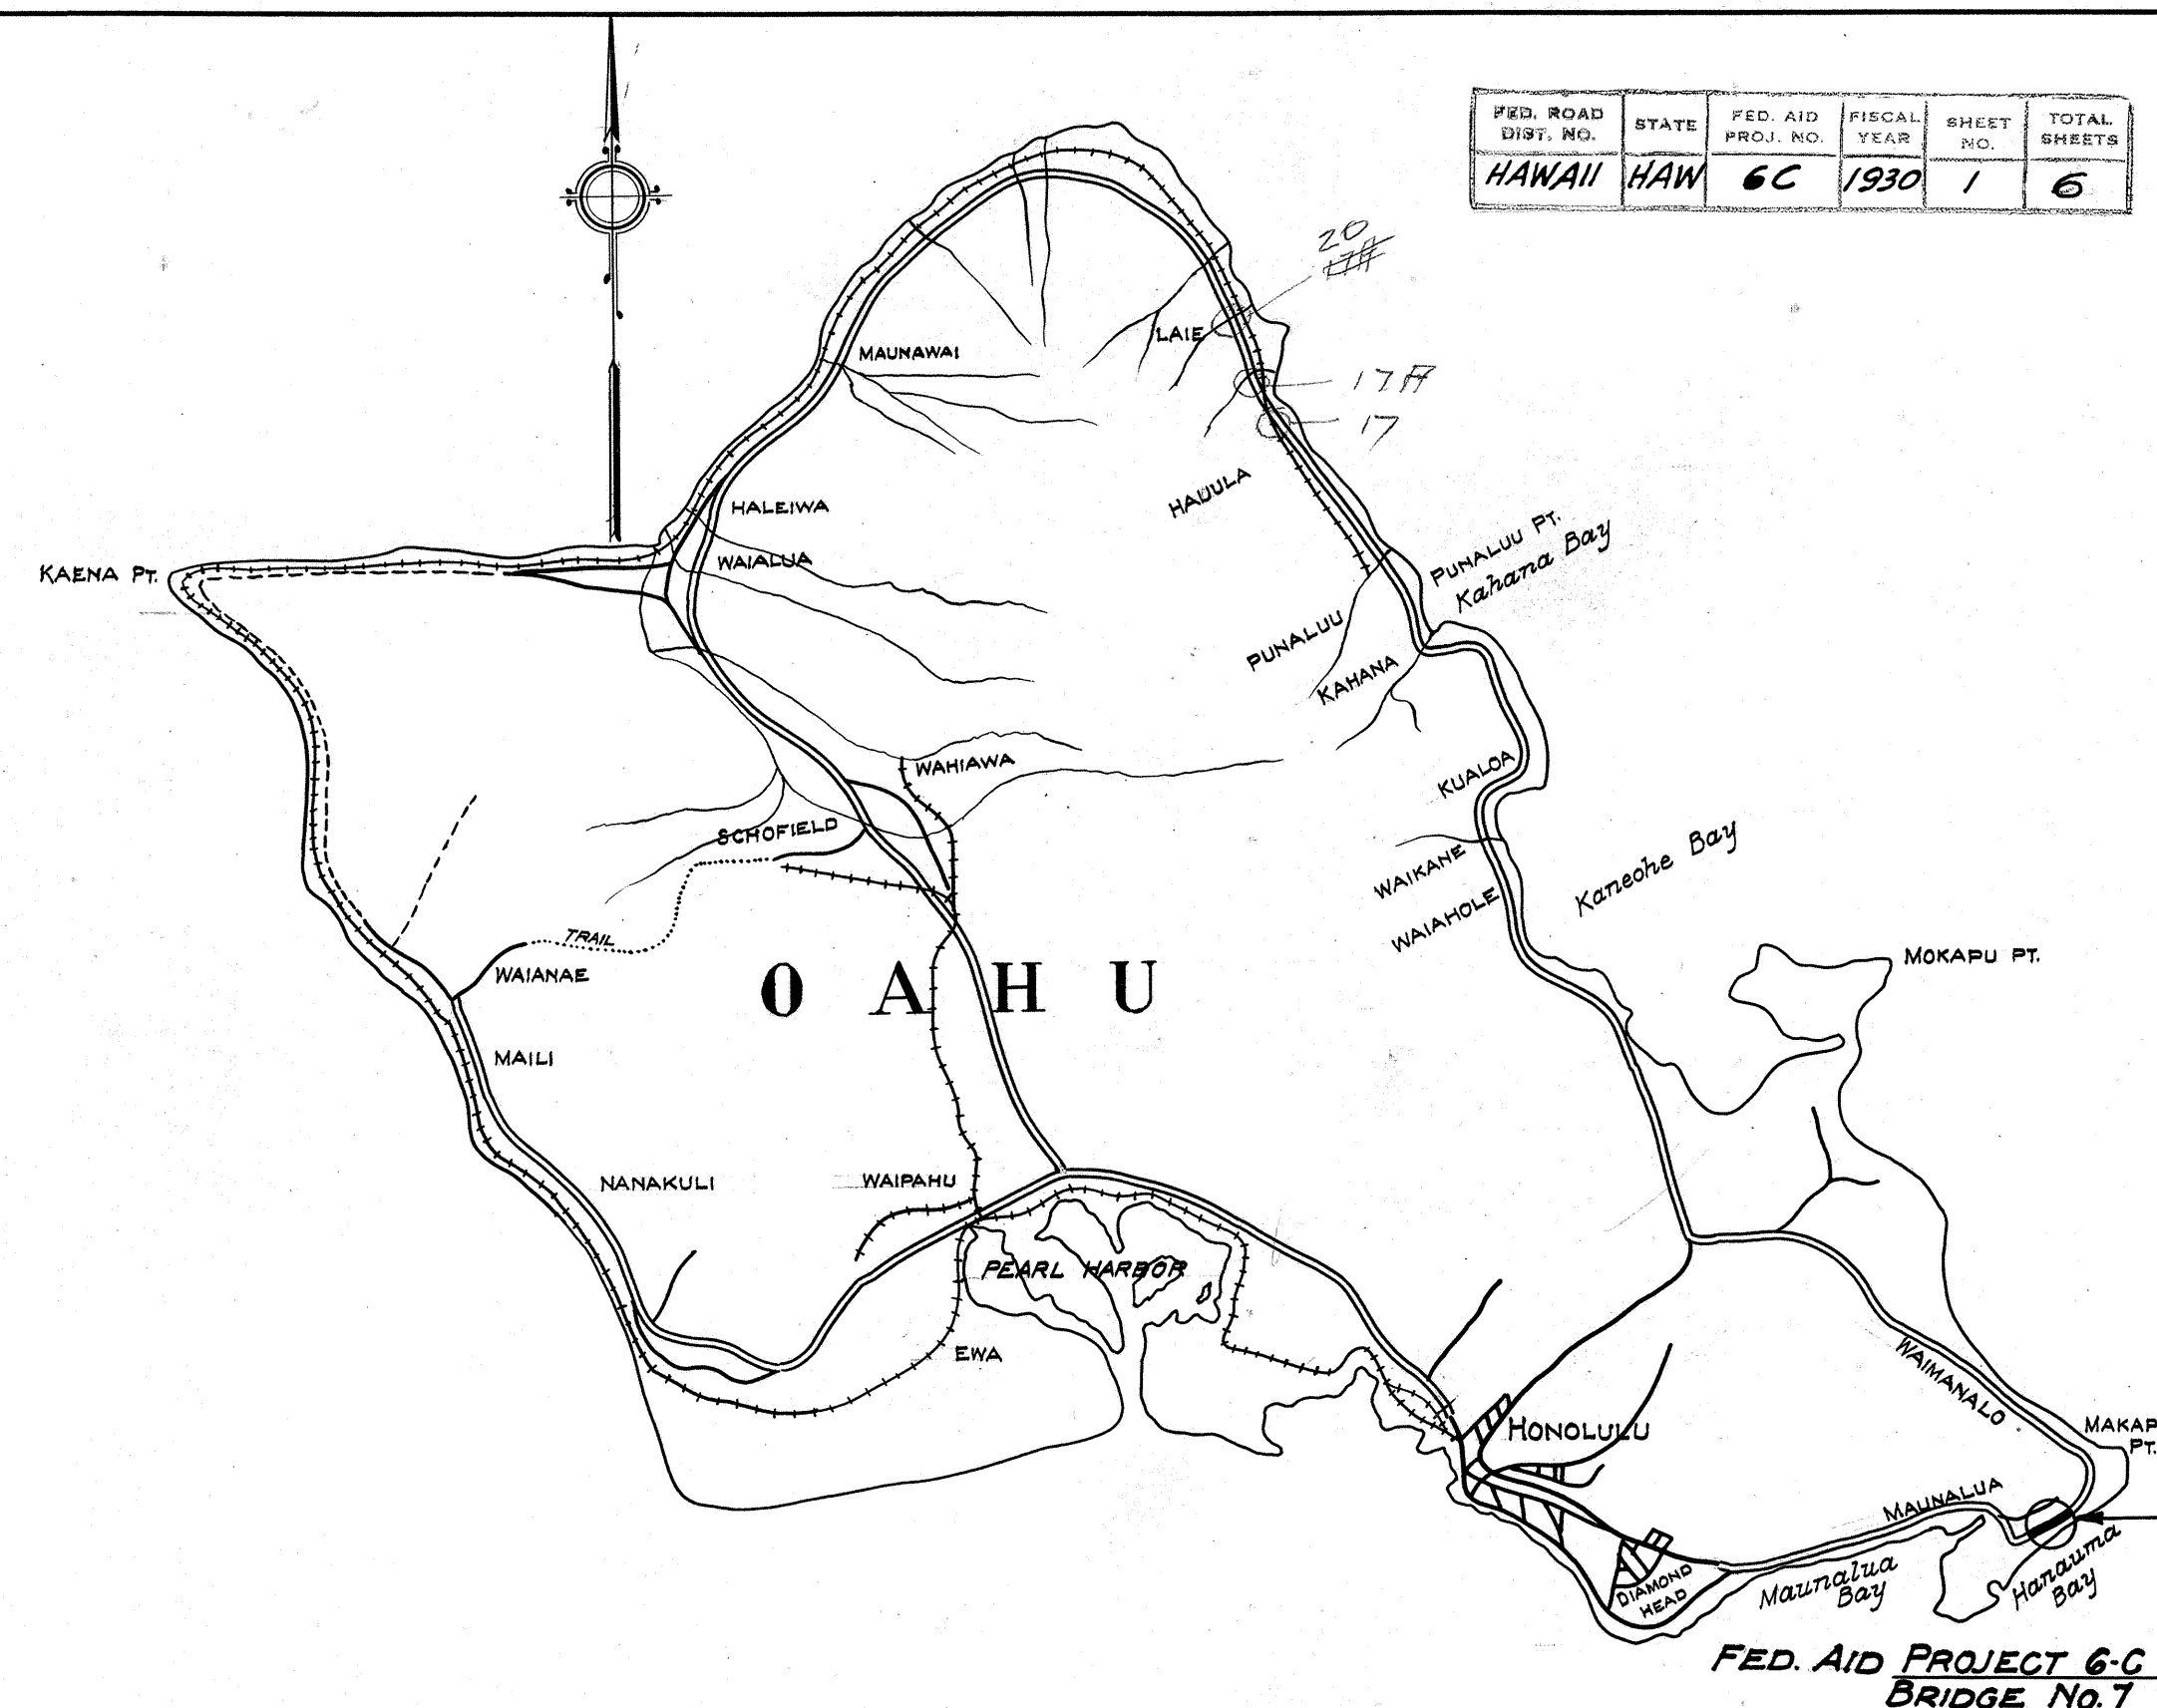

LAYOUT OF PROJECT

SCALE 1 INCH = 400 FEET

GROSS AND NET LENGTH 0.0225 MILES

APPROVED

[Signature]

Aug 2nd 1930

CHIEF ENGR. DEPT. OF PUBLIC WORKS

City and County of Honolulu

APPROVED

[Signature]

July 31, 1930

TERRITORIAL HIGHWAY ENGINEER

RECOMMENDED FOR APPROVAL

1930

PRINCIPAL HIGHWAY ENGR. Bureau of Public Roads

RECOMMENDED FOR APPROVAL

1930

CHIEF ENGR. Bureau of Public Roads

APPROVED

1930

DIRECTOR, Bureau of Public Roads

4169.1