



FED. ROAD DIST. NO.	STATE	FED. AID PROJ. NO.	FISCAL YEAR	SHEET NO.	TOTAL SHEETS
HAWAII	HAW	6C	1930	2	6

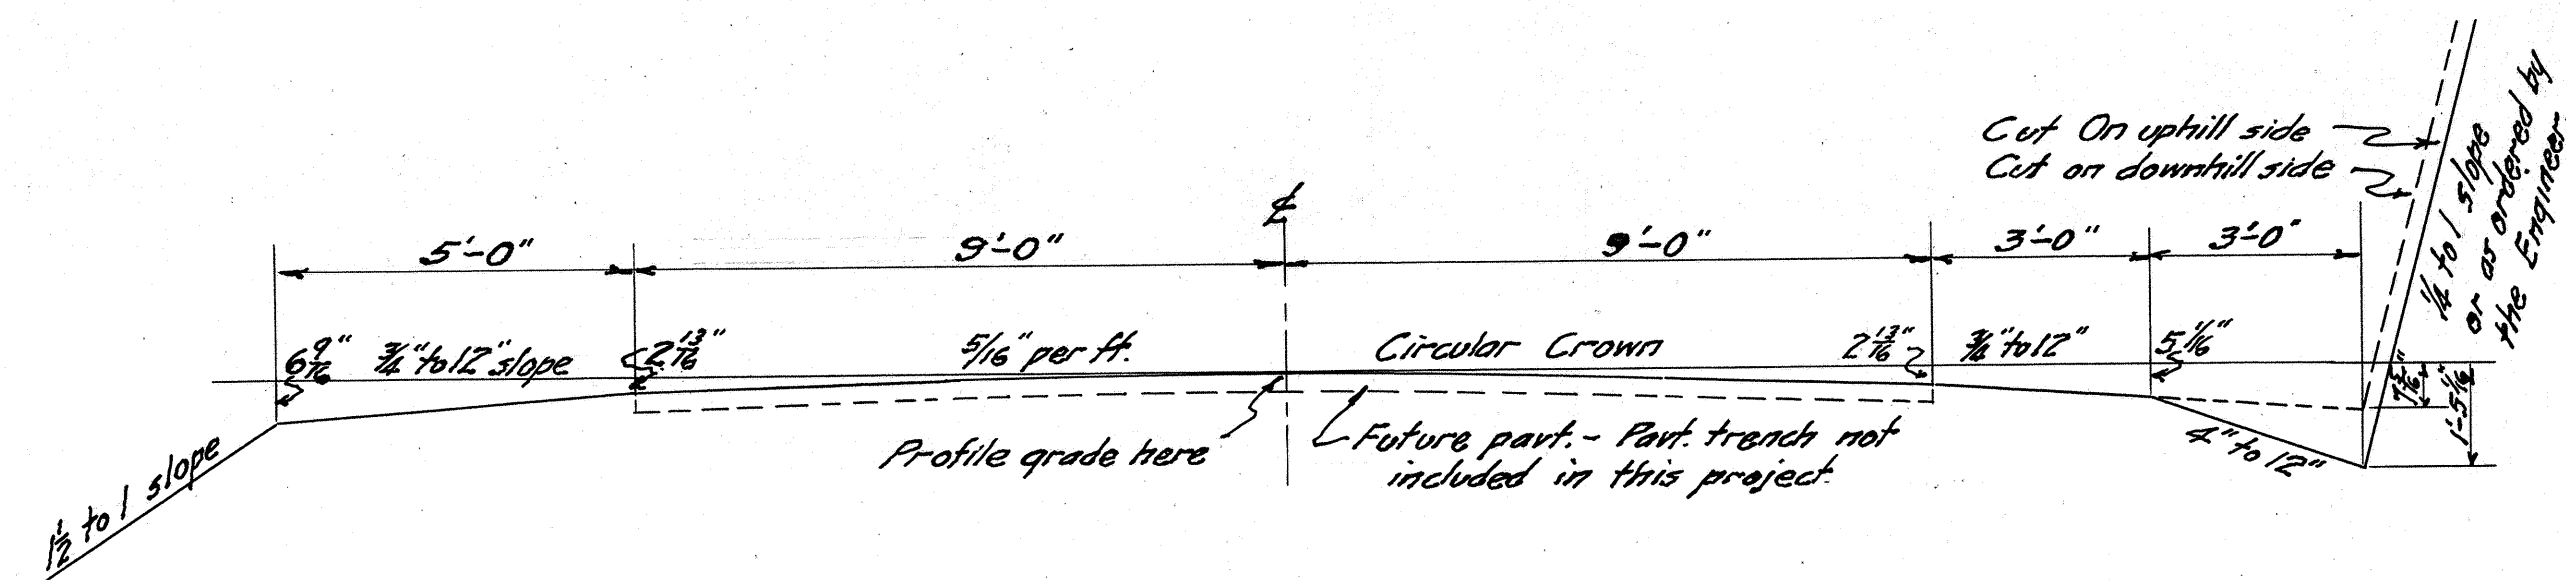


SECTION OF ROAD APPROACH ON TANGENT

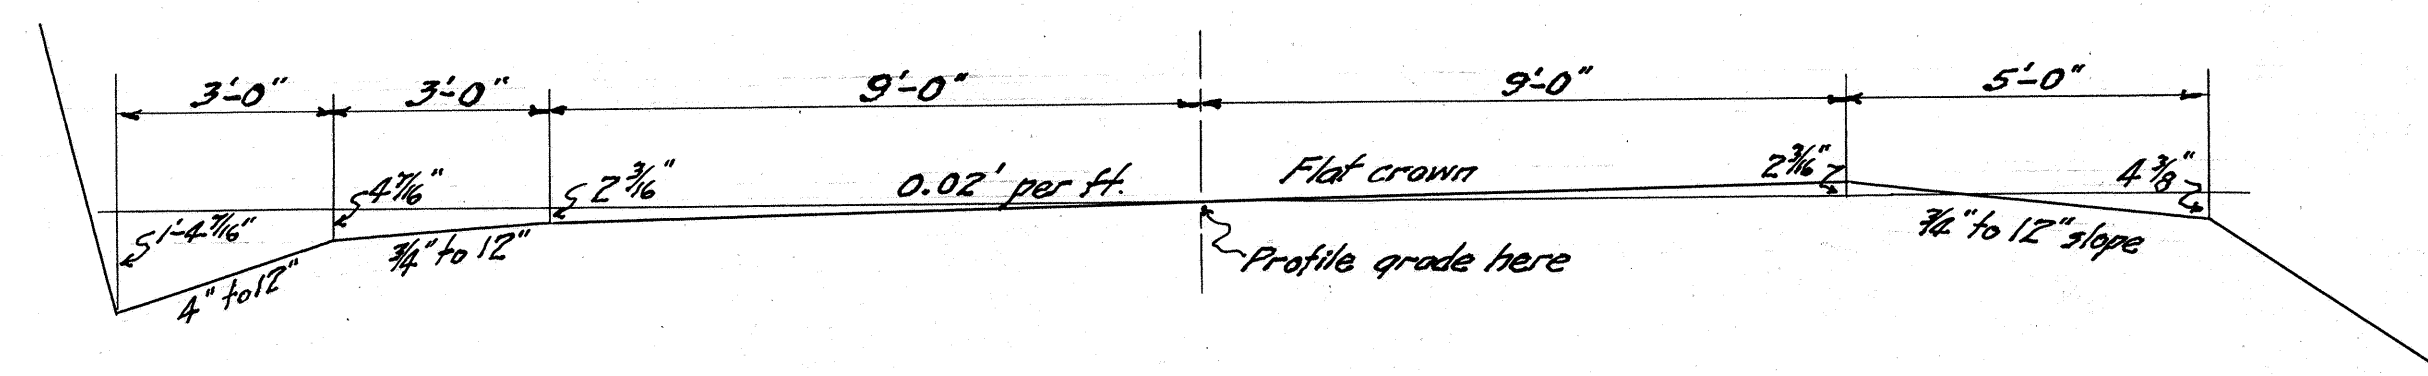








SECTION OF ROAD APPROACH ON CURVE AT BRIDGE

SCALE $\frac{3}{8}$ " = 1'-0"

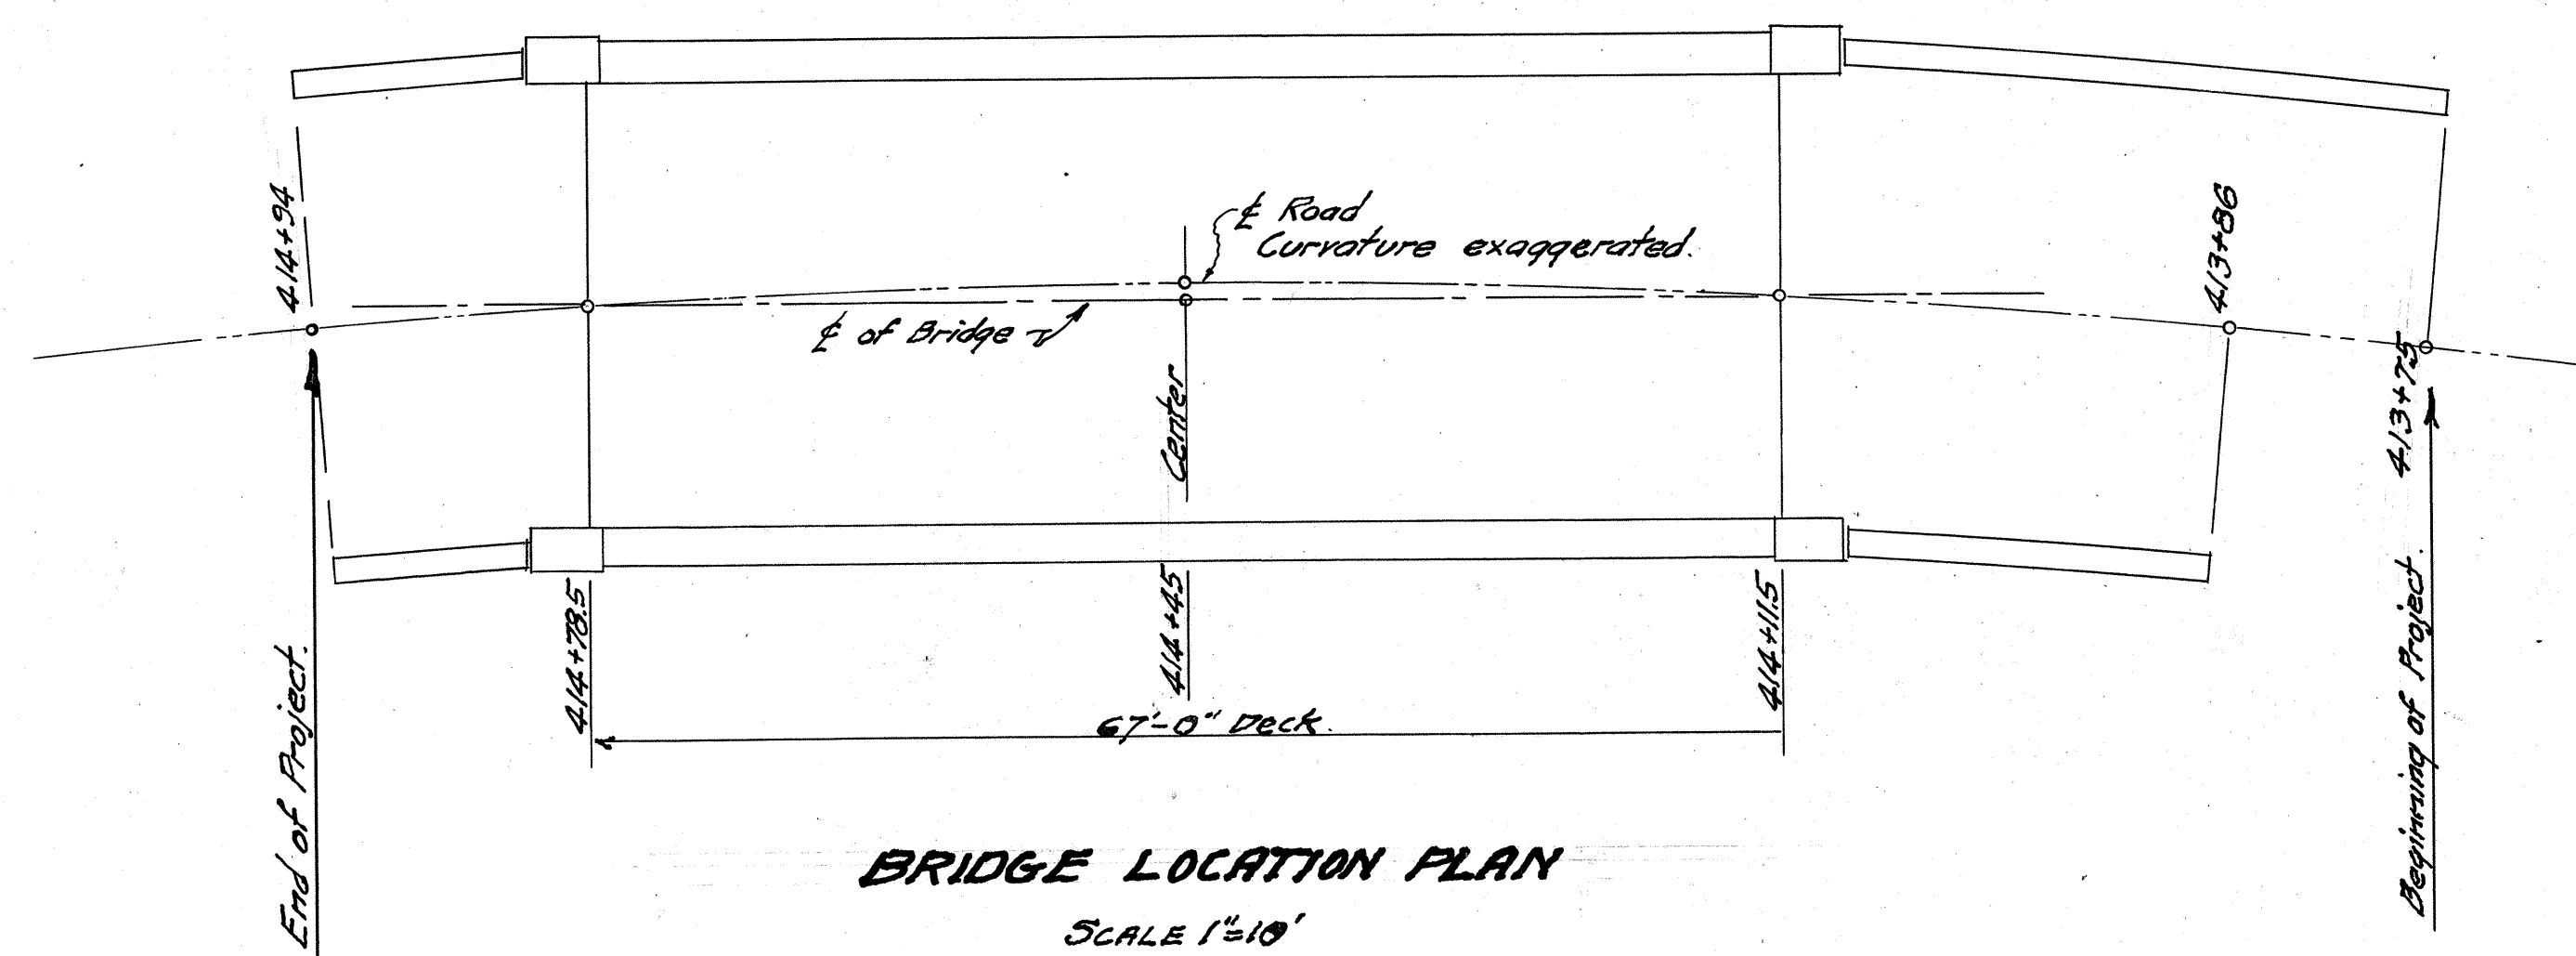

BRIDGE LOCATION PLAN

SCALE 1" = 10'

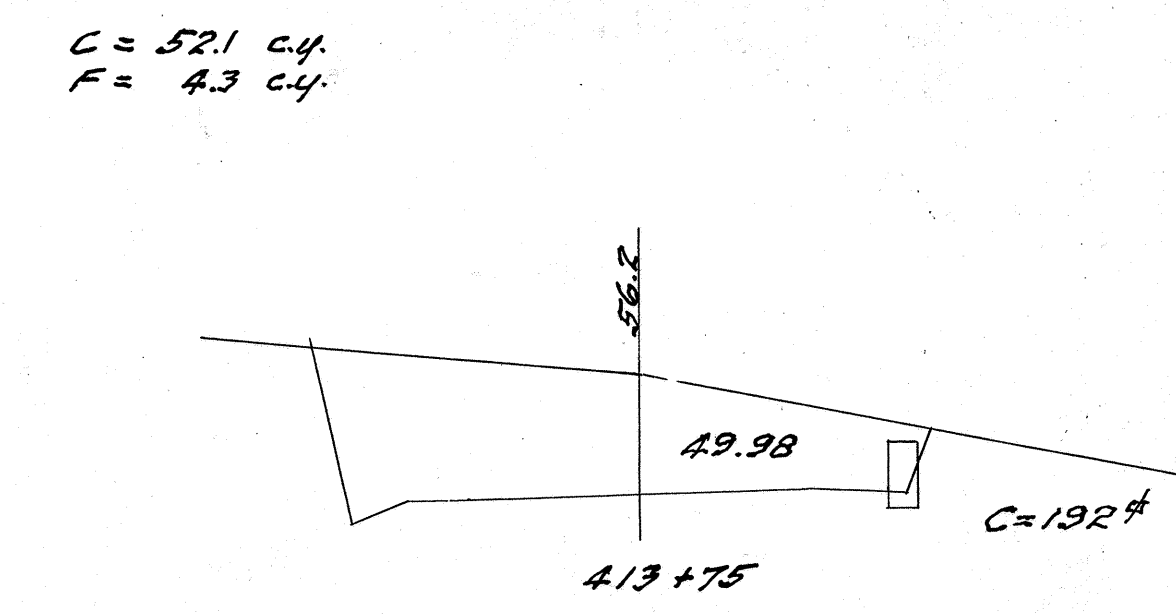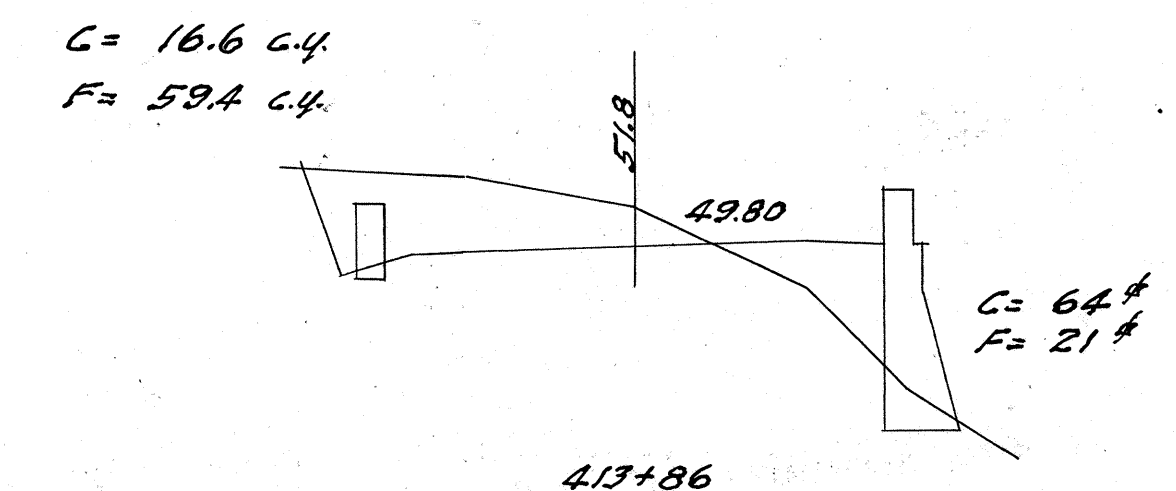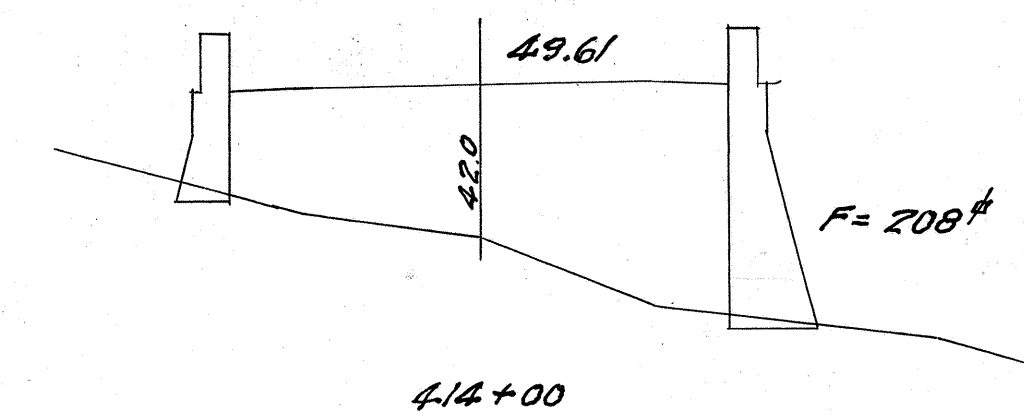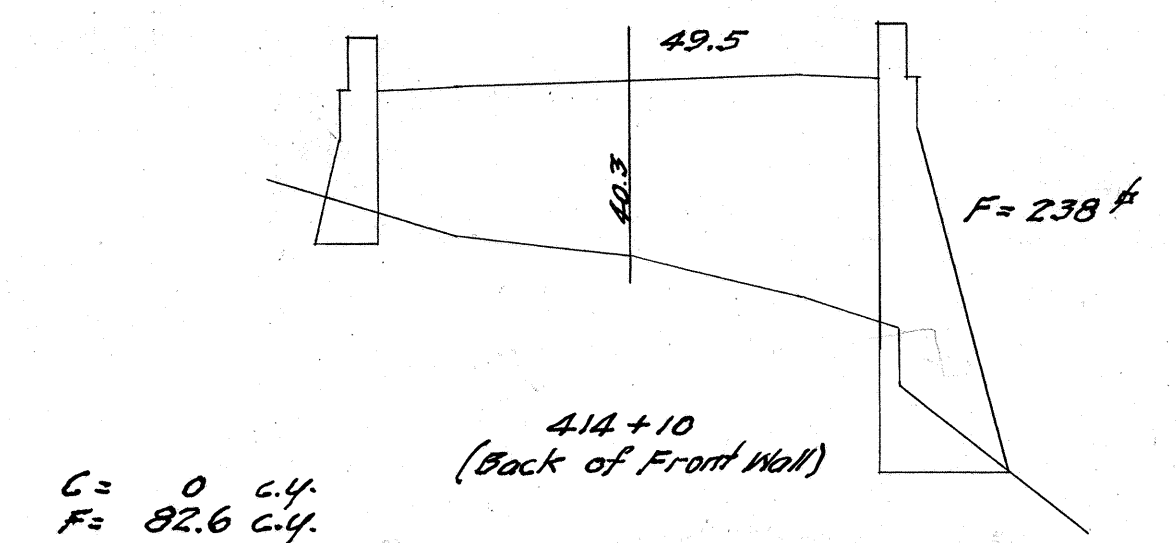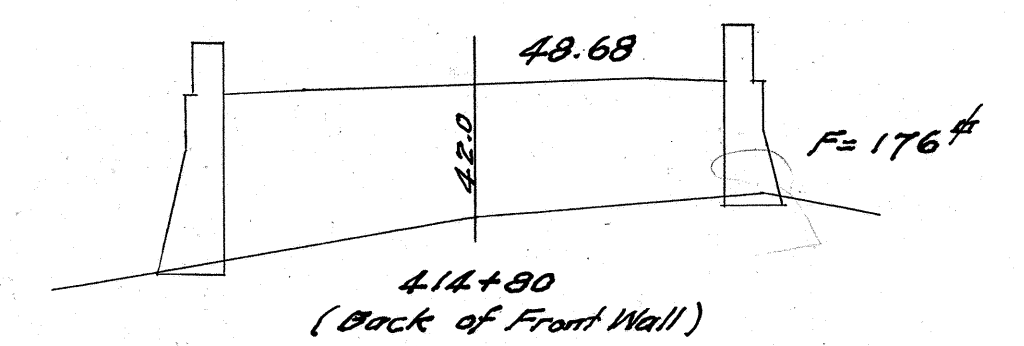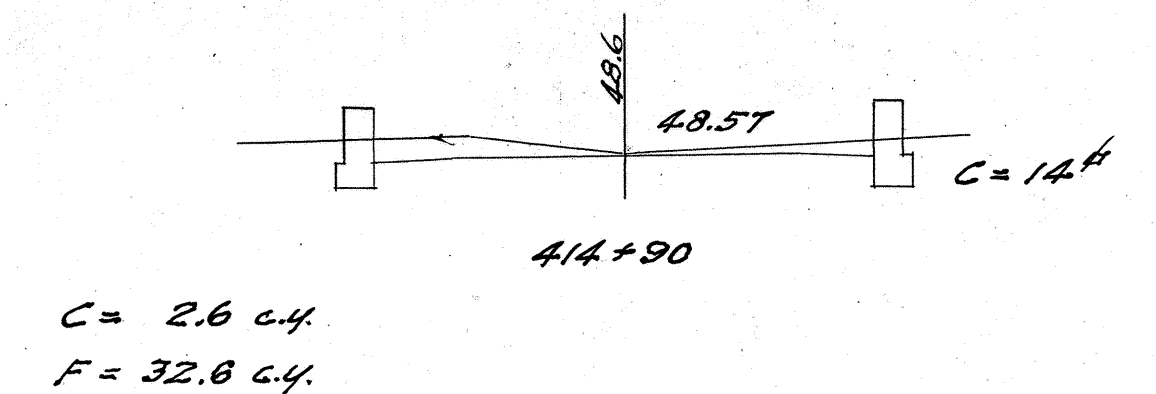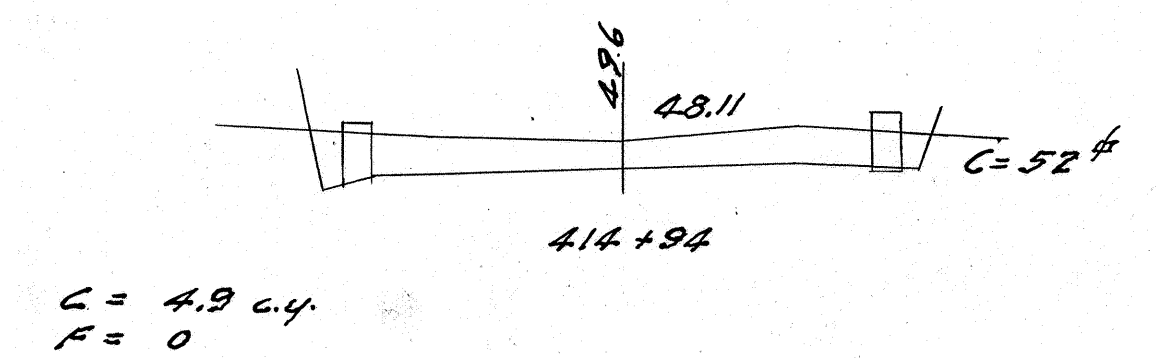

ROAD APPROACH CROSS SECTIONS

SCALE 1" = 10'

4169.2