
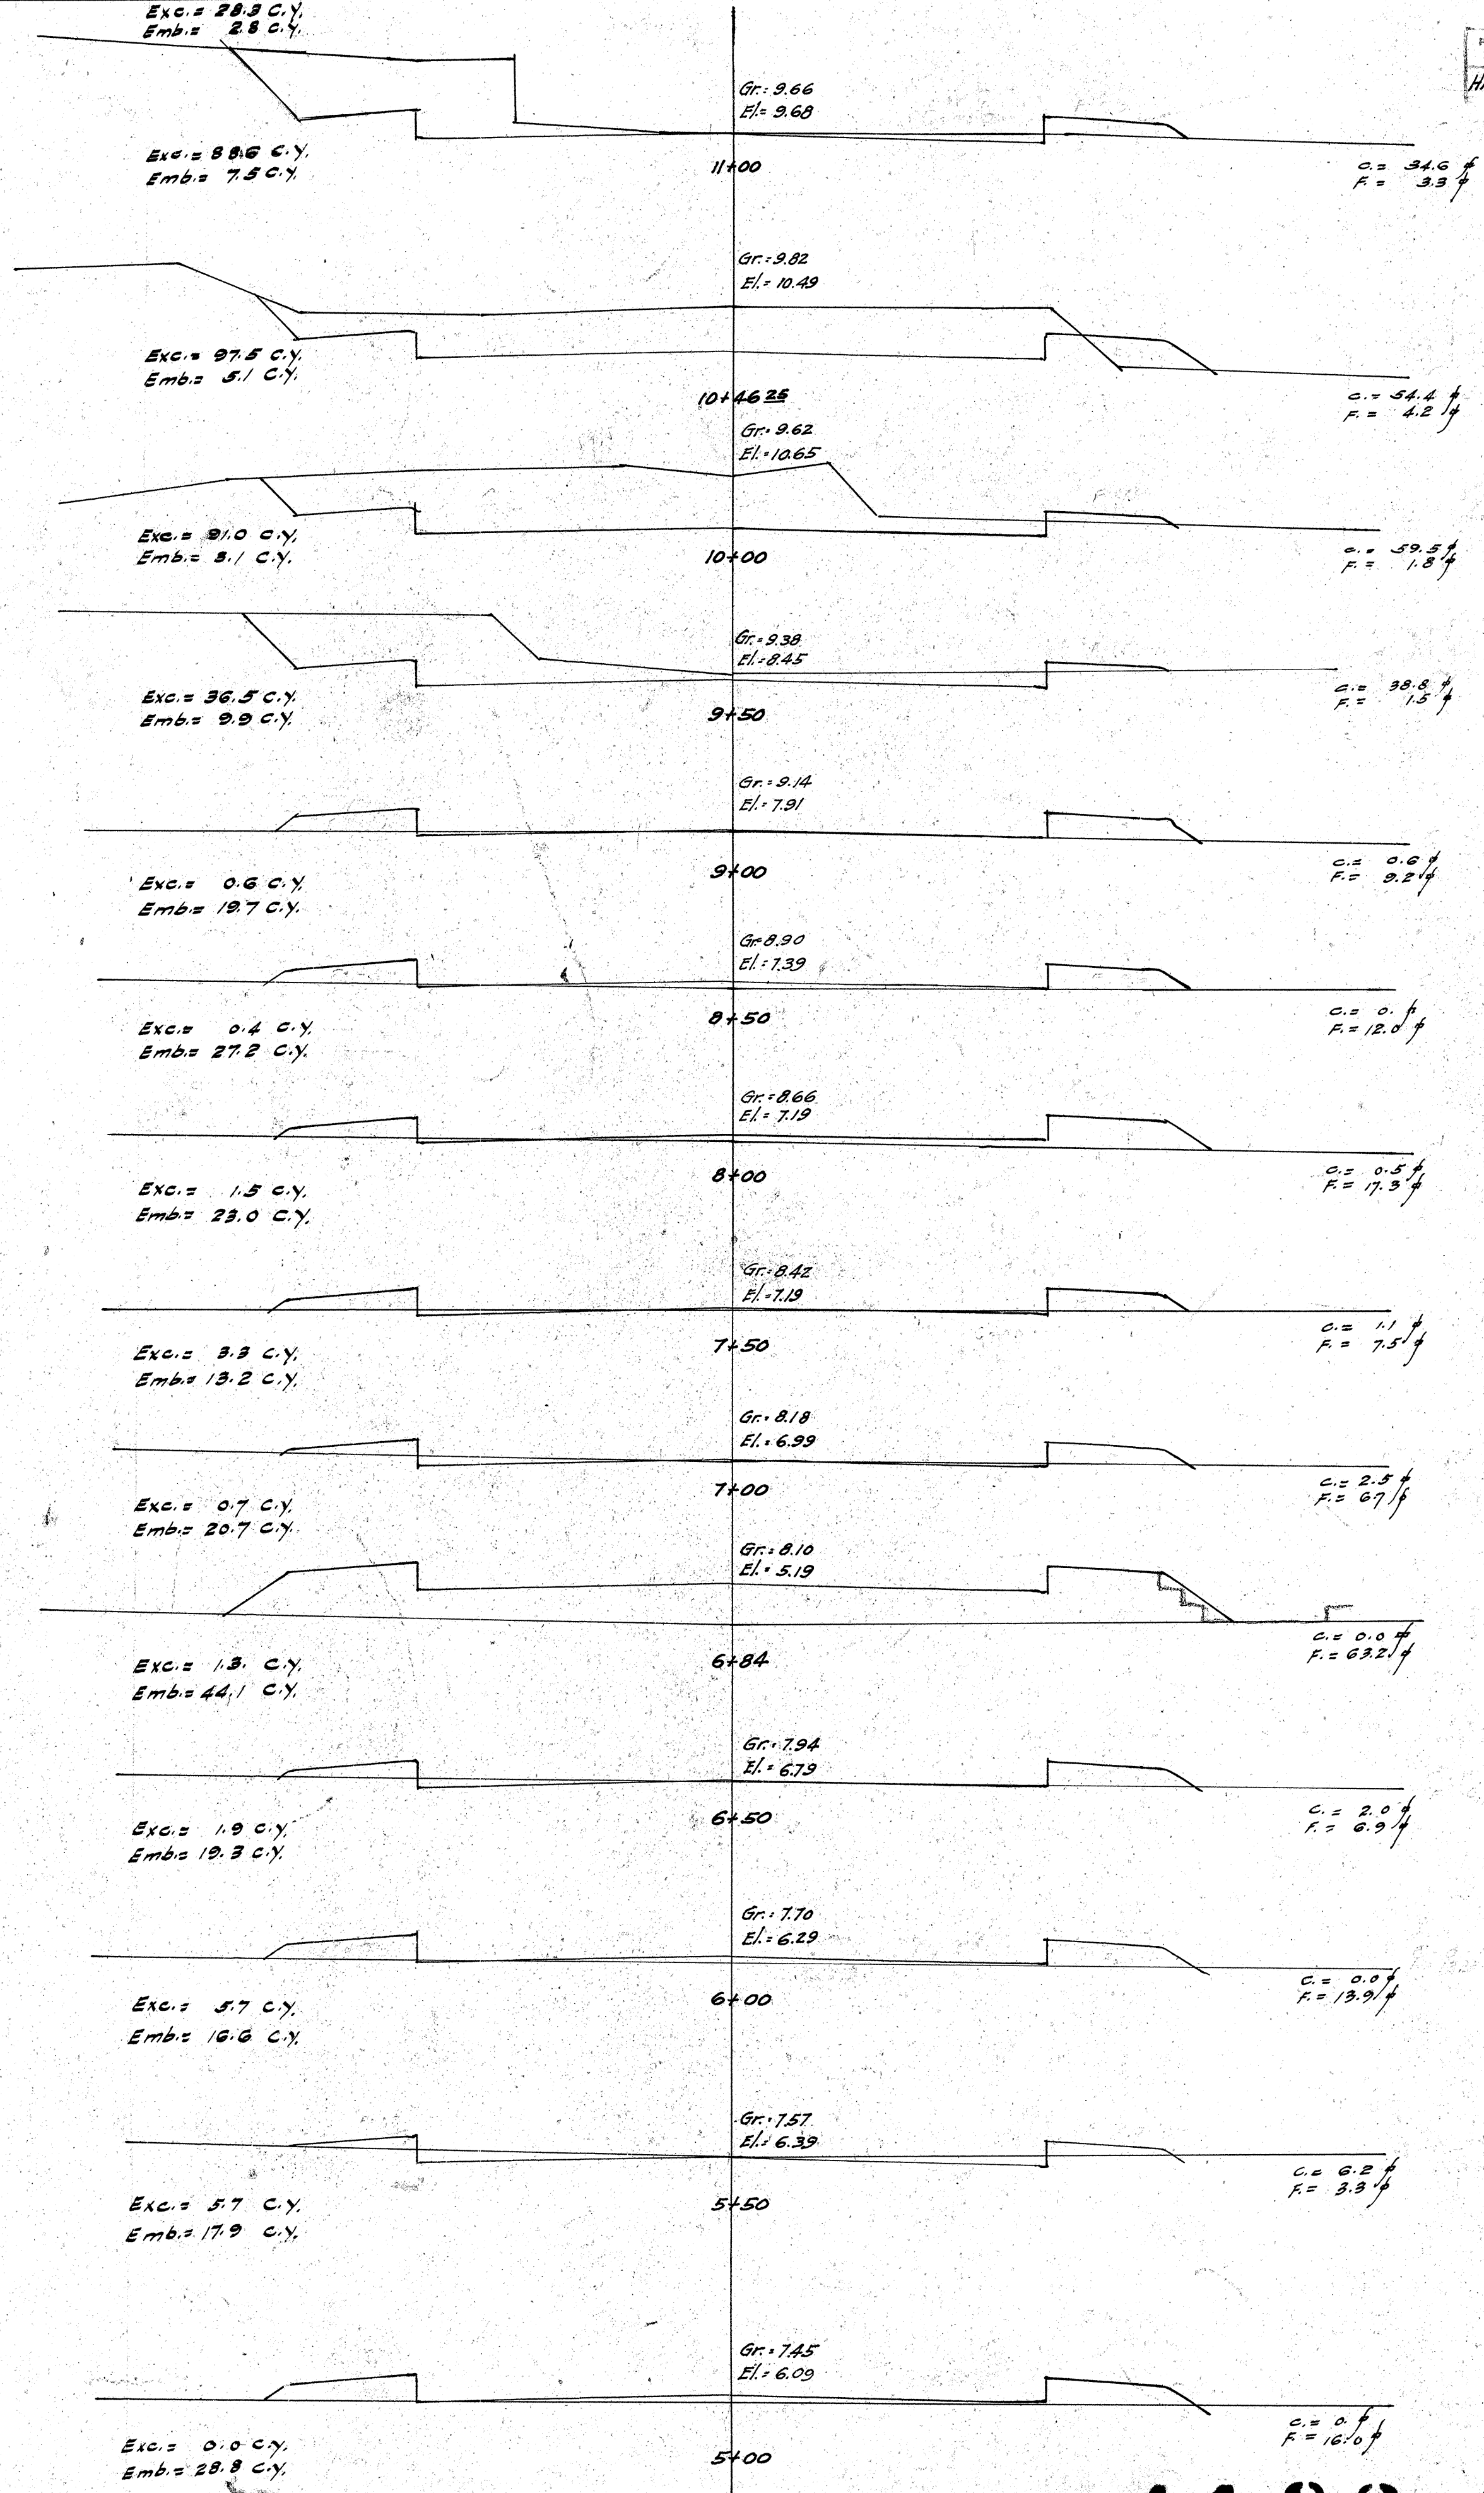


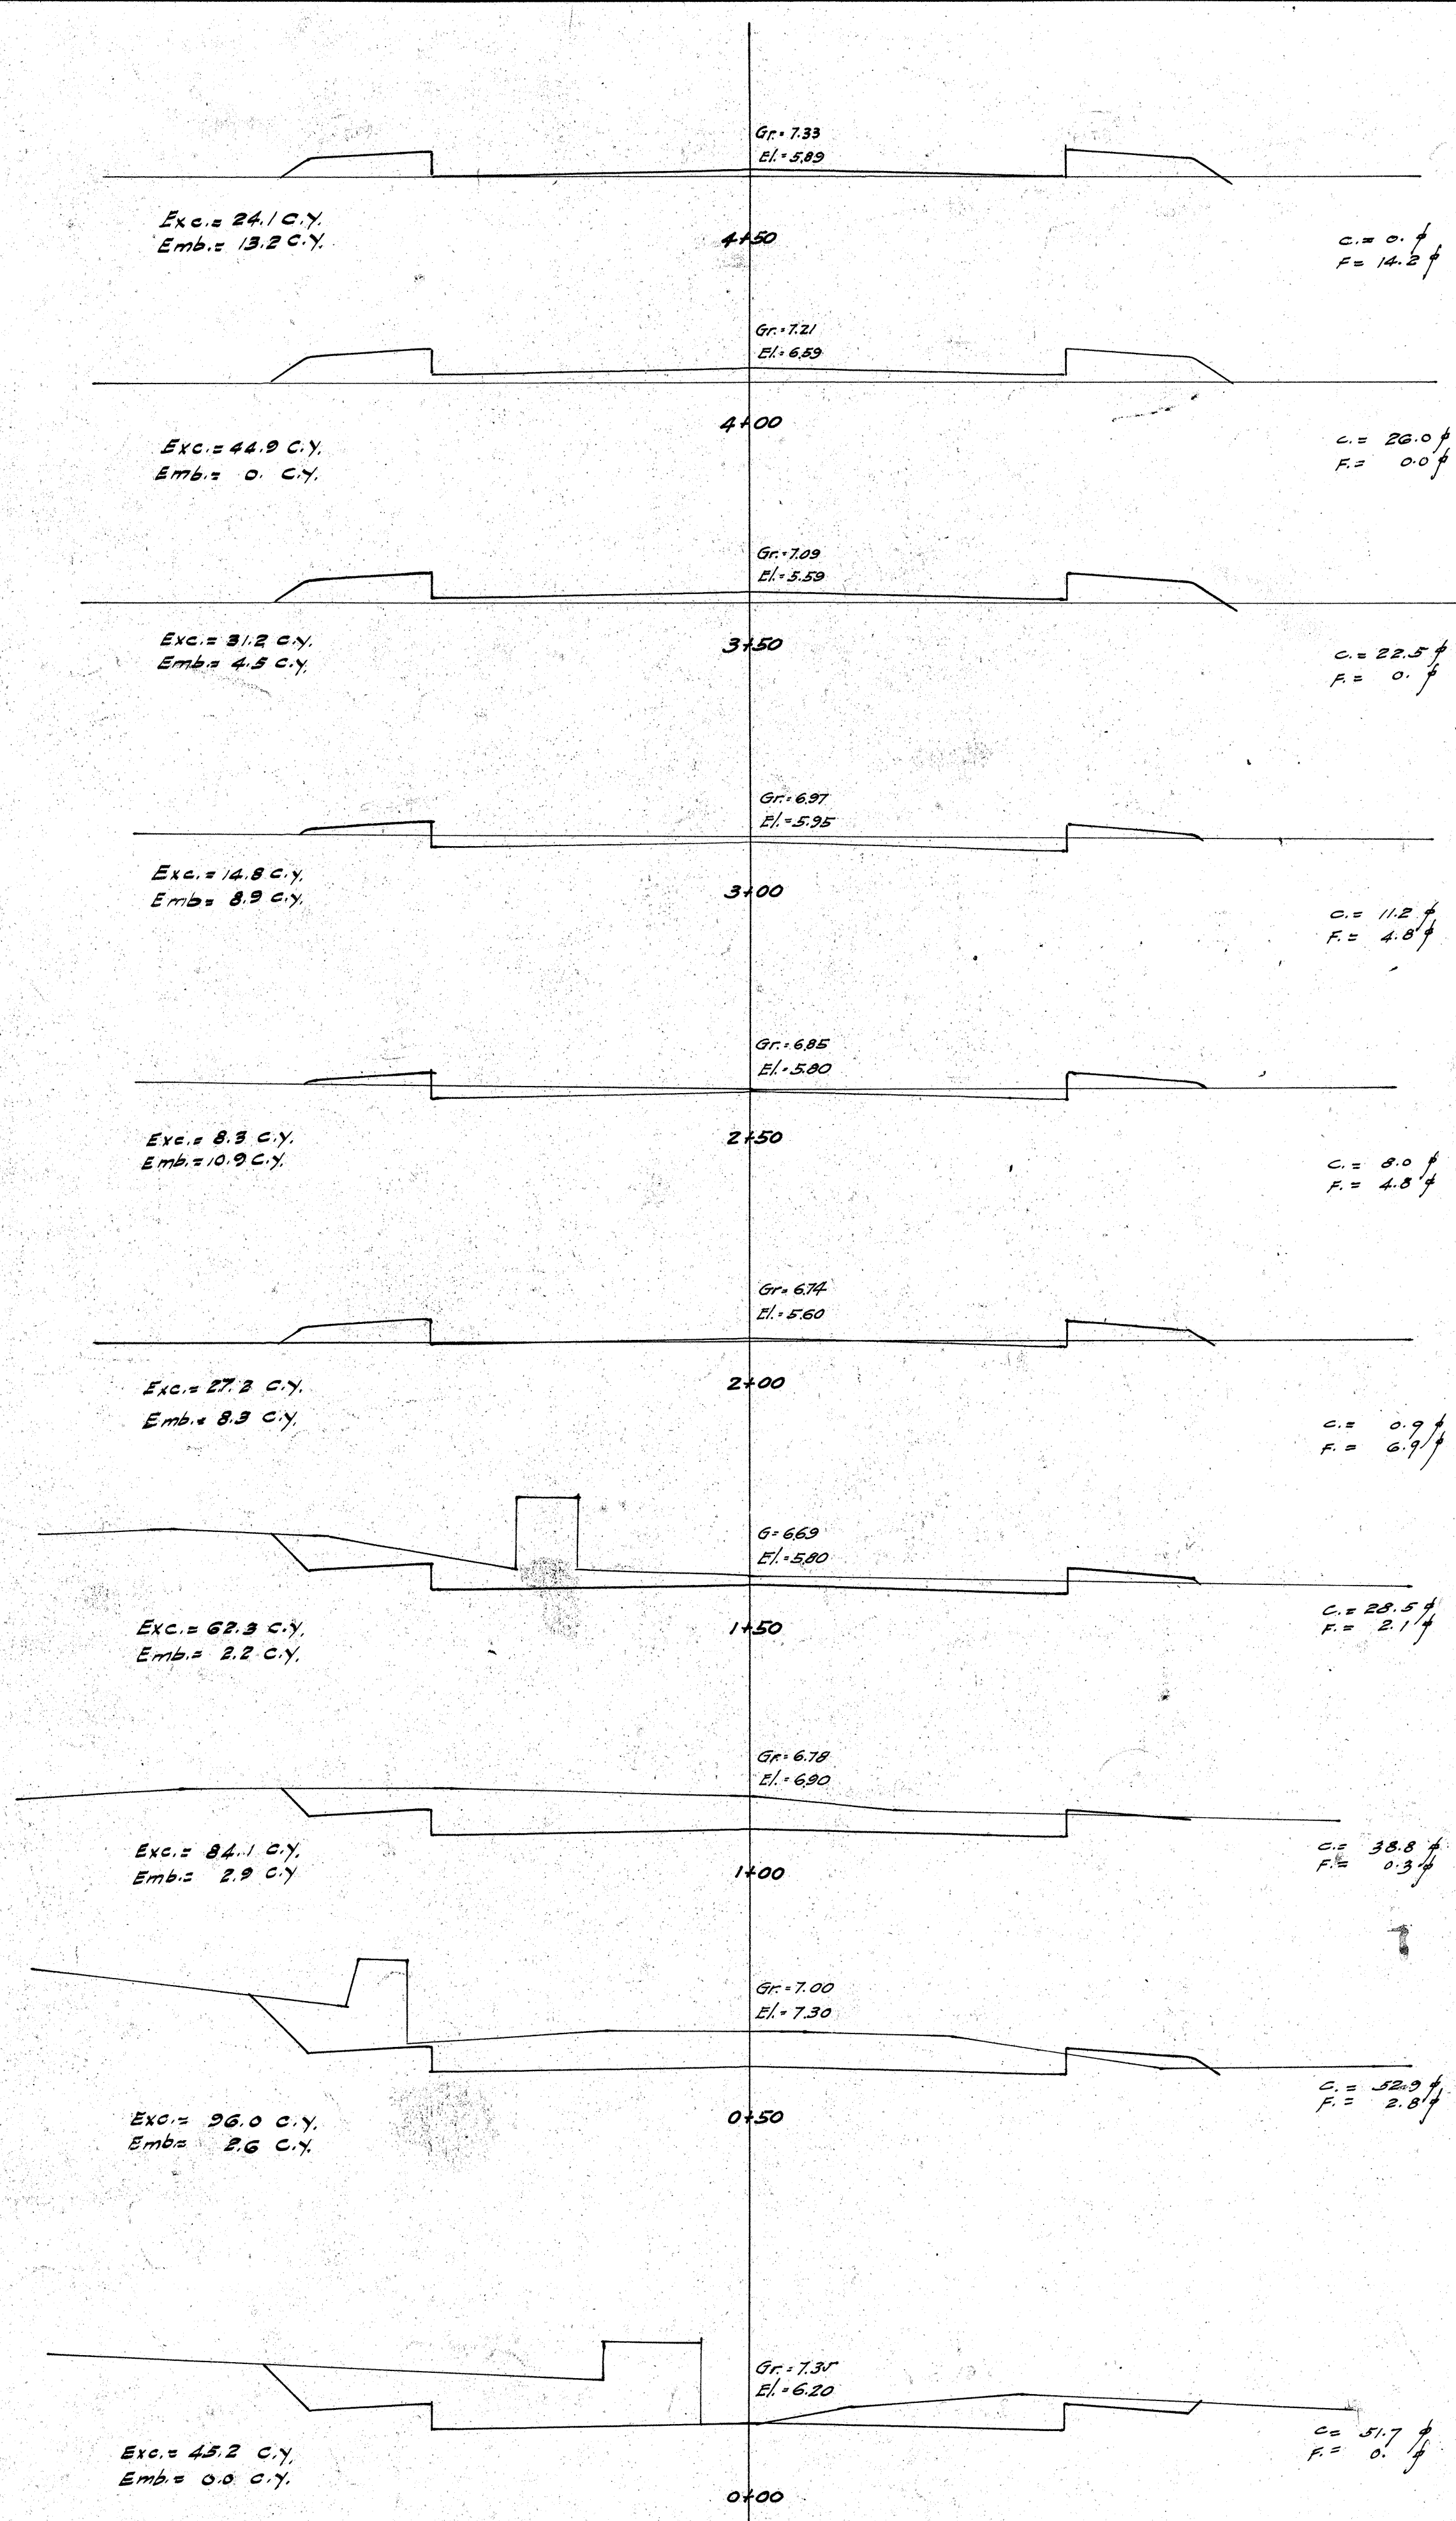

4182.3

Scale
Vertical 1"=5'
Horizontal 1"=5'