



Note: 6" Pavement is comprised of:-
Crushed Rock Base Course - 5% (measured loose) No.1 crushed rock,
Graded Macadam Surface Course - 2% (measured loose) No.2 crushed
rock, 16 lbs. per sq yd grade 16-2 asphalt and No.3 crushed rock to cover.
Seal Coat - 2 to 3 lbs. Grade 16-2 Asphalt and No.4 crushed rock to cover.
Grade 16-2 Asphalt has a 85-100 penetration.

Grade A-2 Asphalt has a 85-100 penetration.


TYPICAL SECTION
Scale 1/4"=1'-0"

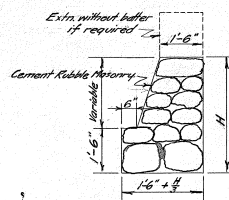


STANDARD RETAINING WALL

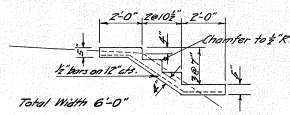


DETAIL OF CONCRETE STEPS

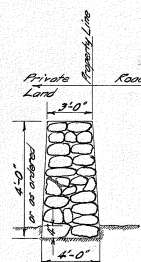

DETAIL RECONSTRUCTED
STONE WALL FENCE

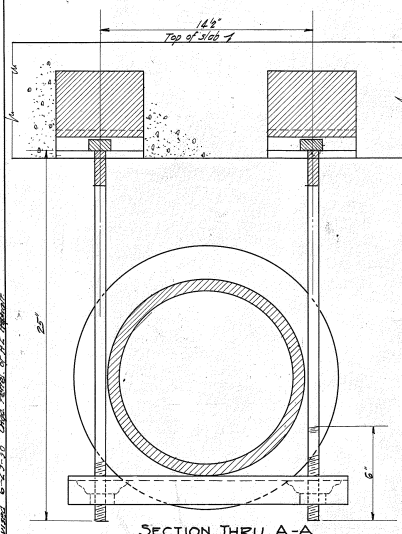


SECTION THRU A-A

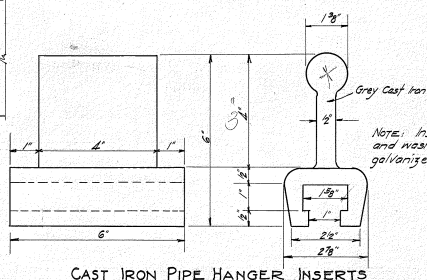

CAST IRON PIPE HANGER INSERTS

DETAIL - PIPE HANGER & INSERTS
FOR 12" CAST IRON WATER MAIN
10 Seps required @ 6'-0" centers

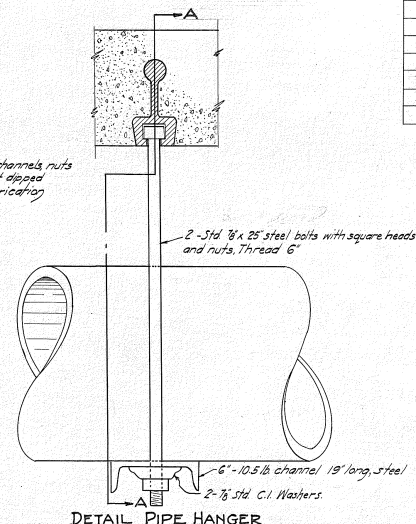

DETAIL PIPE HANGER

	UNCLASSIFIED EXCAVATION	EMBANKMENT	EXCAVATION FOR STRUCTURES	EMBANKMENT FOR STRUCTURES	ROCKY FILL	CEMENT RUBBLE MASSING	RECONSTRUCTED STONE WALL, FENCE	STONE SUBBASE	PAVEMENT	CONCRETE PILES	CLASS "A" CONCRETE	REINFORCING
UNIT USED	CU YD	CU YD	CU YD	CU YD	CU YD	CU YD	CU YD	SQ. YD	SQ. YD	NO.	CU YD	LB.
ROADWAY	383.0	1320.0					298.0	3547.0	3360.0			
WEST ABUTMENT			10.1	8.2	16.0					10		
EAST ABUTMENT			36.9	8.2	16.0					10		
BOTH ABUTMENTS												34.1 4639.0
PIER										9		79 2164.0
SUPERSTRUCTURE												157.7 21340.0
WALL 149+10 KT.			13.0	2.5		7.2						
WALL 149+70 KT.			5.4	1.7		5.1						
15' C.R.M. WALL			5.0			20.0						
CONCRETE STEPS											0.7	31.0
CHANNEL CHANGE	252.0	250.0										
NON-PARTICIPATING							104.0					
TOTALS	635.0	1570.0	70.4	20.6	32.0	32.3	402.0	3547.0	3360.0	29	200.4	3474.0

Depressed V Letters

NAME

Use correct name of stream

Left Hand Side

Right Hand Side

DETAIL LETTERS & FIGURES
ON BRIDGE RAILINGS
Scale 2"=1'-0"

TYPICAL SECTIONS

4141.2

6 14