




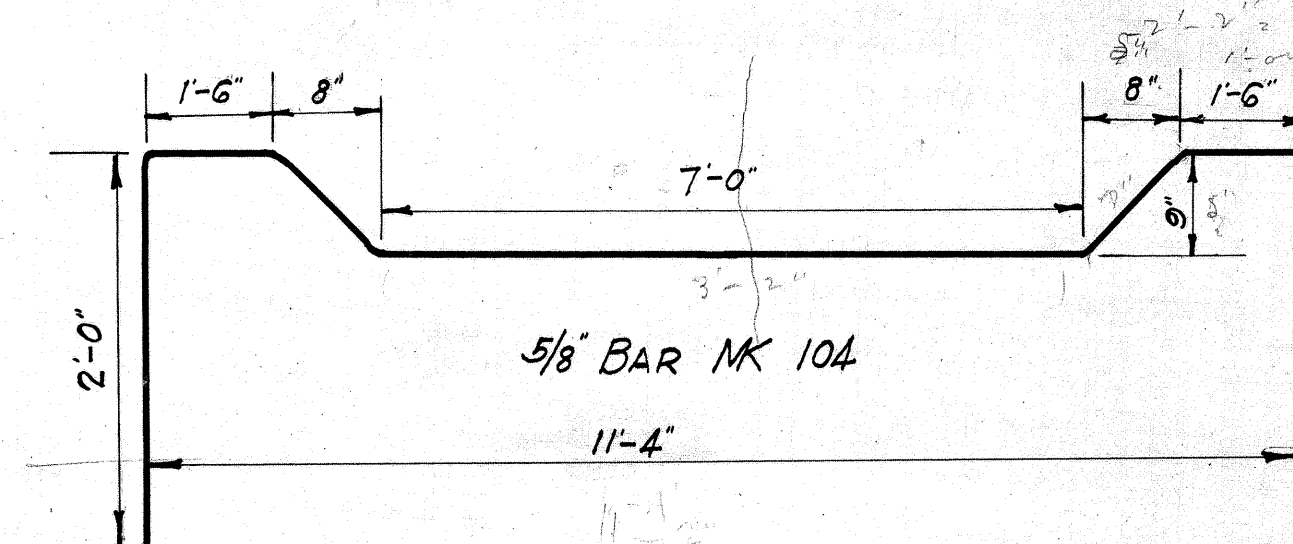


MK	Size	length	bending
103	5/8"	11'-4"	straight
102	1/2"	2'-9"	do
101	1/2"	6'-10"	do

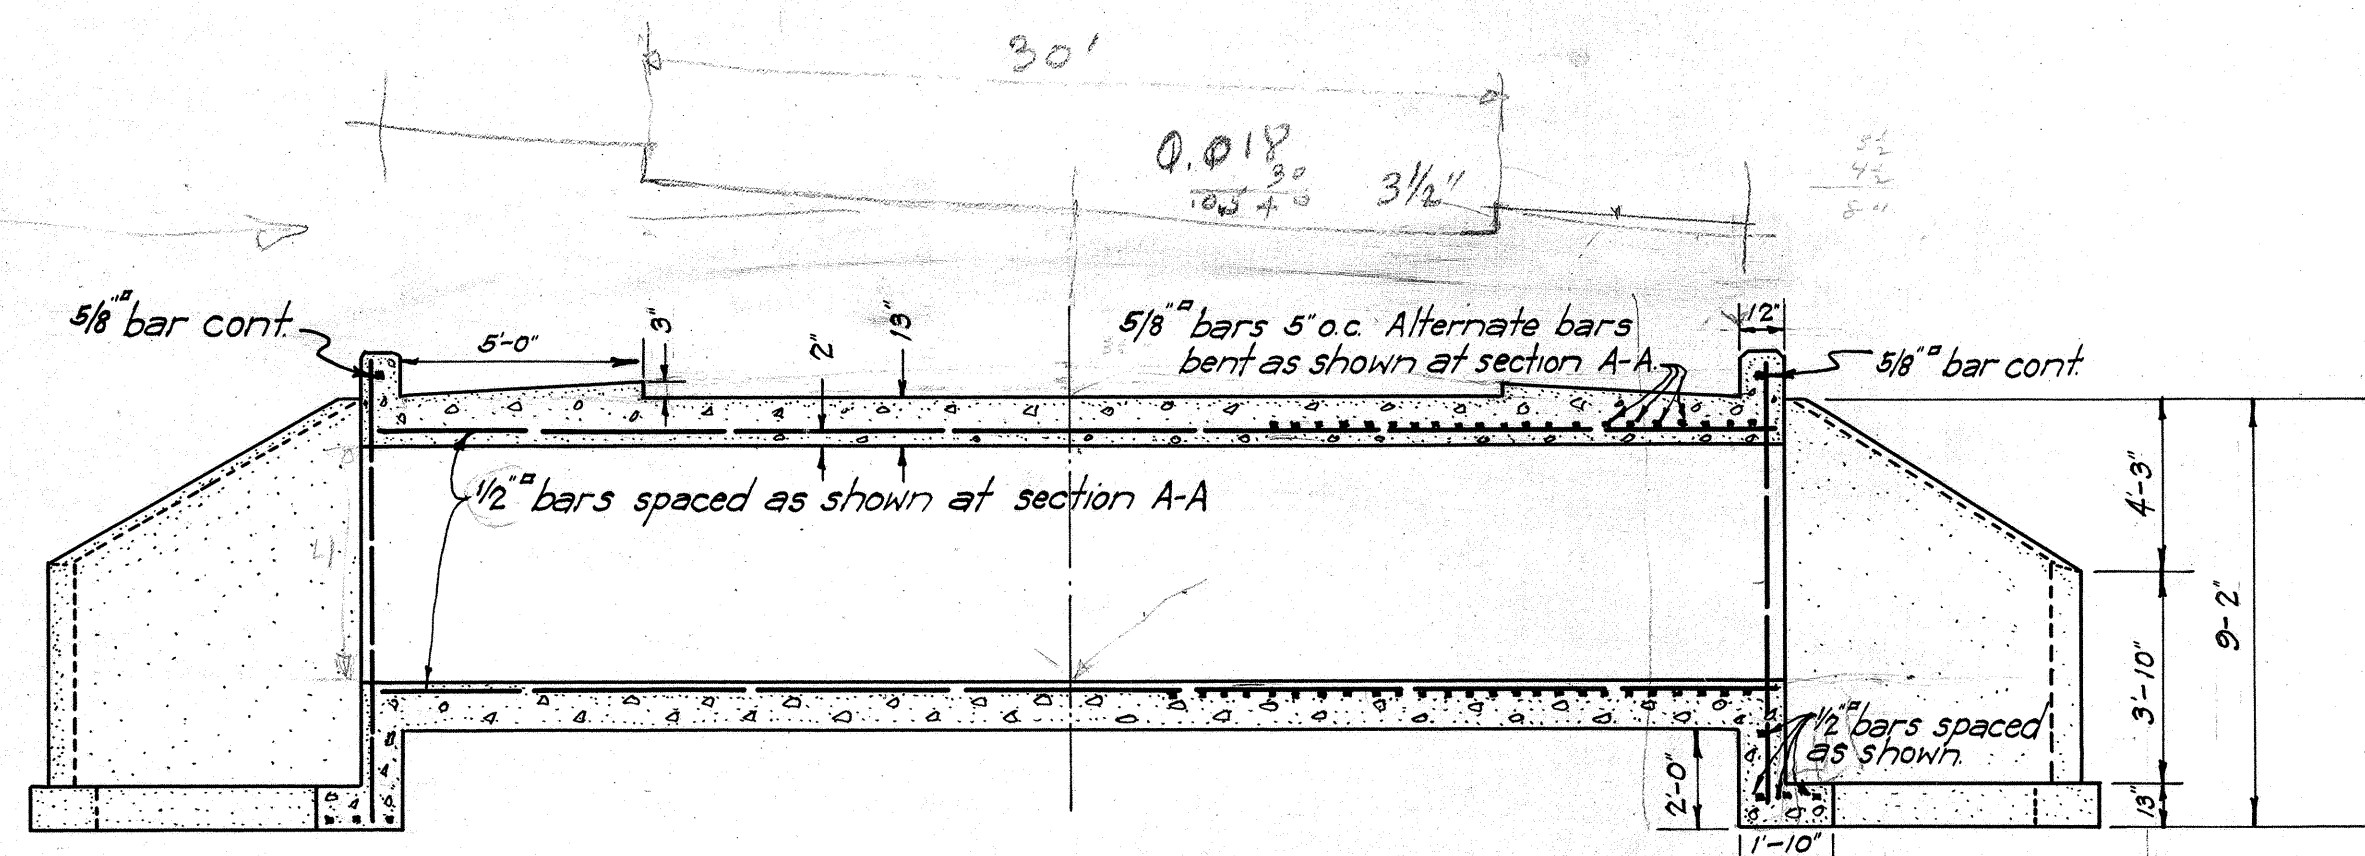


LONGITUDINAL SECTION THRU B-B
Scale 1/4" = 1'-0"

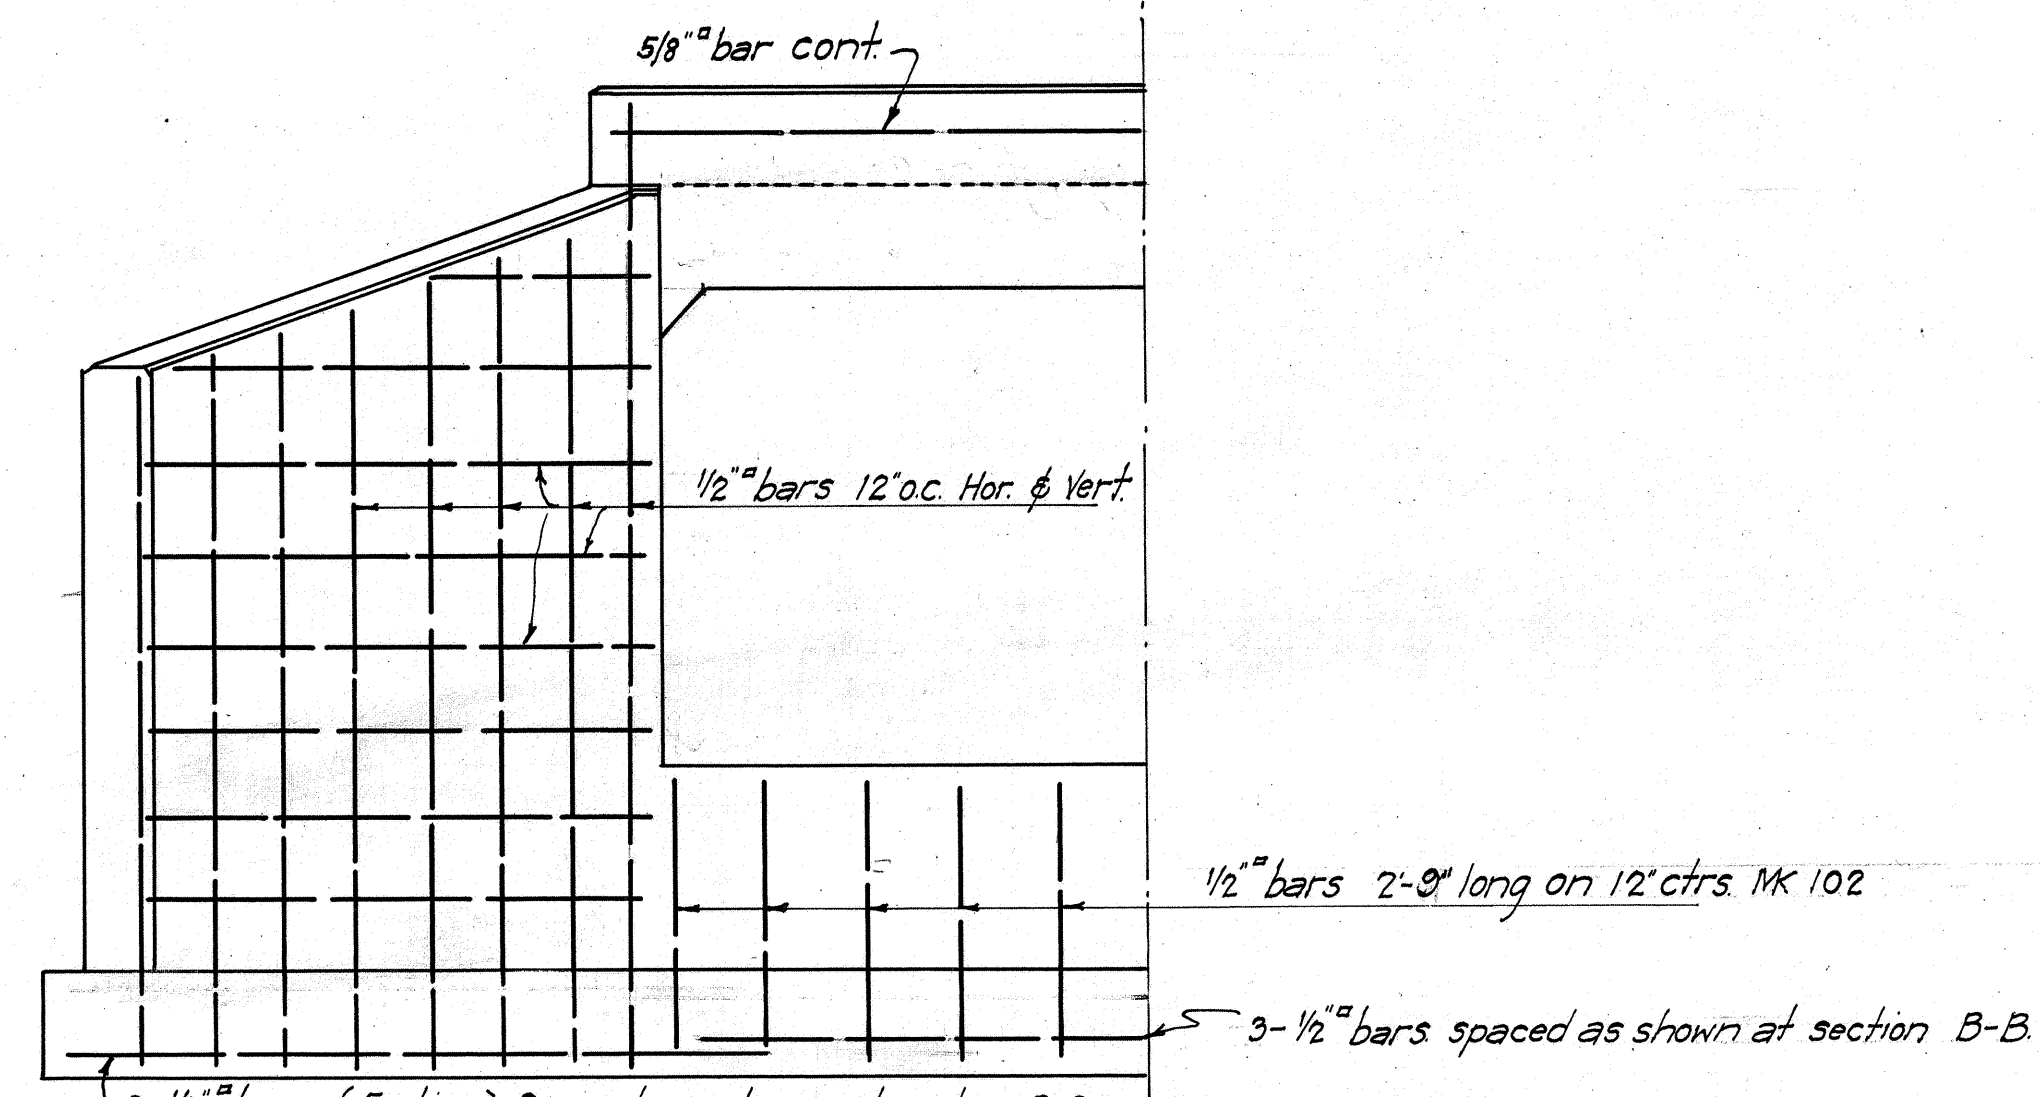


ONE HALF END ELEVATION
Scale 1/2" = 1'-0"

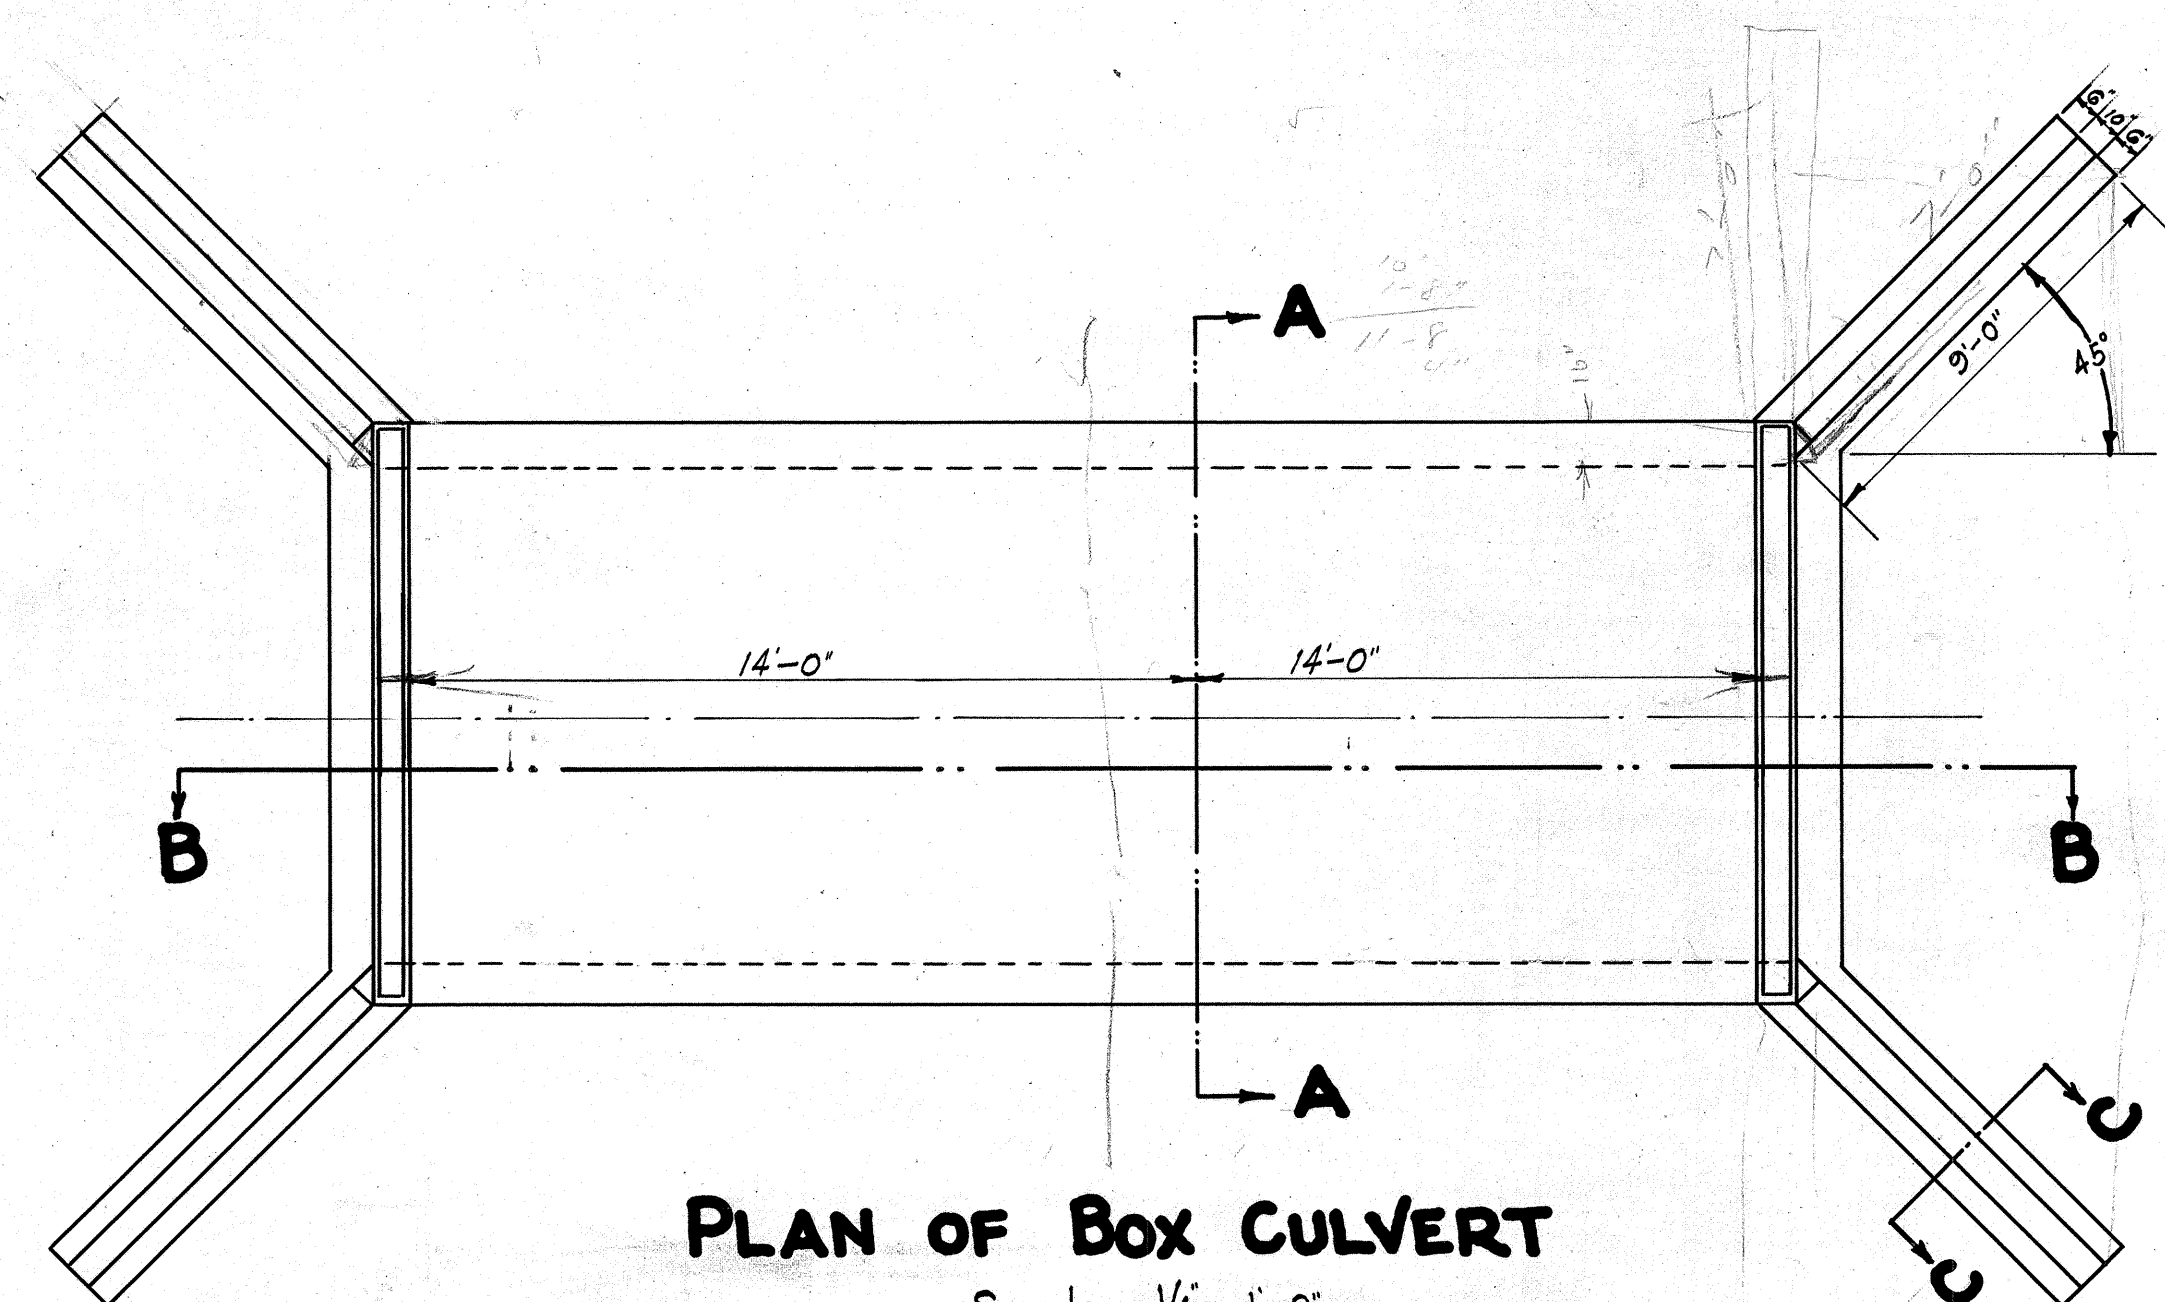

PLAN OF BOX CULVERT
Scale - 1/4" = 1'-0"

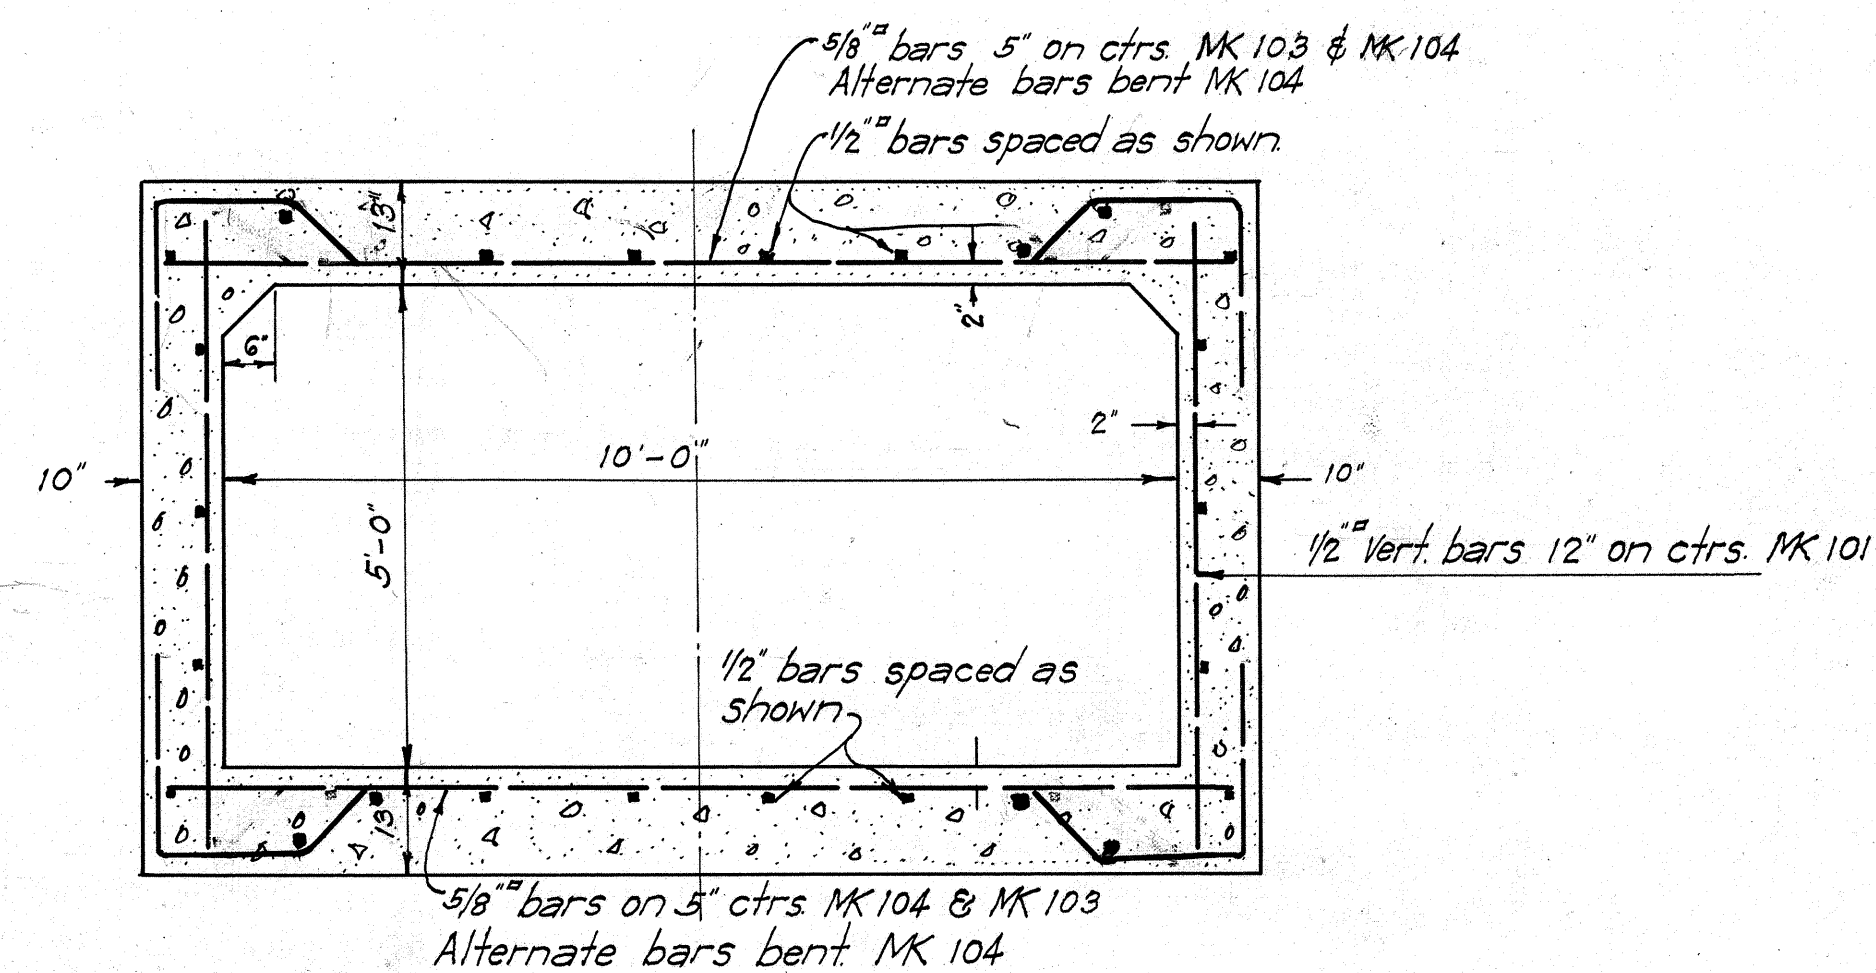

SECTION THRU A-A
Scale 1/2" = 1'-0"

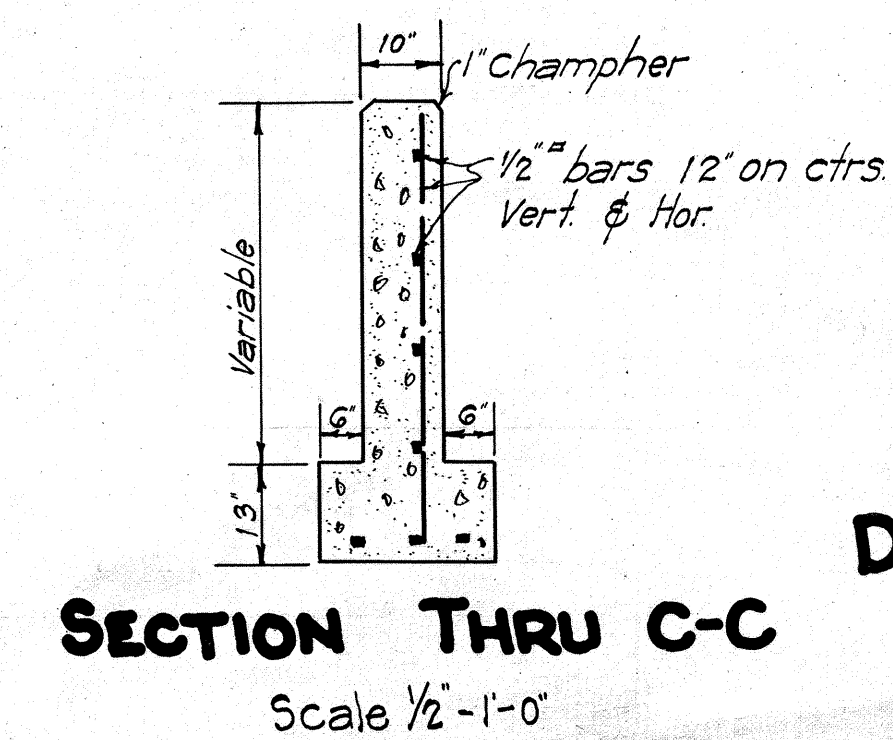

SECTION THRU C-C
Scale 1/2" = 1'-0"

NOTE: All bars with no lengths shown are to be of such a length that they will come to within two inches of the surface of the concrete at each end.
Splices will not be allowed except in longitudinal bars, all splices to lap 30 diameters securely with #16 wire.

TERRITORIAL HIGHWAY DEPT.
TERRITORY OF HAWAII
DETAILS OF CULVERT-STA. 248+60
Superceding details on sheet 4200.2
Kalaniana'ole Hy. Federal Aid Project G-G
Scale as shown July 1931

Plan File	Pocket	Folio	Plan
No. 2	No. 10	No. 13	No.