
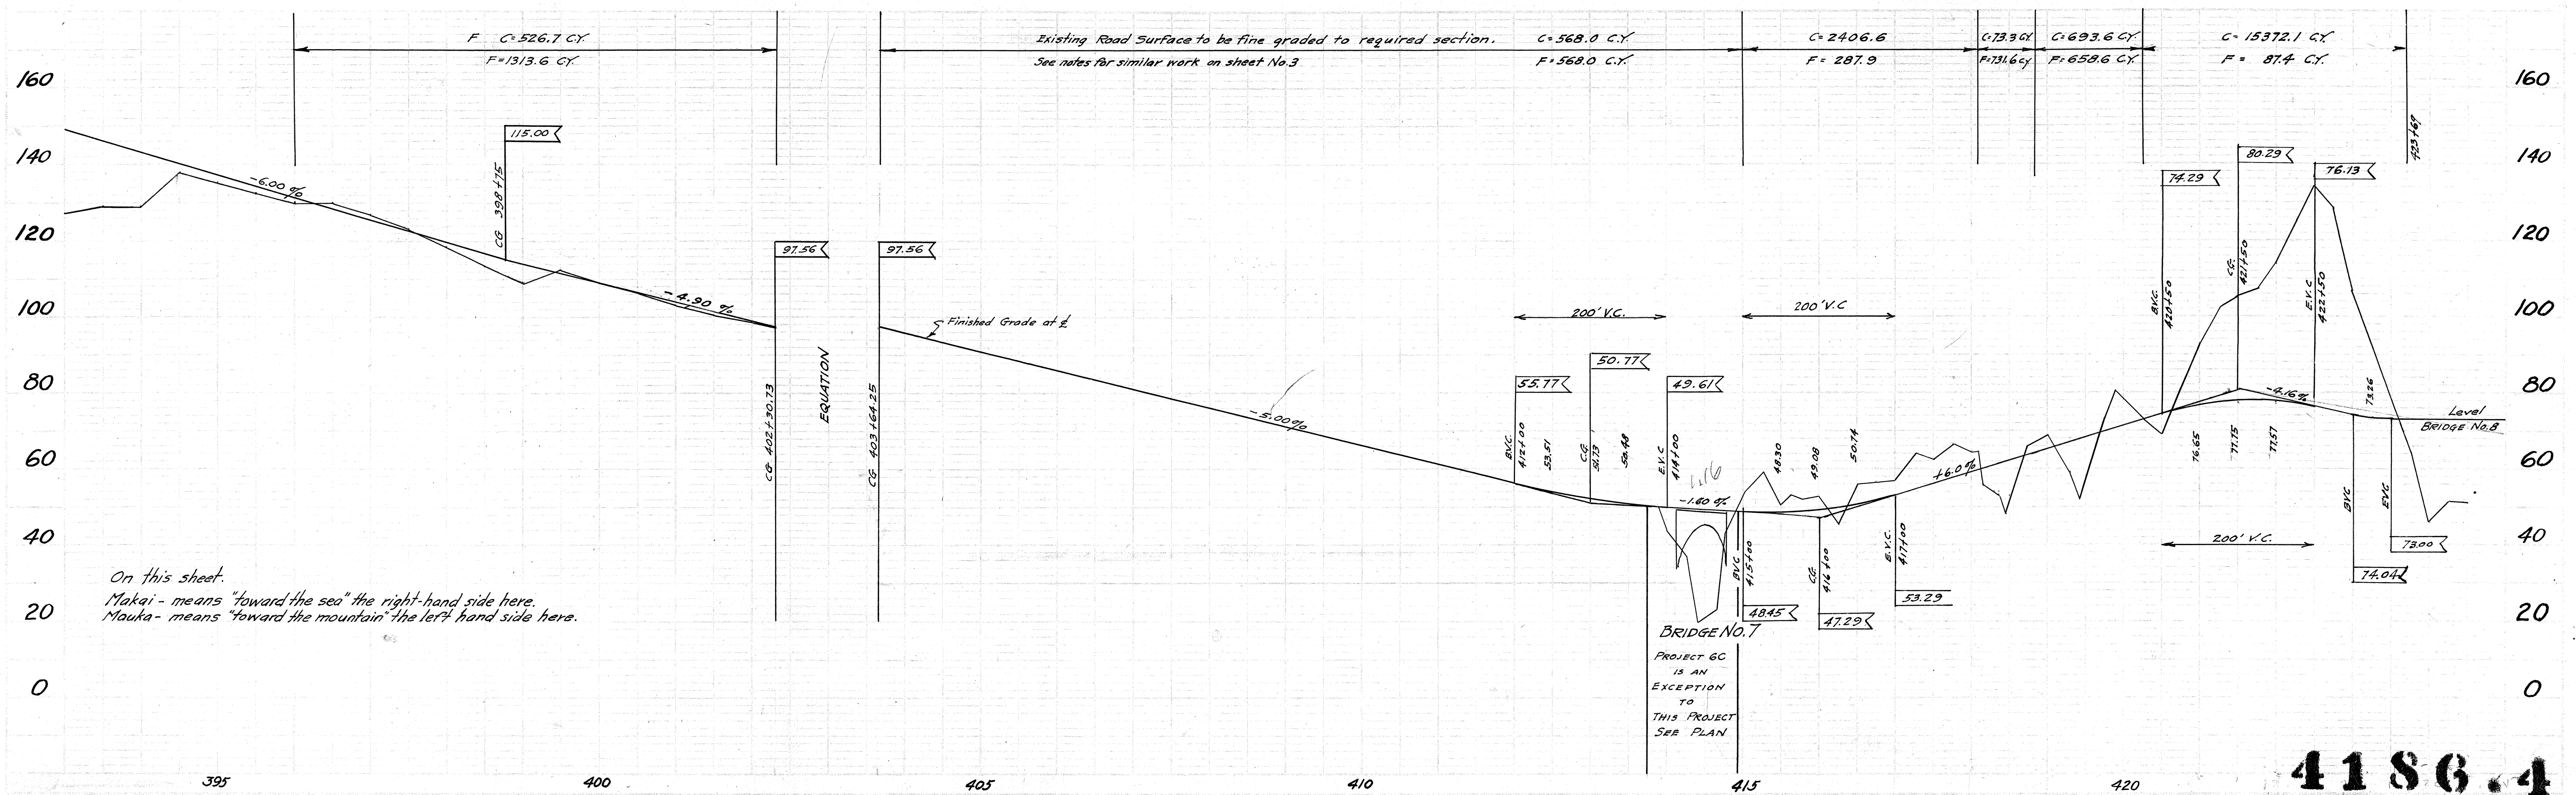


FED. ROAD DIST. NO.	STATE	FED. AID PROJ. NO.	FISCAL YEAR	SHEET NO.	TOTAL SHEETS
HAWAII	HAW.	60	1931	4	23

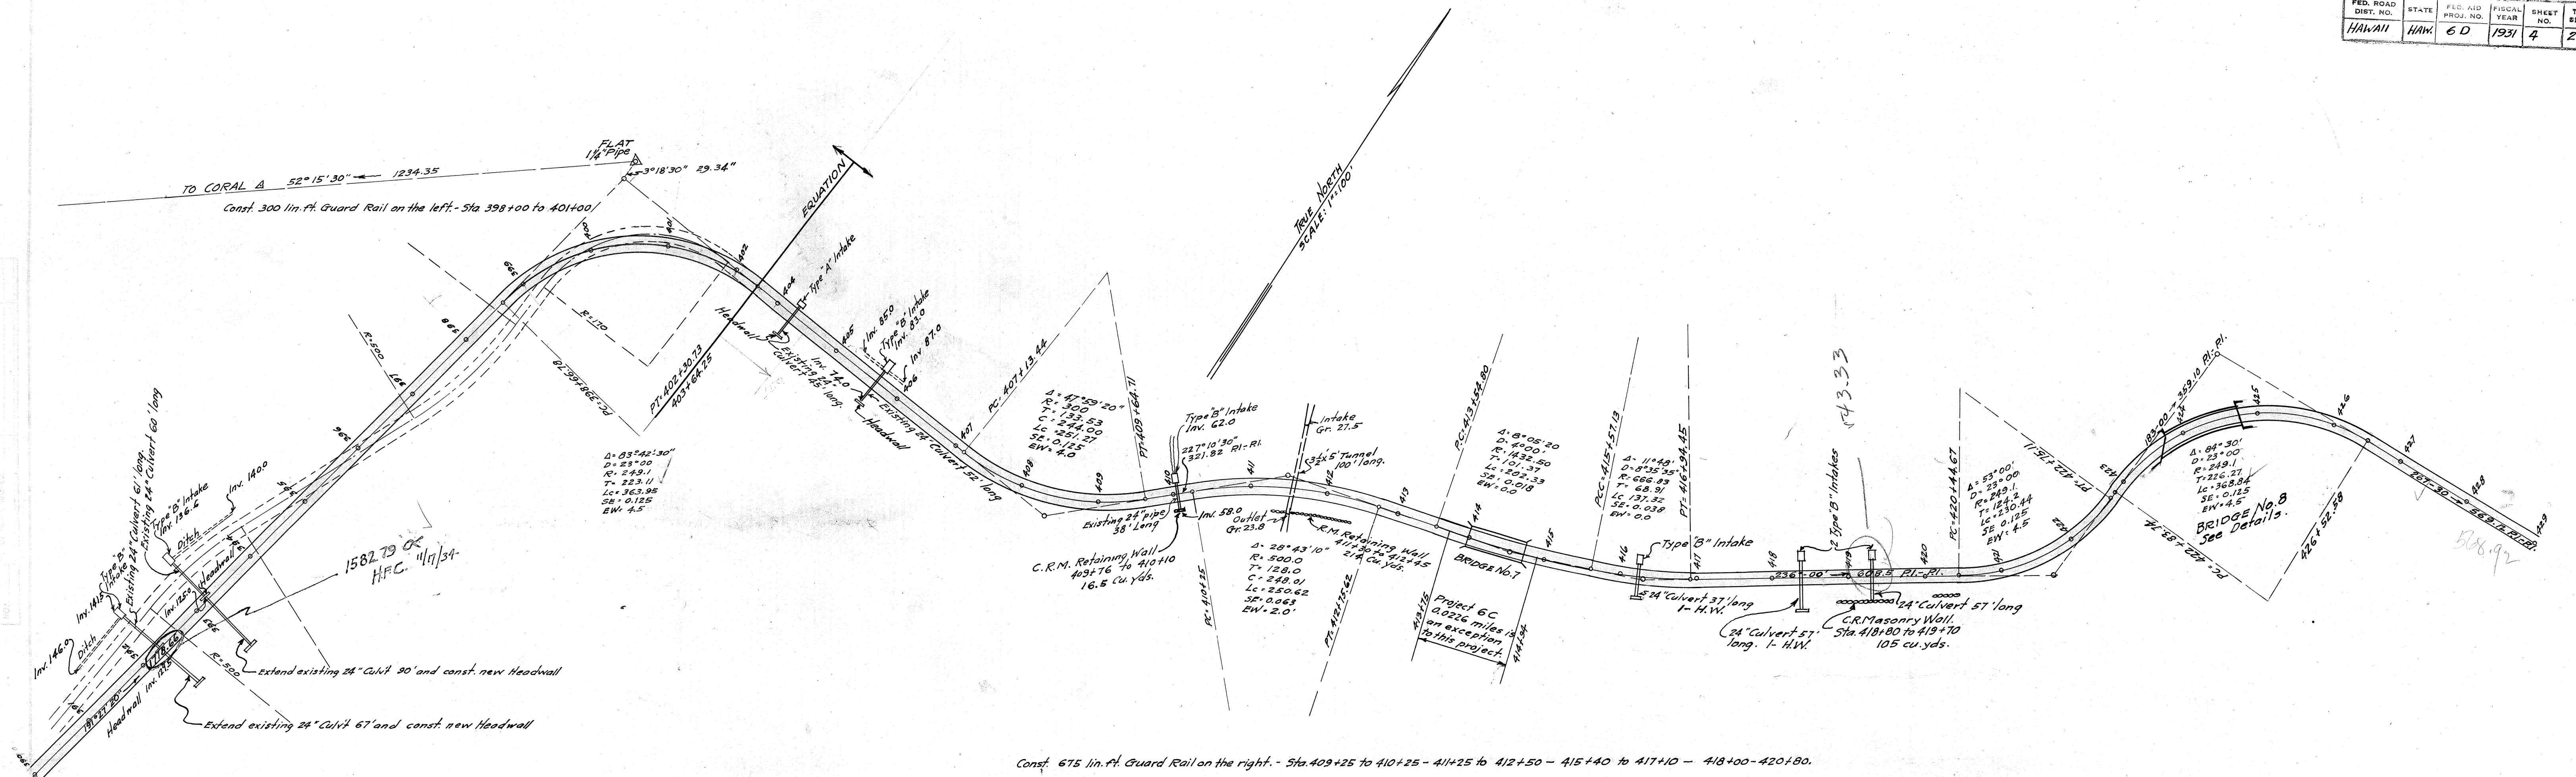

On this sheet.
Makai - means "toward the sea" the right-hand side here.
Mauka - means "toward the mountain" the left hand side here.

BRIDGE No. 7


PROJECT GC
IS AN
EXCEPTION
TO
THIS PROJECT
SEE PLAN

41864


Plan File	Pocket	Folder	Plan
No. 6	No. 14	No. 2	No.

FED. ROAD DIST. NO.	STATE	FED. AID PROJ. NO.	FISCAL YEAR	SHEET NO.	TOTAL SHEETS
HAWAII	HAW.	6D	1931	5	23

Const. 328 lin. ft. Guard Rail on the left. Sta. 442+10 to 445+38.



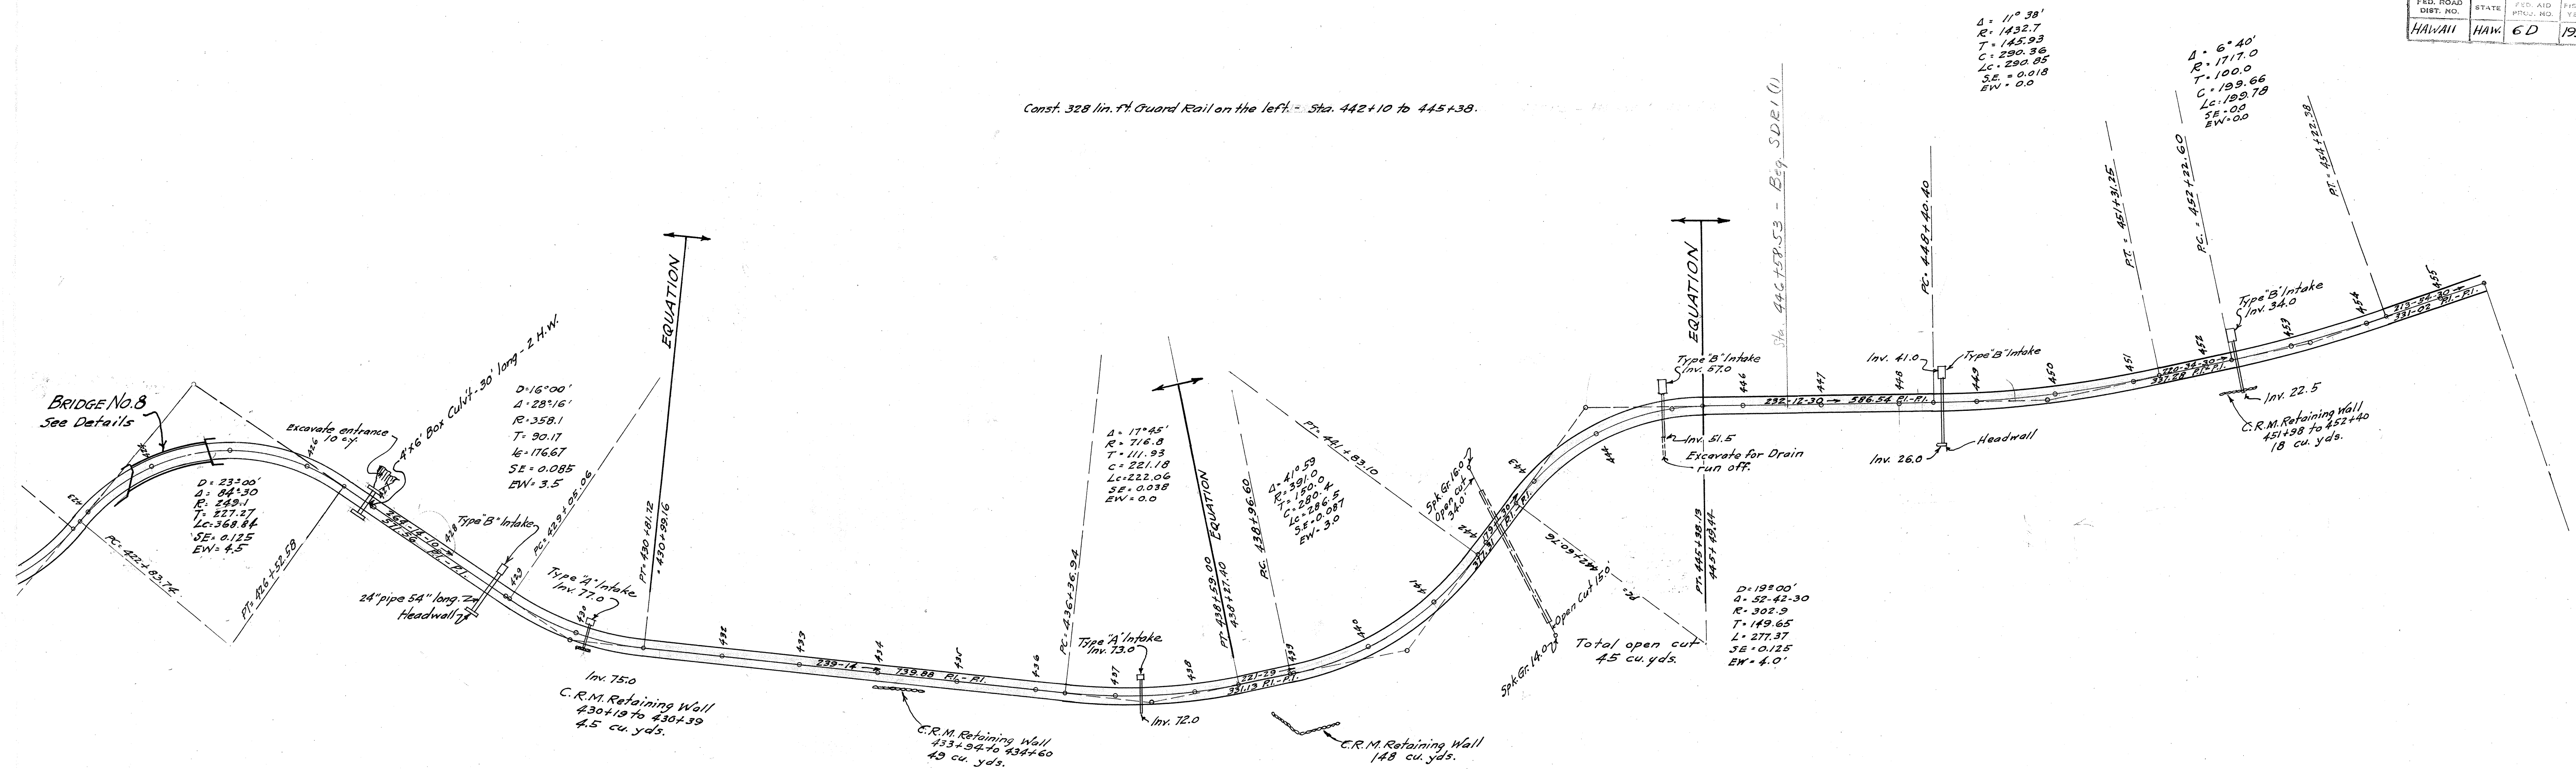


Const. 2588 1/2 in. ft. Guard Rail on the right. Sta. 426+60 to 427+40-428+50 to 429+20-430+00 to 431+20-432+40 to 433+10-433+60 to 434+8-436+00 to 440+00-441+00 to 445+38-448+00 to 449+75-450+00 to 461+00.

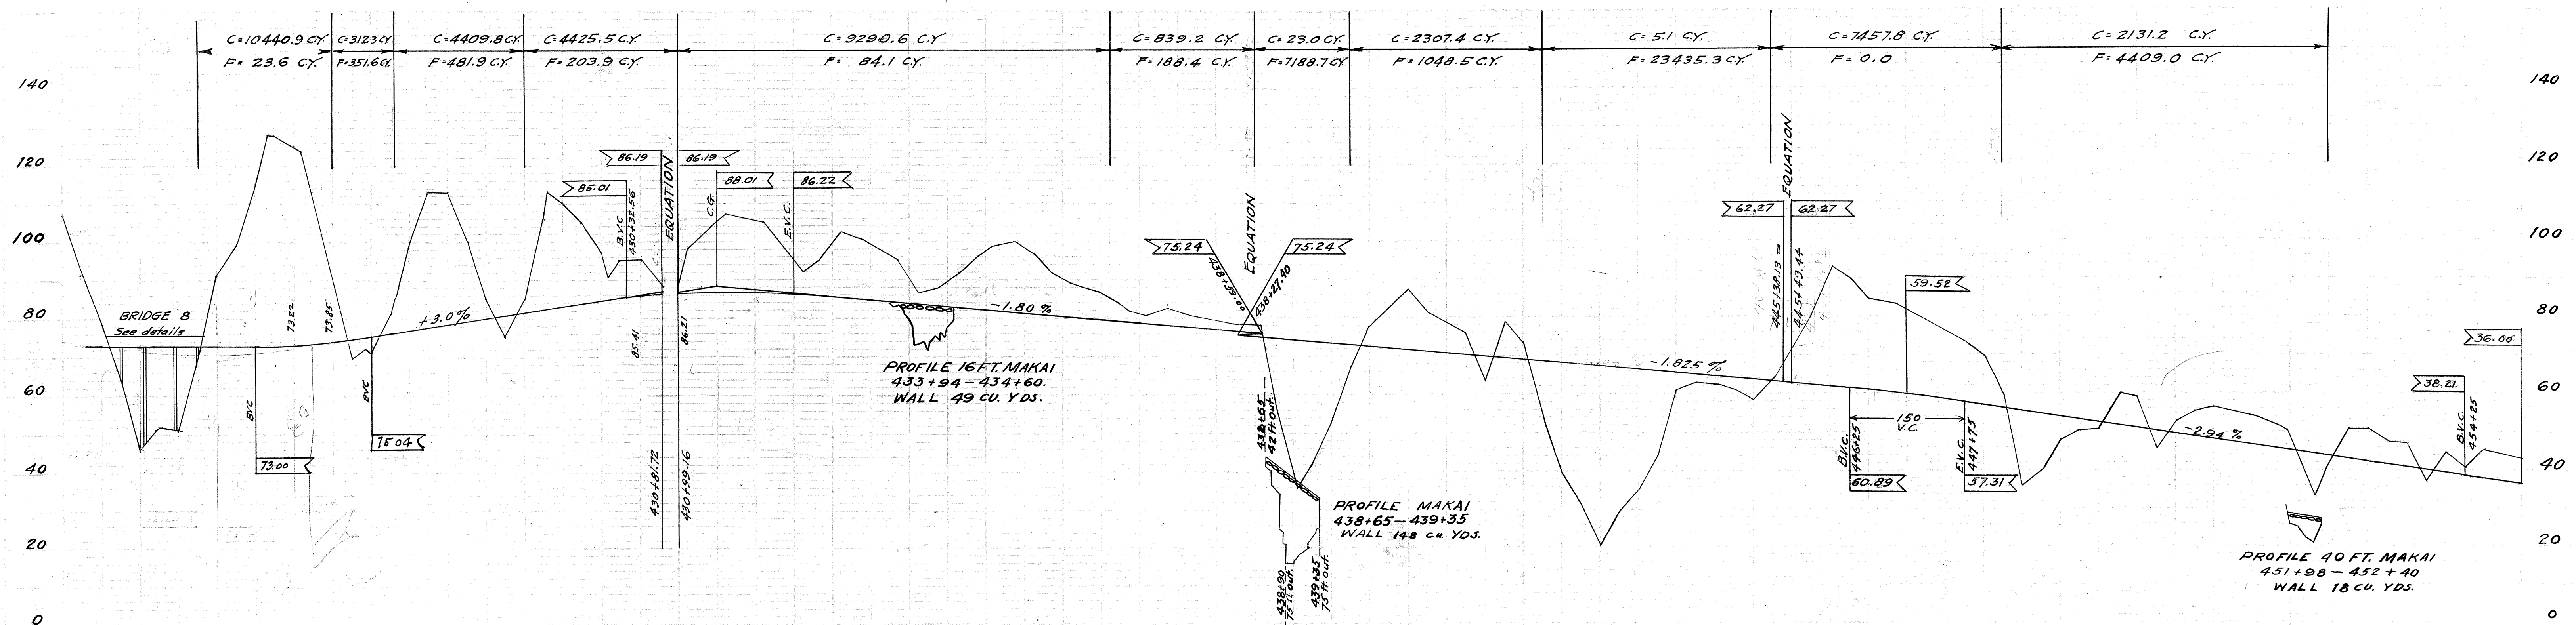

4186.5

Plan File	Pocket	Folder	Plan
No. 6	No. 14	No. 2	No.

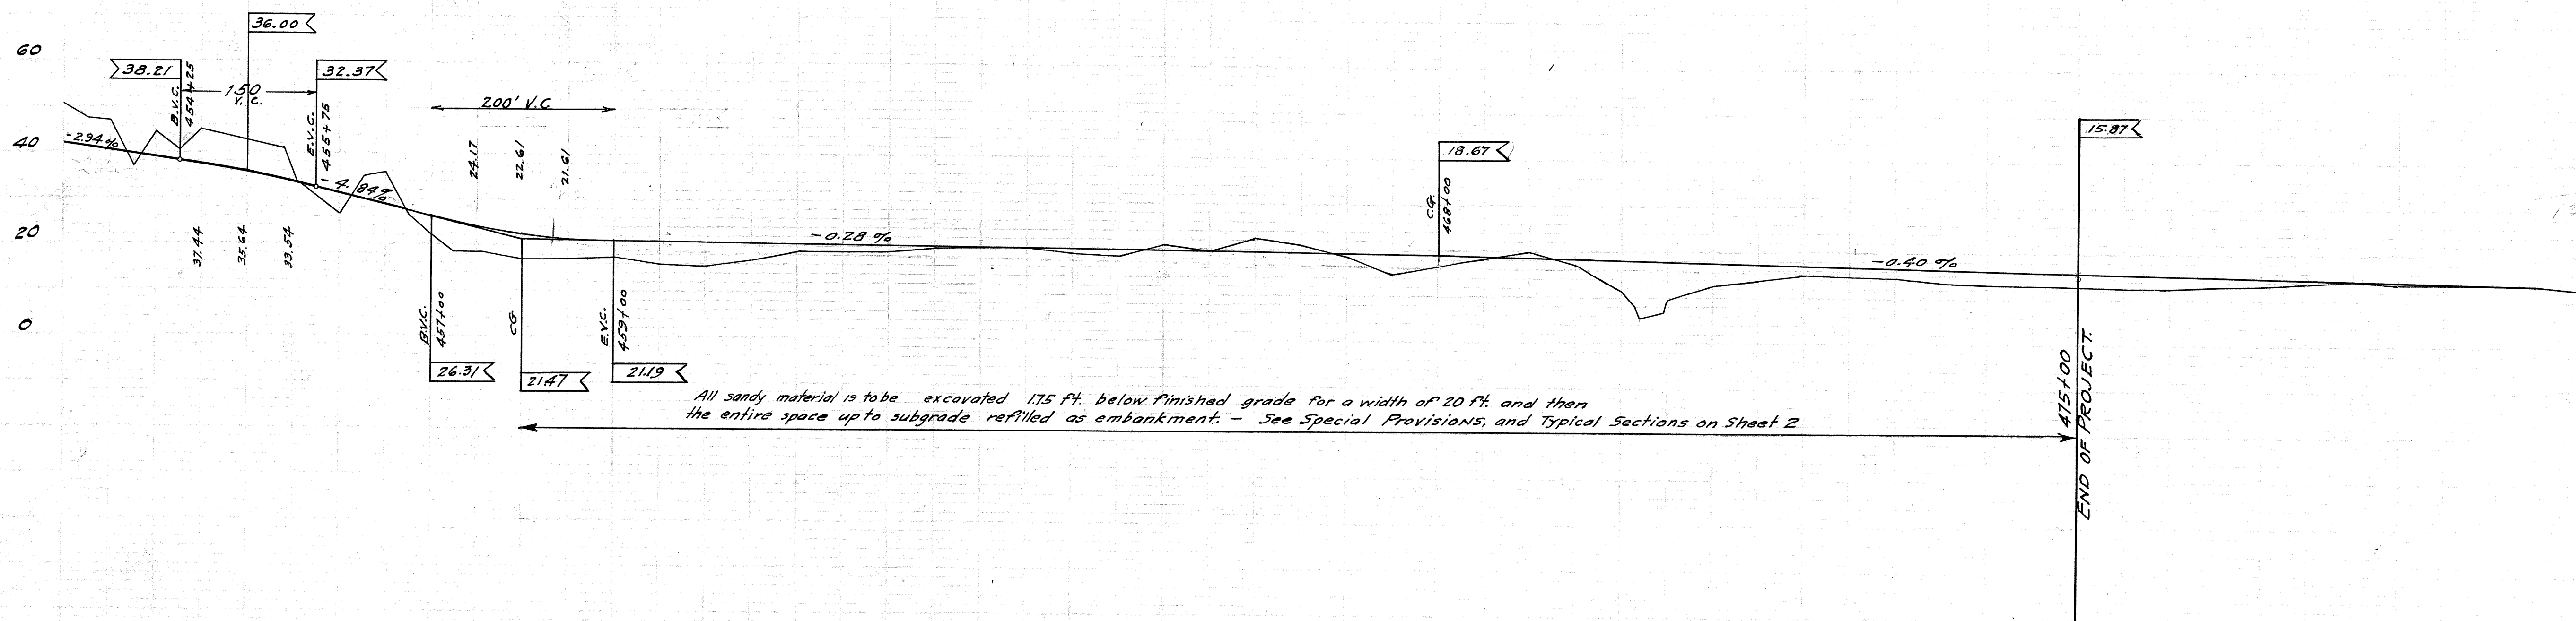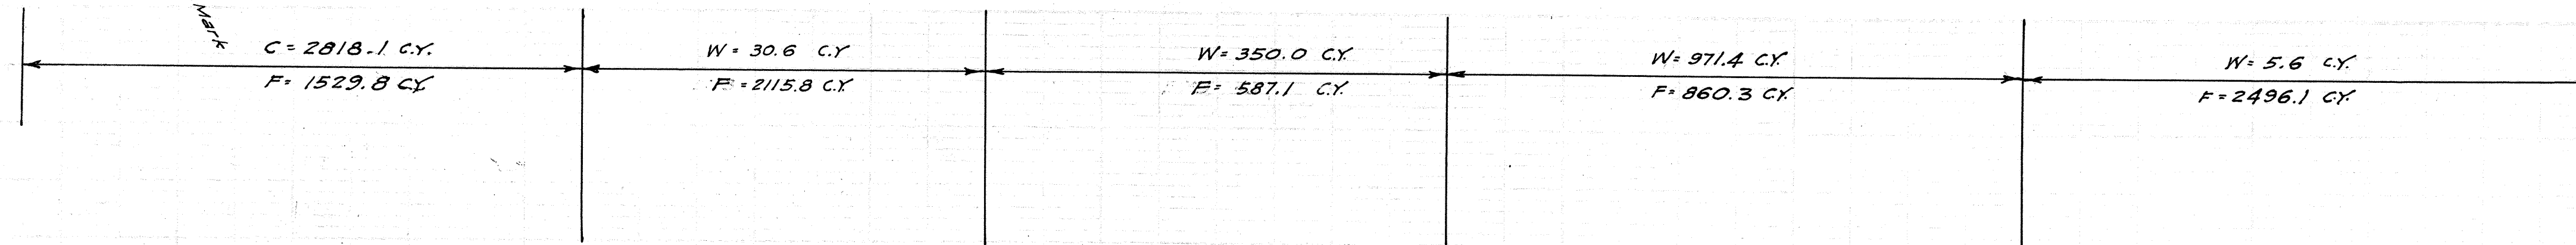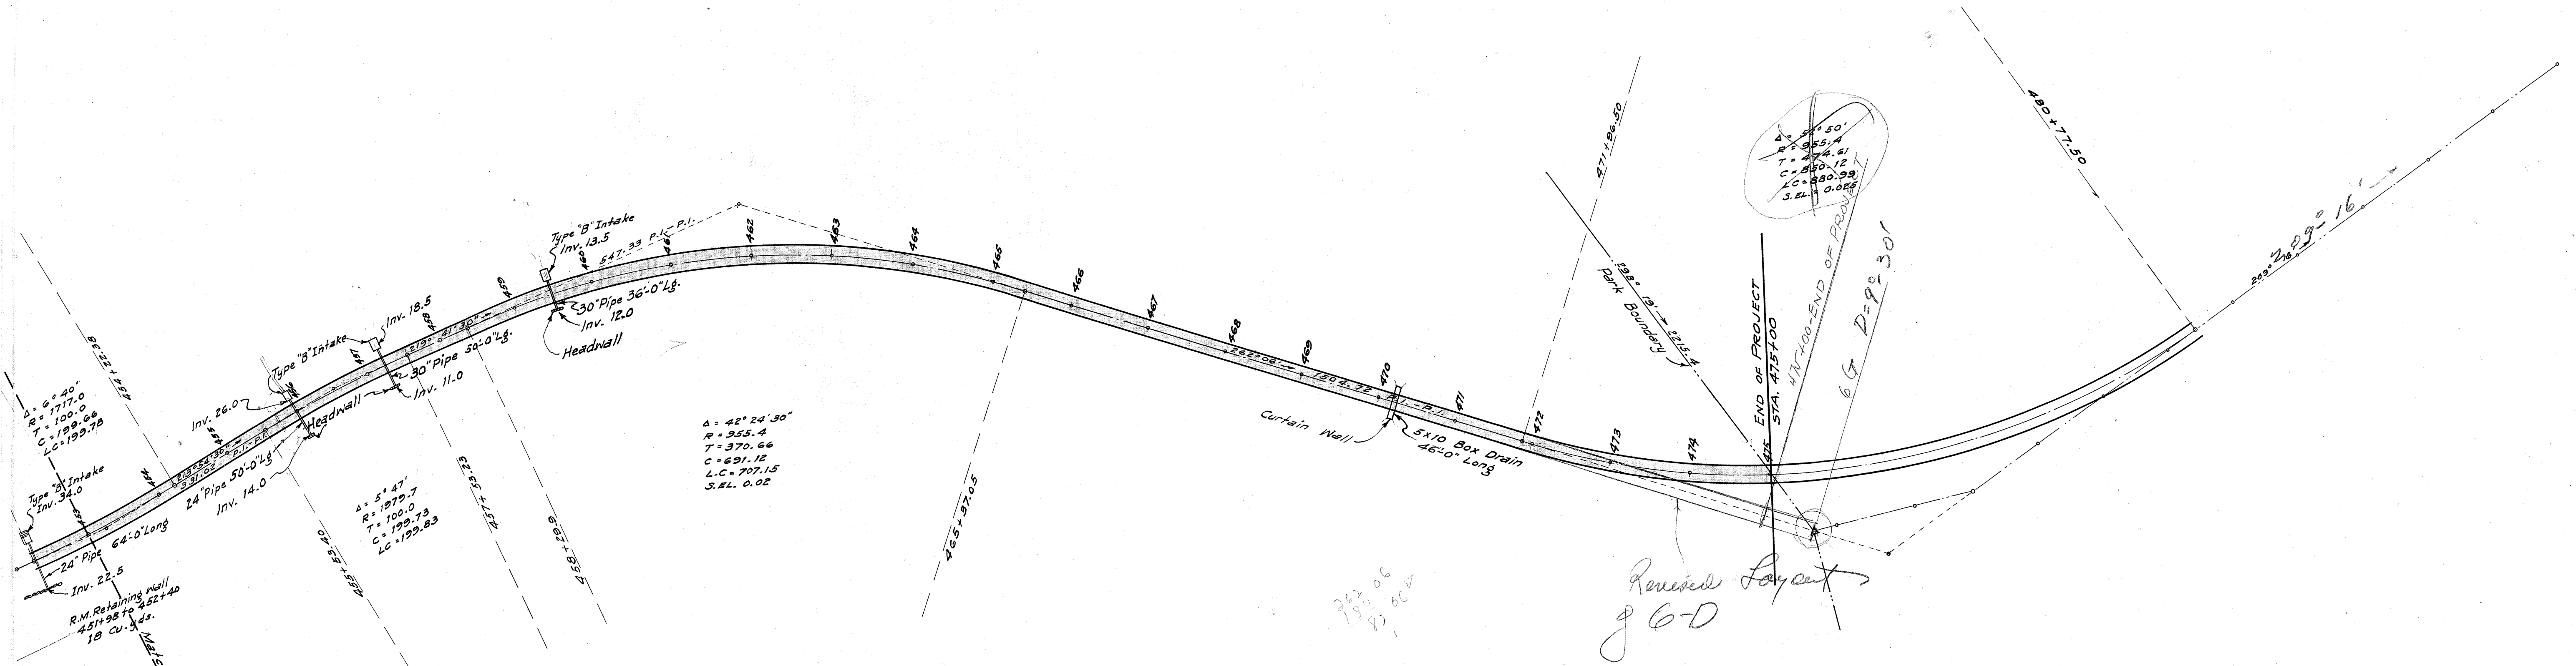

All sandy material is to be excavated 175 ft. below finished grade for a width of 20 ft. and then the entire space up to subgrade refilled as embankment. - See Special Provisions, and Typical Sections on Sheet 2