


[illegible]

	SCALE		
PLAN	1	INCH =	100 FEET
PROFILE	{HOR	1	INCH = 100 FEET
	{VER	1	INCH = 20 FEET
CROSS SECTION	{HOR	1	INCH = 10 FEET
	{VER	1	INCH = 10 FEET

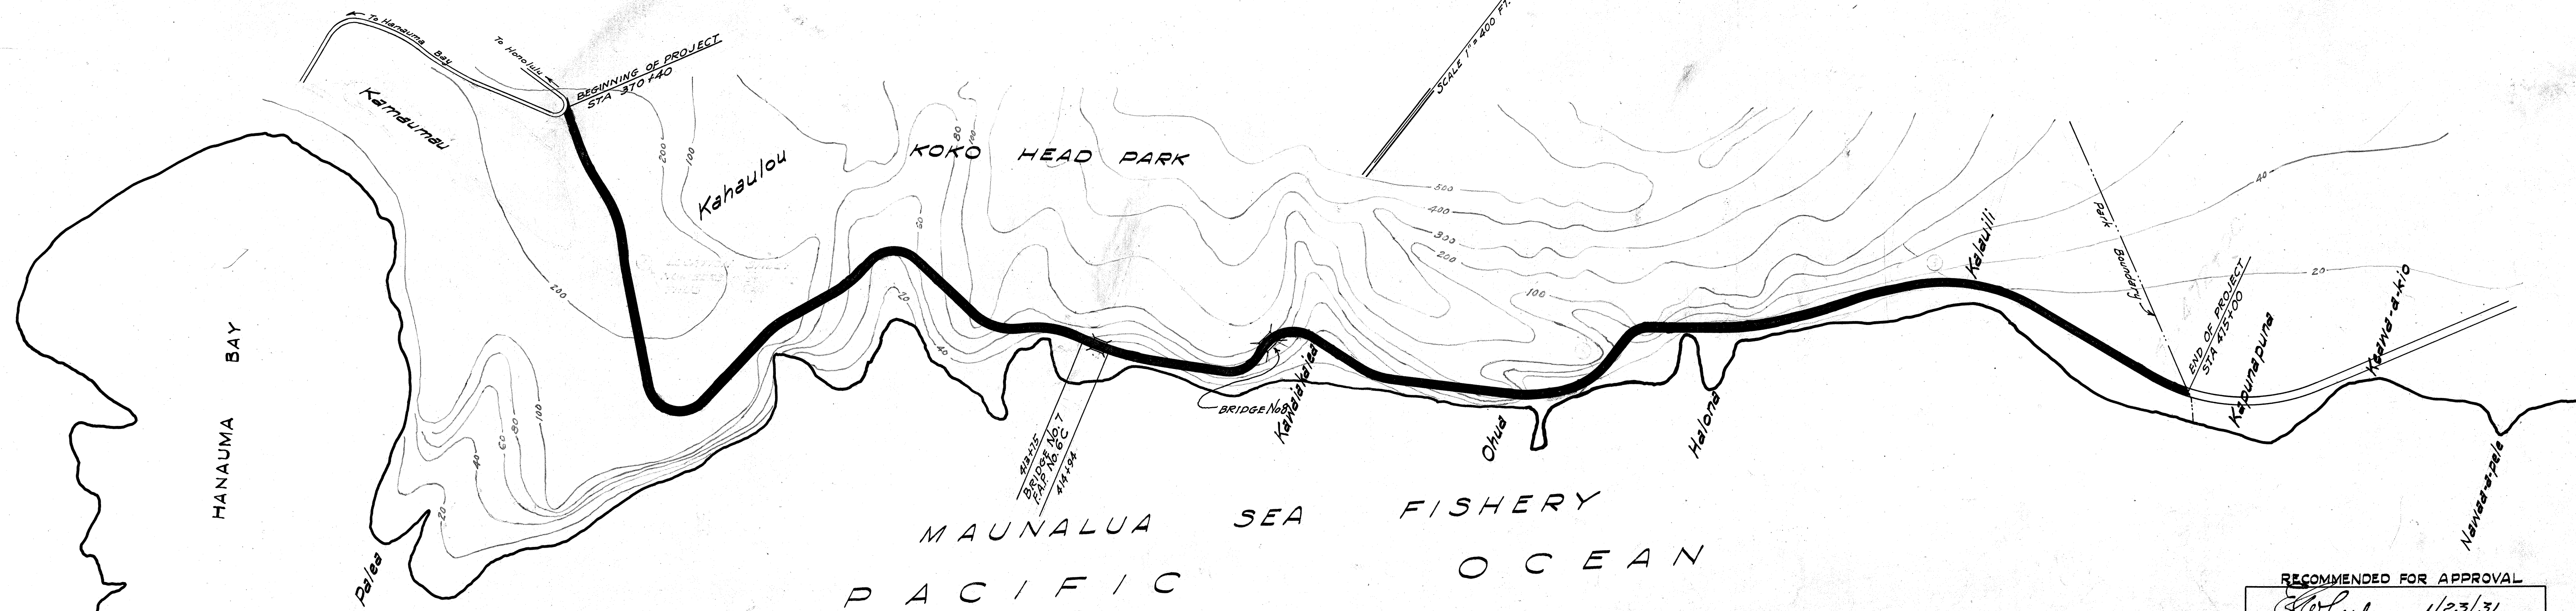

PAVEMENT
RUBBLE MASONRY RETAINING WALL
TUNNEL
BOX CULVERT
CATCH BASIN, PIPE DRAIN & HEAD WALL
BRIDGE

APPROVED

Lynne H. Sigelow

1/22/31

TERRITORIAL HIGHWAY ENGINEER

APPROVED

[Redacted Signature]

DIRECTOR Bureau of Public Roads