





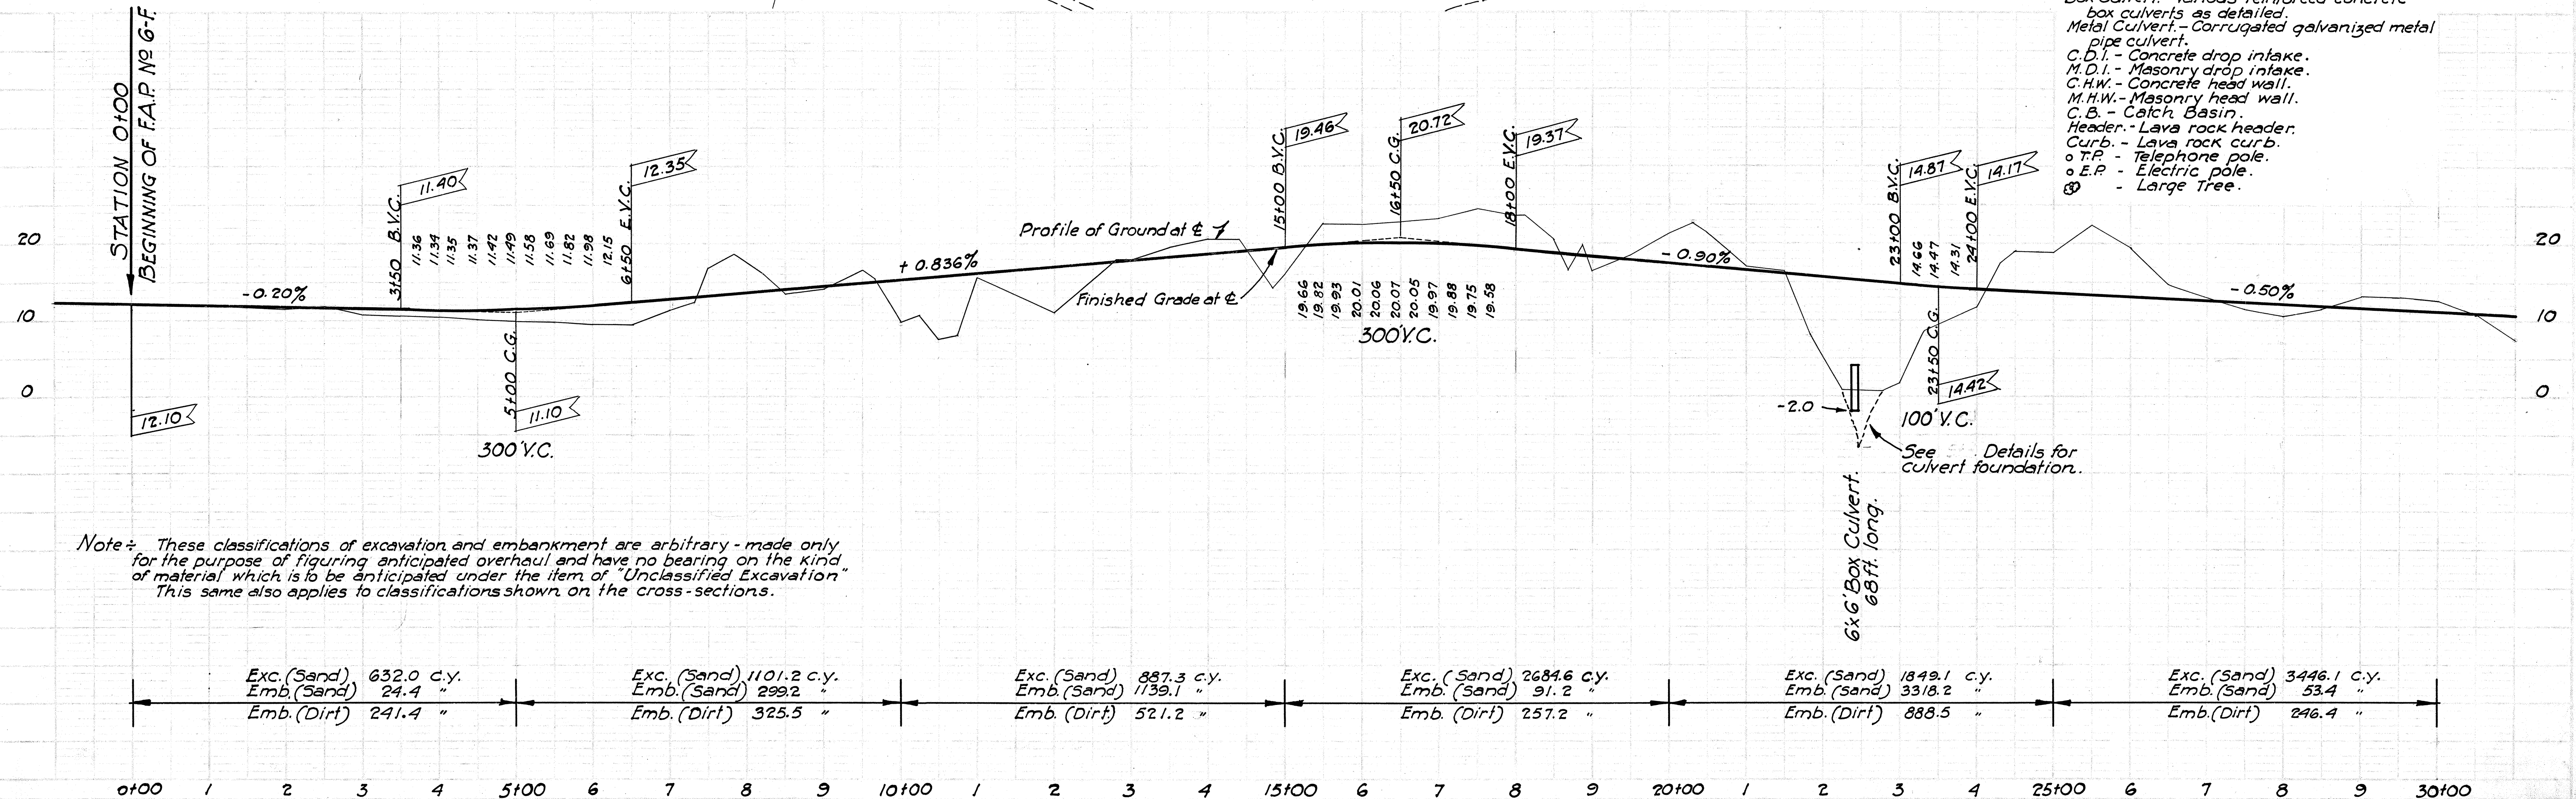

P A C I F I C O C E A N

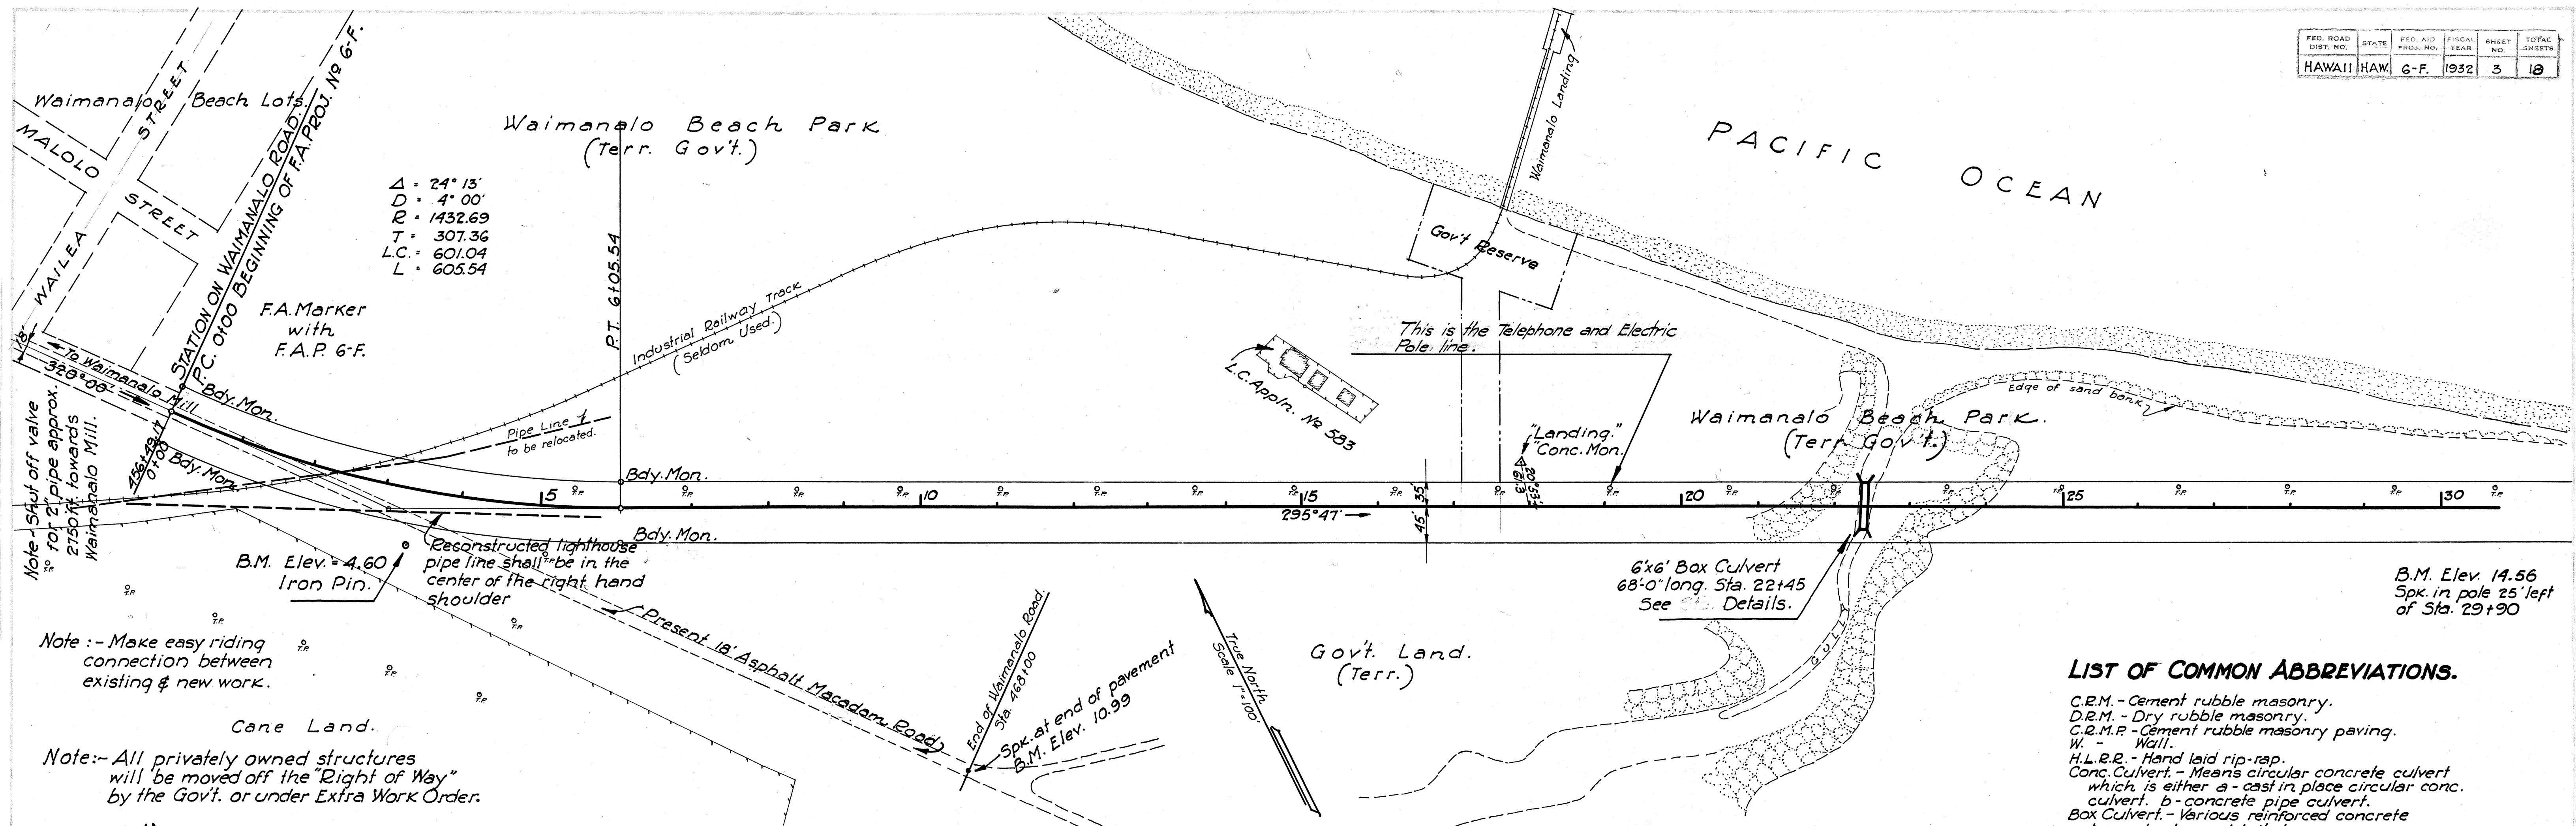