



FED. ROAD DIST. NO.	STATE	FED. AID PROJ. NO.	FISCAL YEAR	SHEET NO.	TOTAL SHEETS
HAWAII	HAWAII	6A	1932	4	8


Exc. Suitable for Emb.
Exc. to be wasted for Emb. Sandy.

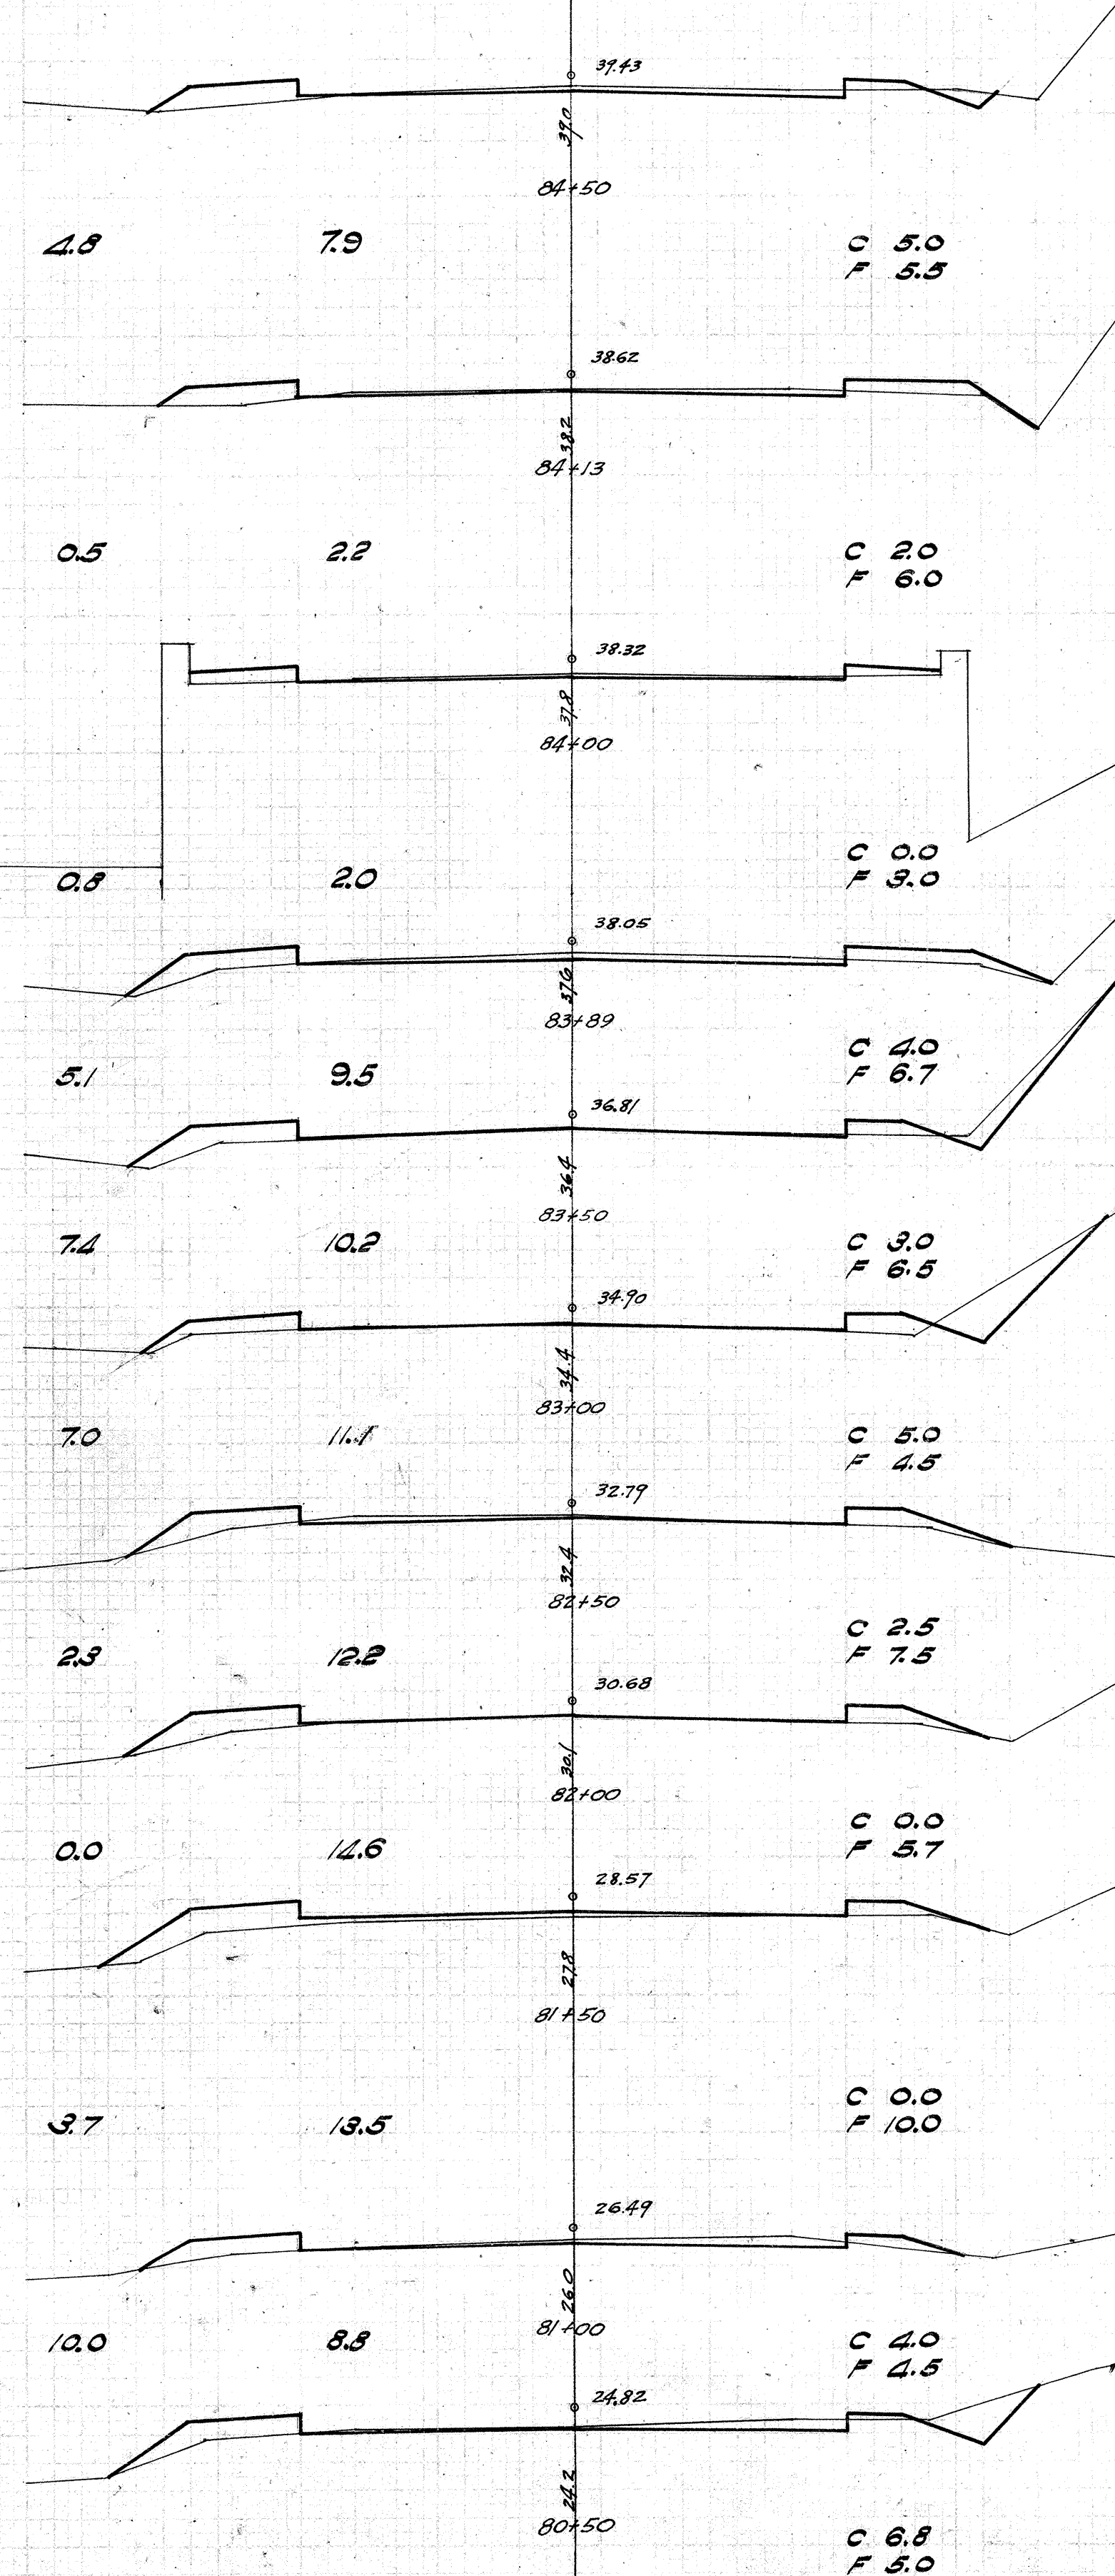

Exc. Suitable for Emb.
Exc. to be wasted for Emb. Sandy.

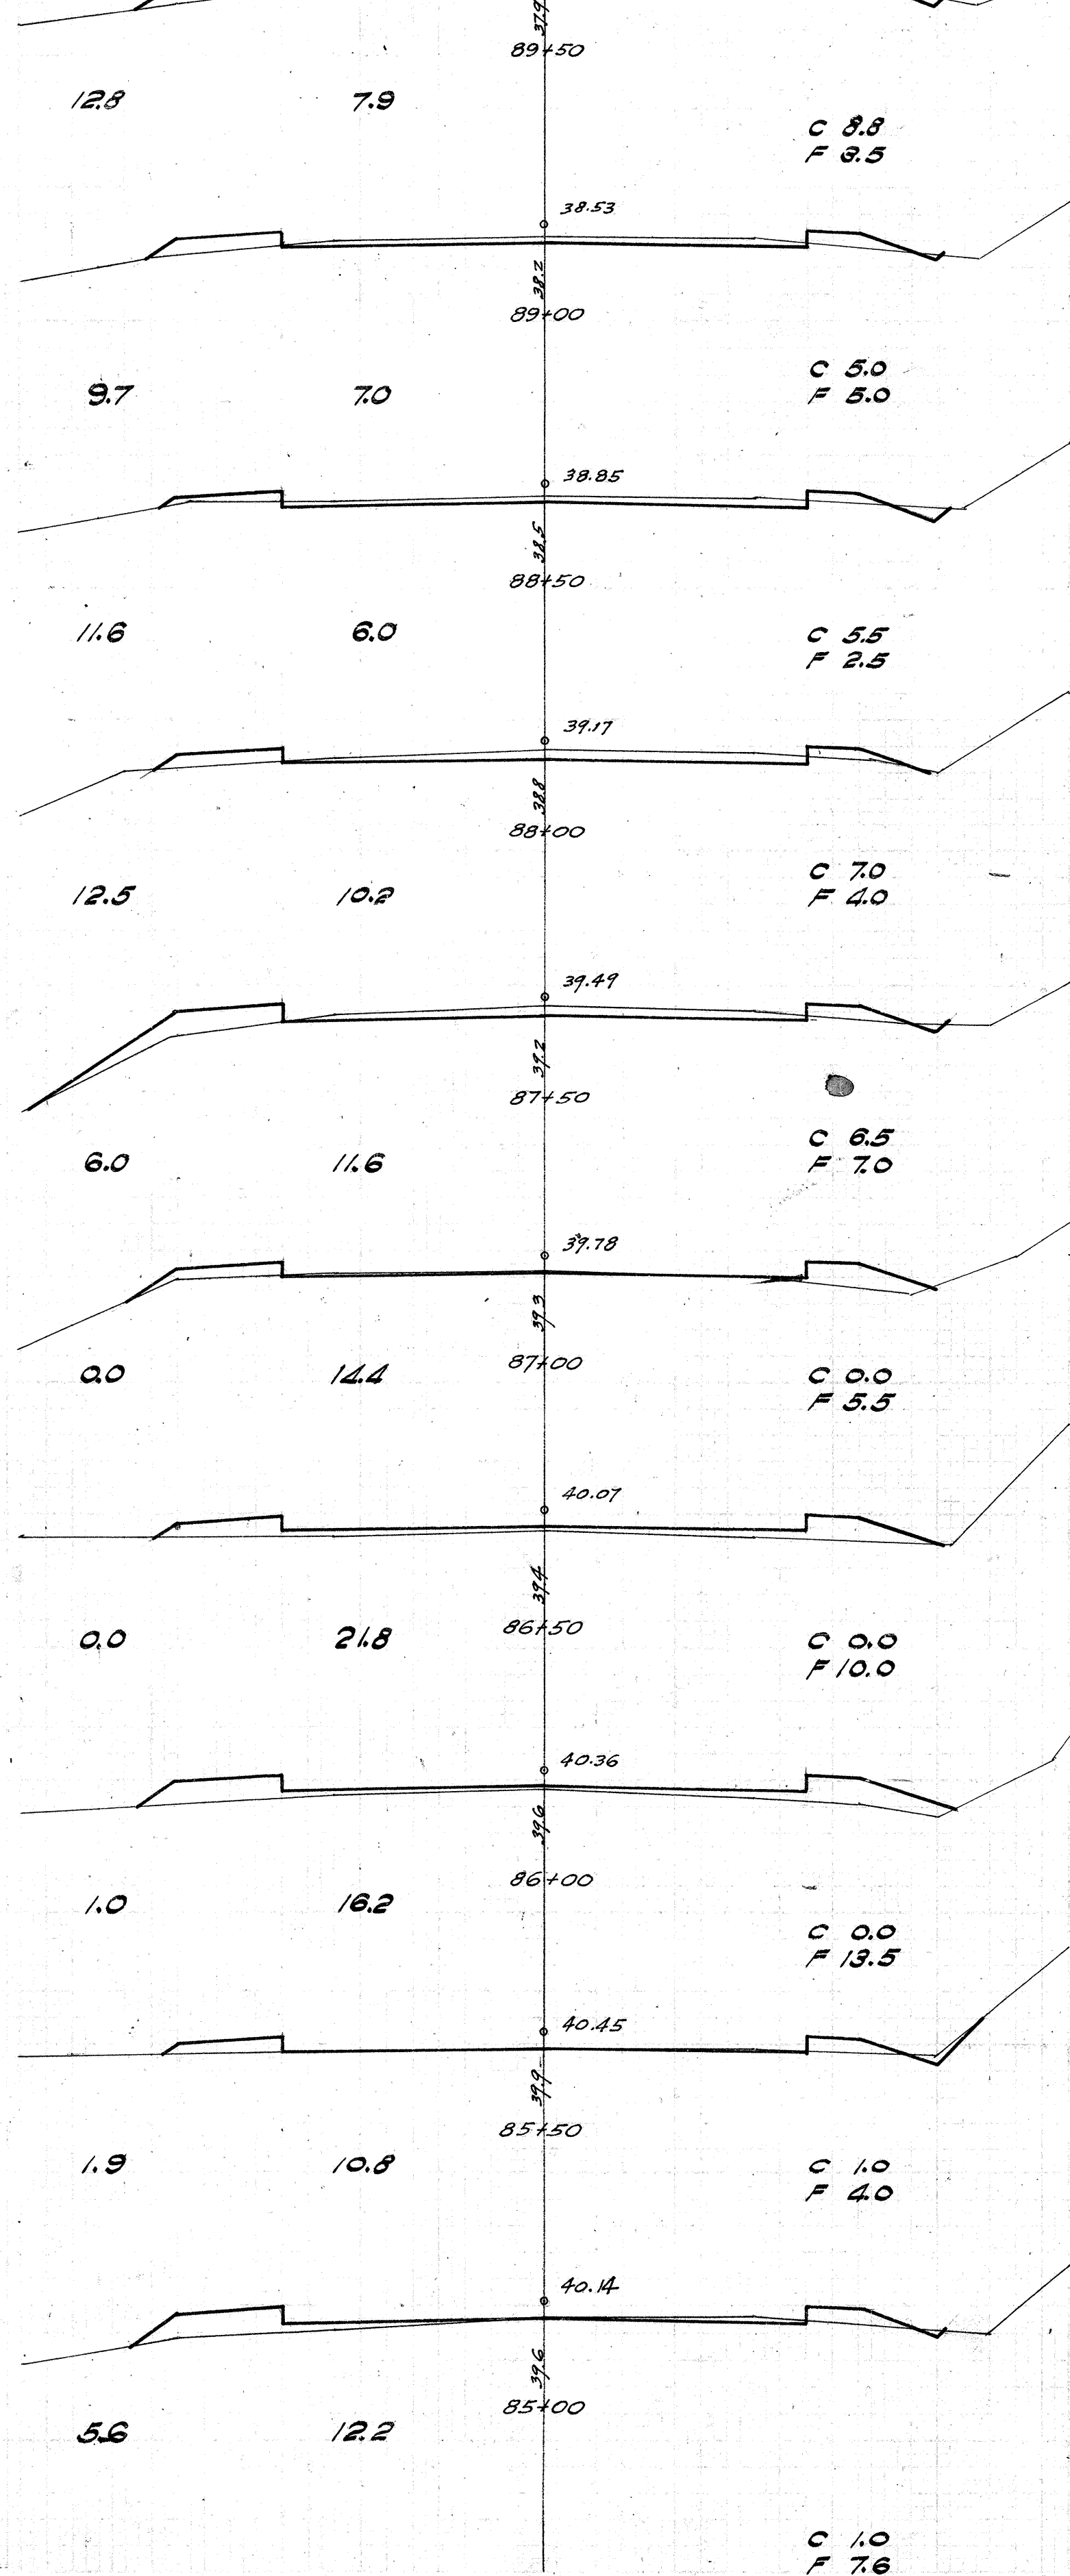


Exc. Suitable for Emb.
Exc. to be wasted for Emb. Sandy.

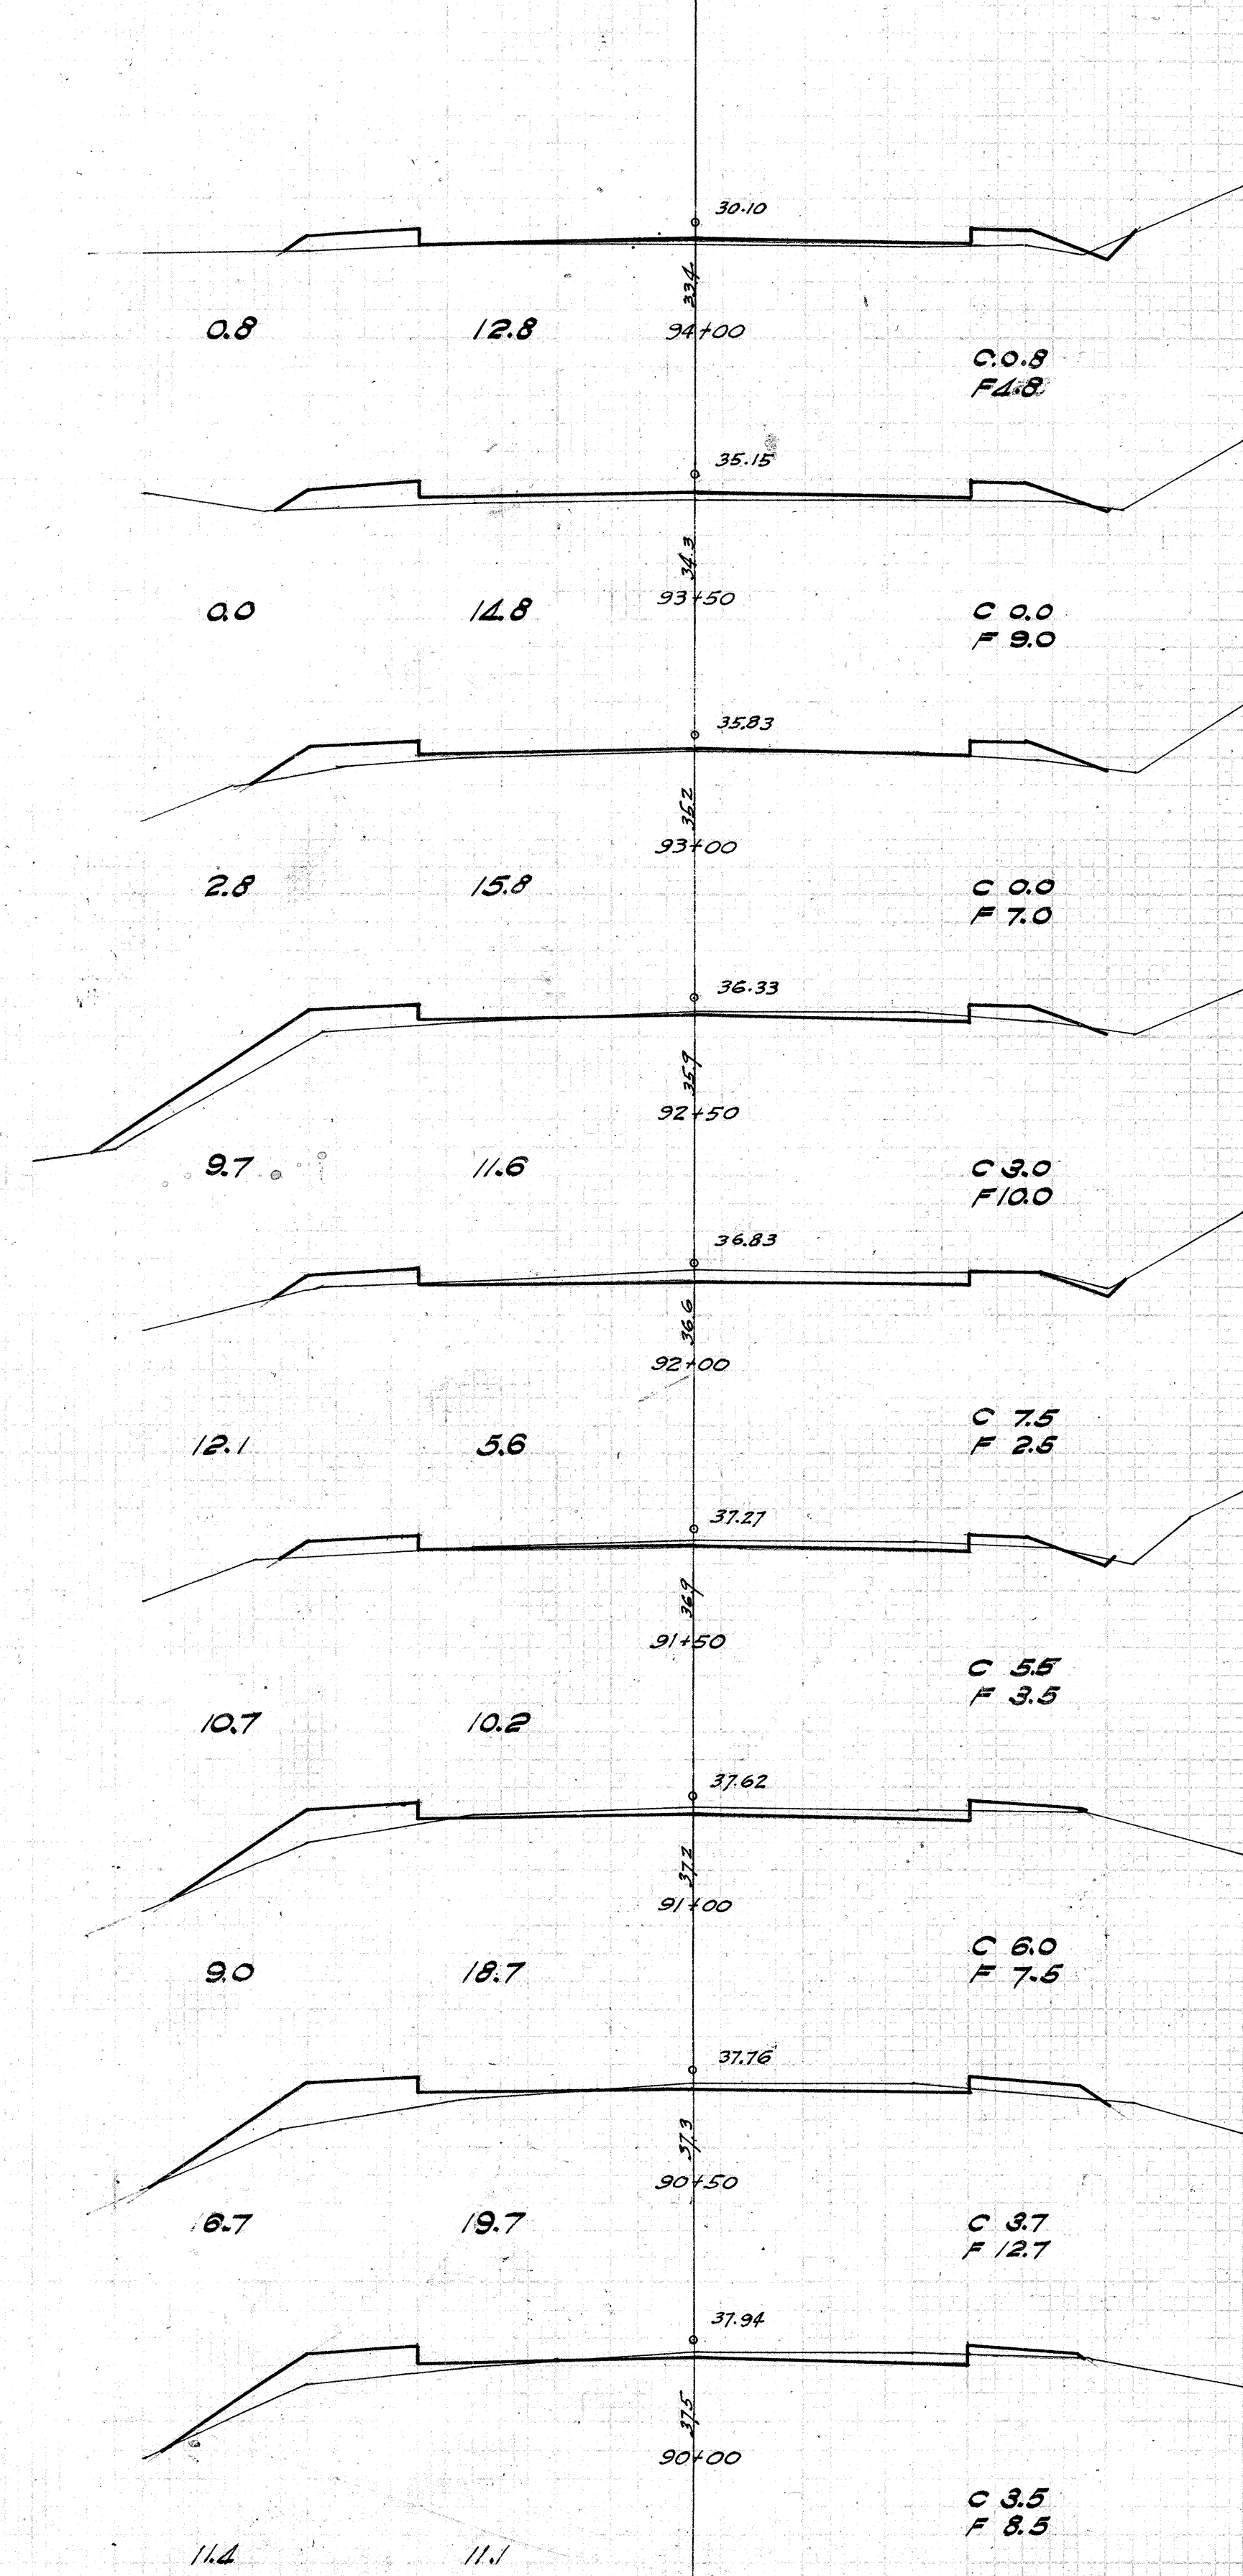


6 14 4

4245.4


Exc. Exc. to be Emb.
Suitable Wasted.
for Emb. Sandy.

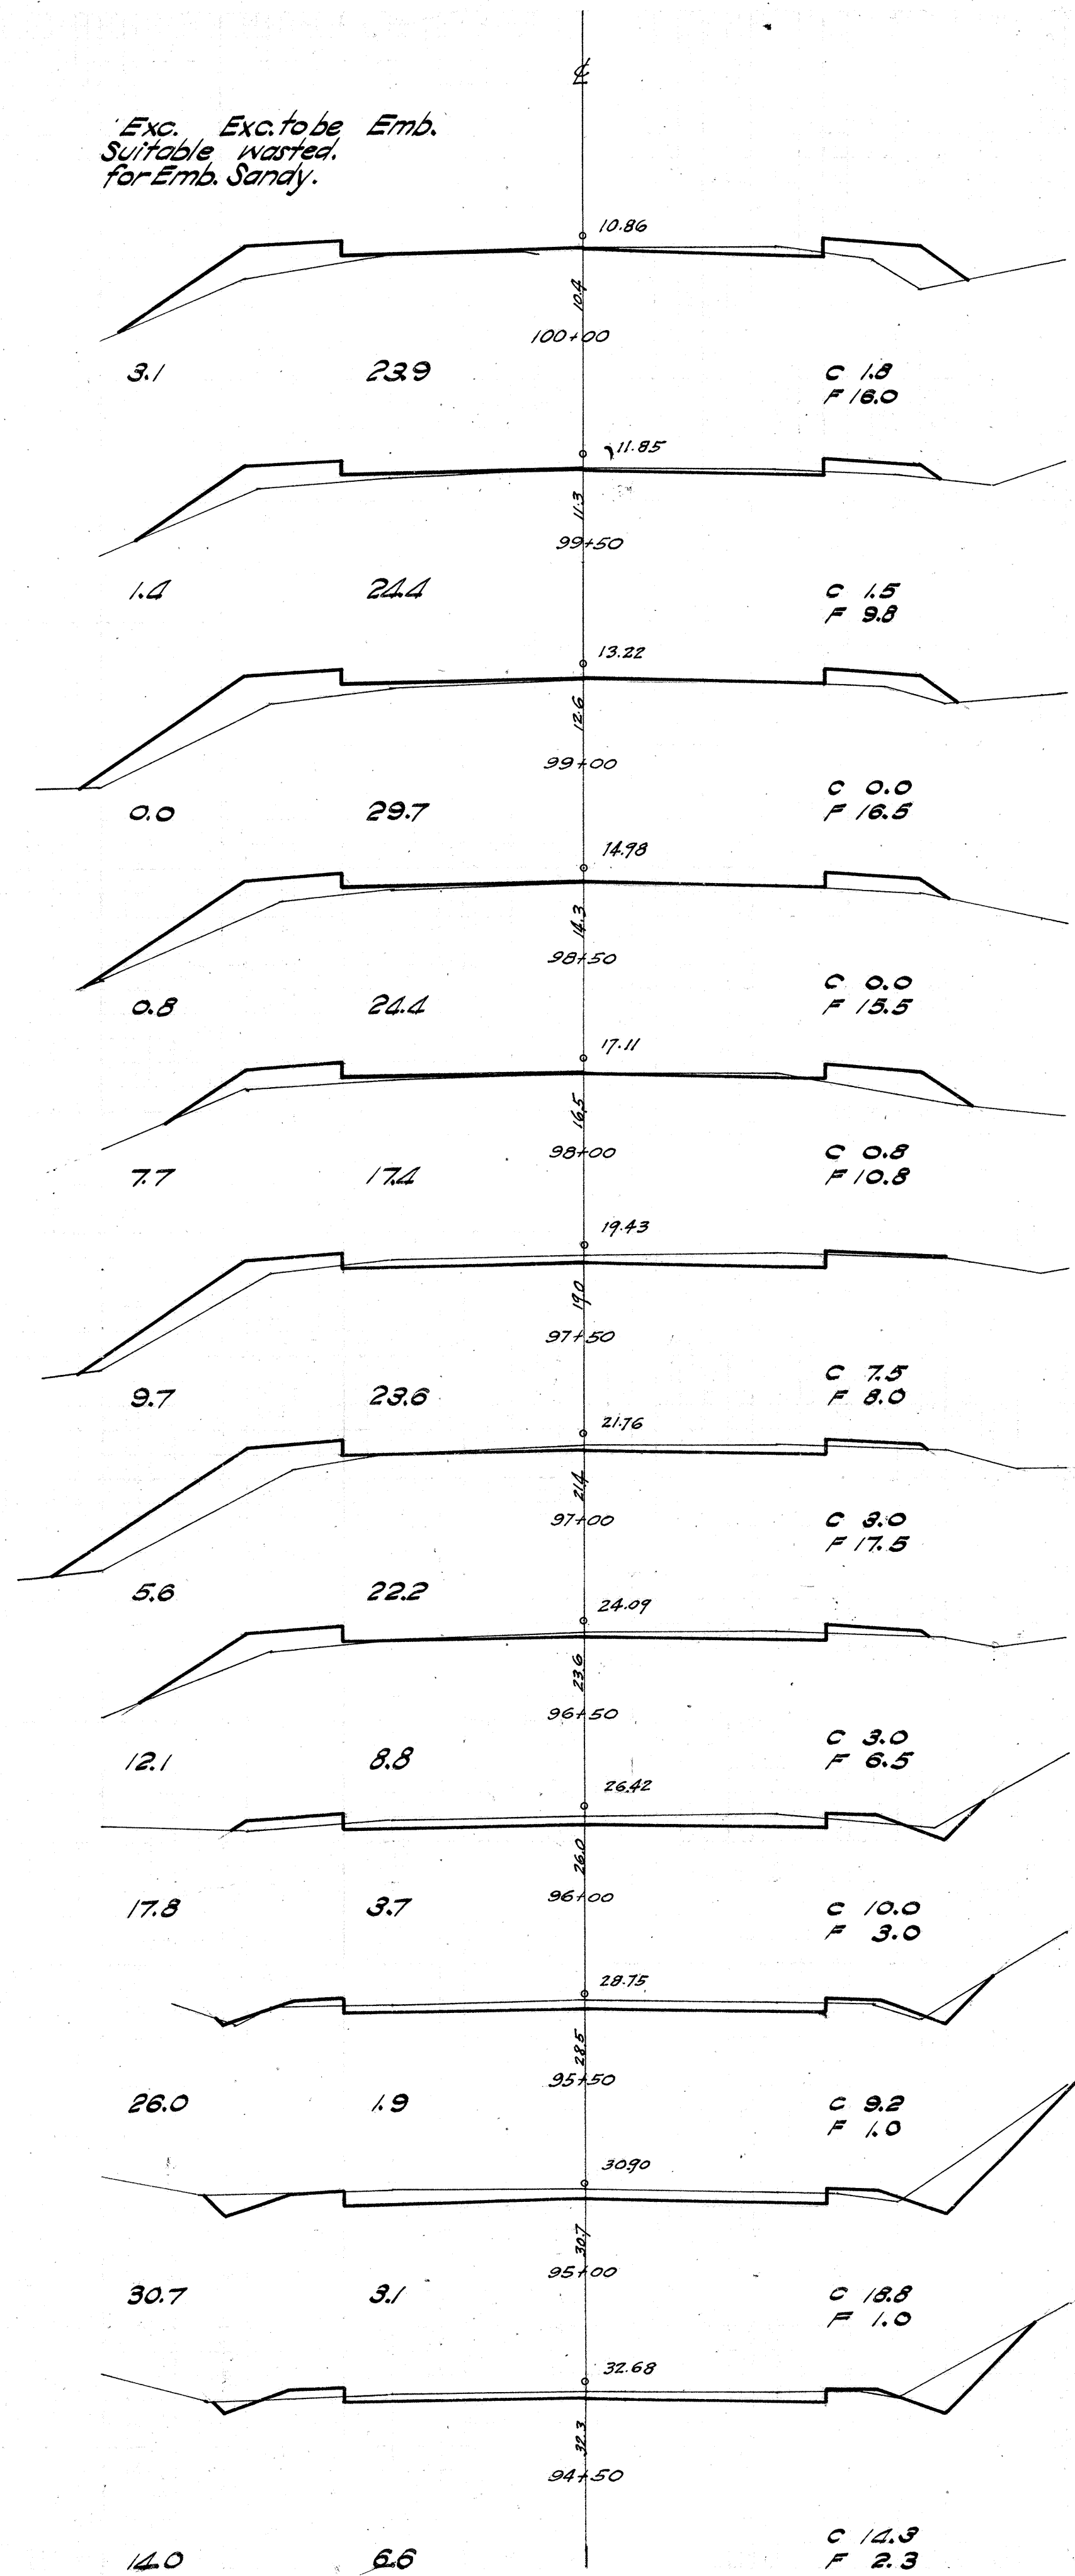


Exc. Exc. to be Emb.
Suitable Wasted.
for Emb. Sandy.

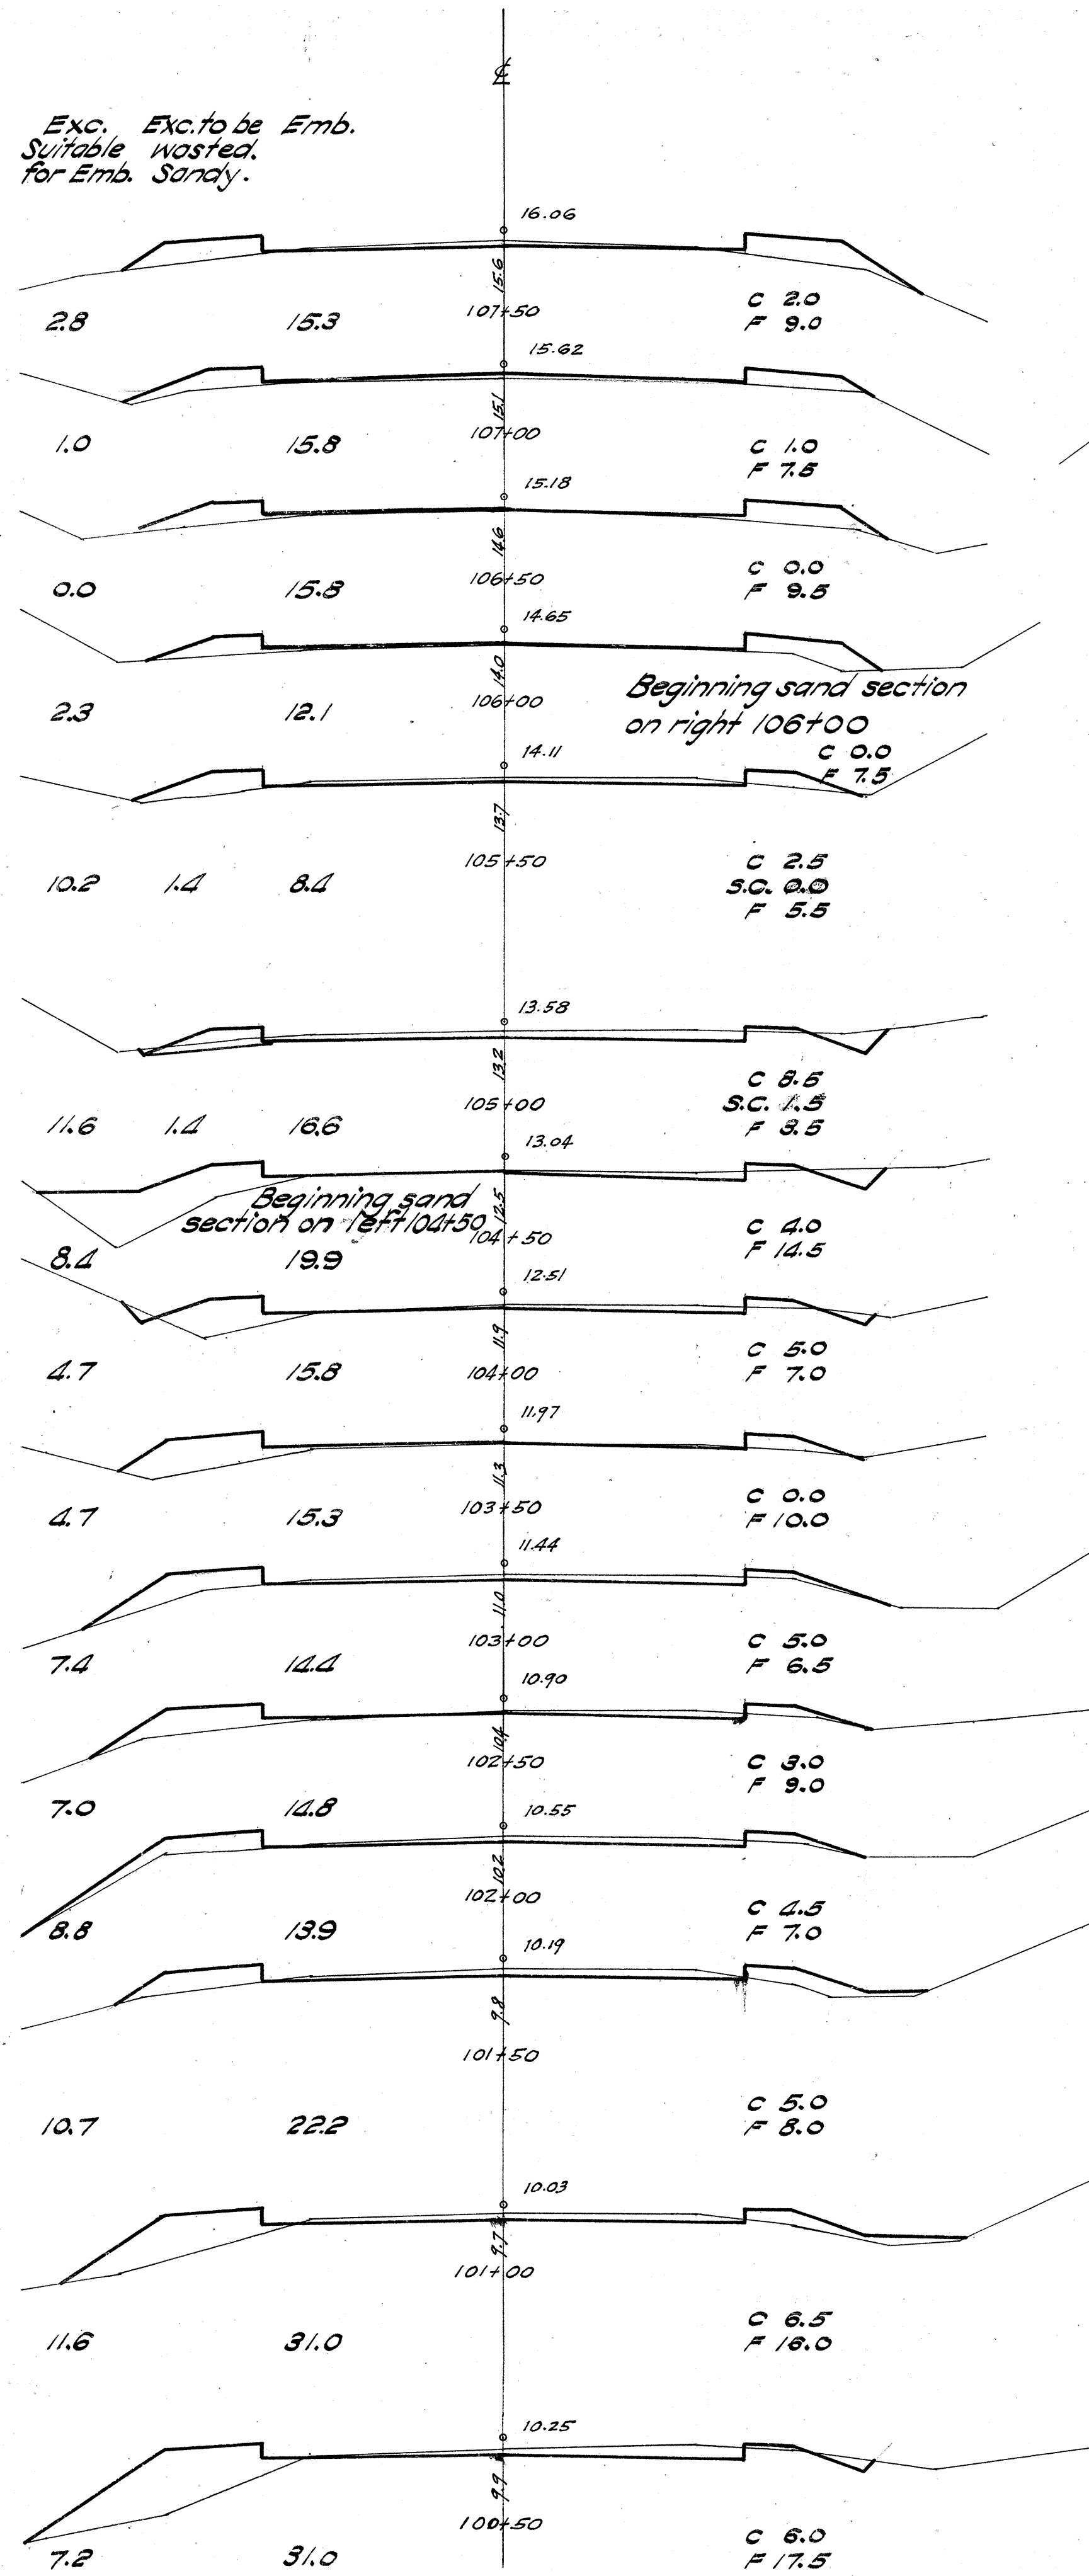


Exc. Exc. to be Emb.
Suitable Wasted.
for Emb. Sandy.

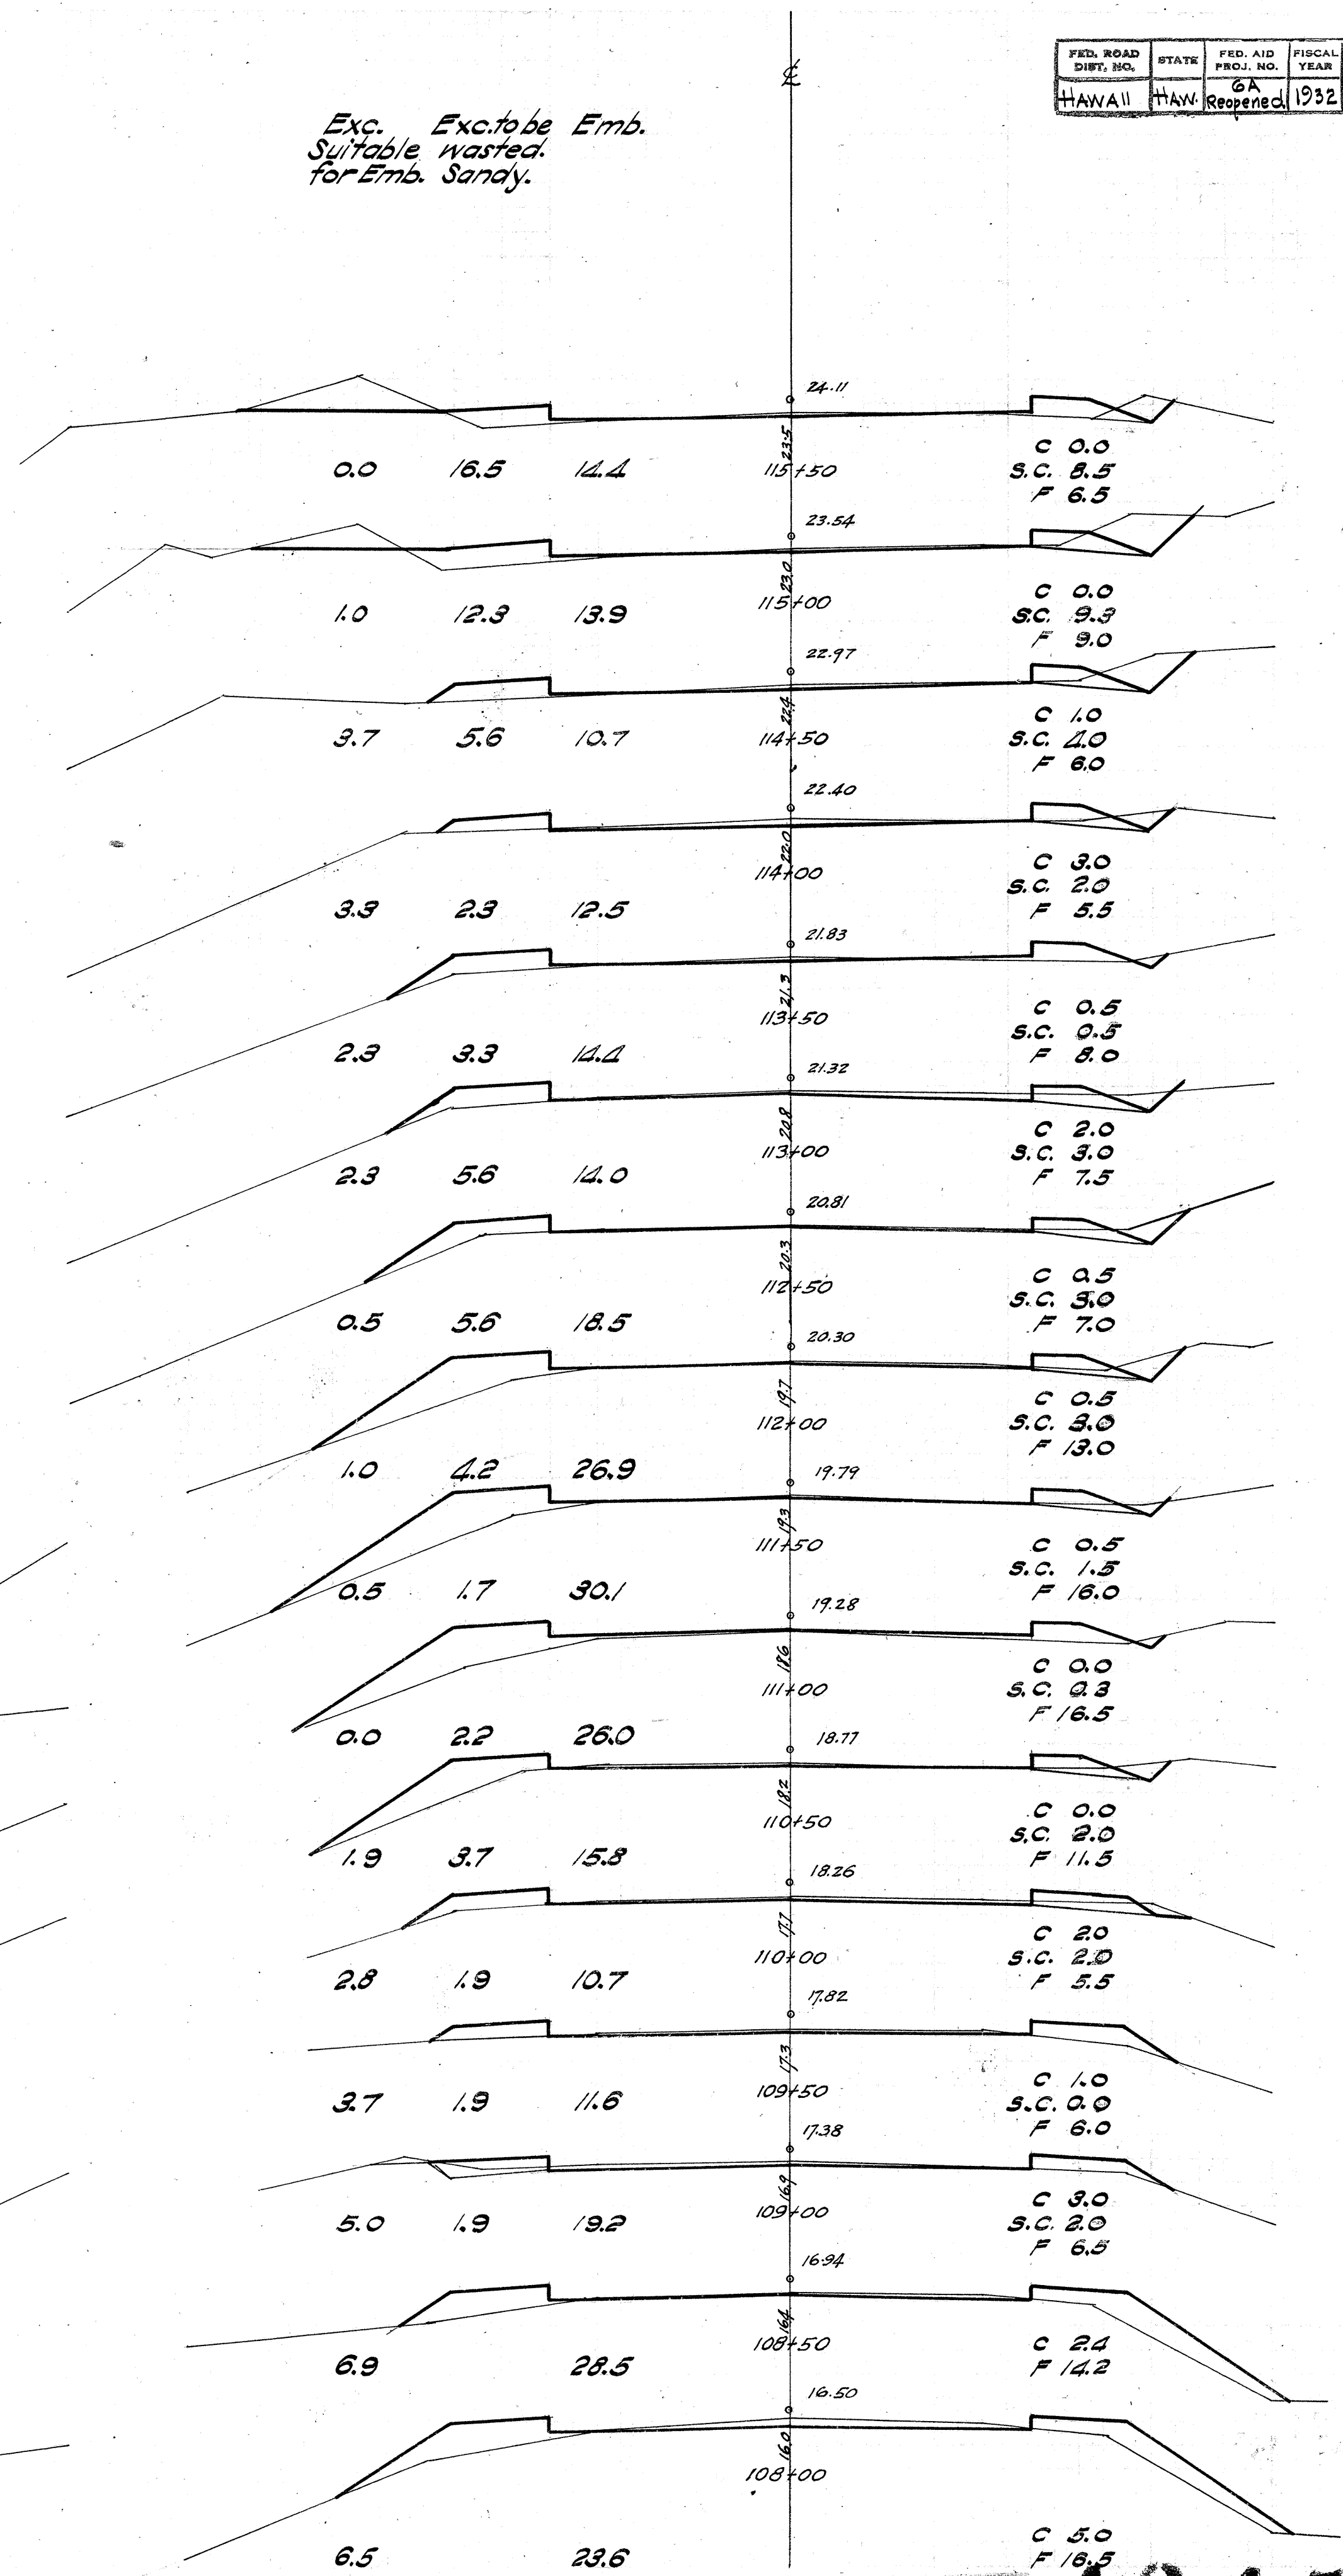


Exc. Exc.to be Emb.
Suitable Wasted. for Emb. Sandy

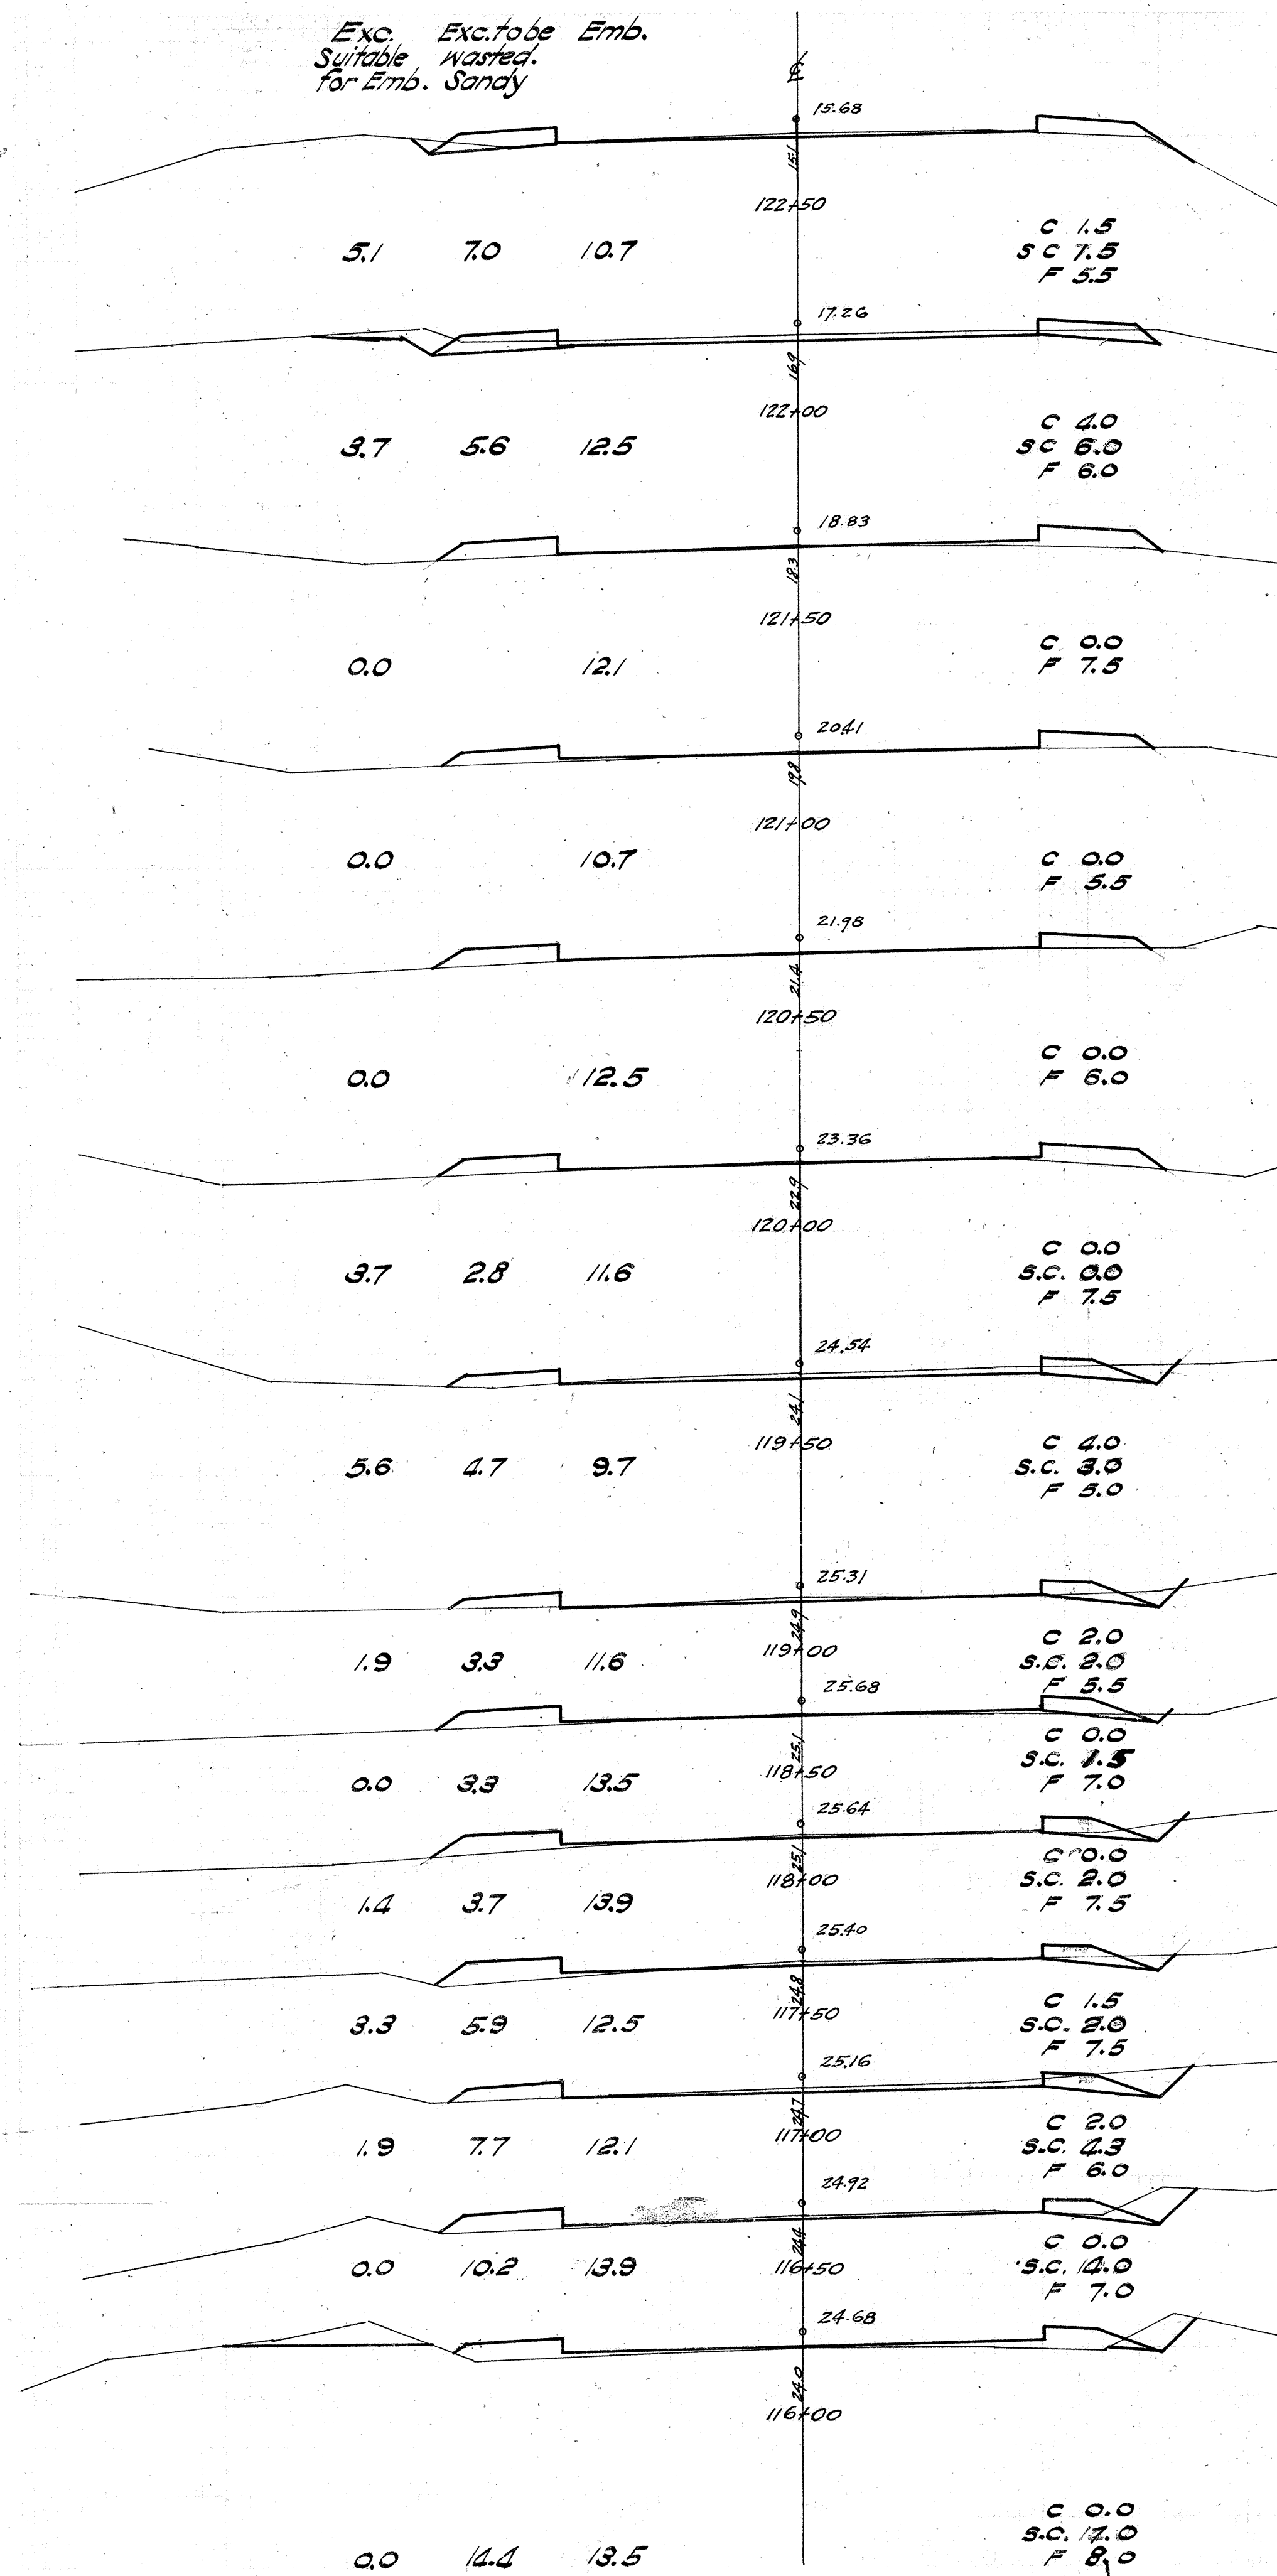

Exc. Exc.to be Emb.
Suitable Wasted. for Emb. Sandy

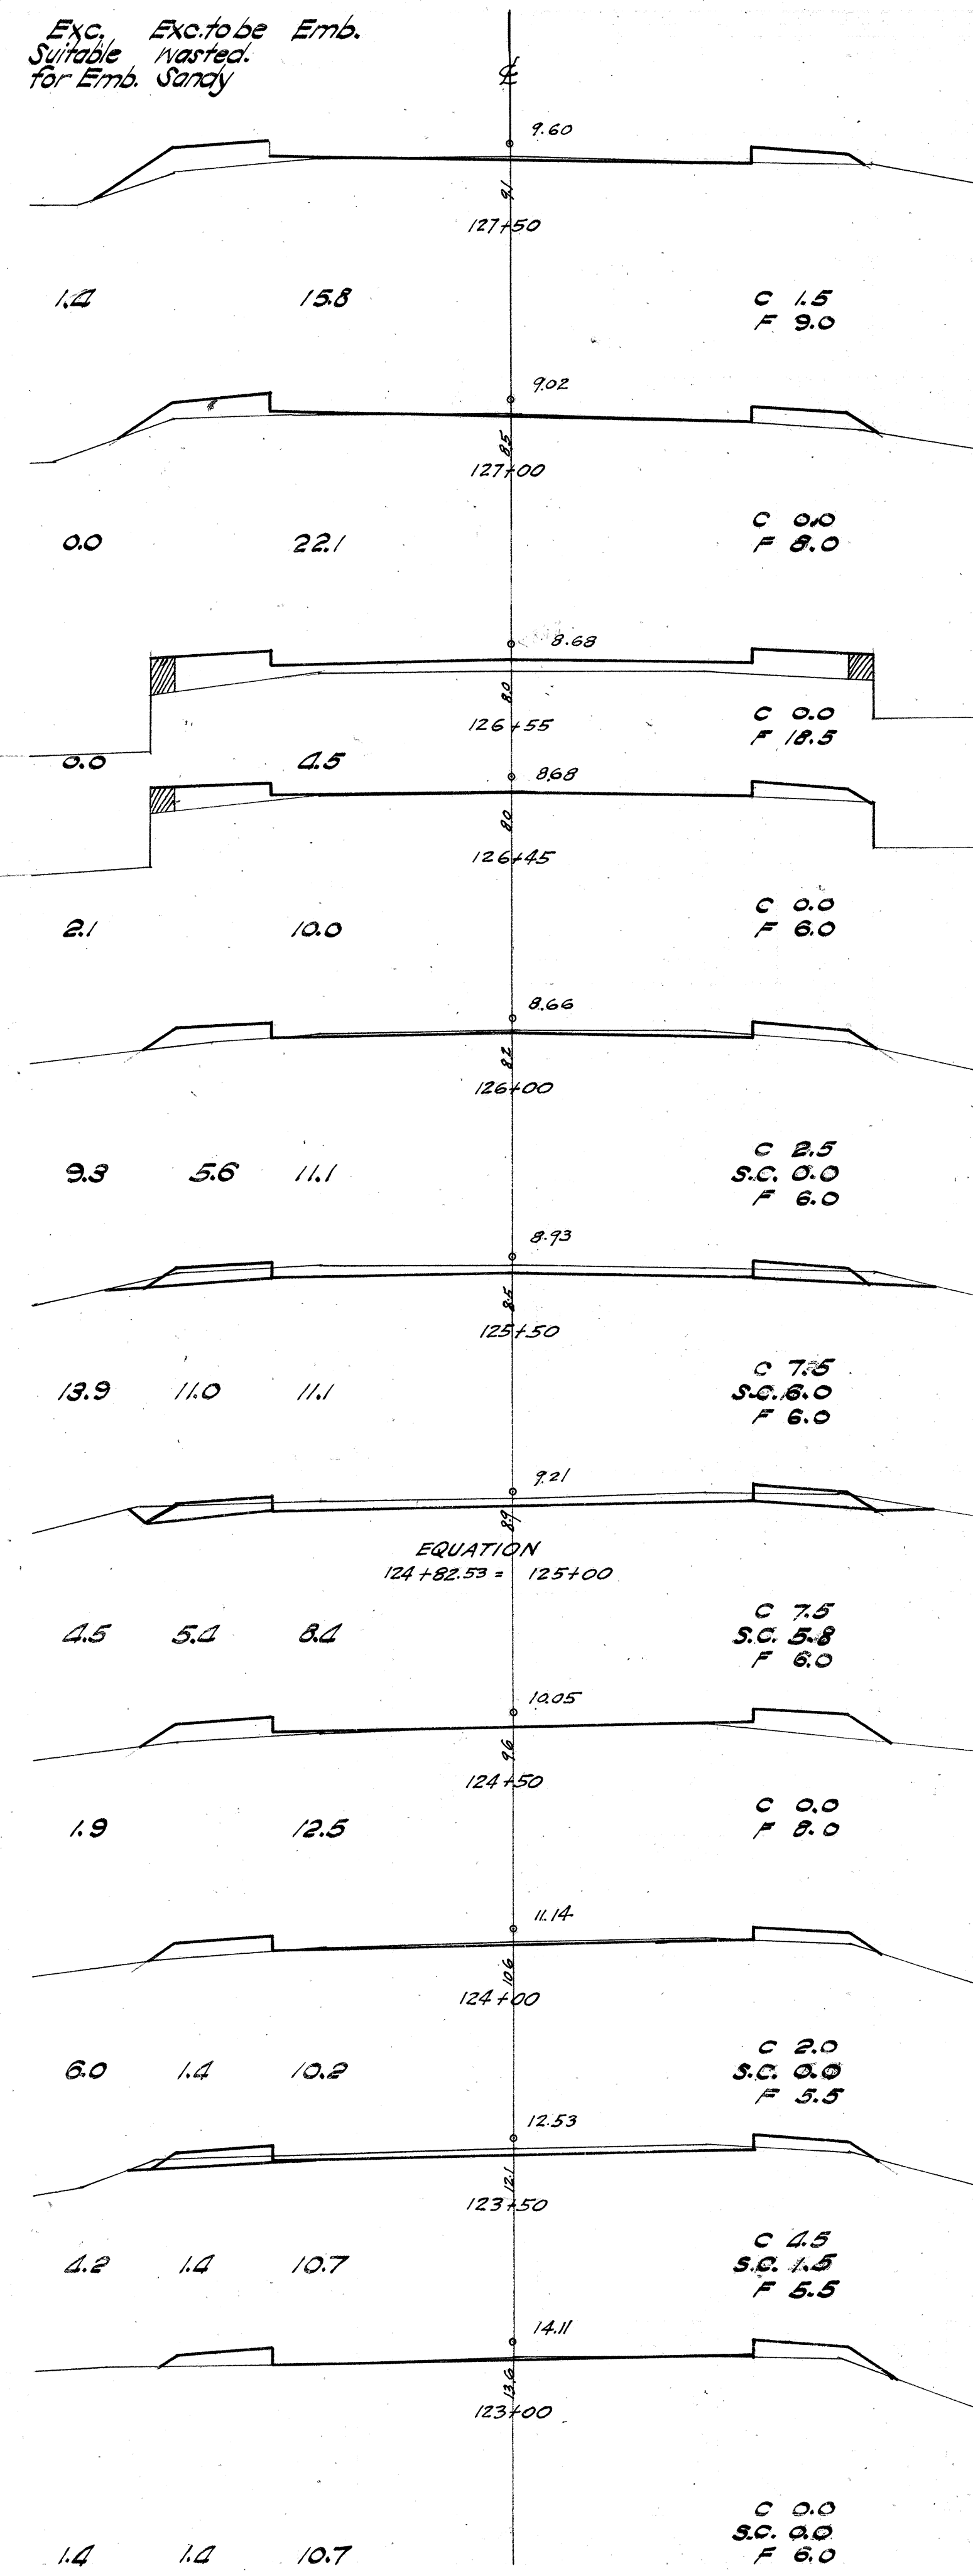


Exc. Exc.to be Emb.
Suitable Wasted. for Emb. Sandy

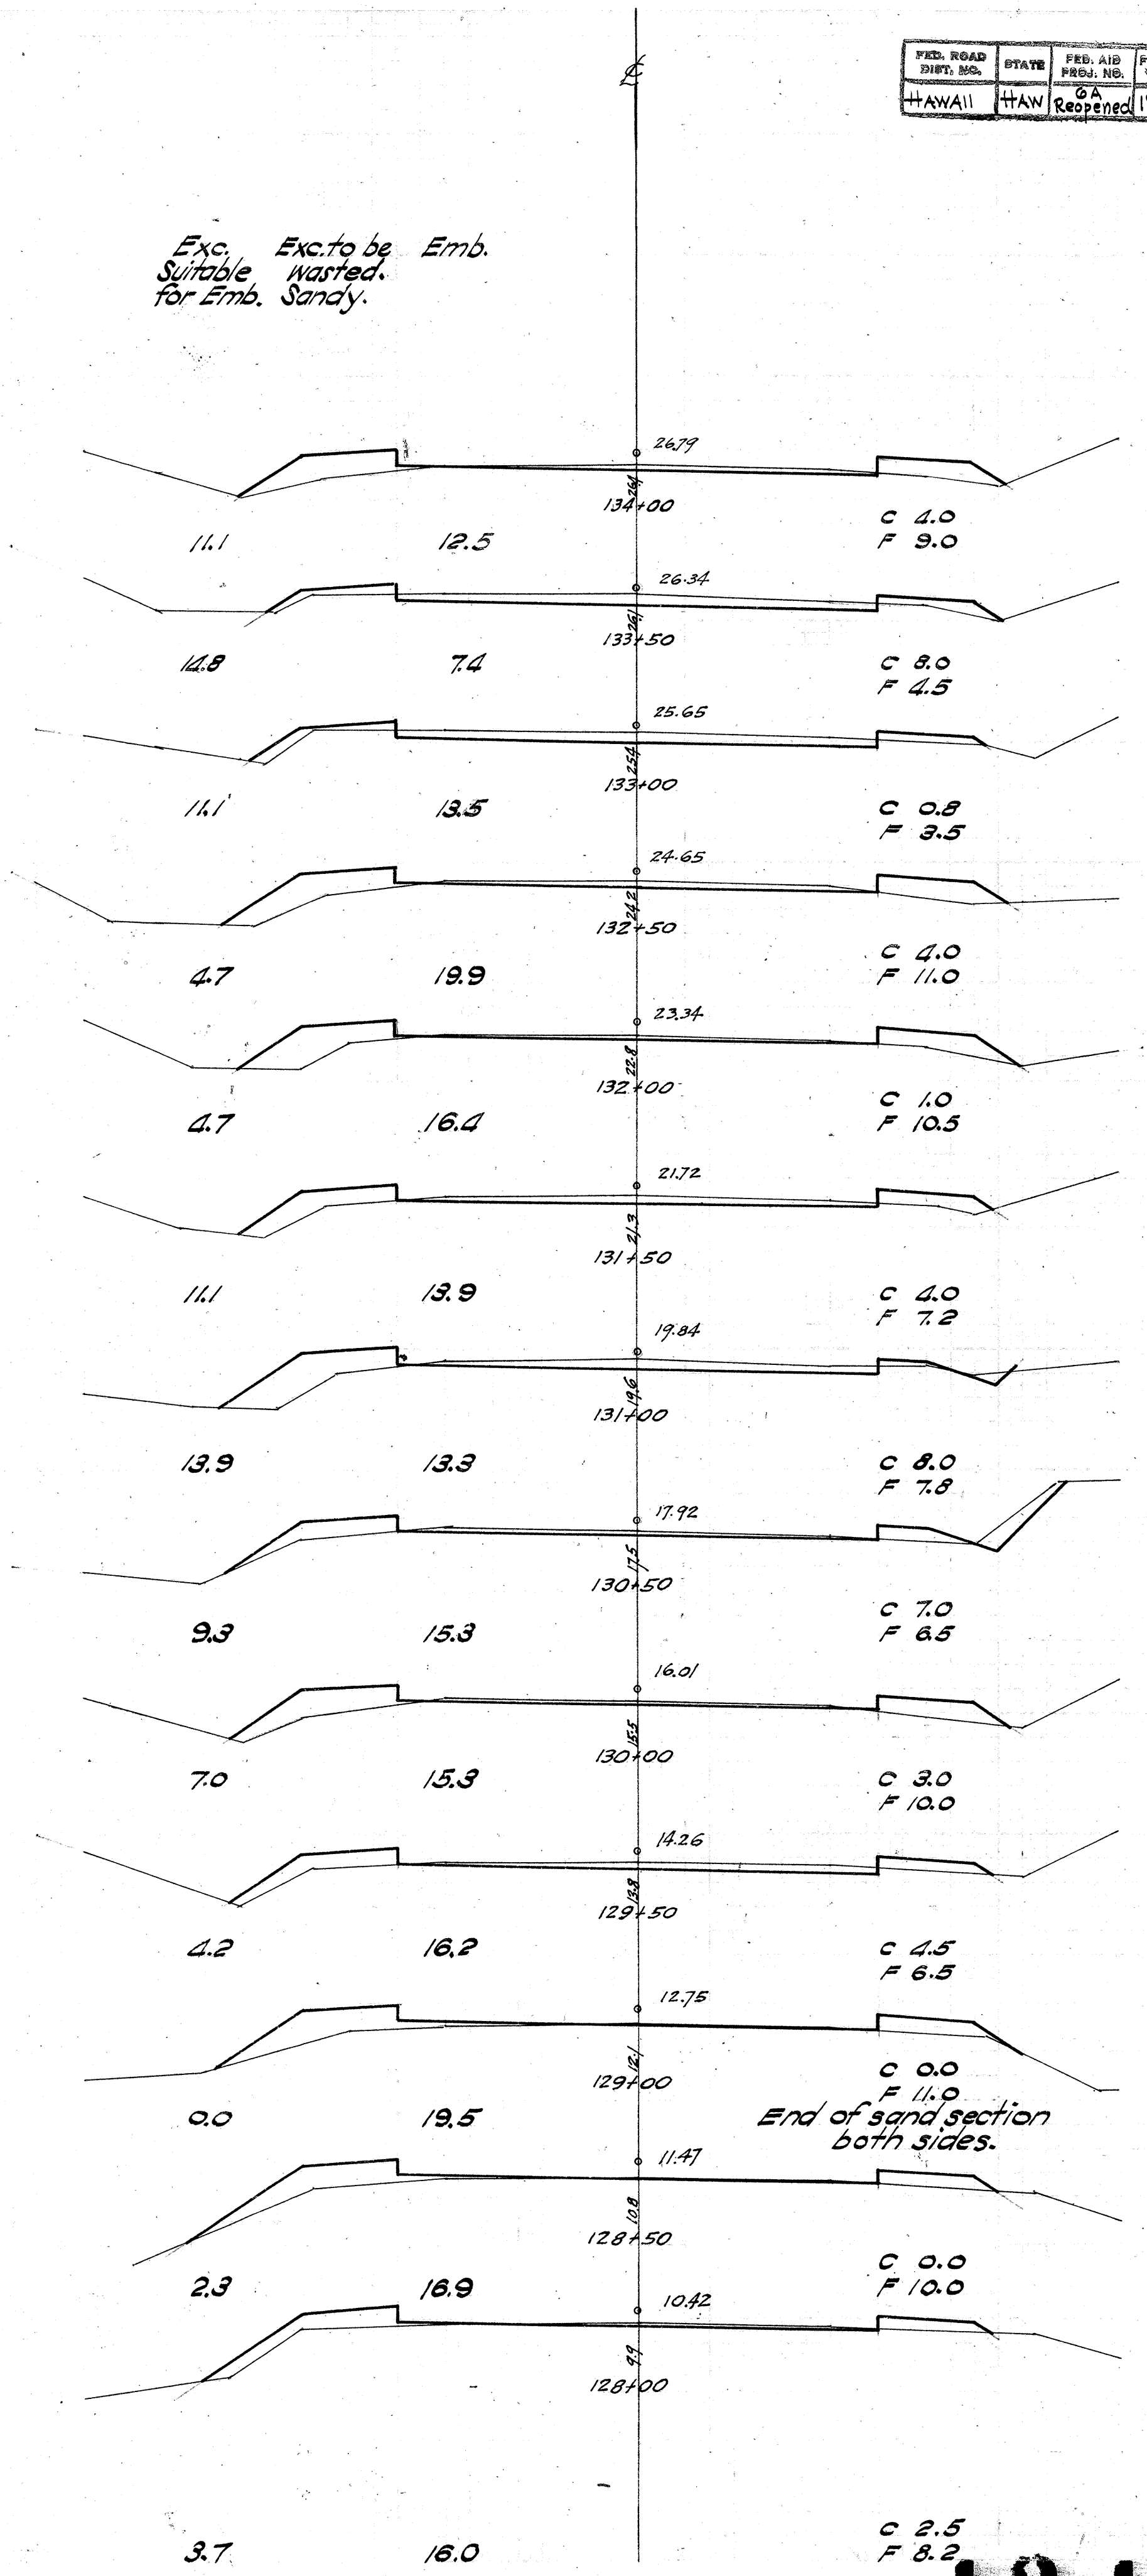


FED. ROAD DIST. NO.	STATE	FED. AID PROJ. NO.	FISCAL YEAR	SHEET NO.	TOTAL SHEETS
HAWAII	HAW	6A Reopened	1932	6	8


Exc. Exc.to be Emb.
Suitable wasted. For Emb. Sandy.

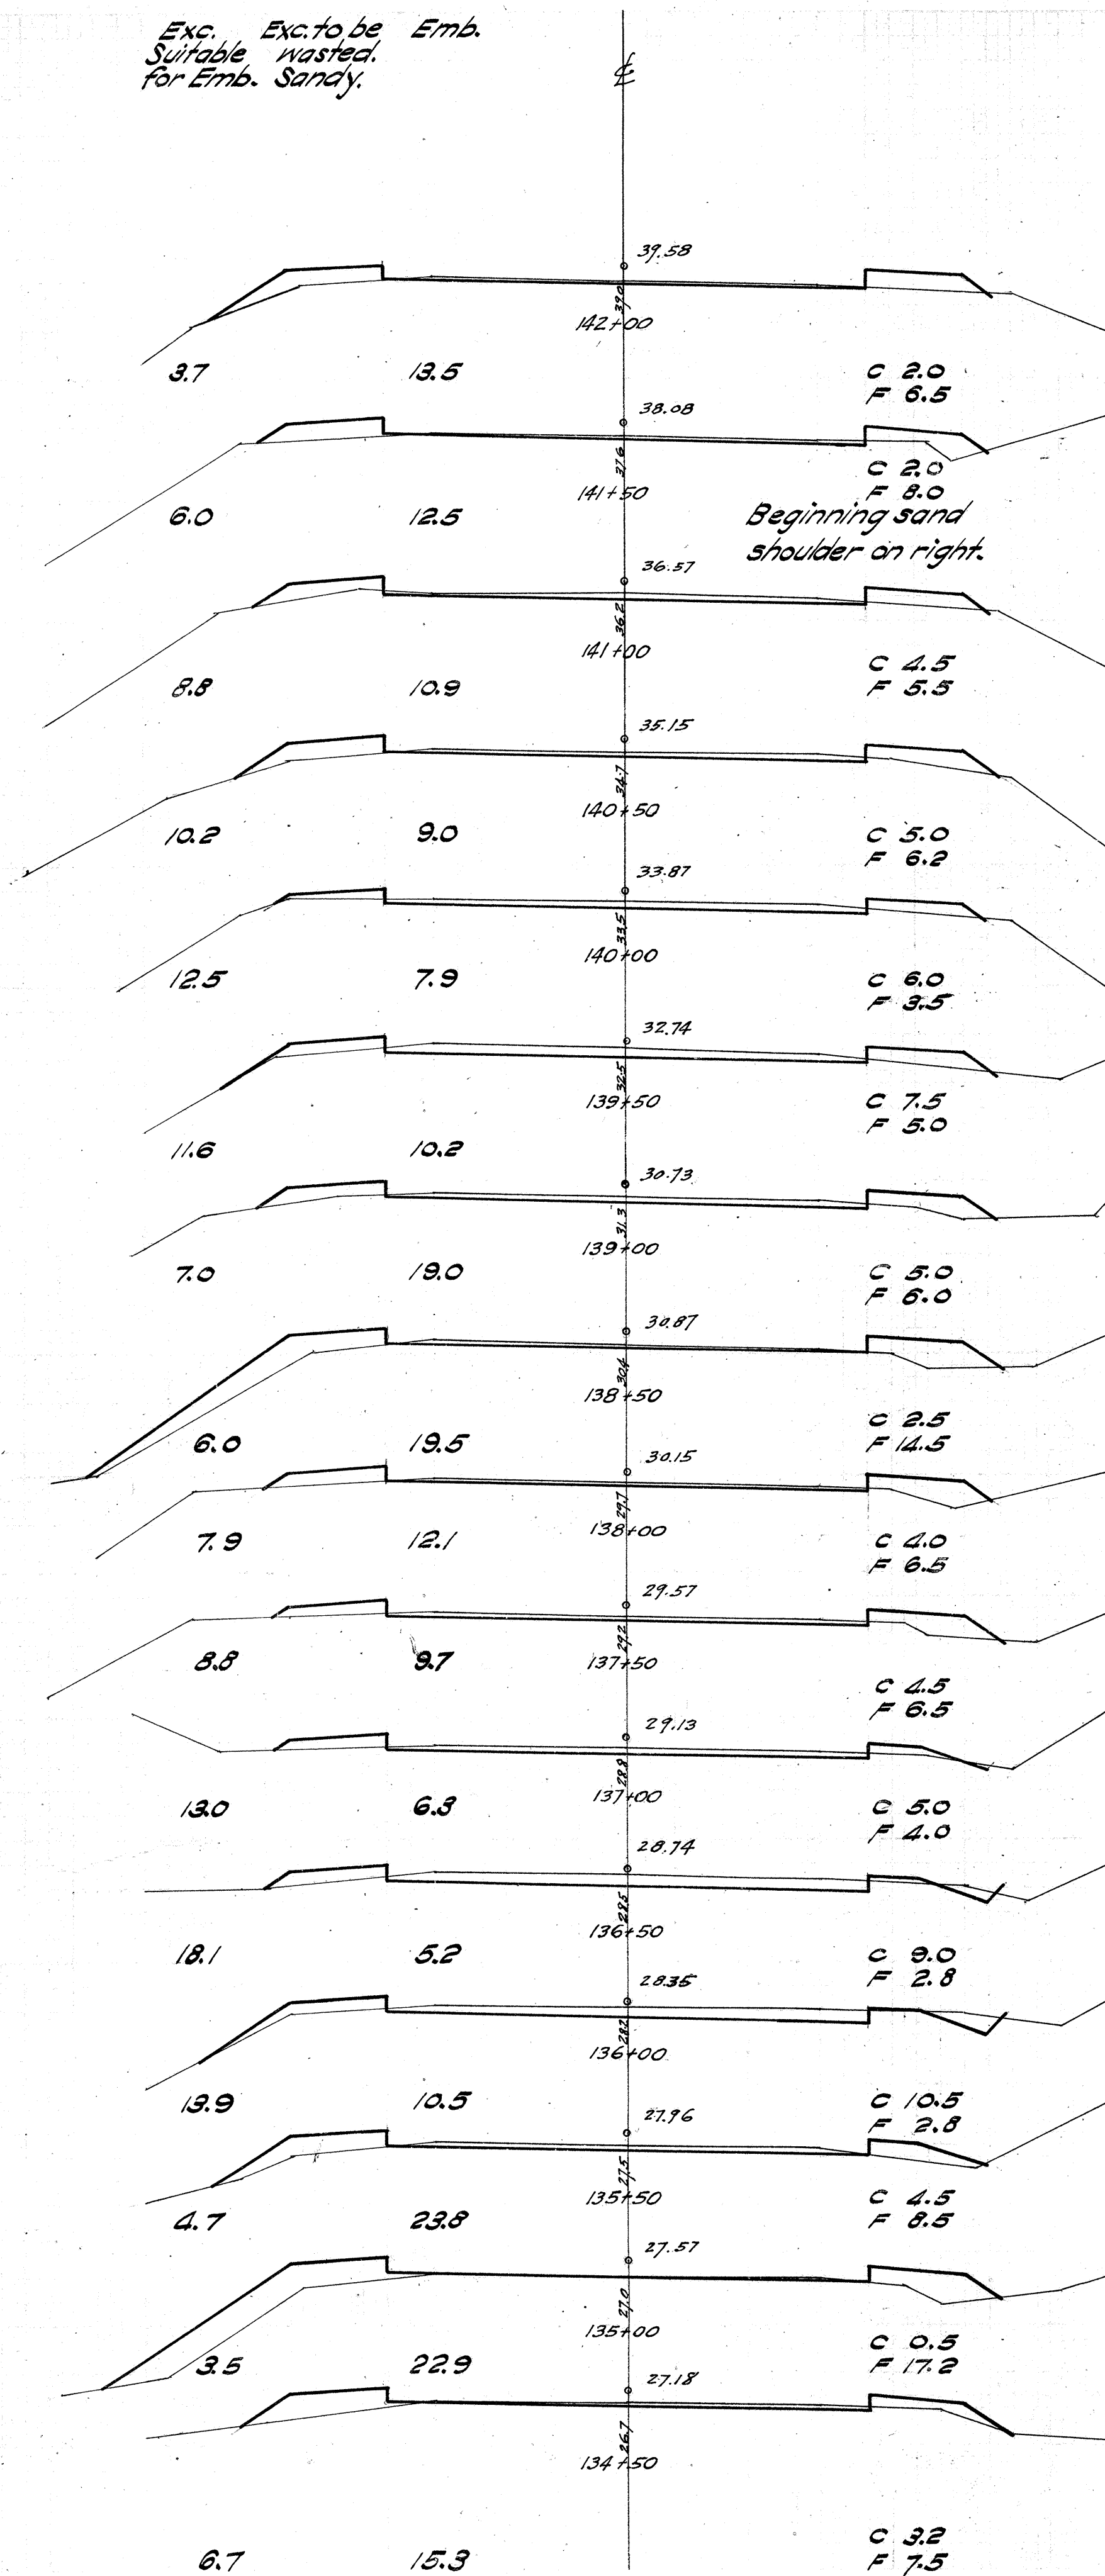

Exc. Exc.to be Emb.
Suitable wasted. For Emb. Sandy.

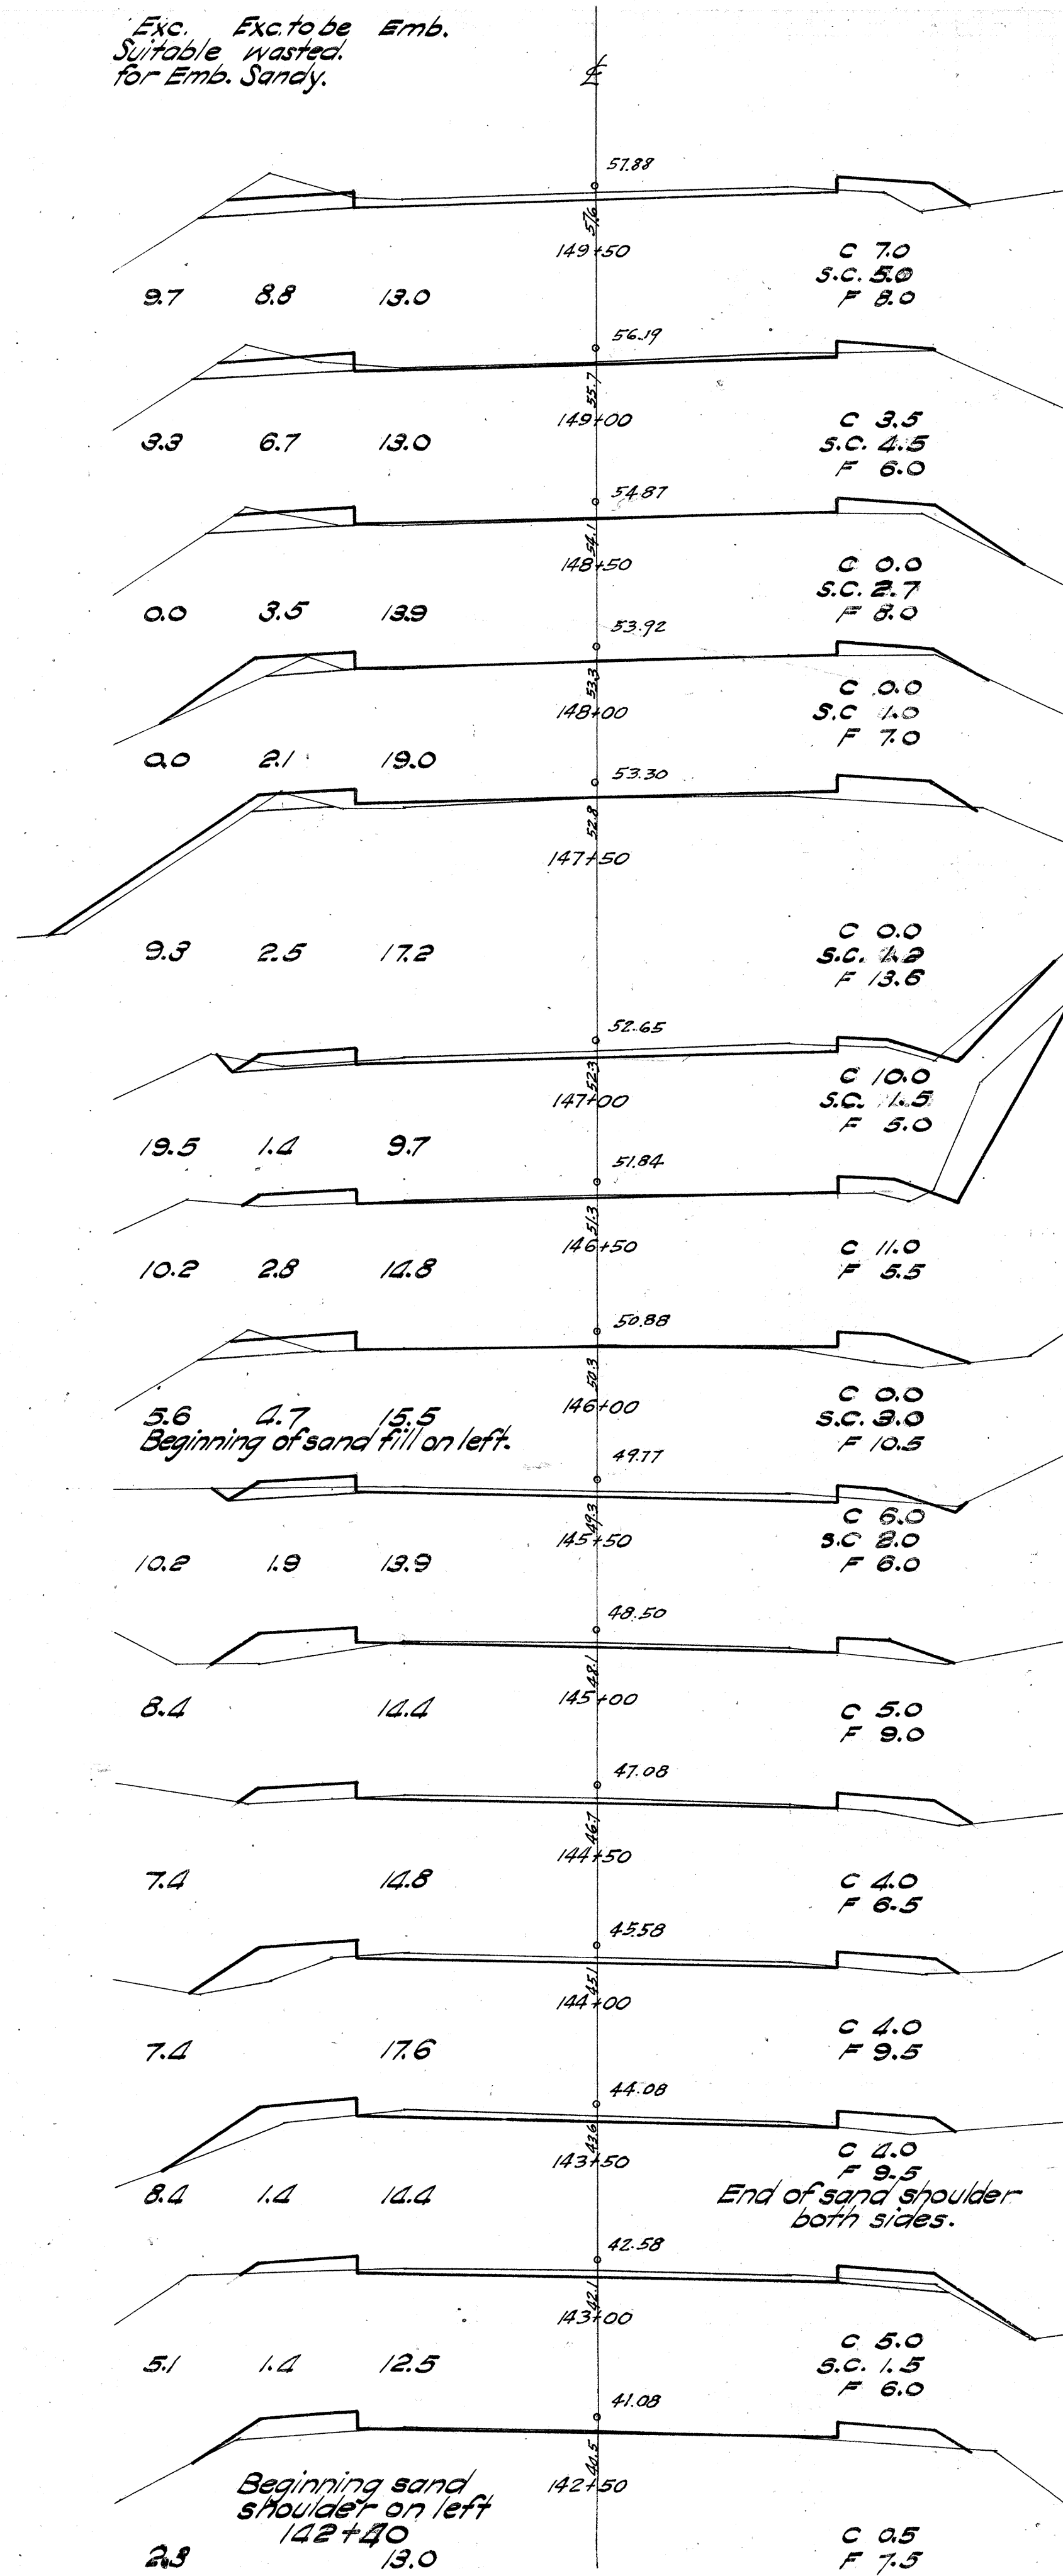


Exc. Exc.to be Emb.
Suitable wasted. For Emb. Sandy.

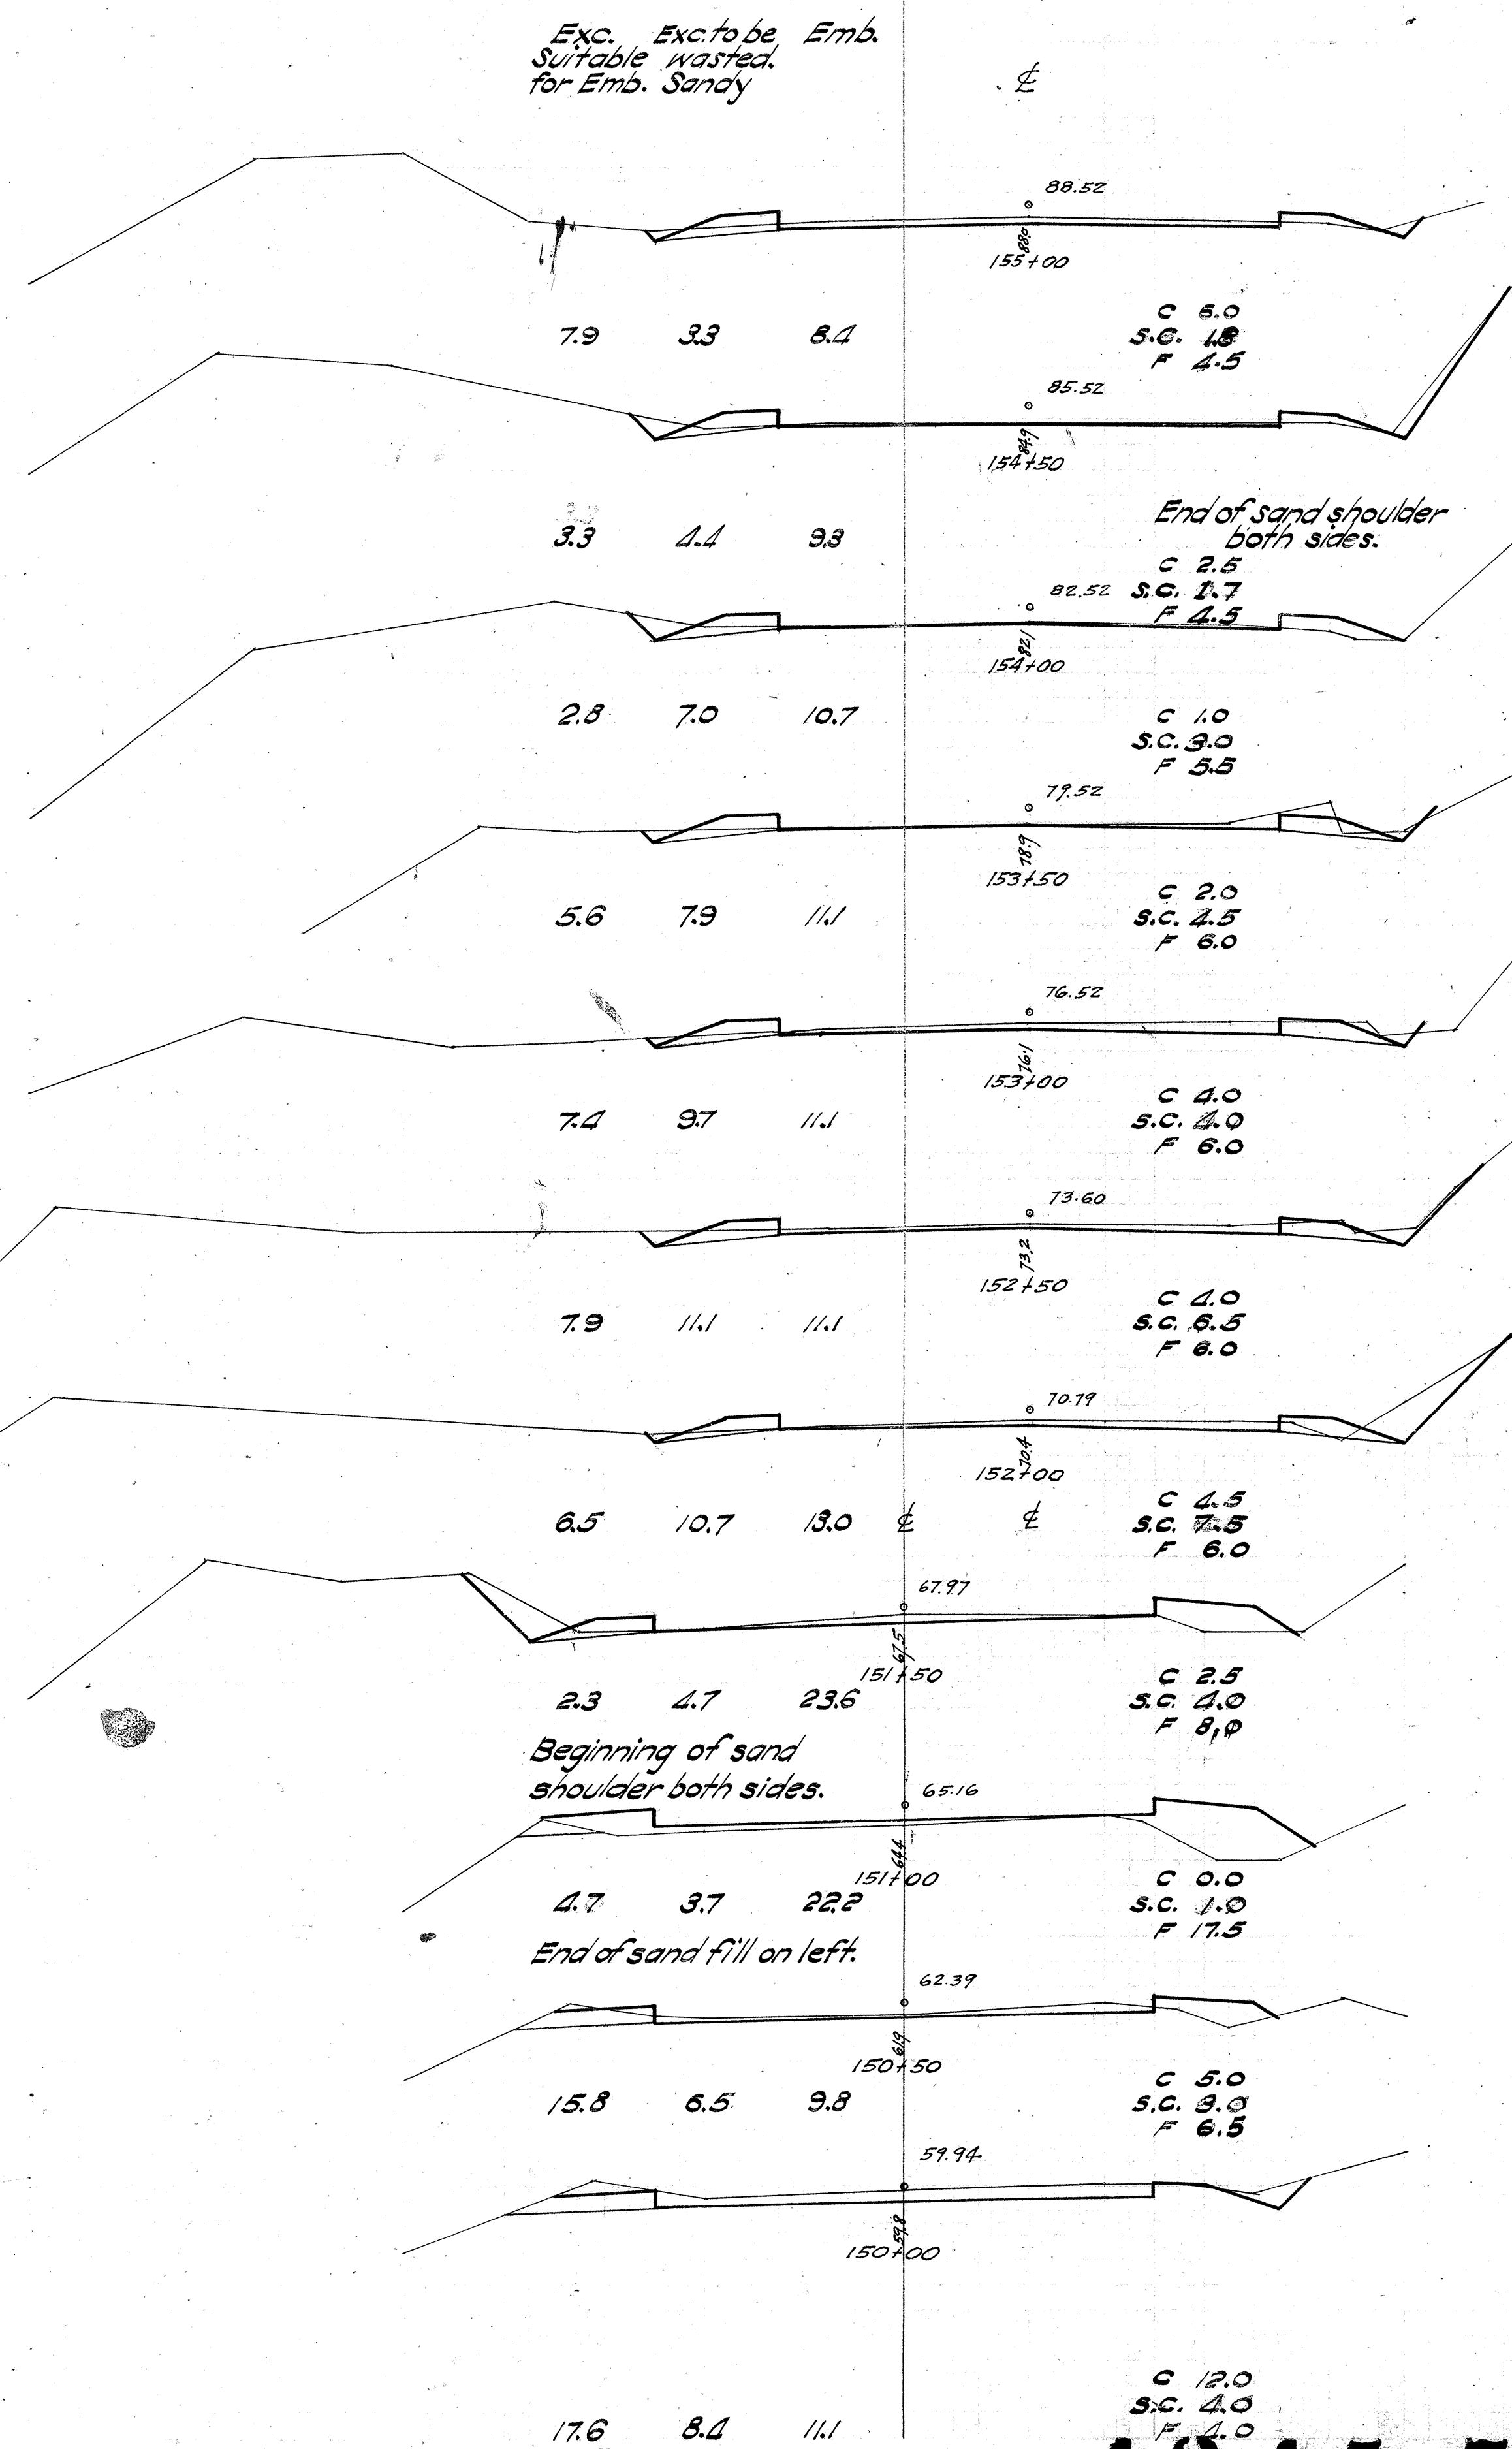


PROJ. ROAD DIST. NO.	STATE	FED. AID PROJ. NO.	FISCAL YEAR	SHEET NO.	TOTAL SHEETS
HAWAII	HAW	64	1932	7	8

4245.7

Exc. to be Emb.
Suitable Wasted.
for Emb. Sandy

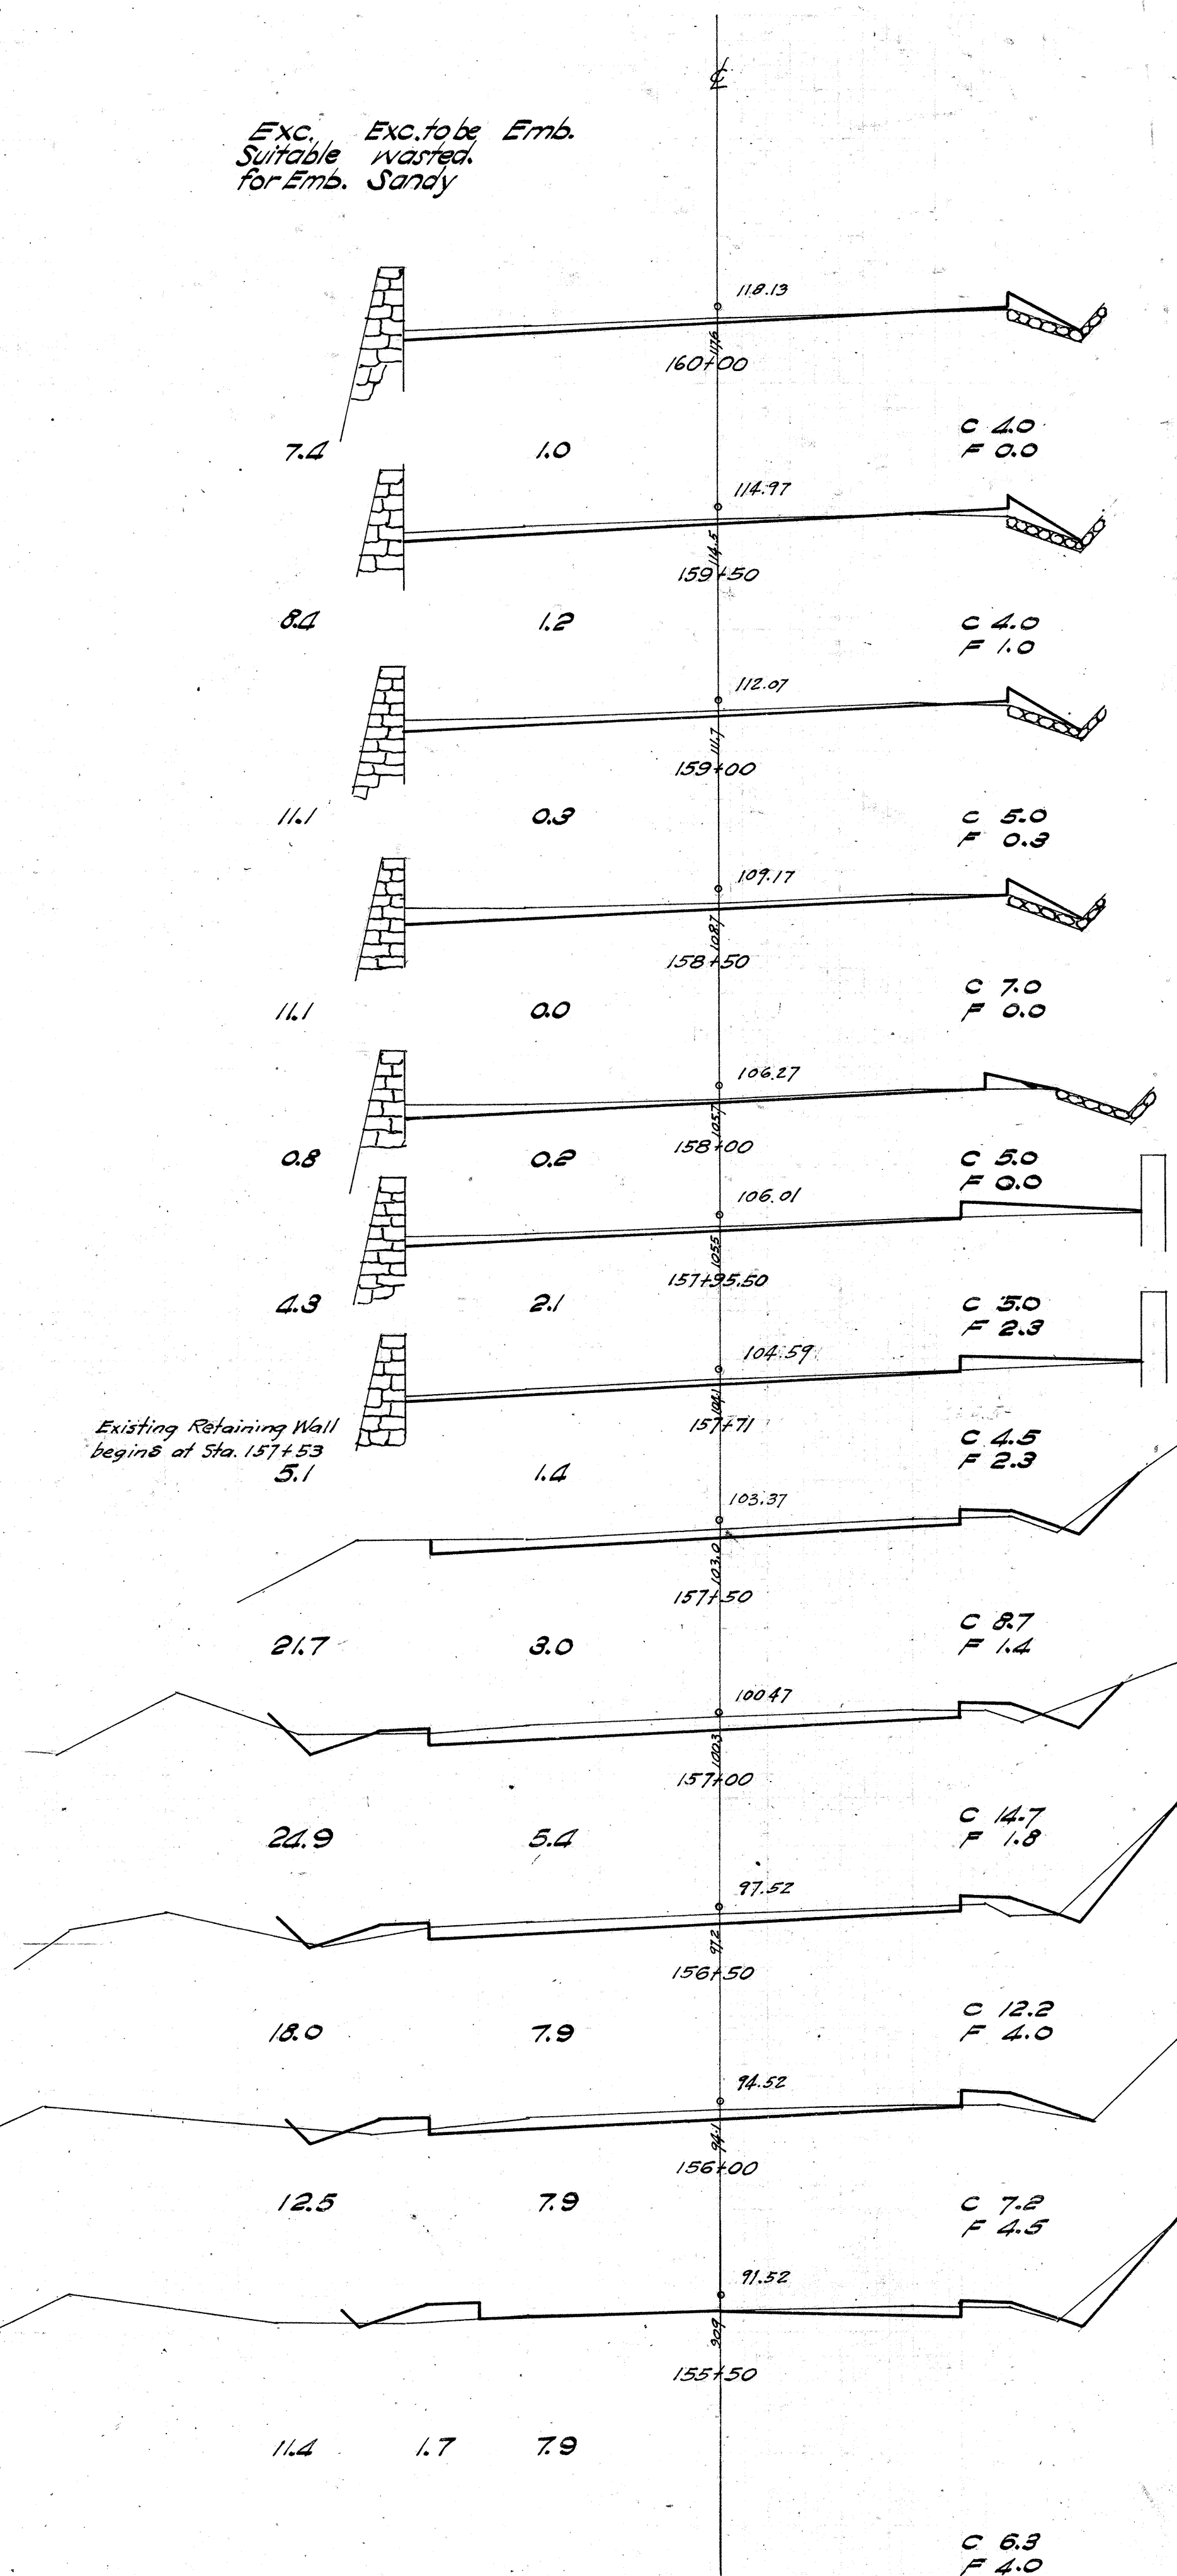

Exc. to be Emb.
Suitable Wasted.
for Emb. Sandy

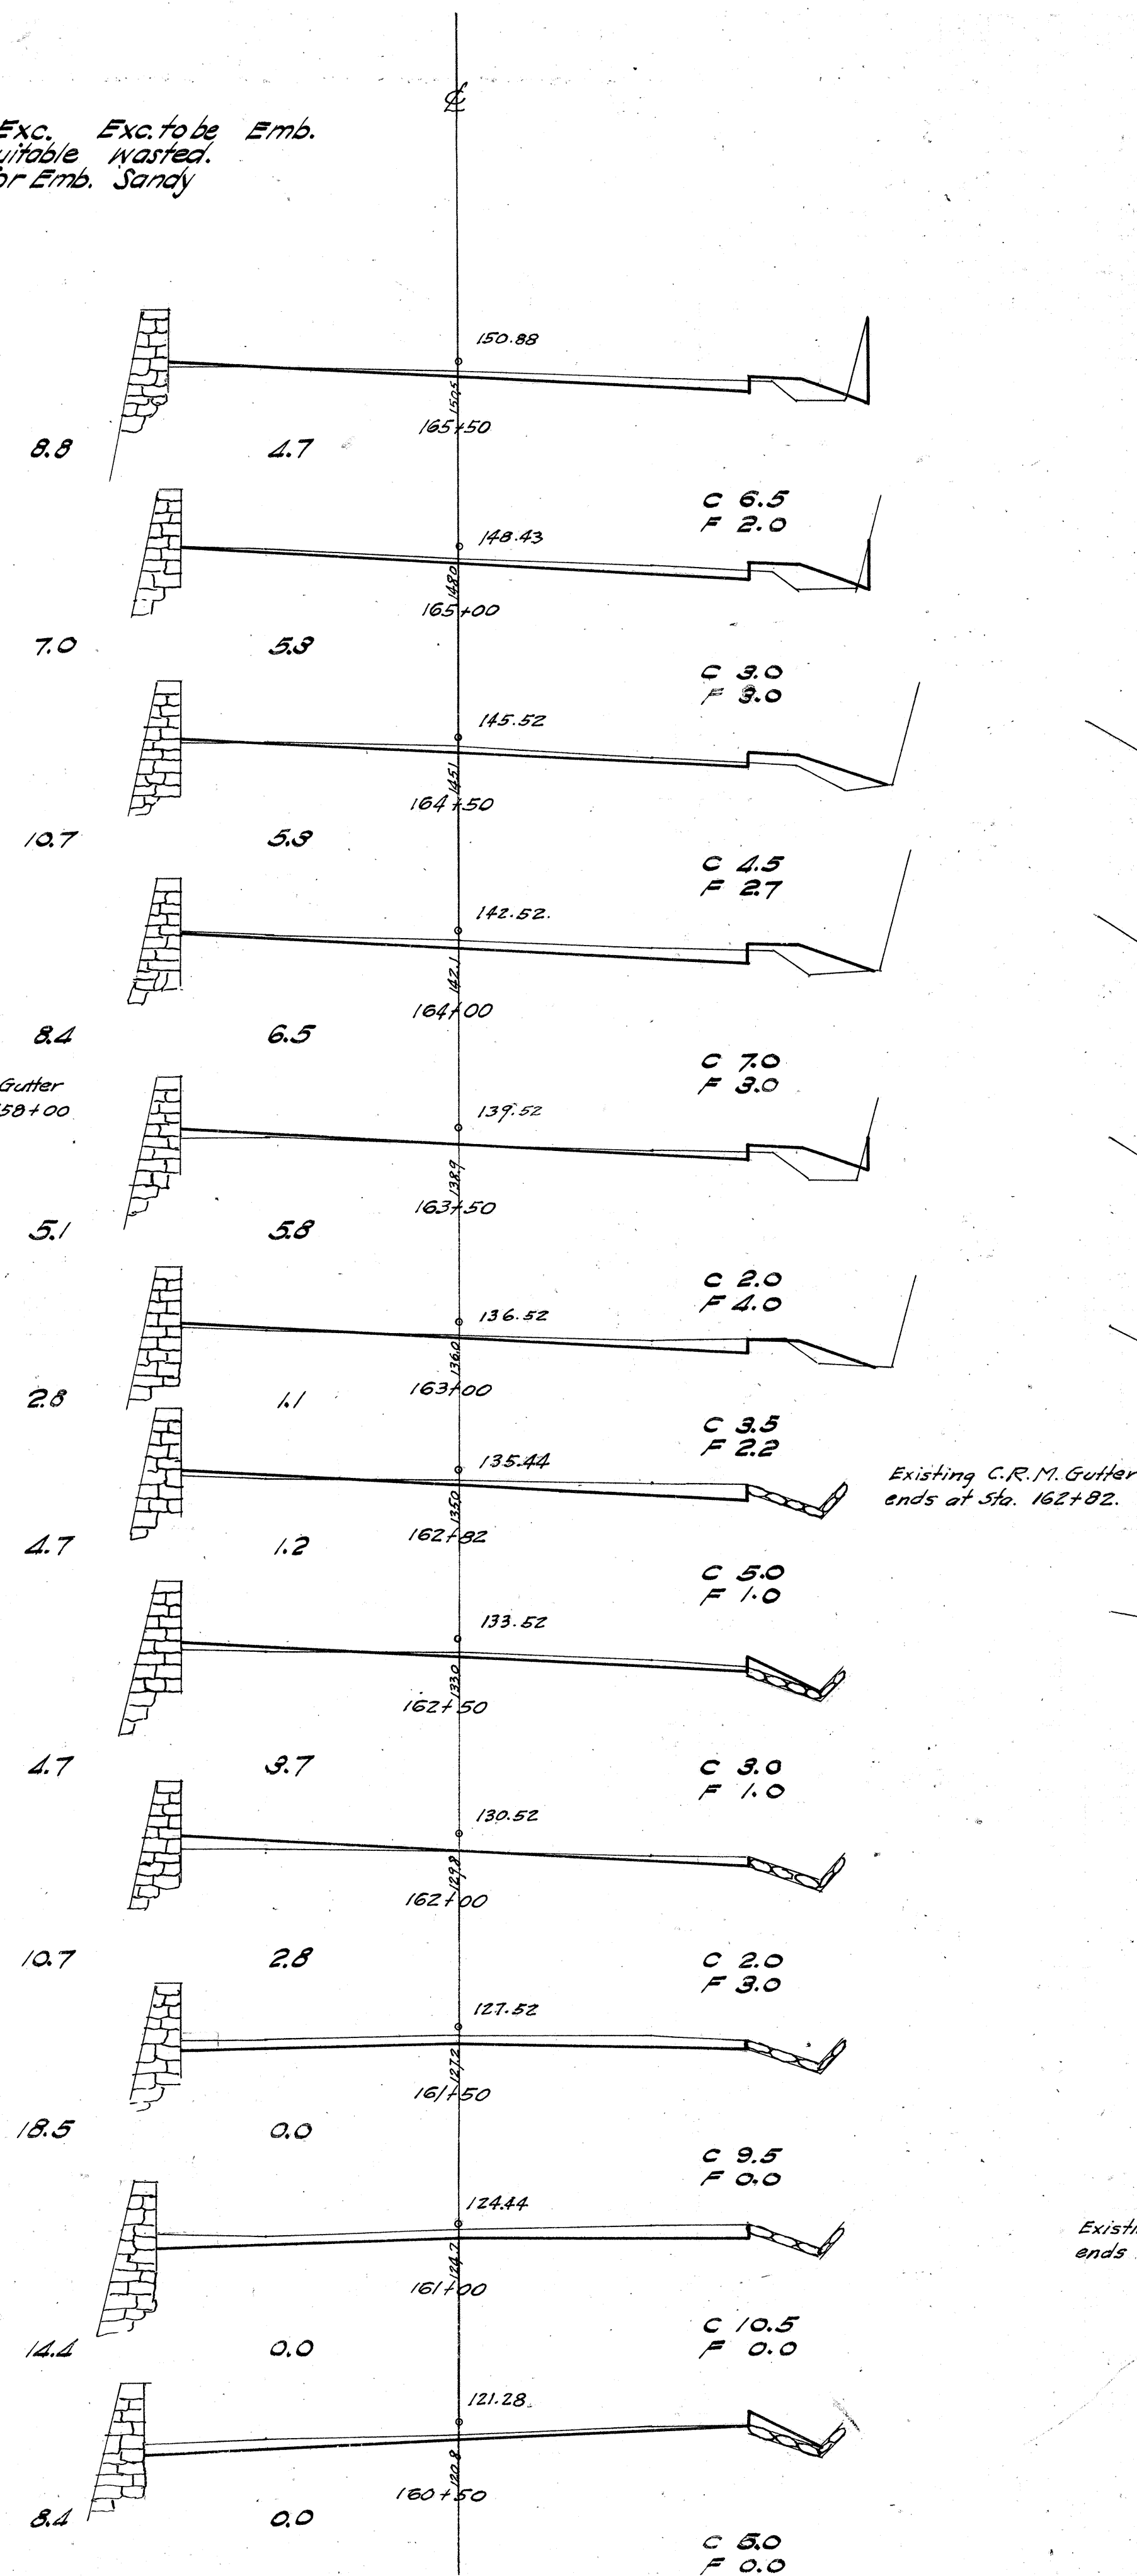

Exc. to be Emb.
Suitable Wasted.
for Emb. Sandy

