

DATE	BY	FINAL SURVEY	SURVEYED	PLOTTED	TEMPERATURE	NO.

DATE	BY	ORIGINAL SURVEY	SURVEYED	PLOTTED	TEMPERATURE	NO.

FED. ROAD DIST. NO.	STATE	FED. AID PROJ. NO.	FISCAL YEAR	SHEET NO.	TOTAL SHEETS
HAWAII	HA	W-11	1935	11	14

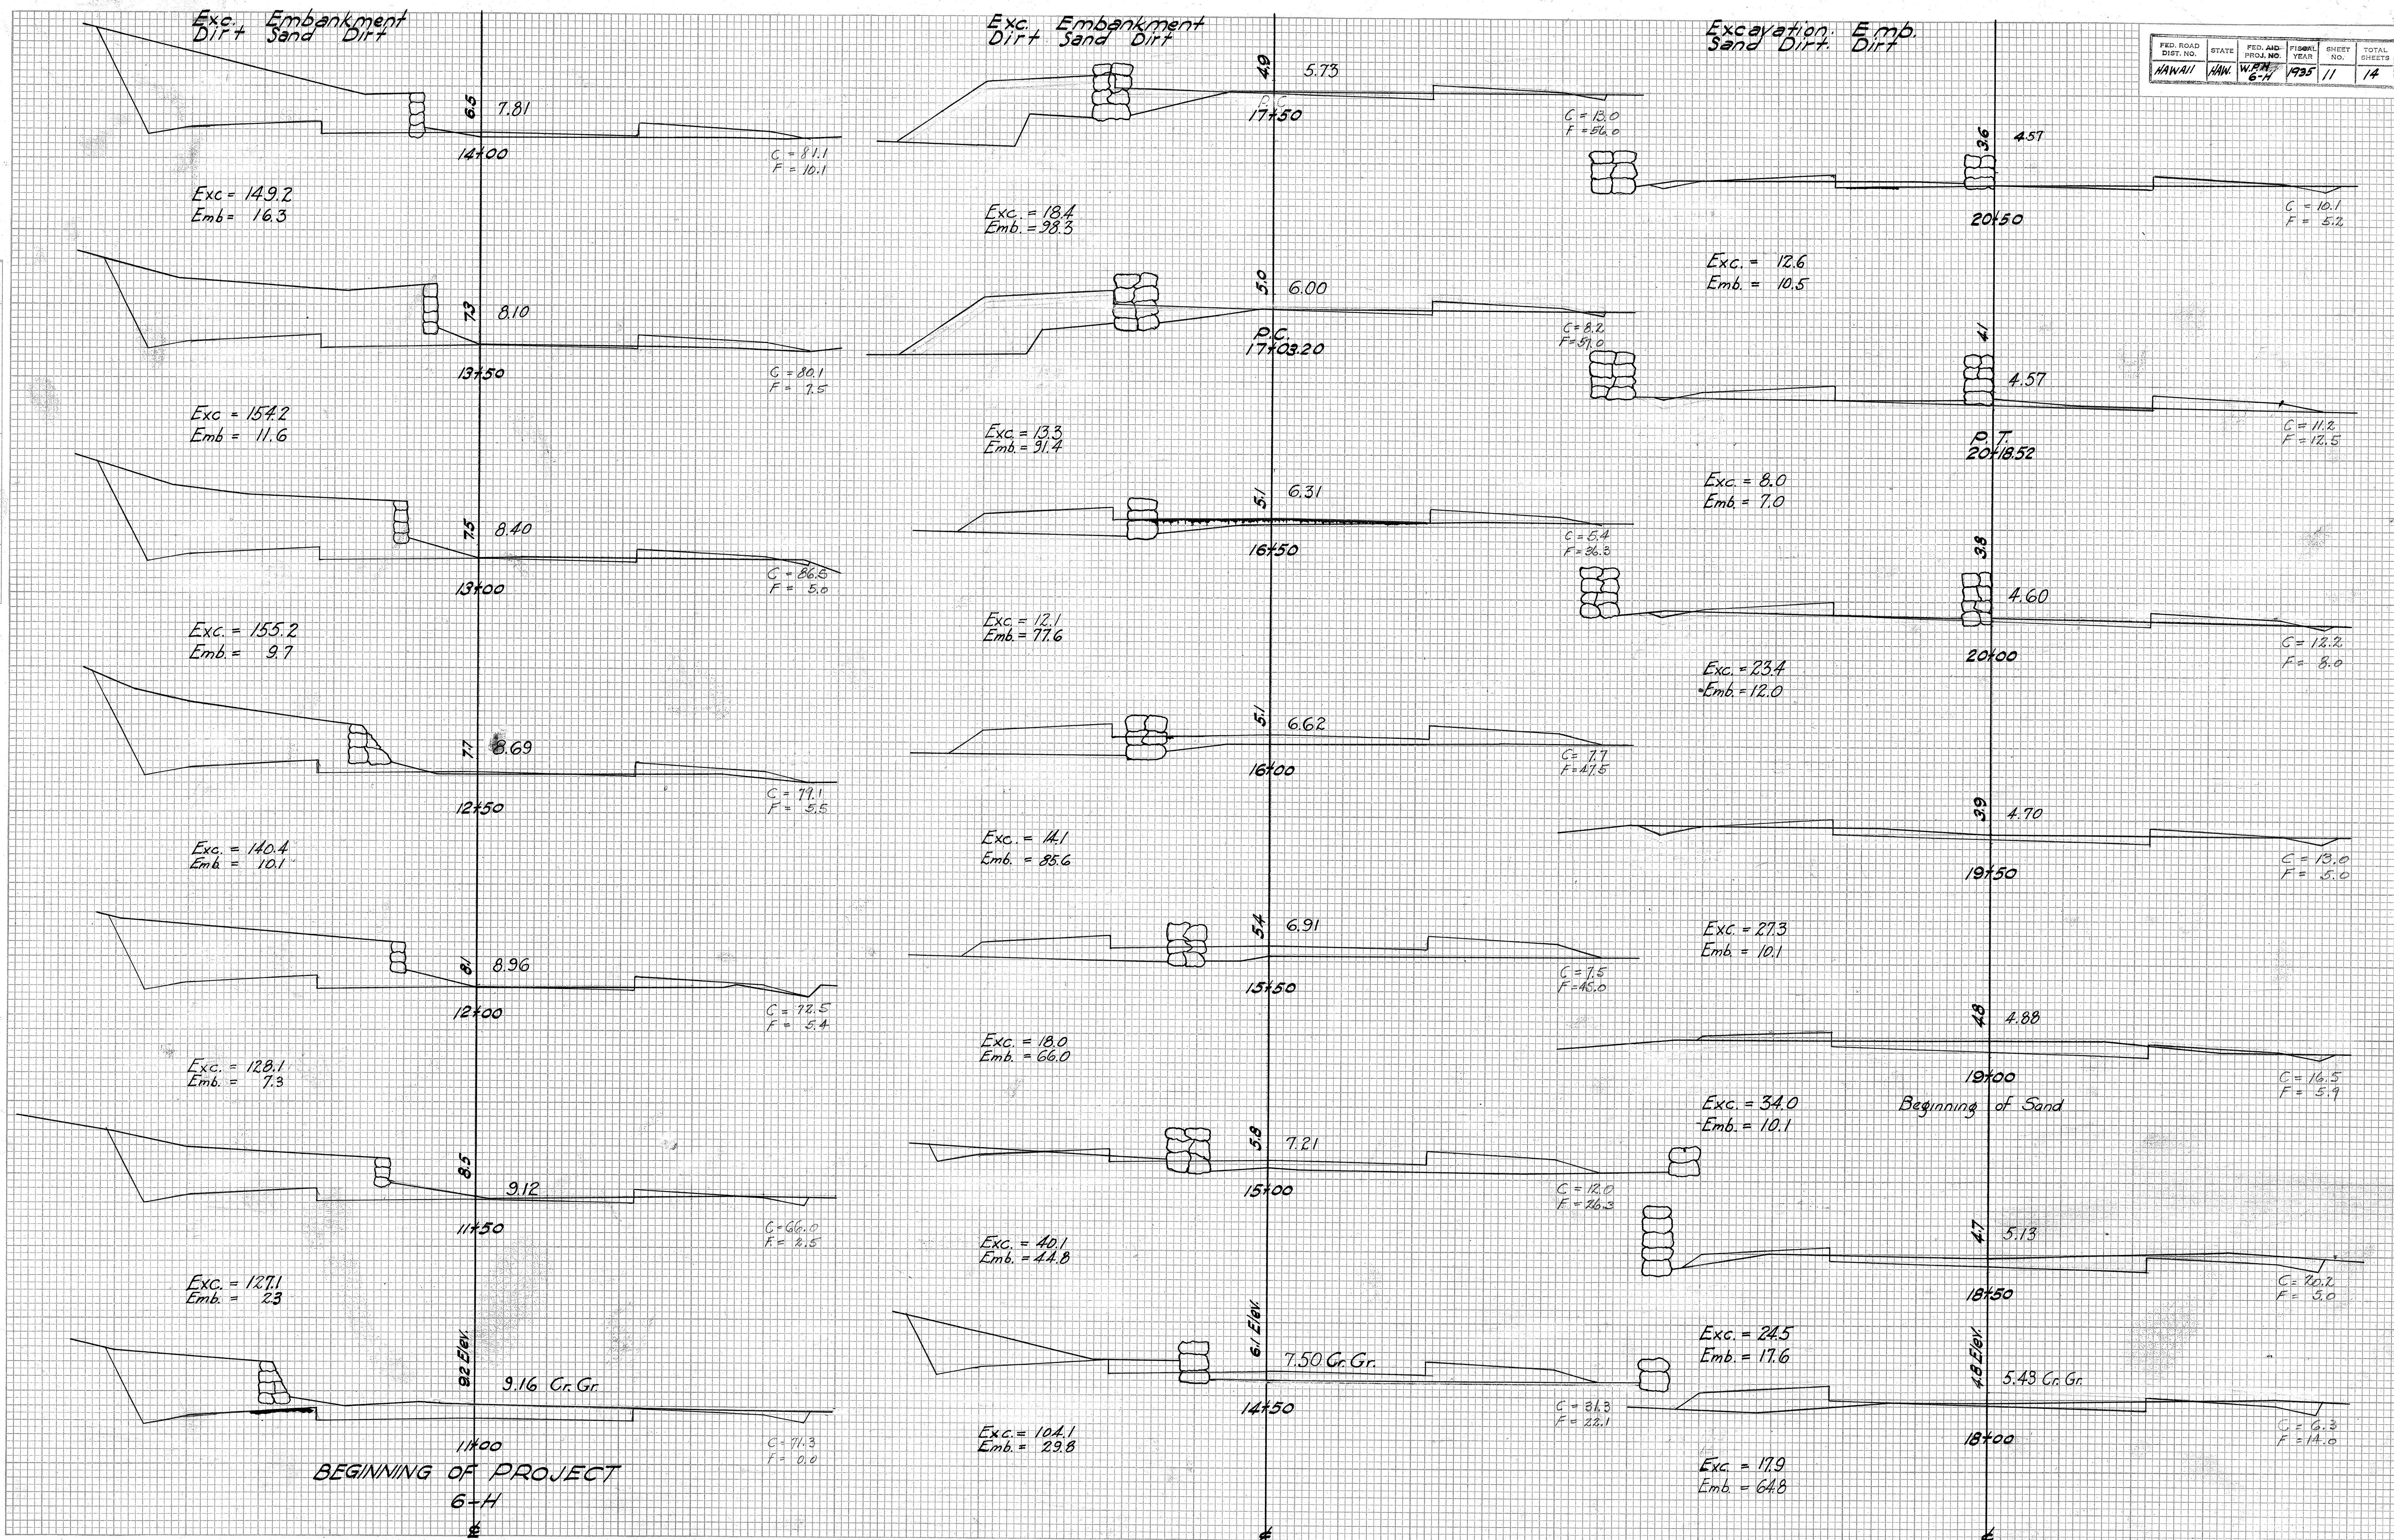



PLATE 3-CROSS SECTION O. P. R. & R. E. STANDARD
KEUFFEL & ESSER CO., NEW YORK.

4268.11

FINAL	SURVEYED	DATE
SURVEY	PLOTTED	BY
NOTE BOOK	TEMPLATE	
NO.	AREAS CHECKED	

ORIGINAL	SURVEYED	DATE
SURVEY	PLOTTED	BY
NOTE BOOK	TEMPLATE	
NO.	AREAS CHECKED	

FED. ROAD DIST. NO.	STATE	FED. AID PROJ. NO.	FISCAL YEAR	SHEET NO.	TOTAL SHEETS
HAWAII HAW	W. B. H.	1935	12	14	

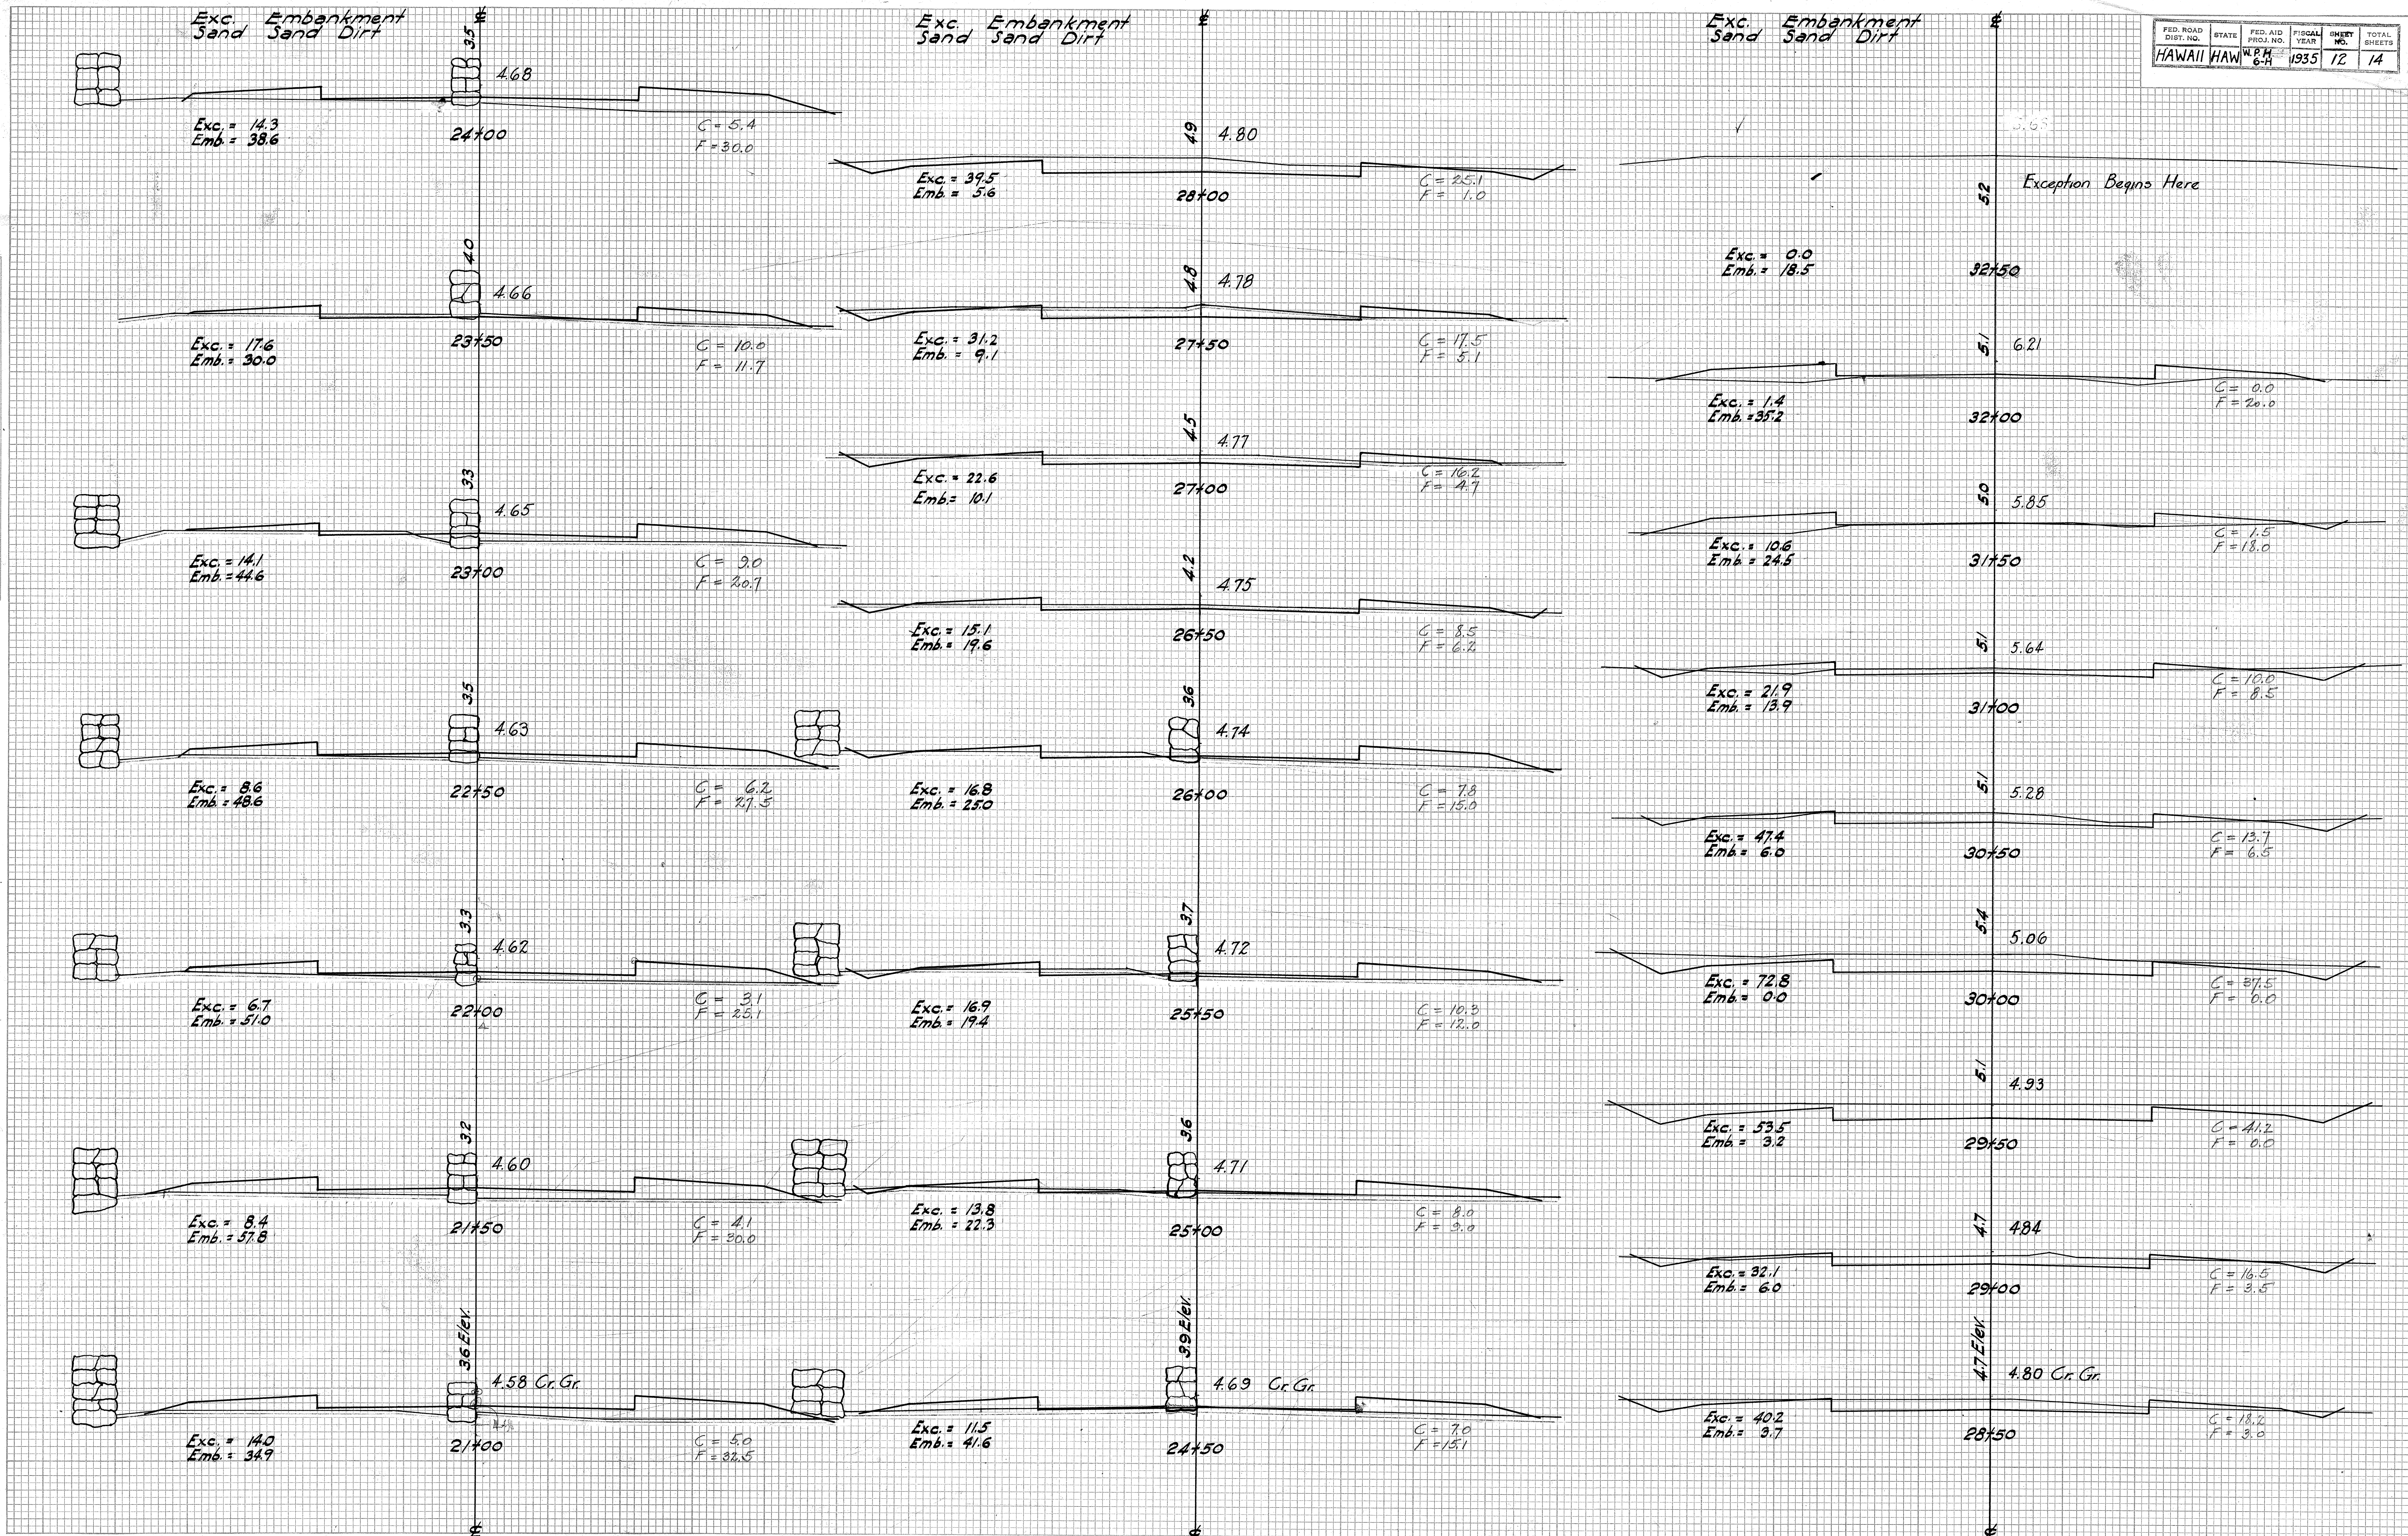

NOTE: Grade revision between Sta. 47+29 - 52+66.14 is shown by the dotted line. Feb. 1936

Grade revision between Sta. 41+00 - 50+50 is shown by the dash line. Apr. 1936

FINAL SURVEY PLOTTED BY DATE
NOTE BOOK NO. AREAS CHECKED

ORIGINAL SURVEY PLOTTED BY DATE
NOTE BOOK NO. AREAS CHECKED

