


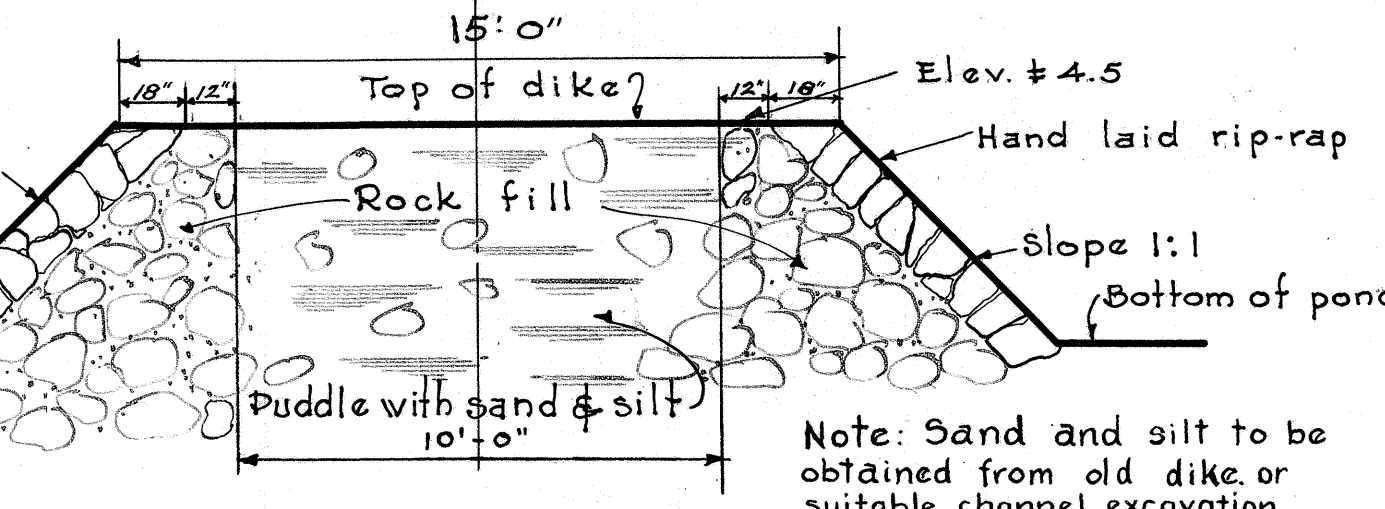
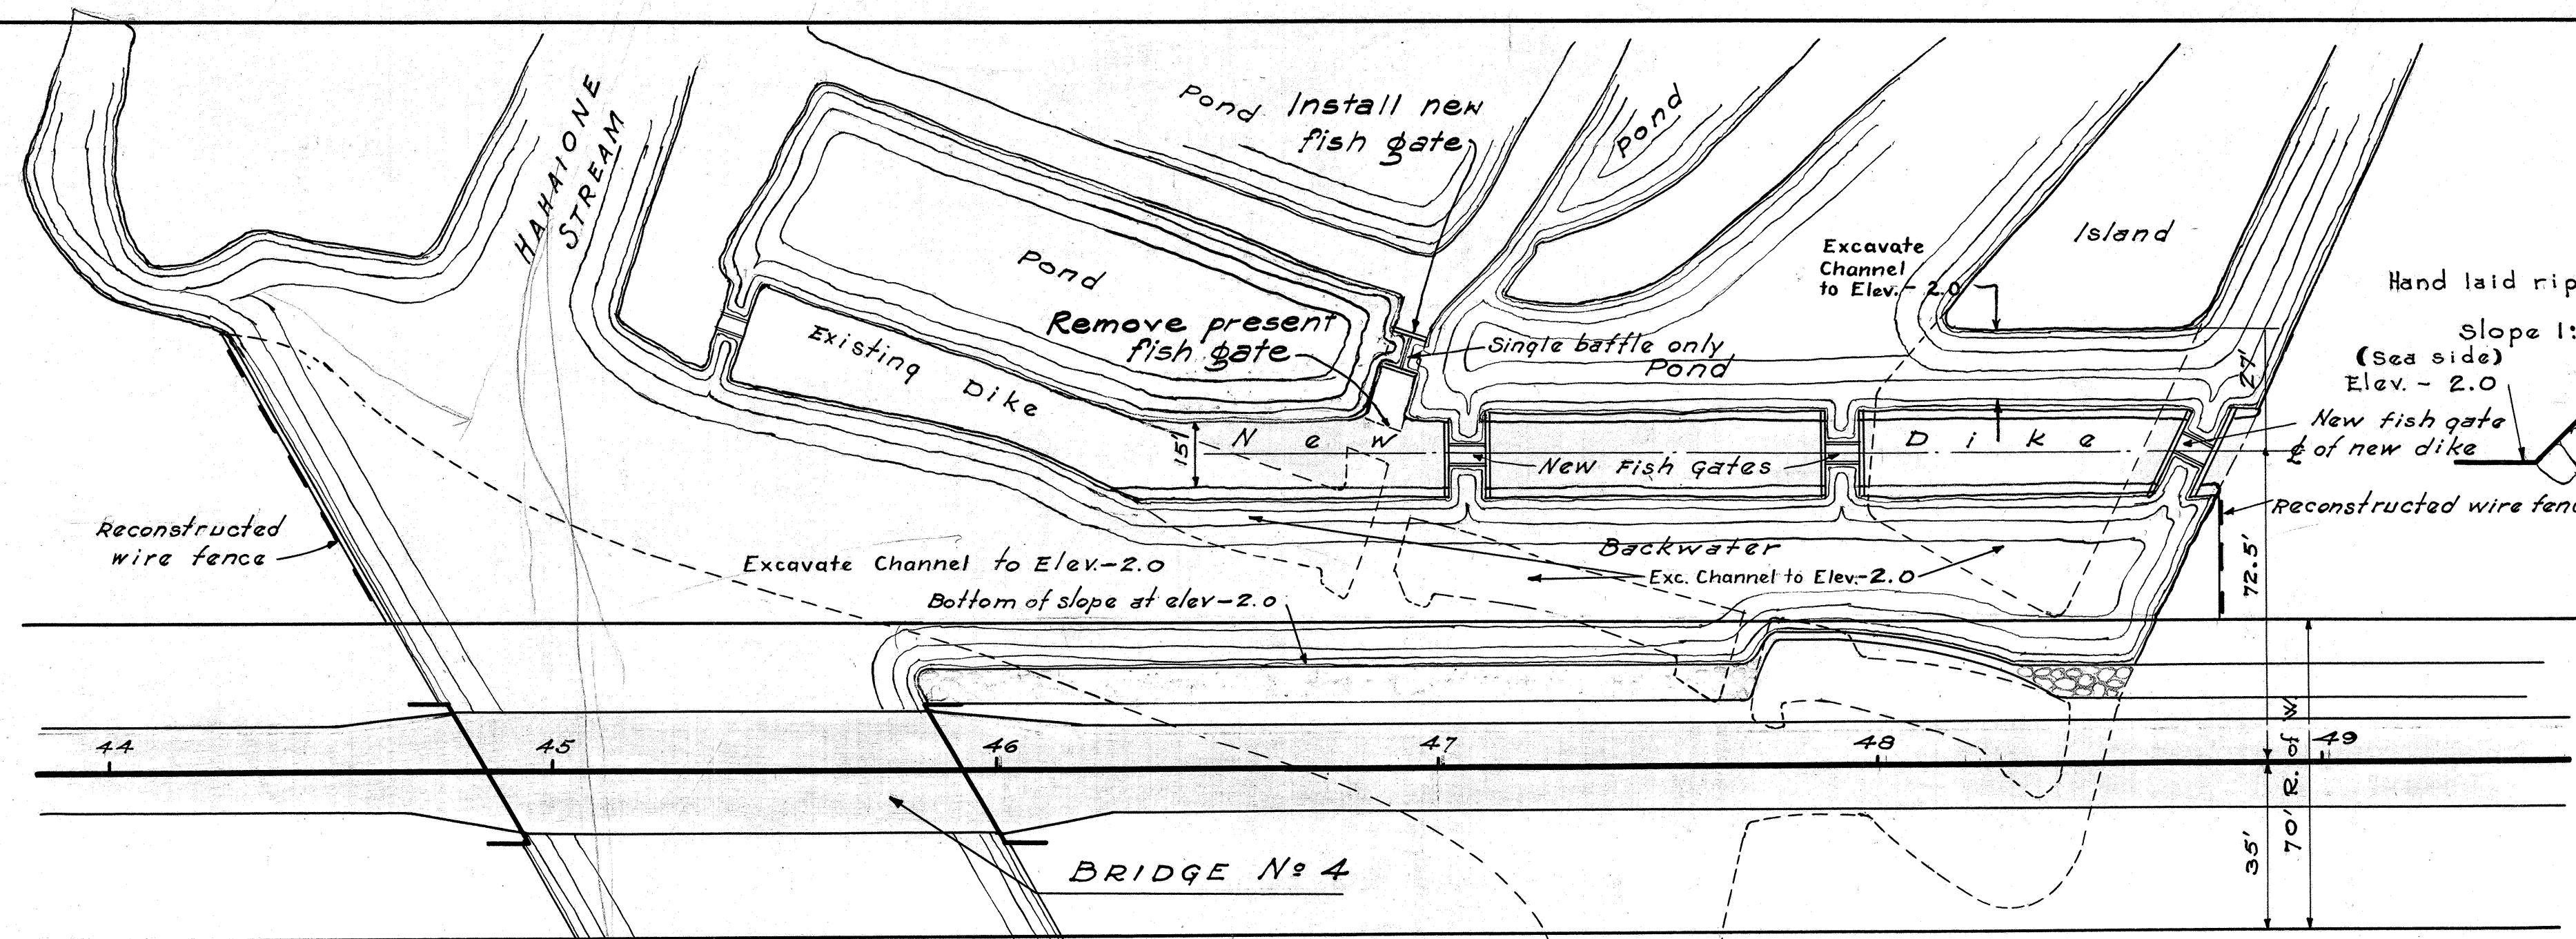


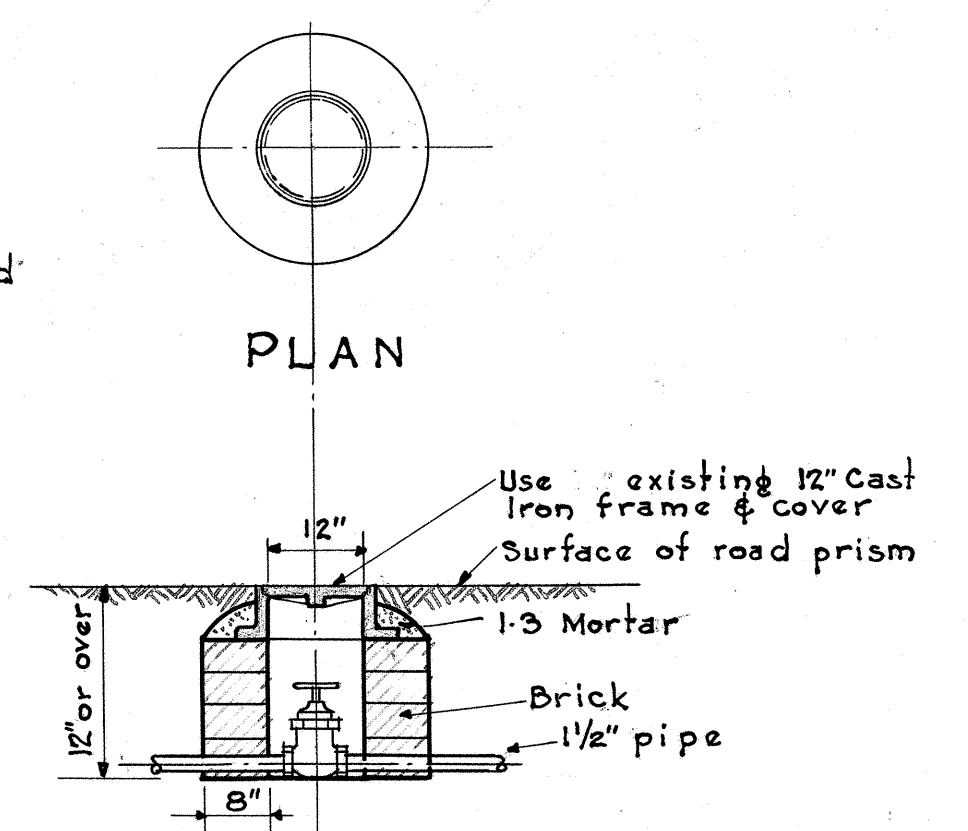


DETAIL OF NEW DIKES
SCALE 1/4" = 1'0"

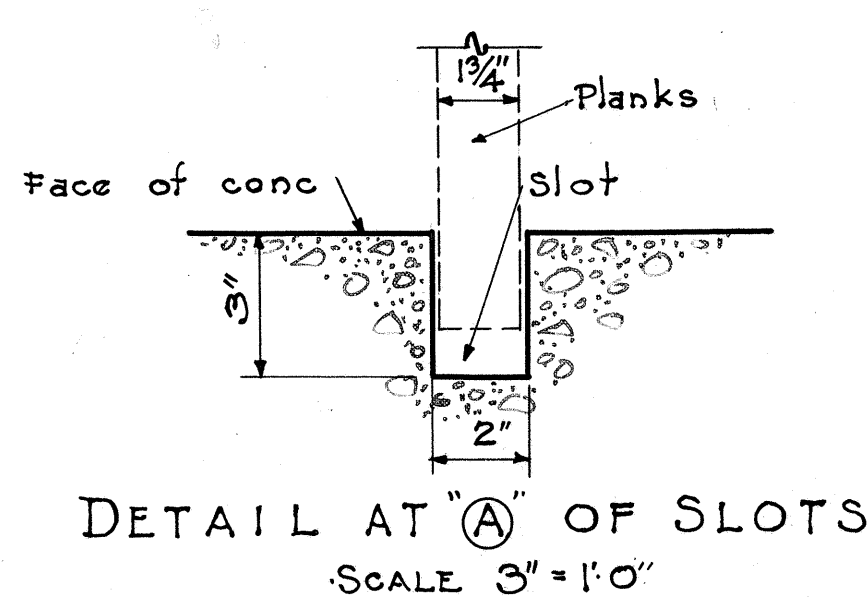


DETAILS OF MANHOLES
FOR 1 1/2" VALVES
SCALE 1/2" = 1'0"

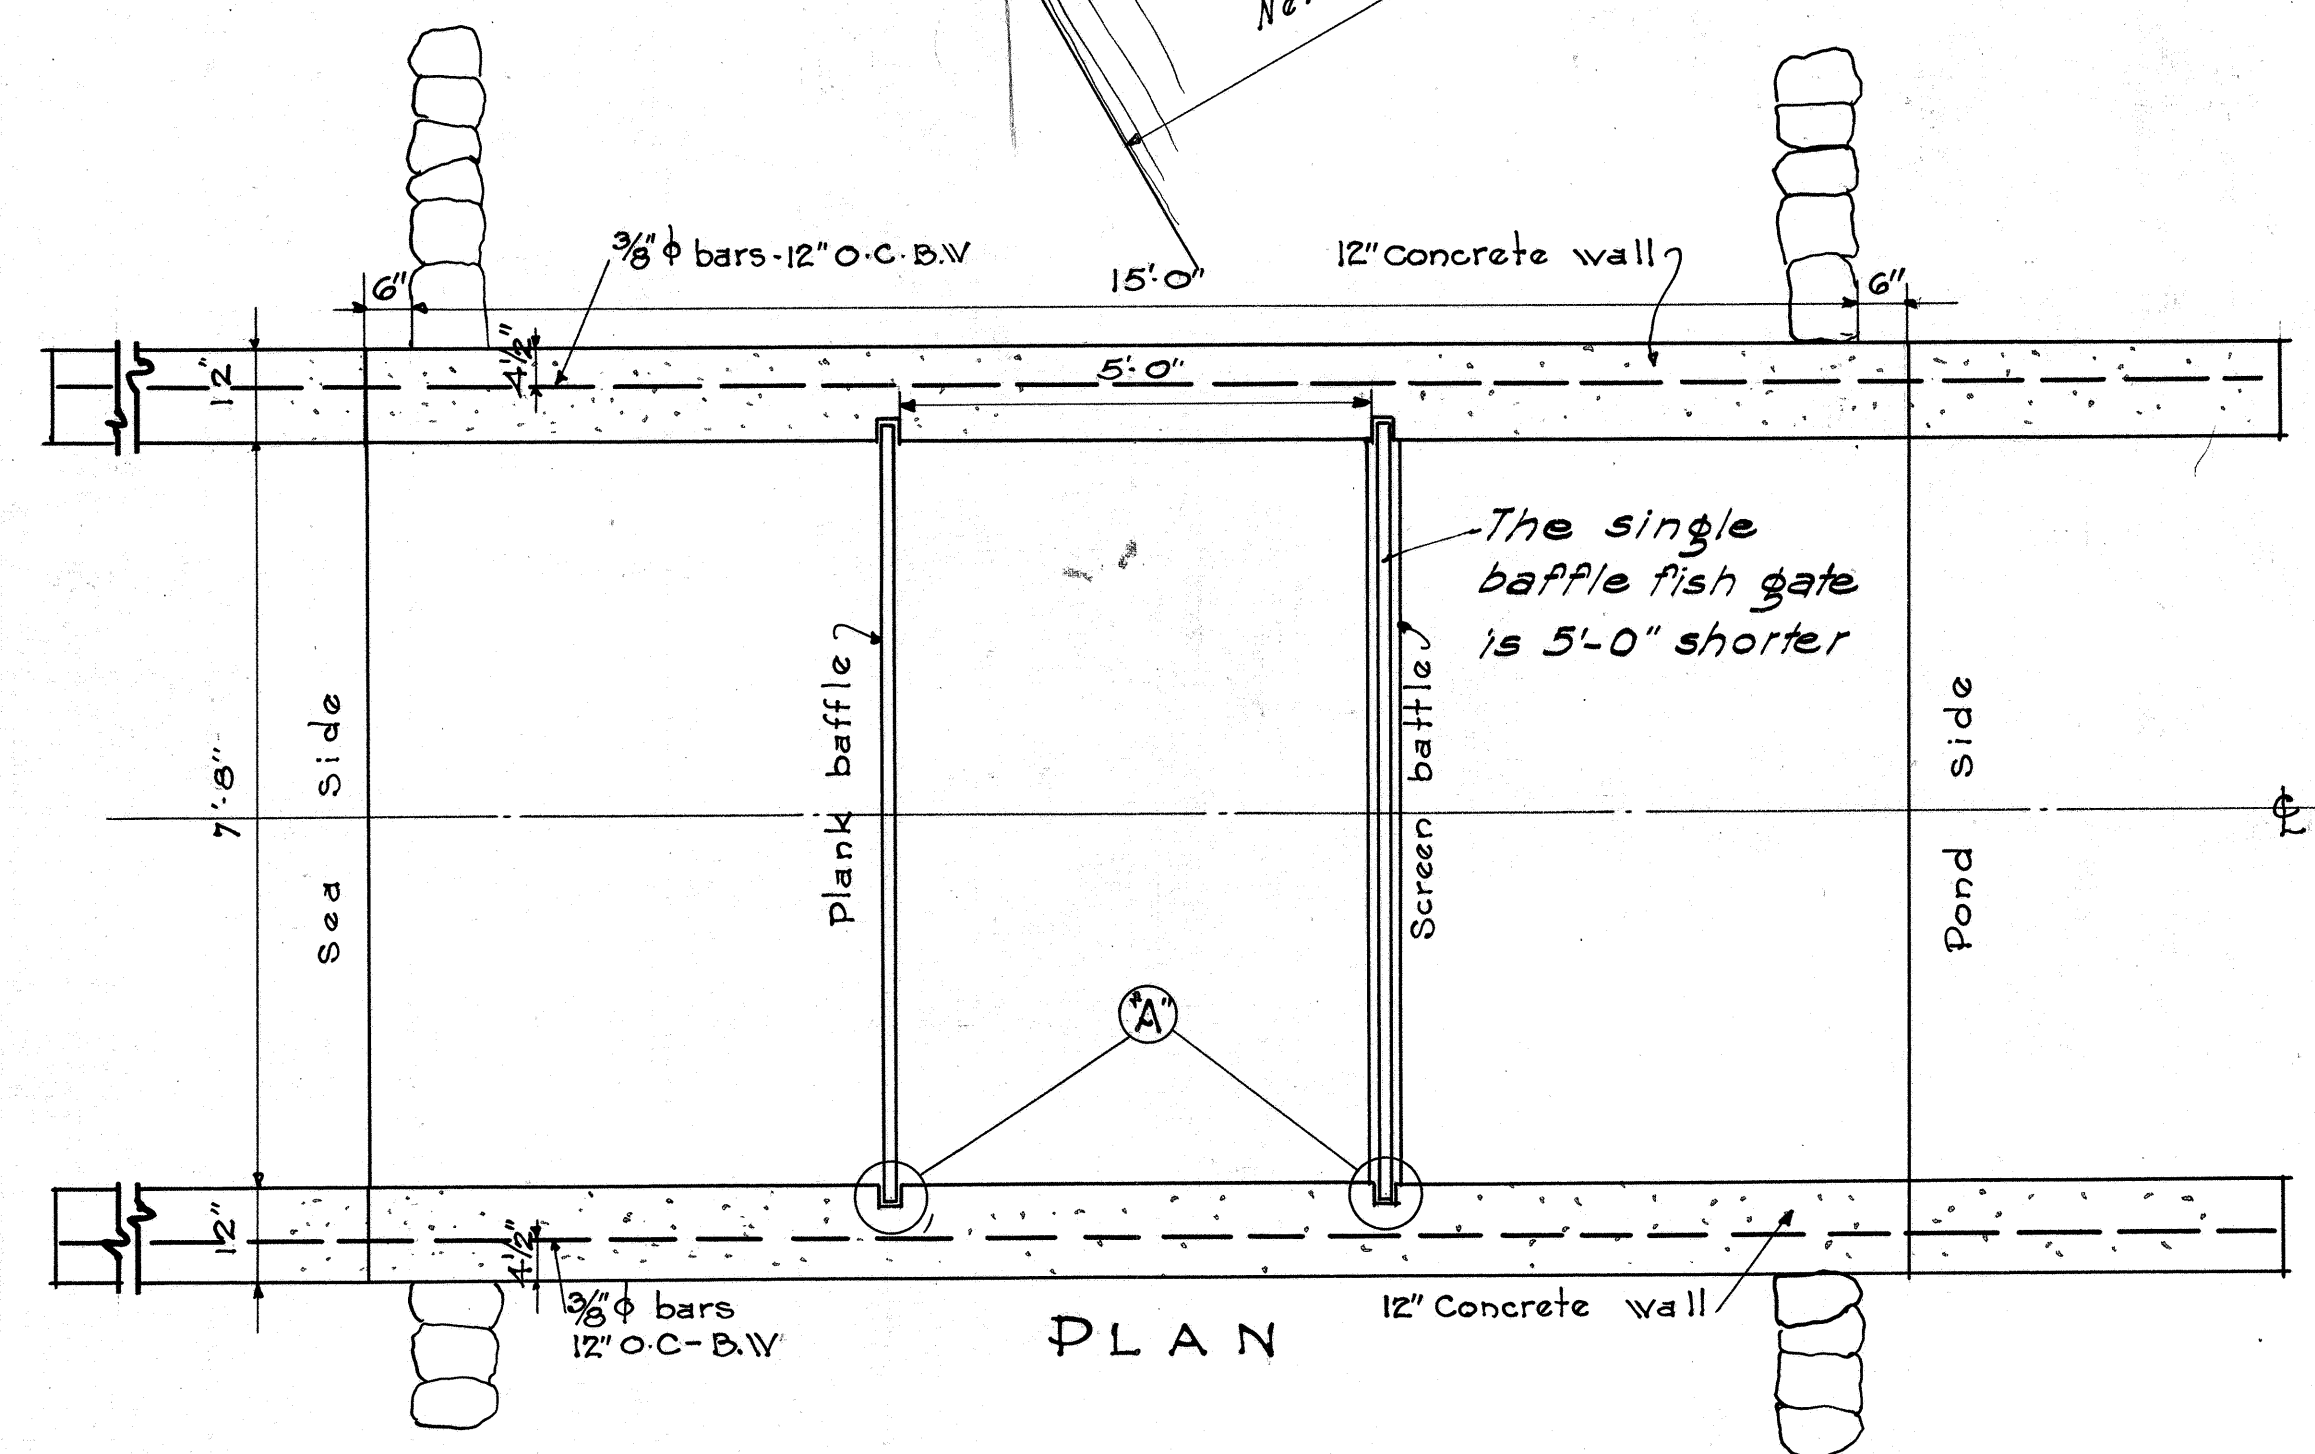



DETAIL AT "A" OF SLOTS
SCALE 3" = 1'0"

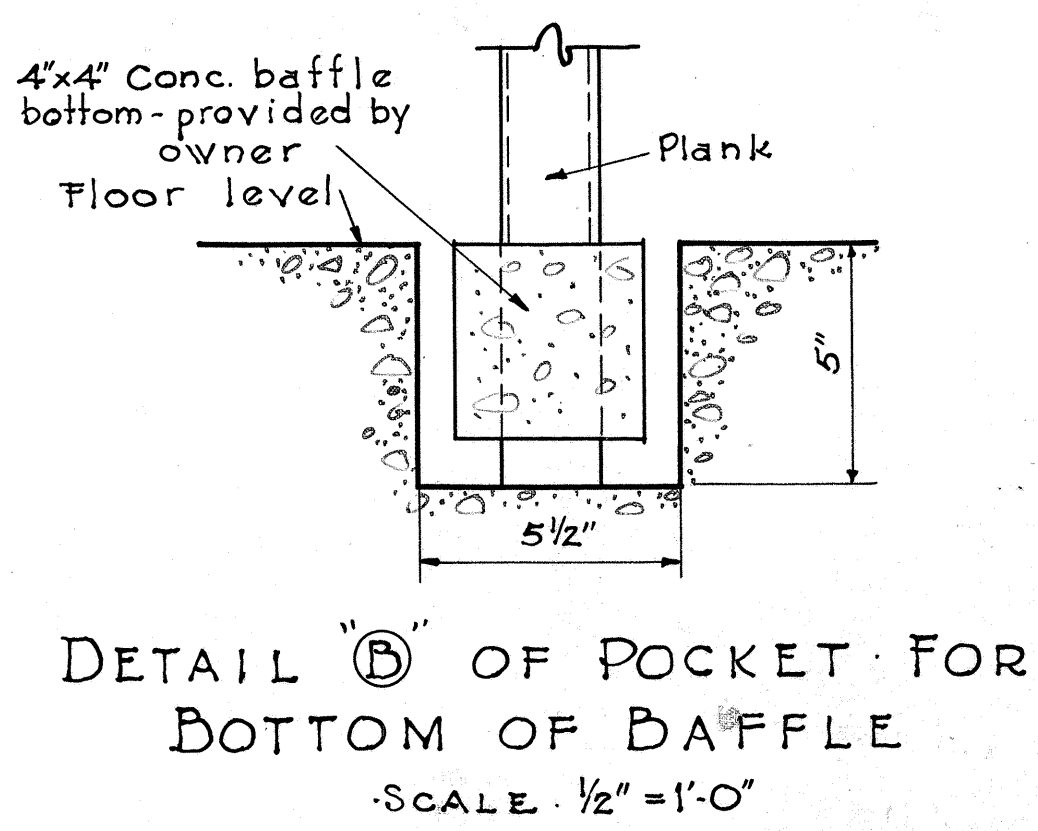



DETAIL "B" OF POCKET FOR
BOTTOM OF BAFFLE
SCALE 1/2" = 1'0"

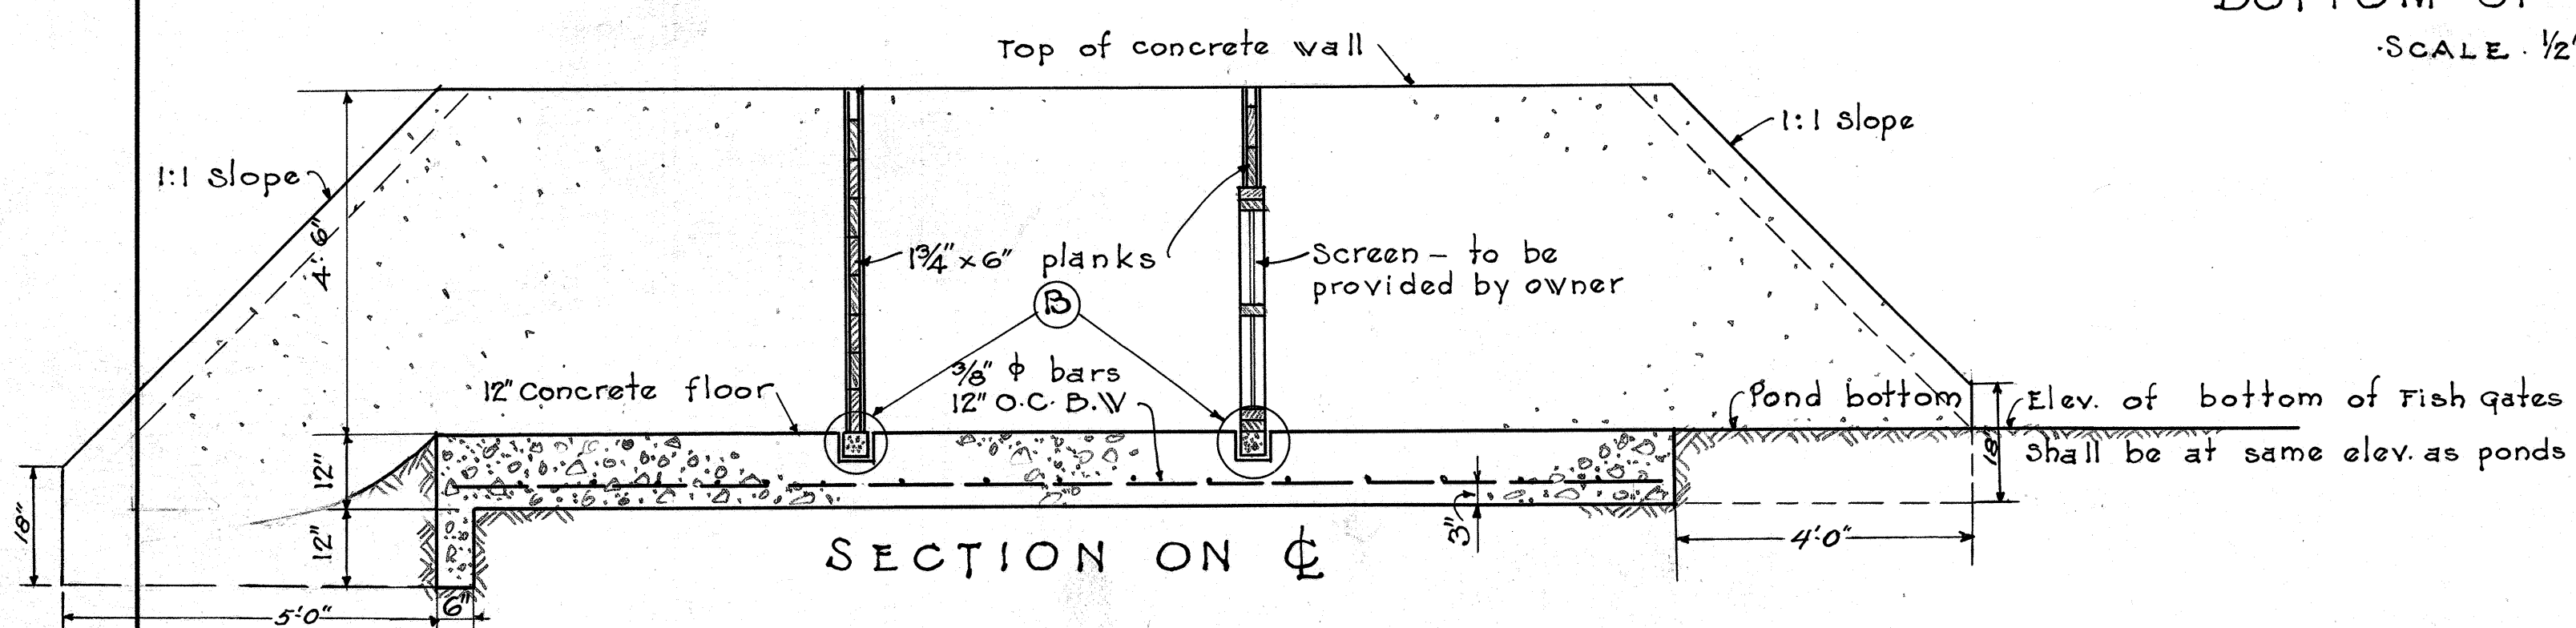


DETAILS OF FISH GATES
SCALE 1/2" = 1'0"

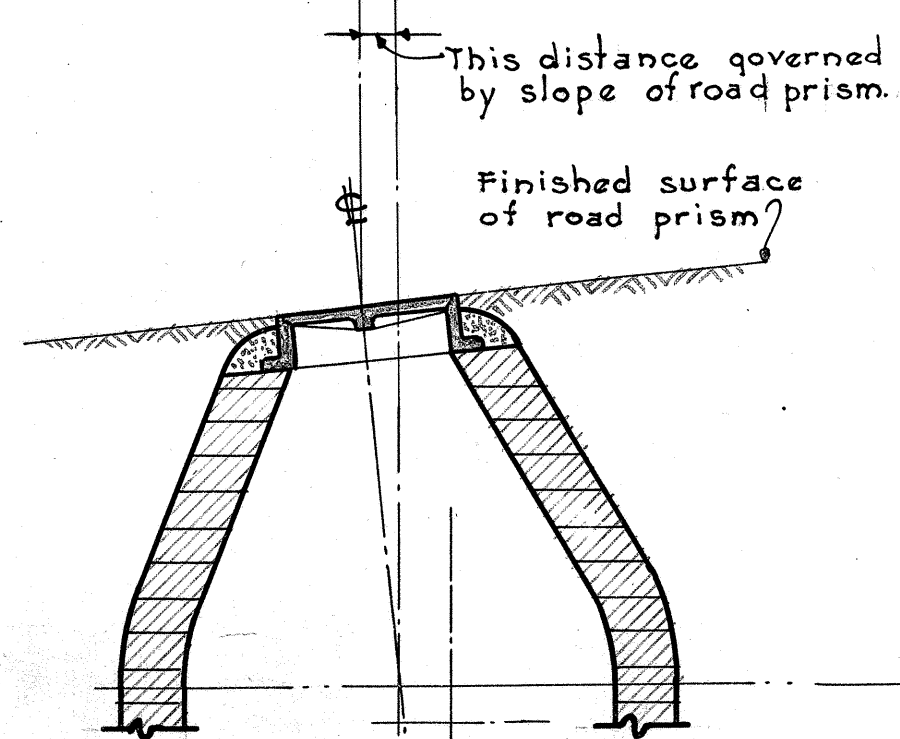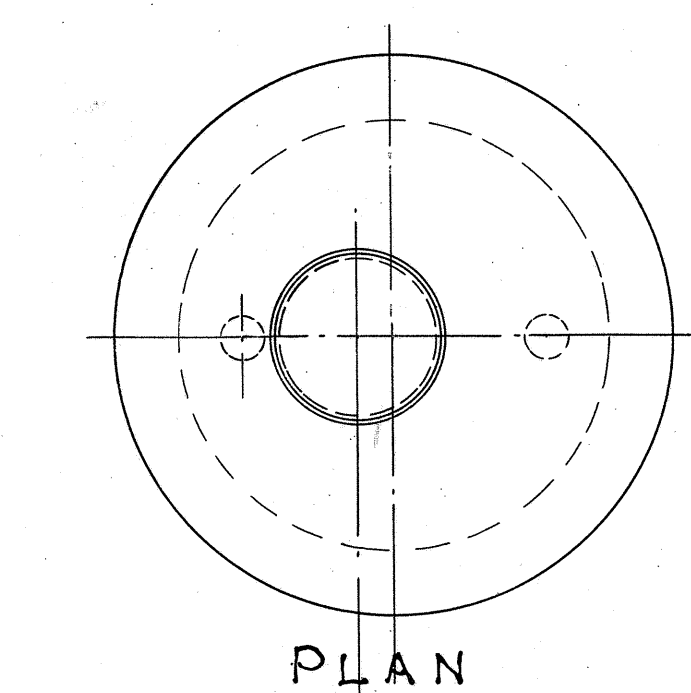

TYPICAL ADAPTION TO SLOPED SURFACE

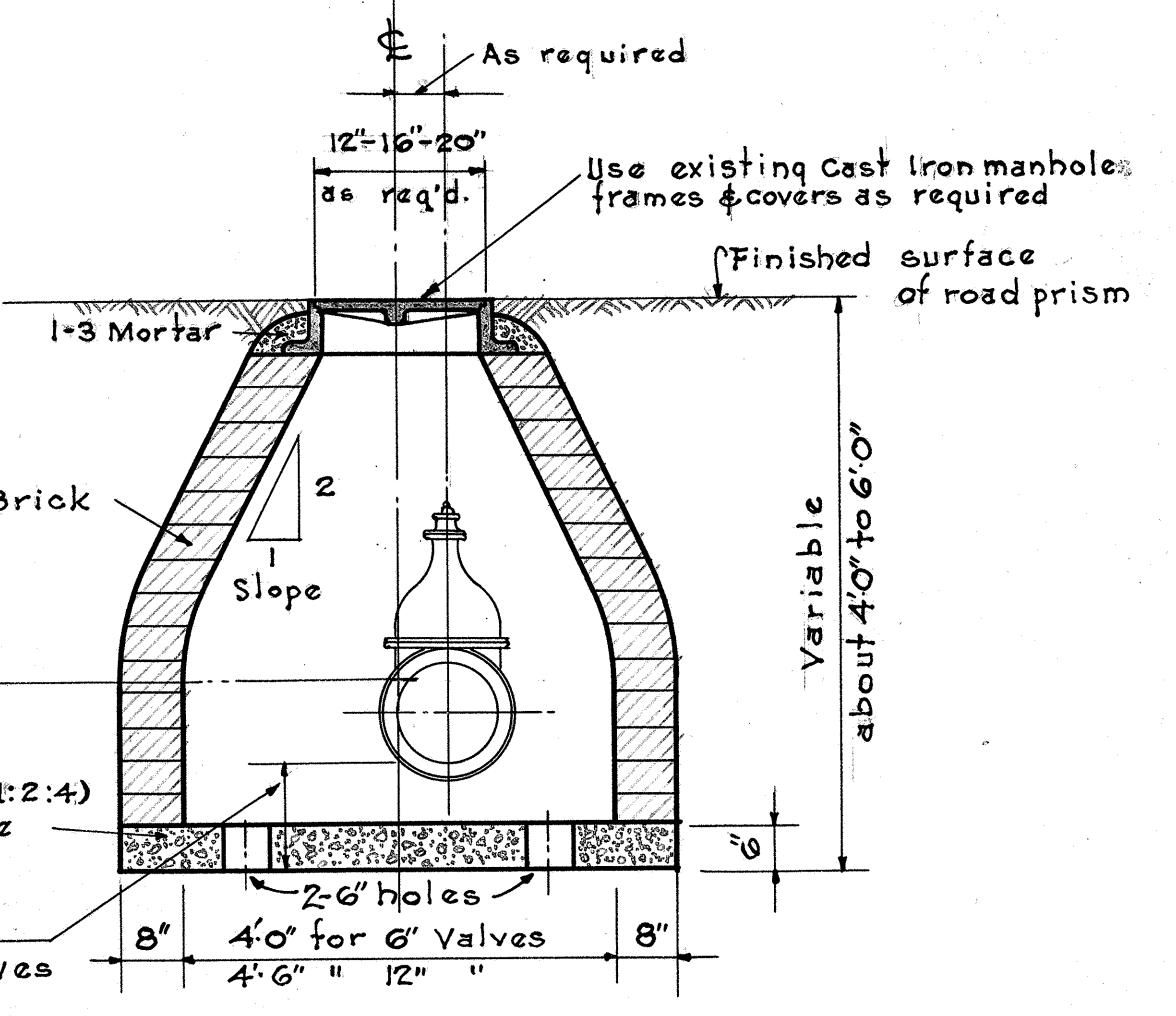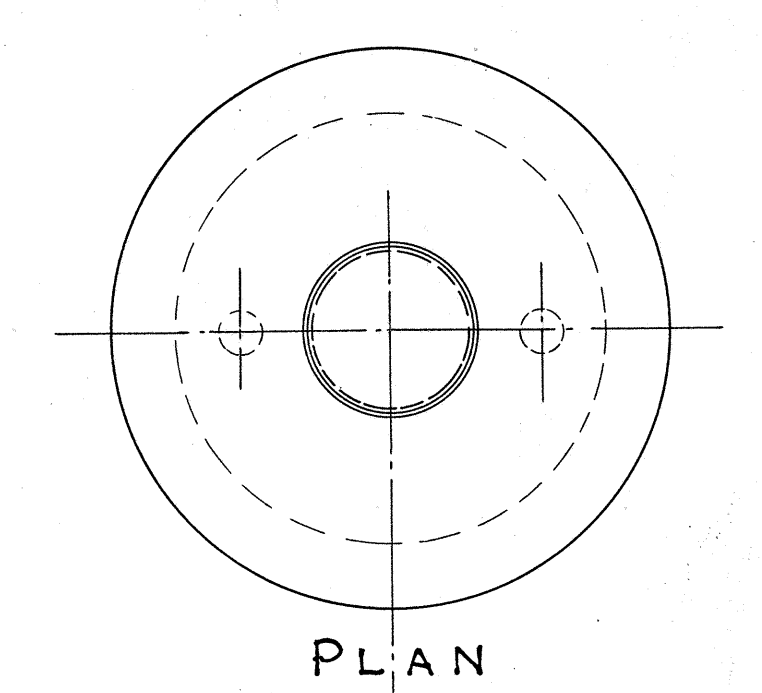

DETAILS OF MANHOLES
FOR 6" & 12" VALVES
SCALE 1/2" = 1'0"

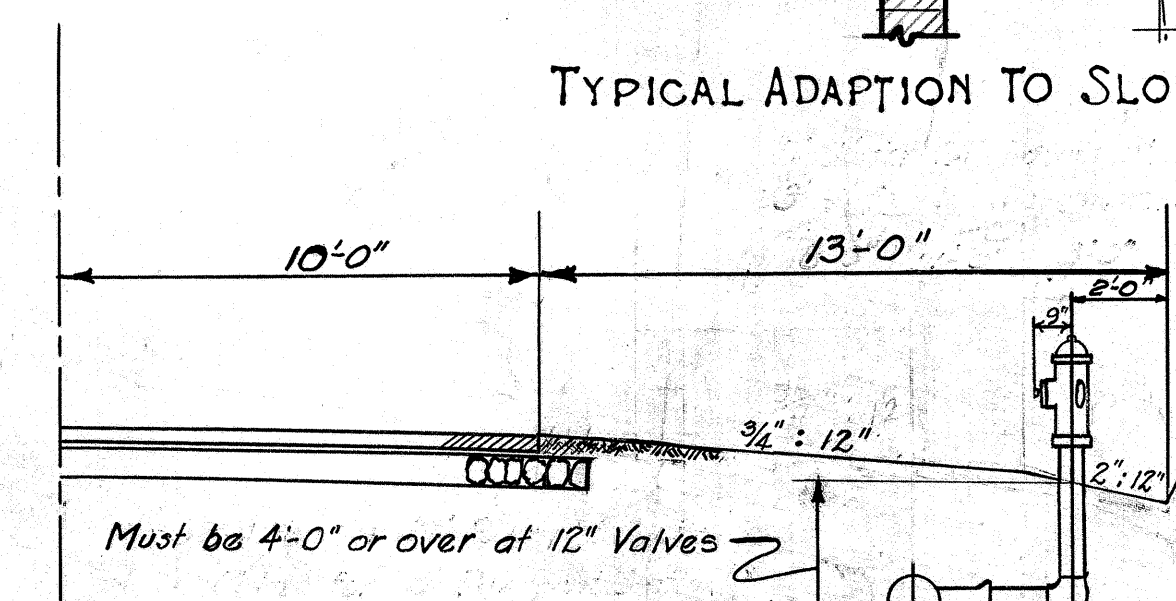

TYPICAL DETAILS OF WATER
MAIN & FIRE HYDRANT
SCALE 1/4" = 1'0"

Note - Above details are typical but must be varied to suit conditions (See plans). Requirements which must be met are; (1) Hydrant centered 24" inside of ditch line; (2) Minimum cover 3'6" to Main Invert; (3) Rim of manhole for the 6" valve flush with finished surface of road section.

