


Land Court Application No. 578

NOTE RE:-

Reconstructing Stone Wall Fences
In front of each property, reconstruct the wall to a uniform section which will require all of the existing wall material.

F.A. Marker
with
"F.A.R."
6-E.
6-H.


$\Delta = 4^{\circ} 24'$
 $D = 1^{\circ} 00'$
 $R = 5730.0$
 $T = 220.12$
 $L.C. = 439.92$
 $L = 440.03$

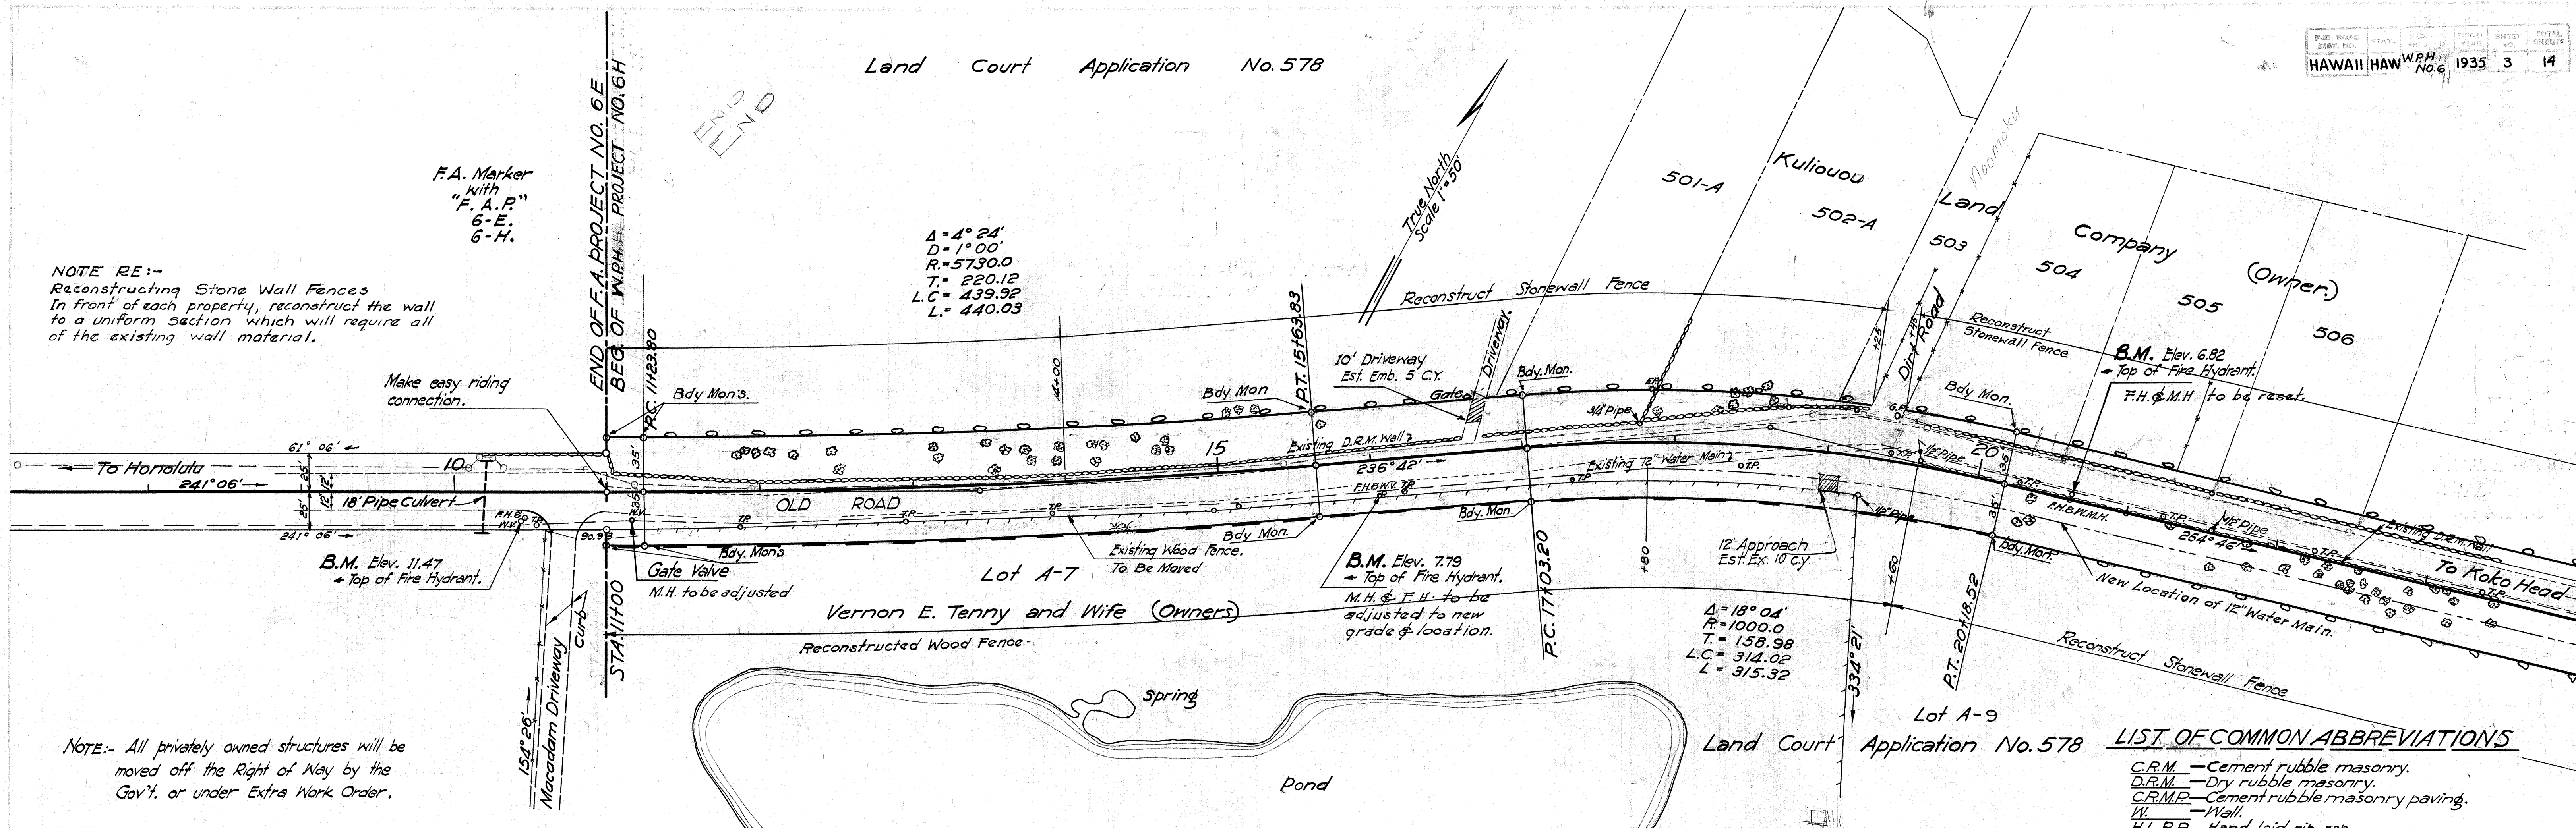

NOTE:- All privately owned structures will be moved off the Right of Way by the Gov't. or under Extra Work Order.

LIST OF COMMON ABBREVIATIONS

- C.R.M. - Cement rubble masonry.
- D.R.M. - Dry rubble masonry.
- C.R.M.P. - Cement rubble masonry paving.
- W. - Wall.
- H.L.R.R. - Hand laid rip-rap.
- Conc. Culvert - Means circular concrete culvert, which is either a-cast in place circular concrete culvert b- concrete pipe culvert.
- Box Culvert - Various reinforced concrete box culverts as detailed.
- Metal Culvert - Corrugated galvanized metal pipe culvert.
- C.D.I. - Concrete drop intake.
- M.D.I. - Masonry drop intake.
- C.H.W. - Concrete head wall.
- M.H.W. - Masonry head wall.
- C.B. - Catch Basin.
- Header - Lava rock header.
- Curb - Lava rock curb.
- T.P. - Telephone pole.
- E.P. - Electric pole.
- BT - Large tree.

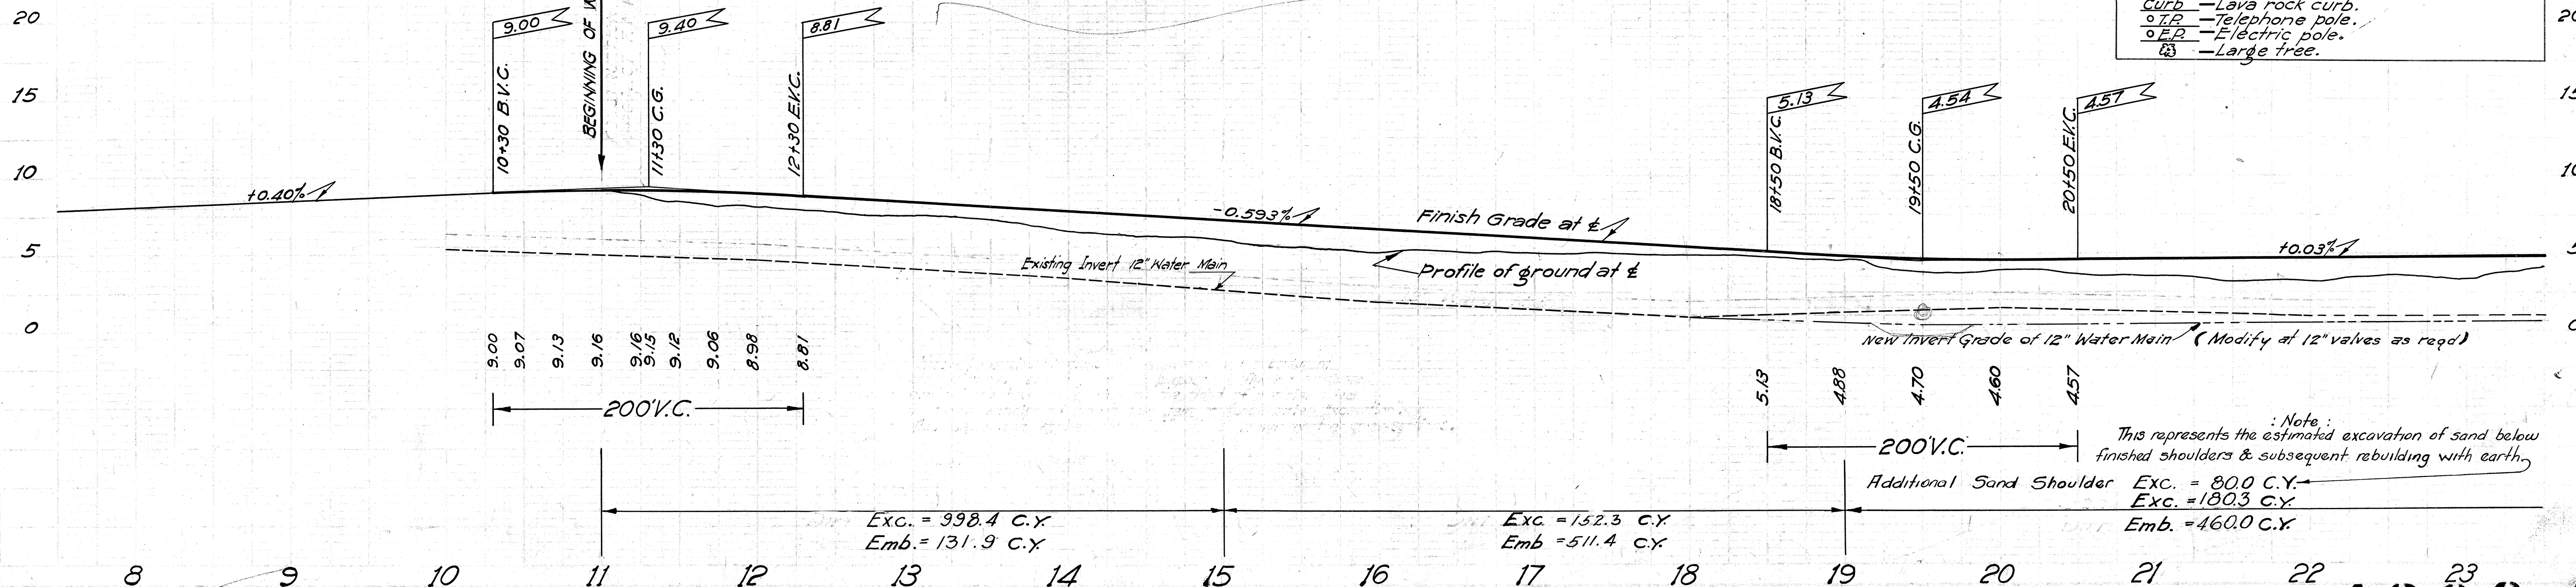

Note:
This represents the estimated excavation of sand below finished shoulders & subsequent rebuilding with earth.

