

INDEX TO DRAWINGS	
SHEET NO.	DESCRIPTION
1	Title Sheet
2	Typical Sections
3	Plan & Profile
4-5	Standard Detail Sheets 1 & 2

TERRITORY OF HAWAII

TERRITORIAL HIGHWAY DEPARTMENT

HONOLULU T.H.

PLANS OF

KALANIANA'OLE HIGHWAY

FEDERAL AID PROJECT NO. 6-D

REOPENED

HONOLULU DISTRICT

OAHU T.H.

CONVENTIONAL

Existing Road

Existing Fence

Boundary Line

Center Line

Paved Approaches, etc.

SIGNS



PLAN

PROFILE

SCALES

1 INCH
HOR 1 INCH
VER 1 INCH

100 FEET
100 FEET
10 FEET

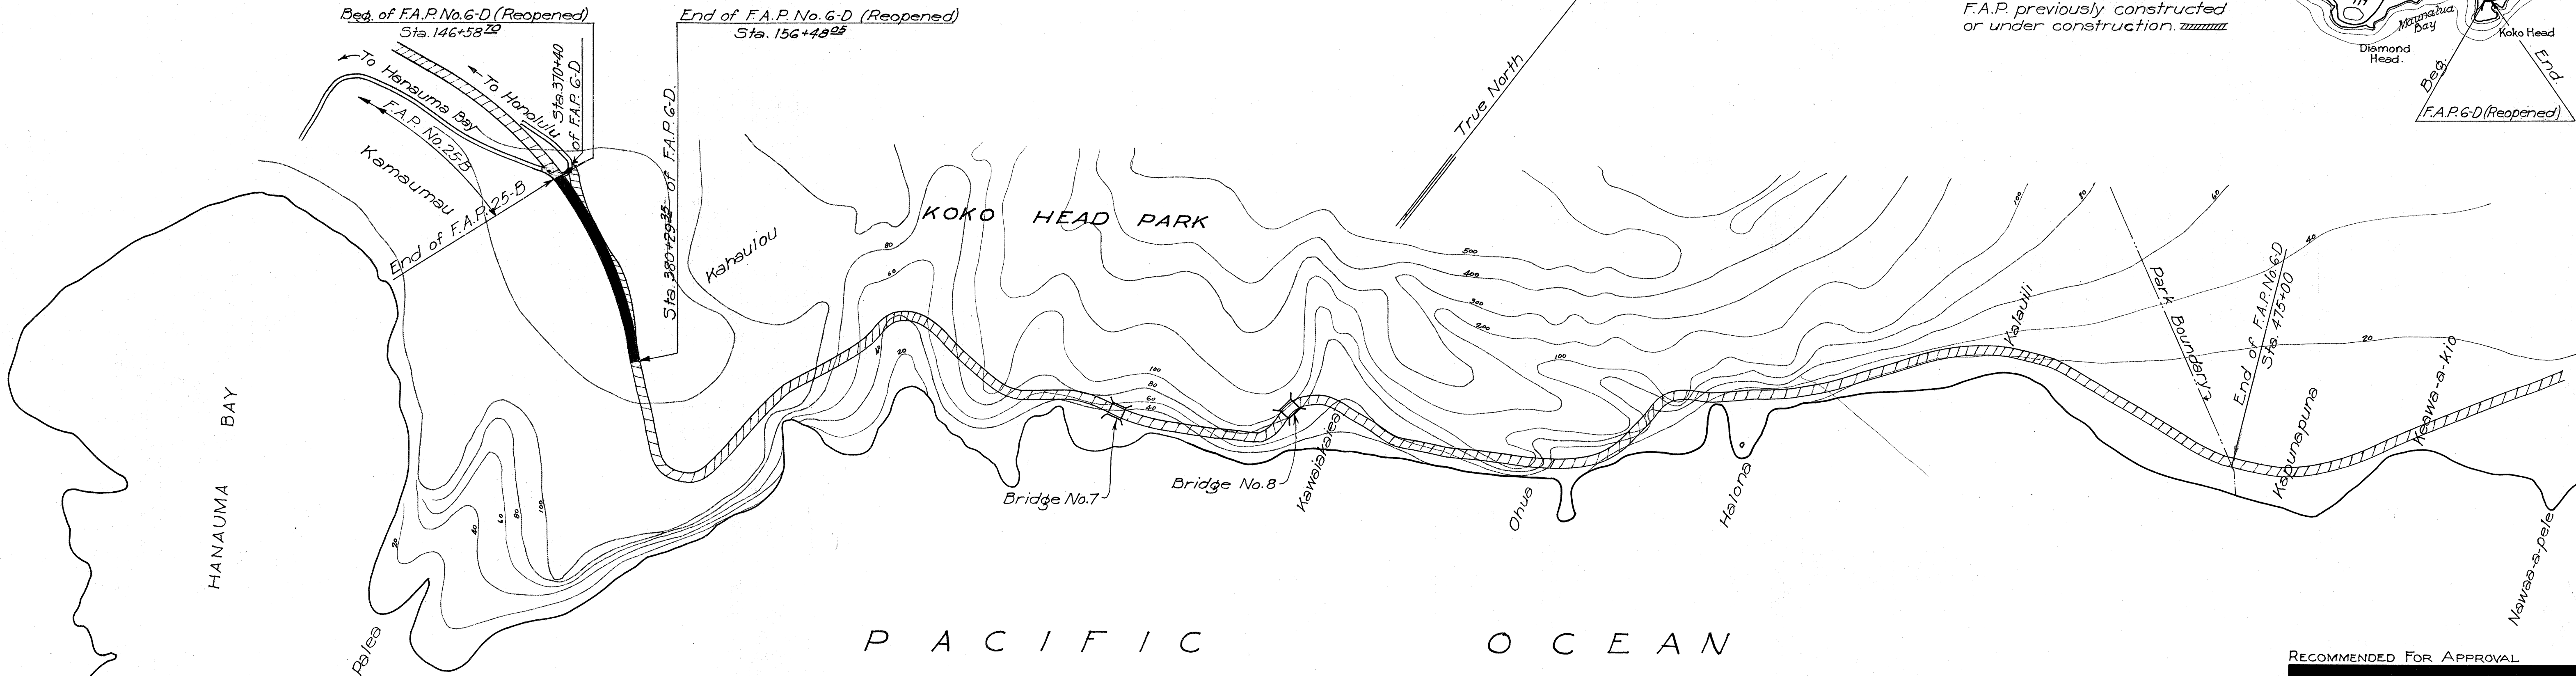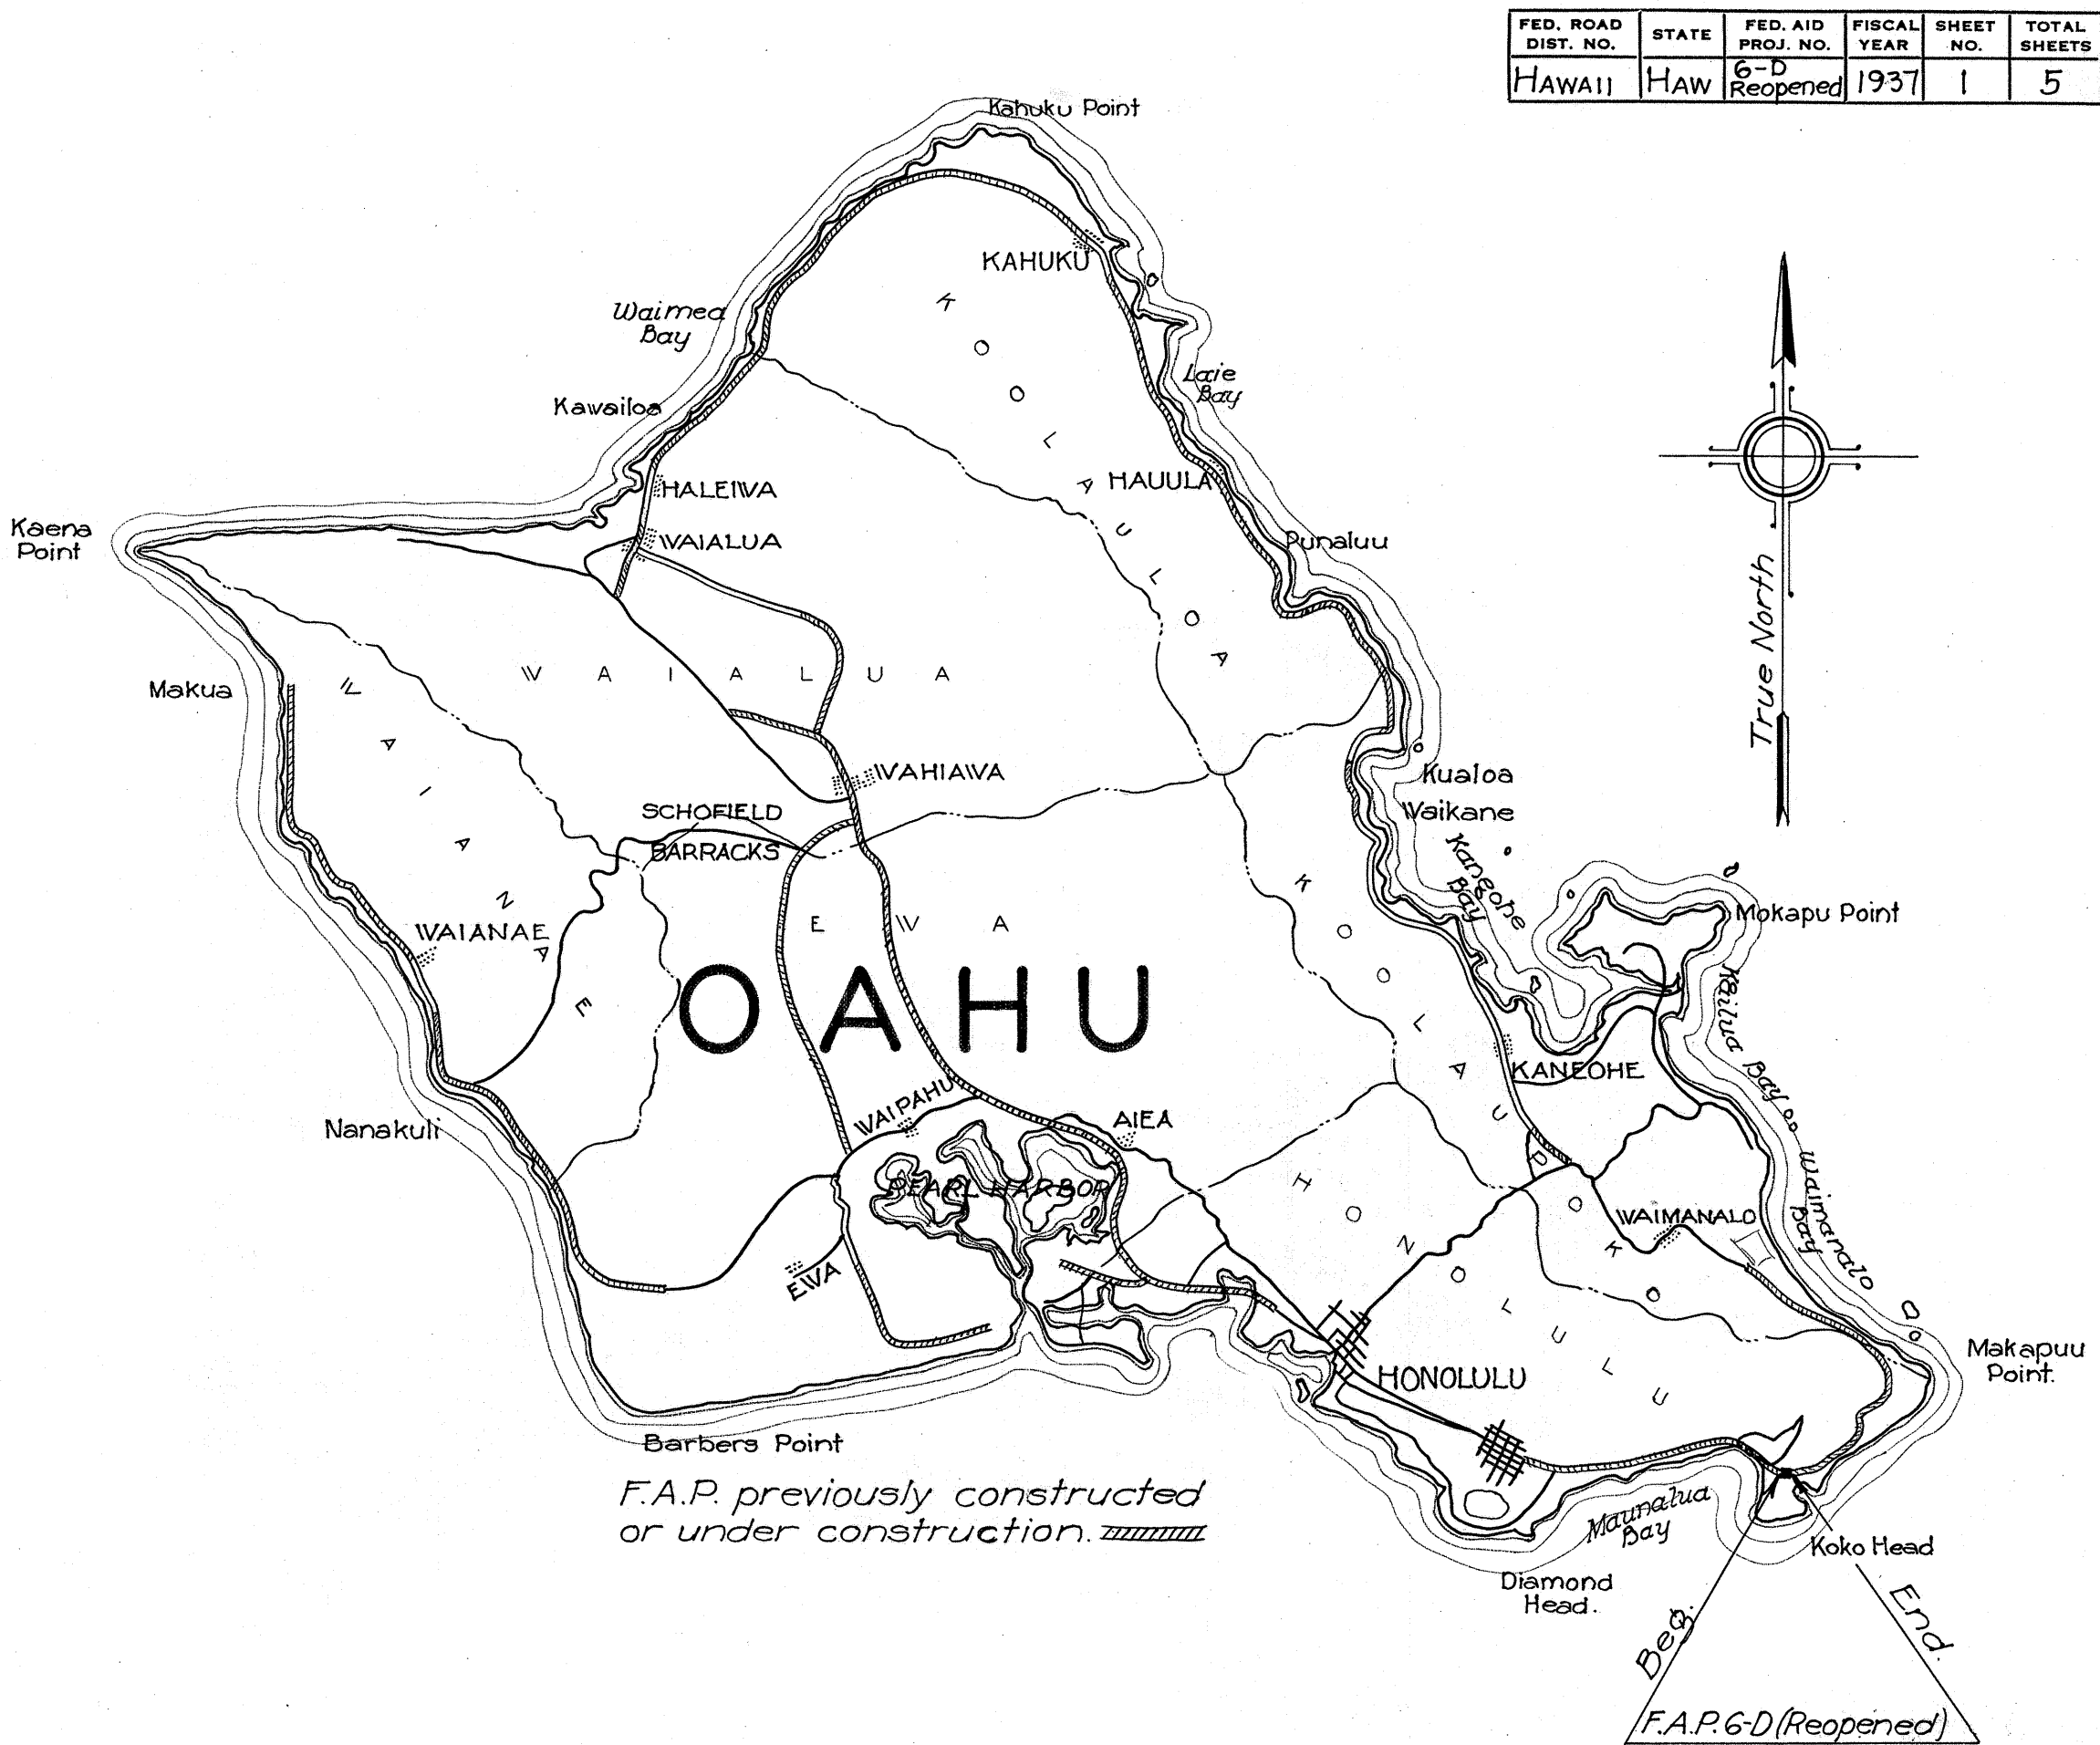

LAYOUT OF PROJECT

SCALE 1 INCH = 400 FEET

GROSS & NET LENGTH 0.187 MILES

APPROVED

John B. Cain

DATE May 22, 1937

Territorial Highway Engineer

RECOMMENDED FOR APPROVAL

Principal Highway Engineer, Bu. of Pub. Rds.

RECOMMENDED FOR APPROVAL

Chief Engineer, Bur. of Pub.

APPROVED

Chief, Bureau of Public Roads.