


B.M. No. 8 EL. 117.28
Top of Spike. P.I. No. 4


FED. ROAD DIST. NO.	STATE	FED. AID PROJ. NO.	FISCAL YEAR	SHEET NO.	TOTAL SHEETS
HAWAII	HAW	25-B	1937	5	32

PLAN	DATE	BY	CHECKED	DATE	BY
NOTE: ALL DIMENSIONS ARE IN FEET UNLESS OTHERWISE NOTED.					

PROFILE	DATE	BY	CHECKED	DATE	BY
NOTE: ALL DIMENSIONS ARE IN FEET UNLESS OTHERWISE NOTED.					

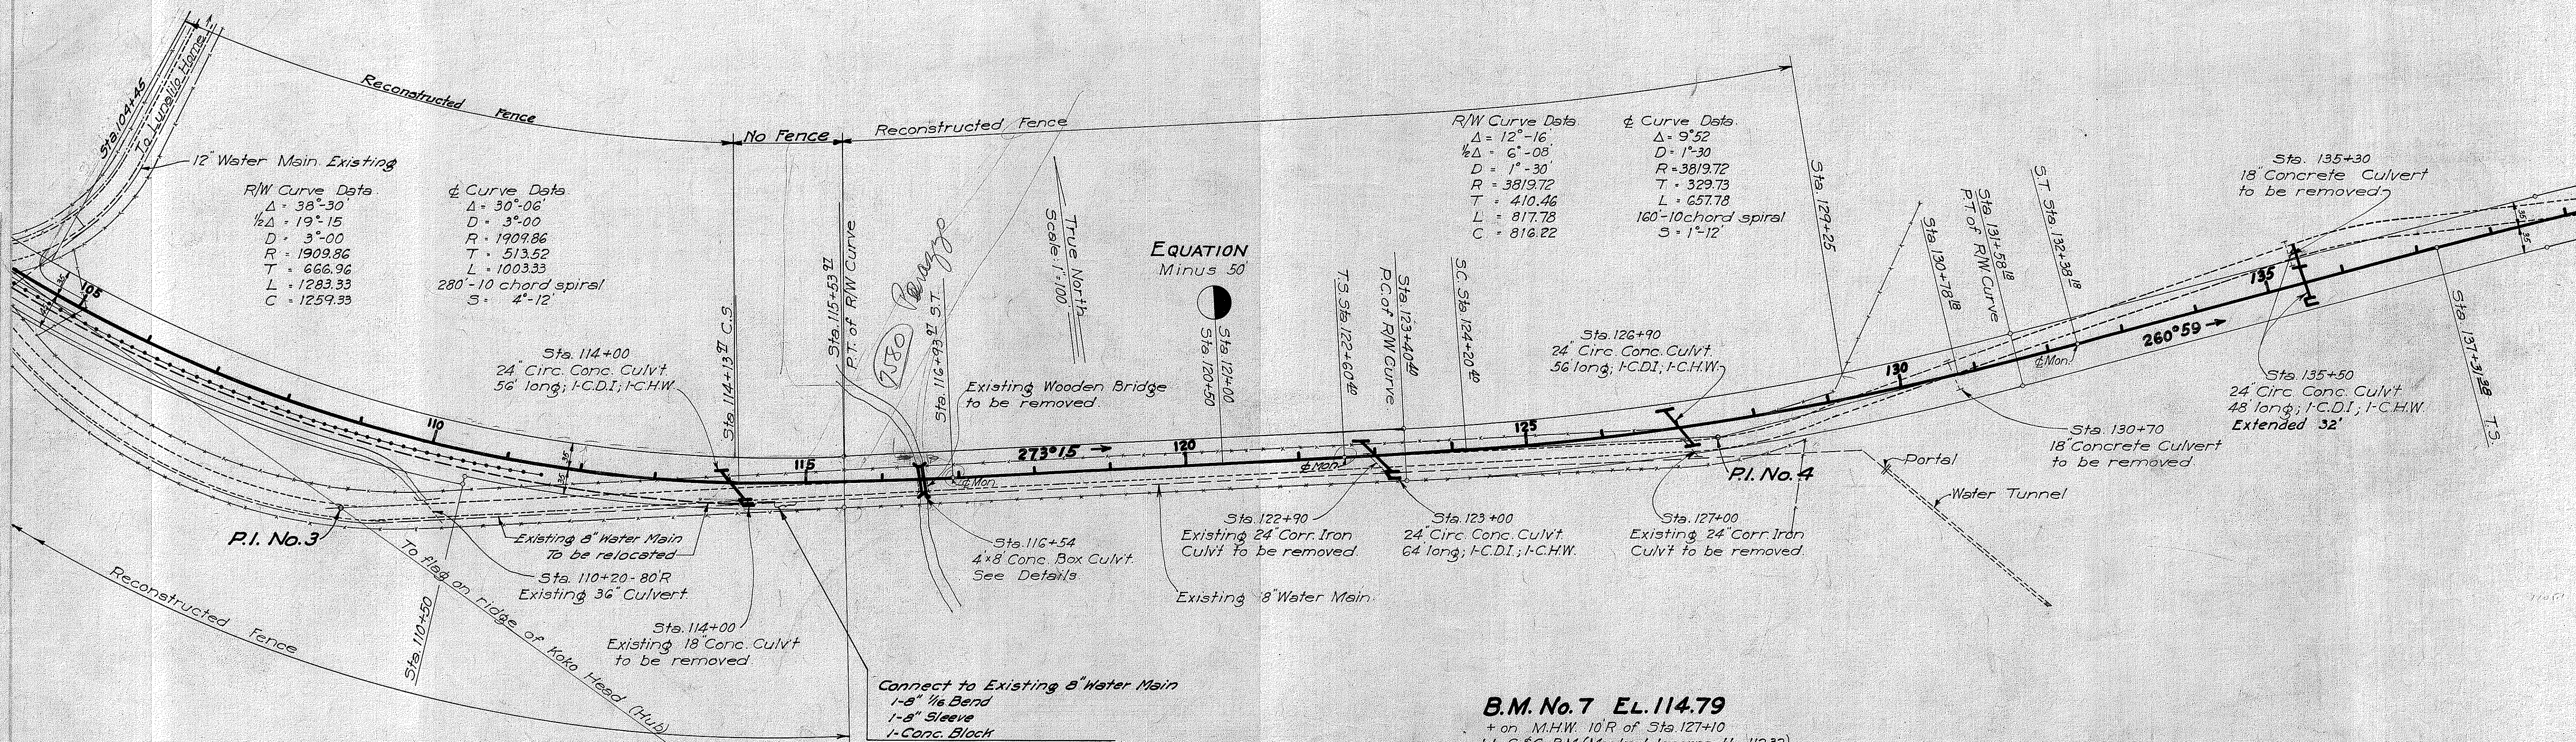

B.M. No. 7 EL. 114.79
+ on M.H.W. 10' R of Sta. 127+10
old C.C. B.M. (Marked Incorrectly 112.32)

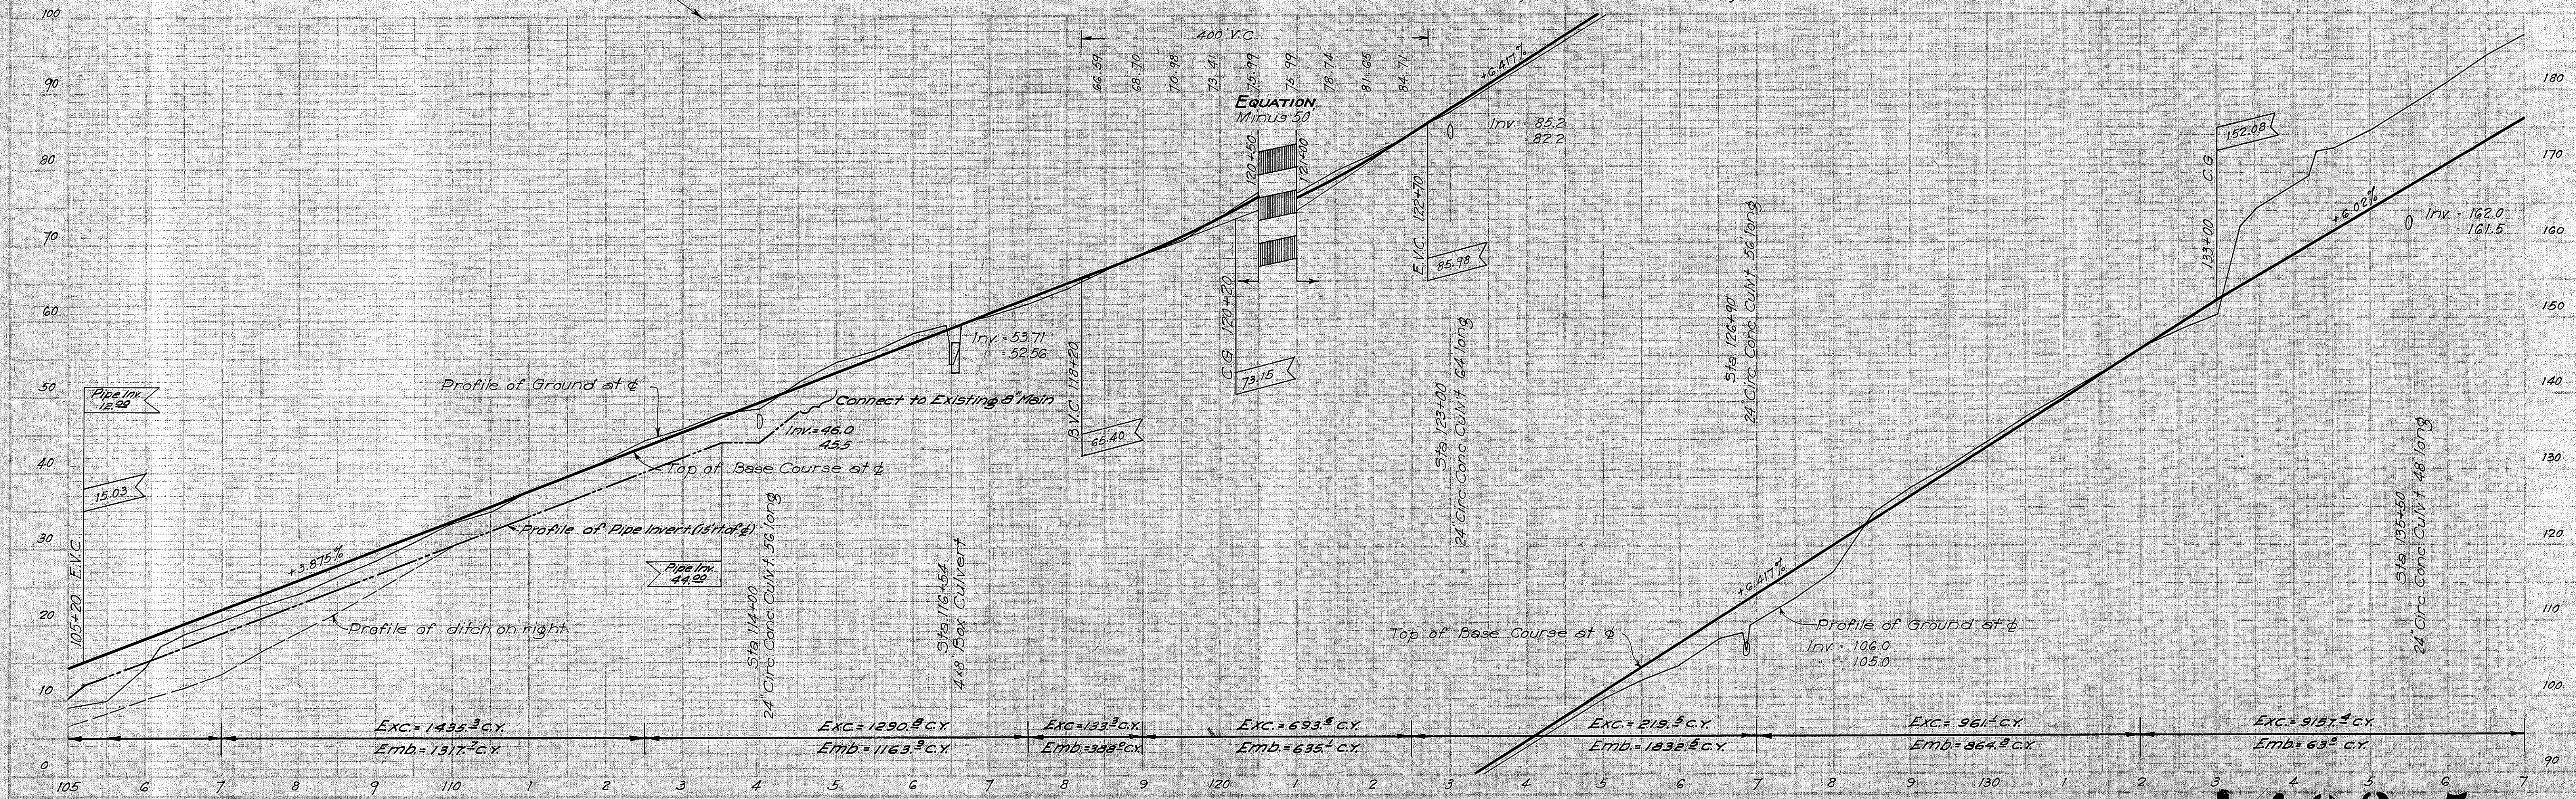



4402.5

FED. ROAD DIST. NO.	STATE	FED. AID PROJ. NO.	FISCAL YEAR	SHEET NO.	TOTAL SHEETS
HAWAII	HAW.	25-B	1937	6	32

FED. ROAD DIST. NO.	STATE	FED. AID PROJ. NO.	FISCAL YEAR	SHEET NO.	TOTAL SHEETS
HAWAII	HAW.	G-D(R)	1937	3	5

PLAN	DATE	BY	CHECKED
	Apr. 1937	R. J. C. Smith	R. J. C. Smith
NOTE: BOOK NUMBER CHECKED. REVISIONS LISTED HERE.			
NO.			

PROFILE	DATE	BY	CHECKED
	Apr. 1937	R. J. C. Smith	R. J. C. Smith
NOTE: BOOK NUMBER CHECKED. REVISIONS LISTED HERE.			
NO.			

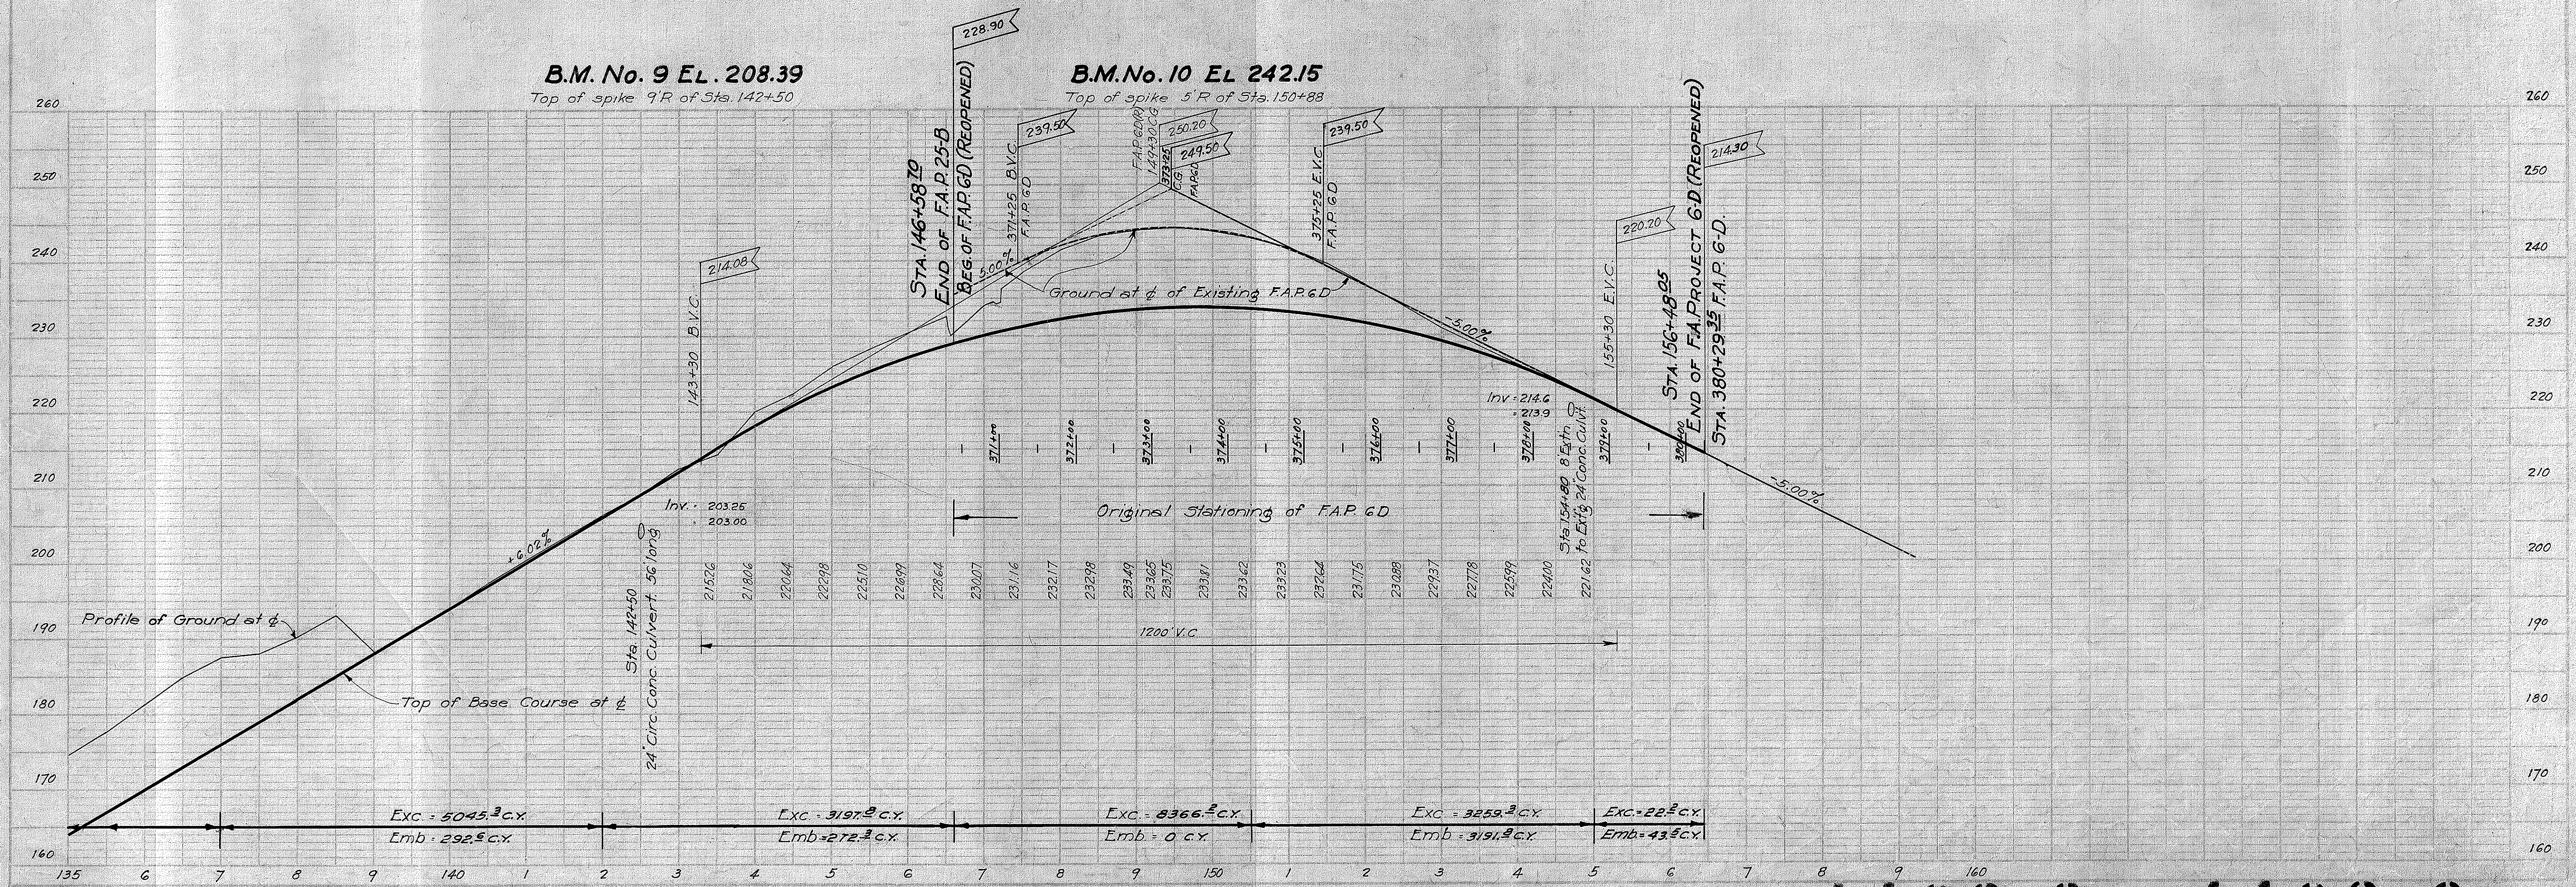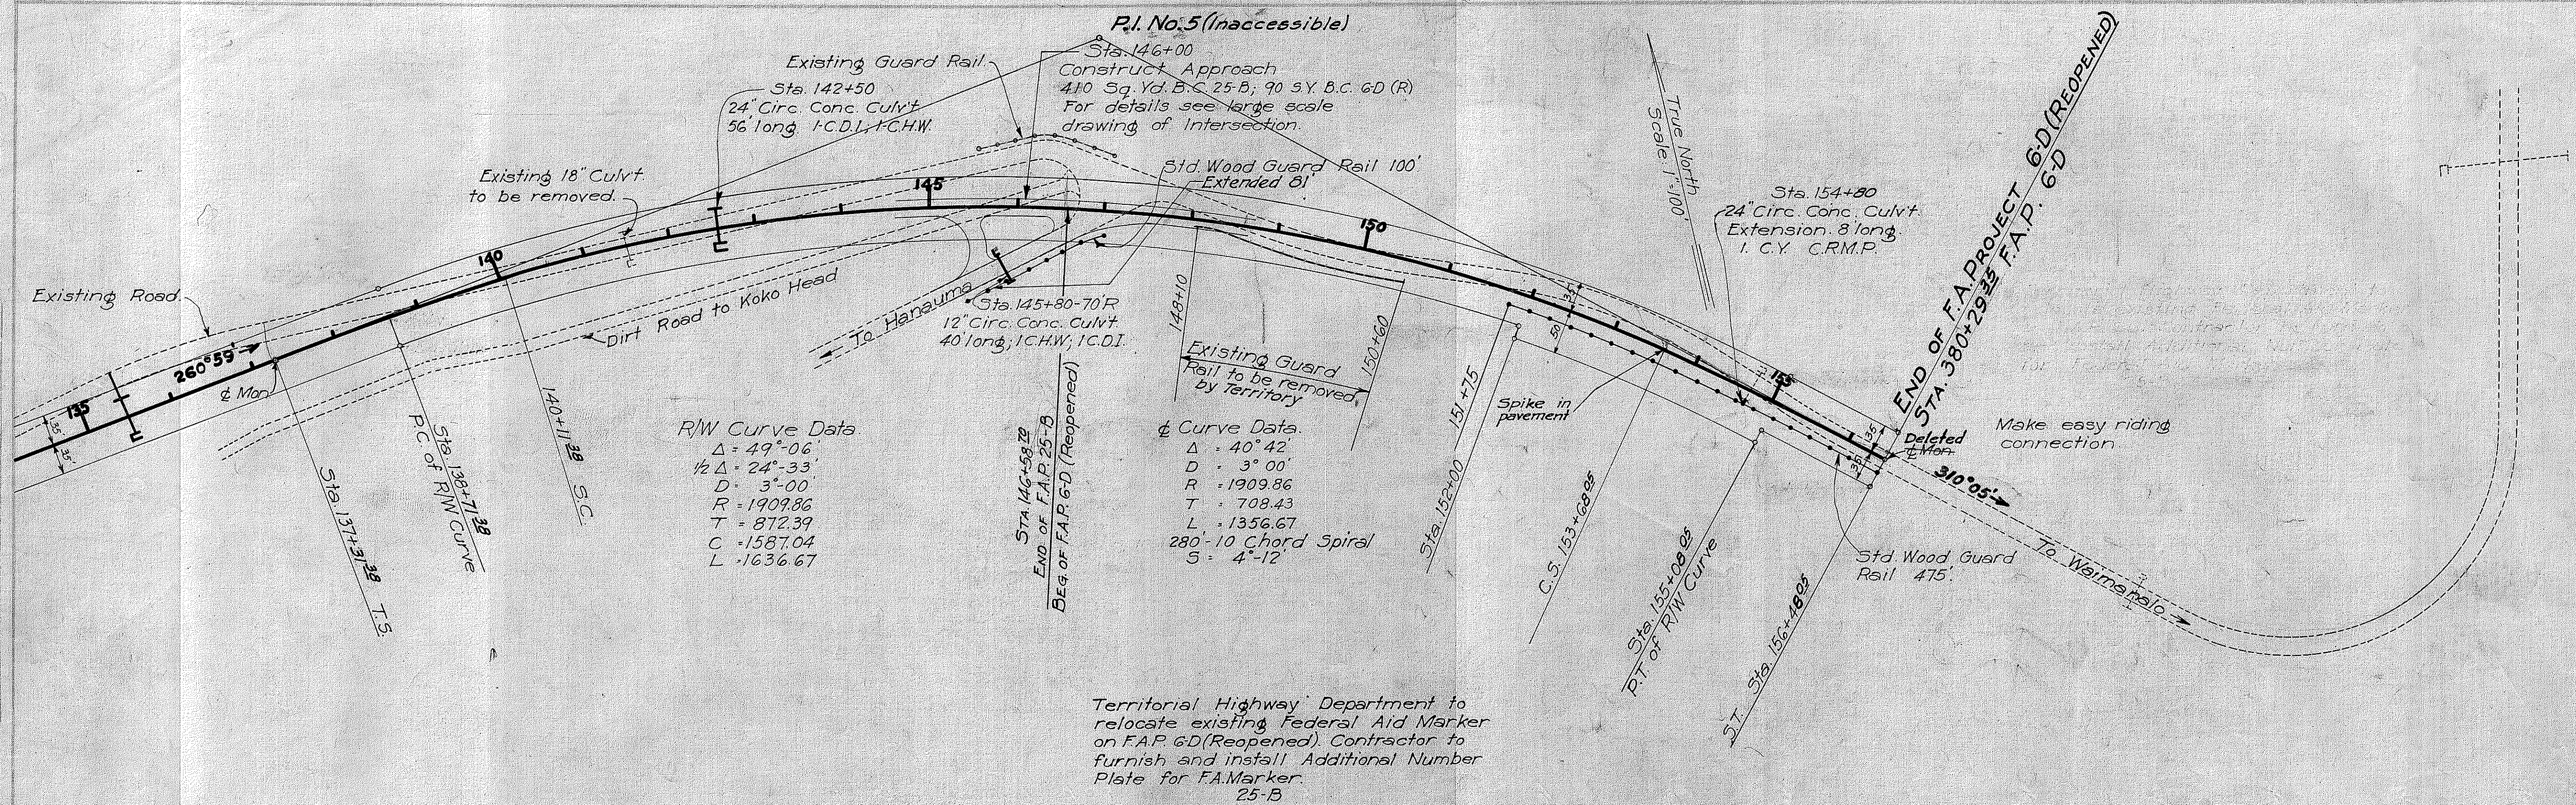

4403.3 4402.6