	INDEX TO DRAWINGS	
SHEET NO DESCRIPTIONS		
1	Title Sheet	
2	Typical Sections	
3-6	Plan & Profile	
7	Intersections & Water Main Details	
8-9	Standard Details Sh * 1 6/2	
10	Culvert Details	
-11-14	Bridge Details	
16 - 32	Cross Sections	

CONVENTIONAL

Existing Road
Existing Fence
Doundary Line
Center Line
Paved Approaches etc.

SURVEY PLOTTI
DESIGNED BY
DRAWN BY
TRACED BY
QUANTITIES BY


SIGNS


TERRITORY OF HAWAII TERRITORIAL HIGHWAY DEPARTMENT HONOLULU T.H.

PLANS OF KALANIANAOLE HIGHWAY FEDERAL AID PROJECT NO. 25-B

MAUNALUA SECTION HONOLULU DISTRICT OAHU T.H.

	SCALE	
PLAN	I INCH -	
PROFILE	(HOR I INCH VER I INCH	100 FEET
CROSS SECTIO		5 FEET
011000 000110	" (VER. I INCH	5 FEET

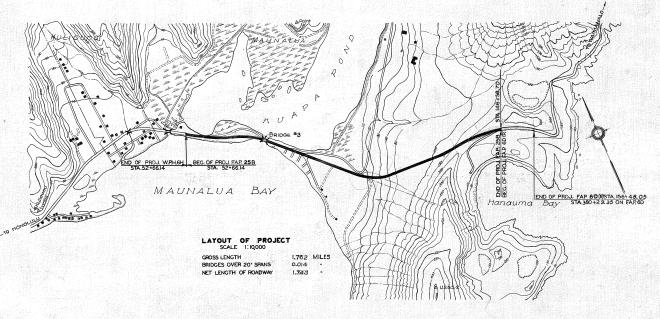

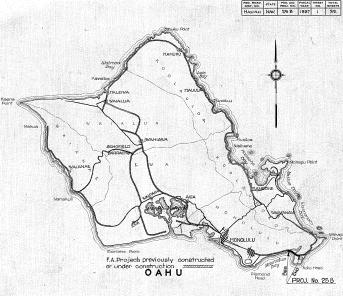

APPROVED

JANUS B. C. May 22 1997

TERRITORIAL HIGHWAY ENGINEER

RECOMMENSED FOR APPROVAL

PRINCIPAL HIGHWAY ENGINEER, BU, OF PUB. R

RECOMMENDED FOR APPROVAL

CHIEF ENGINEER Burgau of Public Roade.

APPROVED

CHIEF, Bureau of Public Rosds