


DETAIL OF ROADSIDE PLANTING

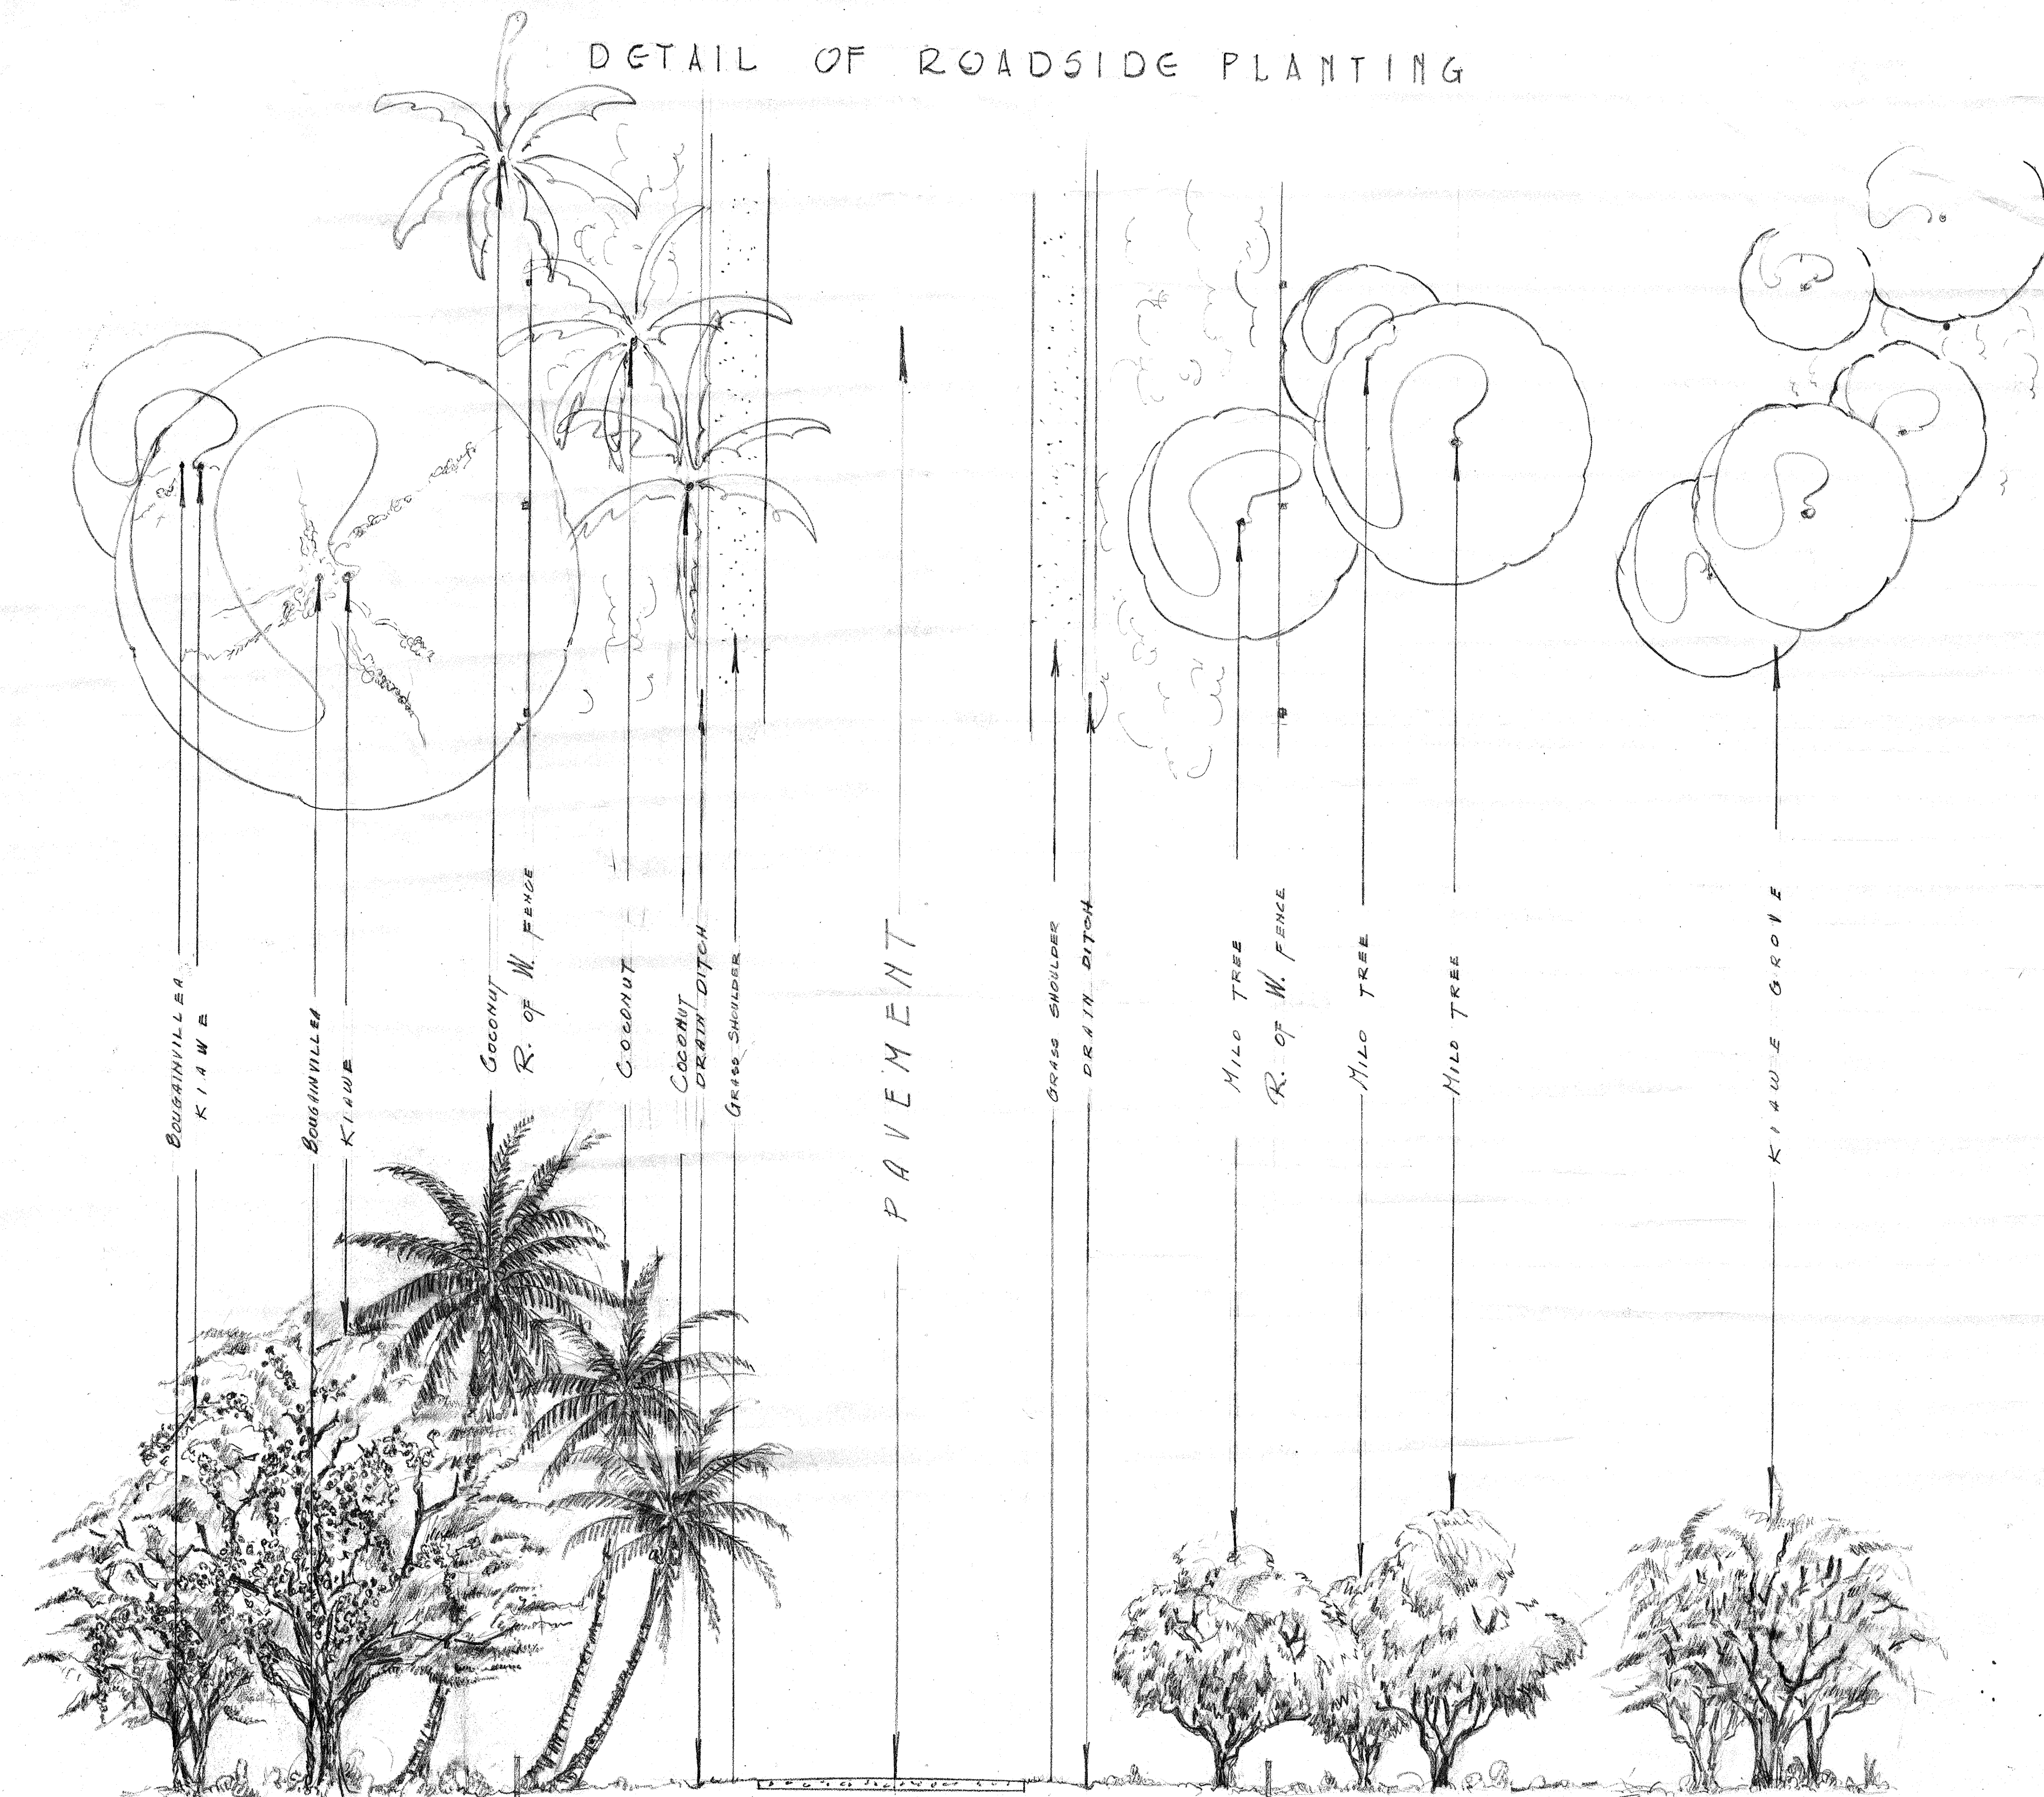

CROSS SECTION OF ROADSIDE PLANTING

NEAR STATION 3+00

SCALE 1" = 10 FT.

LANDSCAPE PLANS FOR
FEDERAL AID PROJECT
No. F.A.P. 6-E

SCALE 1" = 100 FEET

R. C. TONGG • LANDSCAPE ARCHITECT
HONOLULU • HAWAII

APPROVED: _____ DATE: _____

Louis B. Cain
FED. HIGHWAY ENGINEER