



No 6D

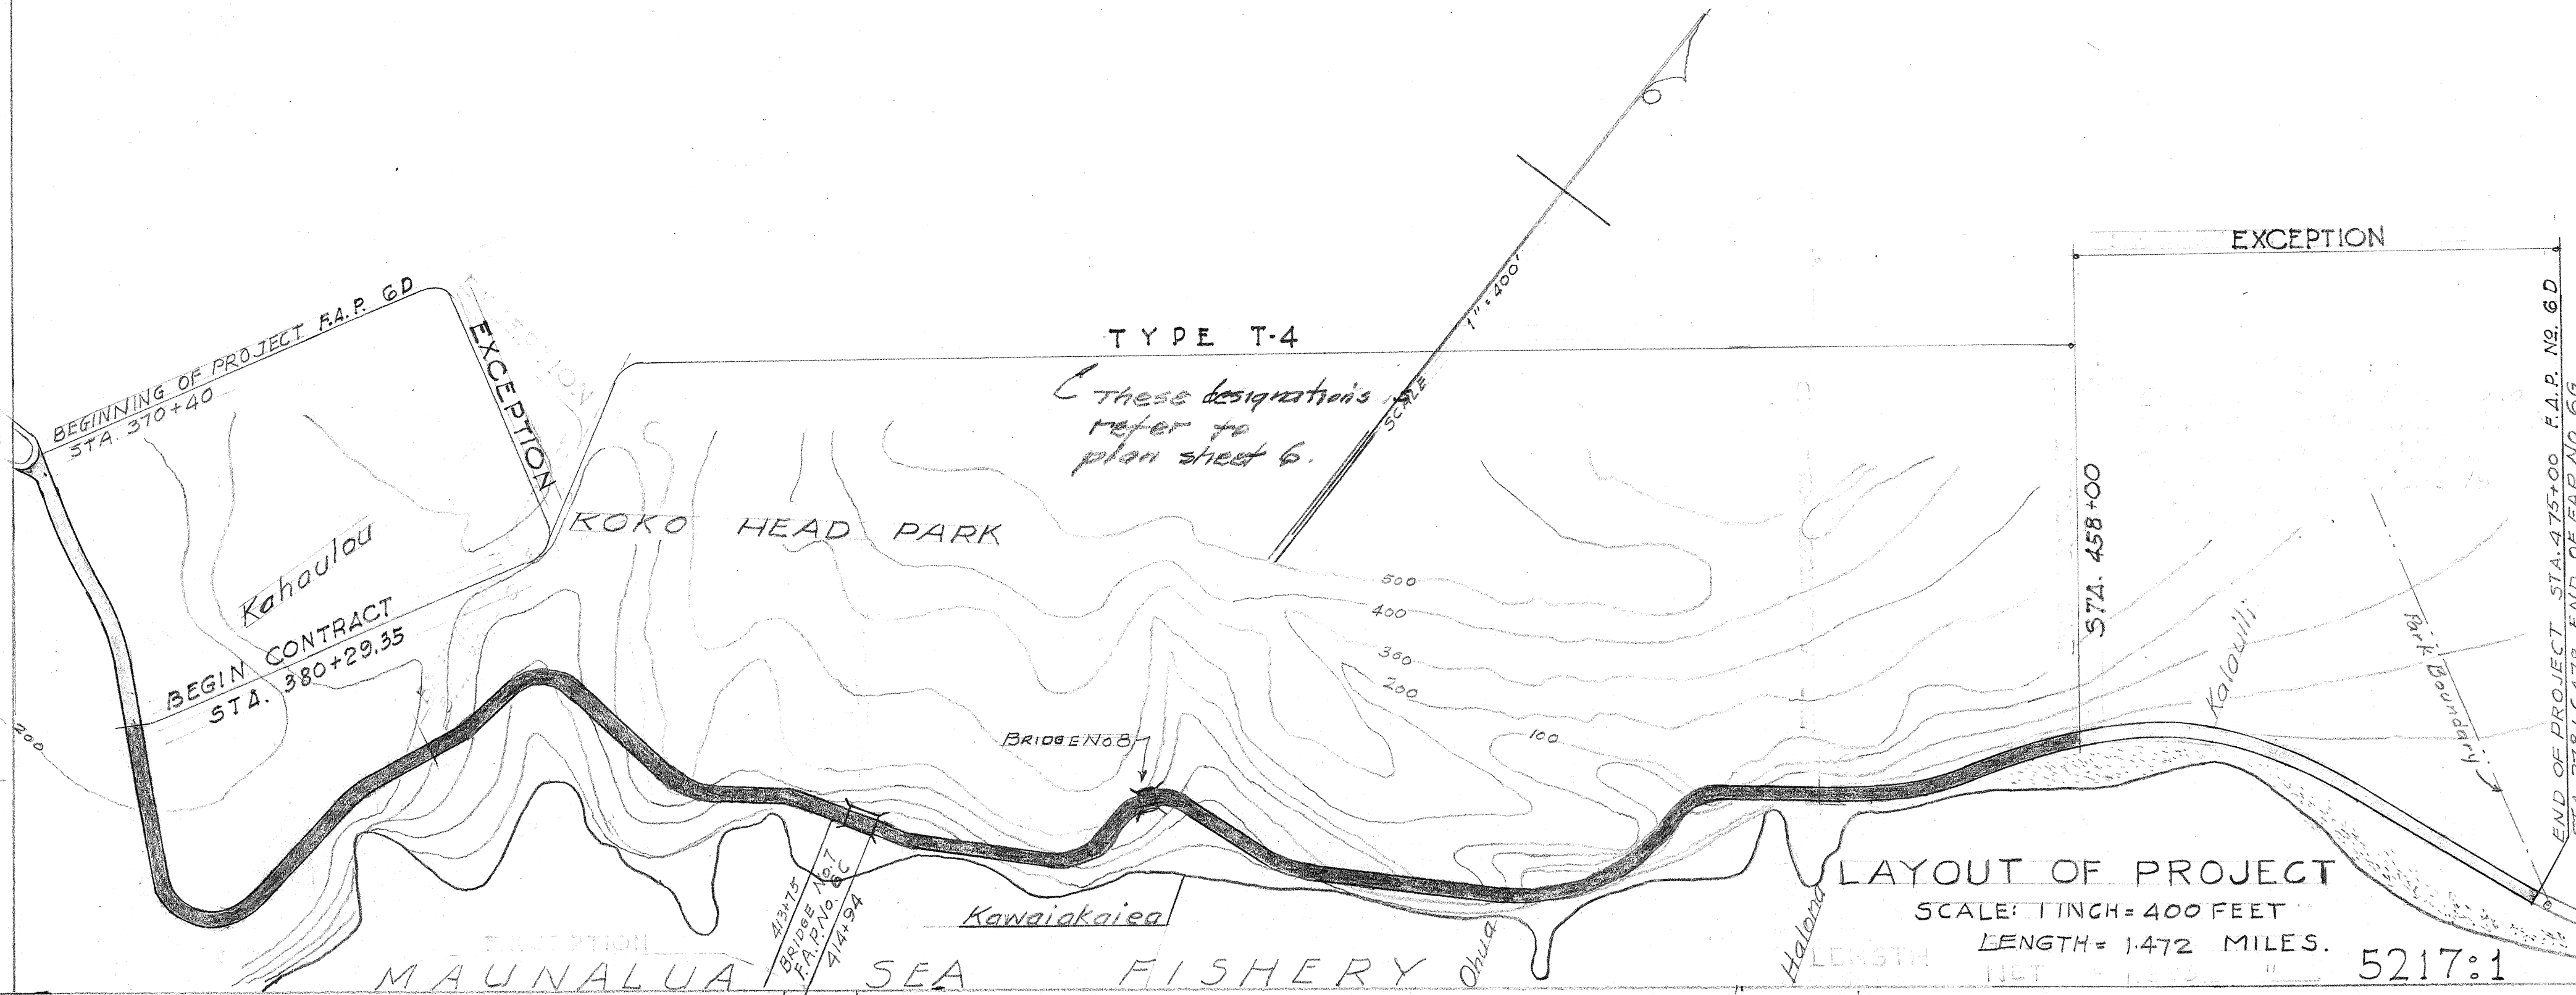


No. 6 G


1

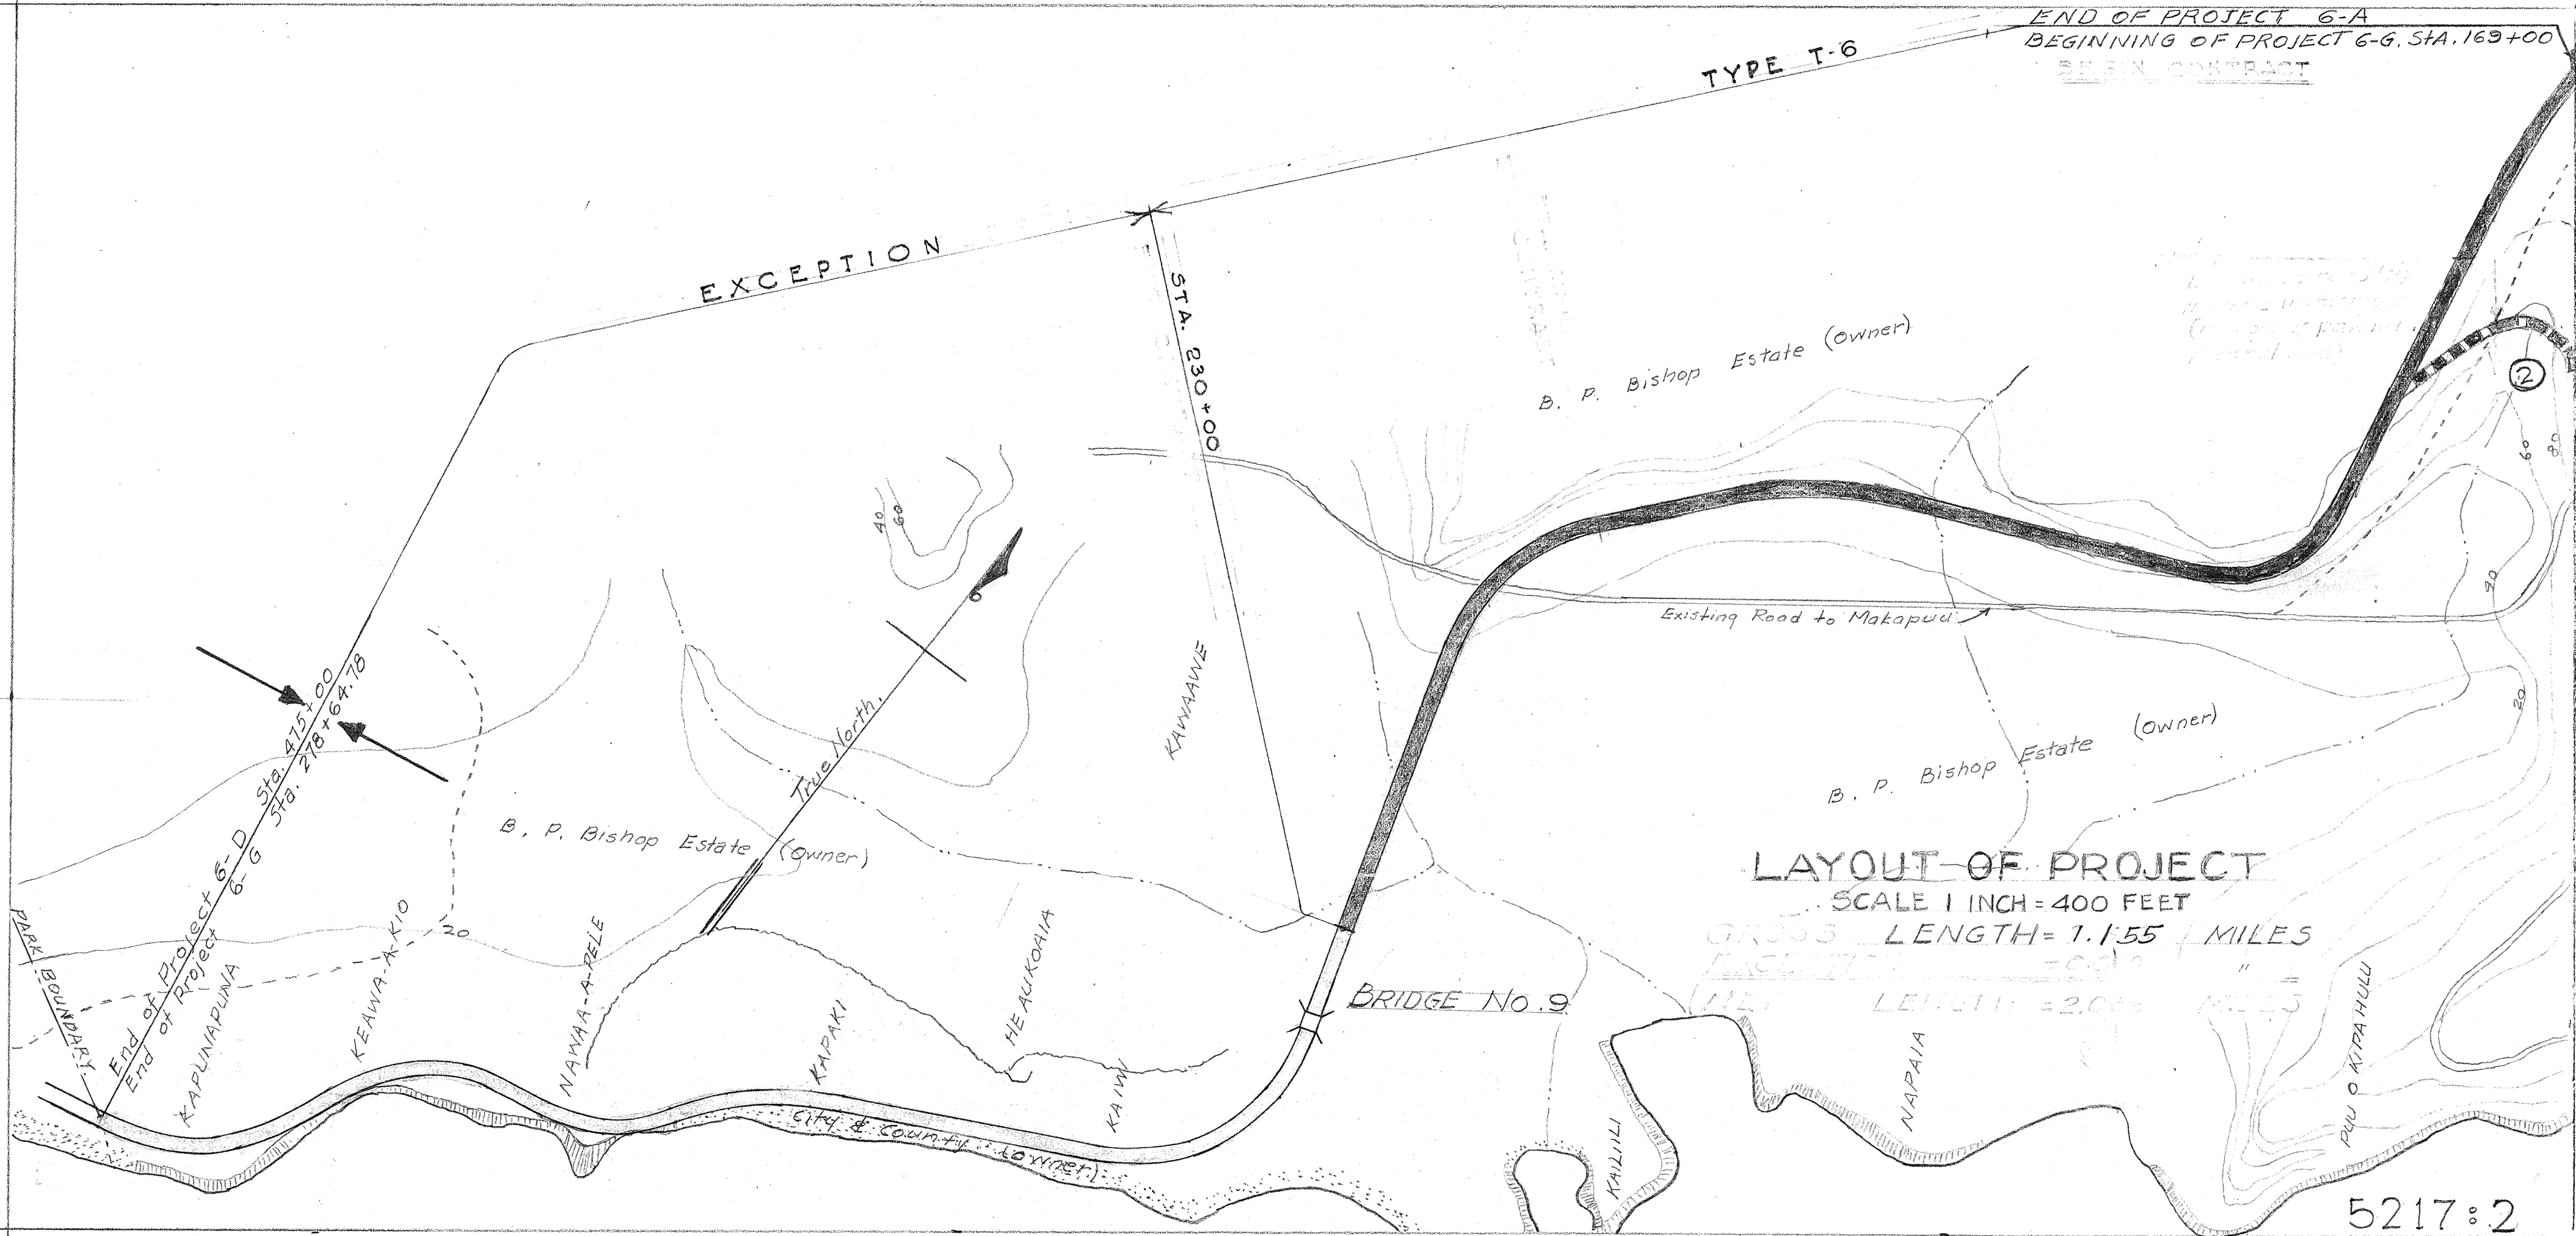

No 6-A

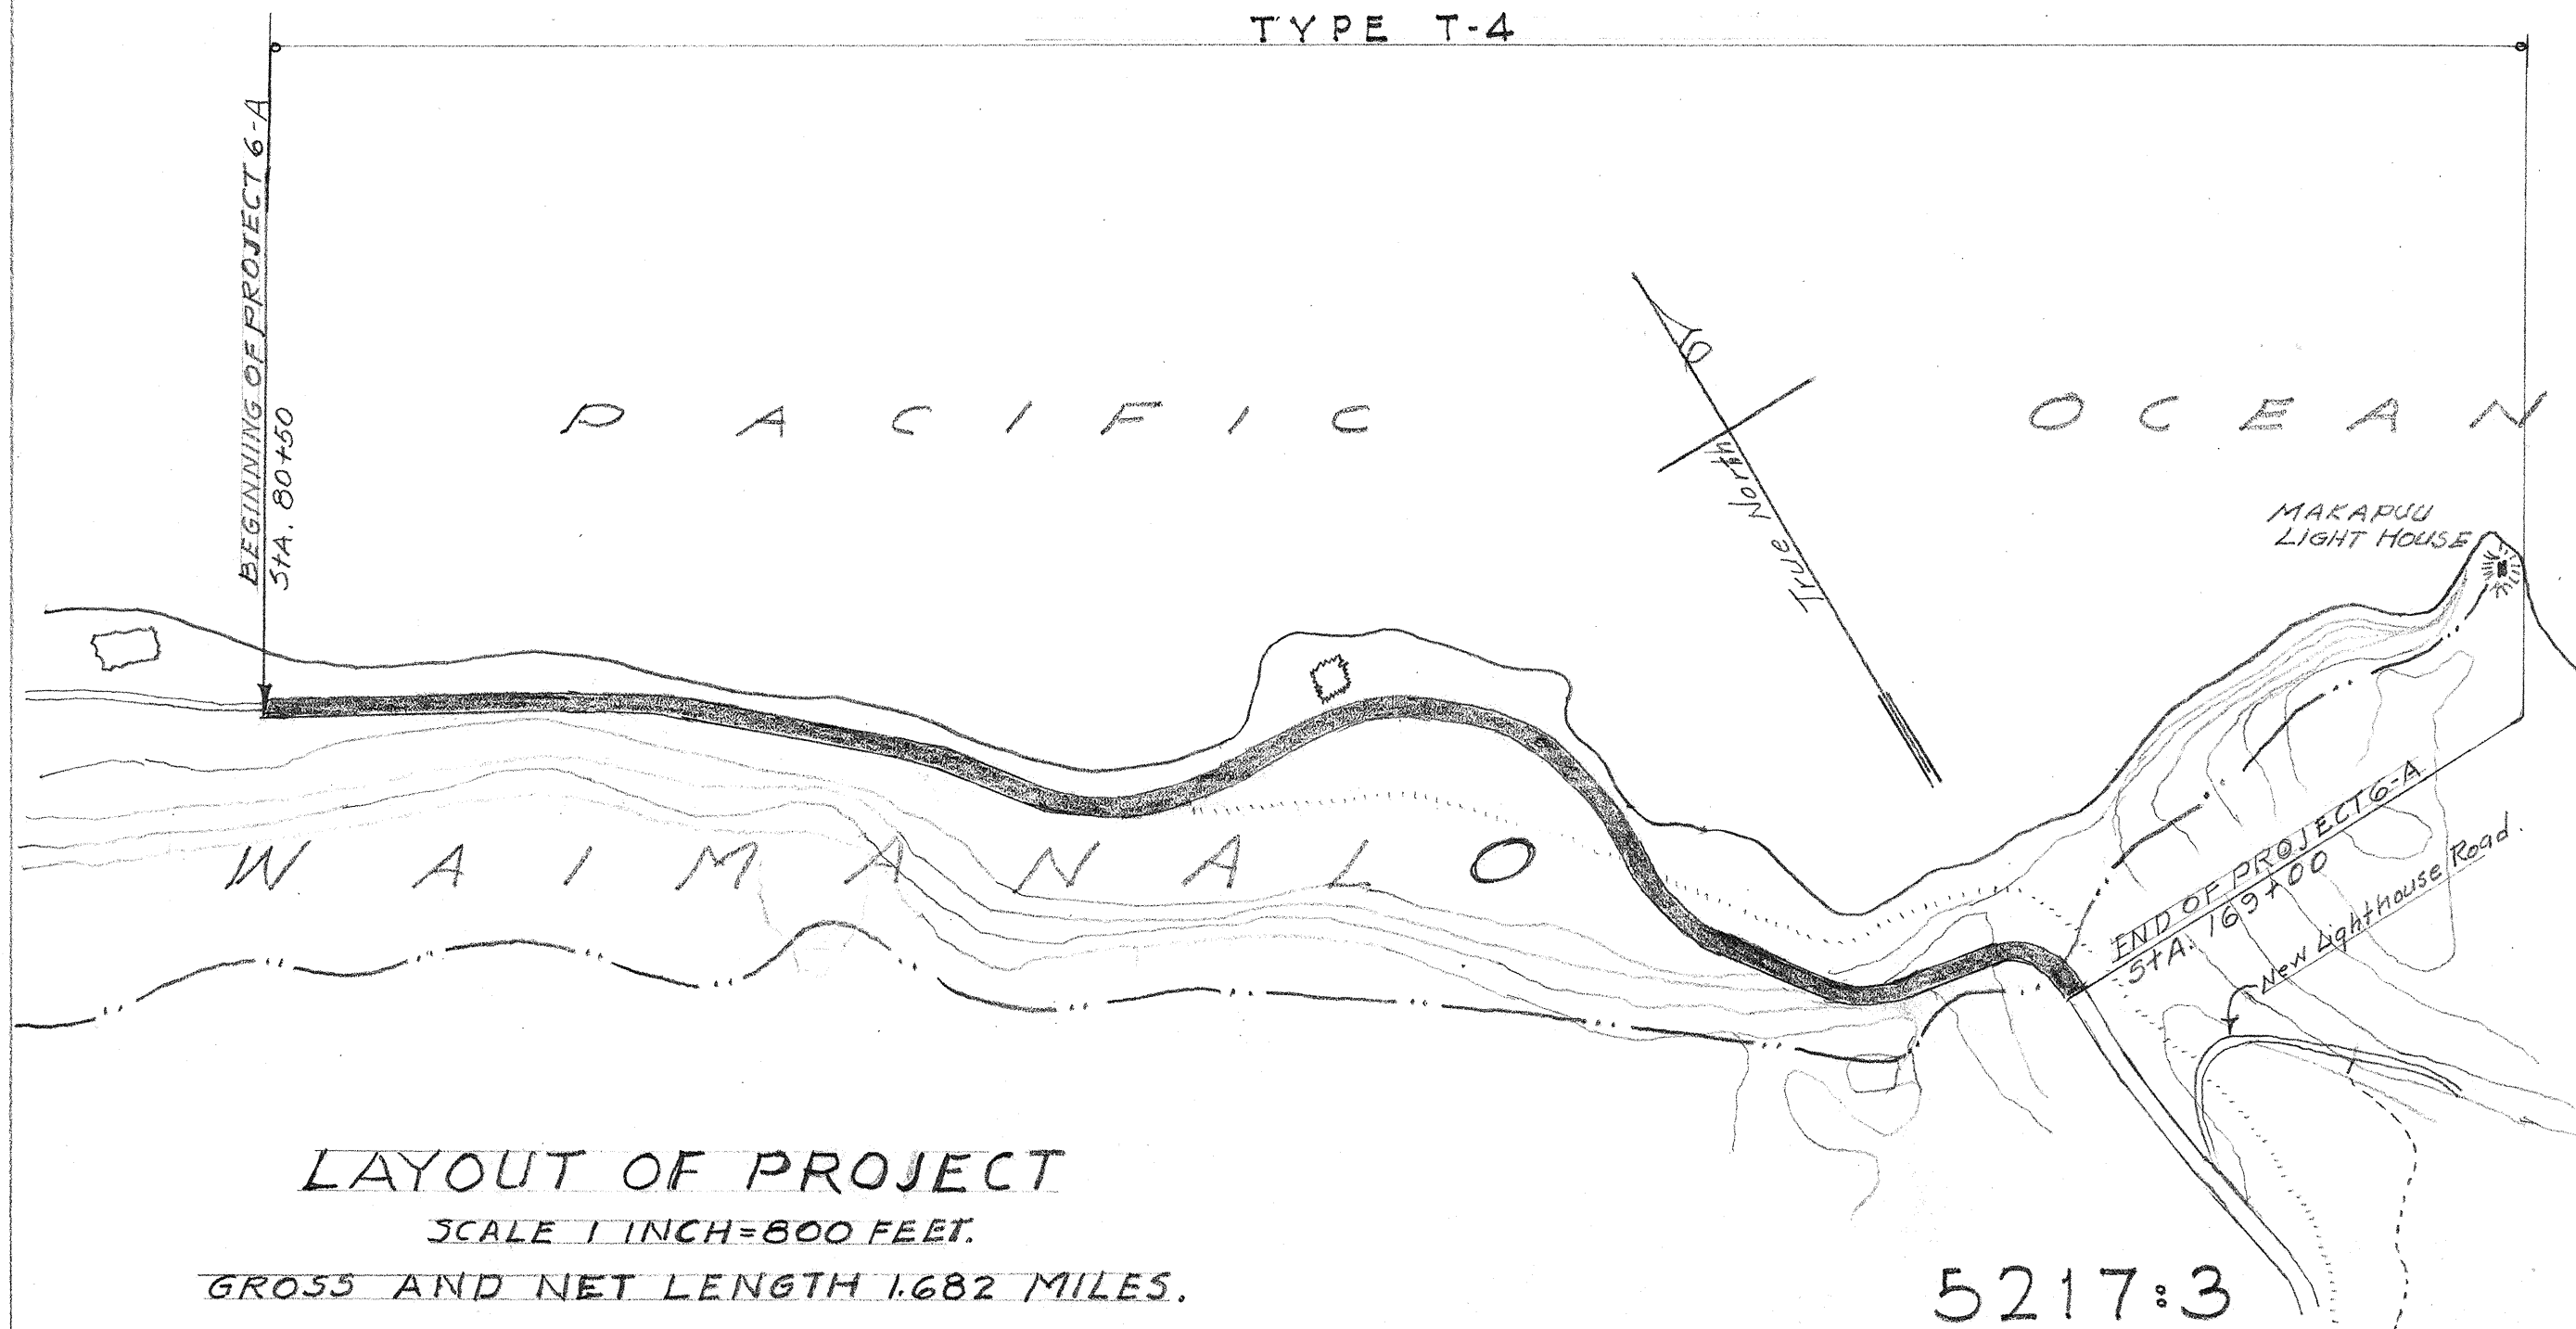

No. 6F

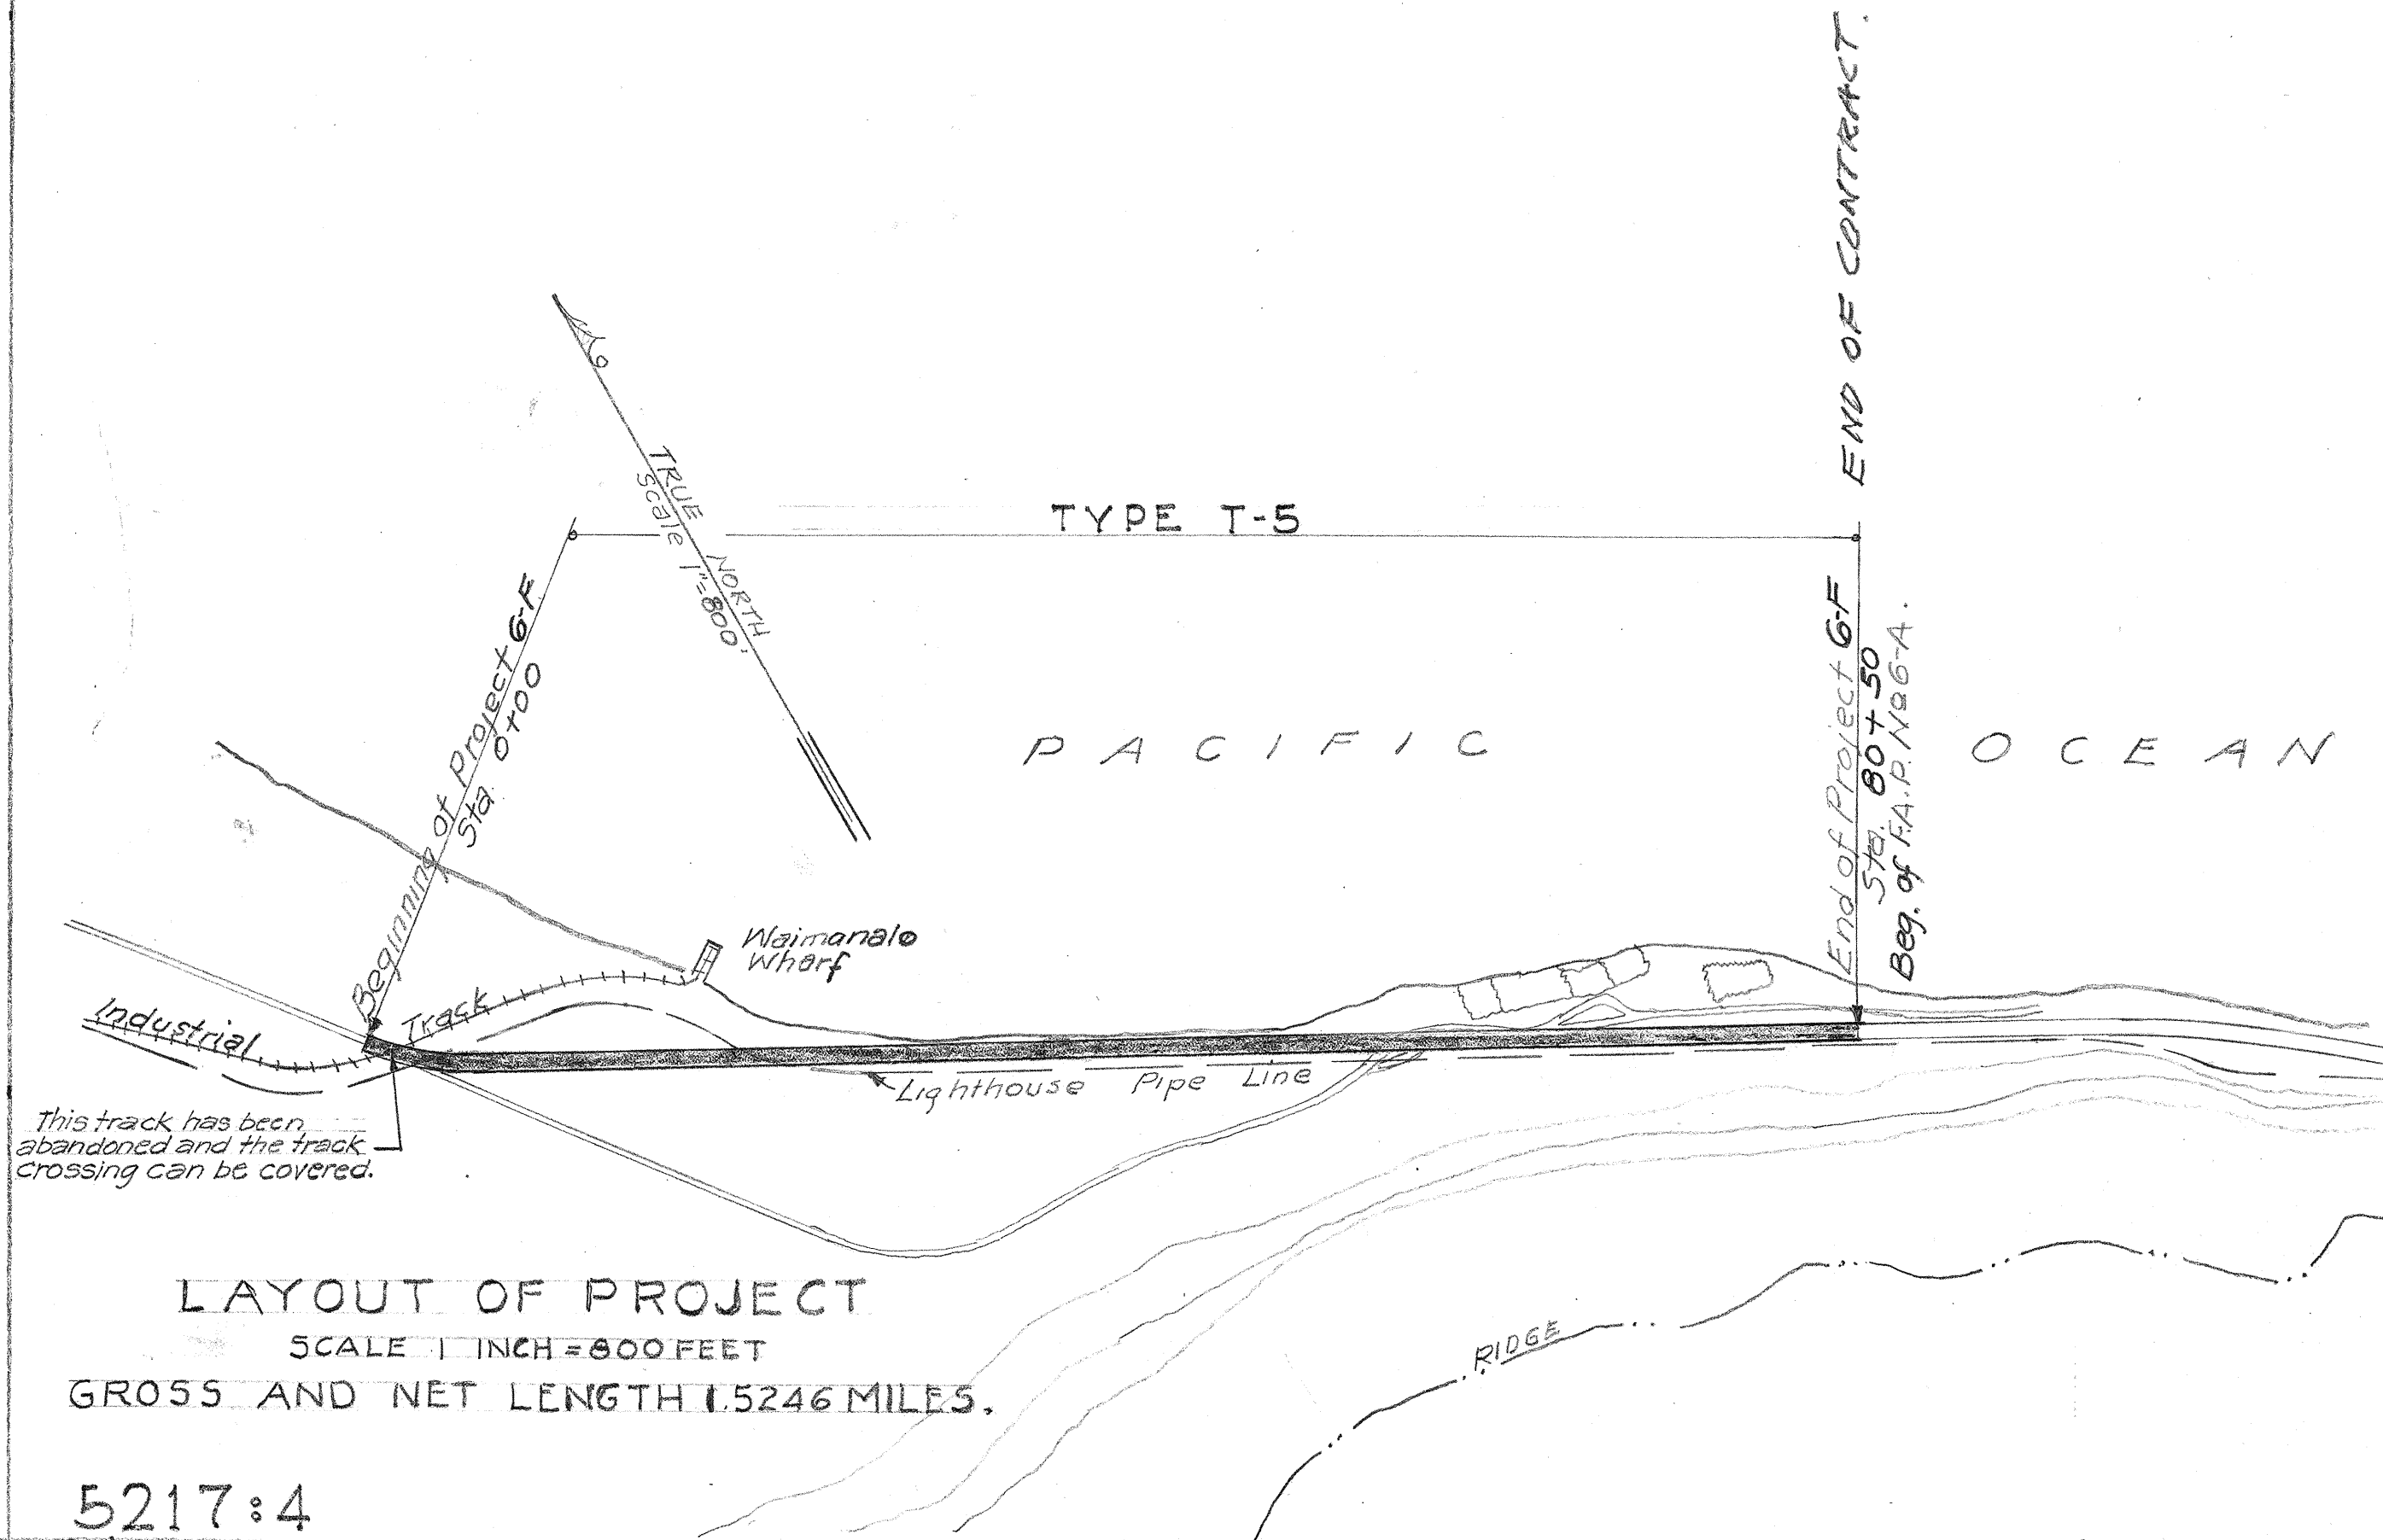

5217:4