

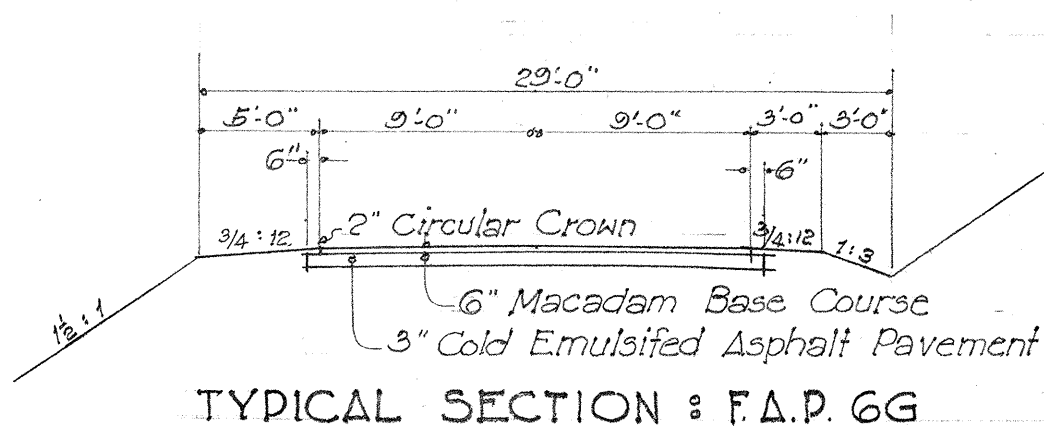
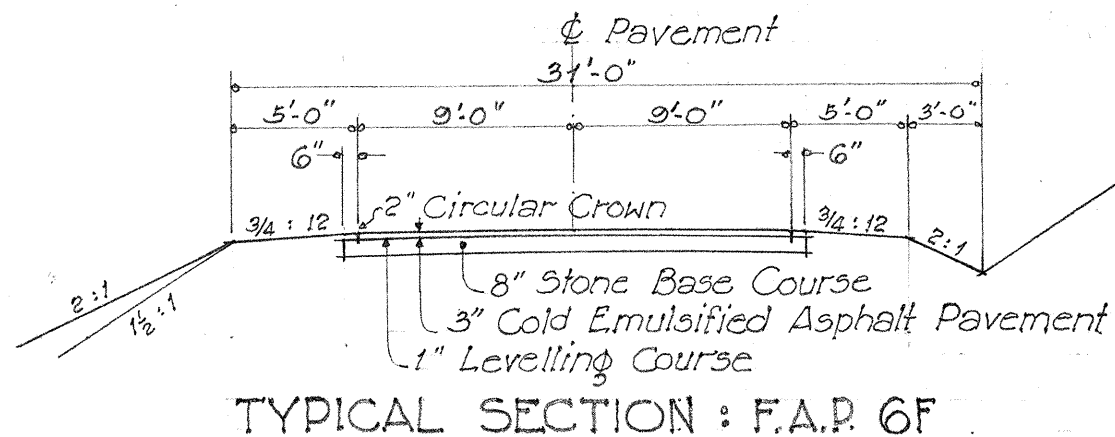
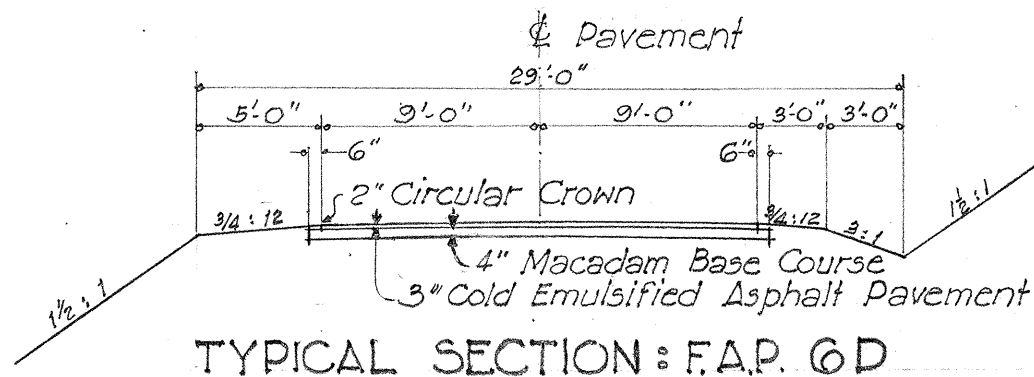
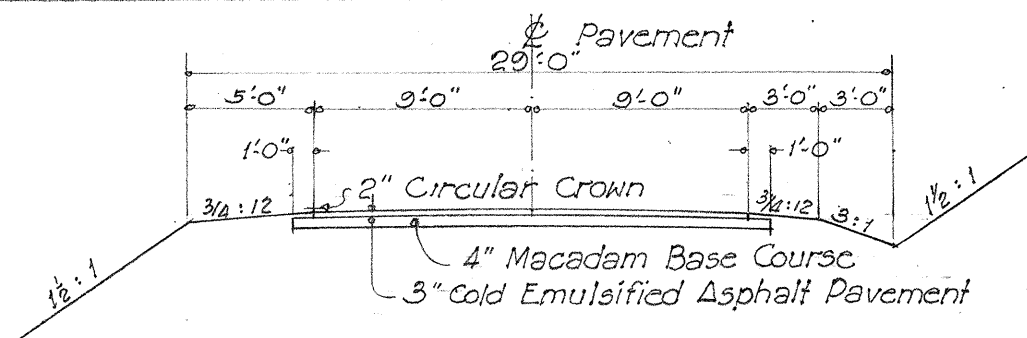
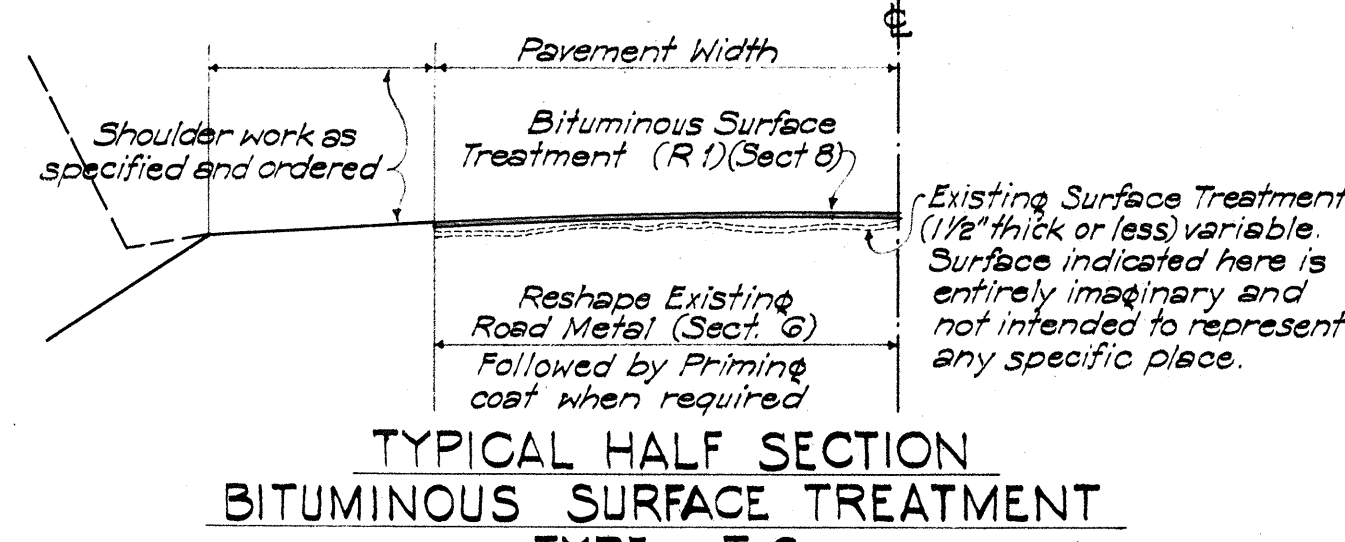
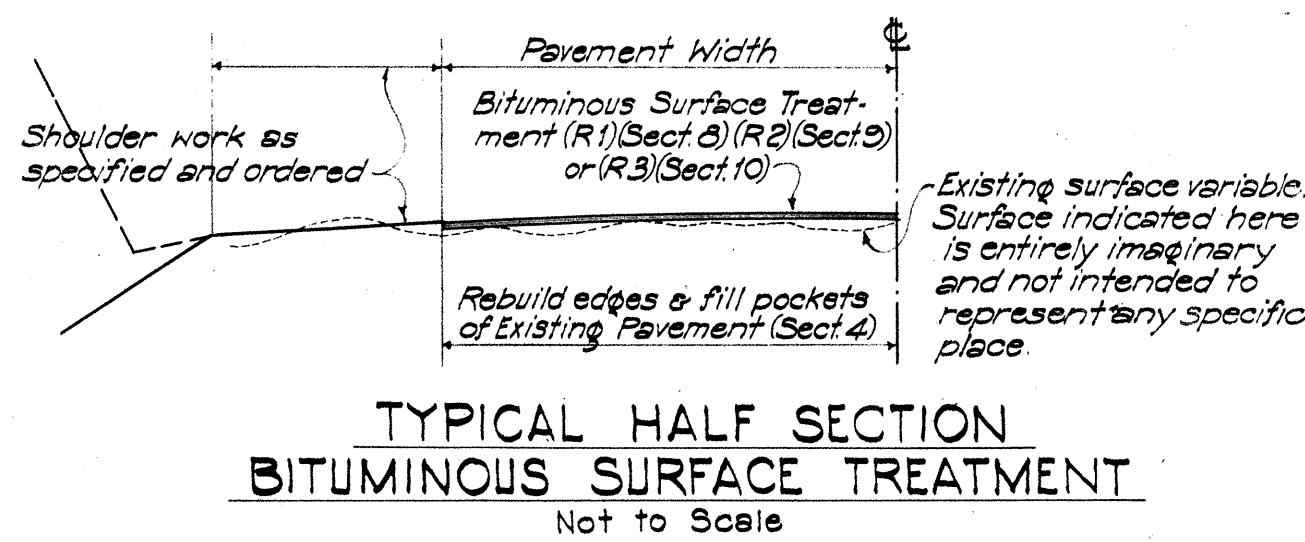
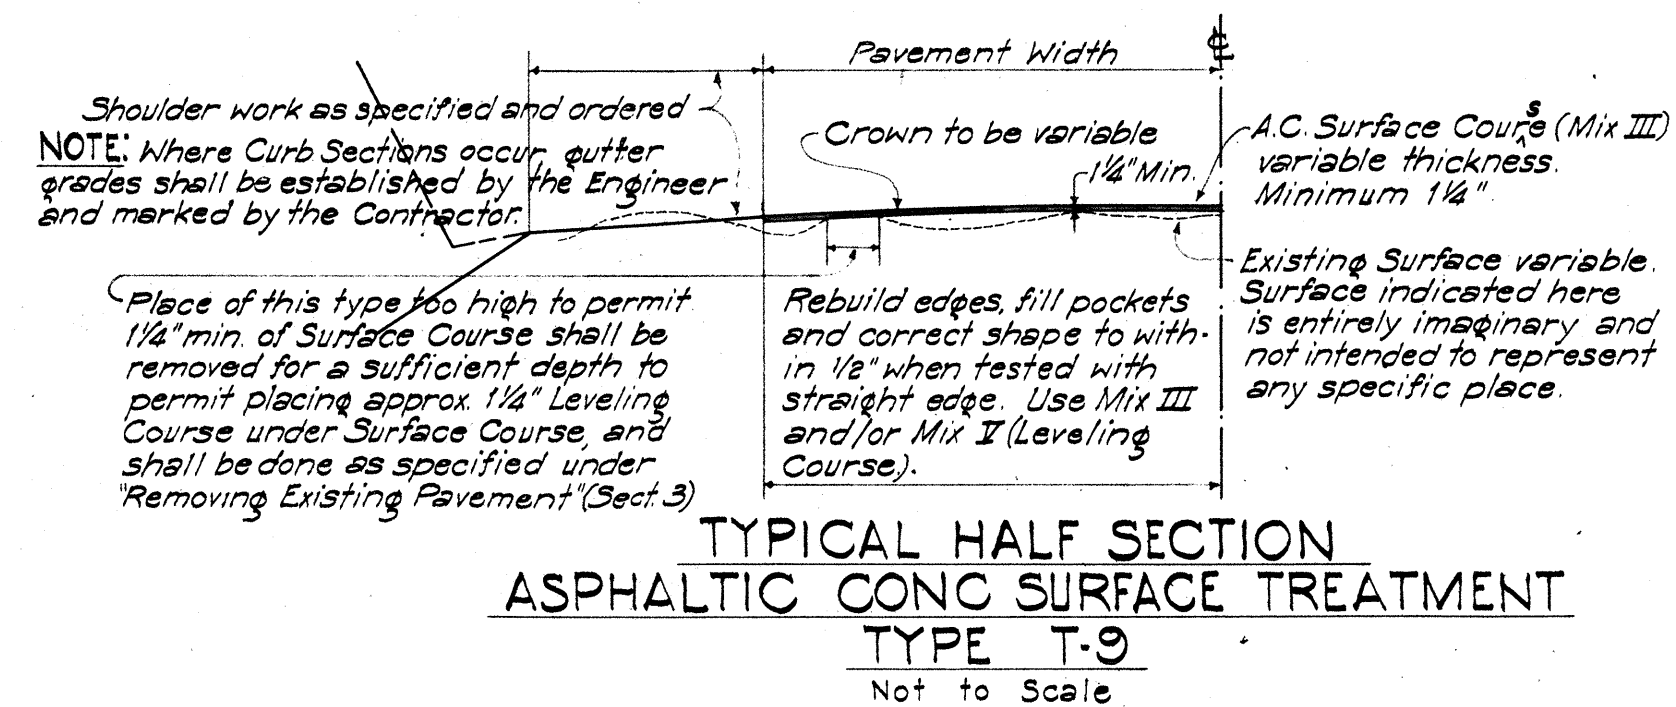


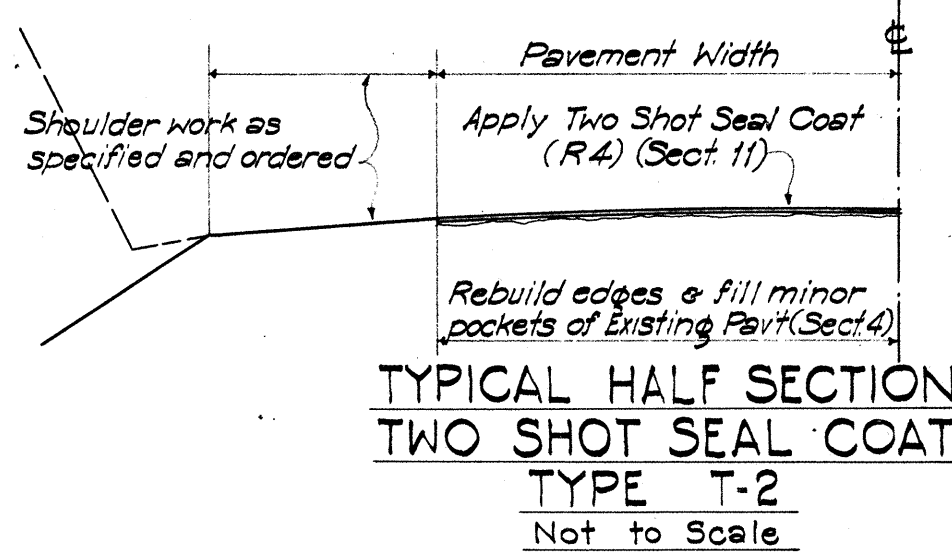

TYPICAL SECTIONS AS CONSTRUCTED
ORIGINALLY 5217:5

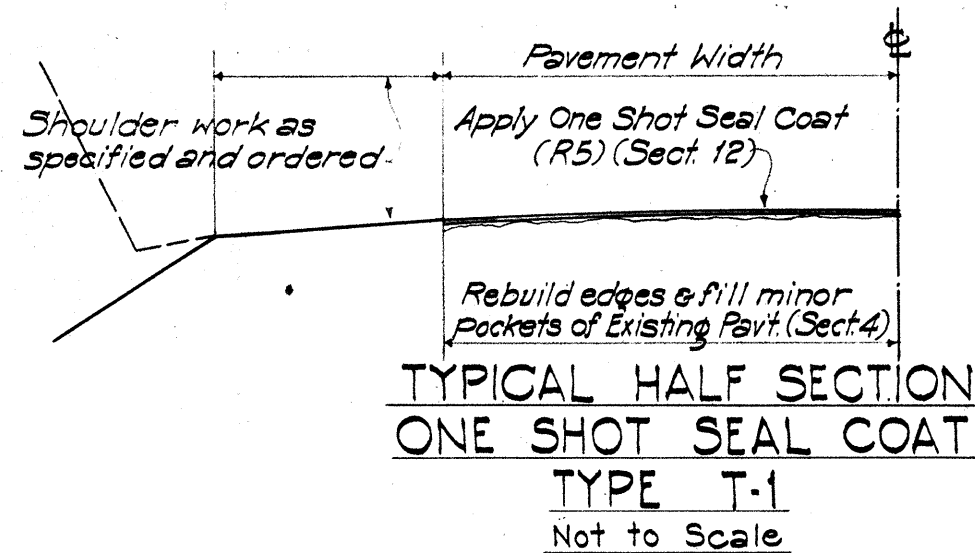


TYPE T-3 use (R1) Surface Treatment (Sect 8)
 TYPE T-4 " (R2) " " (Sect 9)
 TYPE T-5 " (R3) " " (Sect 10)

NOTE: When Type T-5 REHABILITATION is used (Sect. 4) is hereby modified to the extent that only pot-holes are filled and edges rebuilt without correction of surface shape.

GENERAL NOTE:

- 1 For Shoulder and Pavement widths see SECTION showing Project as originally constructed.
- 2 "Sect." used in notes refer to Sections in Pamphlet "U"
- 3 The terms Emulsified Asphalt or Asphaltic Emulsion are synonymous.

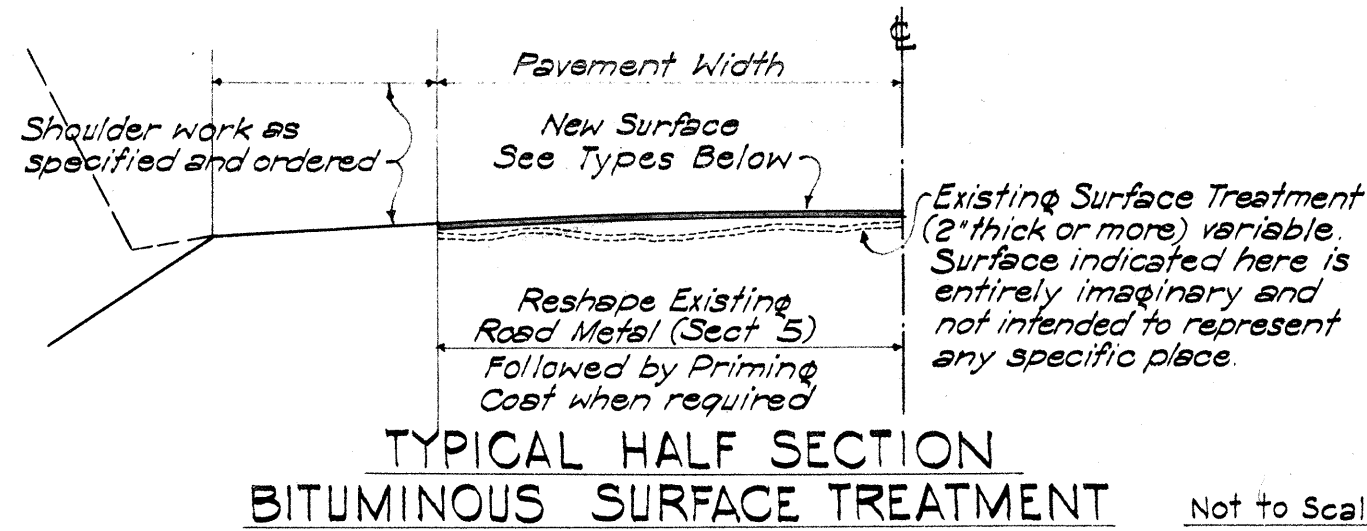

TYPE T-7 use R2 Surface Treatment (Sect. 9)
 TYPE T-8 " Asphalt Macadam Pavement See Special Provisions for Type and thickness.

TYPES OF REHABILITATION	PAMPHLET "U"													
	Sect. 1 Brooming off	Sect. 2 Resetting Manholes & Mans.	Sect. 3 Removing Existing Pavement	Sect. 4 Rebuild edges & Fill Pockets of Exist. Pavt.	Sect. 5 Reshaping Exist. Road Metal (2" or more)	Sect. 6 Reshaping Exist. Road Metal (1/2" or less)	Sect. 7 Asphalt Conc. Resurfacing	Sect. 8 Bit. Surface Treatment (R-1)	Sect. 9 Bit. Surface Treatment (R-2)	Sect. 10 Bit. Surface Treatment (R-3)	Sect. 11 Two Shot Seal Coat (R-4)	Sect. 12 One Shot Seal Coat (R-5)	Sect. 13 Materials	Sect. 14 Traffic Control
T-1	✓			✓								✓	✓	✓
T-2	✓			✓							✓		✓	✓
T-3	✓	x	x	✓				✓					✓	✓
T-4	✓	x	x	✓					✓				✓	✓
T-5	✓	x	x	✓						✓			✓	✓
T-6		x				✓		✓					✓	✓
T-7		x			✓				✓				✓	✓
T-8		x			✓								✓	✓
T-9	✓	x	x				✓						✓	✓

LEGEND:
 ✓ = Required Operation
 x = Possible Operation if Req'd
 NOTES:
 1. When Sect 5 & 6 are used "Sprinkling" Pamphlet H4 is req'd.
 2. When TYPE 8 REHABILITATION is used, "Asphalt Macadam Surface" will be specified in the Special Provisions.
 3. When TYPE 9 REHABILITATION is used, "Asphalt Conc. Pavement" Pamphlet J-4 is req'd.

CHART SHOWING APPLICABLE SECTIONS OF PAMPHLET "U" REQUIRED FOR VARIOUS TYPES OF REHABILITATION

STANDARD SECTIONS & TYPES REQUIRED FOR REHABILITATION