


REHABILITATION OF
KALANIANA'OLE HIGHWAY


FROM KAILUA-WAIMANALO JUNCTION TO WAIMANALO TOWN
AND

CERTAIN STREETS
IN WAIMANALO BEACH SUBDIVISION
KOOLAUPOKO, DISTRICT
ISLAND OF OAHU,
(COUNTY)

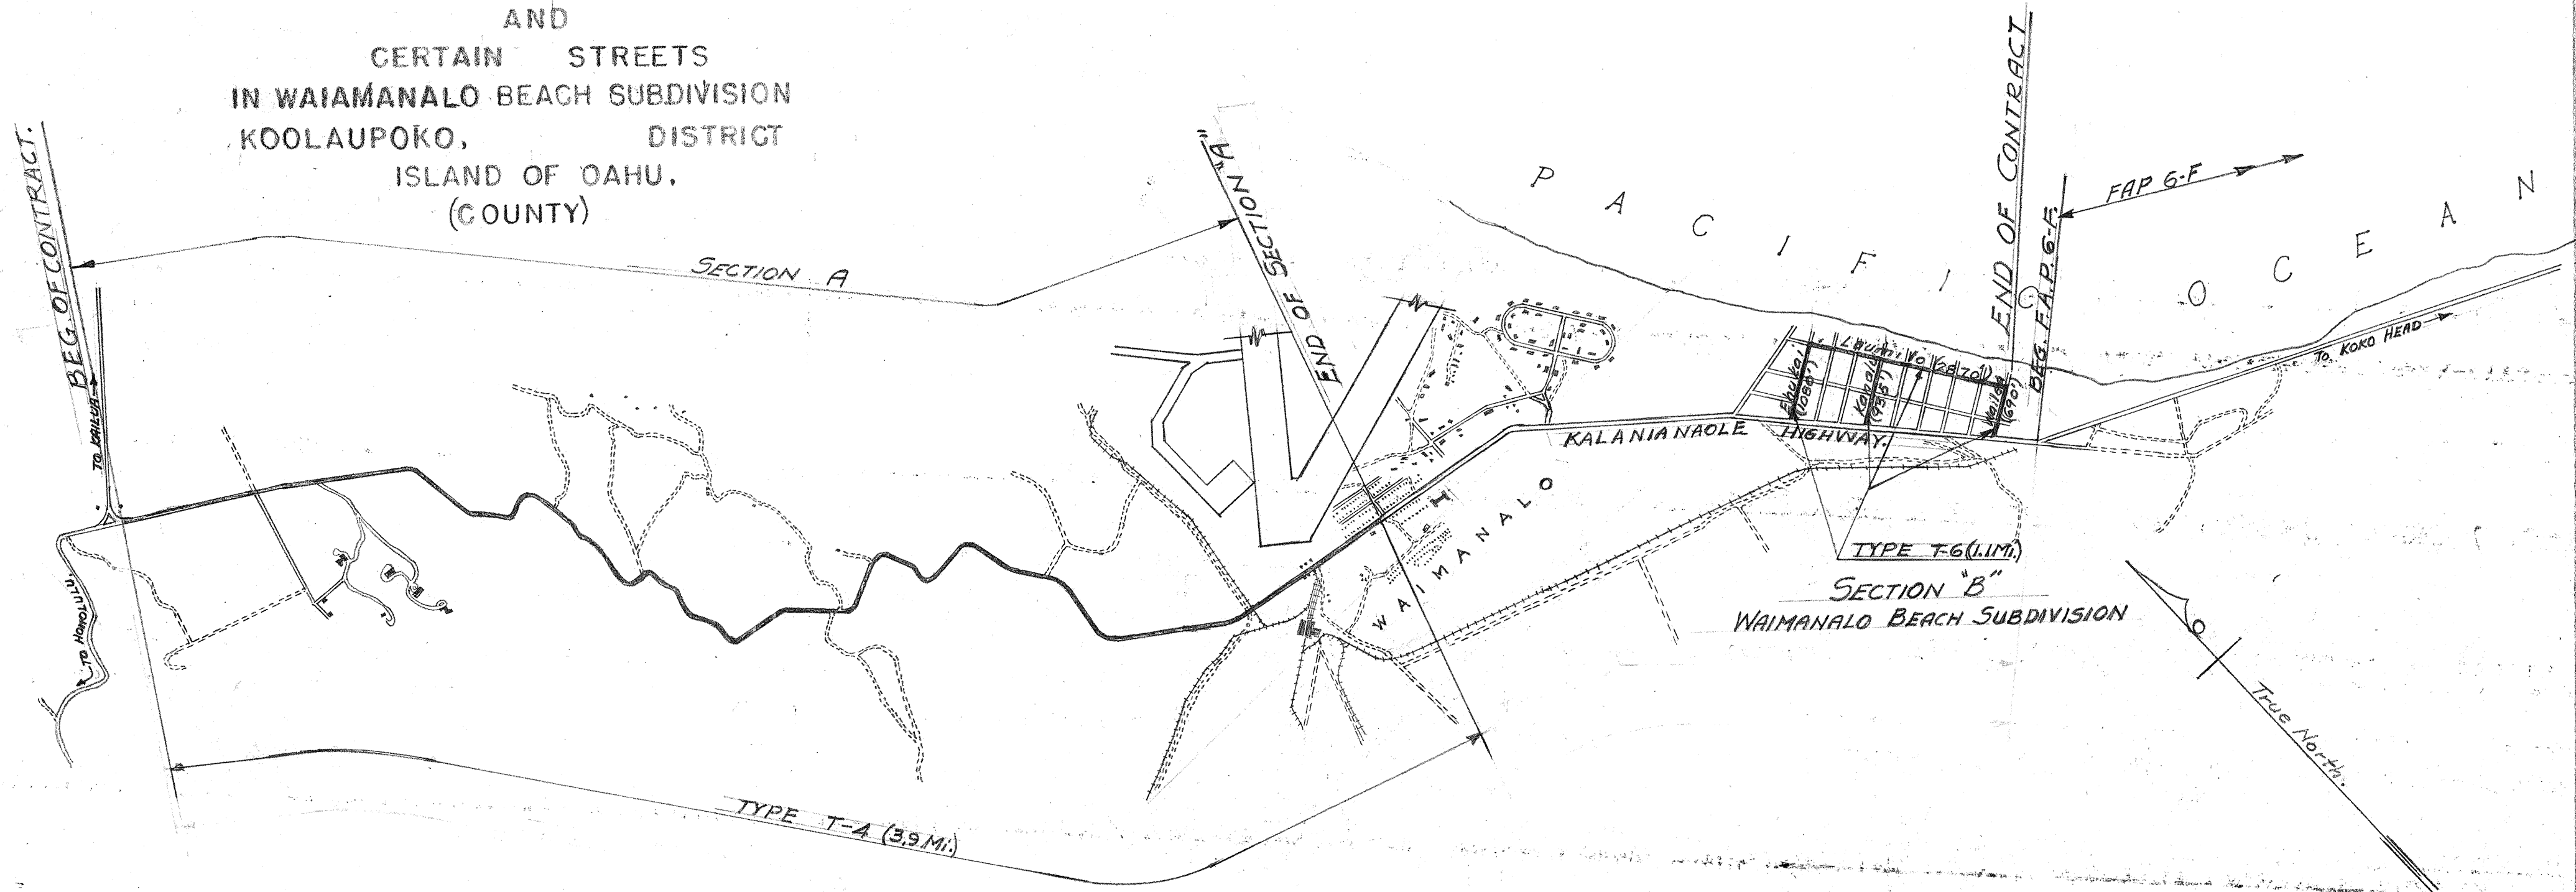


LAYOUT OF PROJECT
SCALE 1 : 20,000 FT.
LENGTH = 5.0 MILES.

5208.1

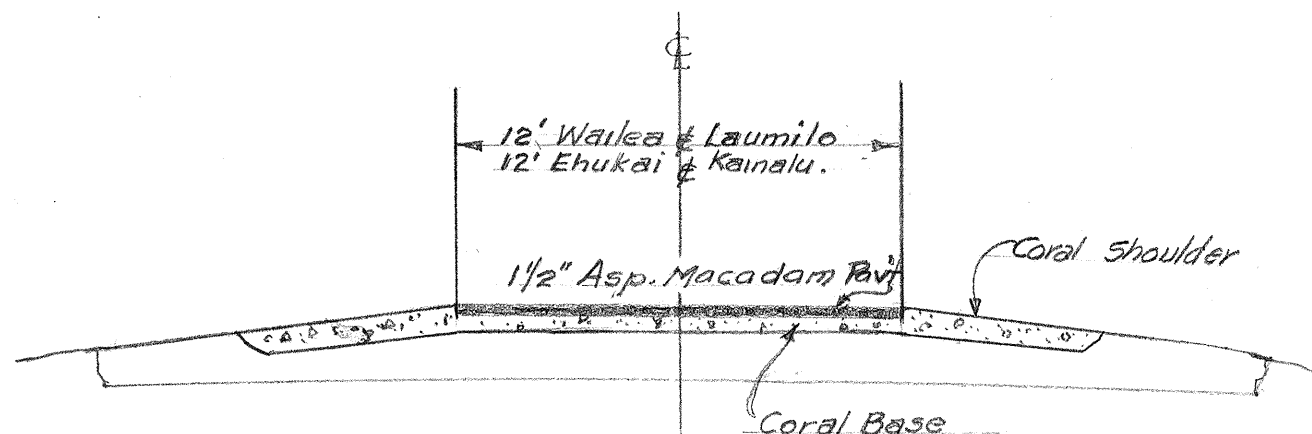

Note: Existing pavement has been entirely destroyed.

WAIMANALO BEACH SUBDIVISION ROADS.

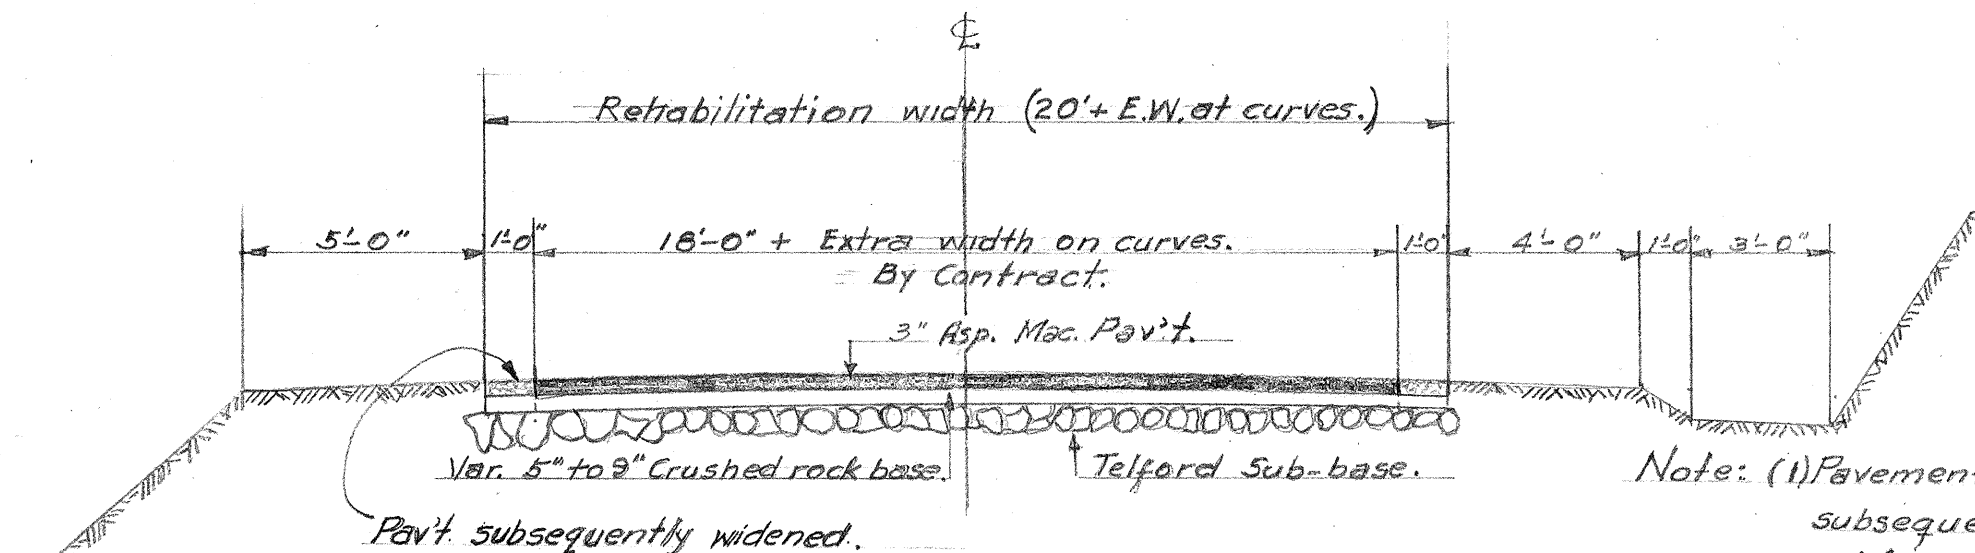

Note: (1) Pavement through Waimanalo town subsequently widened to approx. 32' for a distance of 0.5 miles.
(2) Rehabilitation in any event shall be restricted to existing widths.

KALANIANA'OLE HIGHWAY.

TYPICAL SECTIONS AS ORIGINALLY CONSTRUCTED.

NOT TO SCALE.