



PLAN	DATE	BY	NOTED	CHECKED	RT. OF WAY
NO.					

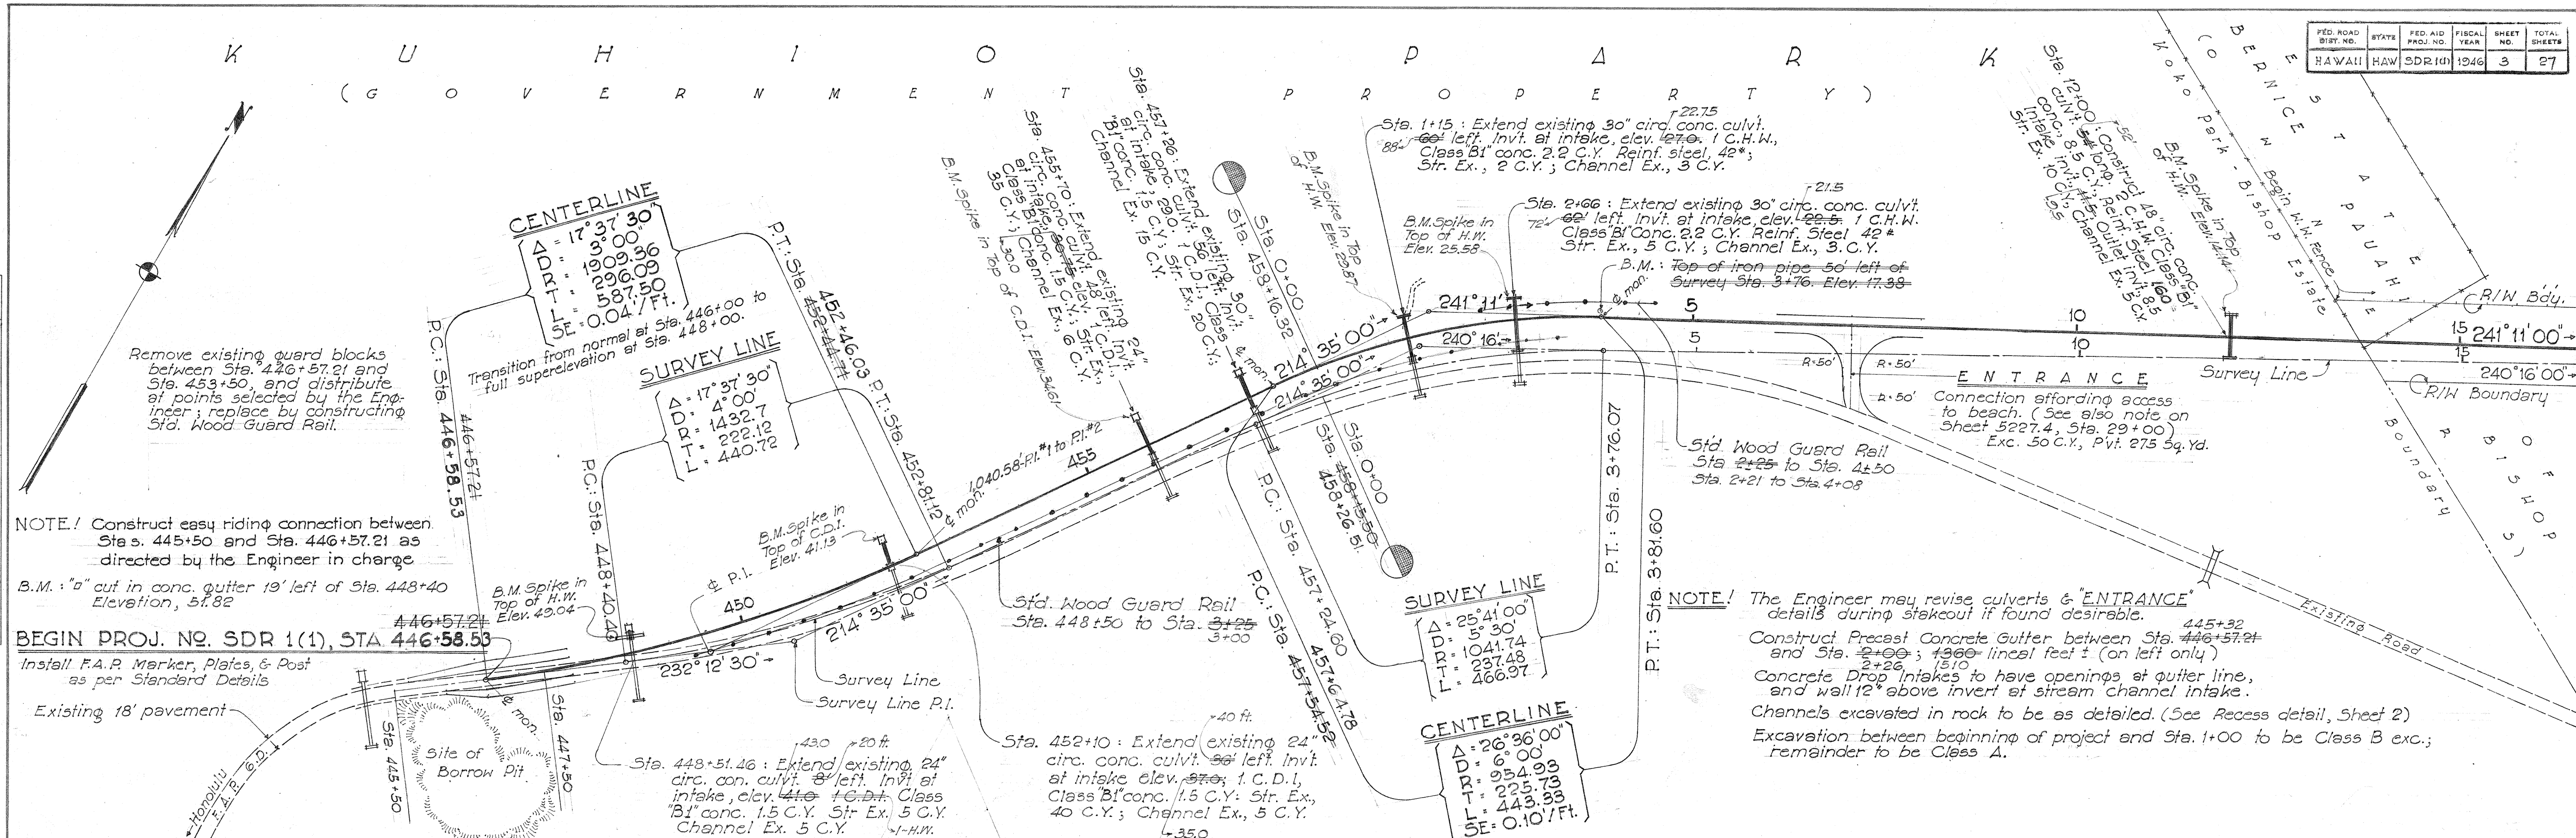

PROFILE	DATE	BY	NOTED	CHECKED	STRUCTURE NOTATIONS
NO.					

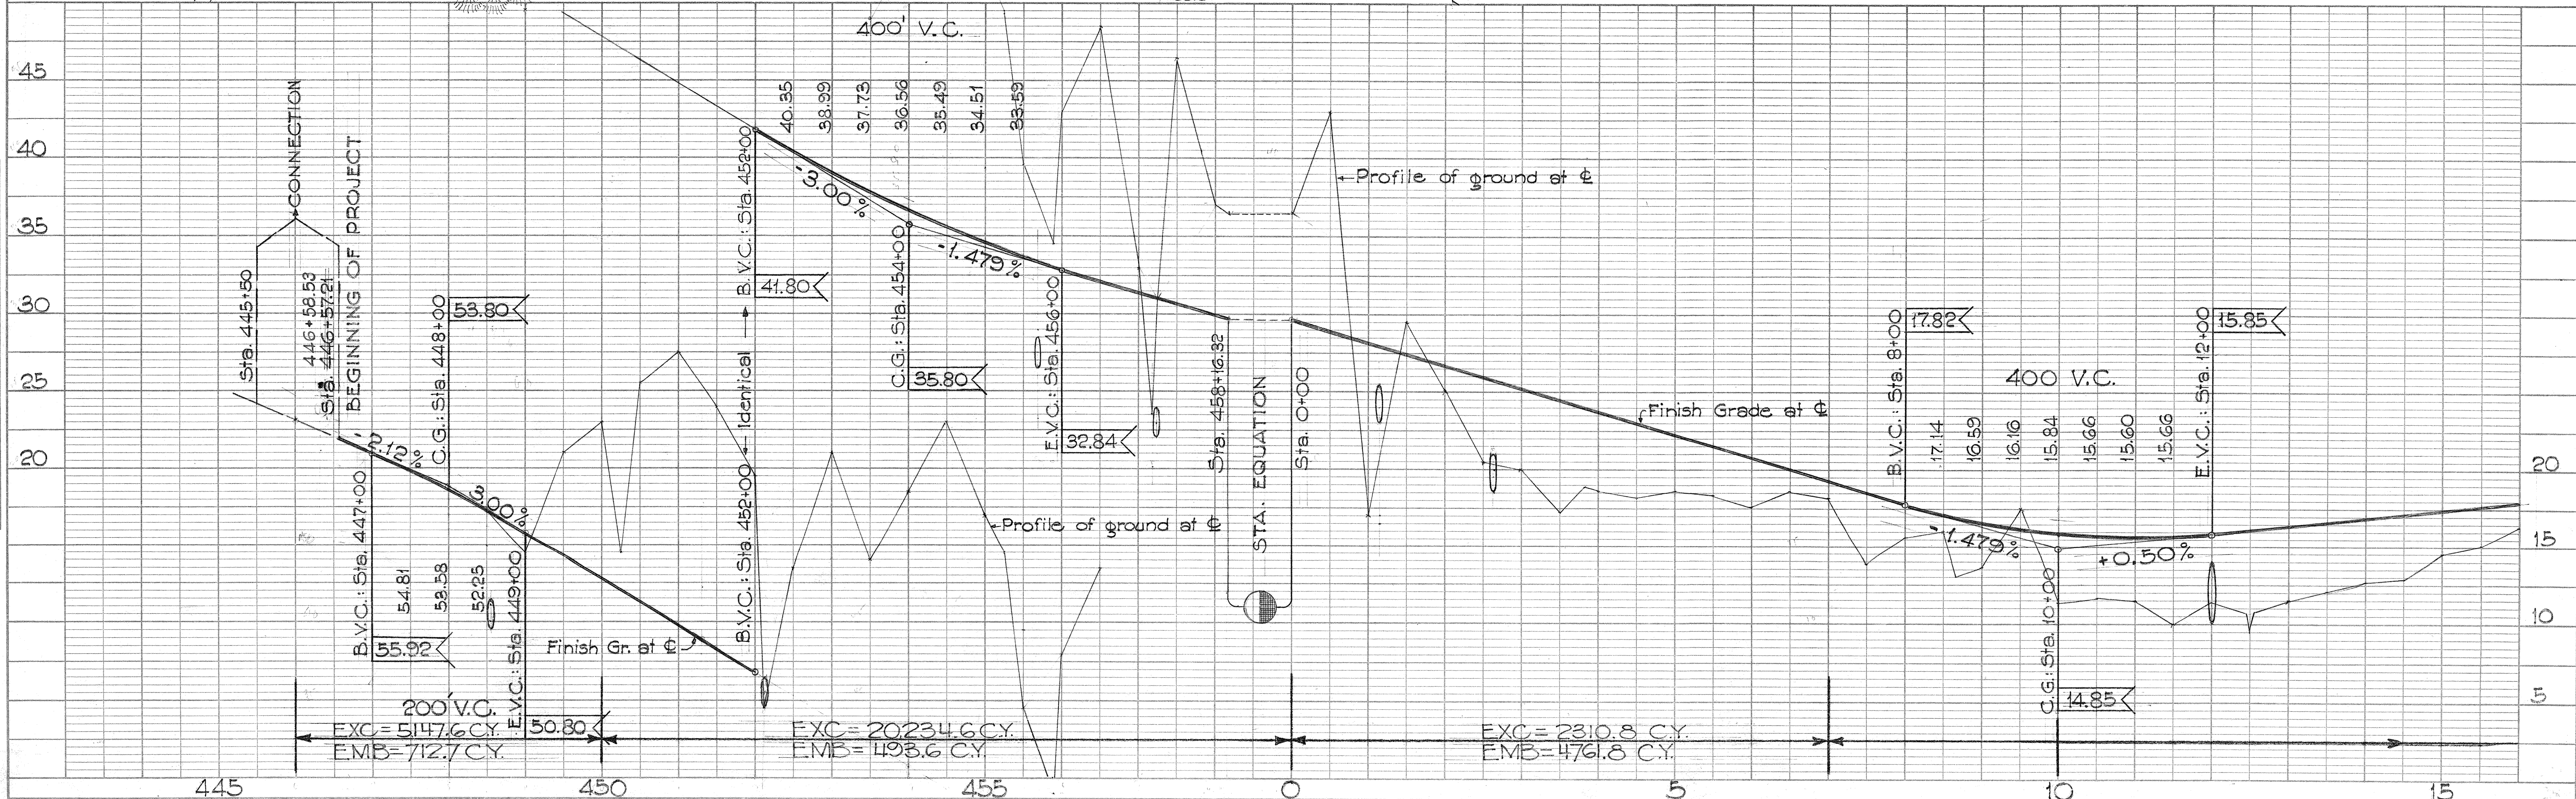

PLAN	DATE	BY
SURVEYED		
PLOTTED		
NOTE BOOK		
NO.		

PROFILE	DATE	BY
SURVEYED		
PLOTTED		
NOTE BOOK		
NO.		

