

INDEX TO DRAWINGS	
SHEET NO.	DESCRIPTION
1	Title Sheet
2	Typical Section
3-5	Plan & Profile
6-8	Std. Detail Sheet
9	Std. Bridge Details
10-13	Bridge Details
14-24	Cross Sections
25-27	" " - Borrow Pit

All changes made during construction have been shown in red on these tracings and checked by:

[Signature]
 Resident Engineer
 Date: 7-16-48


TERRITORY OF HAWAII
 TERRITORIAL HIGHWAY DEPARTMENT
 HONOLULU, OAHU, T. H.

PLANS OF KALANIANA'OLE HIGHWAY SEISMIC WAVE DAMAGE REHABILITATION PROJECT NO. SDR 1 (1)

KOKO HEAD SECTION
 DISTRICT OF HONOLULU
 ISLAND OF OAHU - T. H.


SCALES

PLAN 1 INCH = 100 FEET
 PROFILE HOR. 1 INCH = 100 FEET
 VER. 1 INCH = 5 FEET
 CROSS SECTIONS HOR. 1 INCH = 10 FEET
 VER. 1 INCH = 5 FEET

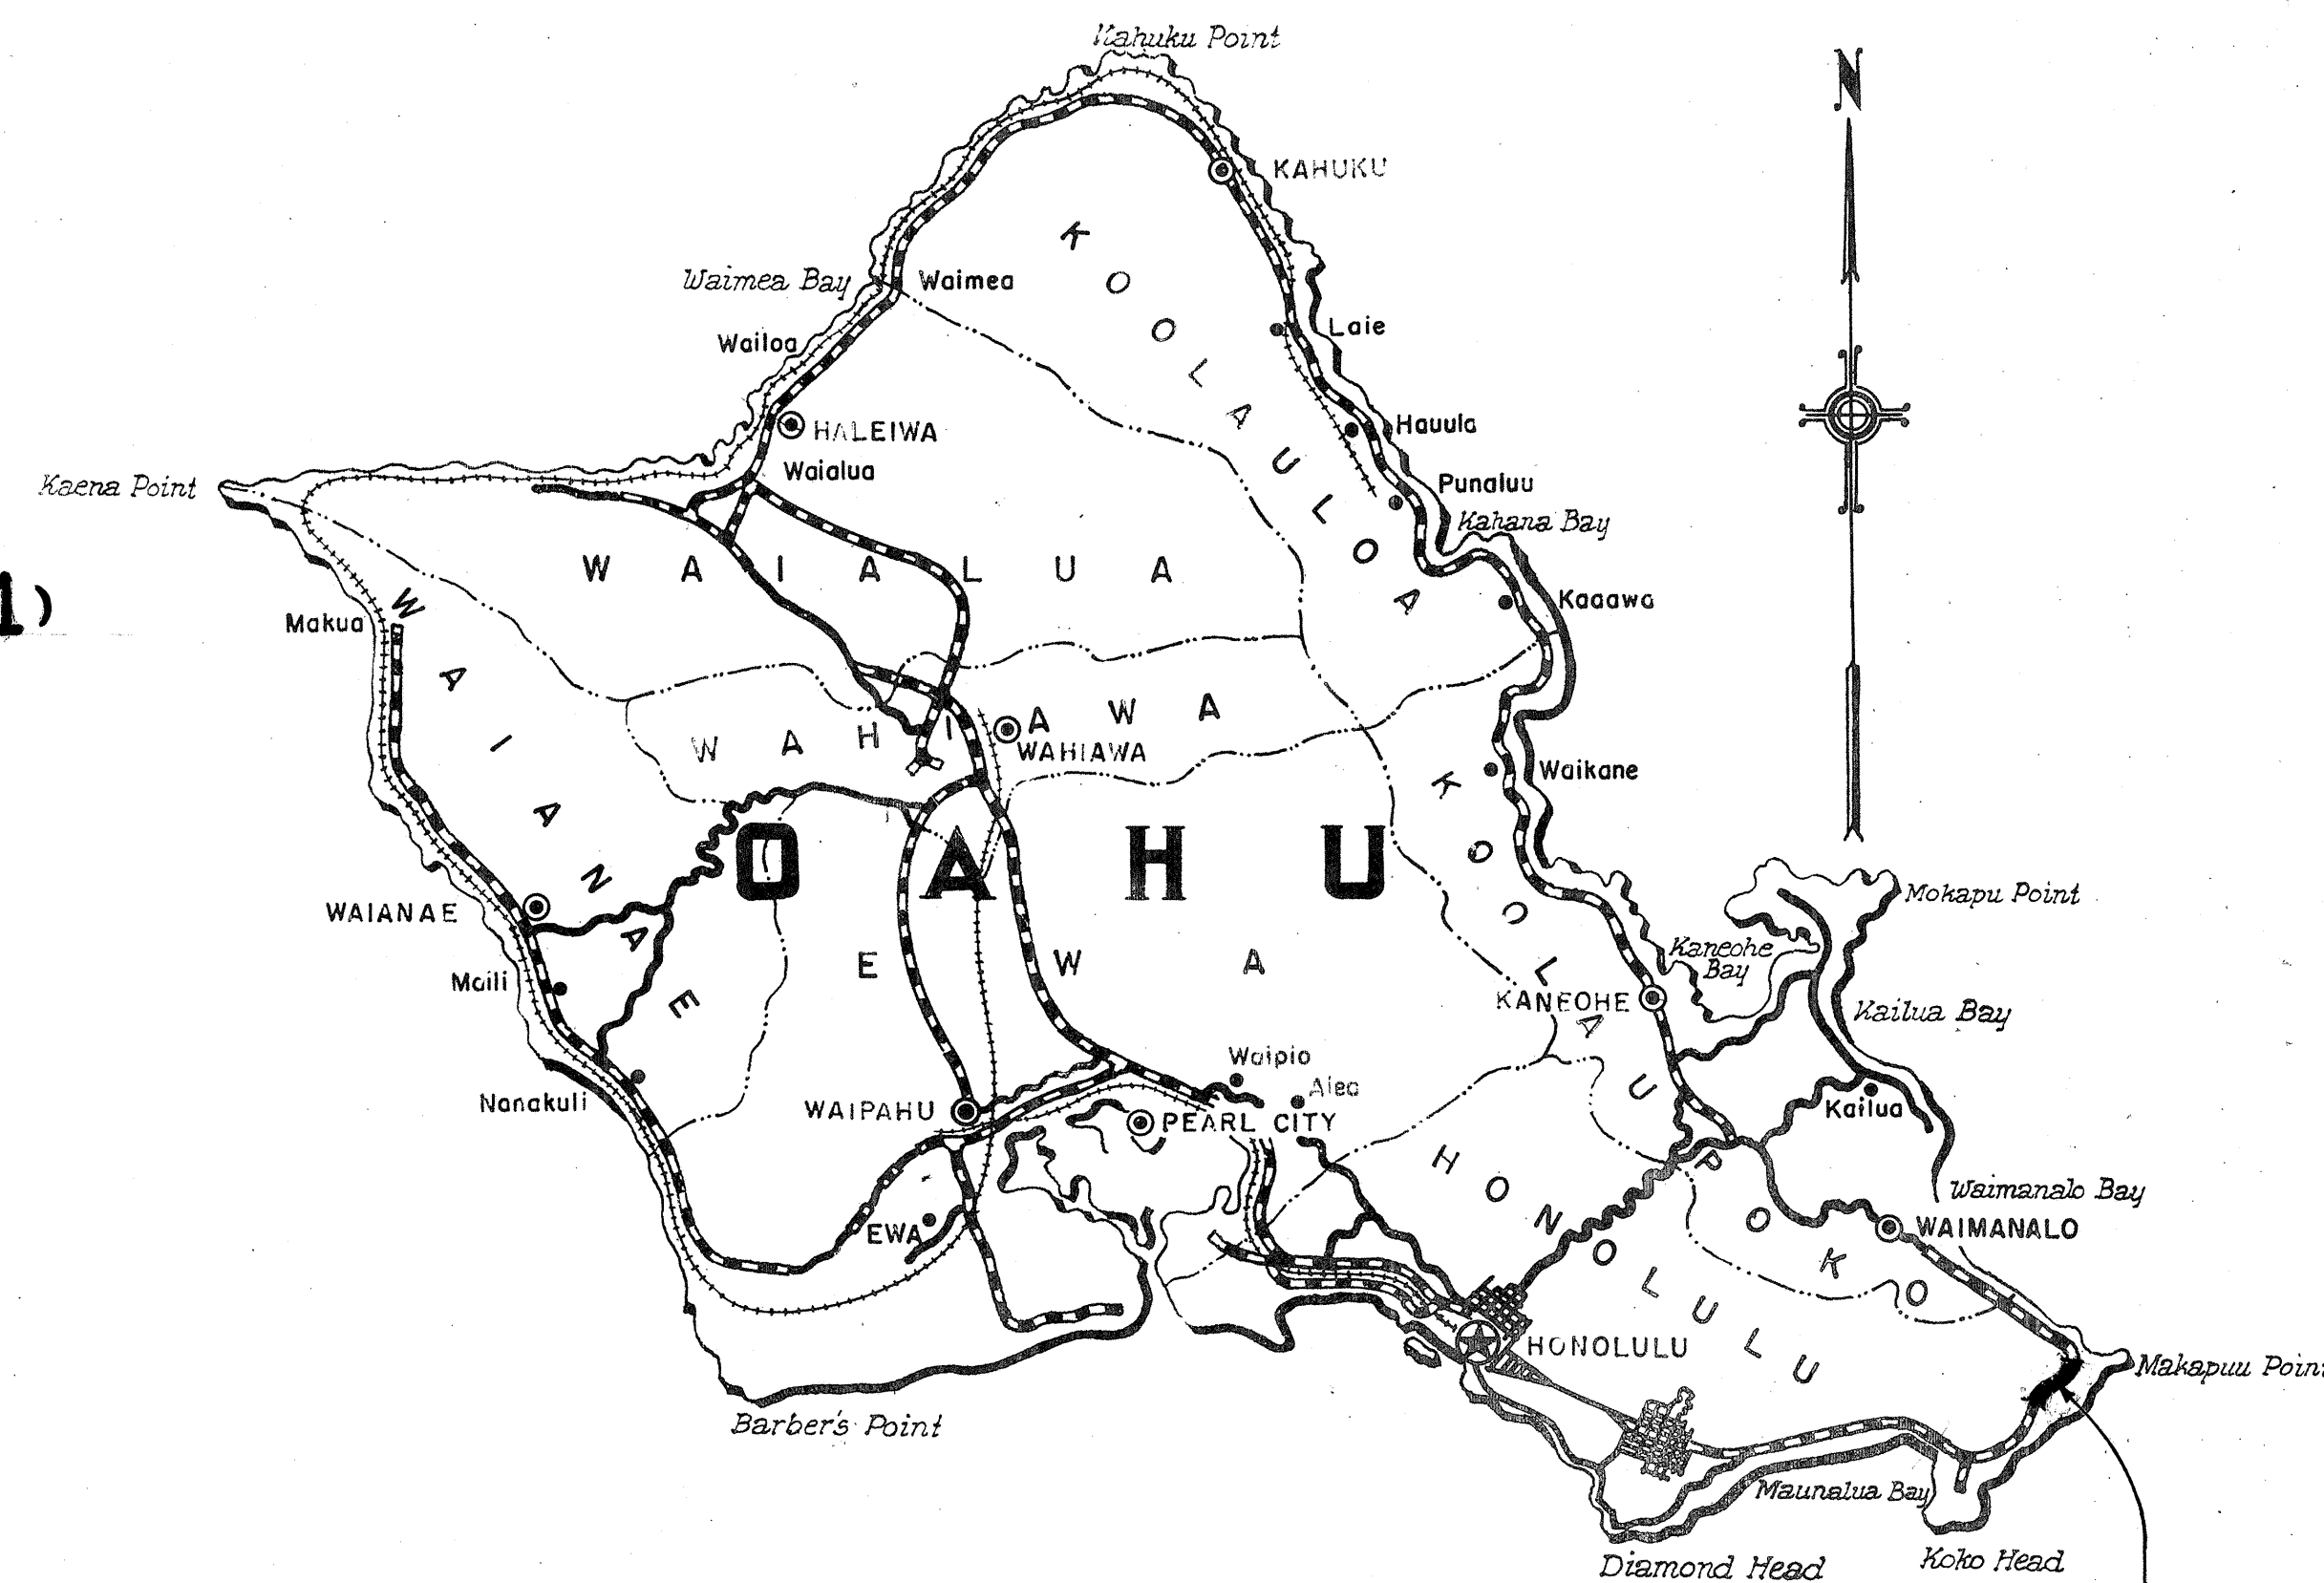

LOCATION OF PROJECT NO. SDR 1 (1)

Federal Aid Projects Previously Constructed Or Under Construction

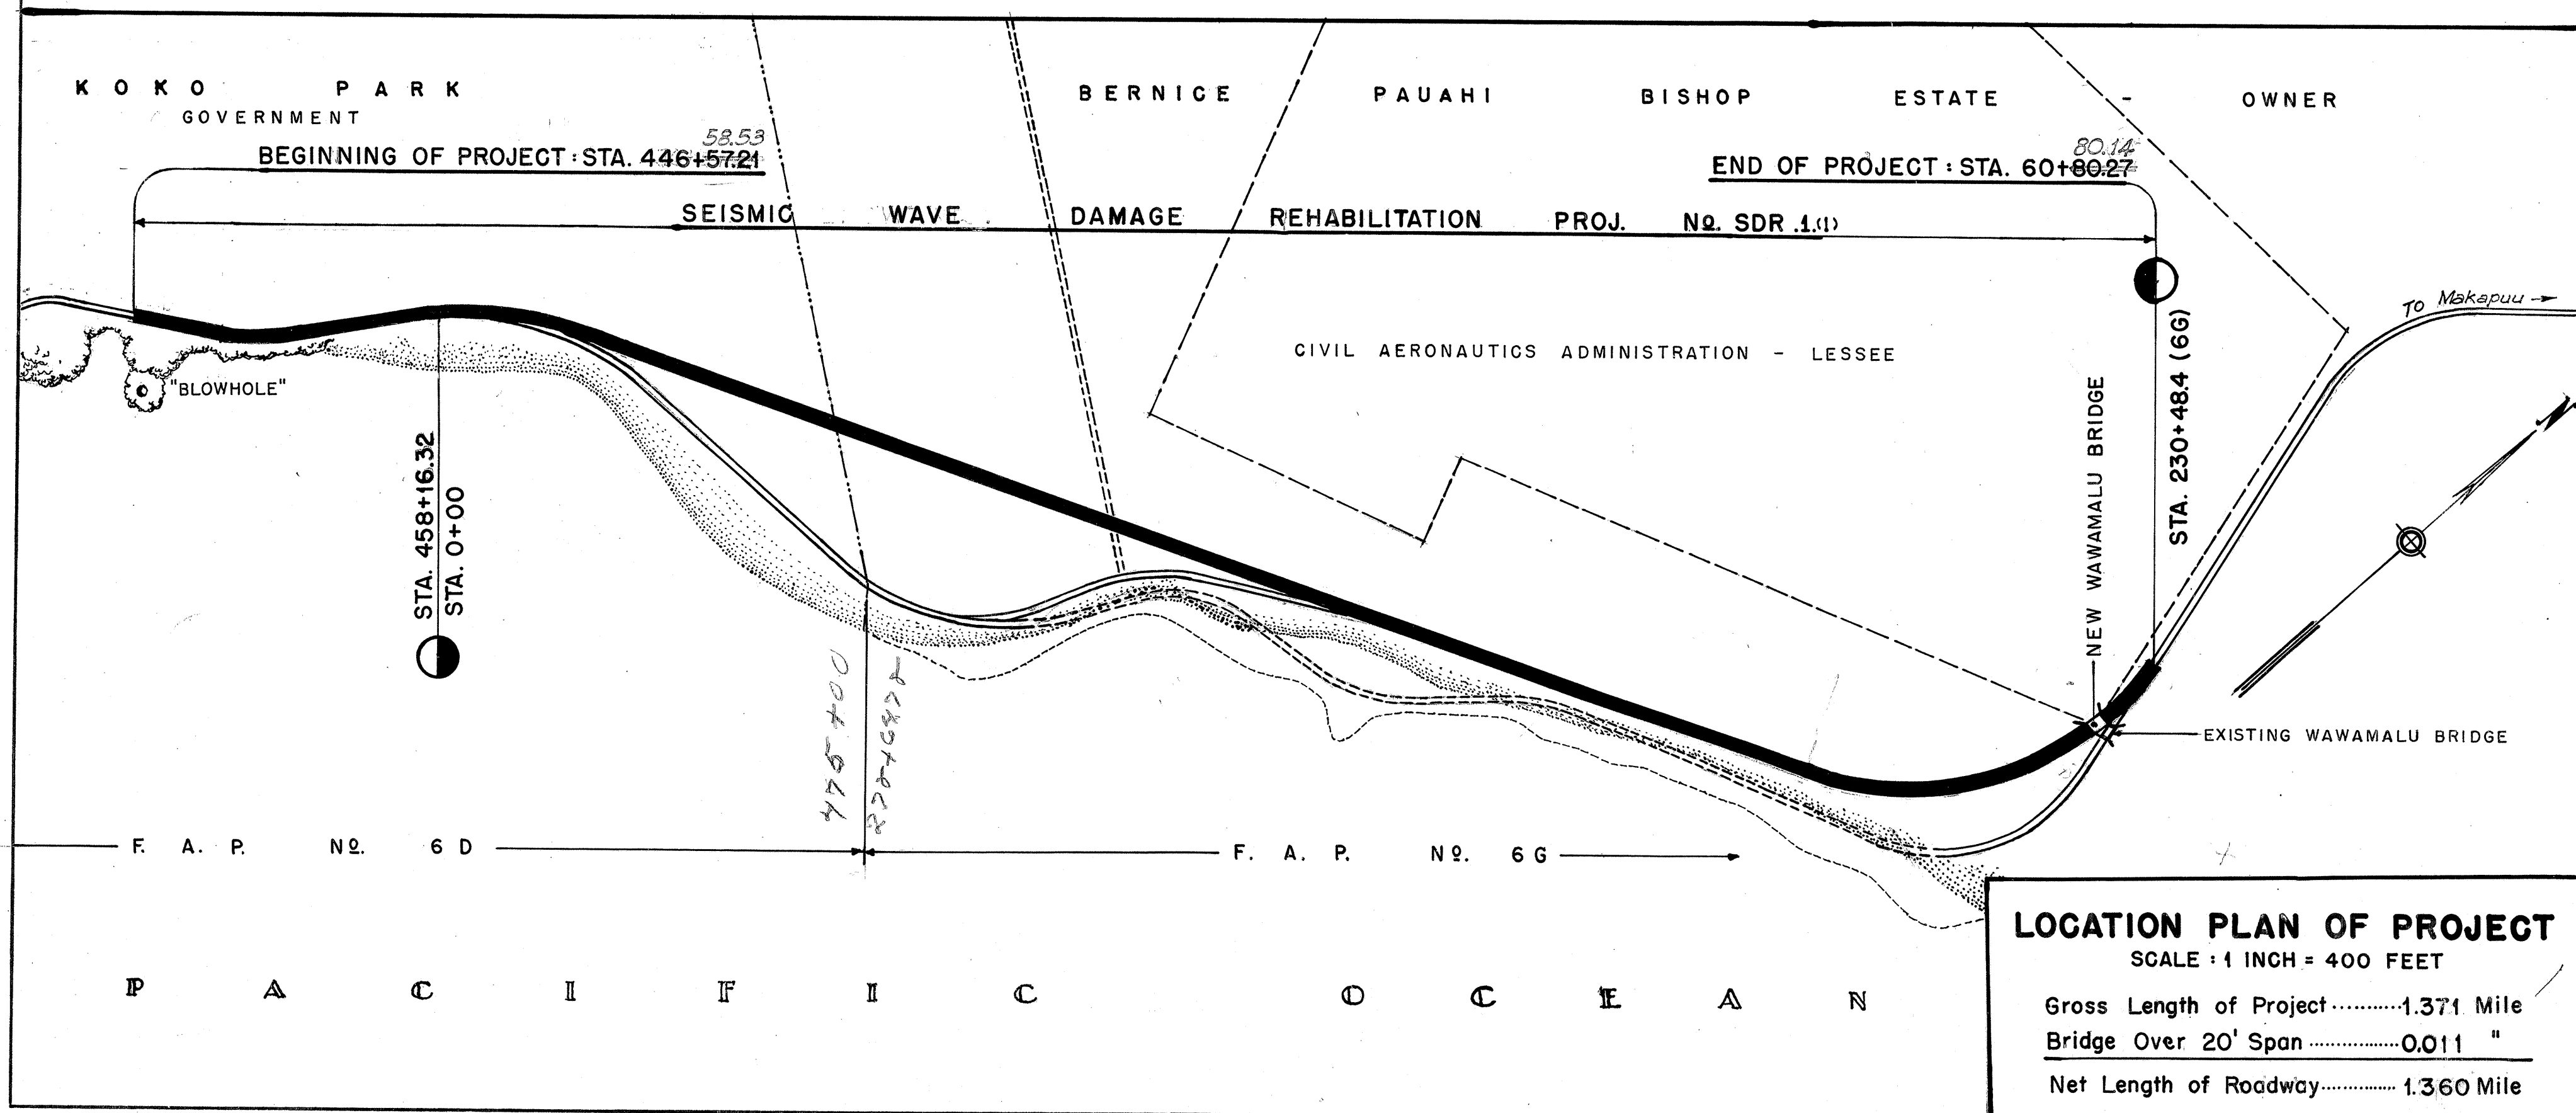

LOCATION PLAN OF PROJECT
 SCALE: 1 INCH = 400 FEET
 Gross Length of Project 1.371 Mile
 Bridge Over 20' Span 0.011 "
 Net Length of Roadway 1.360 Mile

APPROVED _____ DATE Jan. 23, 1947
B.F. Rush
 TERRITORIAL HIGHWAY ENGINEER

RECOMMENDED FOR APPROVAL DATE _____

 DISTRICT ENGINEER
 PUBLIC ROADS ADMINISTRATION
 FEDERAL WORKS AGENCY
 APPROVED _____ DATE _____

 DIVISION ENGINEER
 PUBLIC ROADS ADMINISTRATION
 FEDERAL WORKS AGENCY

5227.1