


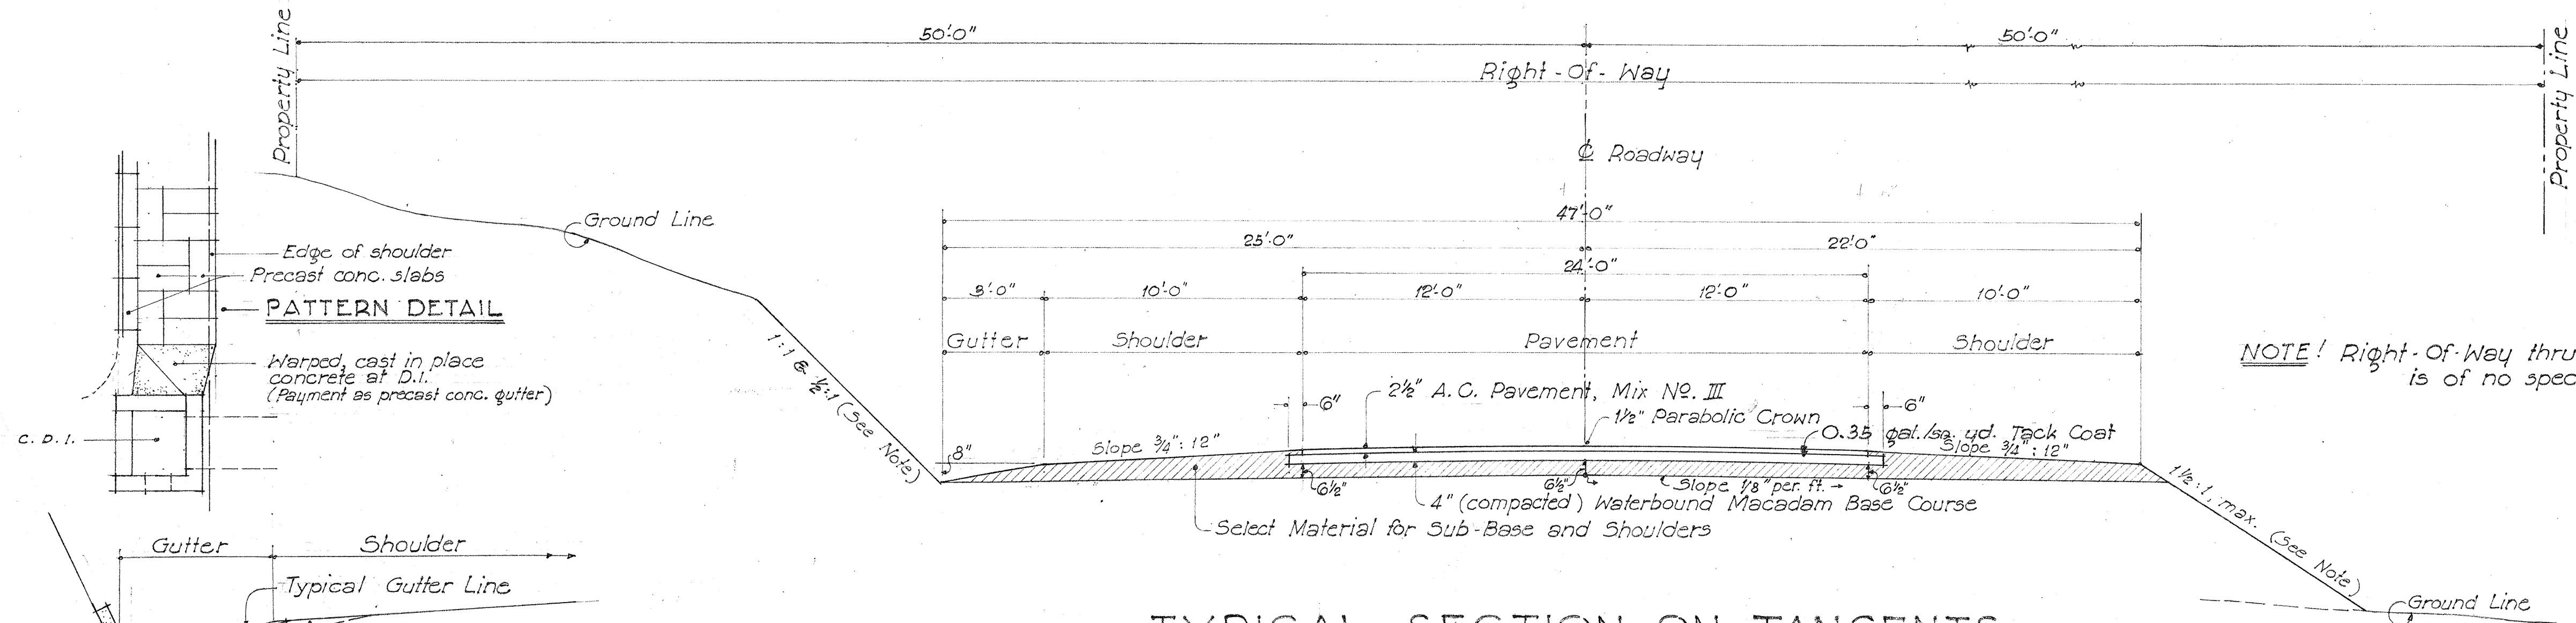


TYPICAL SECTION ON TANGENTS

Scale: 1/4" = 1'-0"

NOTE: Right-Of-Way thru Koko Head Park (City & County of Honolulu property) is of no specific width.


PRECAST CONCRETE GUTTER

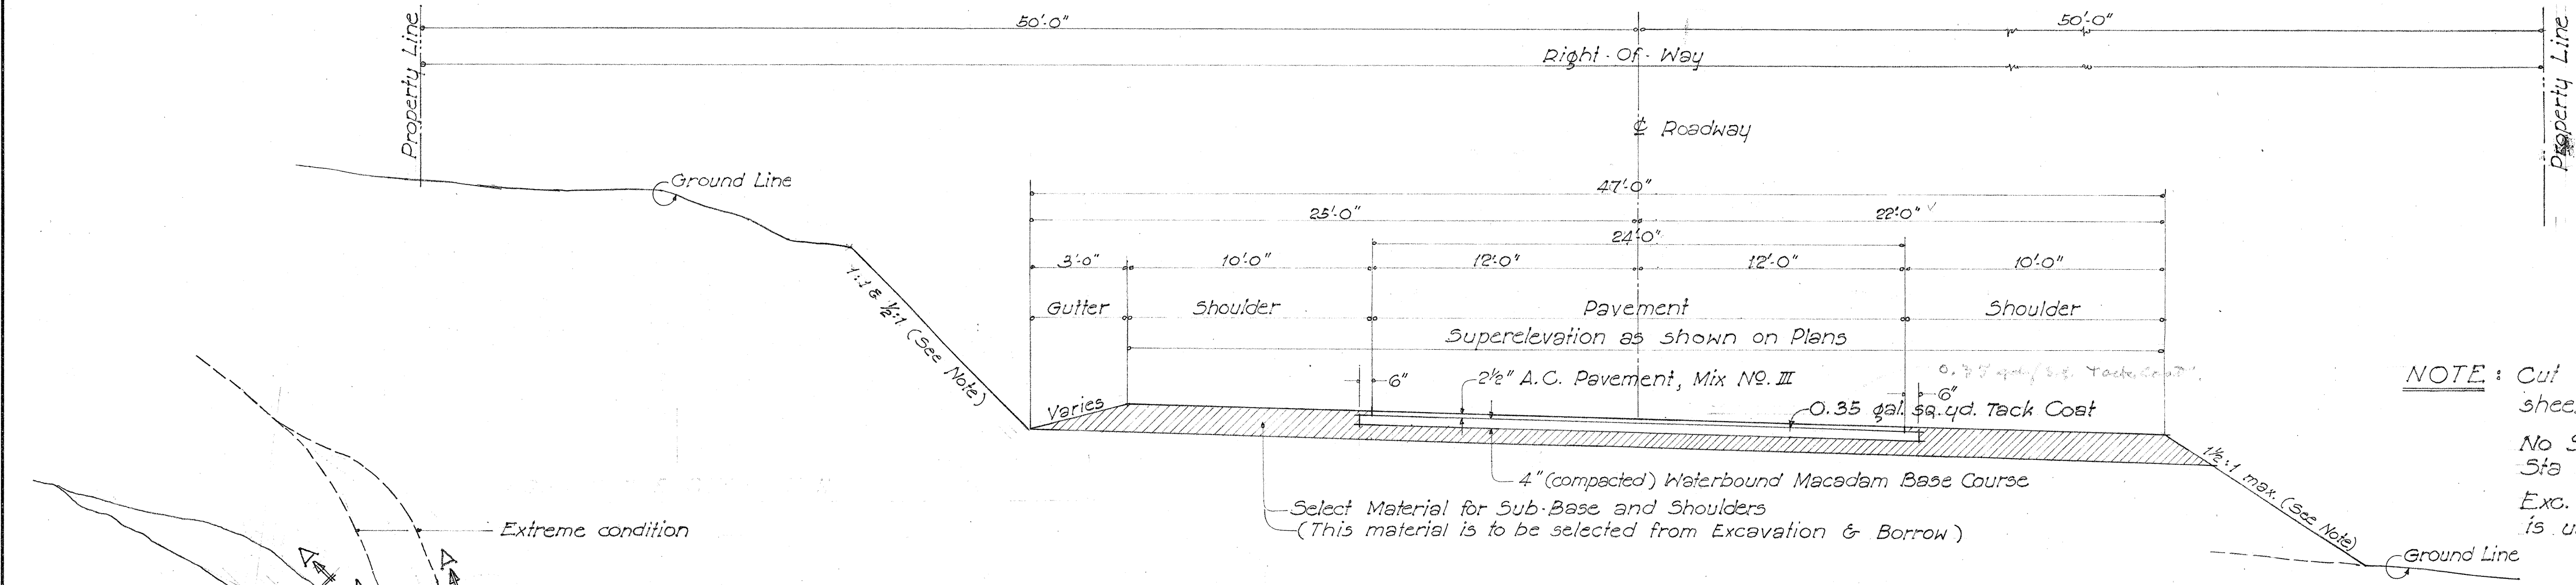

TYPICAL SECTION ON CURVES

Scale: 1/4" = 1'-0"

NOTE: Cut & Fill slopes as shown here and on cross section sheets may be varied during construction by the Engineer. No Select Material Sub-Base between Sta. 446+00 and Sta. 451+00 except as ordered by the Engineer. Exc. 6" below subgrade not required where sub-base is used.

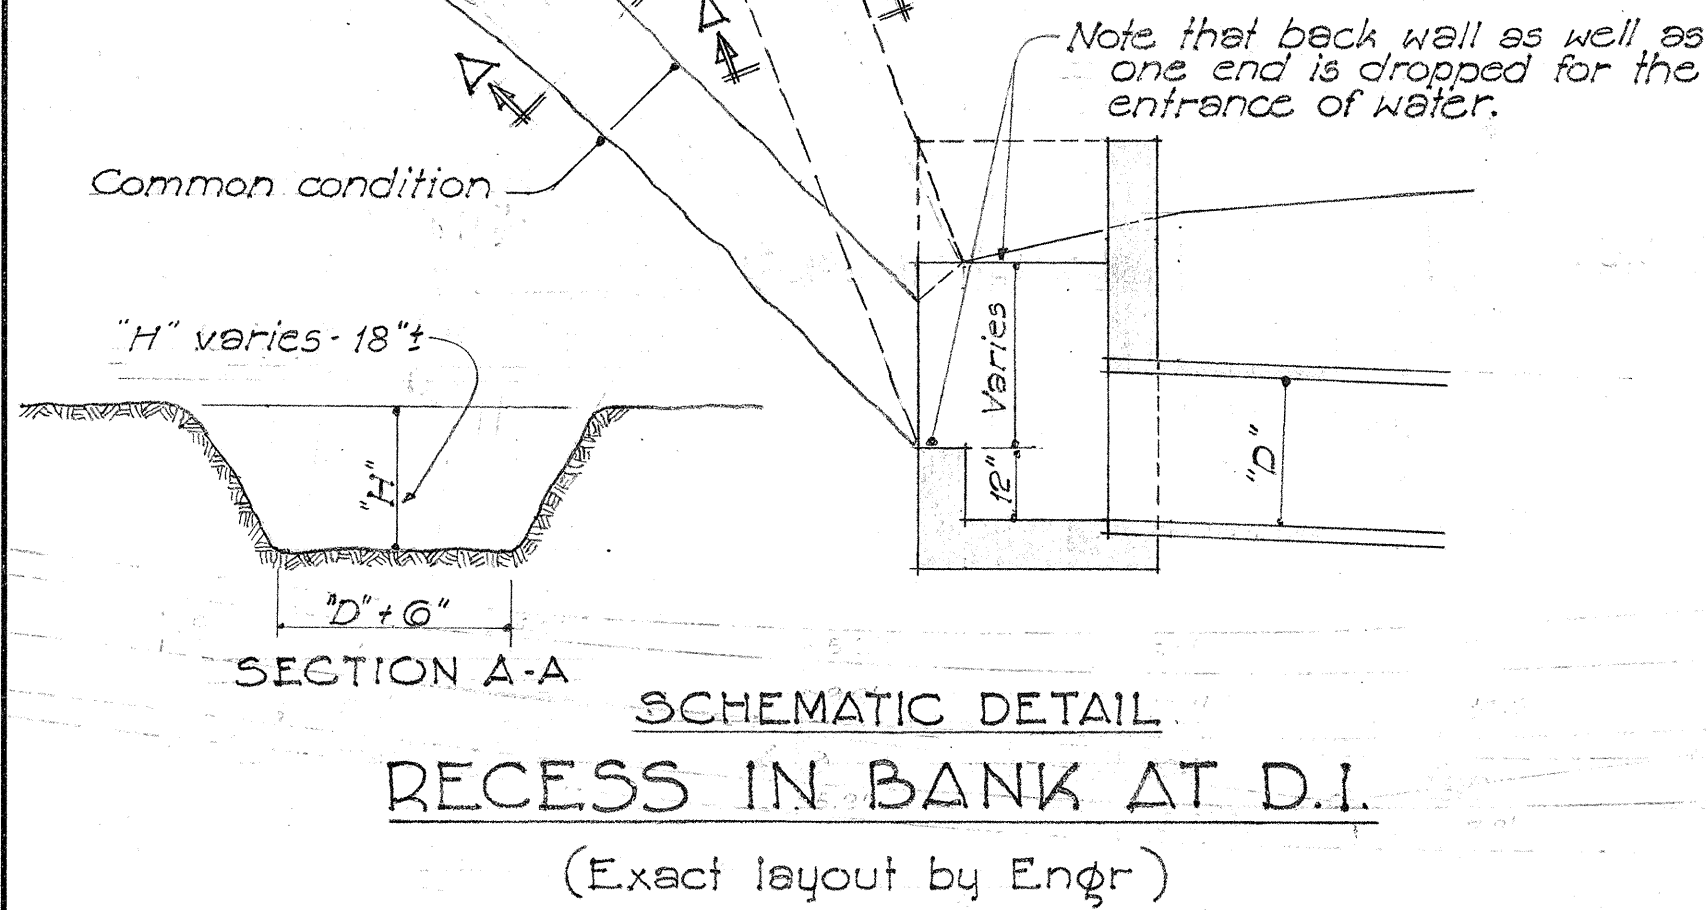

RECESS IN BANK AT D.I.

(Exact layout by Engr)

TERRITORIAL HIGHWAY DEPARTMENT
TERRITORY OF HAWAII

TYPICAL SECTIONS
PROJ. NO. SDR. 1(1)

SHEET NO. OF SHEETS

3227.2

DATE: 10-46
DESIGNED BY: COOK
TRACED BY: COOK
QUANTITIES BY: COOK
CHECKED BY: COOK
ORIGINAL PLAN: NO.
NOTE BOOK: NO.