



FED. ROAD DIST. NO.	STATE	FED. AID PROJ. NO.	FISCAL YEAR	SHEET NO.	TOTAL SHEETS
Hawaii	Haw	WDR 16(1)	1948	2	2

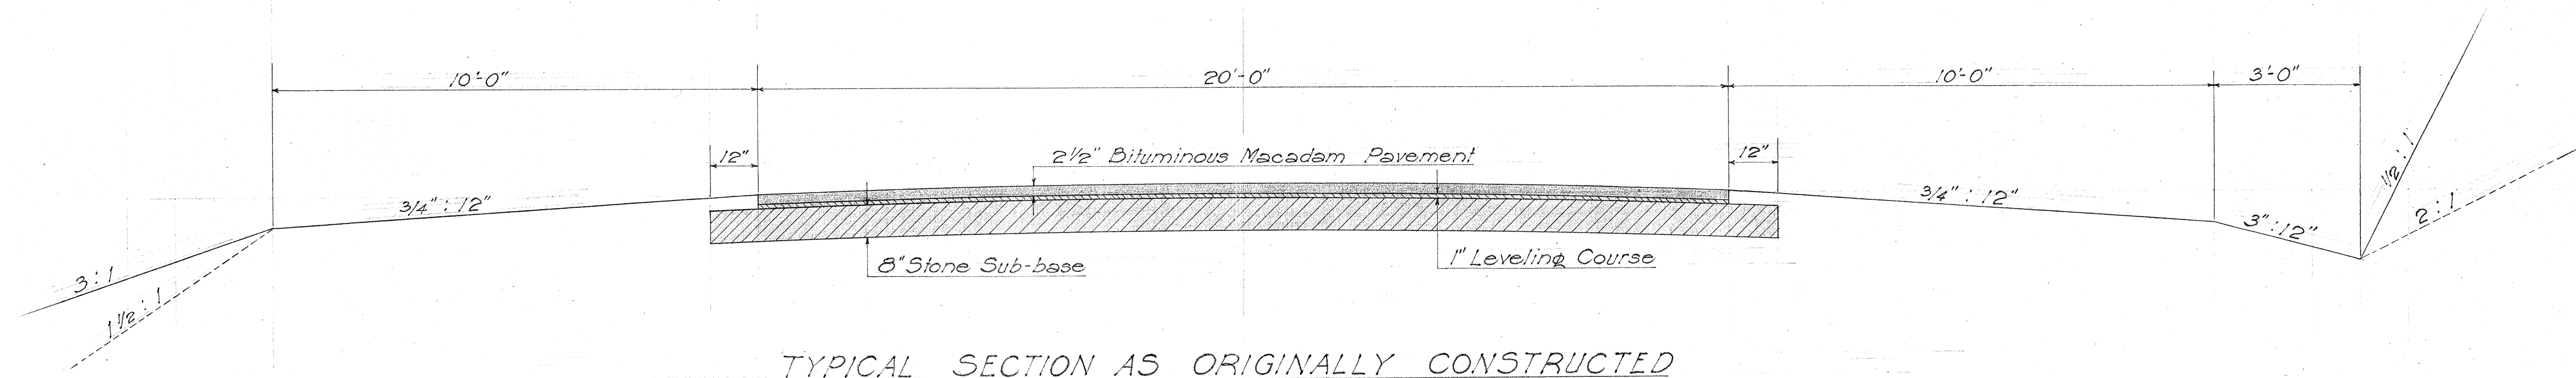

TYPICAL SECTION AS ORIGINALLY CONSTRUCTED
Sta. 11+00 to Sta. 52+66.14
Scale: 1/2" = 1'-0"

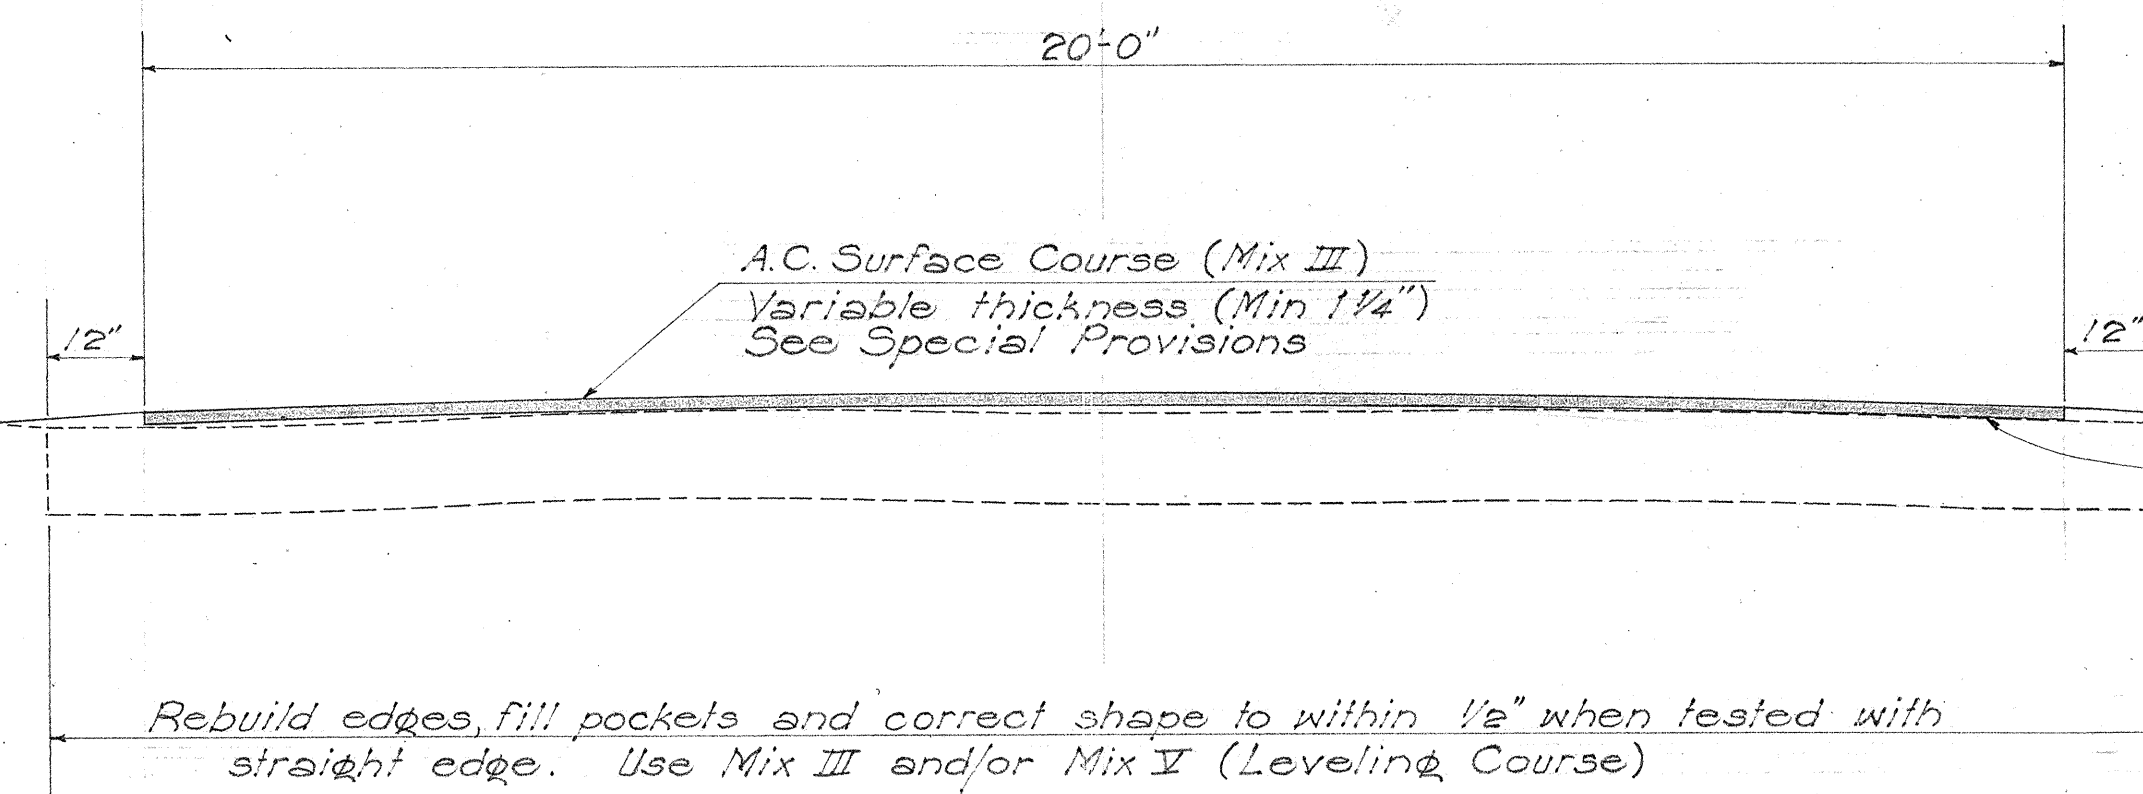

TYPICAL SECTION OF WORK TO BE DONE
ASPHALT CONCRETE RESURFACING
Sta. 11+00 to Sta. 52+66.14
Scale: 1/2" = 1'-0"

NOTE:
No shoulder grading to be performed under this contract.

Existing surface variable. Surface indicated here is entirely imaginary and not intended to represent any specific place.

SURVEY PLOTTED BY	DATE
DESIGNED BY	
DRAWN BY	
TRACED BY	
QUANTITIES CHECKED BY	
NOTE BOOK No.	
CHECKED BY	

TERRITORIAL HIGHWAY DEPARTMENT
TERRITORY OF HAWAII
TYPICAL SECTIONS
KALANIANA'OLE HIGHWAY
PROJECT NO. WDR 16(1)
Scale: As noted. Nov. 1948

SHEET No. OF SHEETS

5371.2