




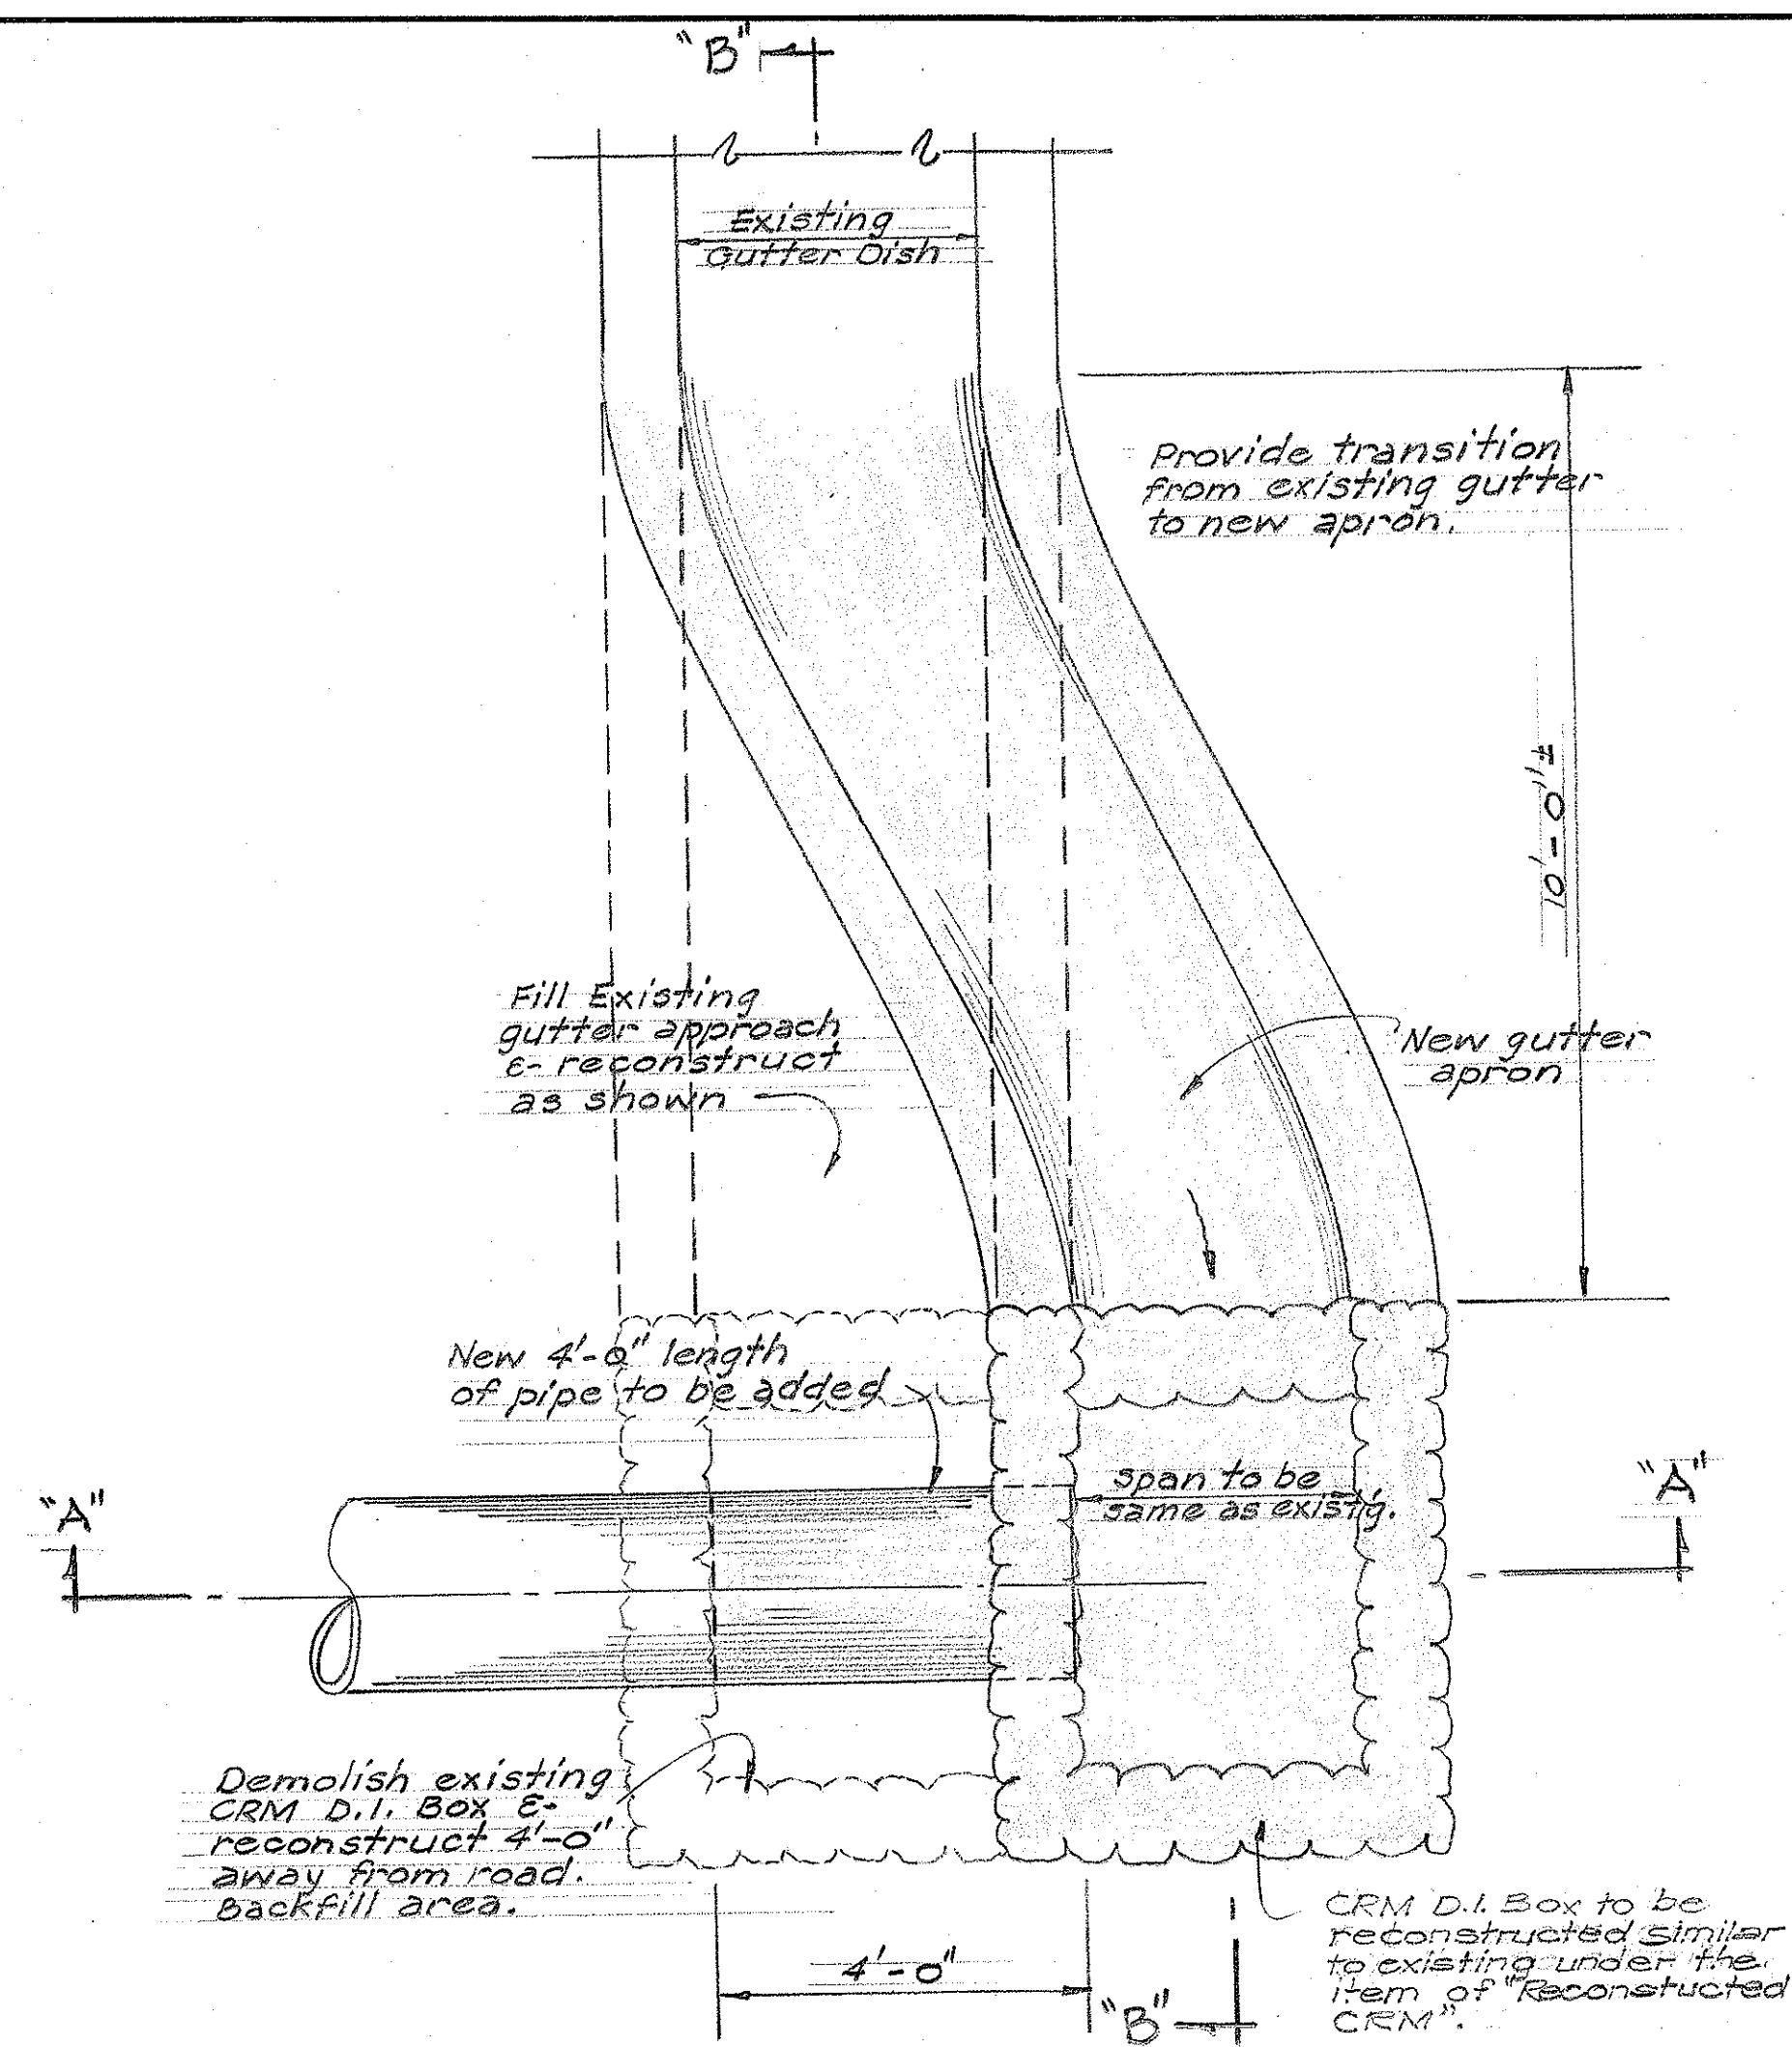


PLAN - TYPE "A" INTAKE

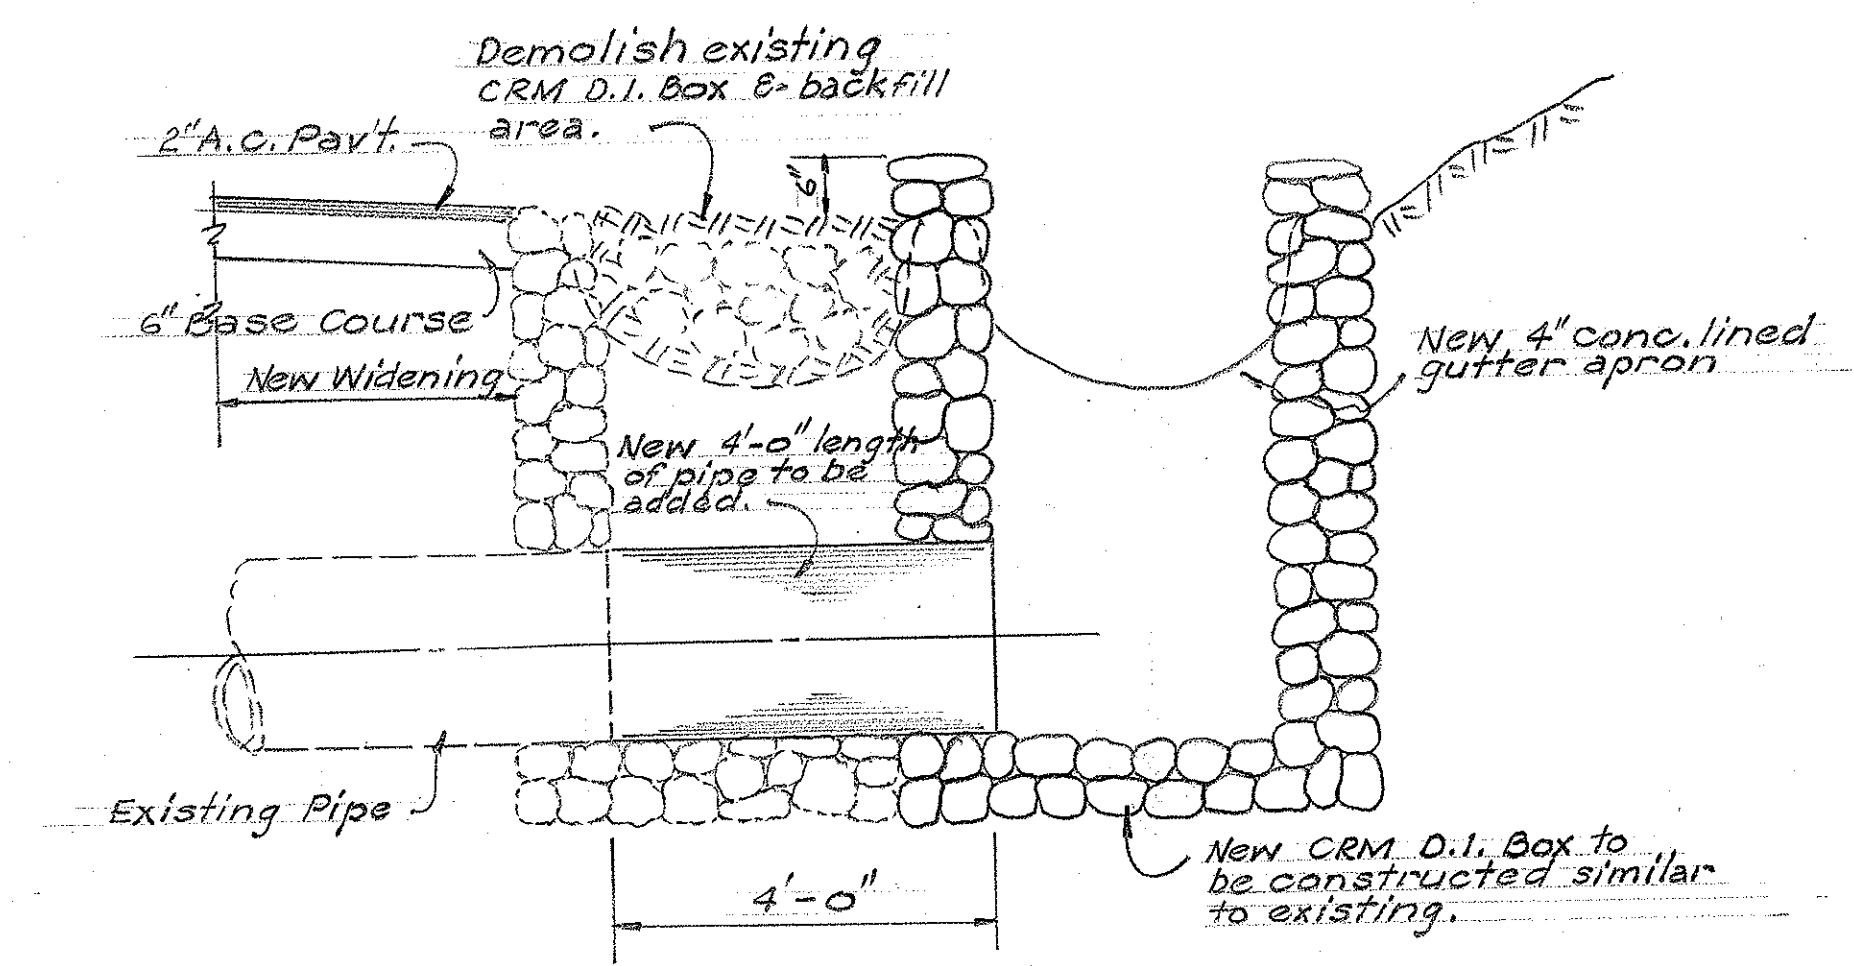


SECTION "A-A"

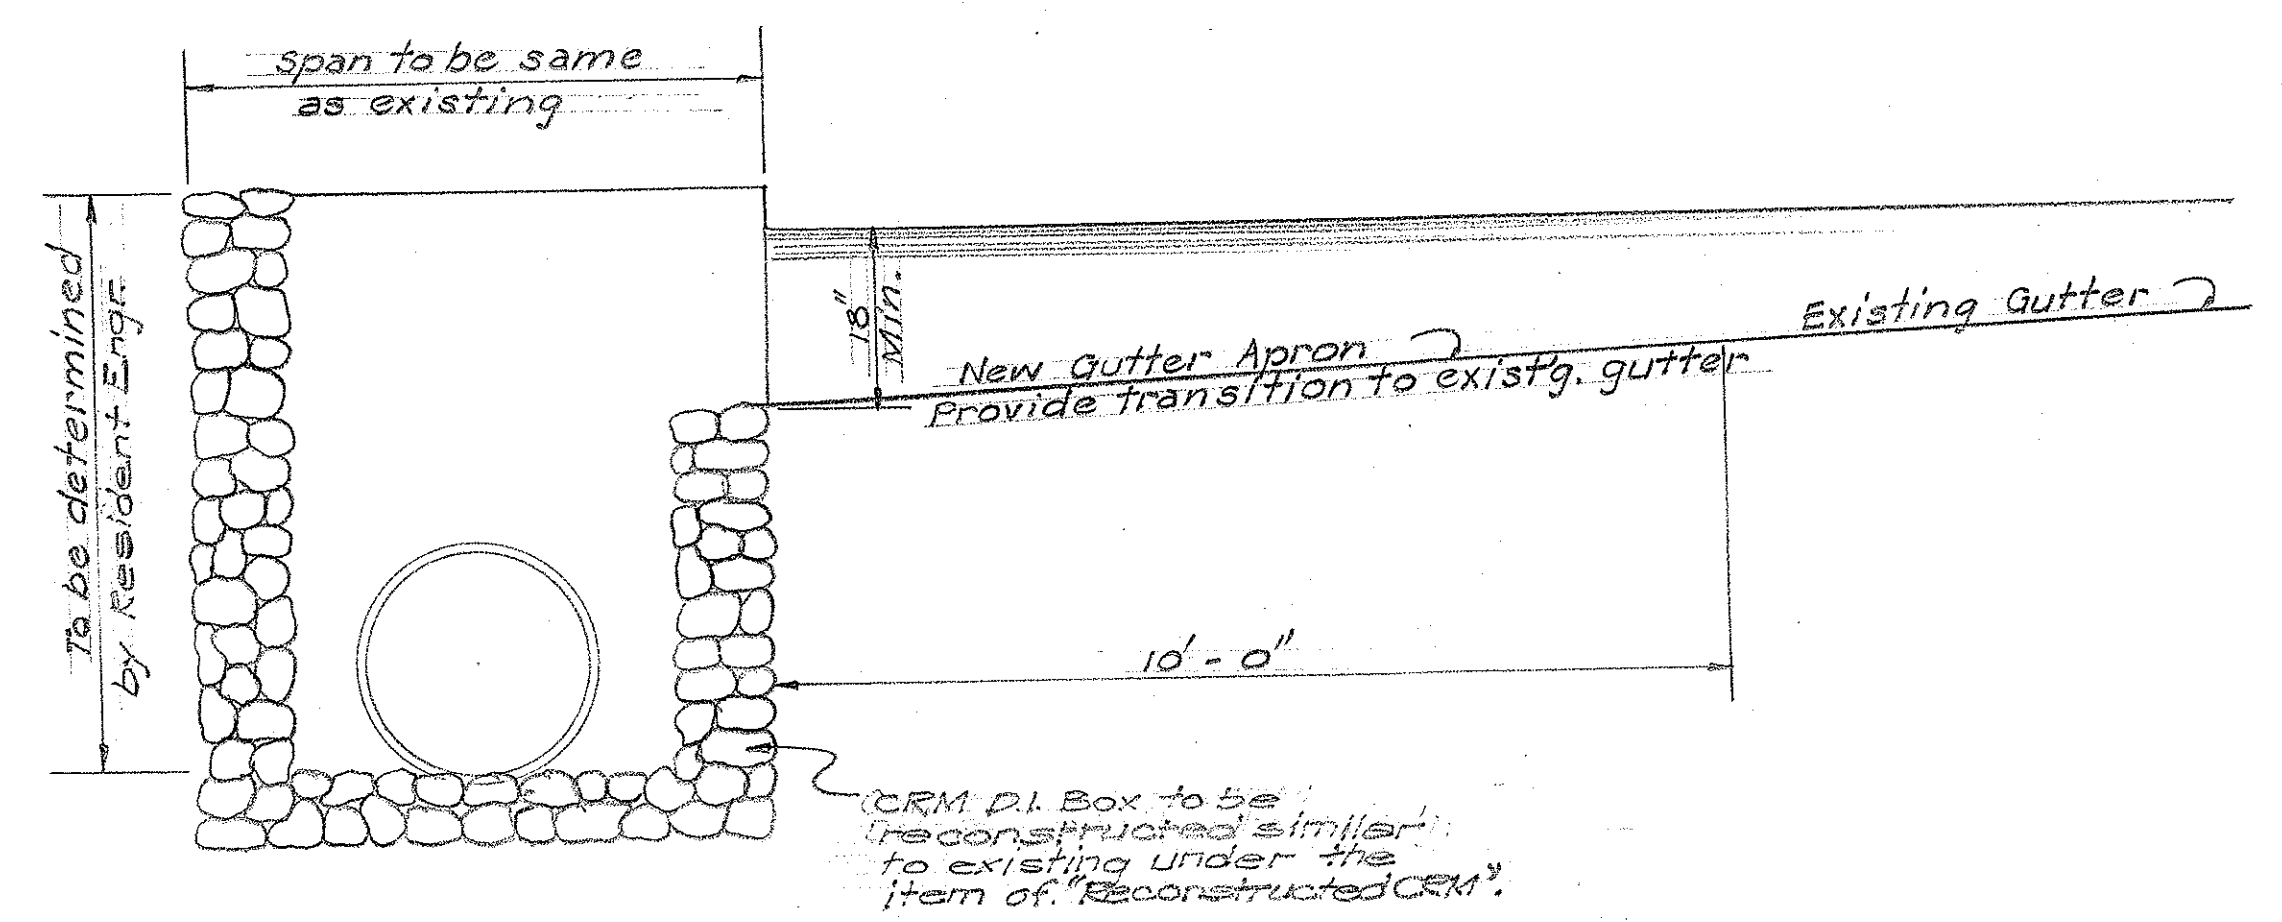


SECTION "B-B"

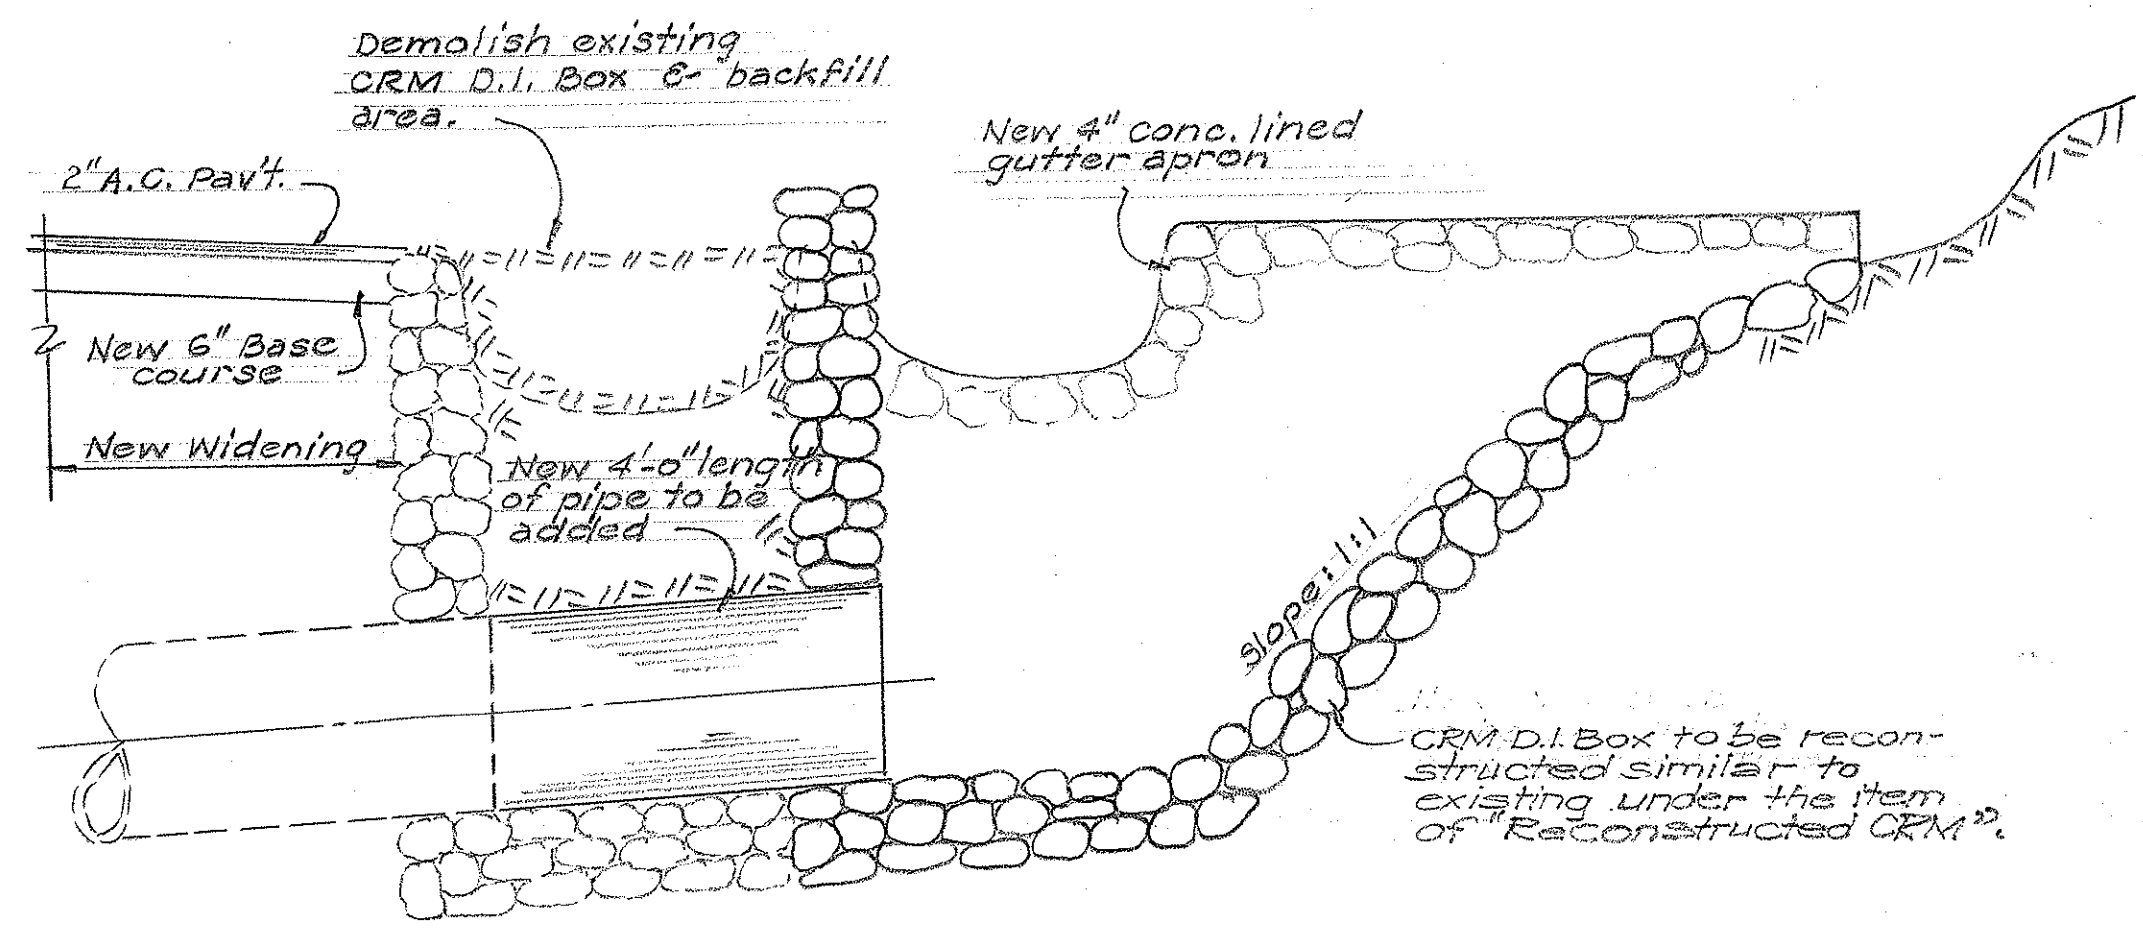

SECTION "X-X"

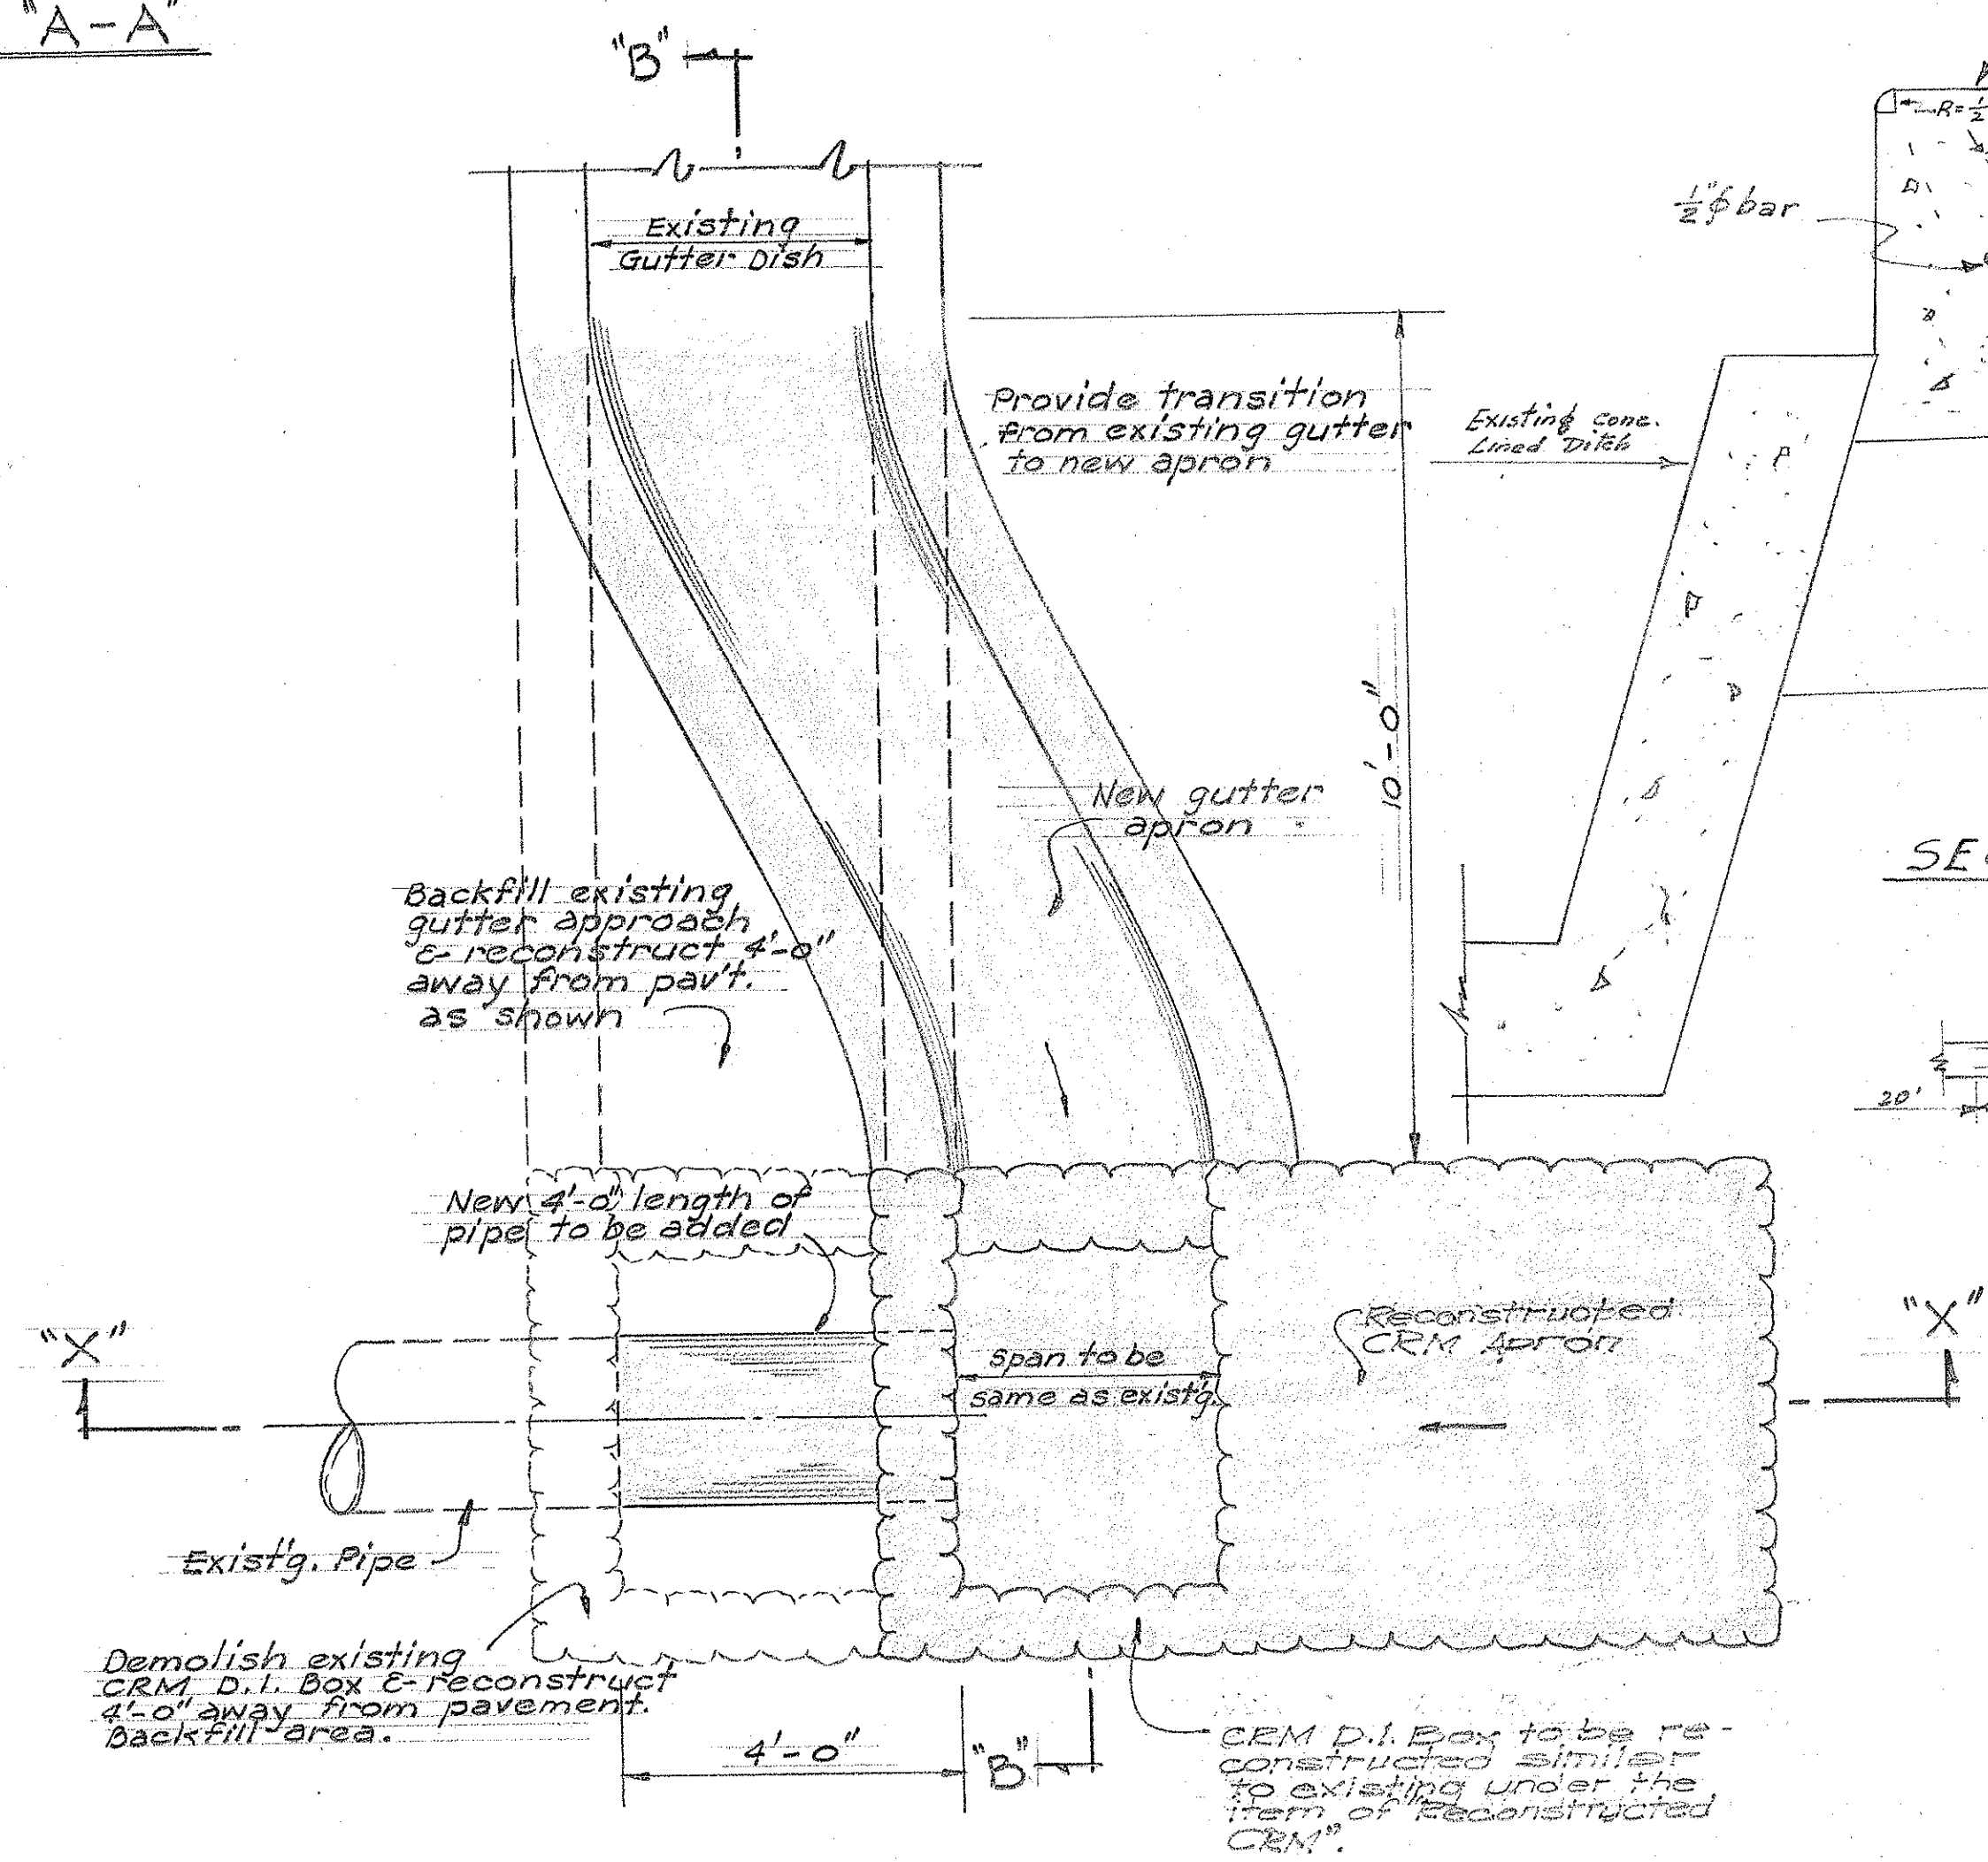


PLAN - TYPE "B" INTAKE

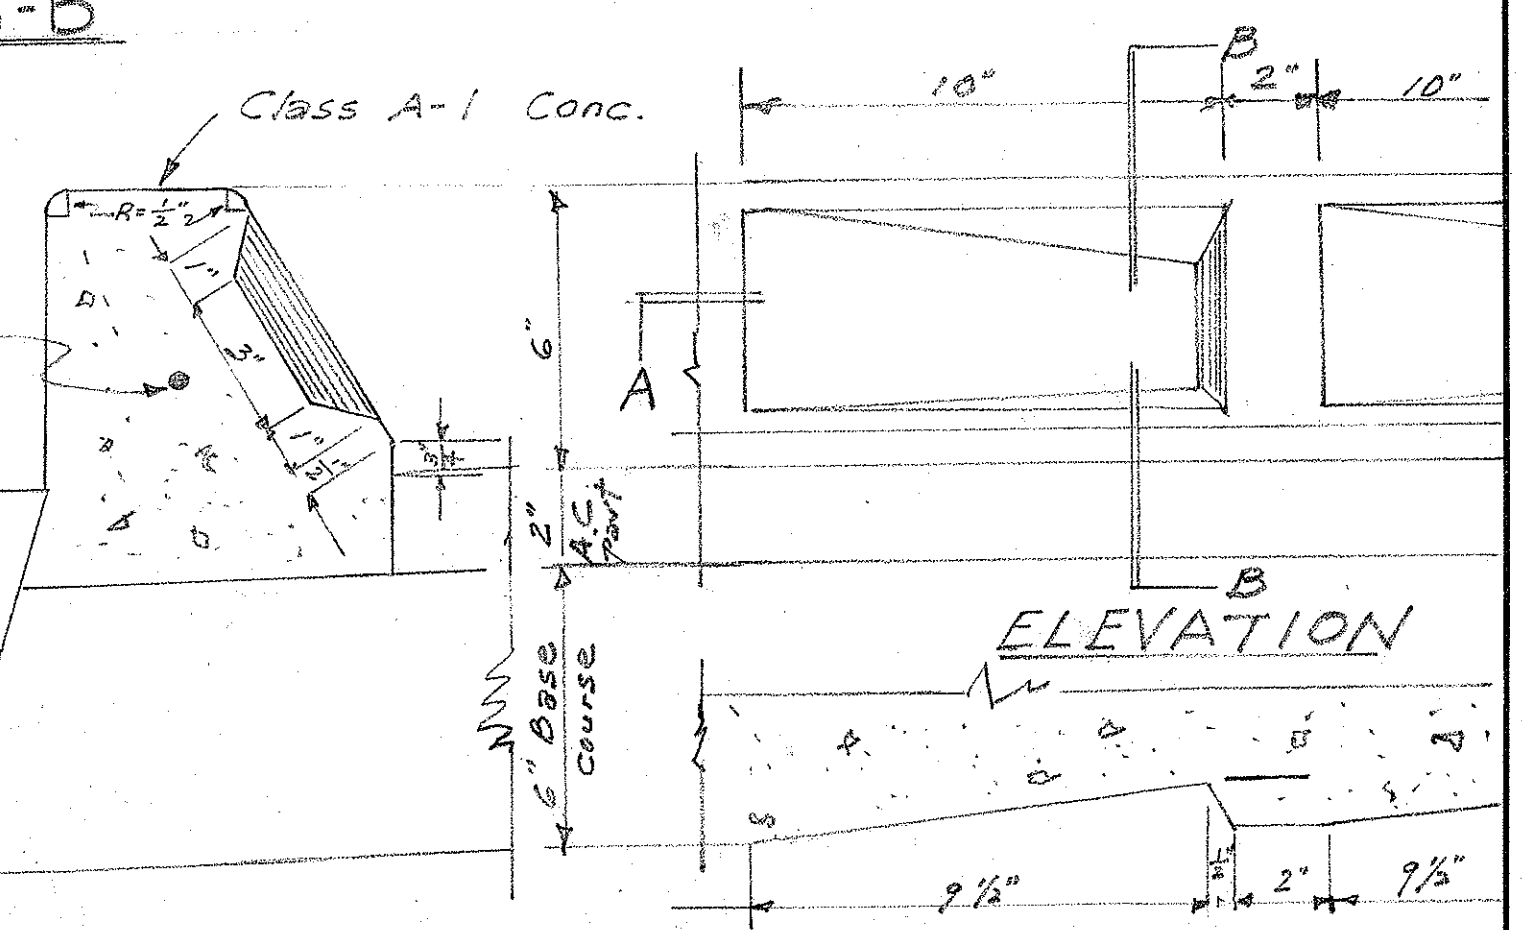

SEC. B-B

SEC. A-A

Scale 3/4" = 1'-0"

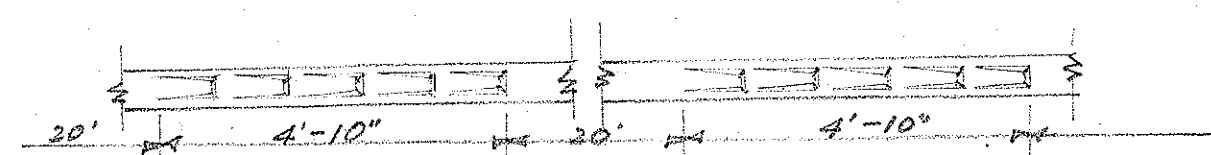

TYPE "A" CURB
WIDENING OF KALANIANA'OLE HWY.
Fed. Aid Proj. FG(16) & War Damage Rehab. Proj. WDR 10
Scale as noted Aug 29, 1949

TERRITORIAL HIGHWAY DEPARTMENT
TERRITORY OF HAWAII
DETAILS FOR RECONSTRUCTION OF TYPE "A" & TYPE "B" D.I. BOXES