

INDEX TO DRAWINGS	
SHEET NO.	DESCRIPTION
1	TITLE SHEET
2	TYPICAL SECTION
3-12	PLAN & PROFILE
13-14	EXTENSION OF CULVERT DETAIL
15	RECONSTRUCTION OF DROP INTAKE BOX DETAIL
16-18	STANDARD DETAIL
19-31	CROSS SECTION

NOTE:
ALL CHANGES MADE DURING CONSTRUCTION
HAVE BEEN NOTED IN RED ON THESE TRACINGS
AND CHECKED.



By: *[Signature]*
Resident Engineer
Date: June 28, 1942

TERRITORY OF HAWAII
TERRITORIAL HIGHWAY DEPARTMENT
HONOLULU, OAHU, T. H.

PLANS OF WIDENING OF A PORTION OF KALANIANA'OLE HIGHWAY FEDERAL AID PROJECT NO. F 6 (16) DISTRICTS OF KOOLAUPOKO AND HONOLULU ISLAND OF OAHU

CONVENTIONAL SIGNS

Centerline	125
Boundary Lines	or
Fences (Named)	-----
Existing Roadways	-----
Circular Culvert	-----
Box Culvert	-----
Bridge	-----
Telephone Pole	-----
Electric Power Pole	-----
Water Main	W ₂ W ₂ (W ₄ , 8, 12, Etc.)
Storm Drain	SD ₁₂ SD ₁₂ (SD ₁₈ , 24, Etc.)
Concrete Drop Intake	C.D.I.
Standard Catch Basin	C.B.
Standard Manhole	M.H.S.
Sewer Manhole	S.S. S.S. (S.S., T.M.H.)
Telephone Manhole	T.M.H.
Fire Hydrant	F.H.
Tree (Large, named)	Mango, Coca
Railroad	-----

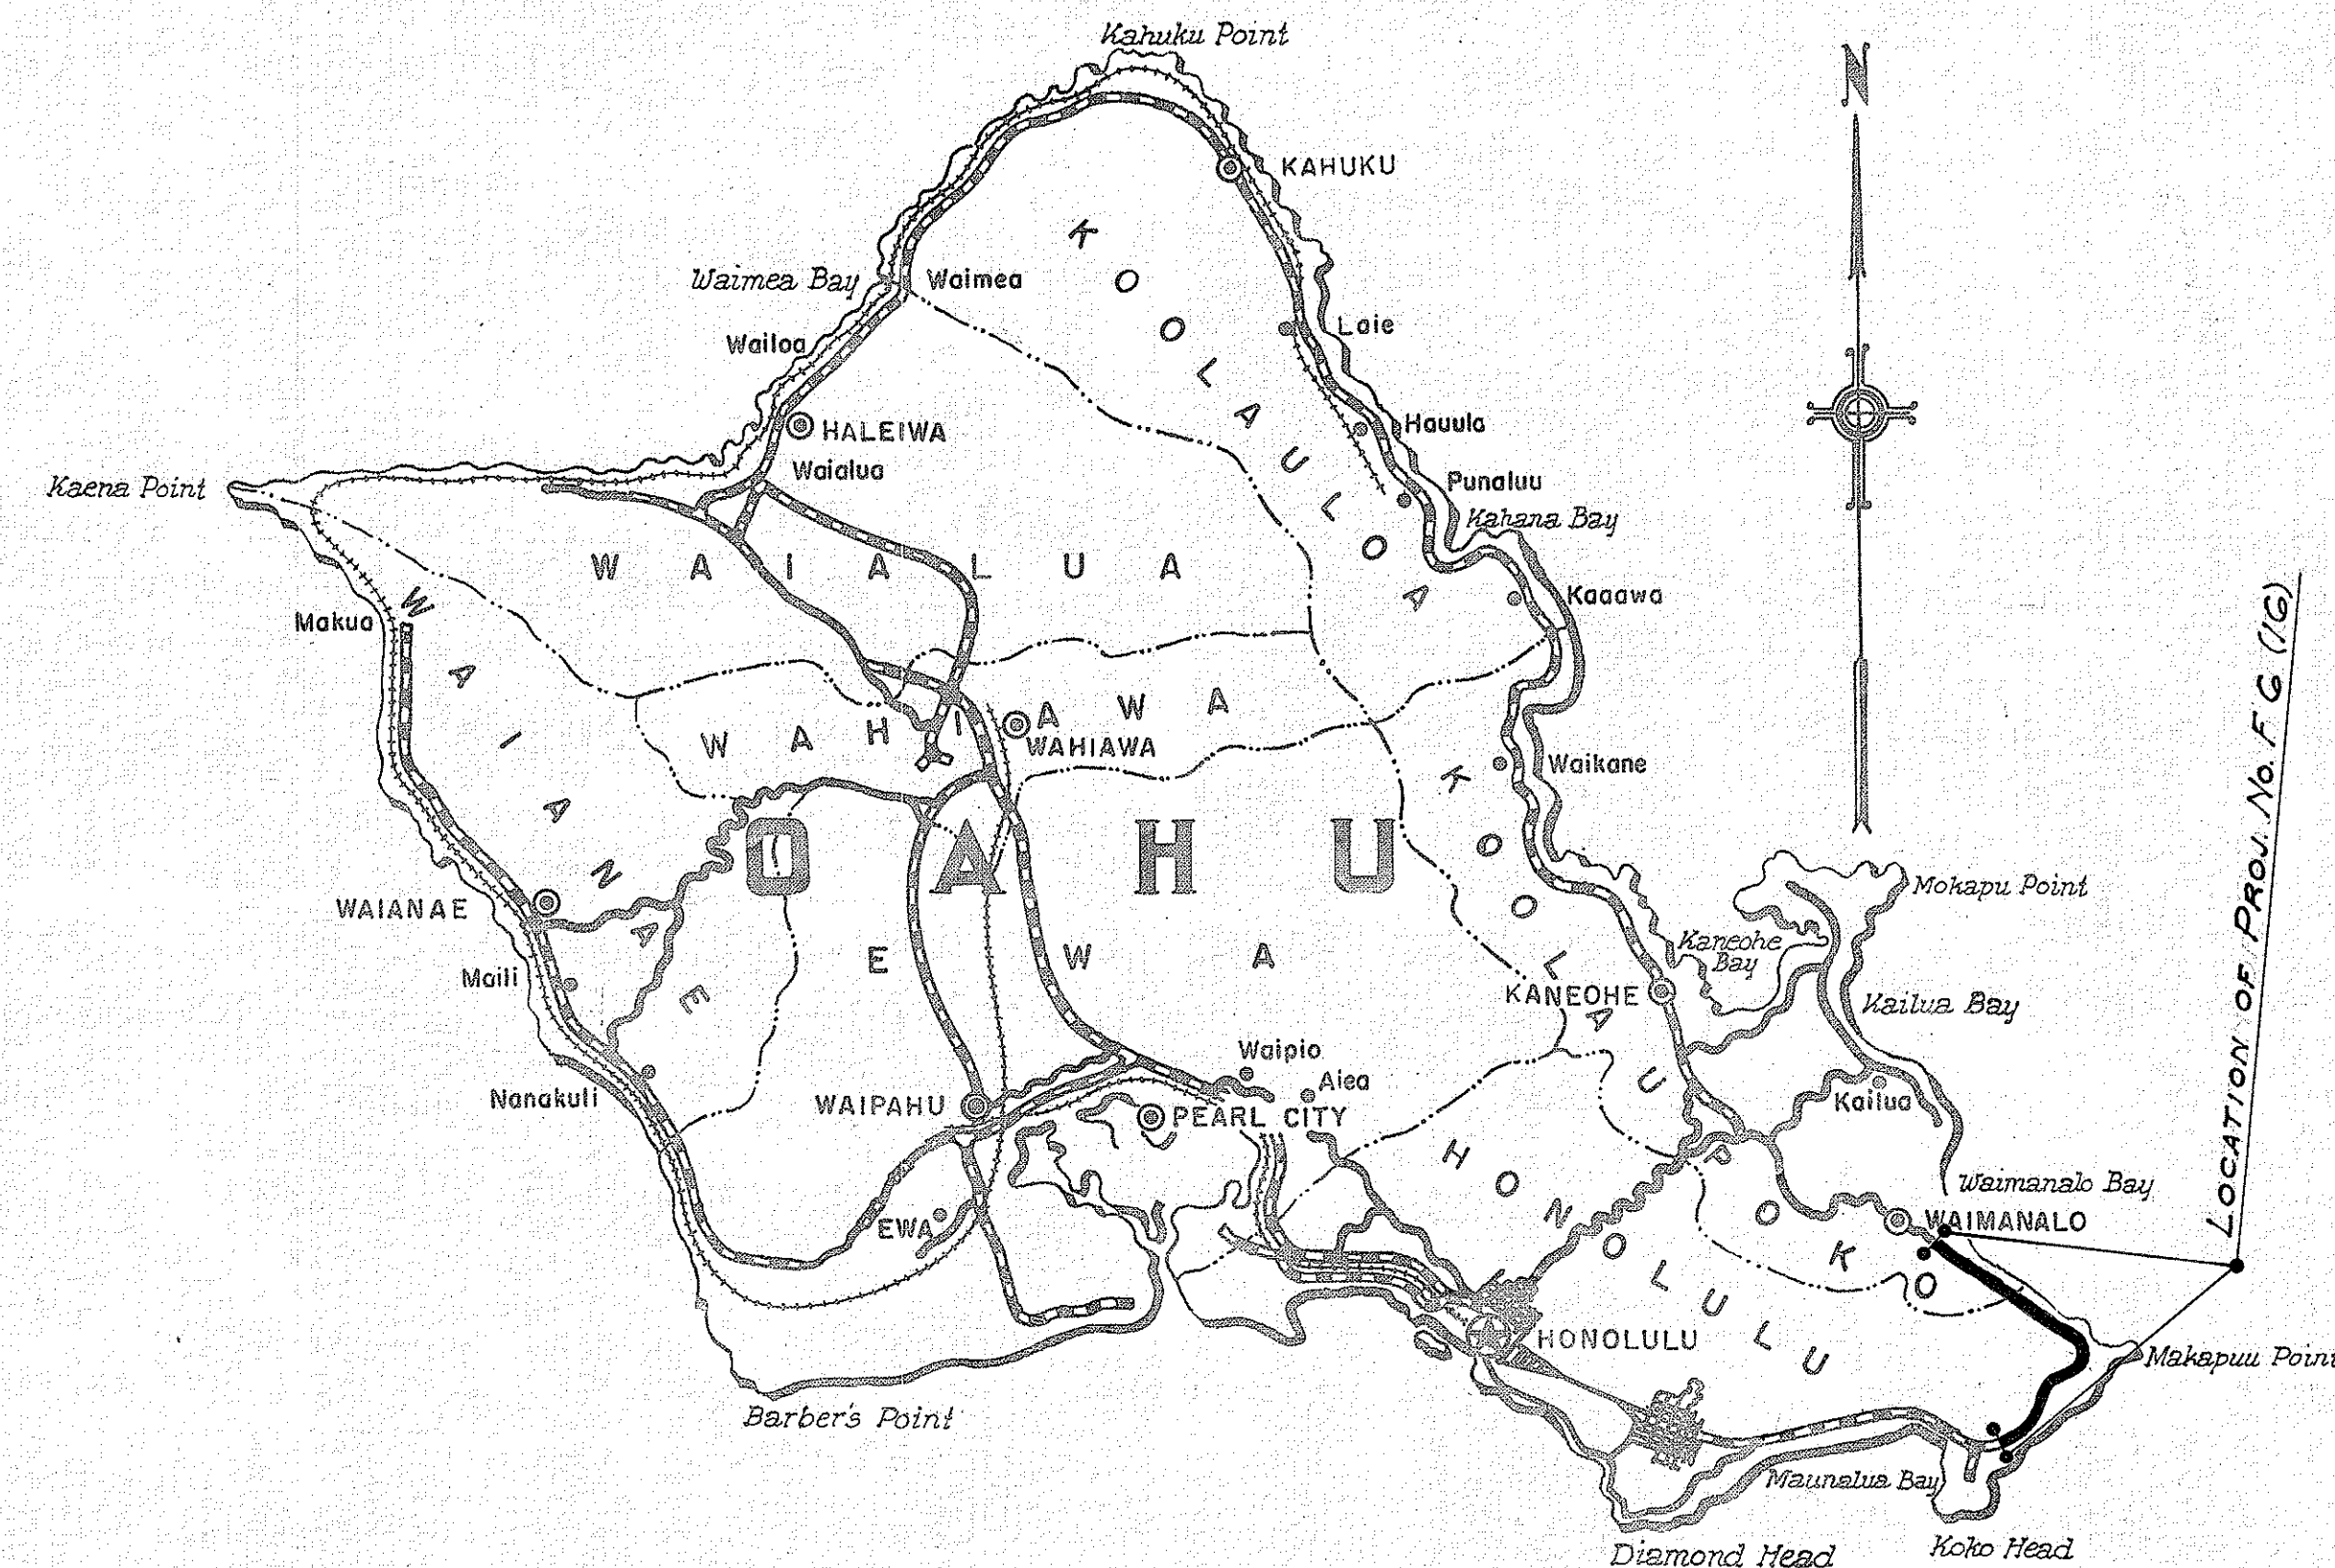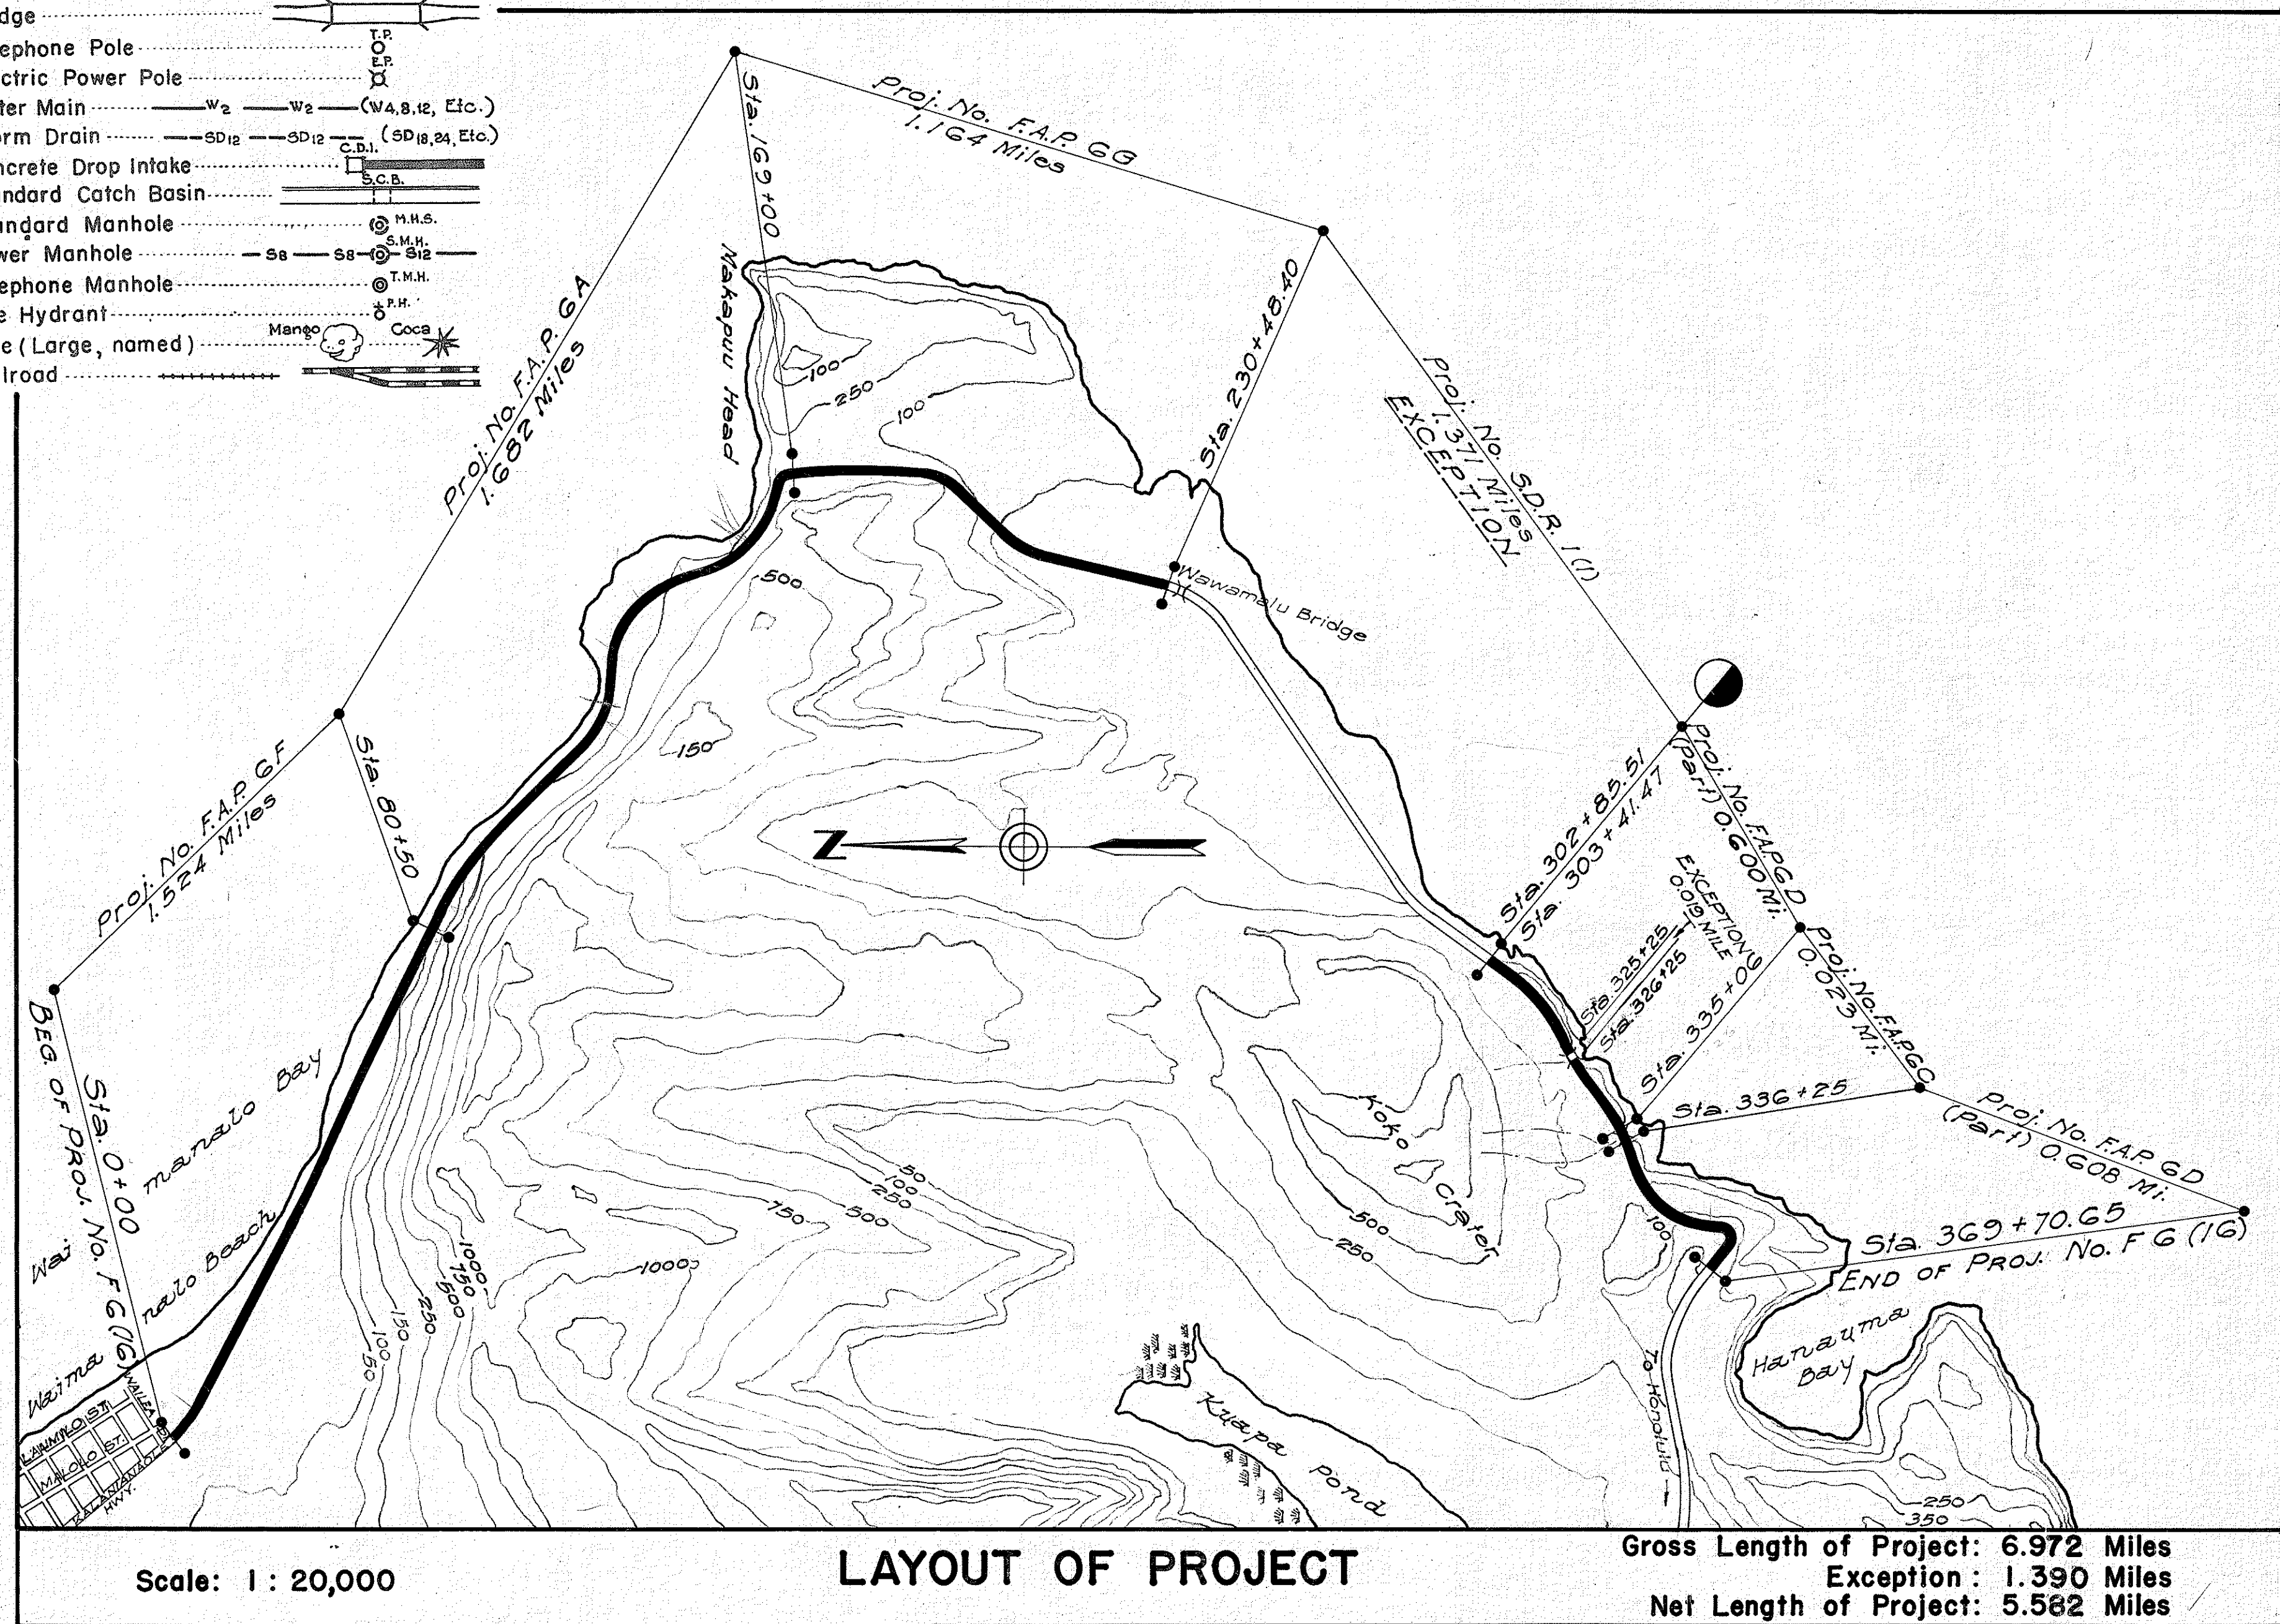

Federal Aid Projects Previously Constructed Or Under Construction

DATE	
DESIGNED BY	
TRACED BY	
QUANTITIES BY	
CHECKED BY	
ORIGINAL PLAN	
NOTE BOOK	
No.	

RECOMMENDED FOR APPROVAL DATE:

DISTRICT ENGINEER
PUBLIC ROADS ADMINISTRATION
FEDERAL WORKS AGENCY

APPROVED DATE:

DIVISION ENGINEER
PUBLIC ROADS ADMINISTRATION
FEDERAL WORKS AGENCY

APPROVED DATE: April 21, 1942

[Signature]
TERRITORIAL HIGHWAY ENGINEER