
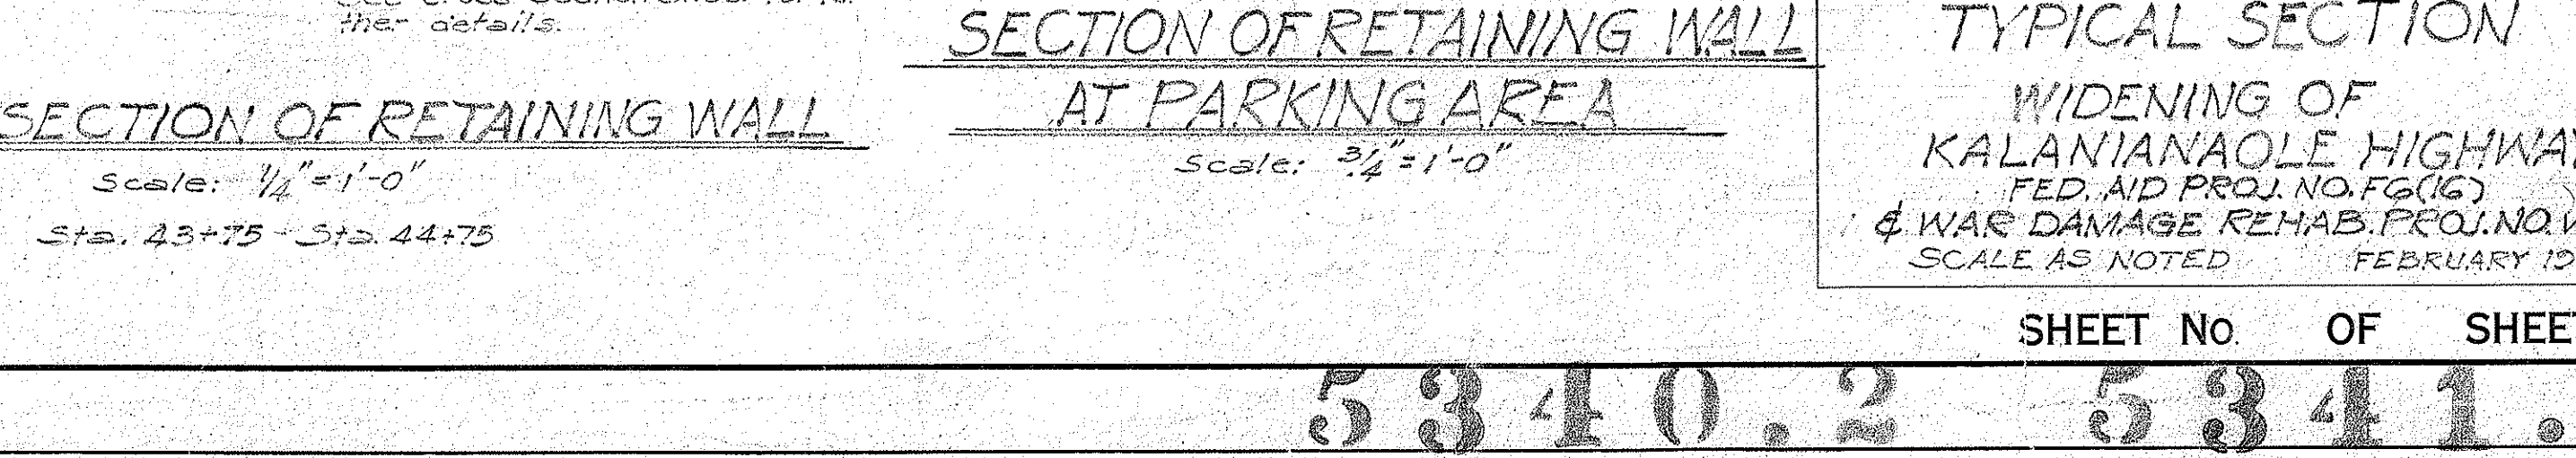
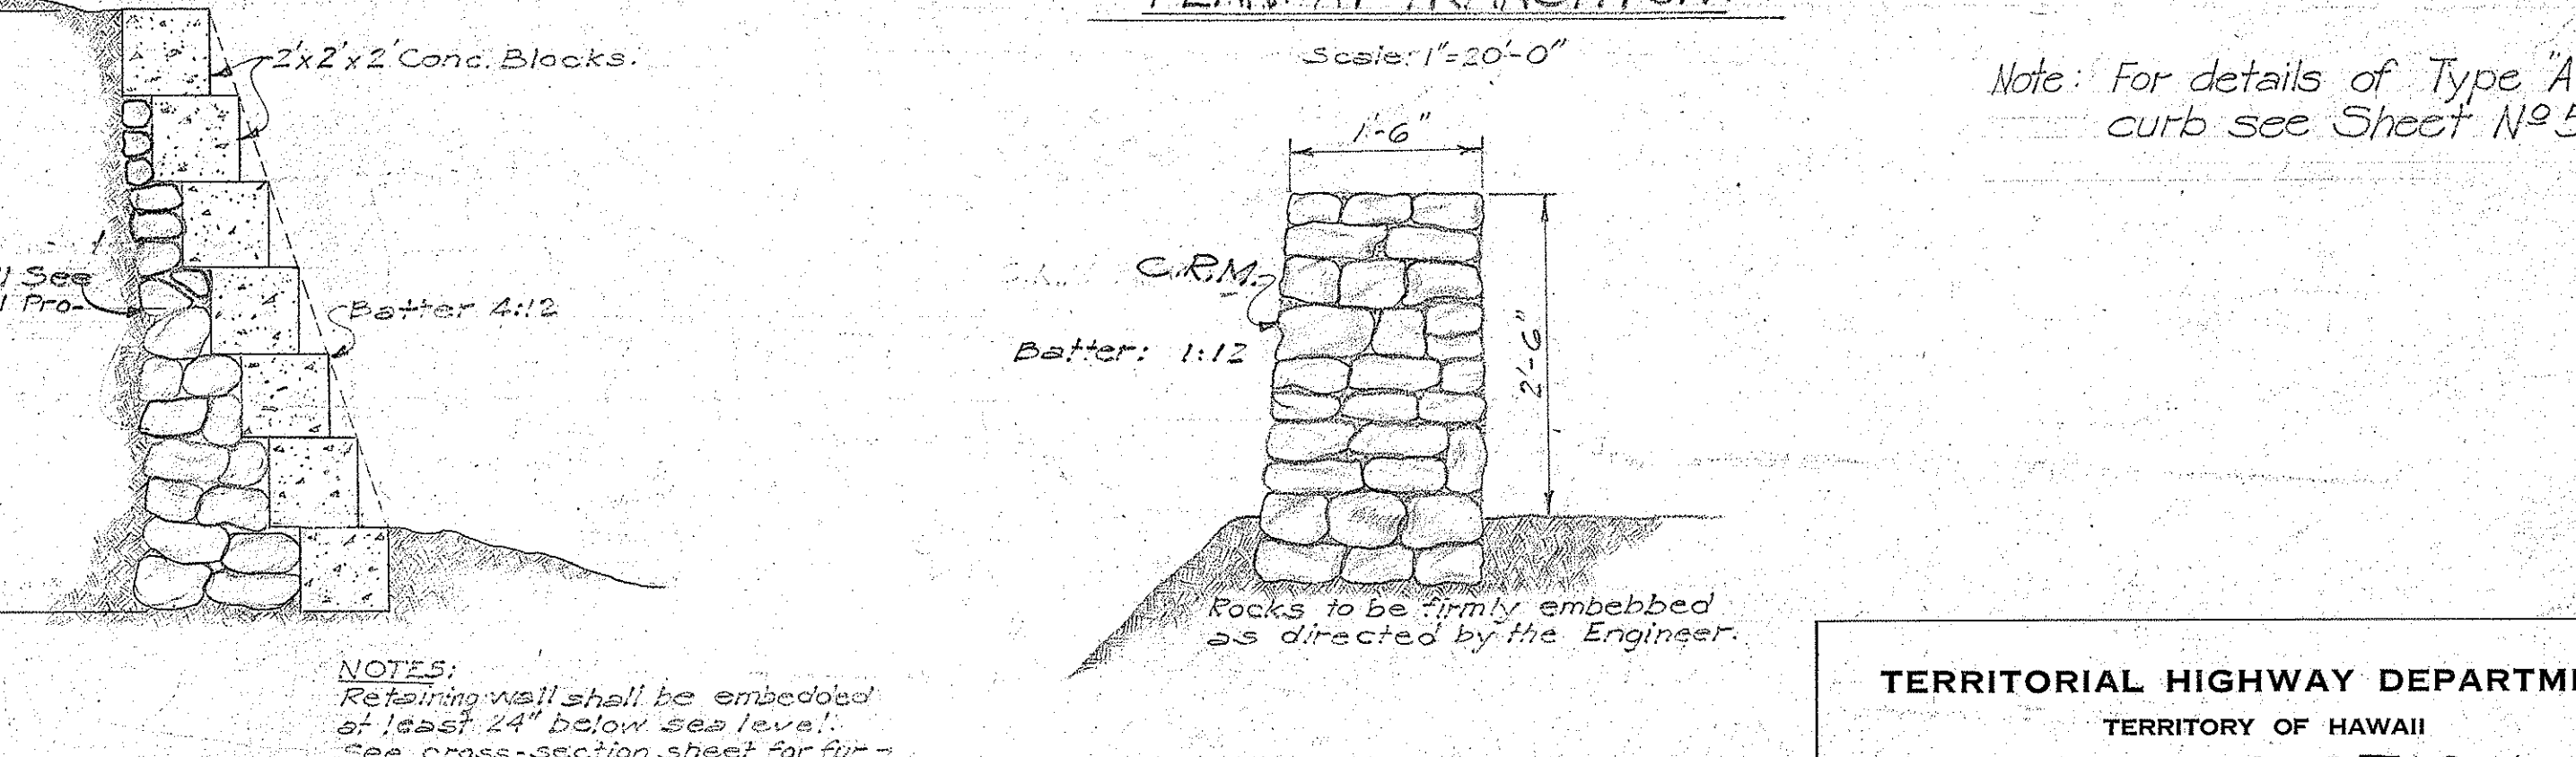
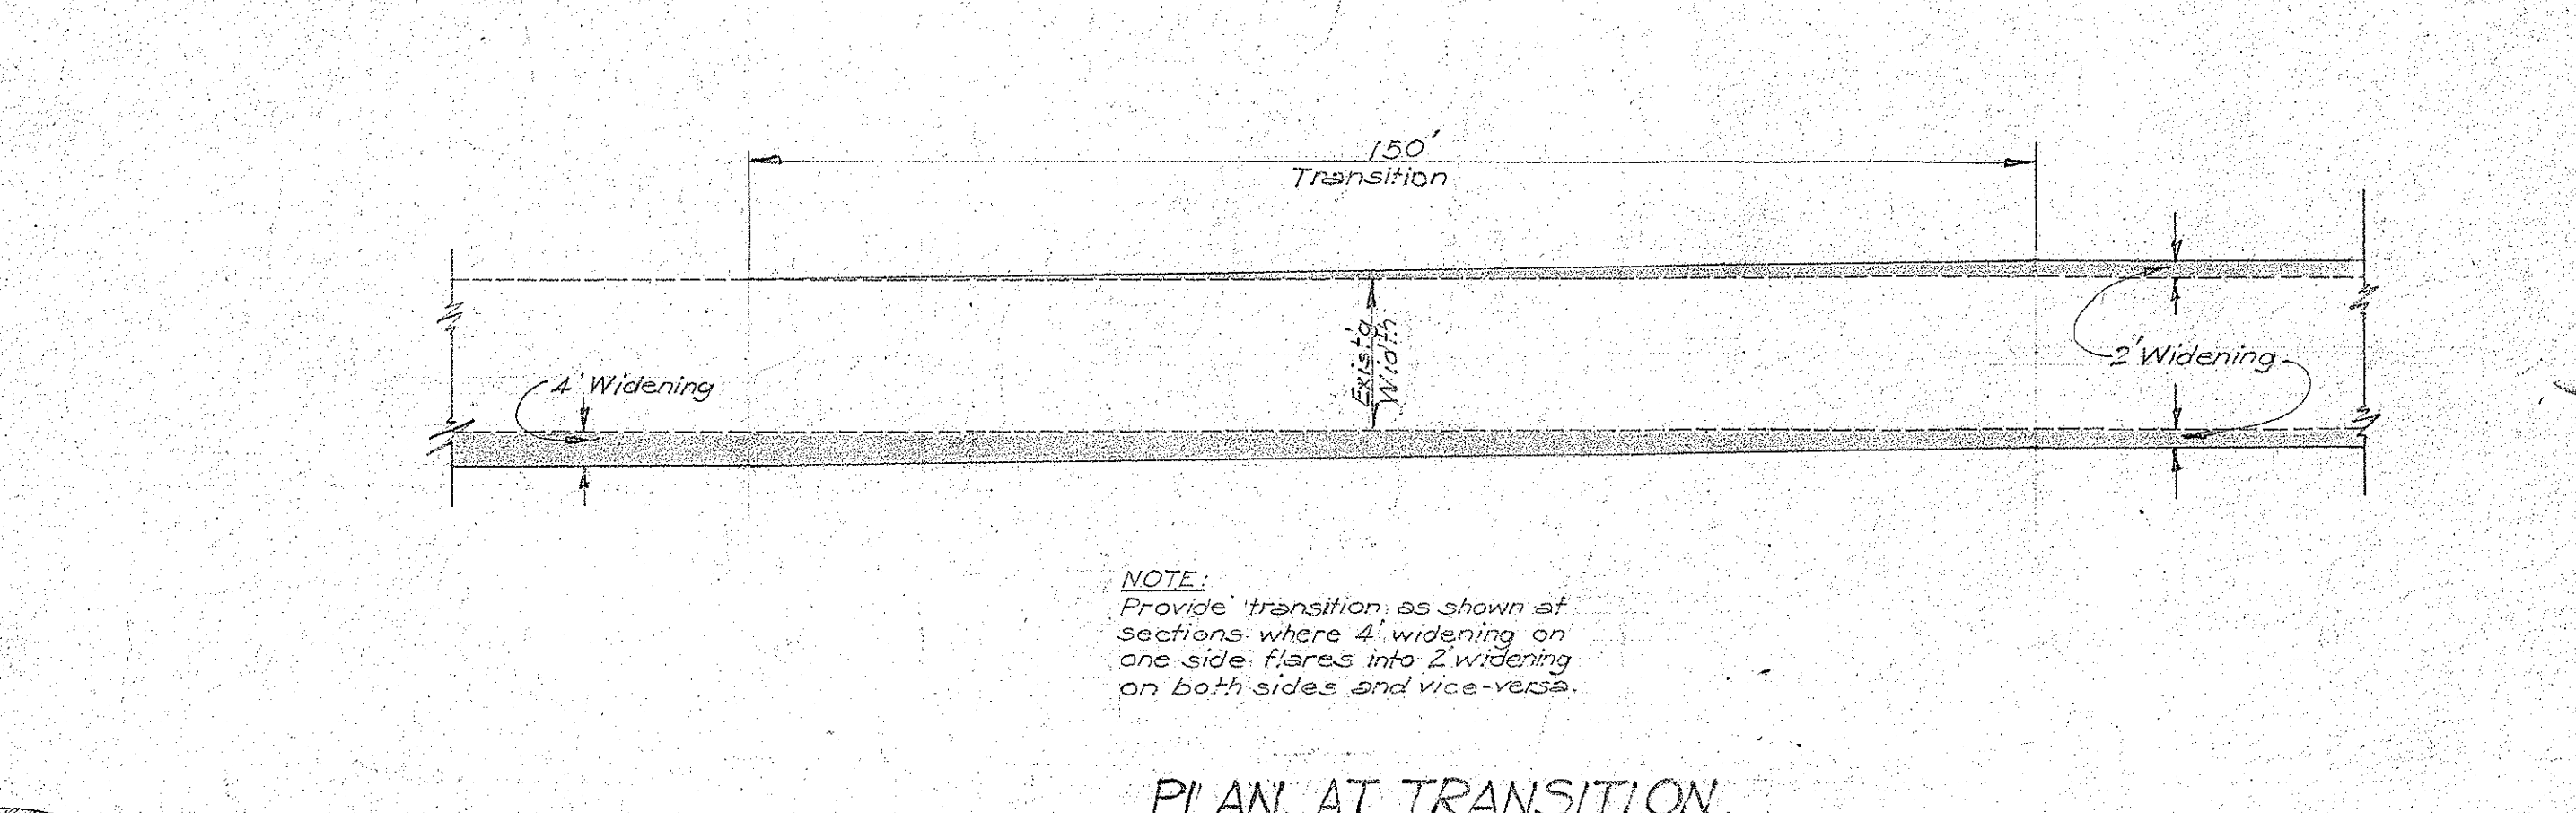
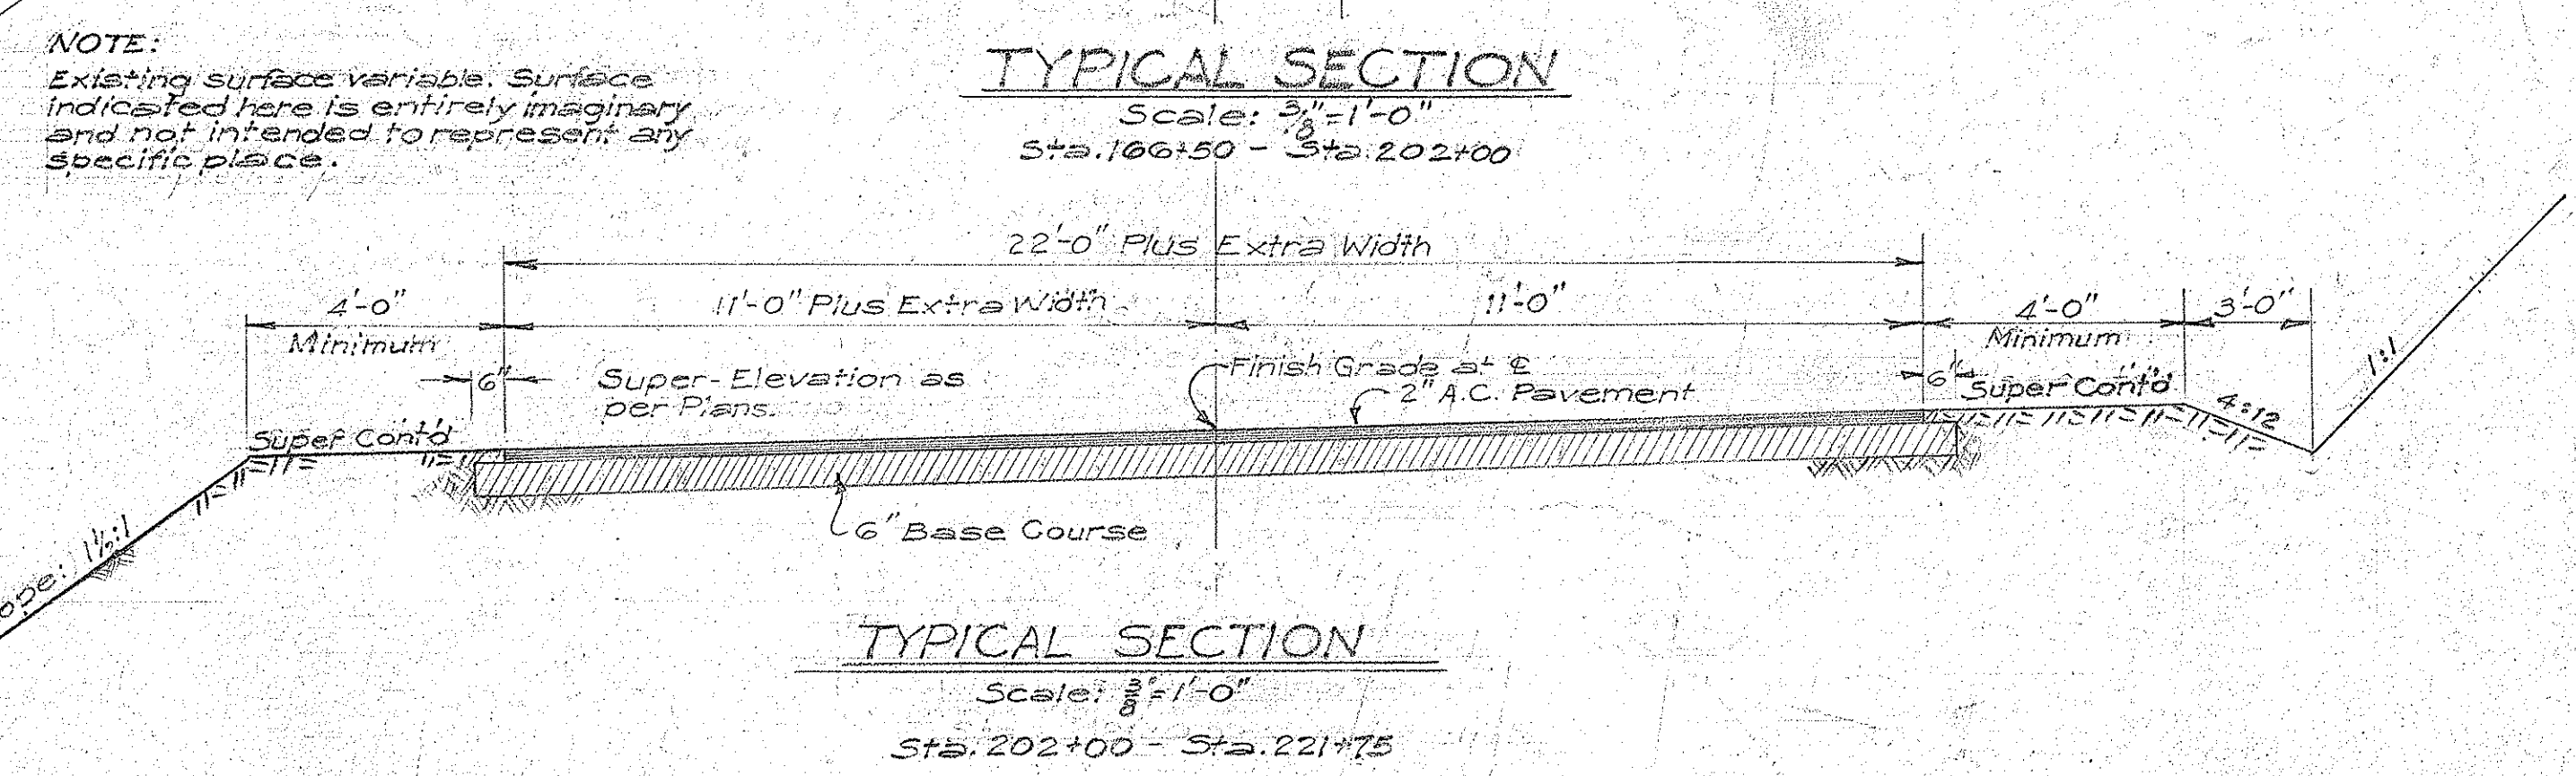
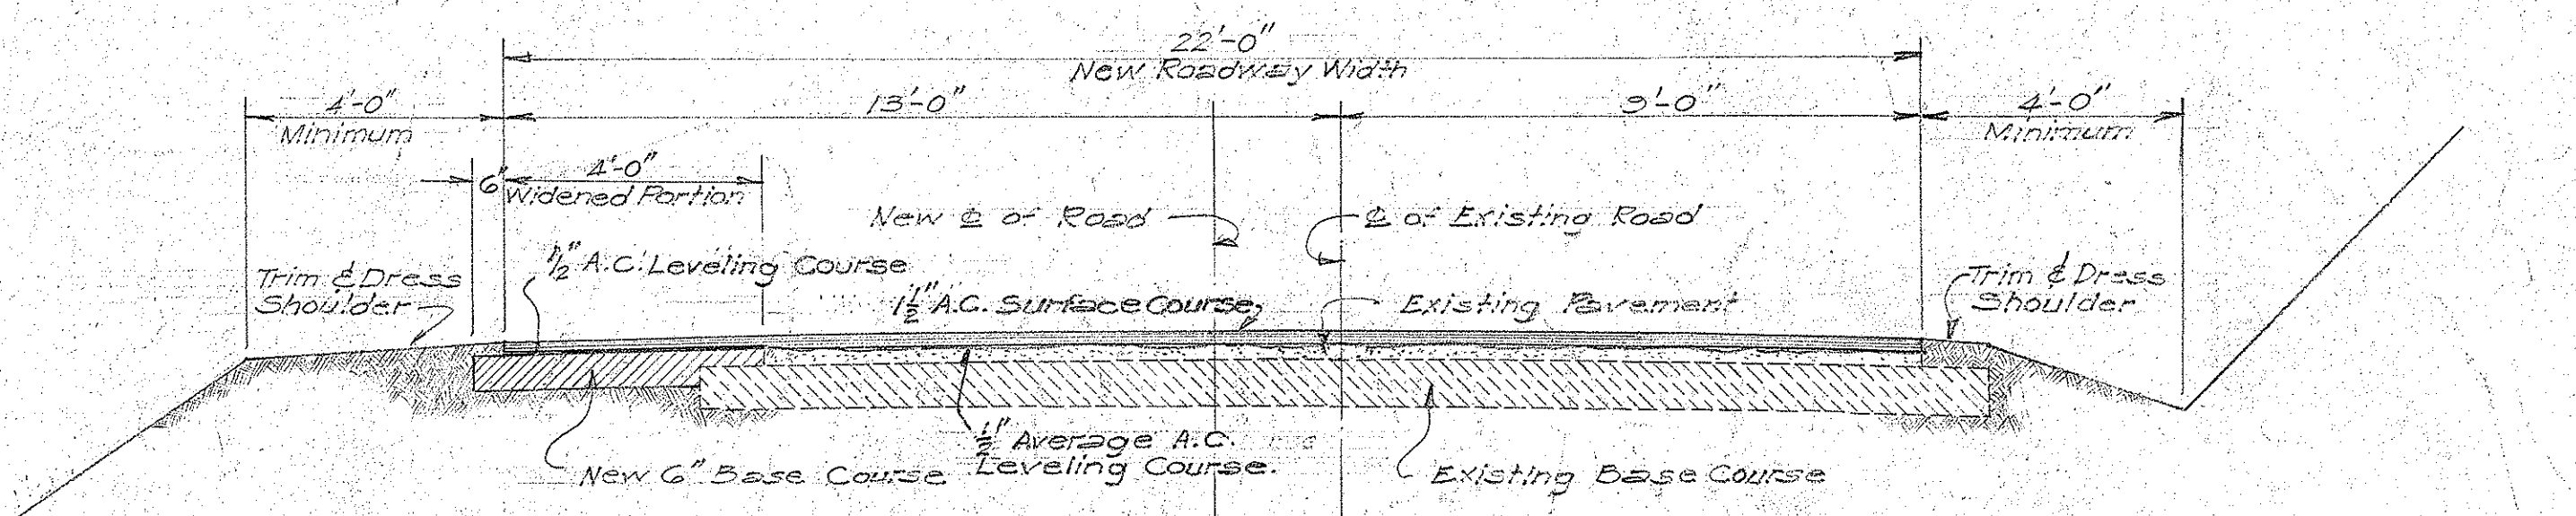
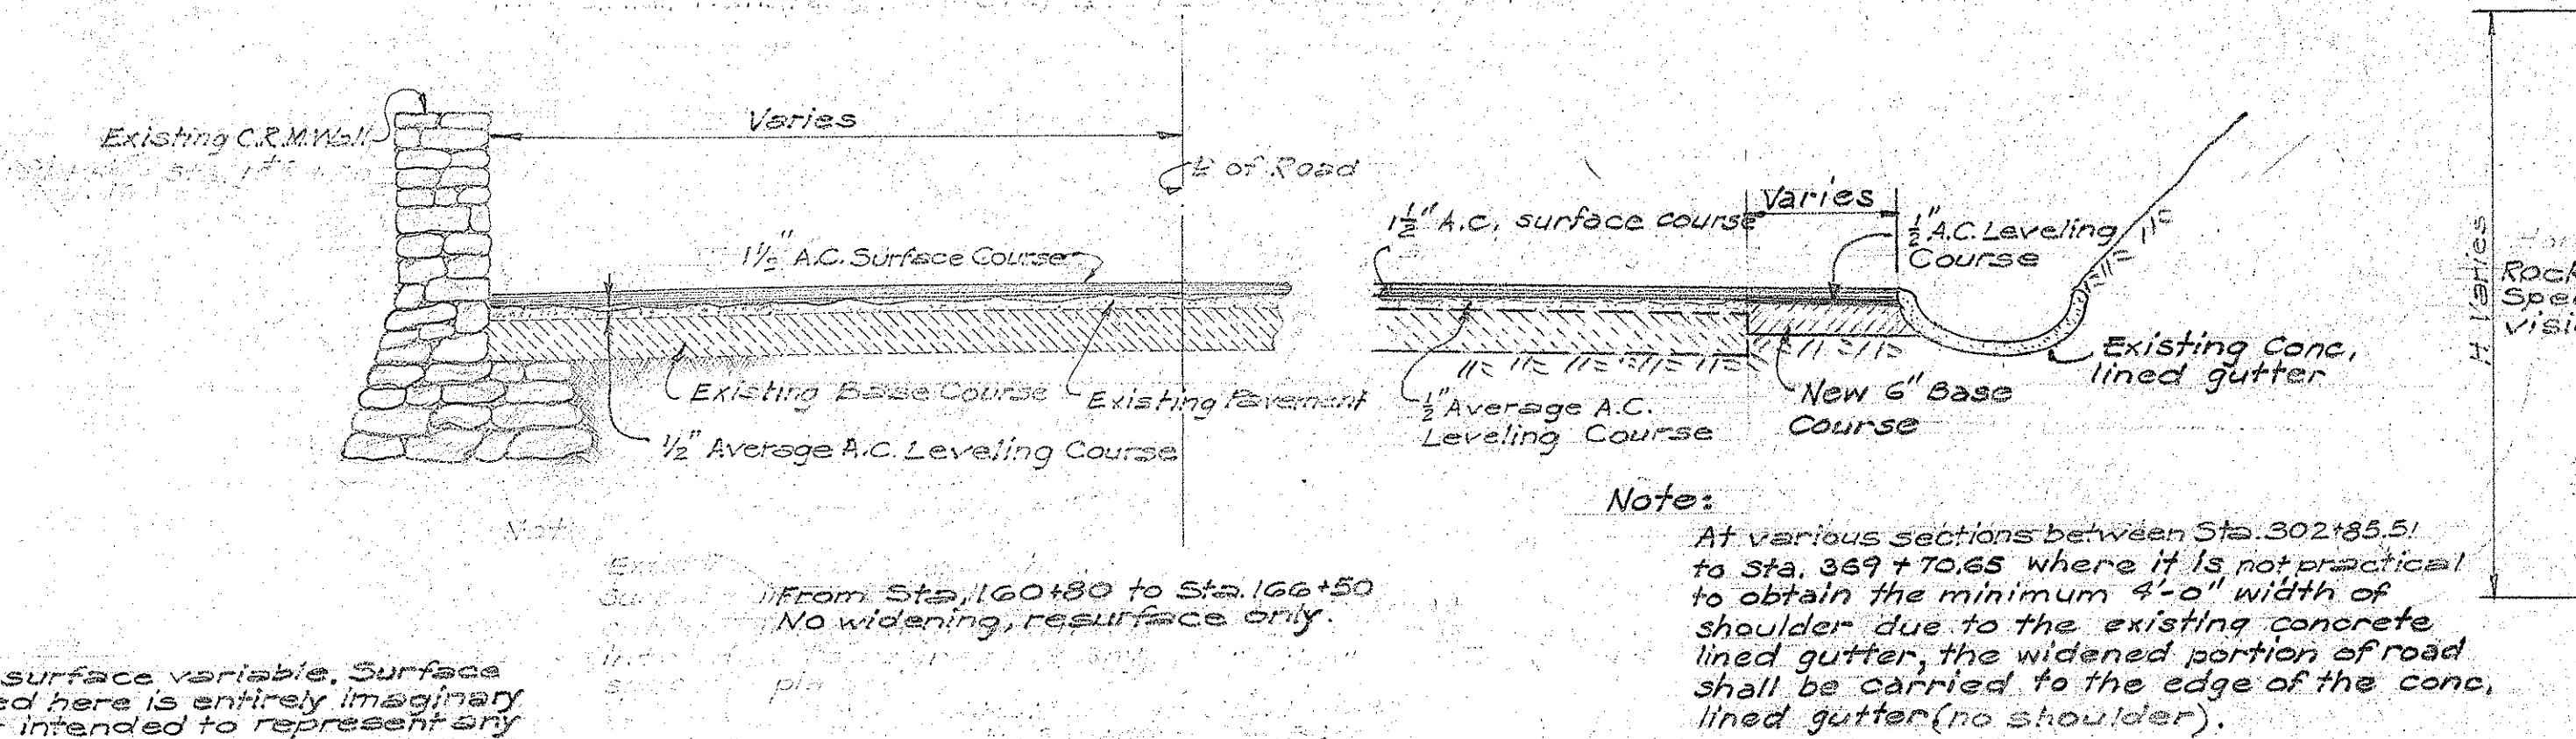
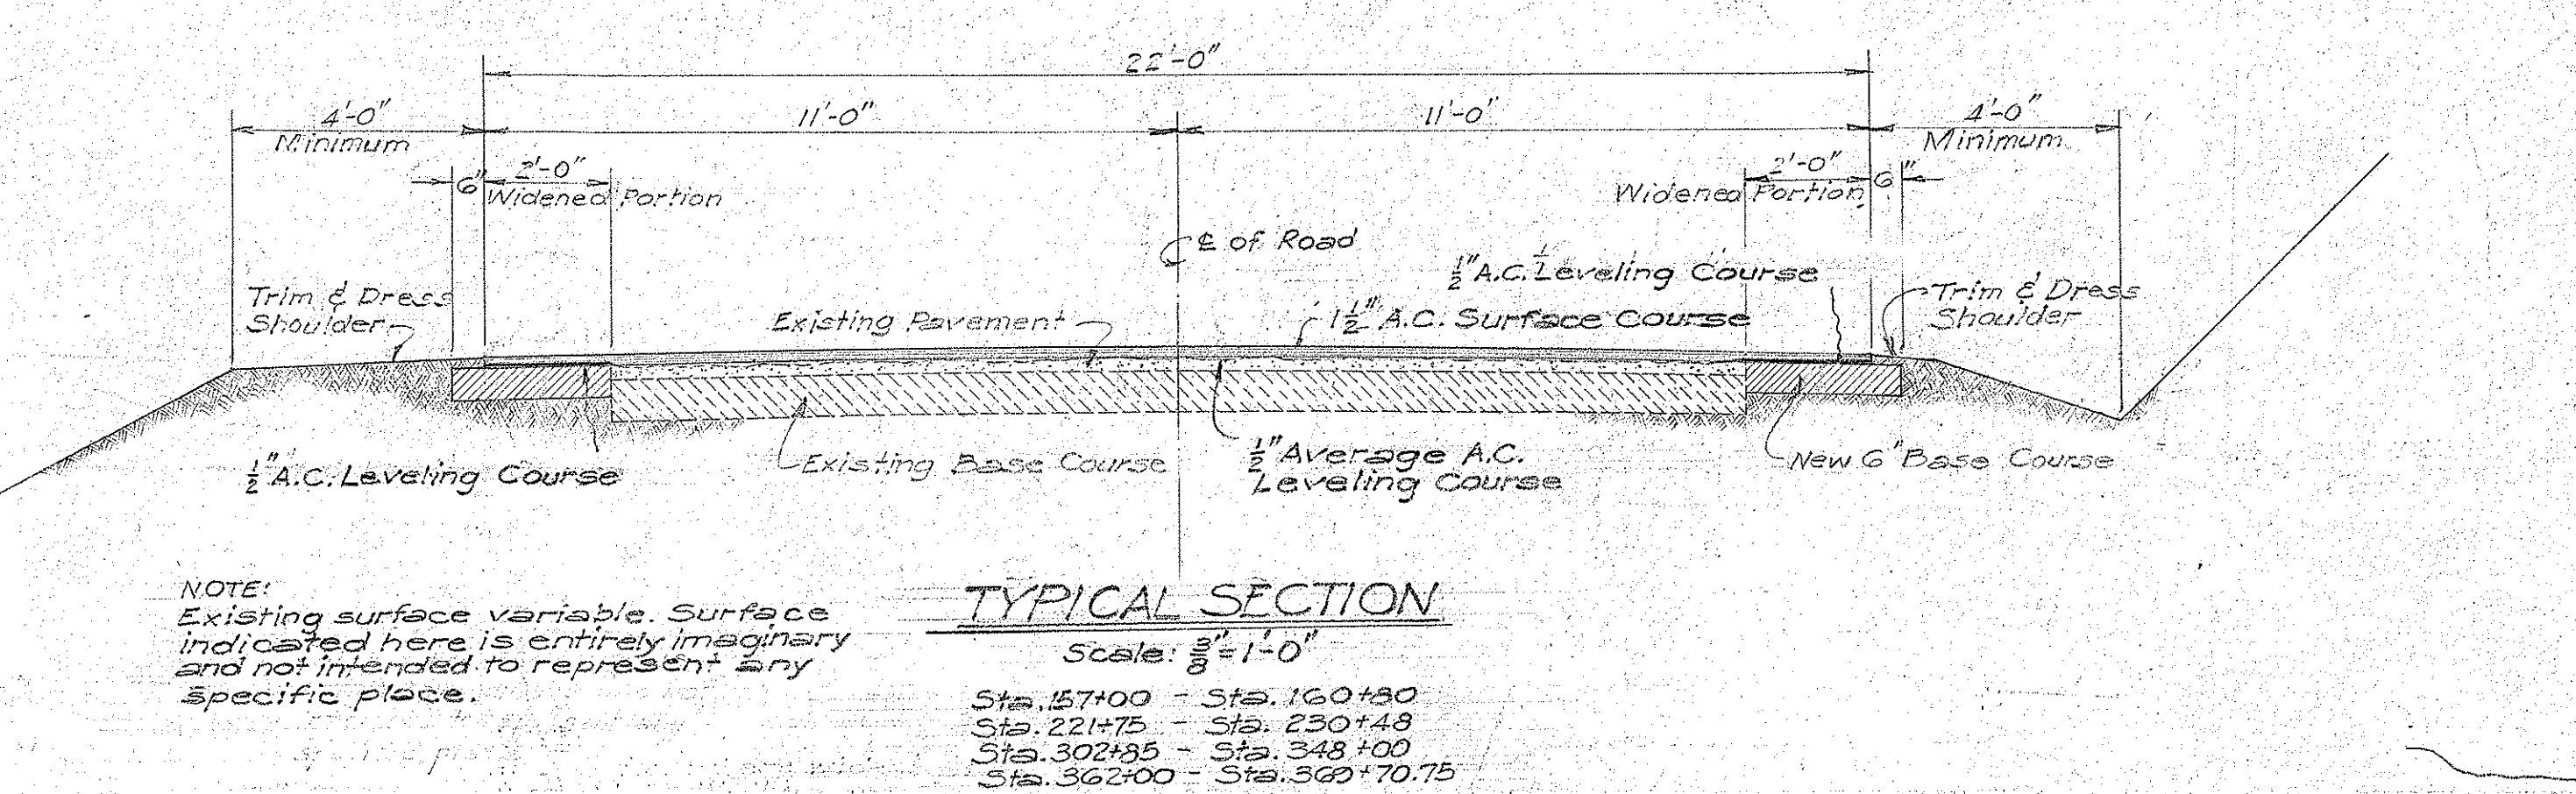
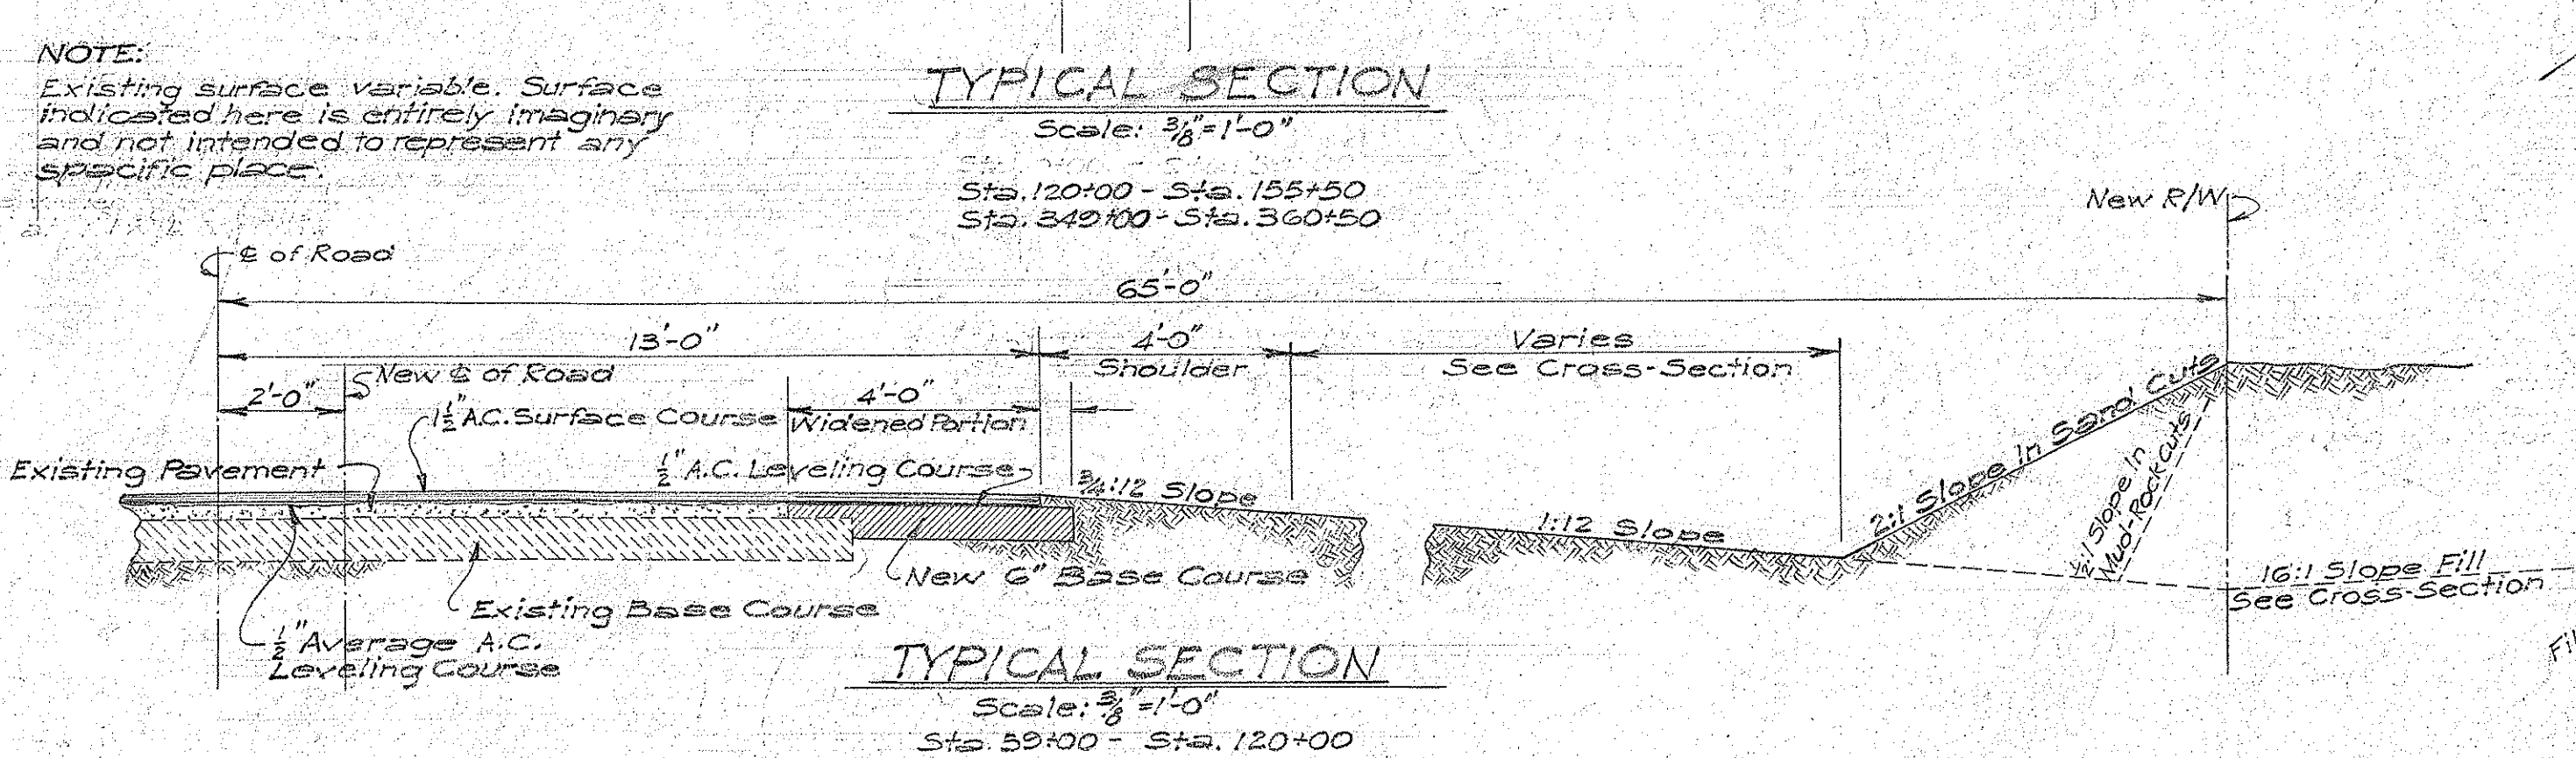
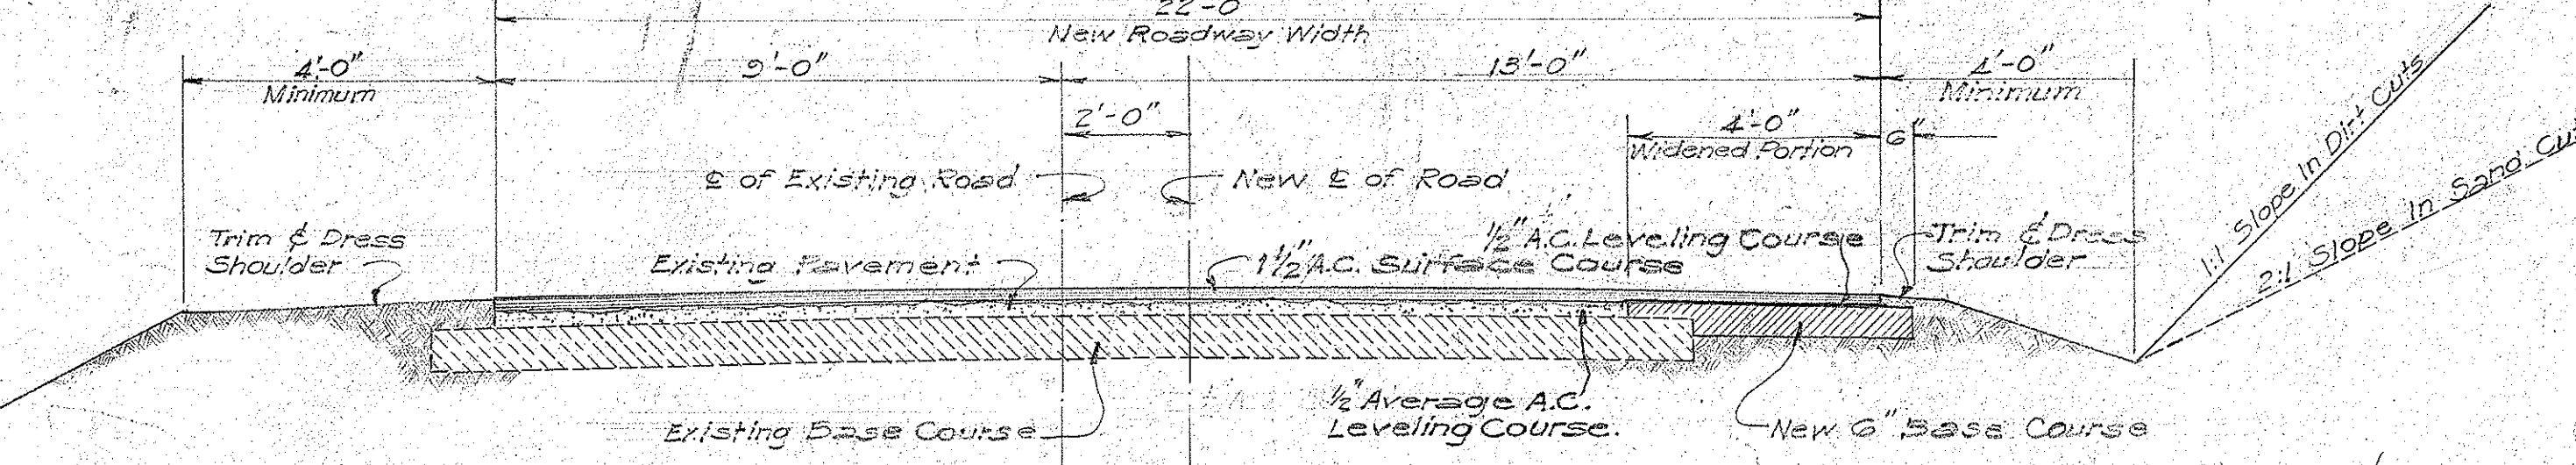


FED. ROAD DIST. NO.	STATE	FED. AID PROJ. NO.	FISCAL YEAR	SHEET NO.	TOTAL SHEETS
HAWAII	HAW	WDR101	1949	2	12

FED. ROAD DIST. NO.	STATE	FED. AID PROJ. NO.	FISCAL YEAR	SHEET NO.	TOTAL SHEETS
HAWAII	HAW	FG(16)	1949	2	31

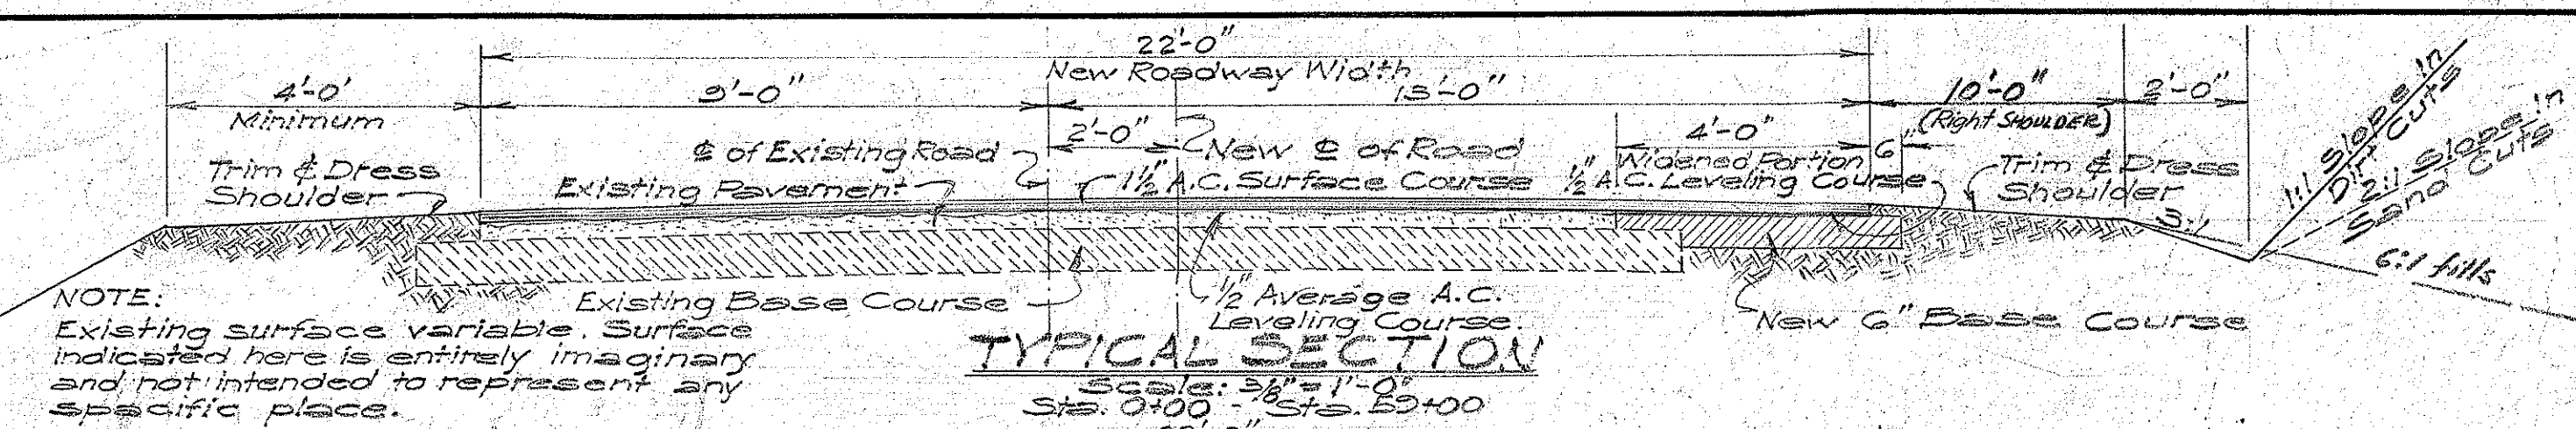

DATE: MAY 17, 1949

SURVEY PLOTTED BY: [blank]

DESIGNED BY: [blank]

DRAWN BY: [blank]

CHECKED BY: [blank]

NOTE BOOK NO. [blank]

TERRITORIAL HIGHWAY DEPARTMENT
TERRITORY OF HAWAII

TYPICAL SECTION
WIDENING OF KALANIANA'OLE HIGHWAY
FED. AID PROJ. NO. FG(16)
& WAR DAMAGE REHAB. PROJ. NO. WDR11(1)
SCALE AS NOTED FEBRUARY 1949

SHEET NO. OF SHEETS