
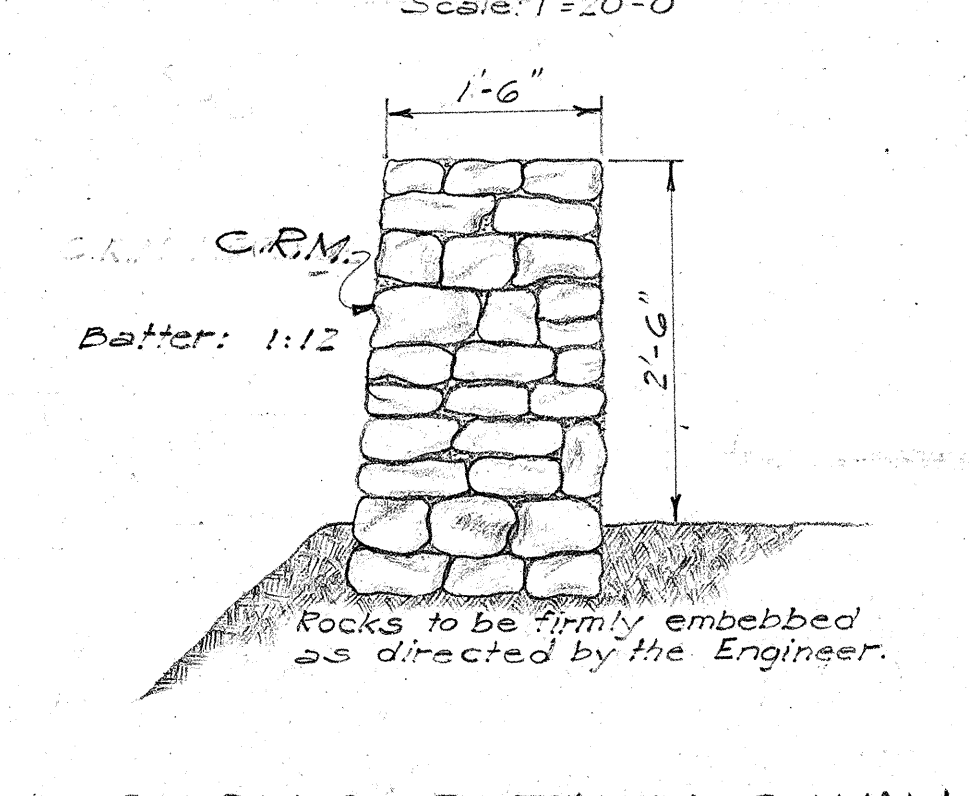
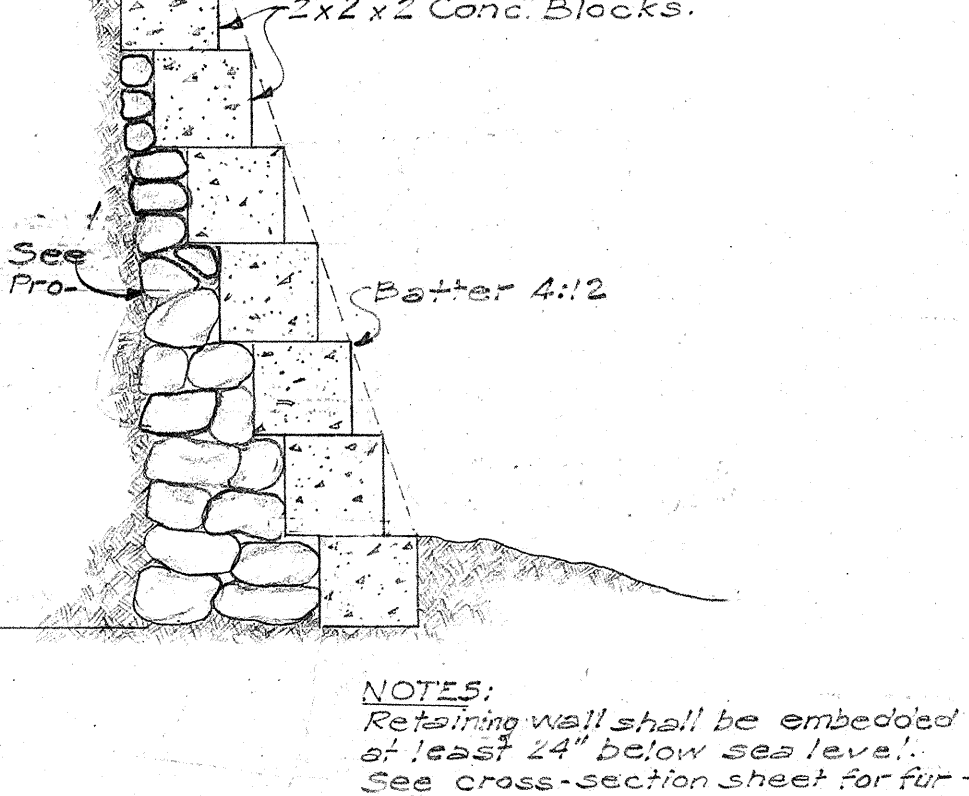
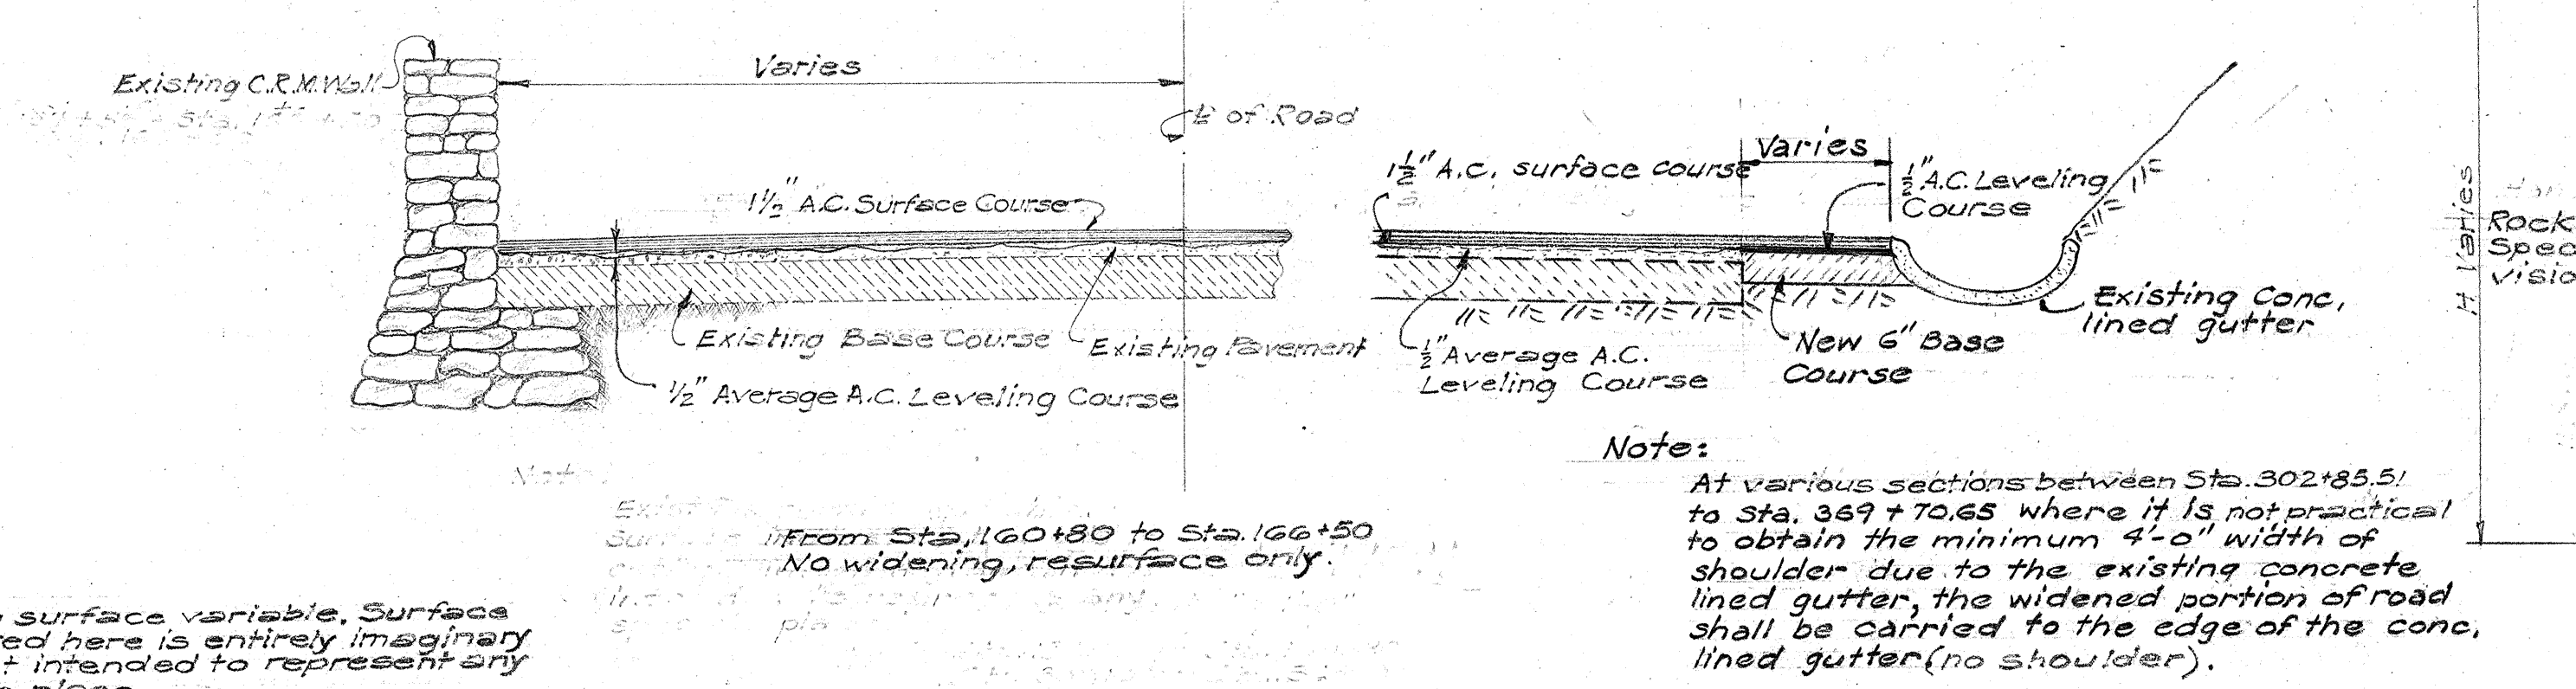
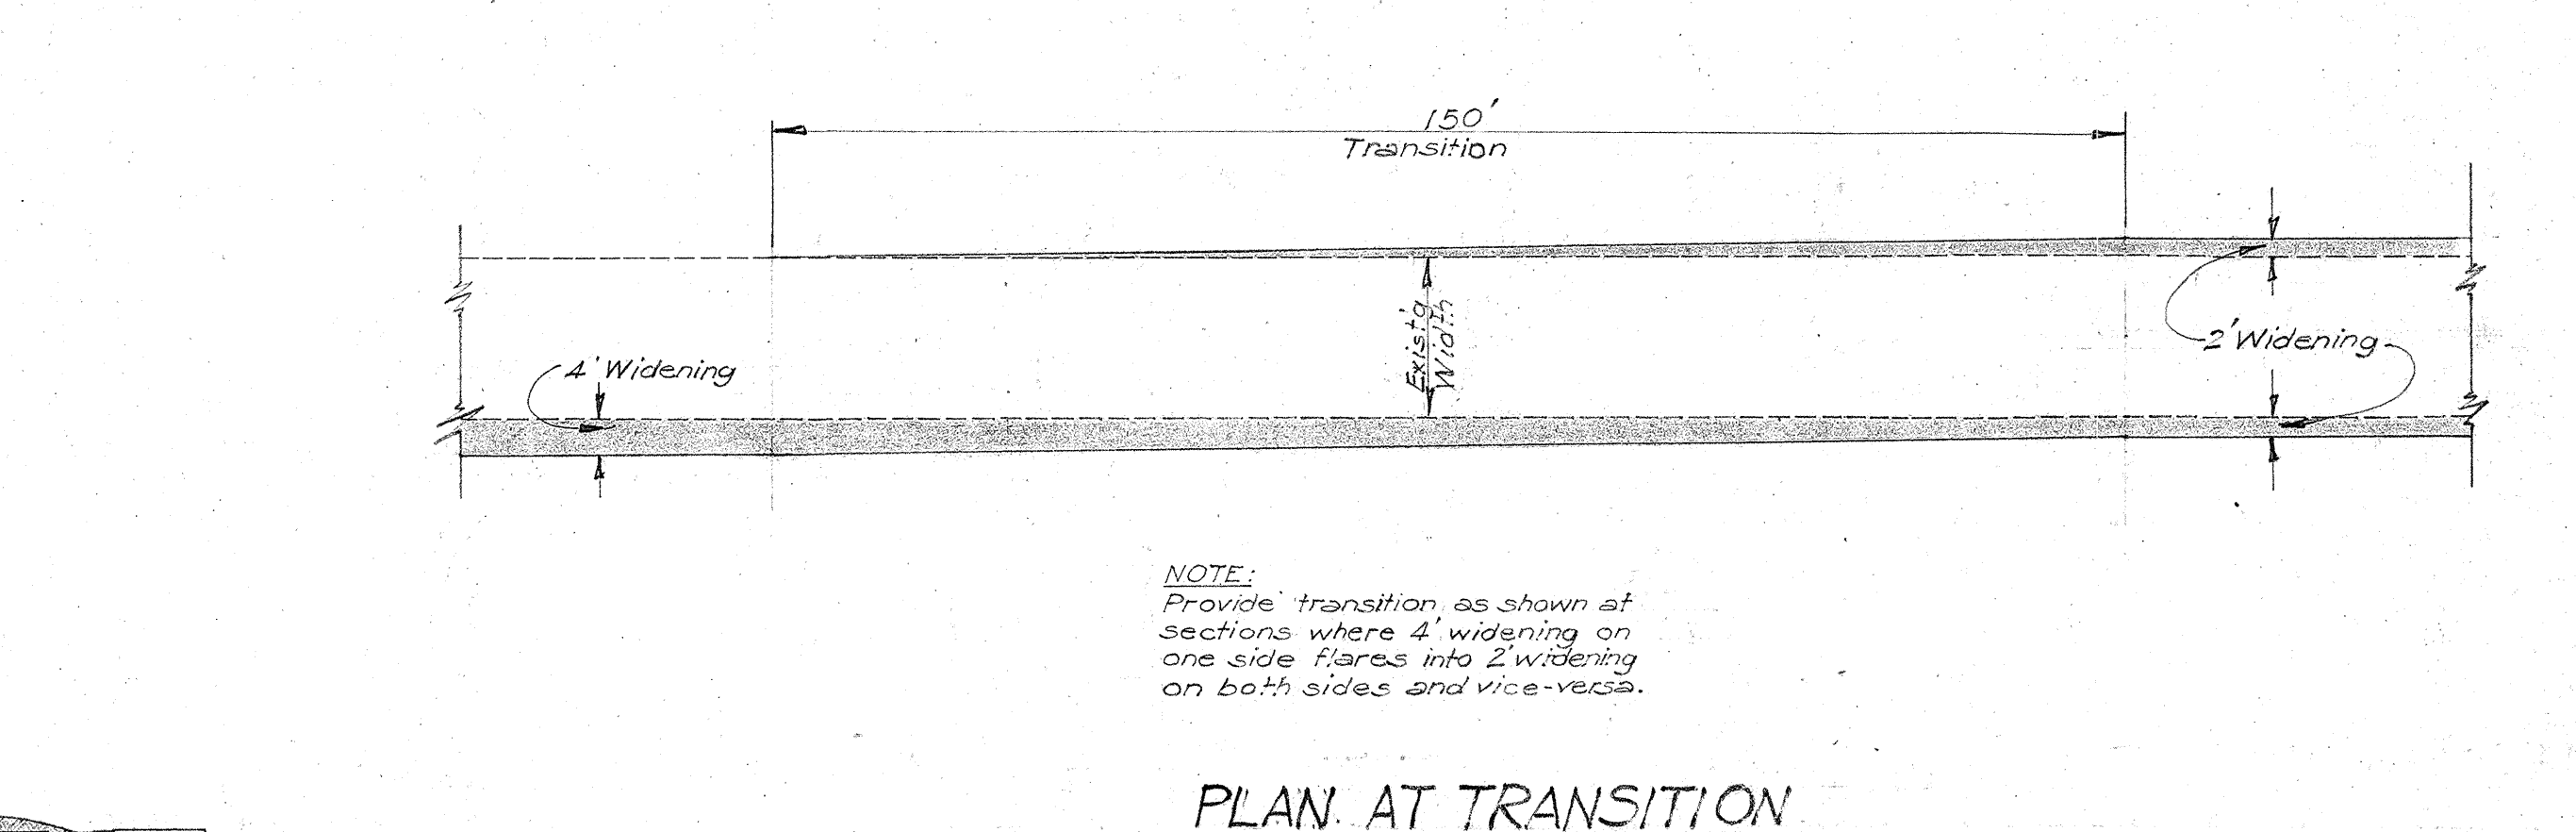
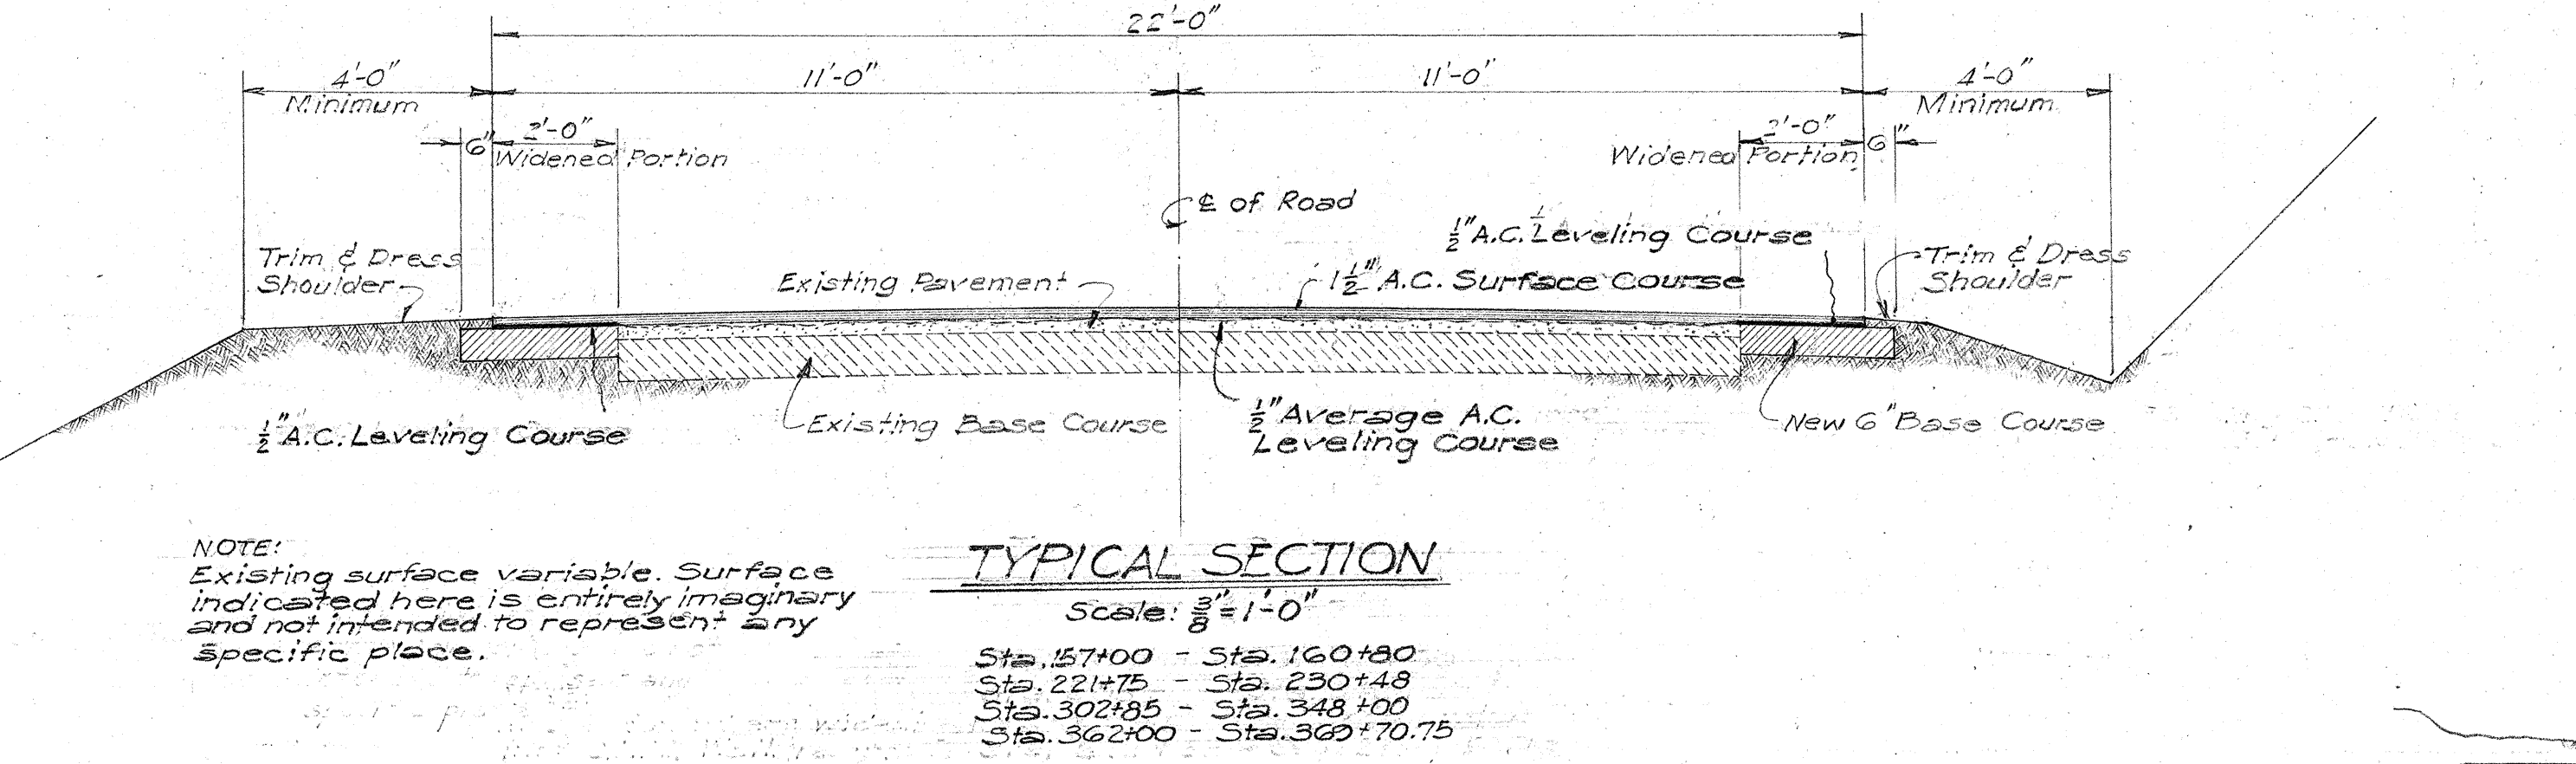
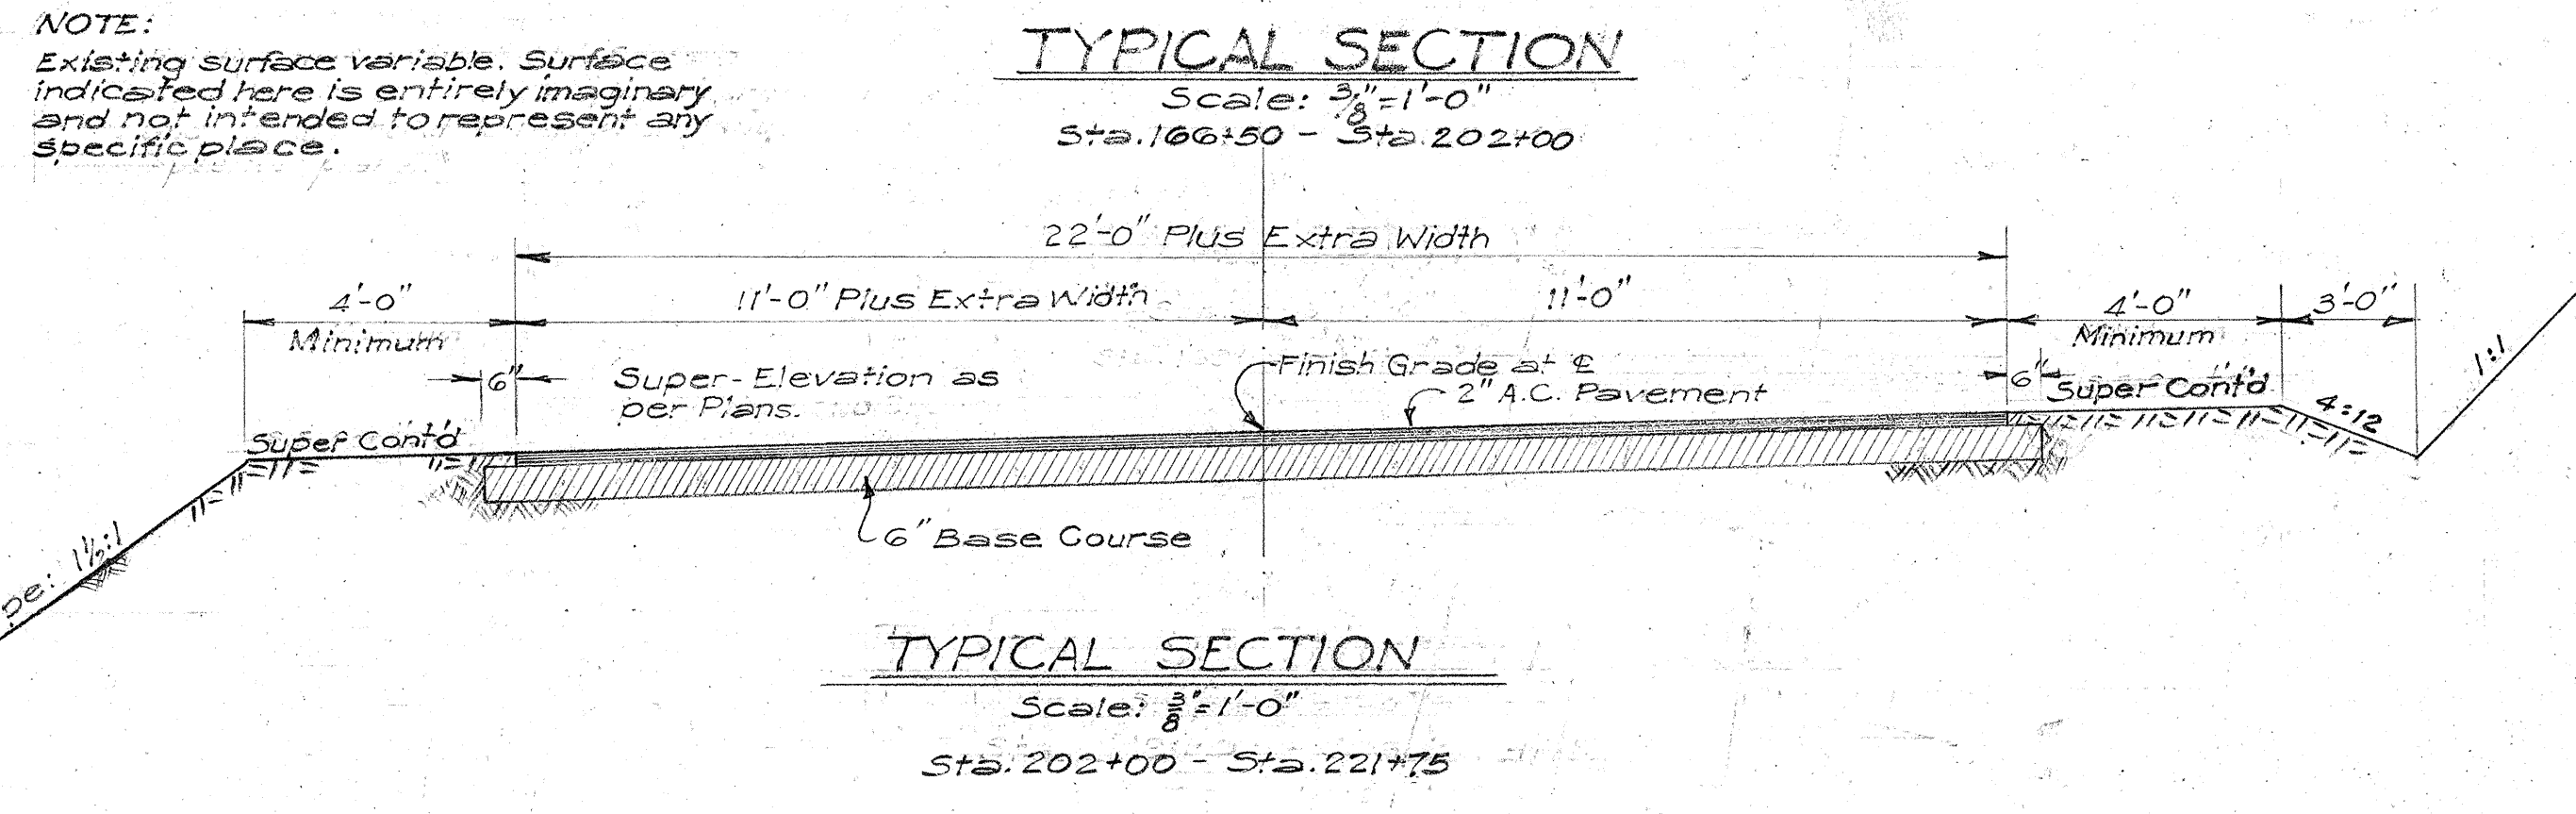
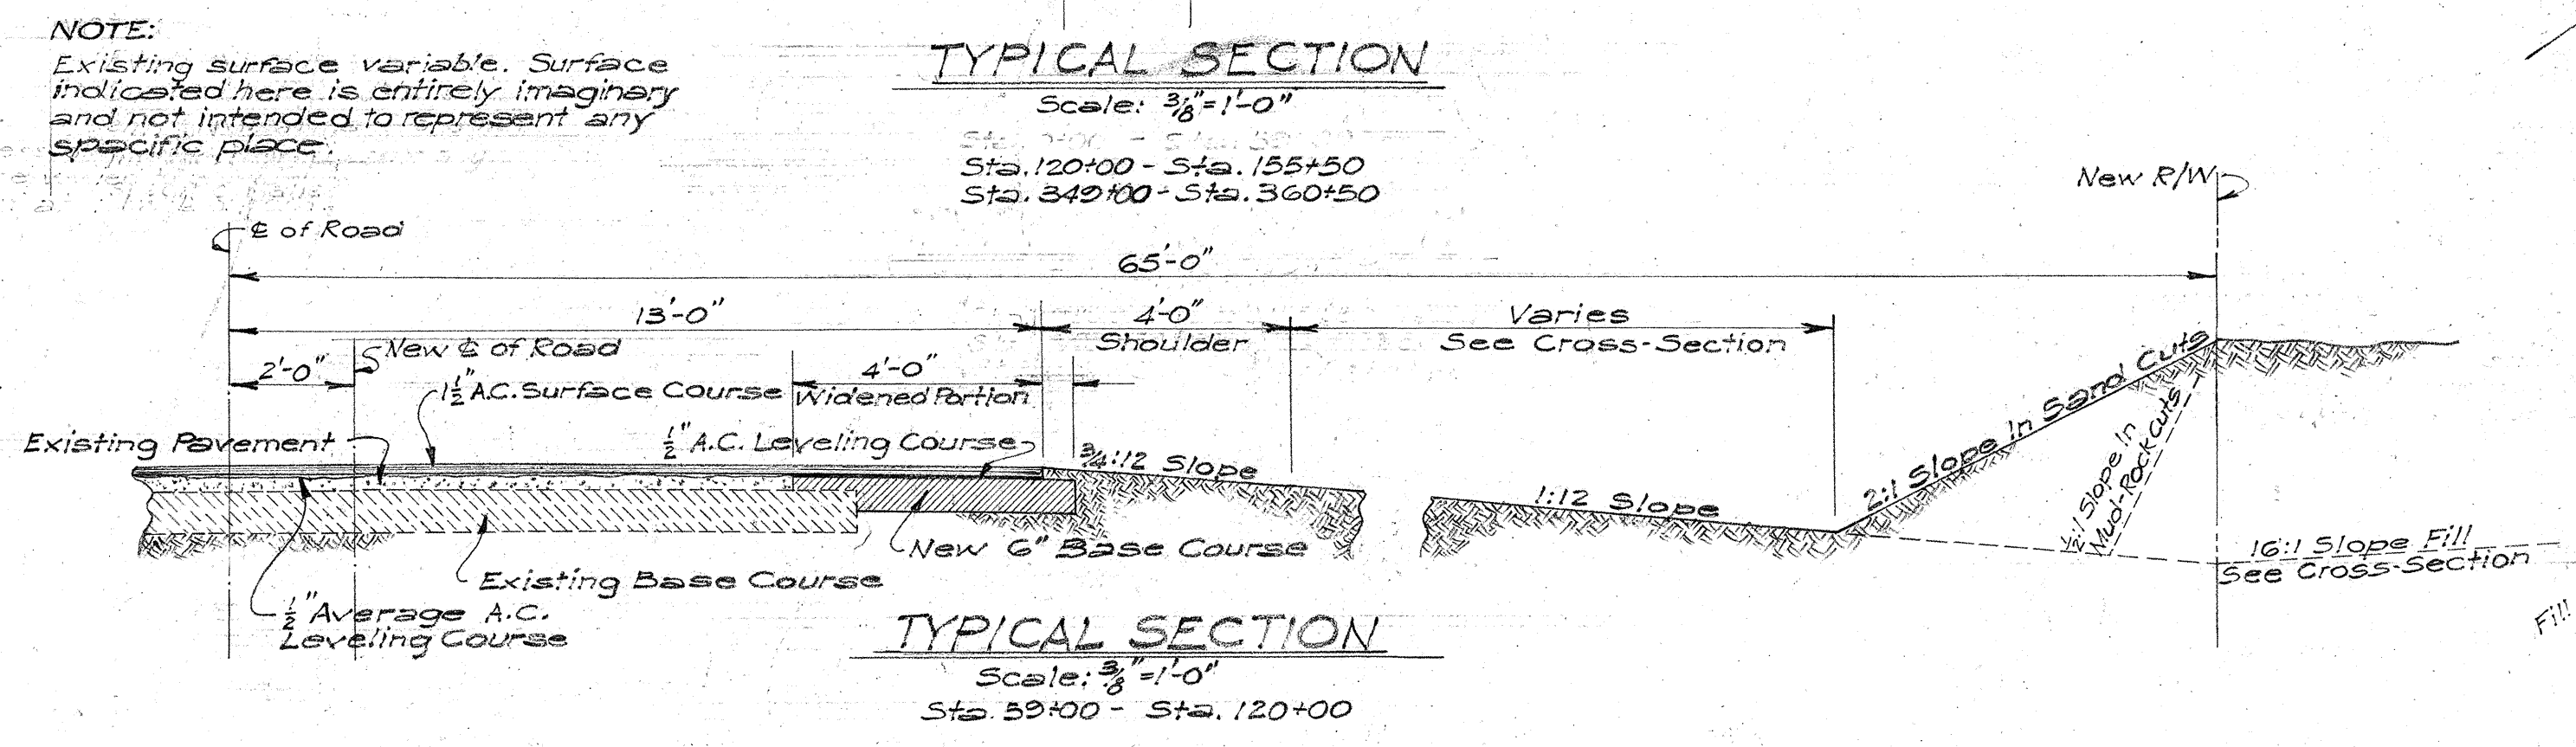
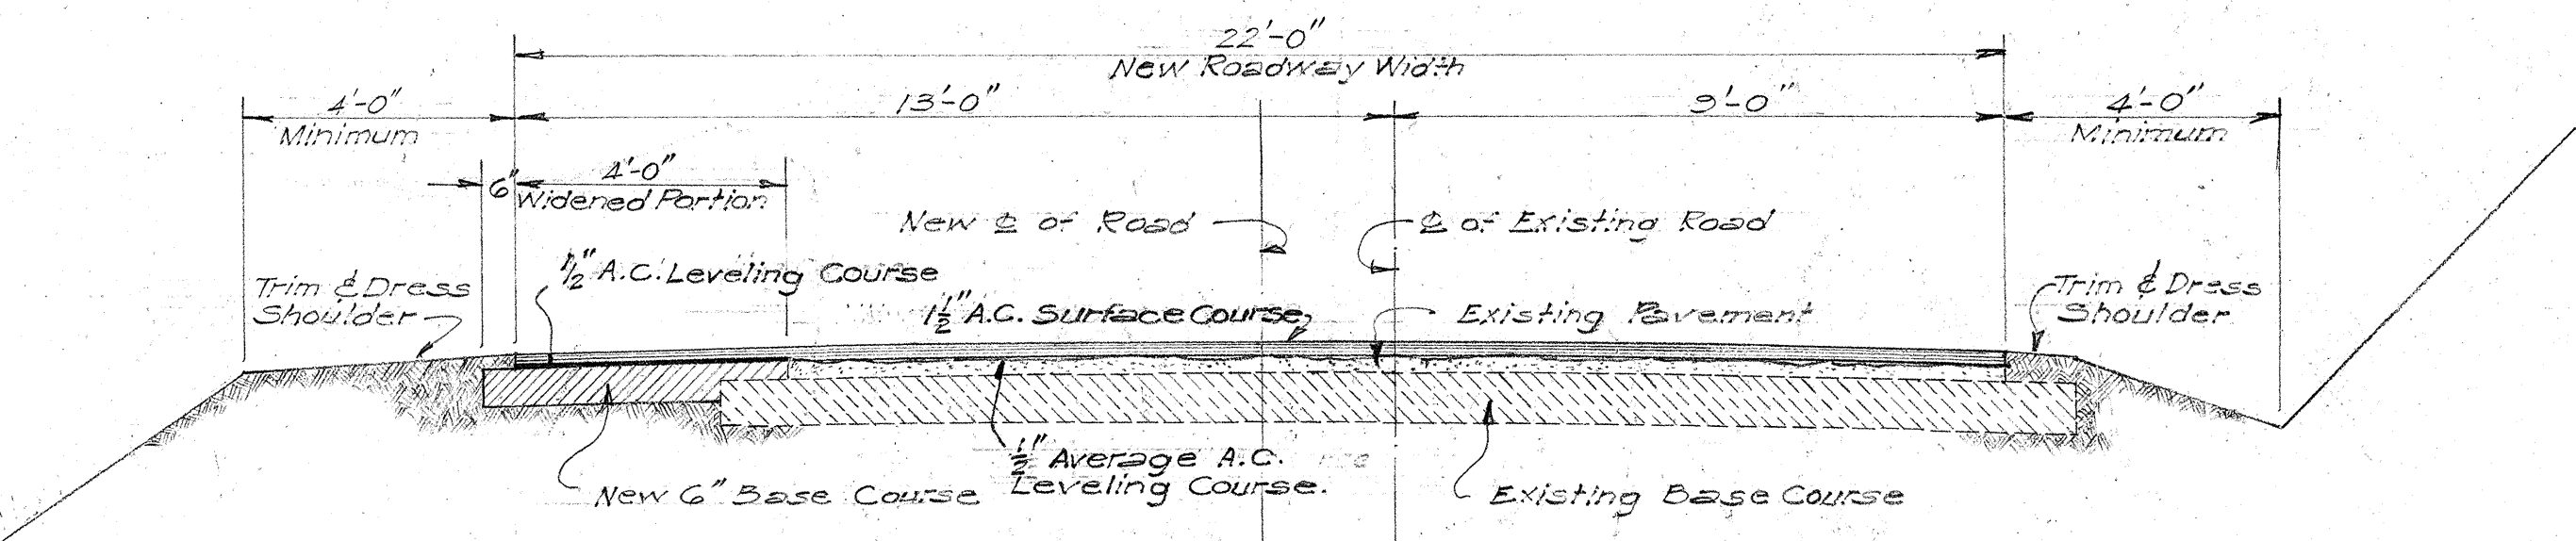
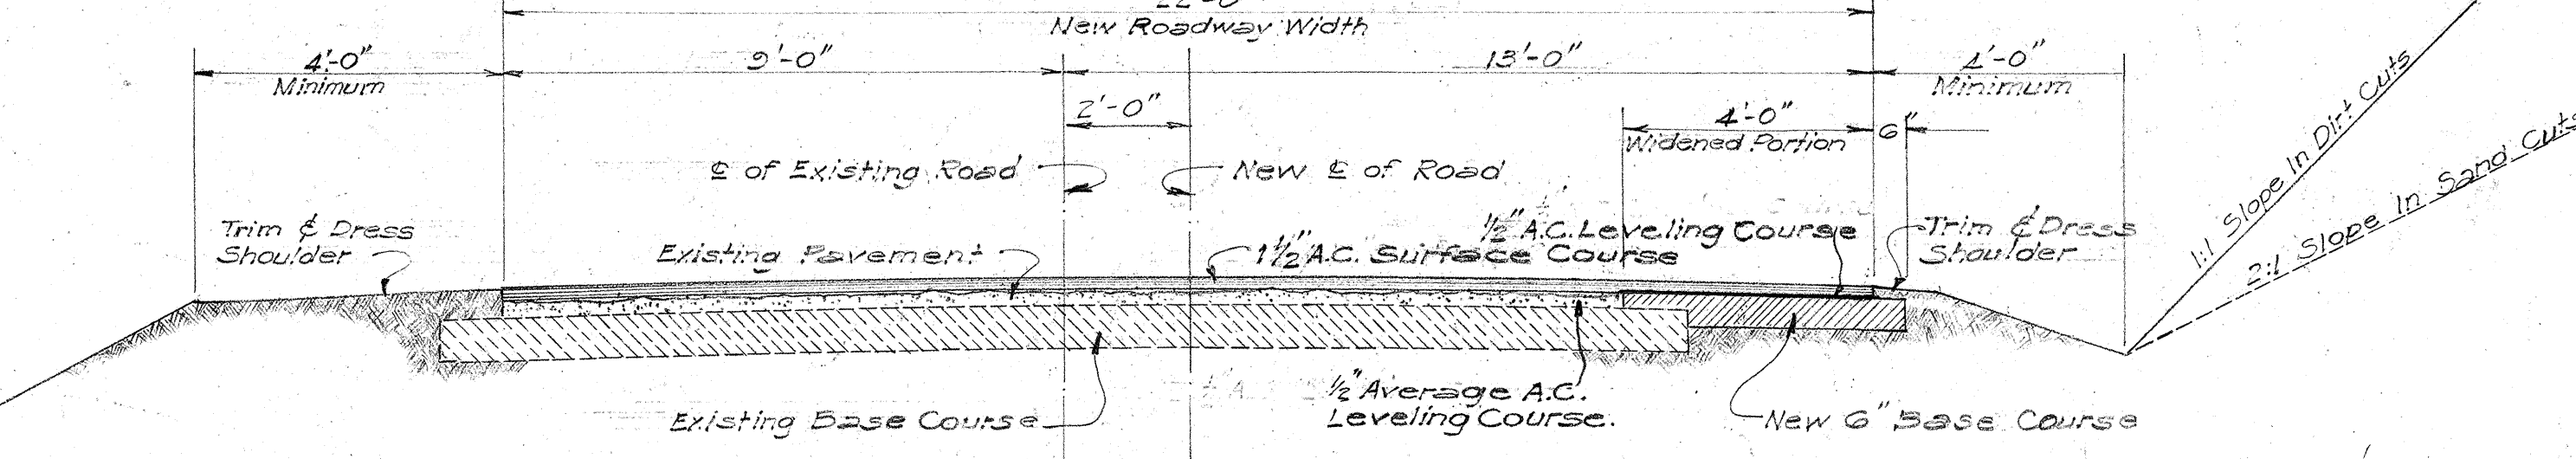


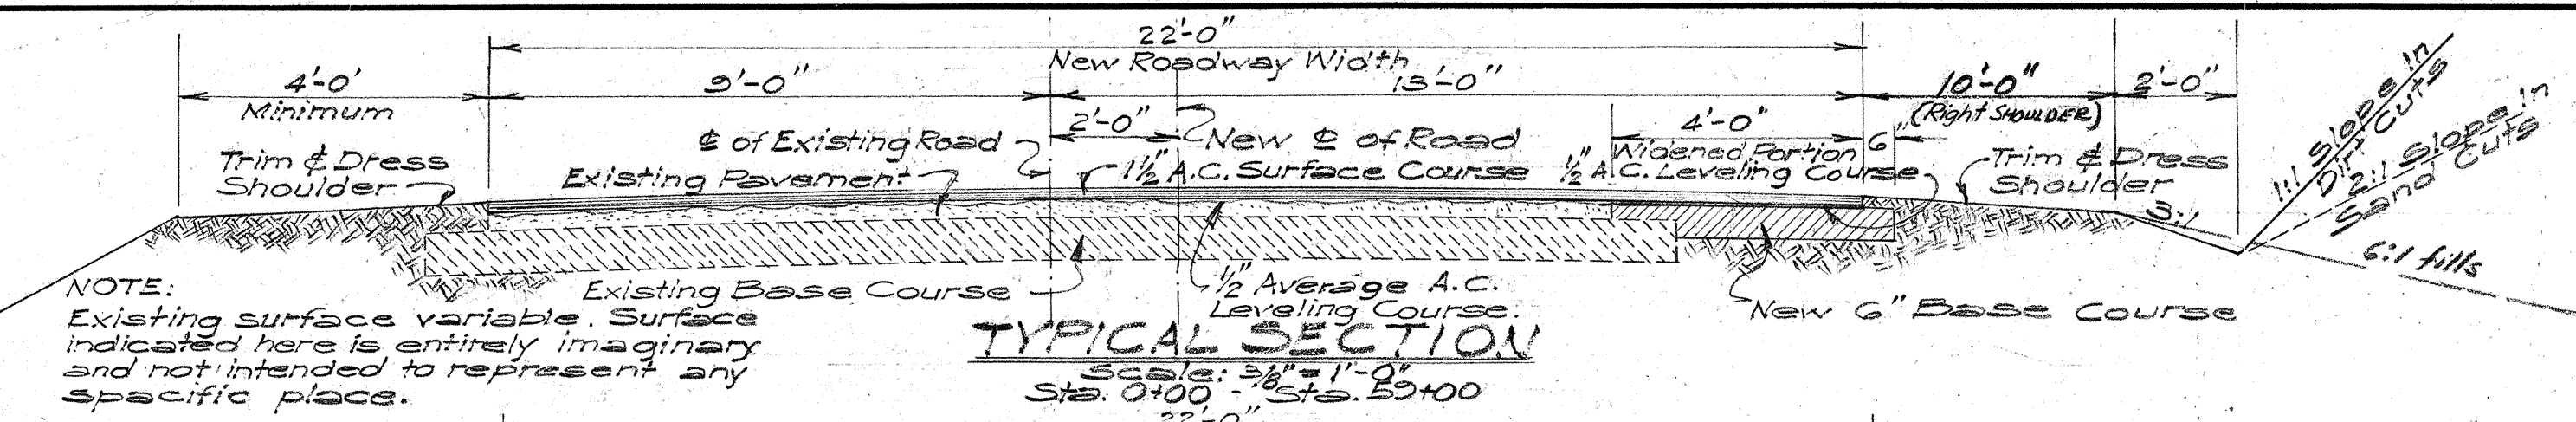

TERRITORIAL HIGHWAY DEPARTMENT
TERRITORY OF HAWAII

TYPICAL SECTION
WIDENING OF
KALANIANA'OLE HIGHWAY
FED. AID PROJ. NO. FG(16)
& WAR DAMAGE REHAB. PROJ. NO. WDR(11)
SCALE AS NOTED FEBRUARY 1949

NOTE: For details of Type 'A' curb see Sheet No. 5340.15.

DATE: _____
DESIGNED BY: _____
CHECKED BY: _____
NOTED BY: _____
ORIGINAL PLAN NO. _____
NOTE BOOK NO. _____