
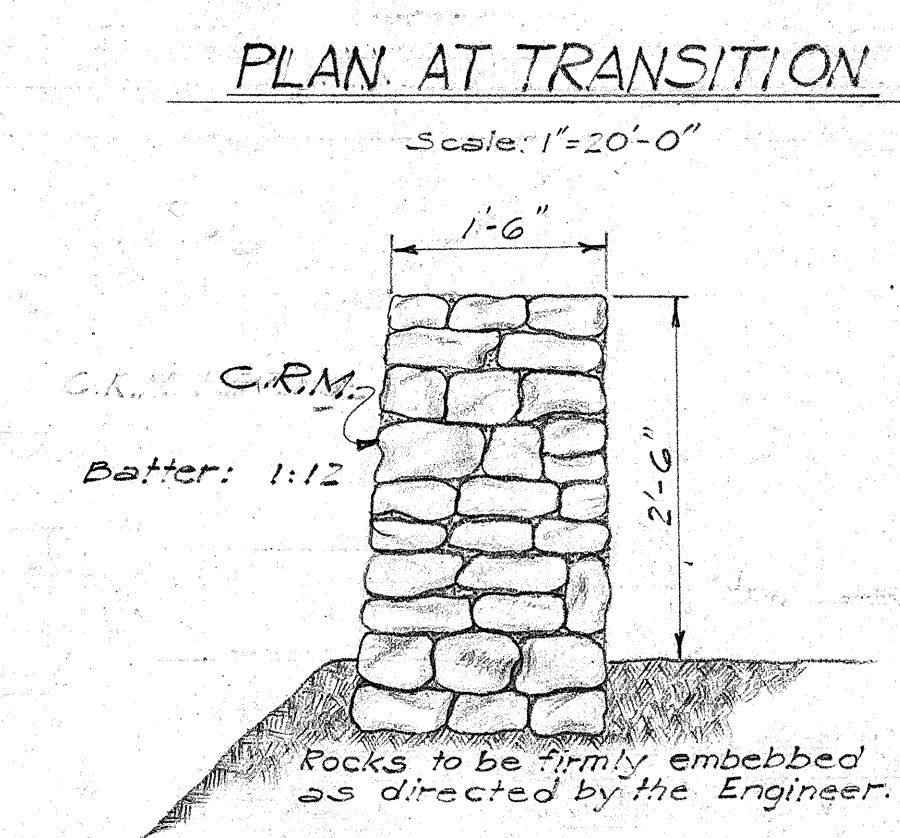
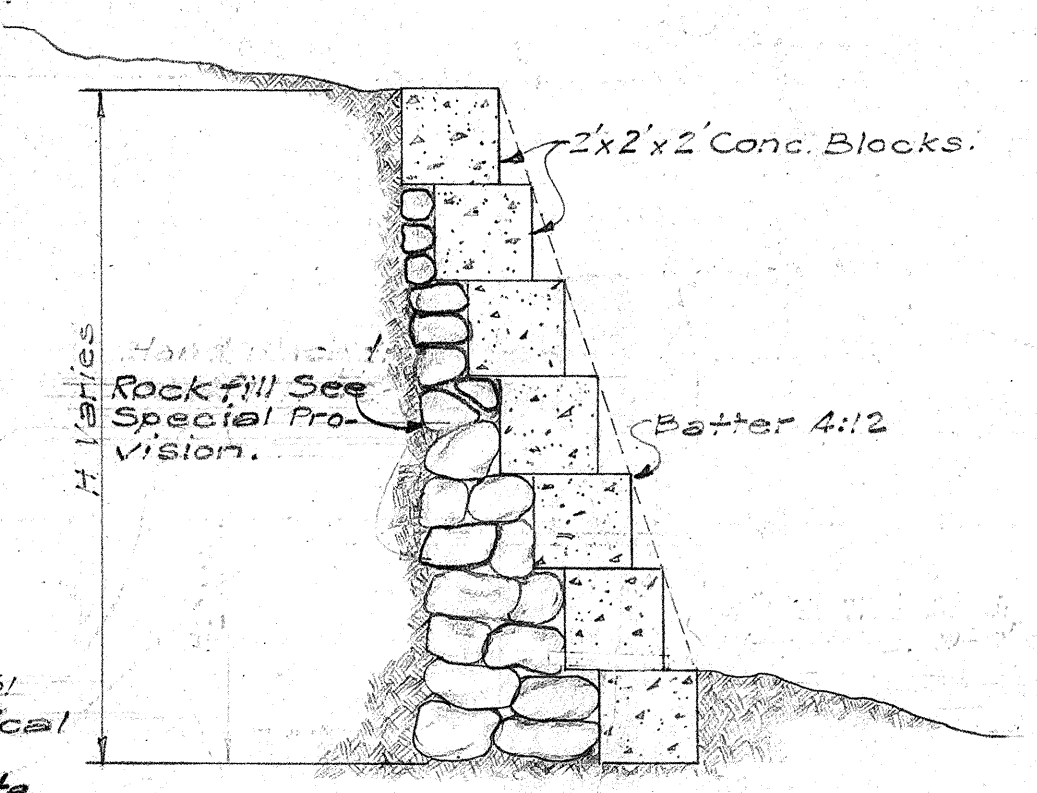
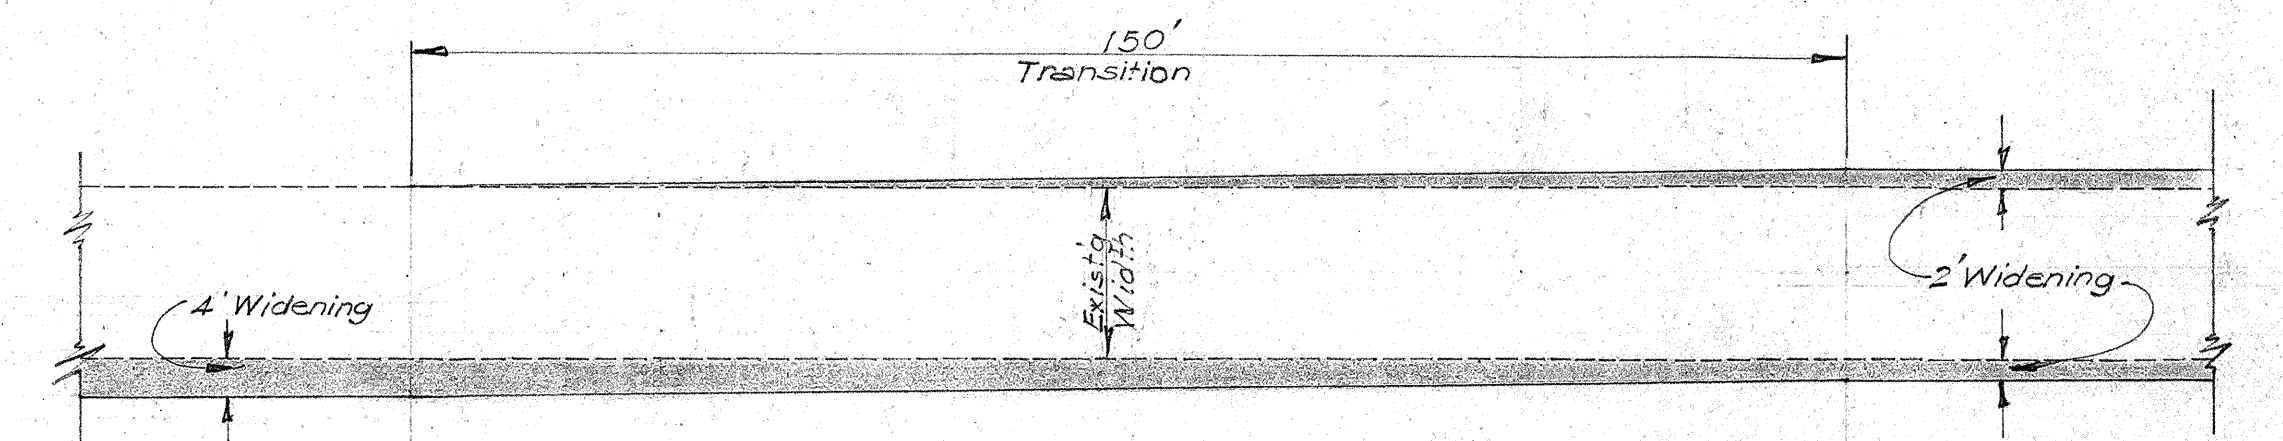
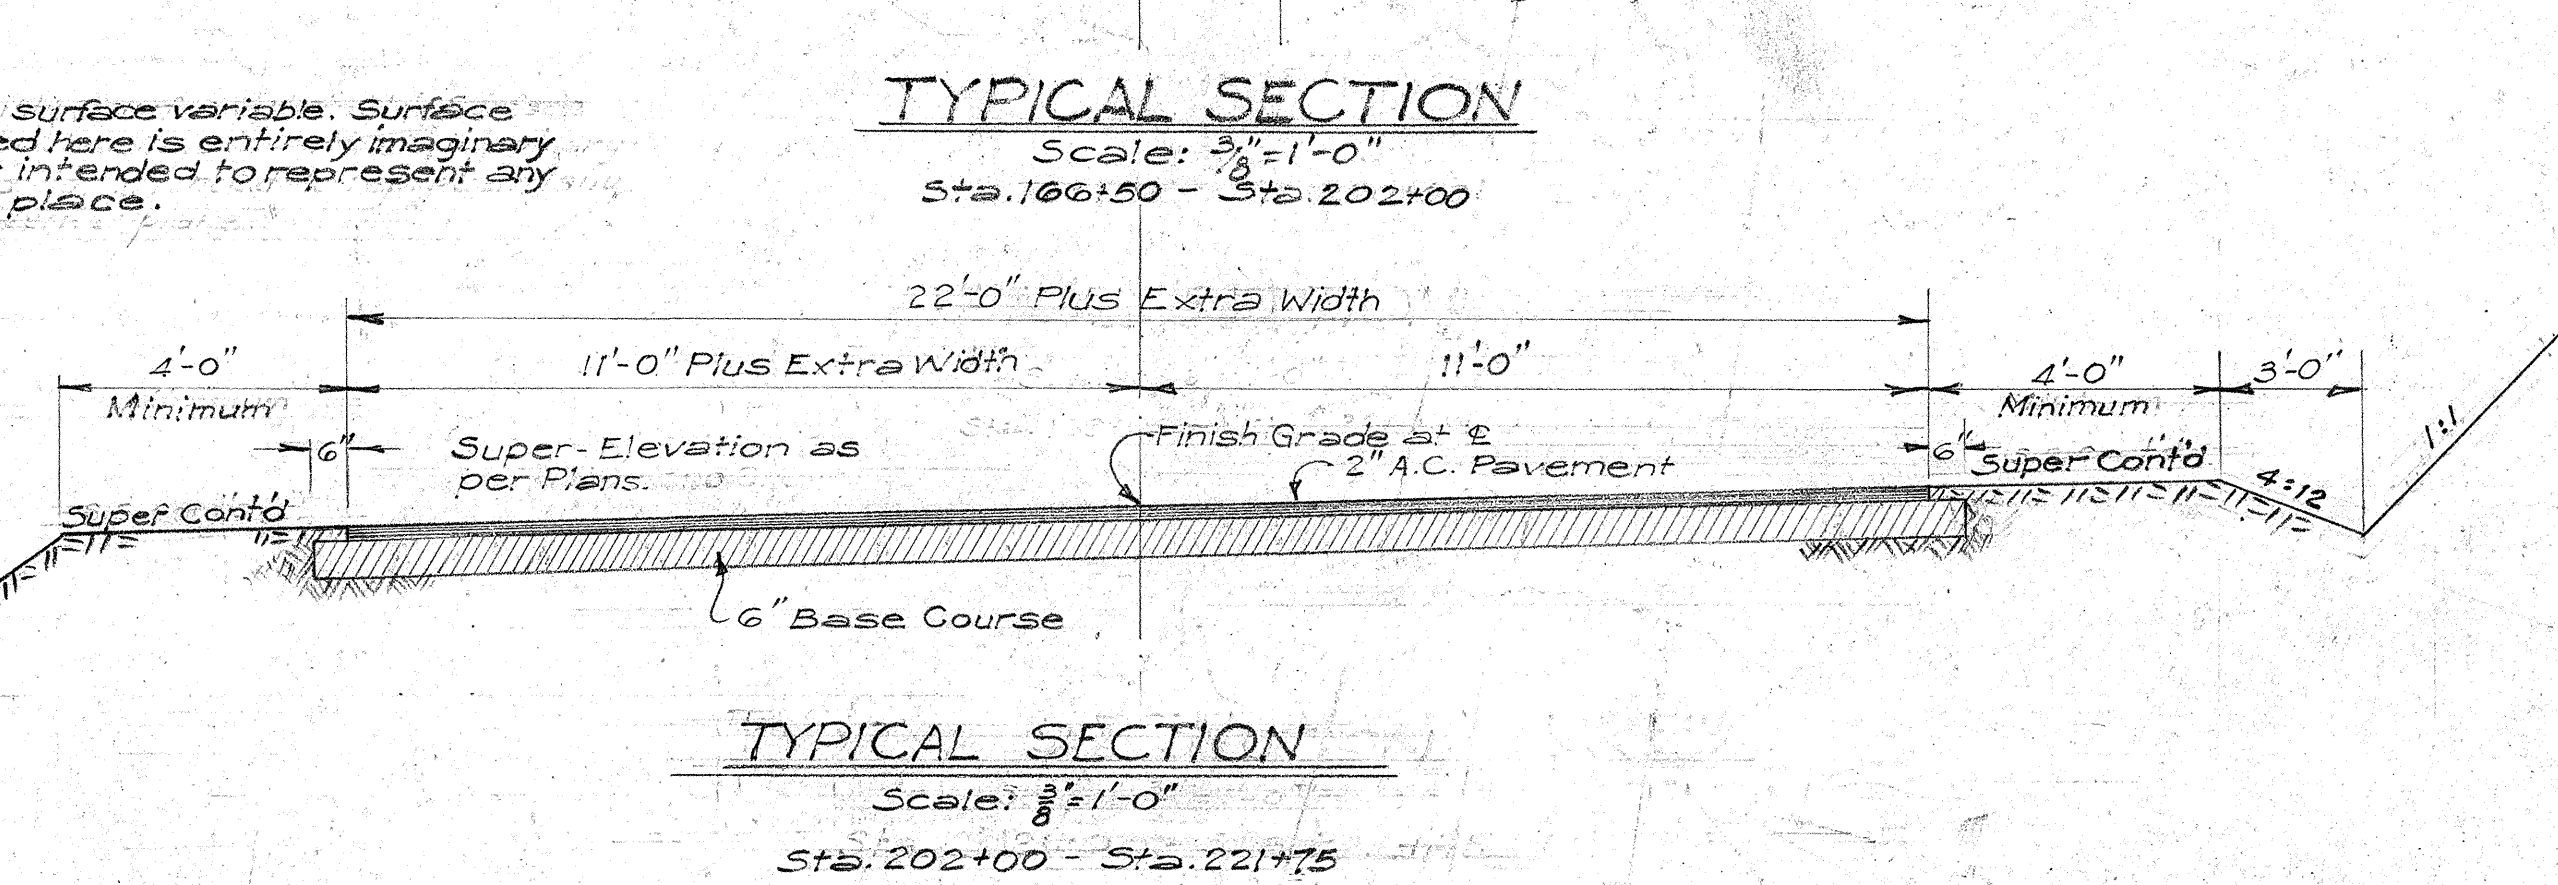
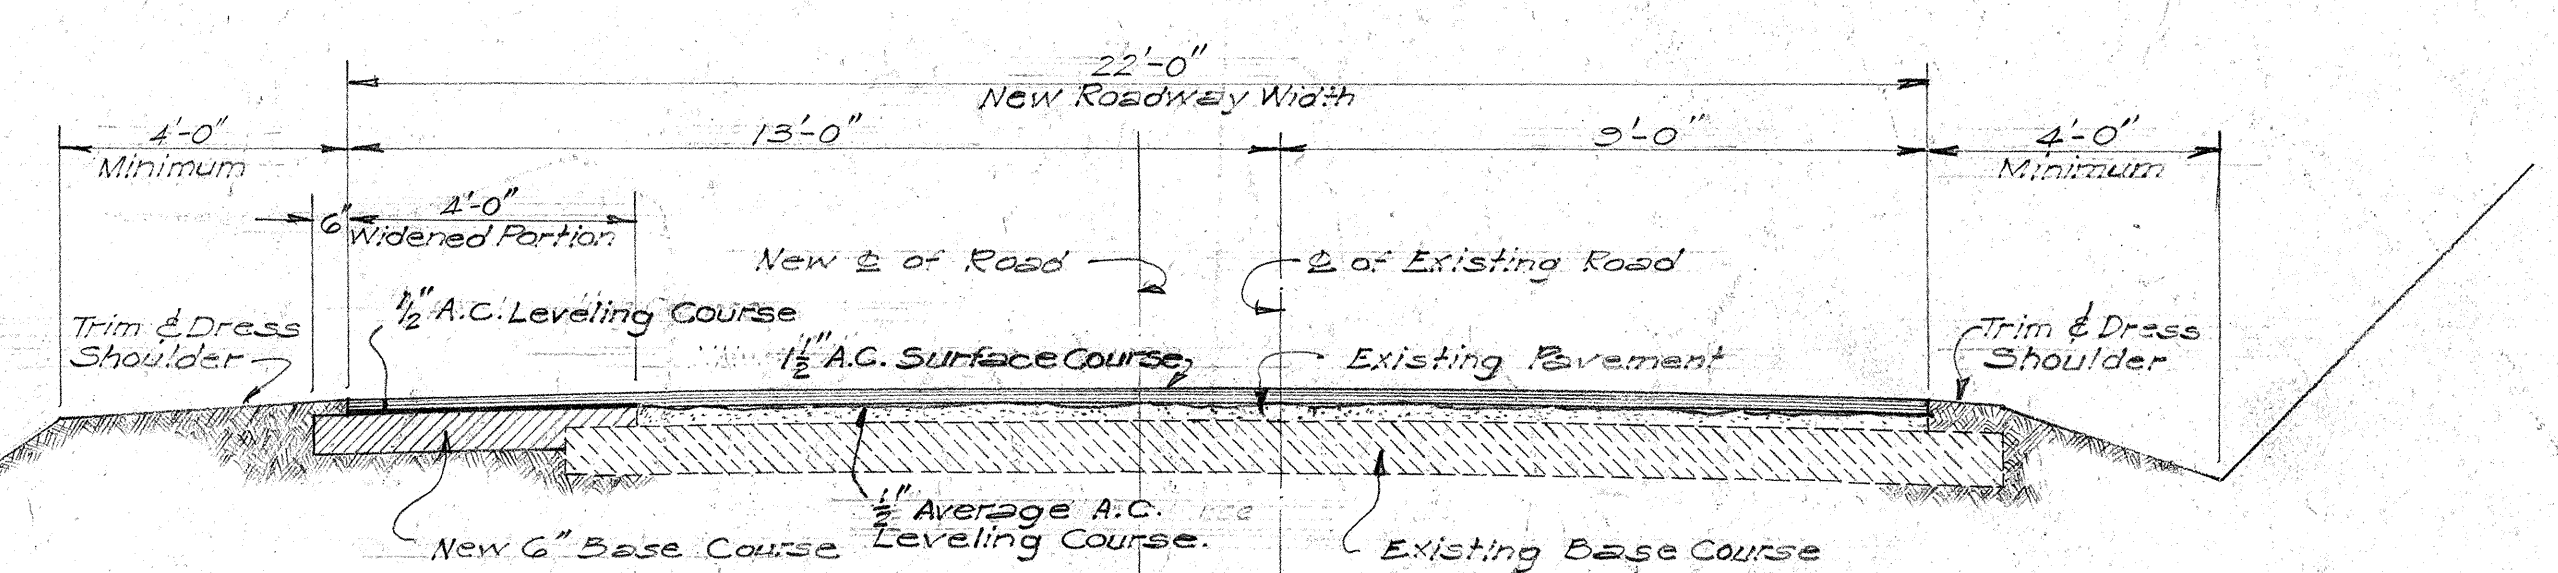
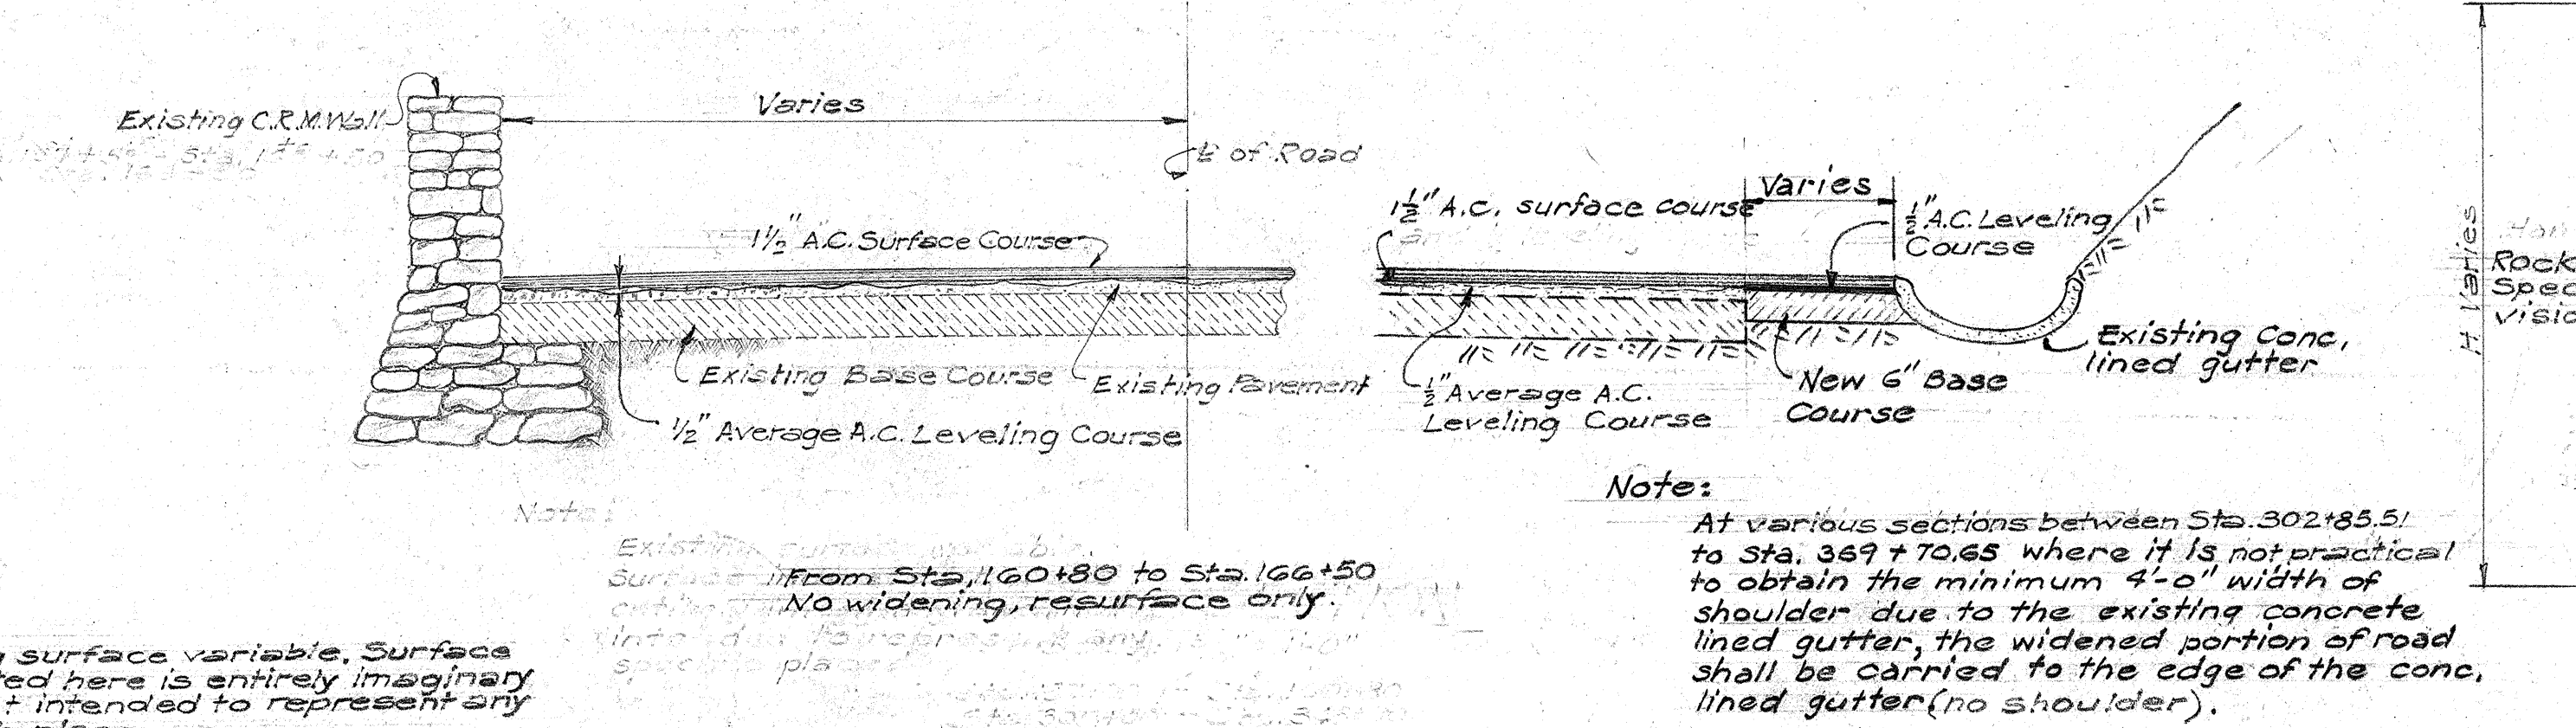
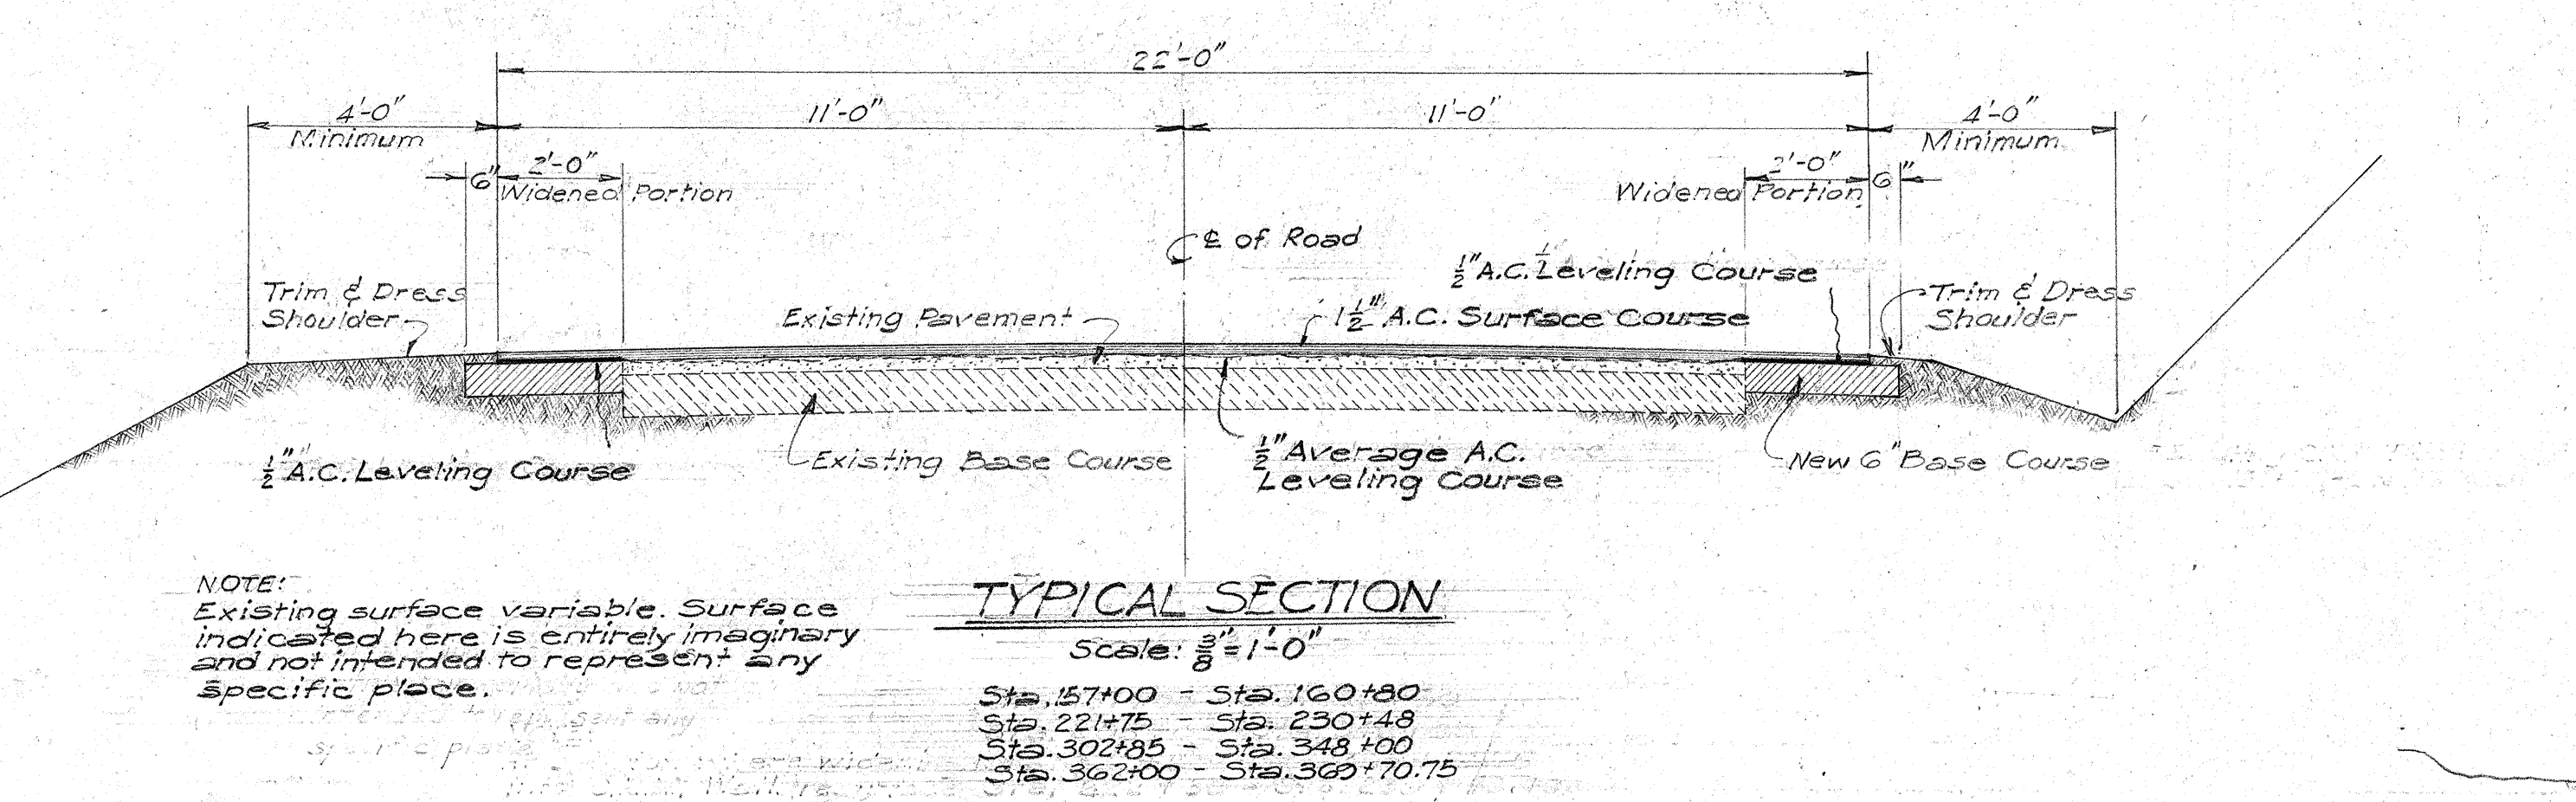
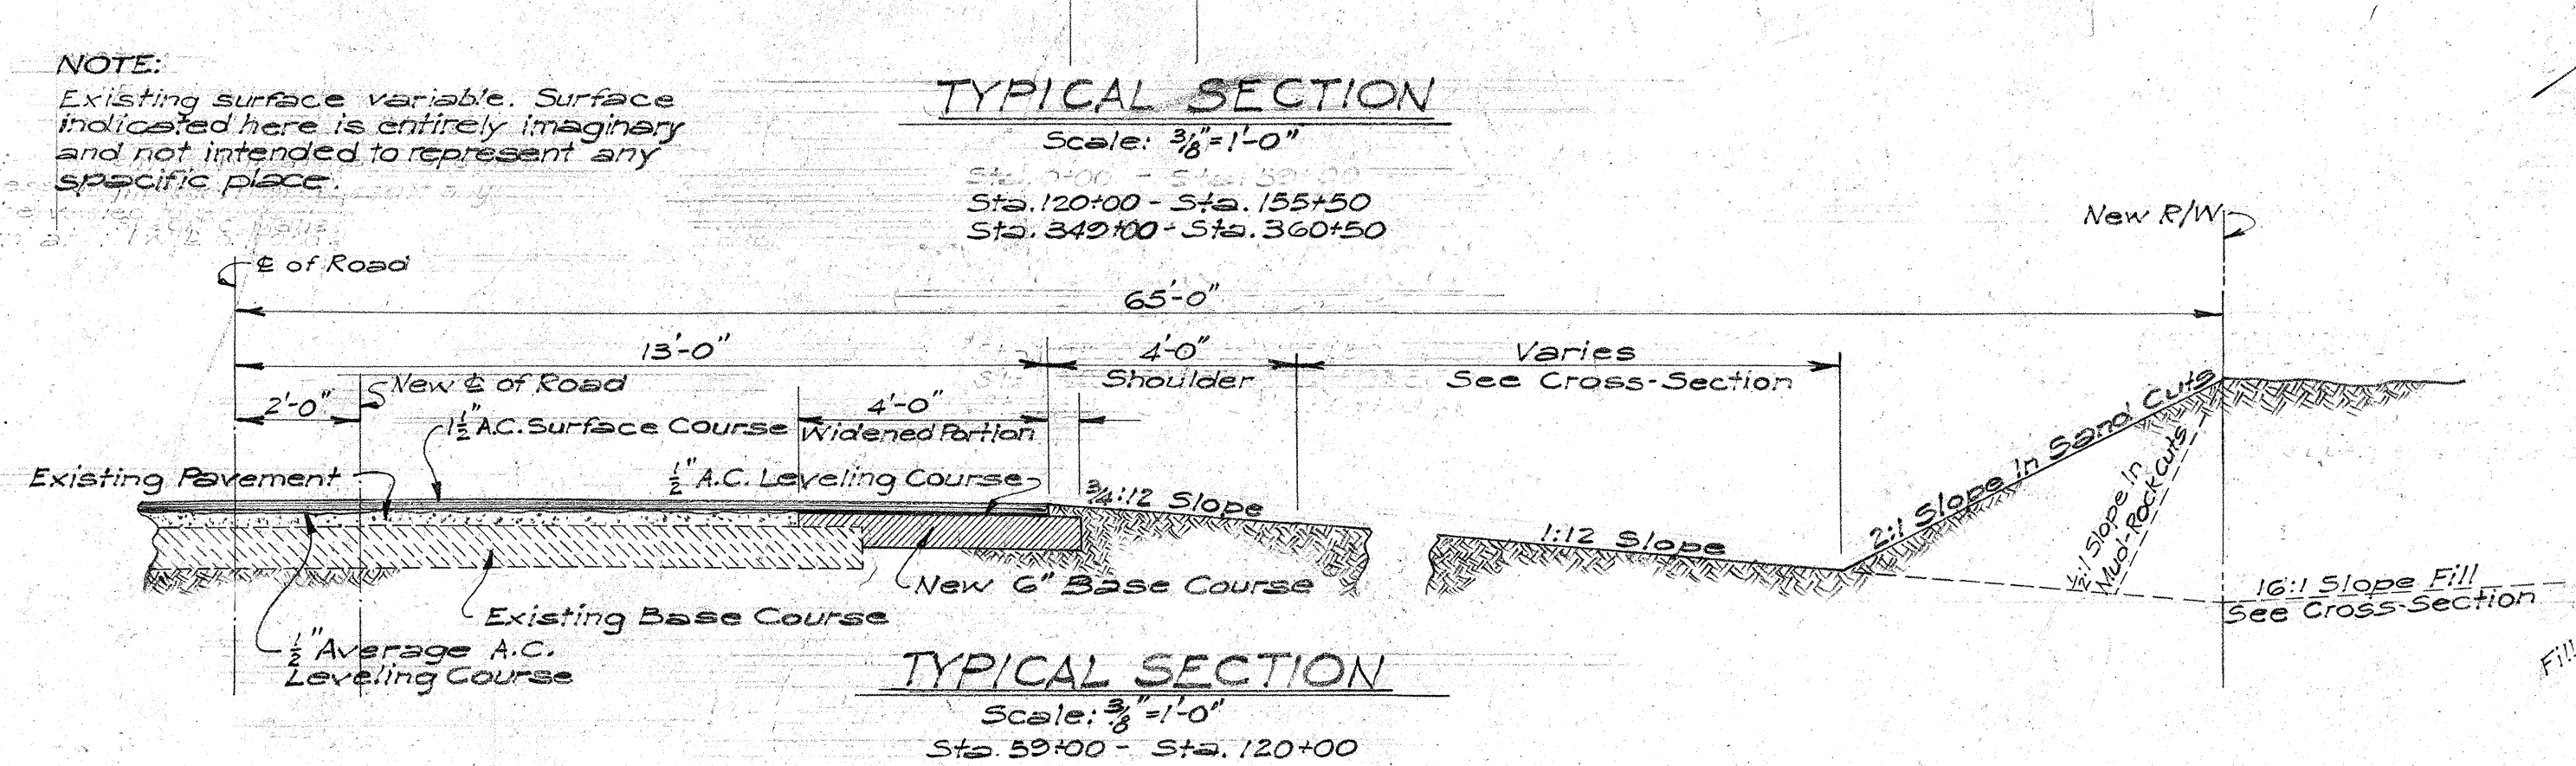
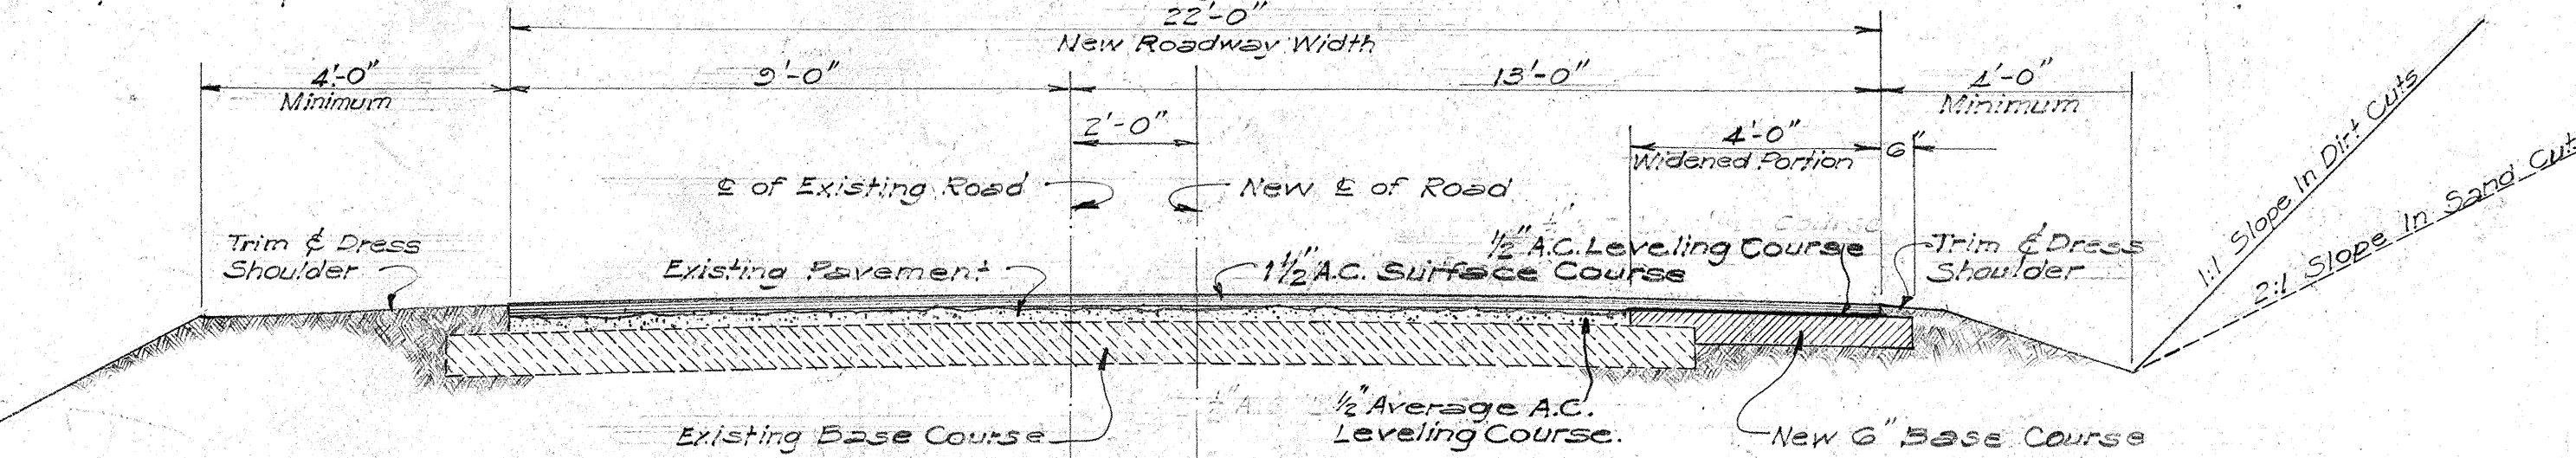


FED. ROAD DIST. NO.	STATE	FED. AID PROJ. NO.	FISCAL YEAR	SHEET NO.	SHEETS	FED. ROAD DIST. NO.	STATE	FED. AID PROJ. NO.	FISCAL YEAR	SHEET NO.	TOTAL SHEETS
HAWAII	HAW.	WDR 10	1949	2	12	HAWAII	HAW.	FG (16)	1949	2	31

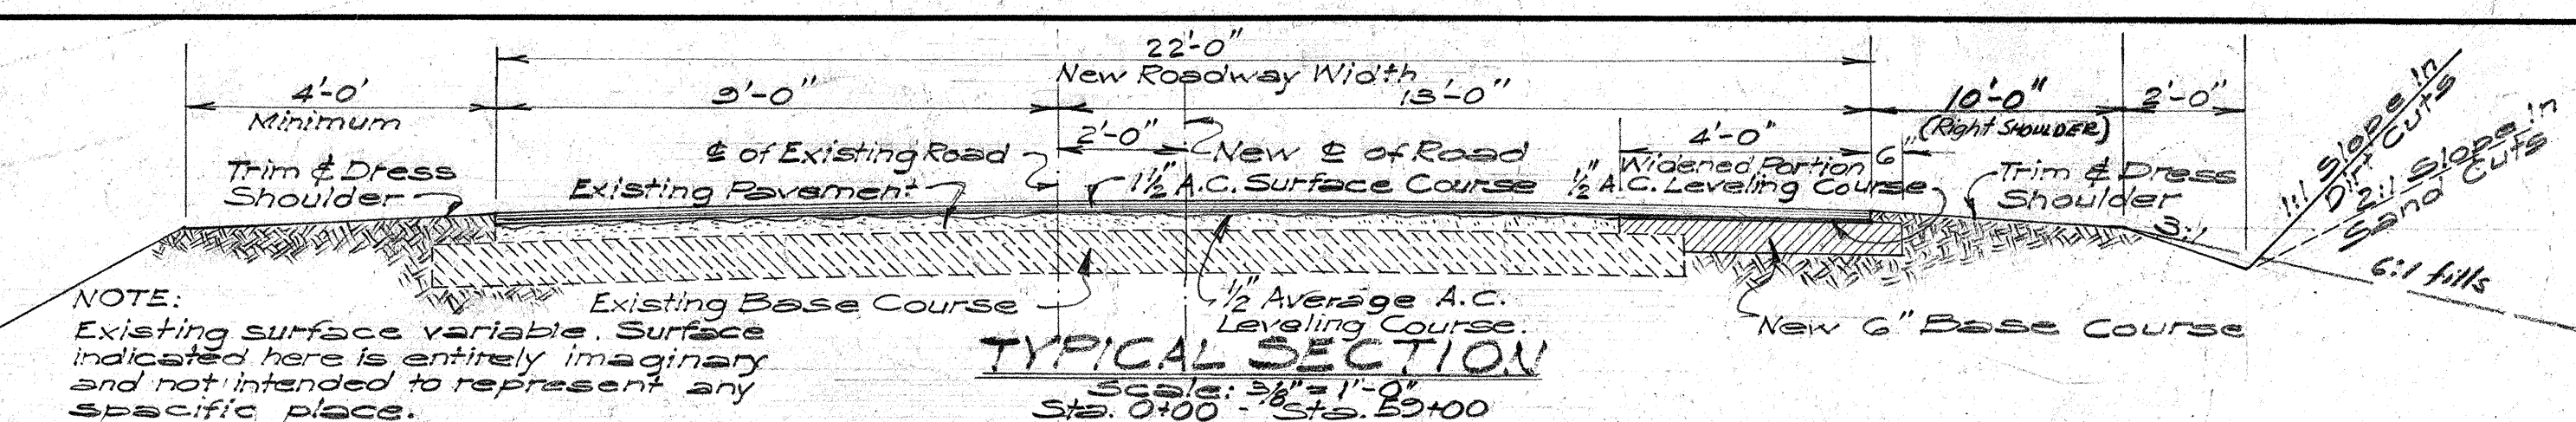

Note: For details of Type "A" curb see Sheet No 5340.15.

TERRITORIAL HIGHWAY DEPARTMENT
TERRITORY OF HAWAII
TYPICAL SECTION
WIDENING OF
KALANIANA'OLE HIGHWAY
FED. AID PROJ. NO. FG(16)
& WAR DAMAGE REHAB. PROJ. NO. WDR(11)
SCALE AS NOTED FEBRUARY 1949

SHEET No. OF SHEETS

5340.2 5341.2

May 17, 1949

DATE
DESIGNED BY
CHECKED BY
NOTED BY
ORIGINAL PLAN
NOTE BOOK
No.