

FED. ROAD DIST. NO.	STATE	FED. AID PROJ. NO.	FISCAL YEAR	SHEET NO.	TOTAL SHEETS


Field Books 816, 817, 818, & 819

TERRITORY OF HAWAII
TERRITORIAL HIGHWAY DEPARTMENT
HONOLULU T. H.

PLANS OF

MISCELLANEOUS DRAINAGE STRUCTURES

ON
KALANIANA'OLE HIGHWAY
WAILUPE SECTION
ISLAND OF OAHU
JOB N^o 5434

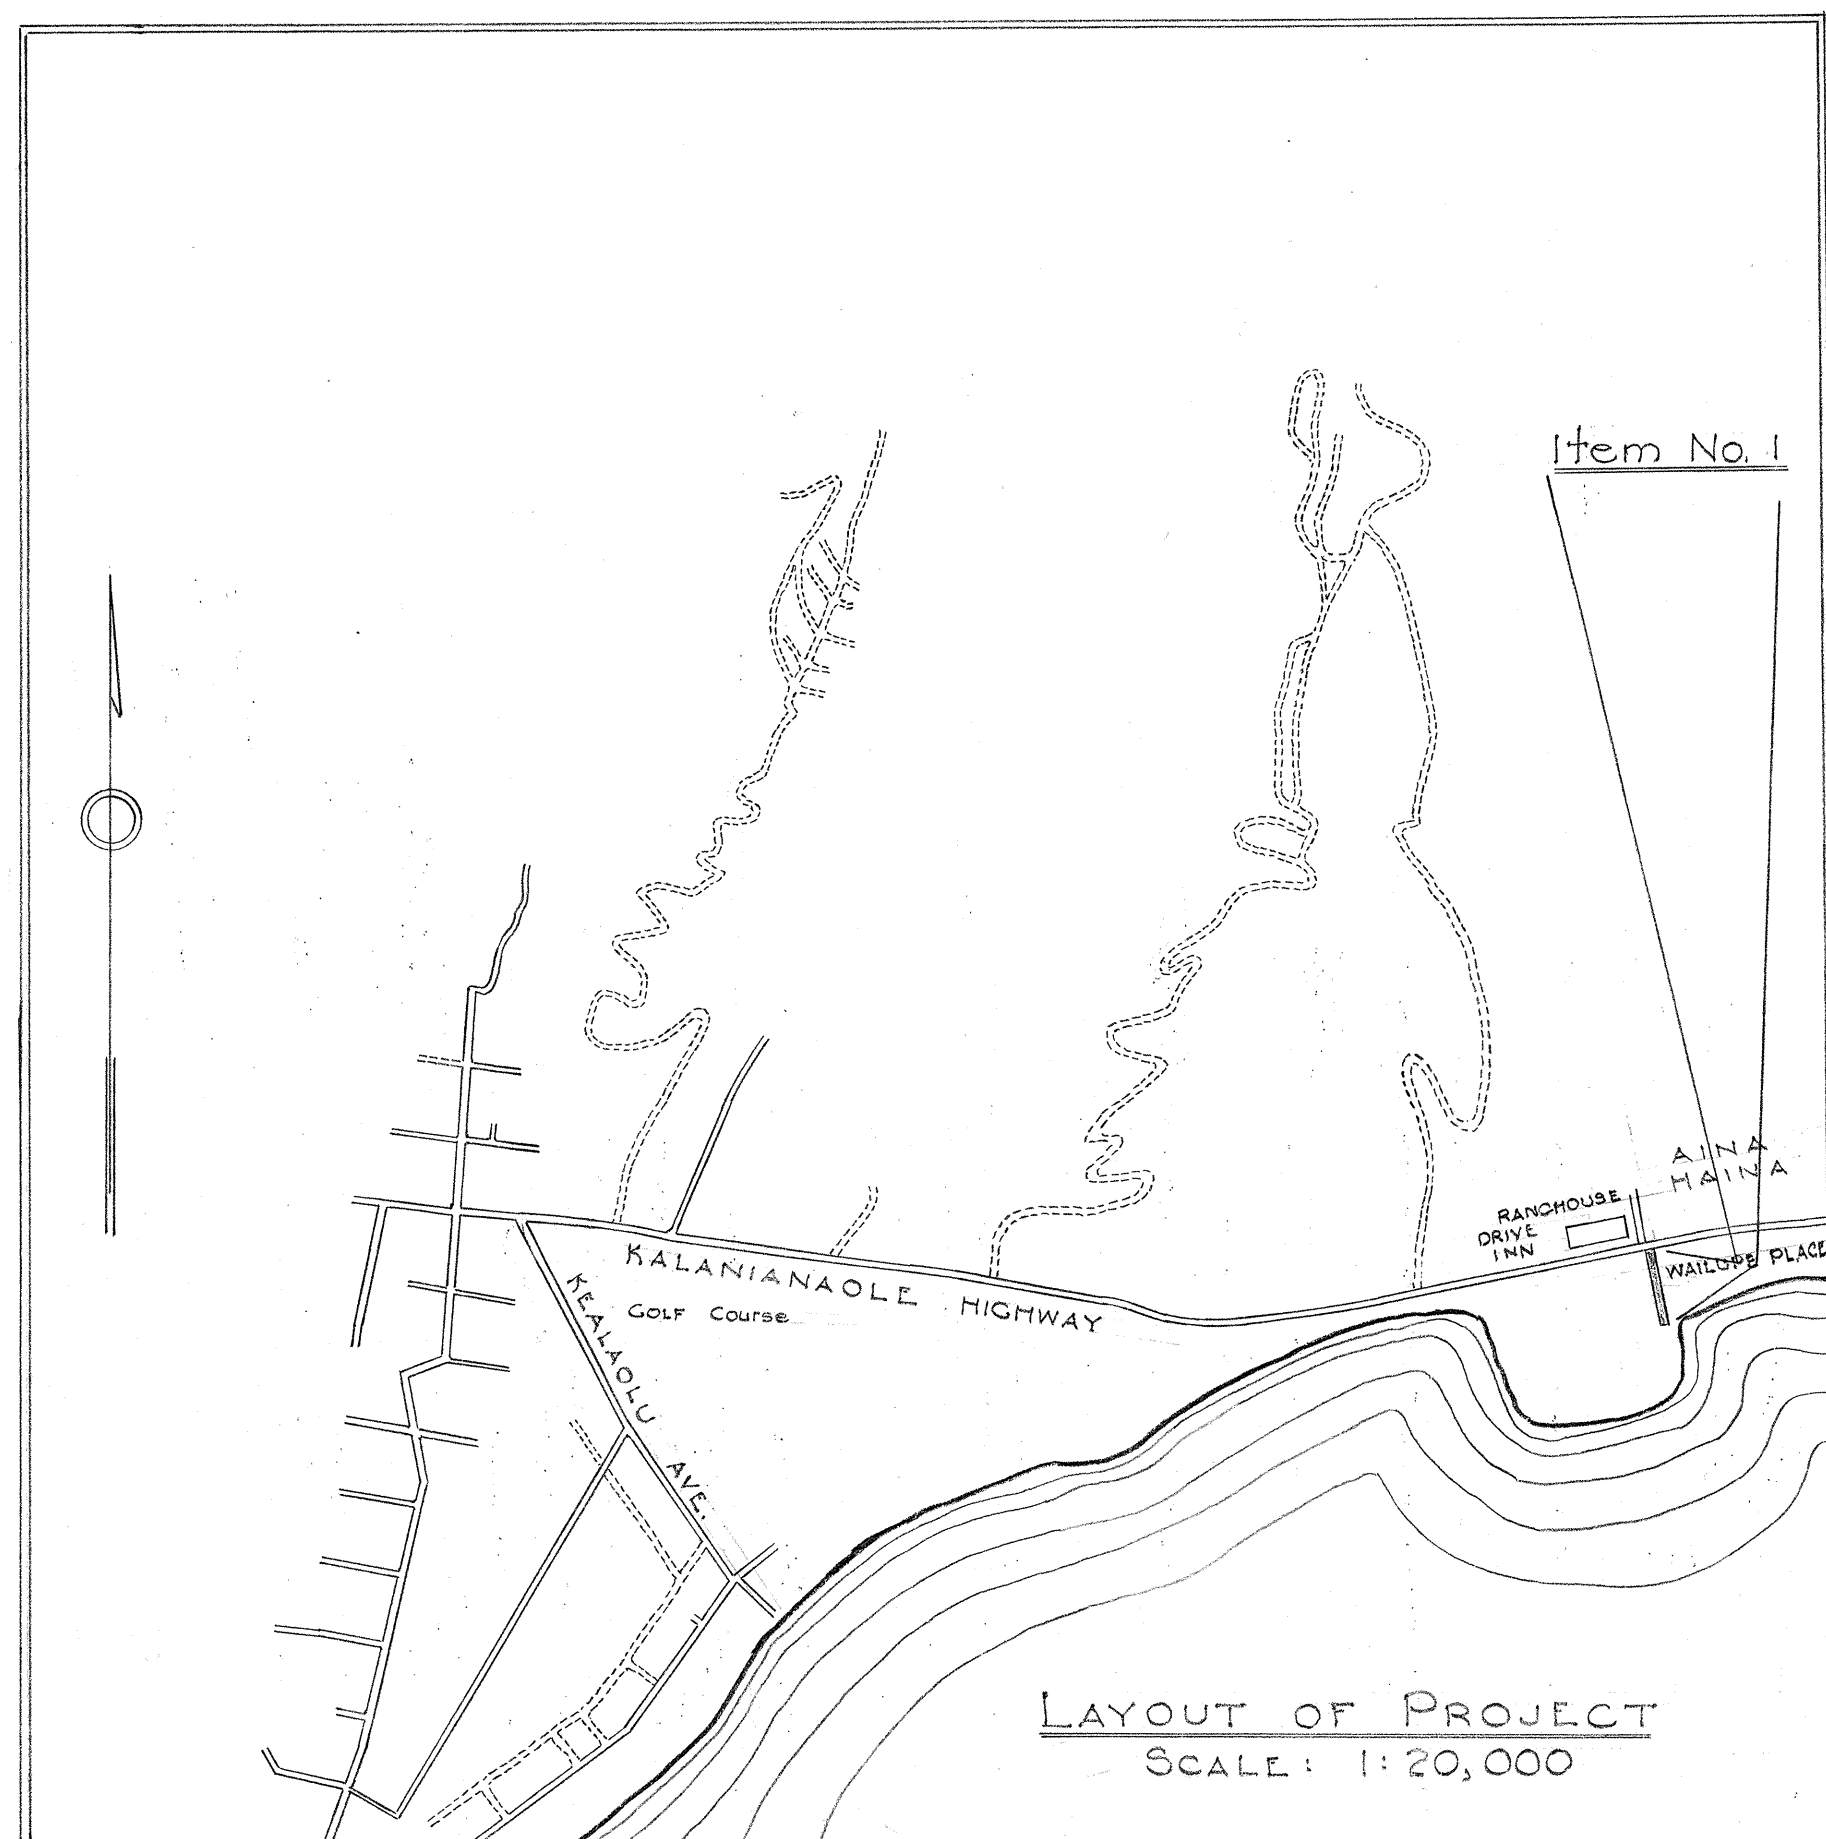

Approved: *[Signature]*
Territorial Highway Engineer
Date: Sept. 21, 1948

5434.1