
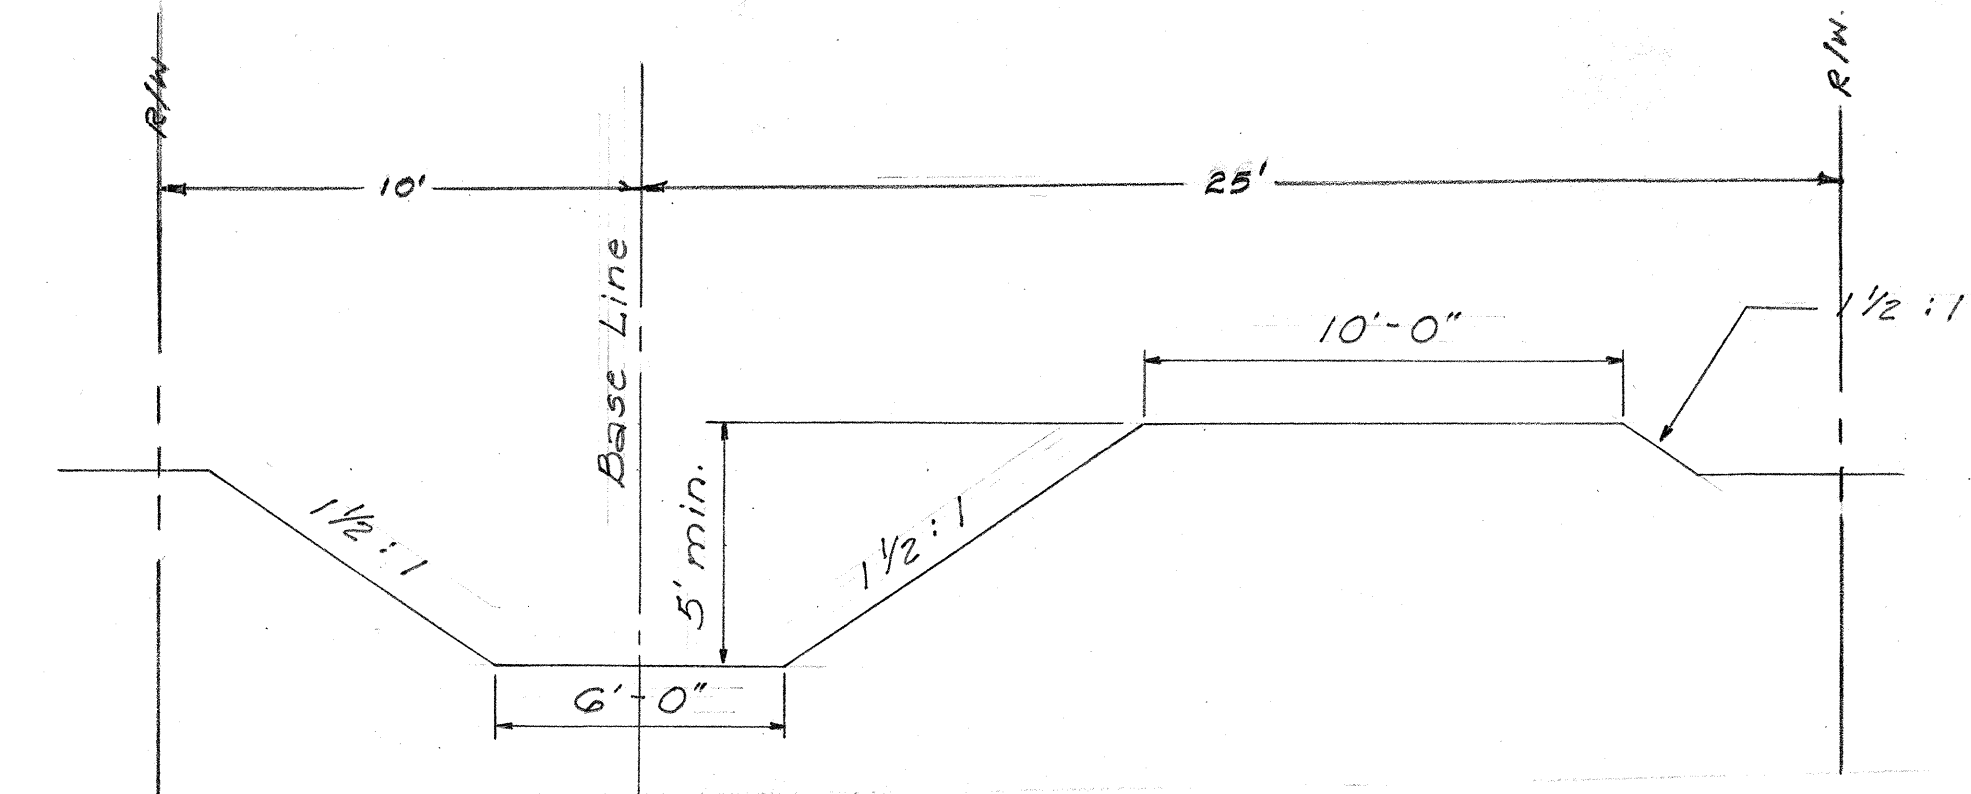


PLAN	DATE	BY
SURVEYED		
NOTED		
NOTED		
RT. OF WAY CHECKED		
NO.		


PROFILE	DATE	BY
SURVEYED		
NOTED		
NOTED		
STRUCTURE NOTATIONS CHKD		
NO.		

Existing 36" Conc.
Culvert, - 2 CHW

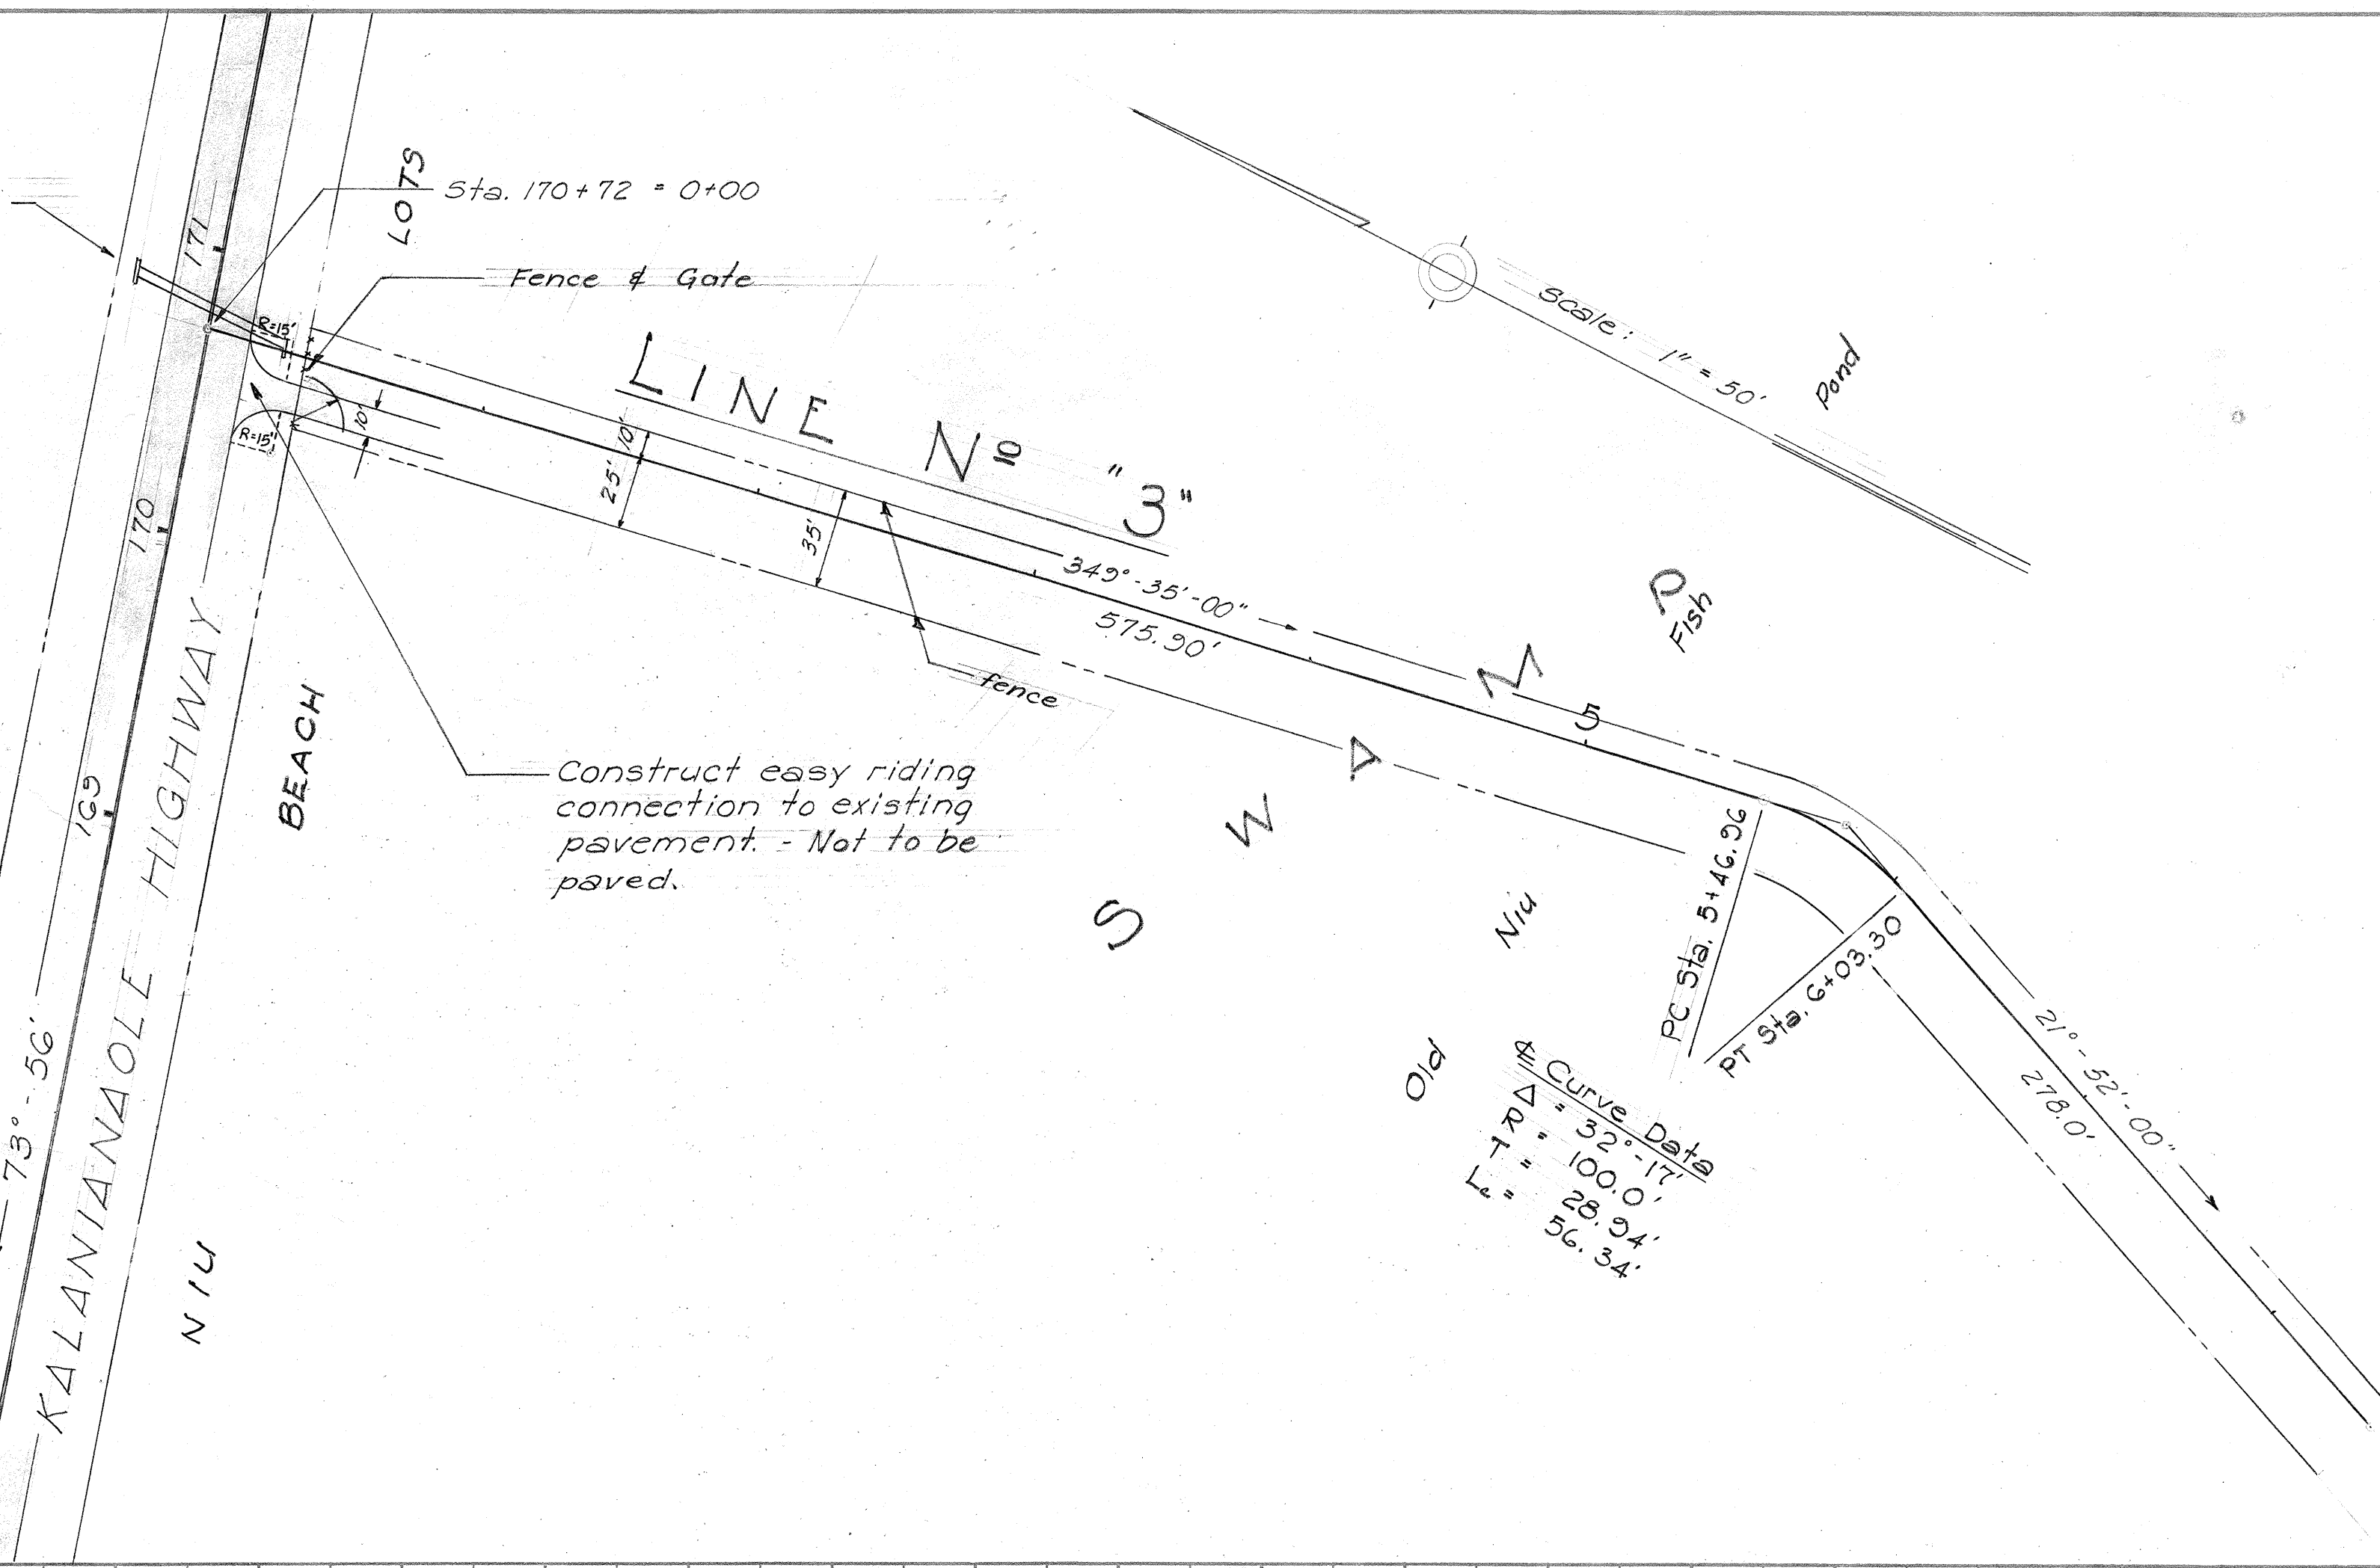

TYPICAL SECTION LINE "3"

Scale: 1/4" = 1'-0"

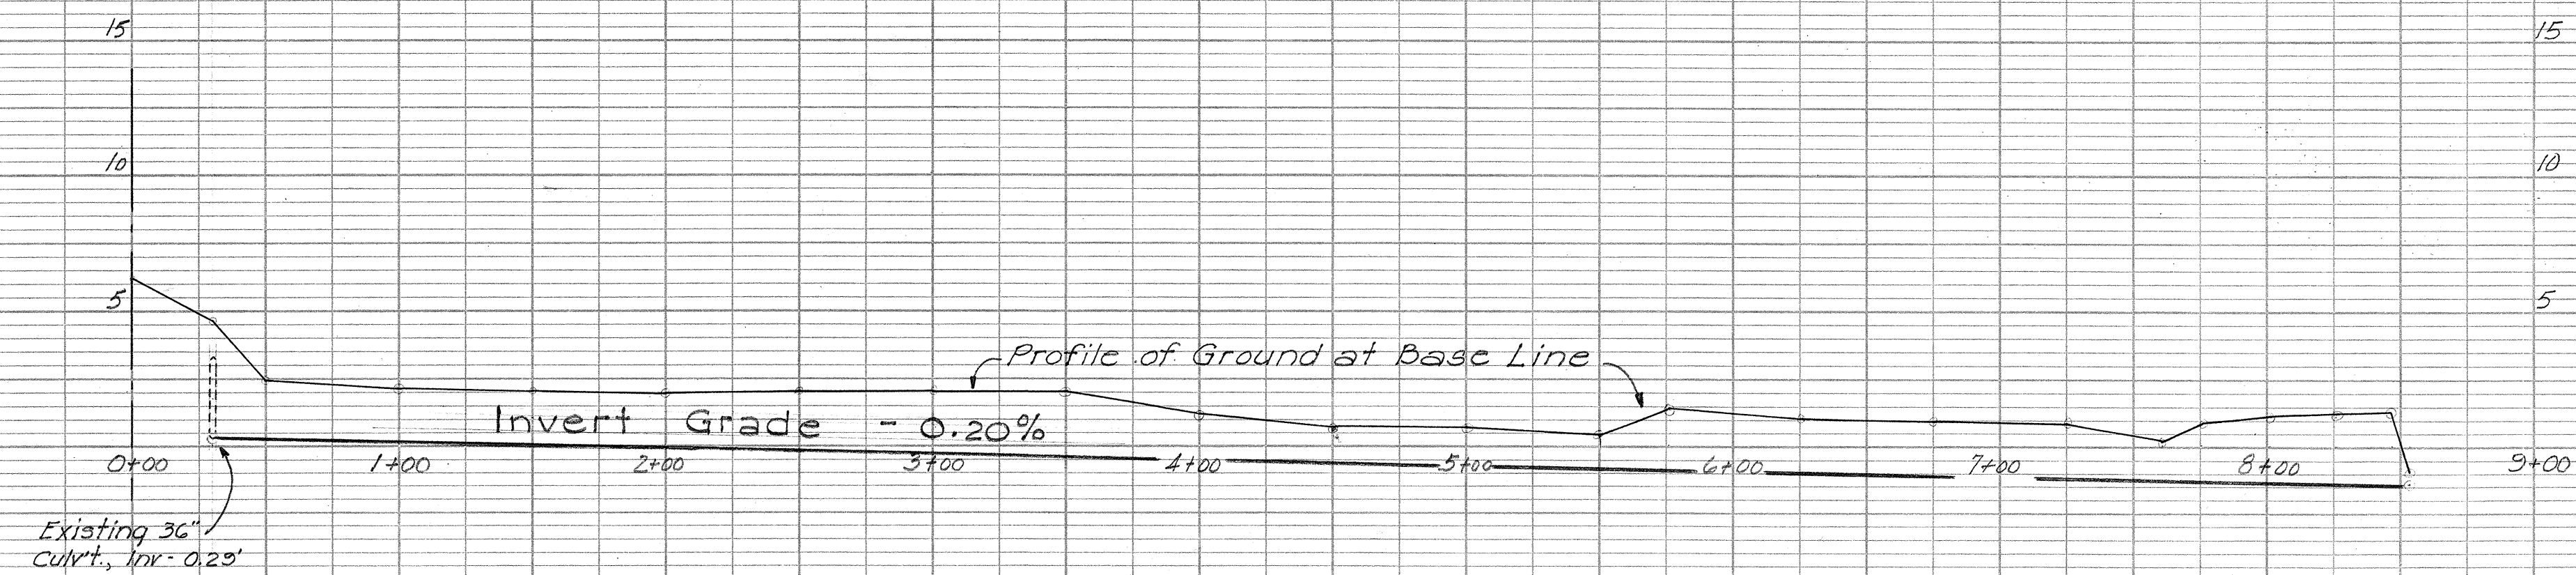

LINE No. "3"




Profile Right of Sta. 170+72

Scale: Vert. = 1" = 5'

Hor. = 1" = 50'

DATE	BY	FINAL SURVEY
		NO. 1
		NO. 2
		NO. 3
		NO. 4
		NO. 5
		NO. 6
		NO. 7
		NO. 8
		NO. 9
		NO. 10

DATE	BY	ORIGINAL SURVEY
		NO. 1
		NO. 2
		NO. 3
		NO. 4
		NO. 5
		NO. 6
		NO. 7
		NO. 8
		NO. 9
		NO. 10

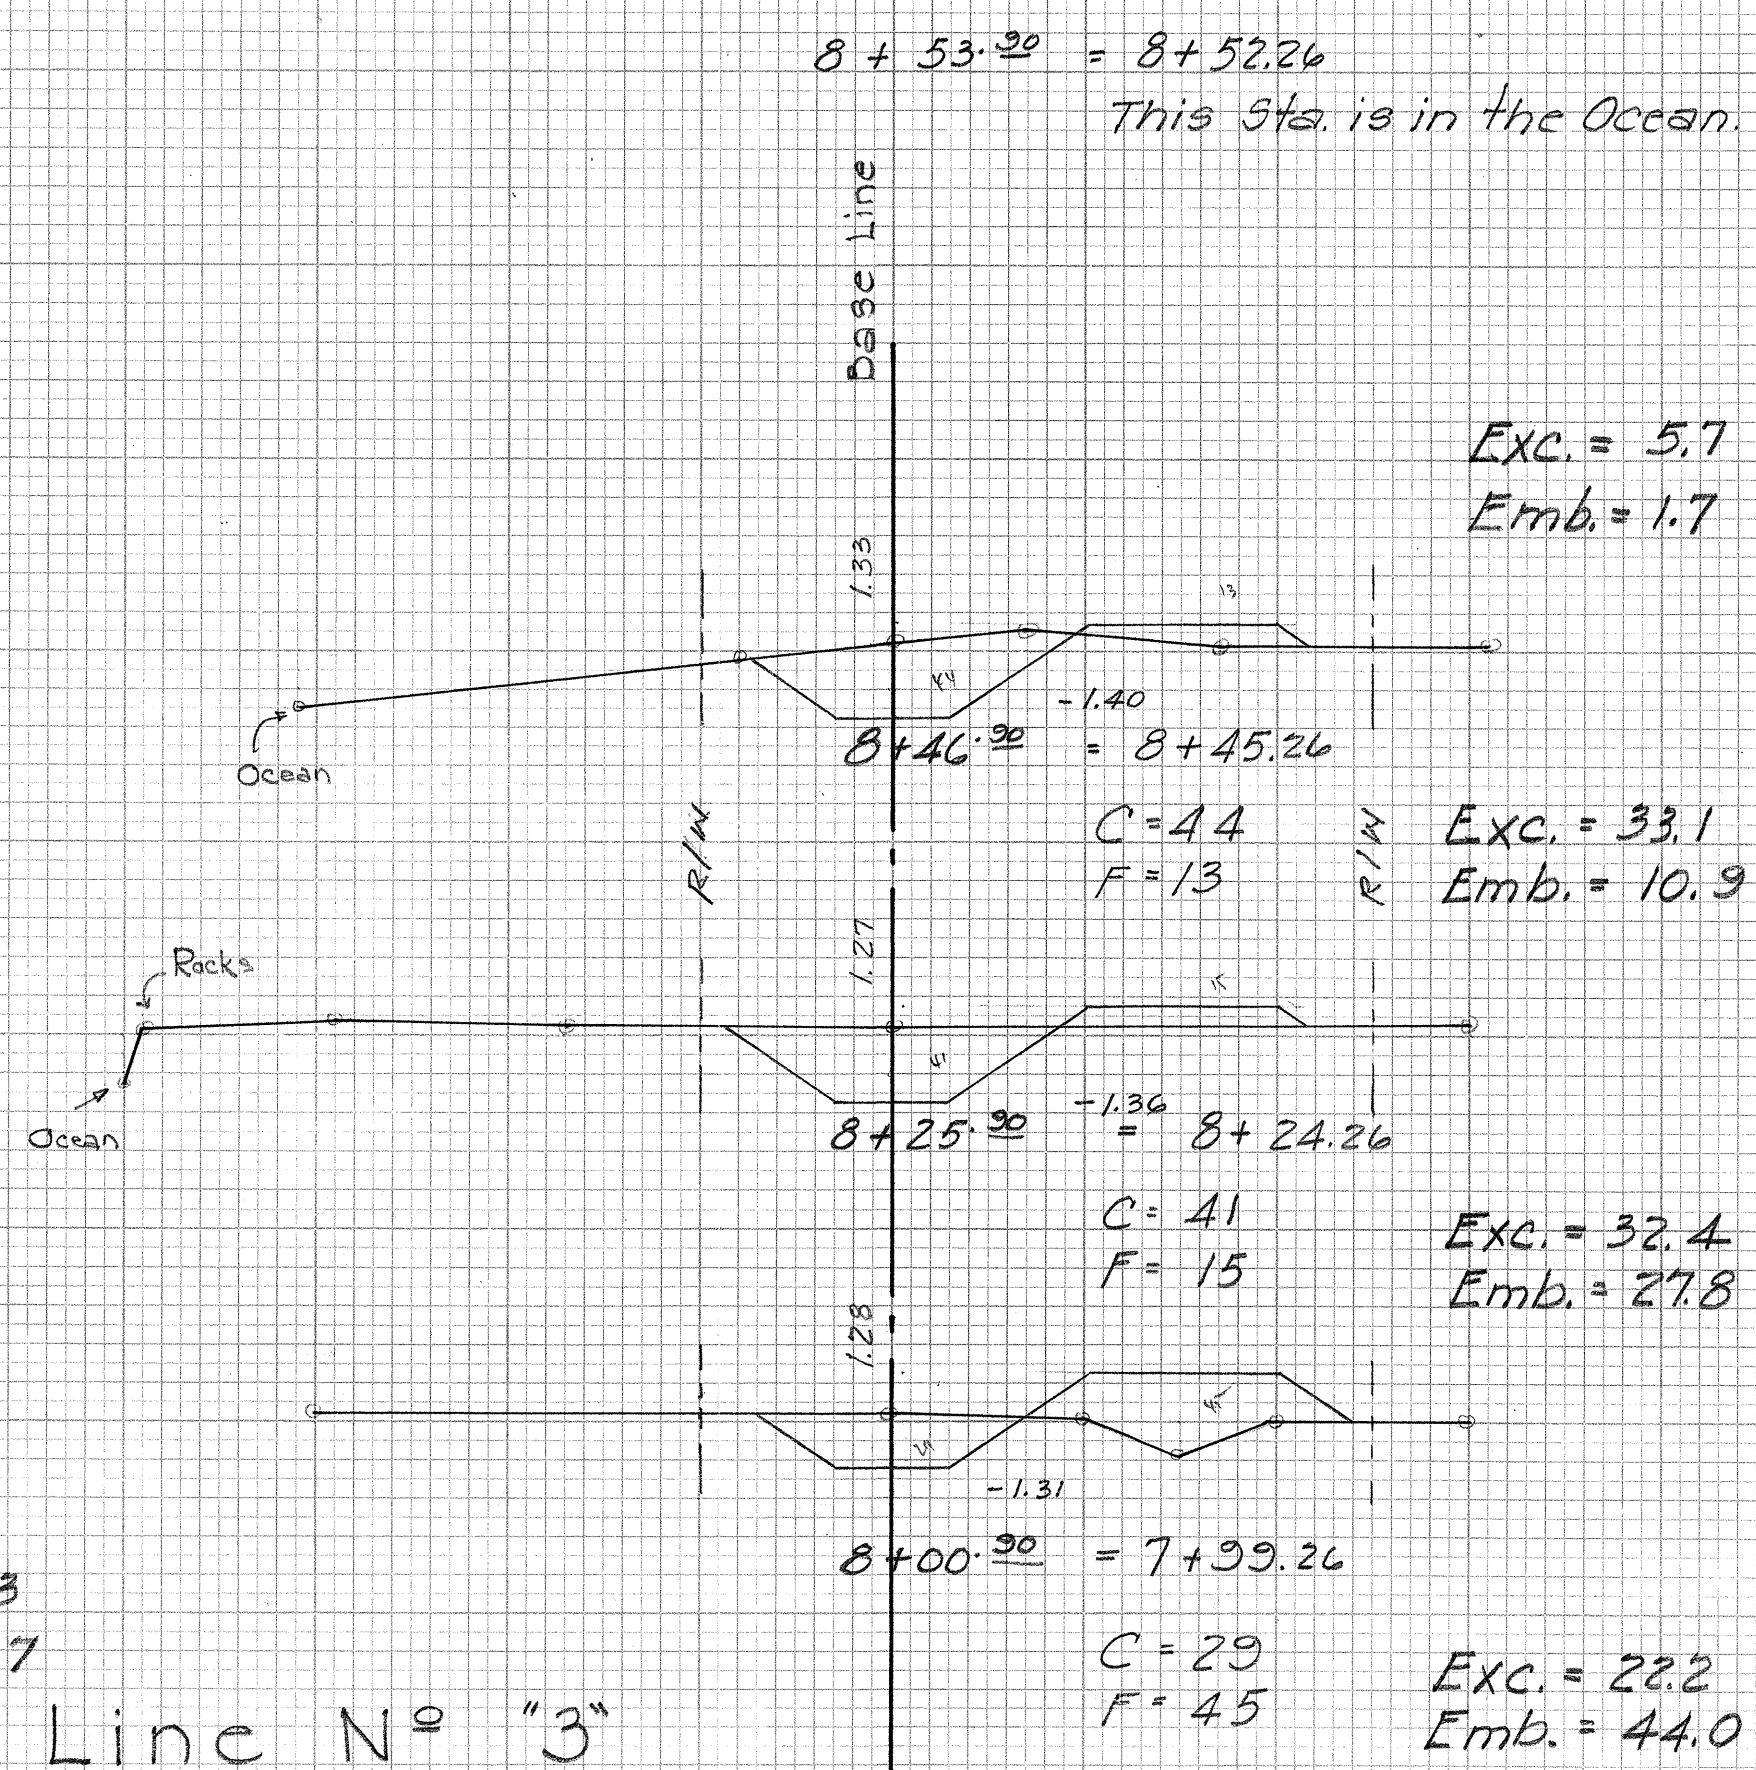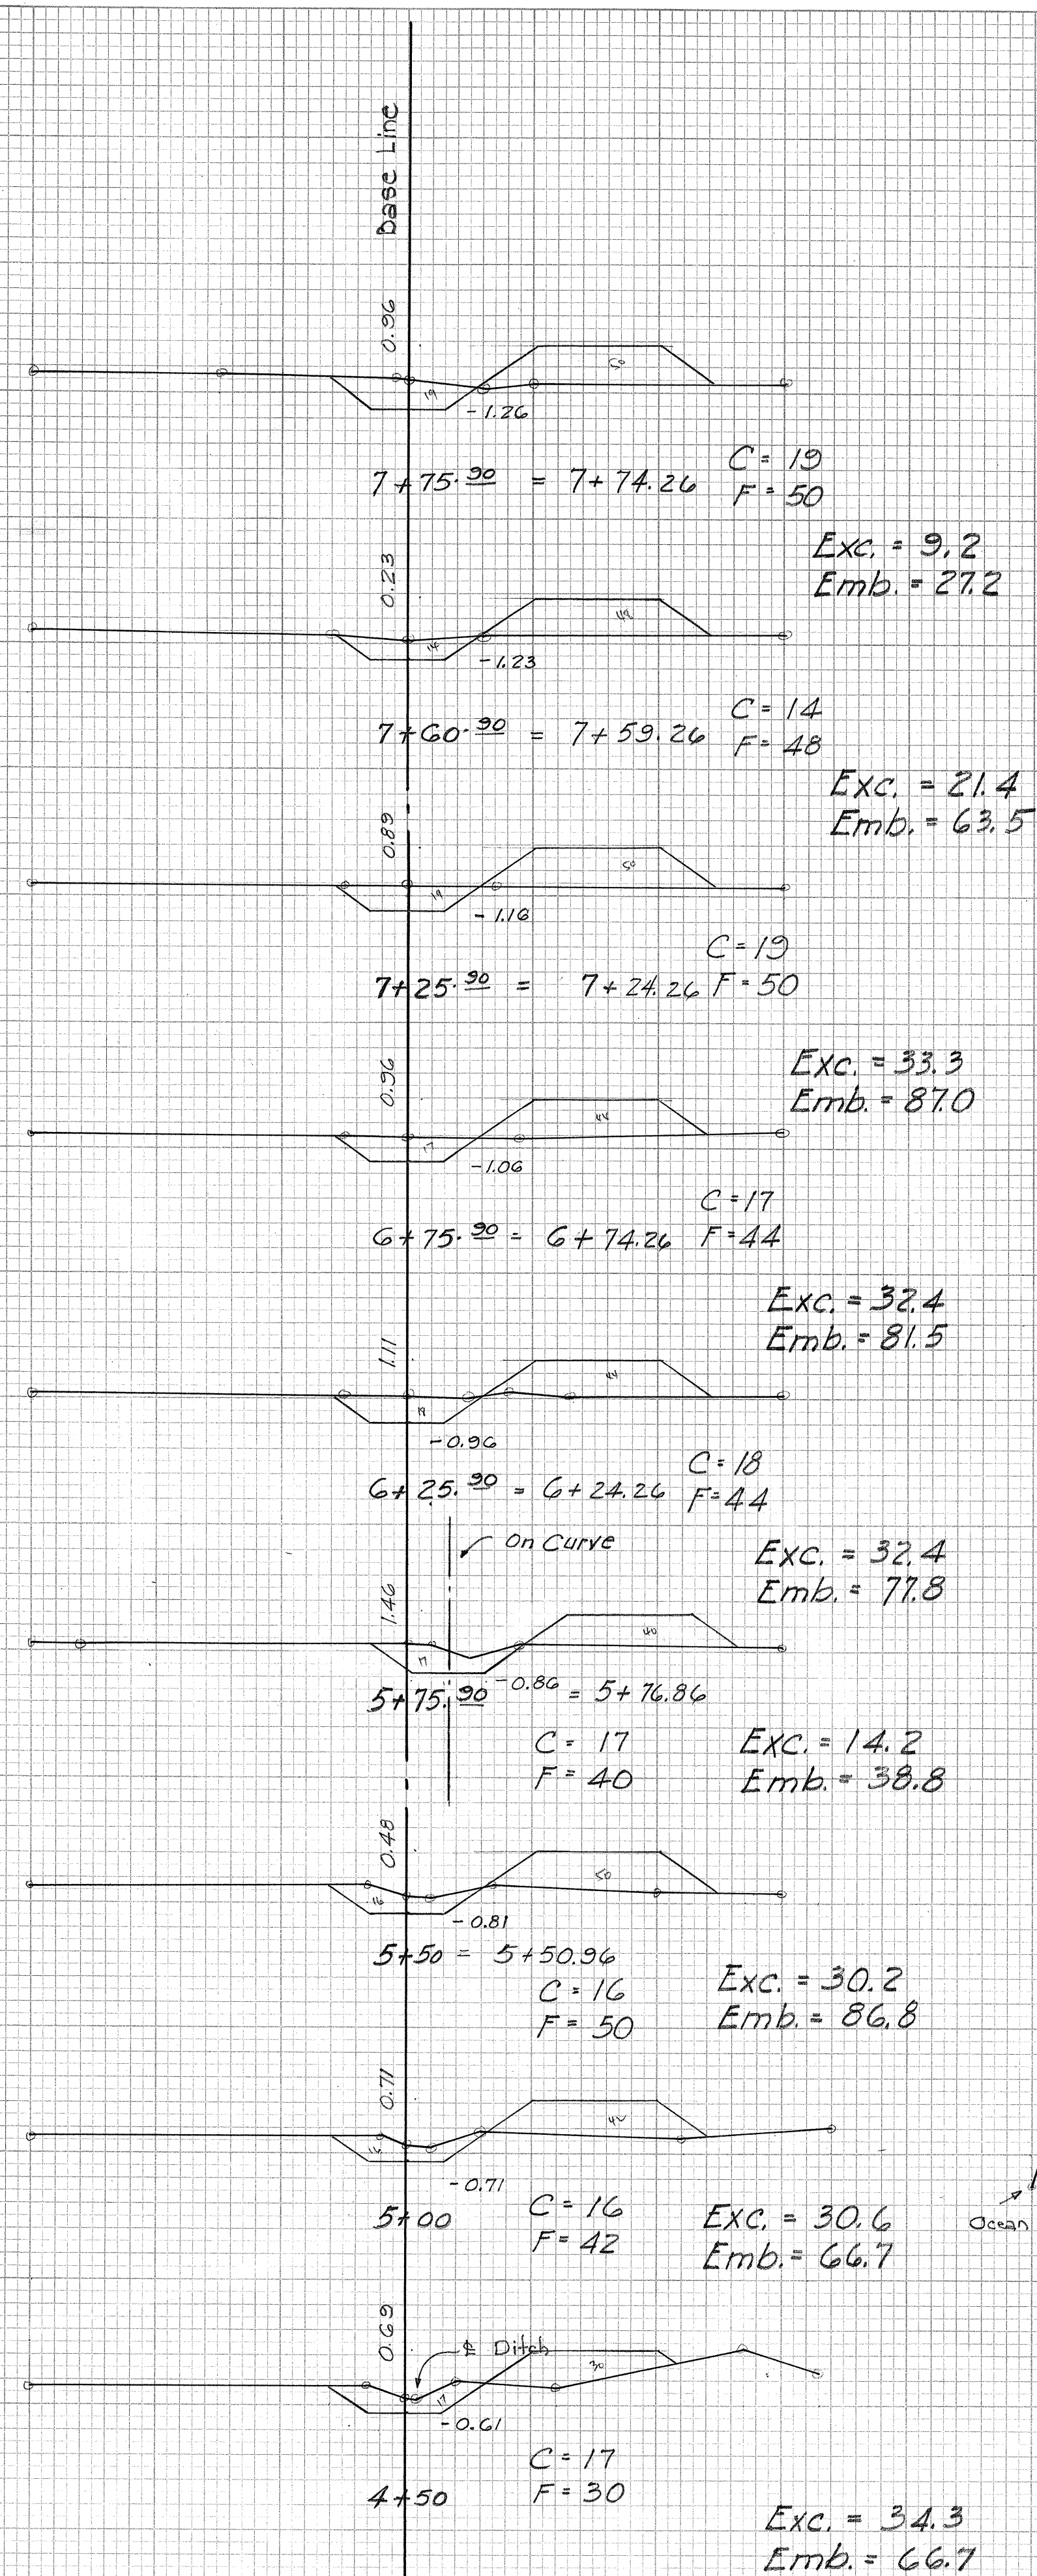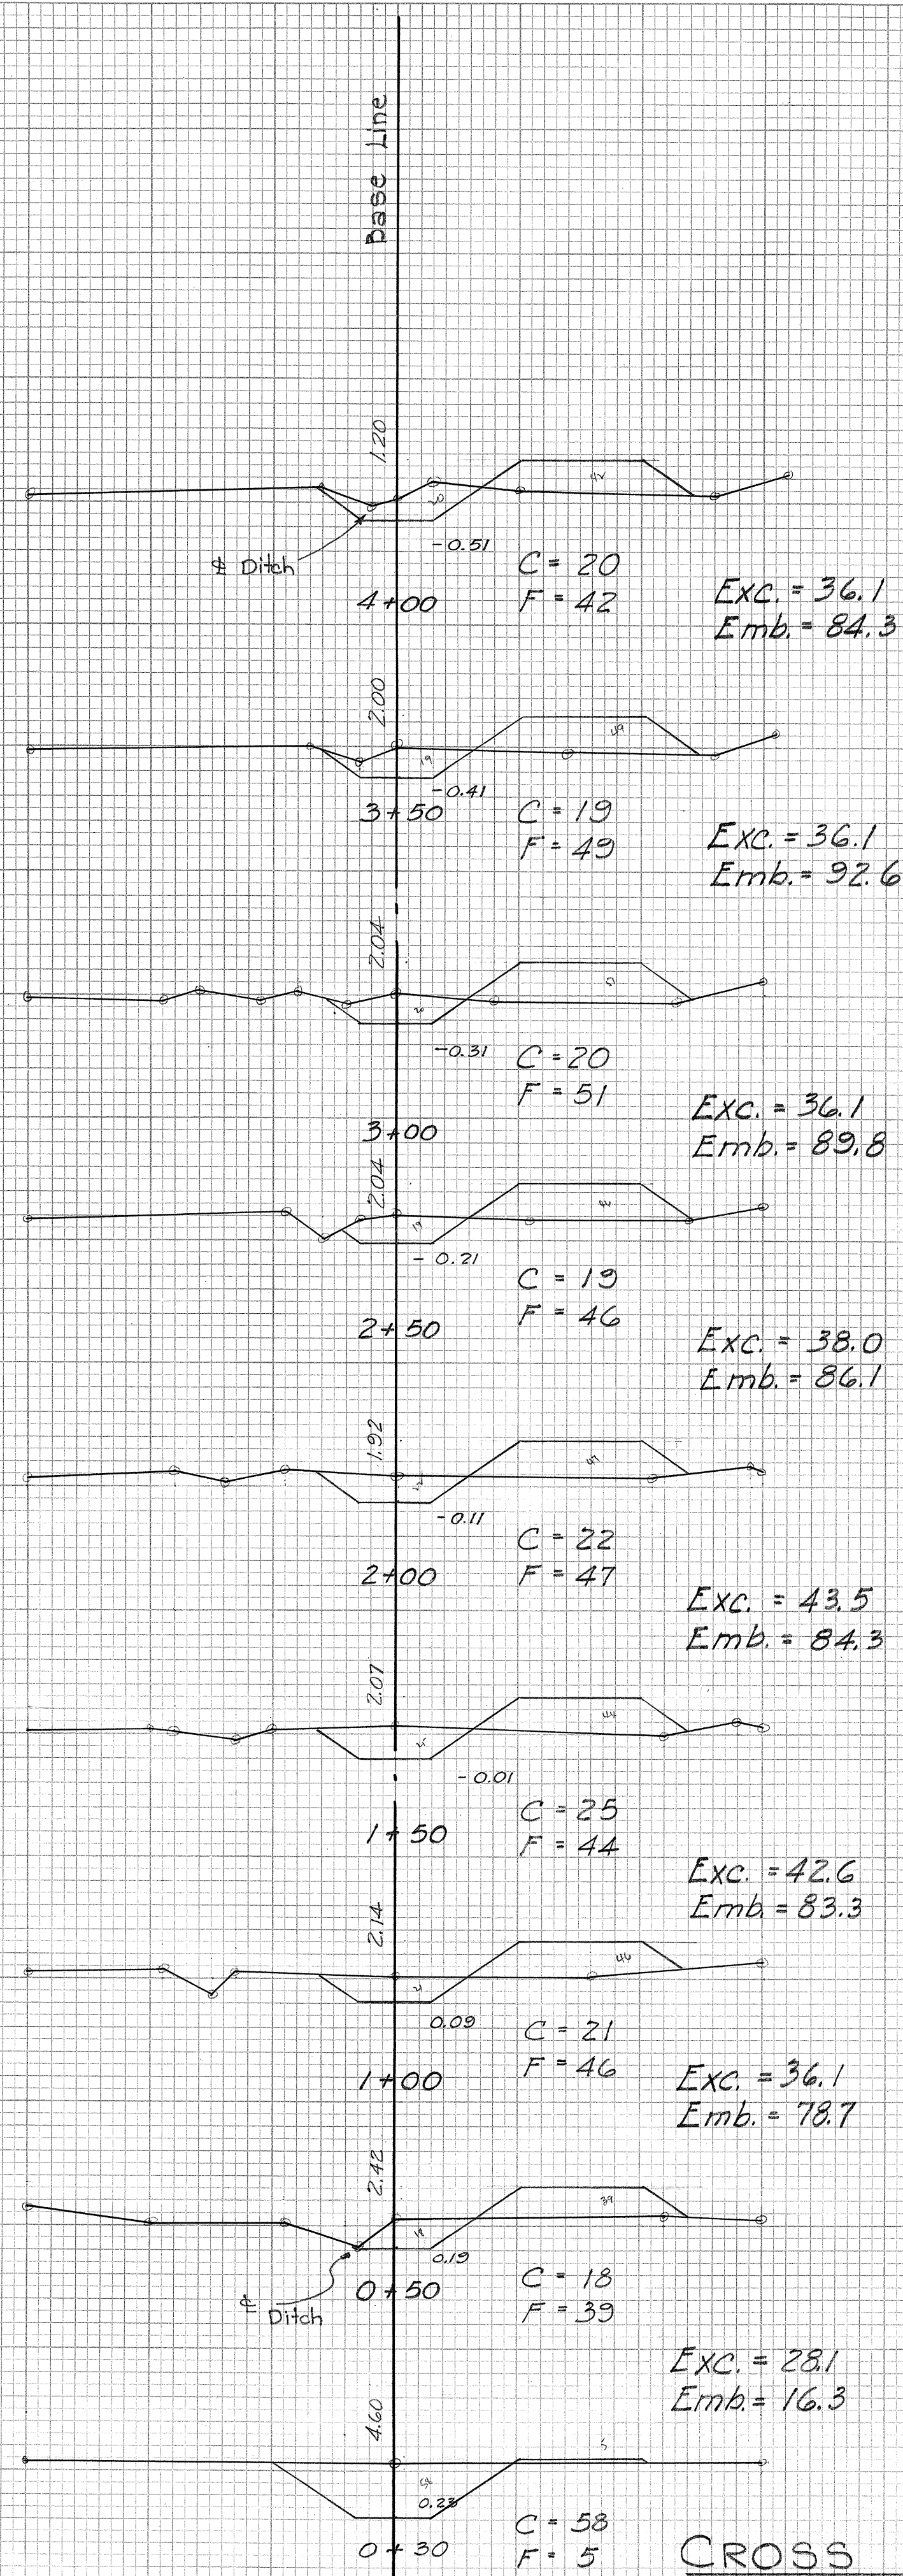

CROSS Sections to Right of Sta. 170+72 Line No. "3"