

INDEX TO DRAWINGS	
SHEET NO.	DISCRIPTION
1	TITLE SHEET
2	TYPICAL SECTION
3-4	PLANS

TERRITORY OF HAWAII
TERRITORIAL HIGHWAY DEPARTMENT
HONOLULU, OAHU, T.H.

PLANS OF
ROADSIDE LANDSCAPING
FOR
KALANIANA'OLE HIGHWAY


FEDERAL AID PROJECT NO. FI5(5)

DISTRICT OF KOOLAUPOKO
ISLAND OF OAHU

SCALE: AS NOTED
JOB NO. 5462

FED. ROAD DIST. NO.	STATE	FED. AID PROJ. NO.	FISCAL YEAR	SHEET NO.	TOTAL SHEETS
HAWAII	HAW.	FI5(5)	1949	1	4


G-28-50

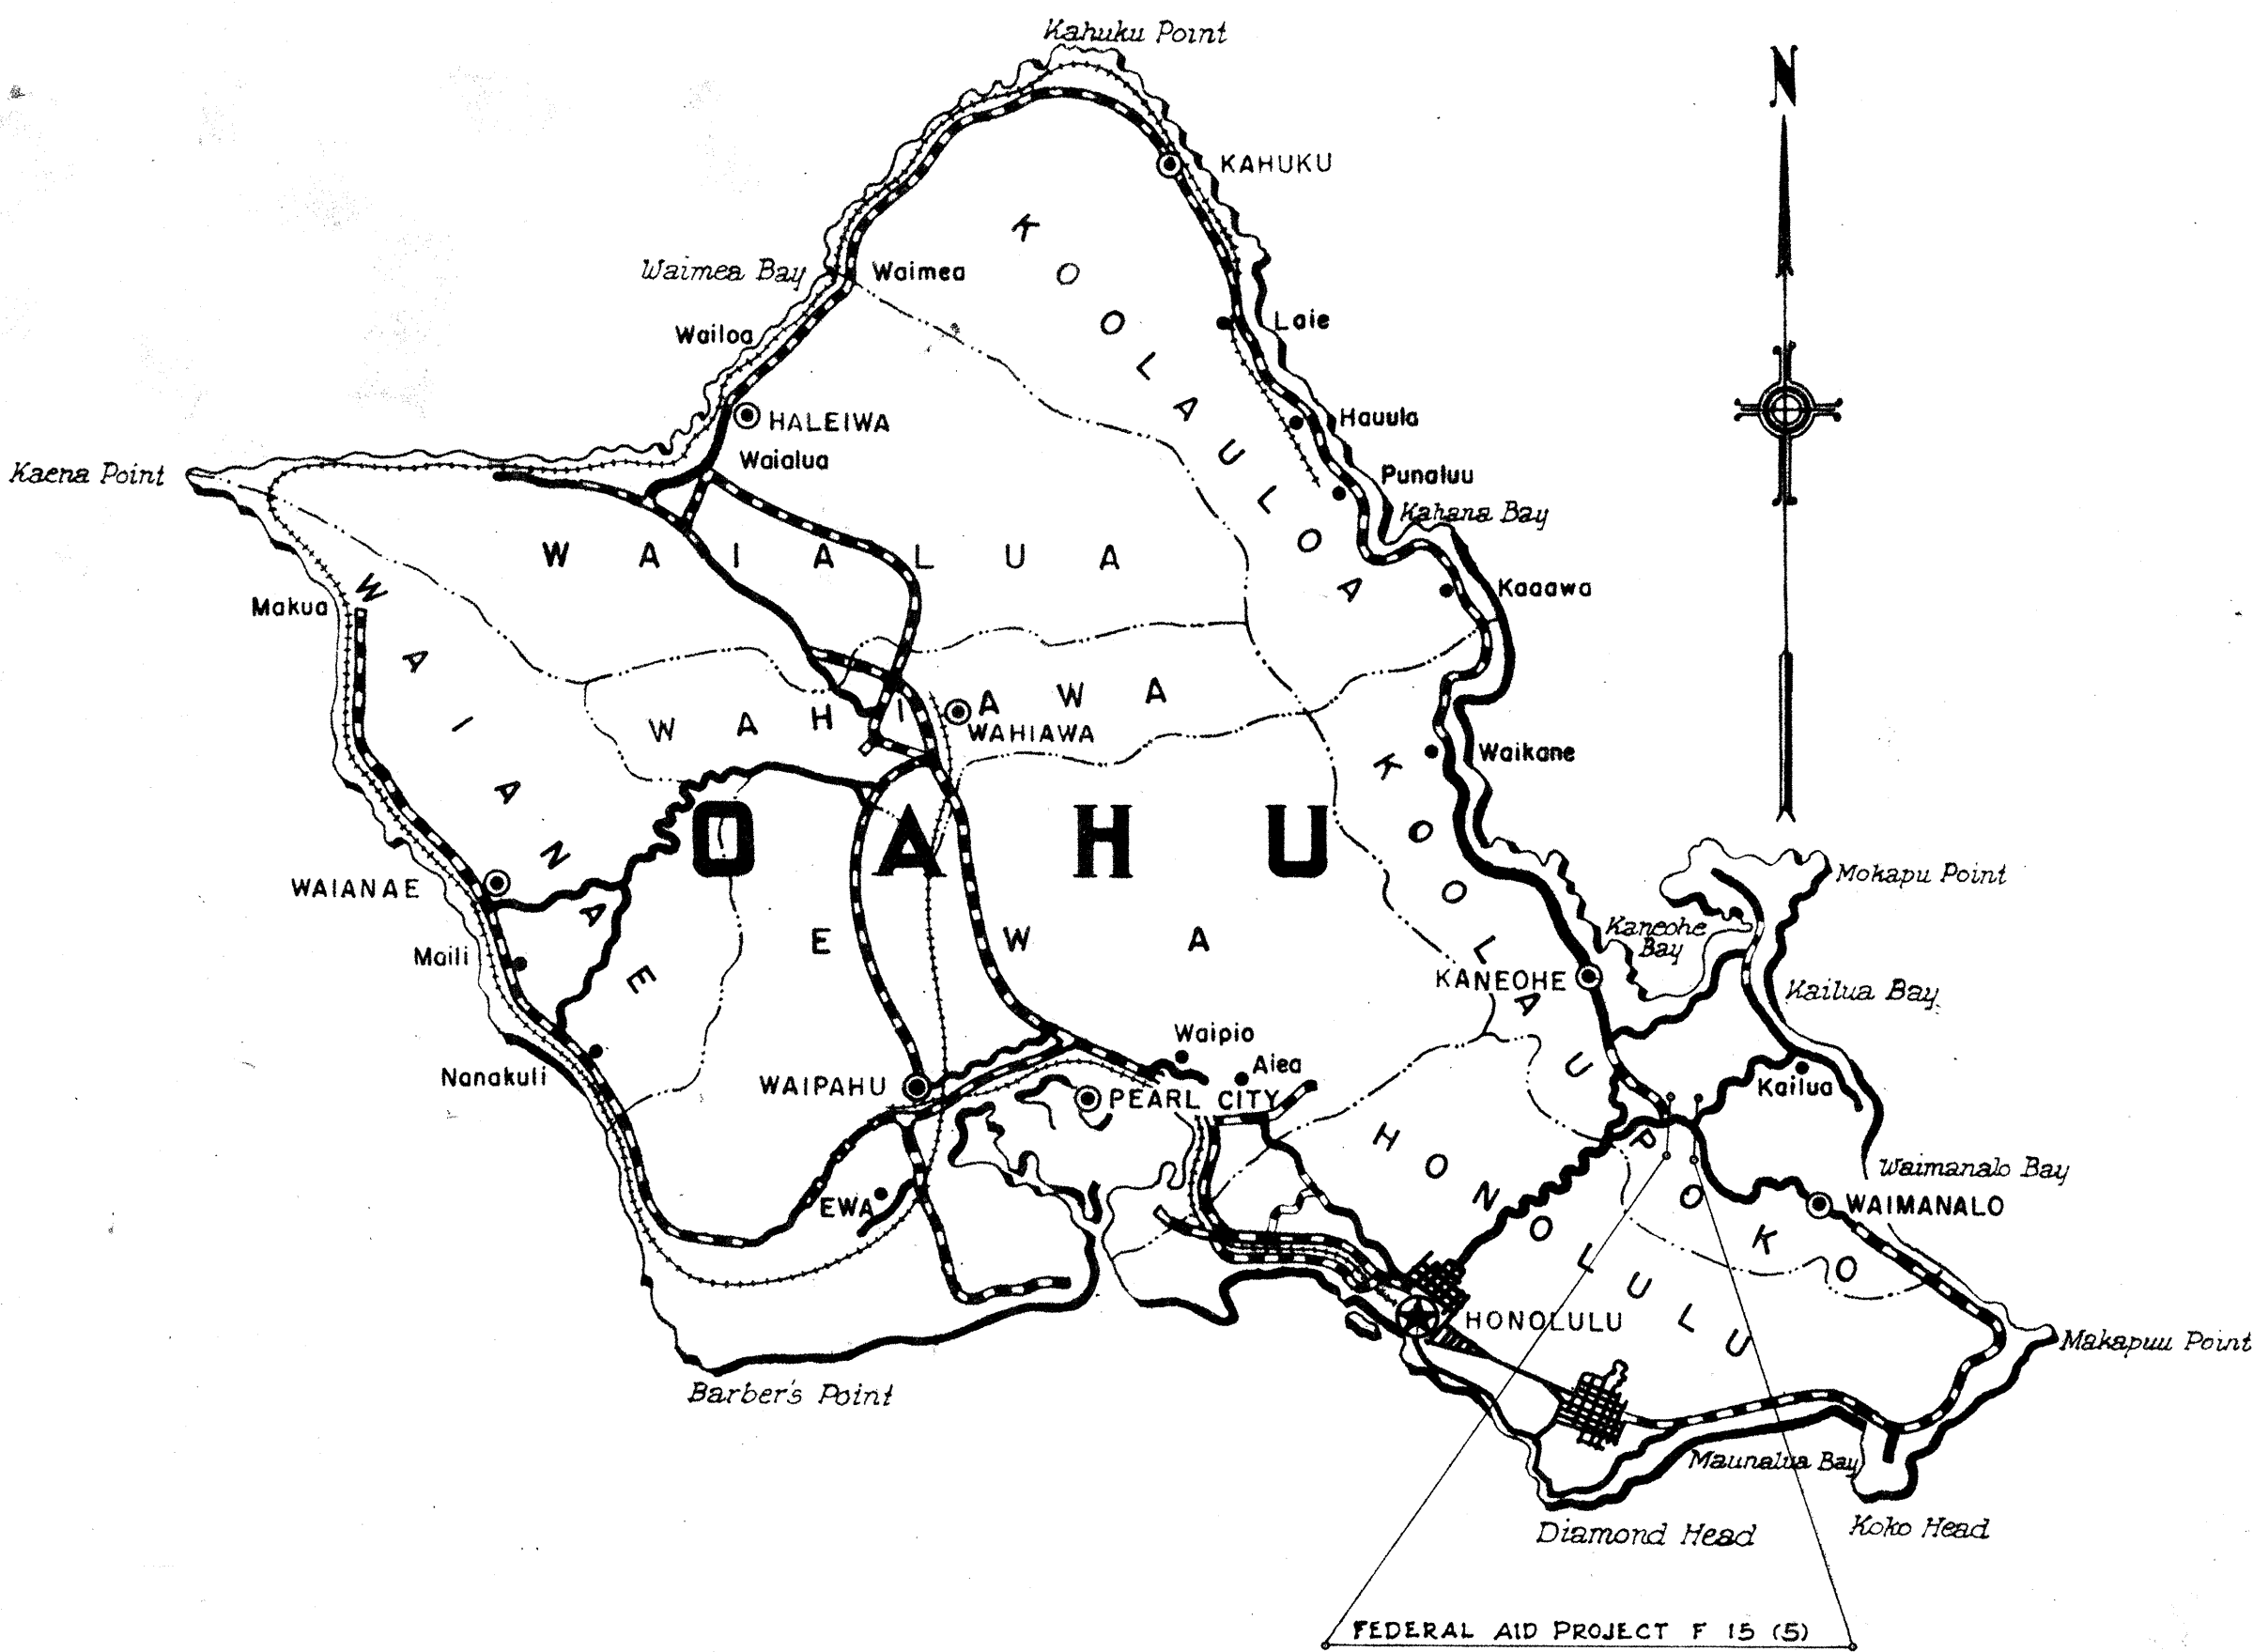

Federal Aid Projects Previously Constructed Or Under Construction

Note:
All changes made during construction have been noted in red on these tracings and checked.

By: *Julian Budd*
Project Engineer
Date: *January 29, 1952*

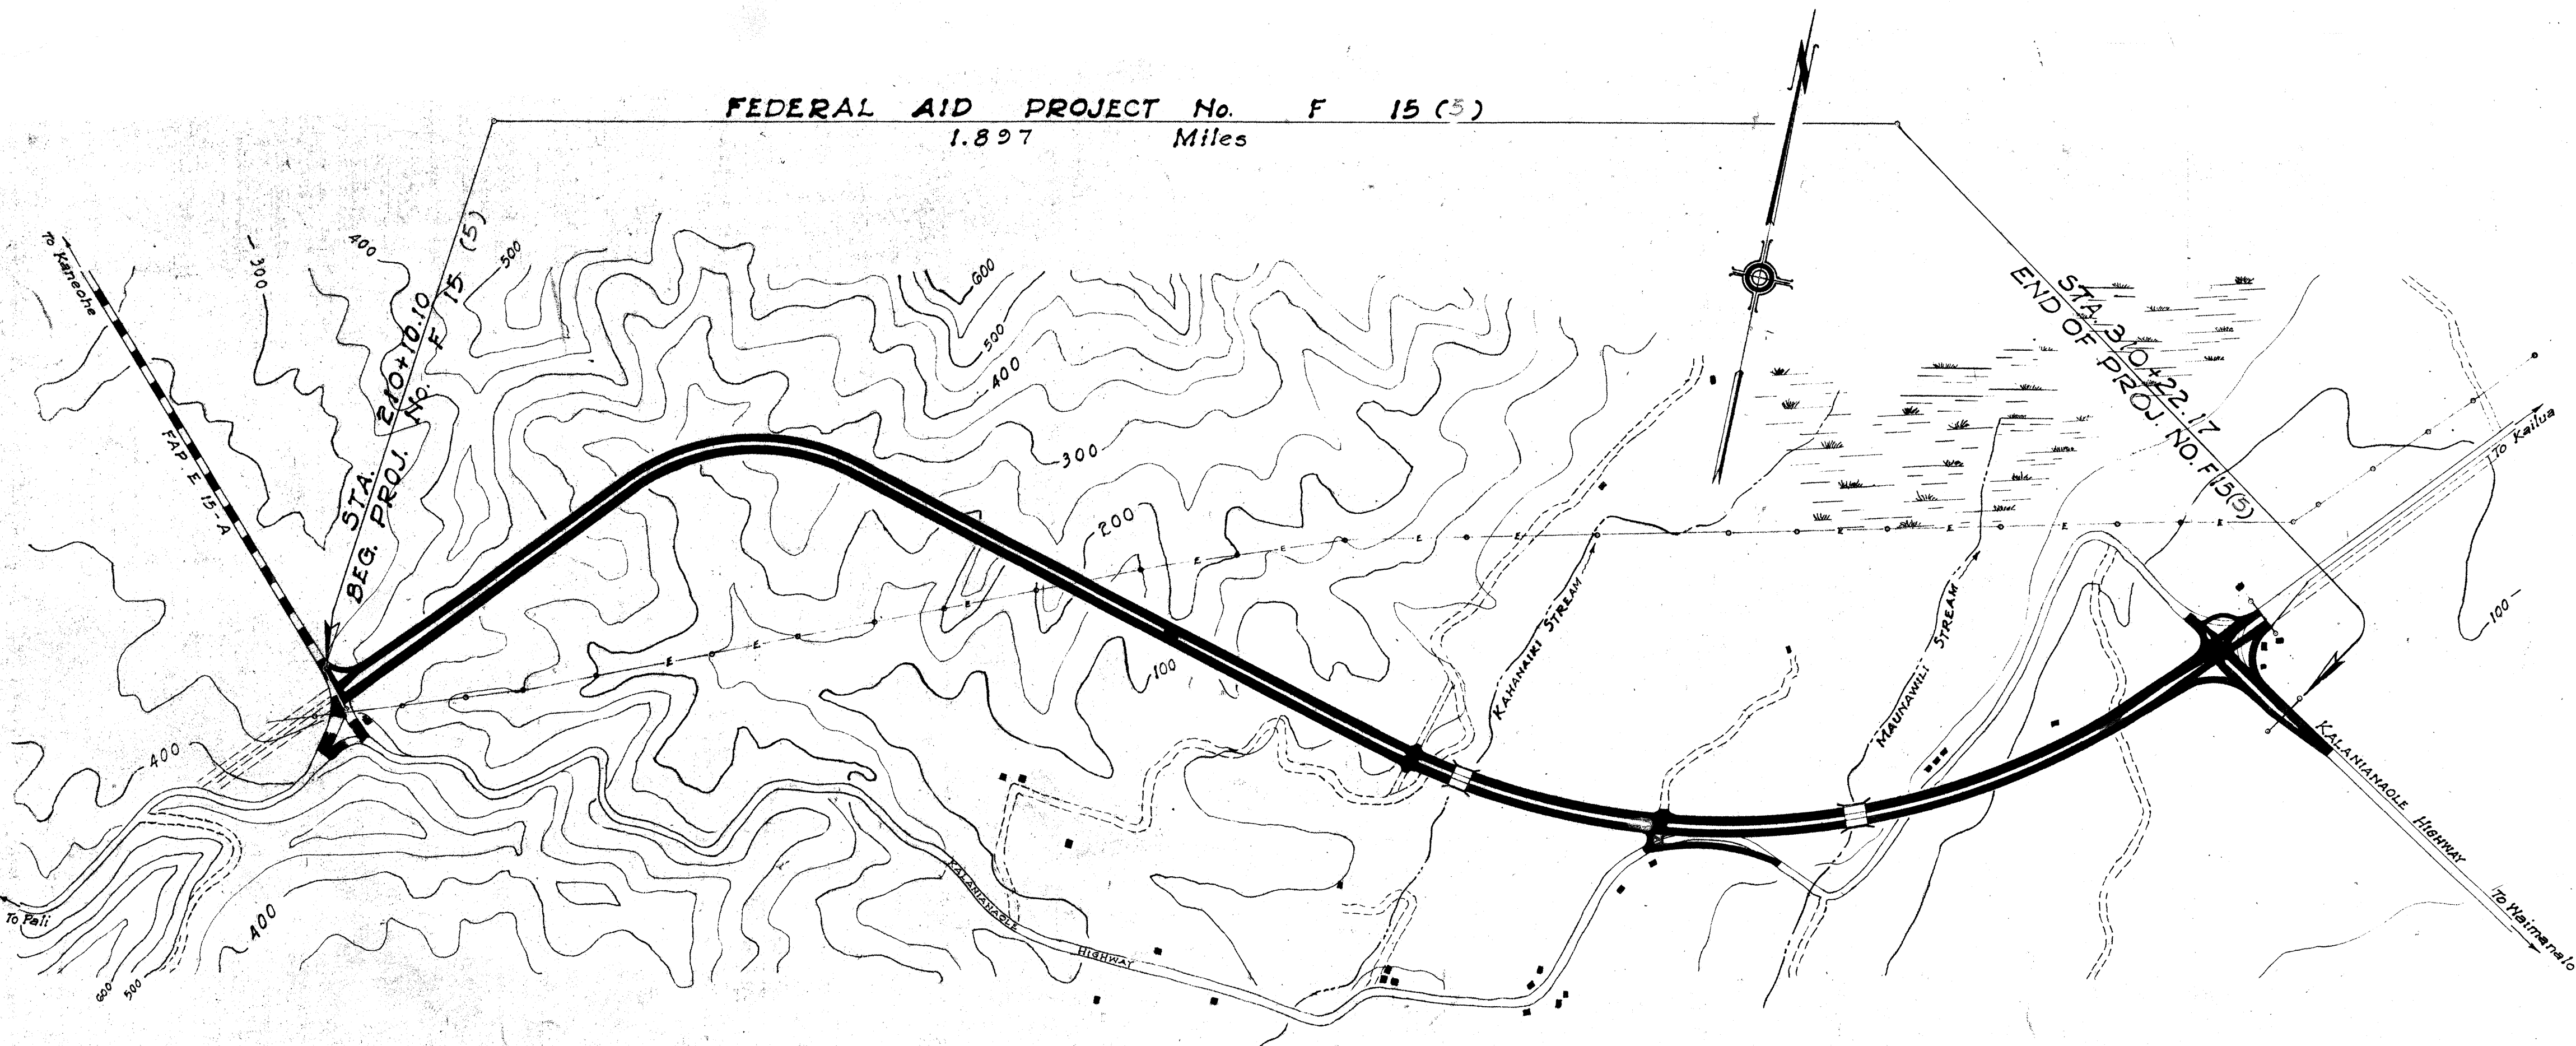

LAYOUT PLAN
Scale: 1 in. = 500 ft.

Gross Length of Project	1.896	Miles
Bridges	0.043	Miles
Net Length of Project	1.853	Miles

APPROVED
Julian Budd
TERRITORIAL HIGHWAY ENGINEER

DATE: JAN. 23, 1950

DEPARTMENT OF COMMERCE
BUREAU OF PUBLIC ROADS

RECOMMENDED FOR APPROVAL:

DISTRICT ENGINEER _____ DATE _____

APPROVED: _____

DIVISION ENGINEER _____ DATE _____

SURVEY PLOTTED BY	DESIGNED BY	TRACED BY	QUANTITIES CHECKED BY	NO. _____
ORIGINAL PLAN	NOTE BOOK	NO. _____	NO. _____	NO. _____