

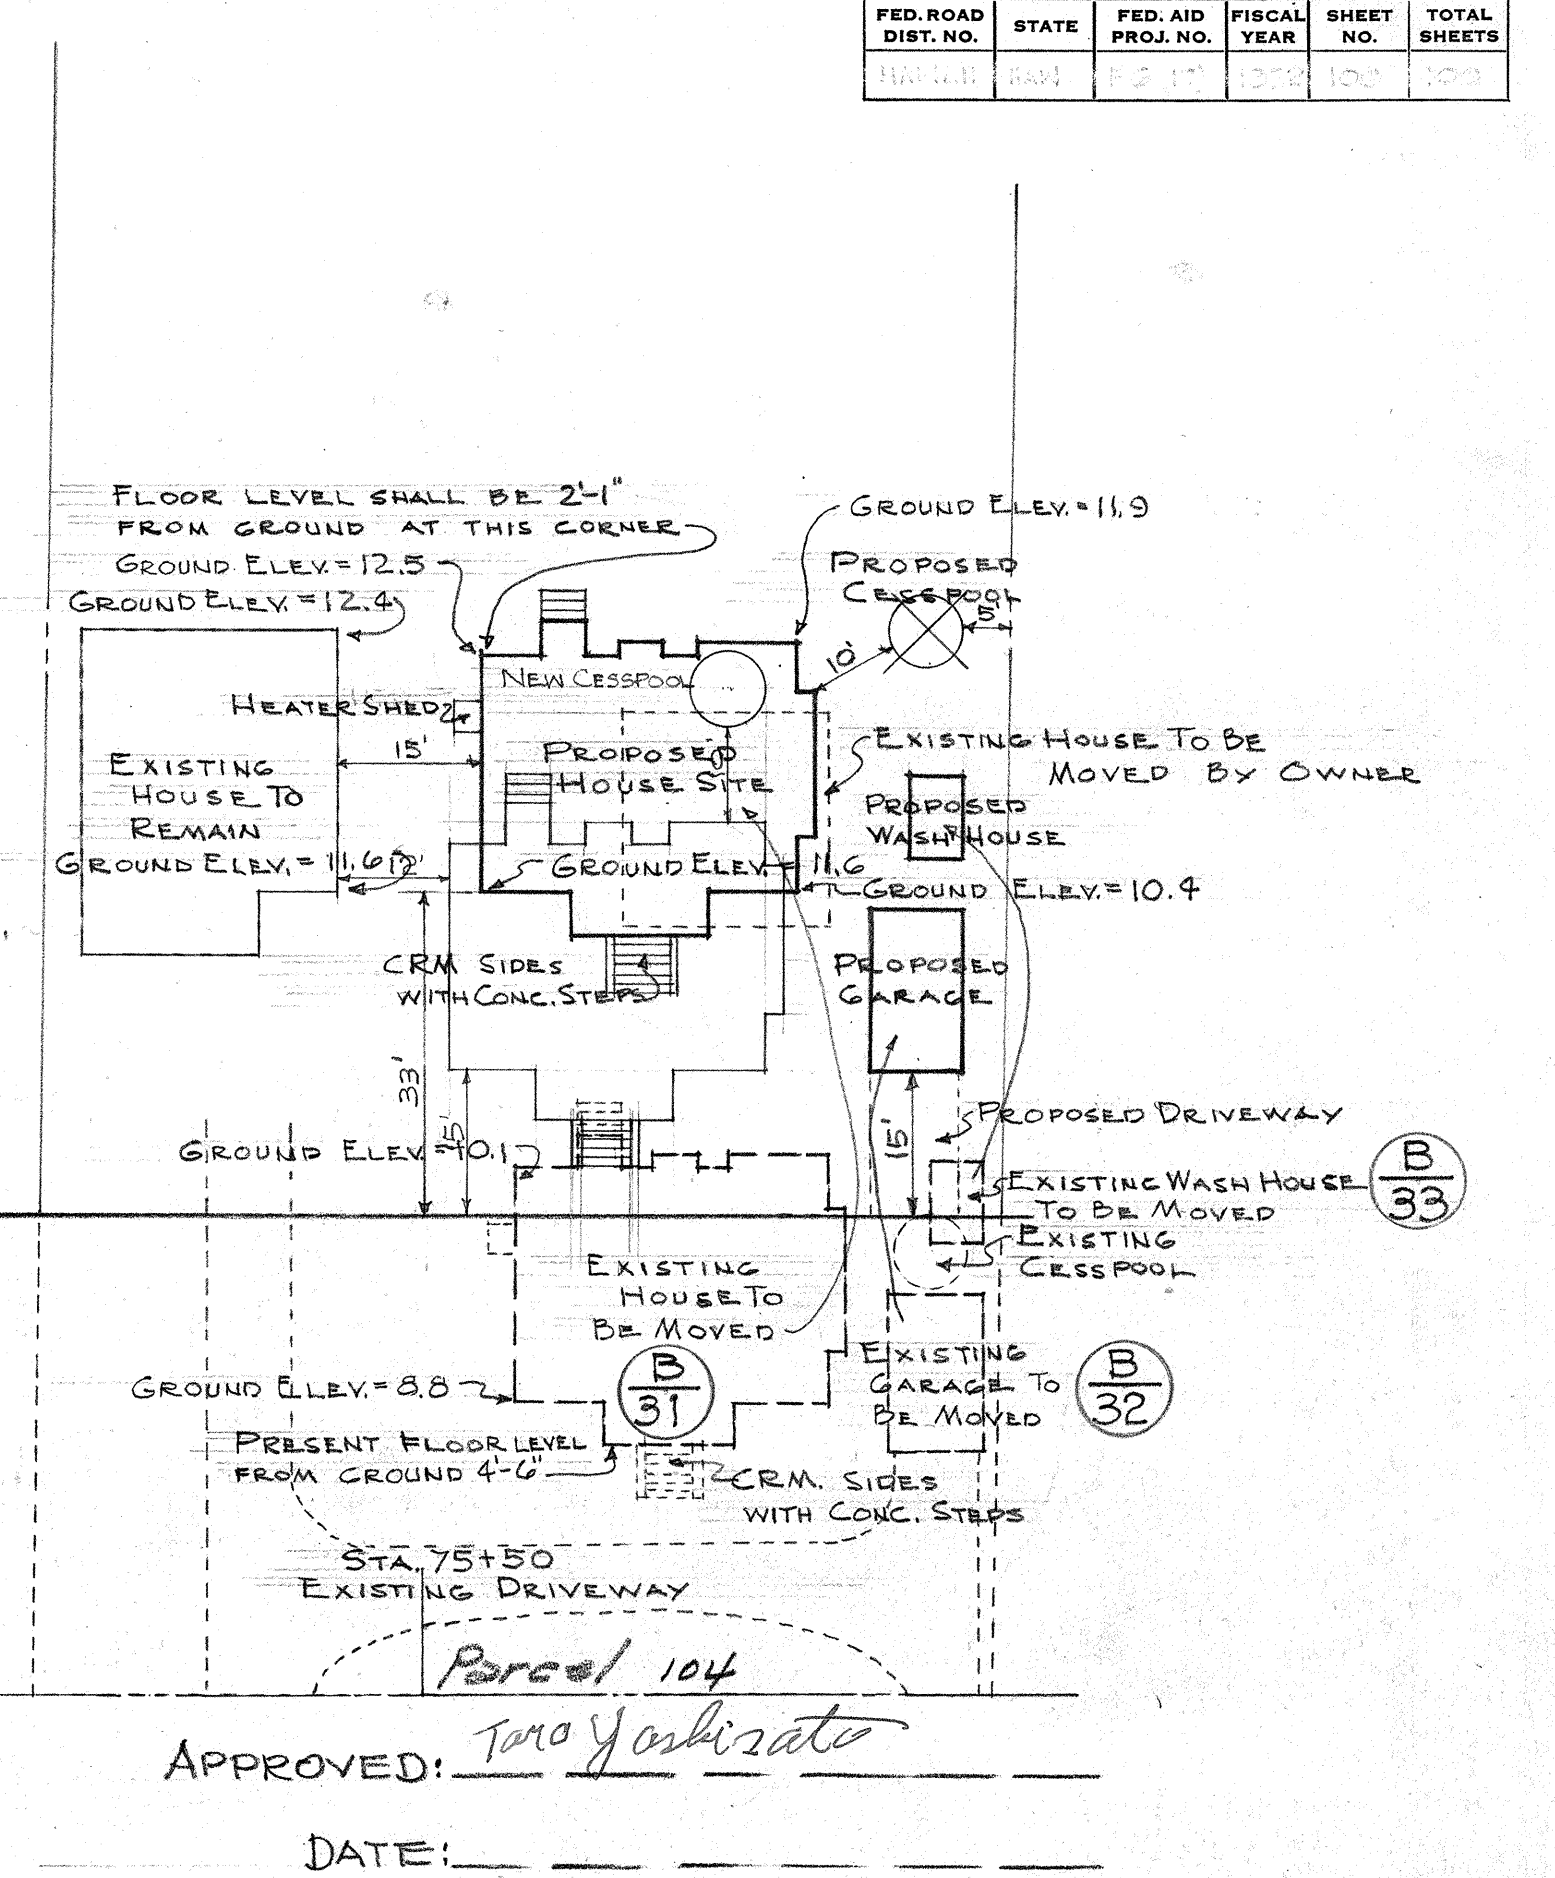
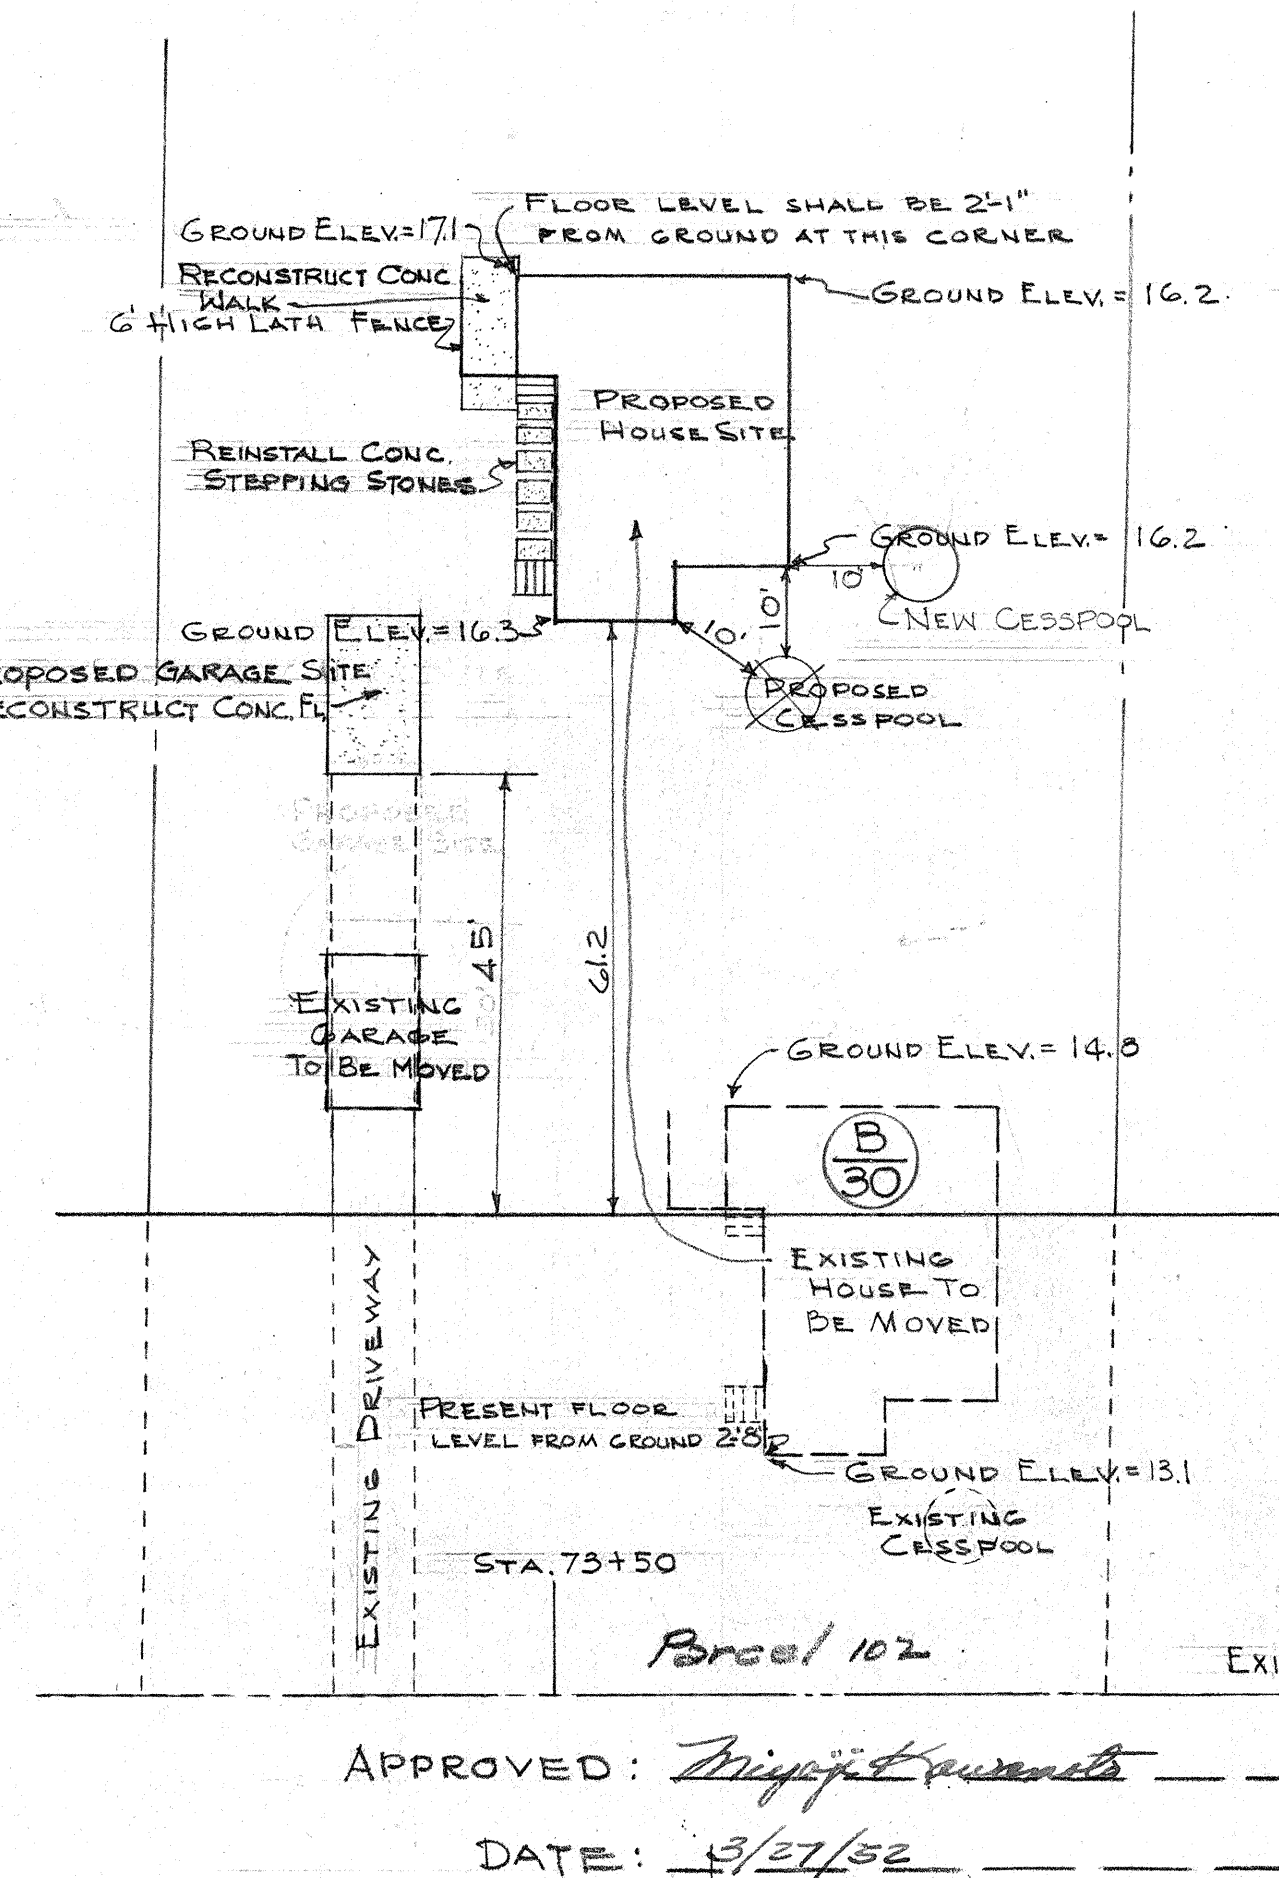
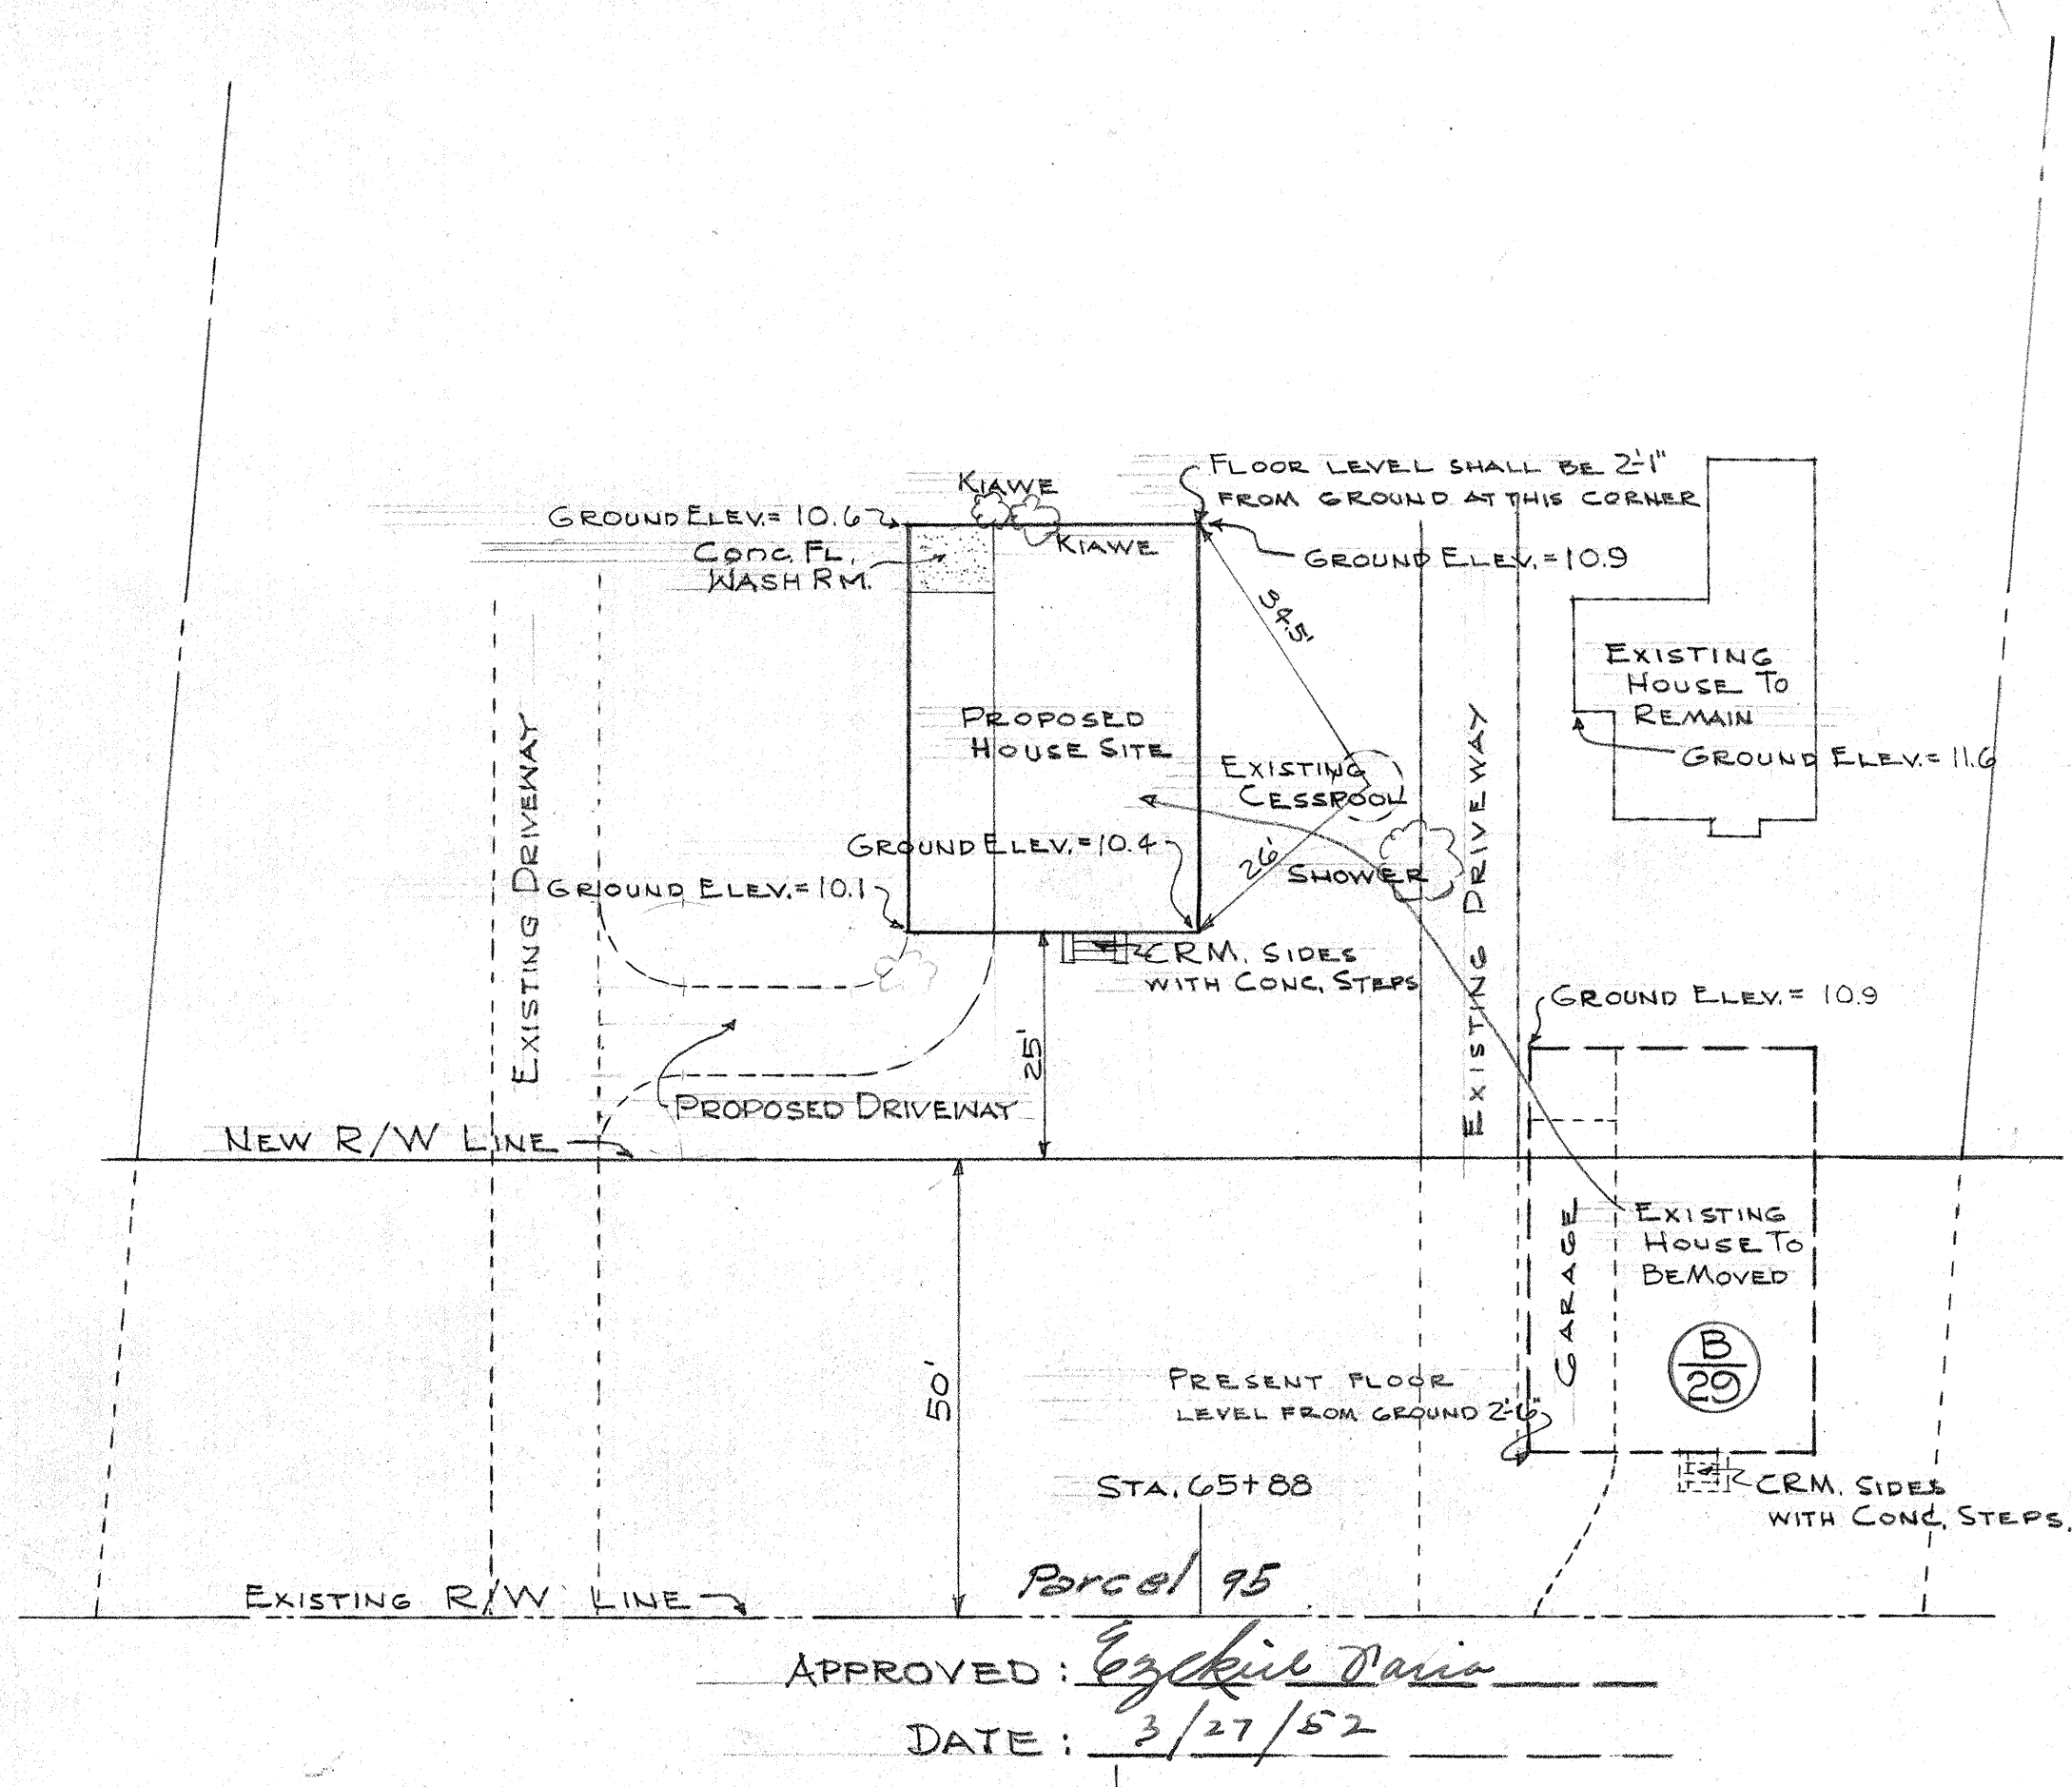


FED. ROAD DIST. NO.	STATE	FED. AID PROJ. NO.	FISCAL YEAR	SHEET NO.	TOTAL SHEETS
101	HI	101	1952	101	101

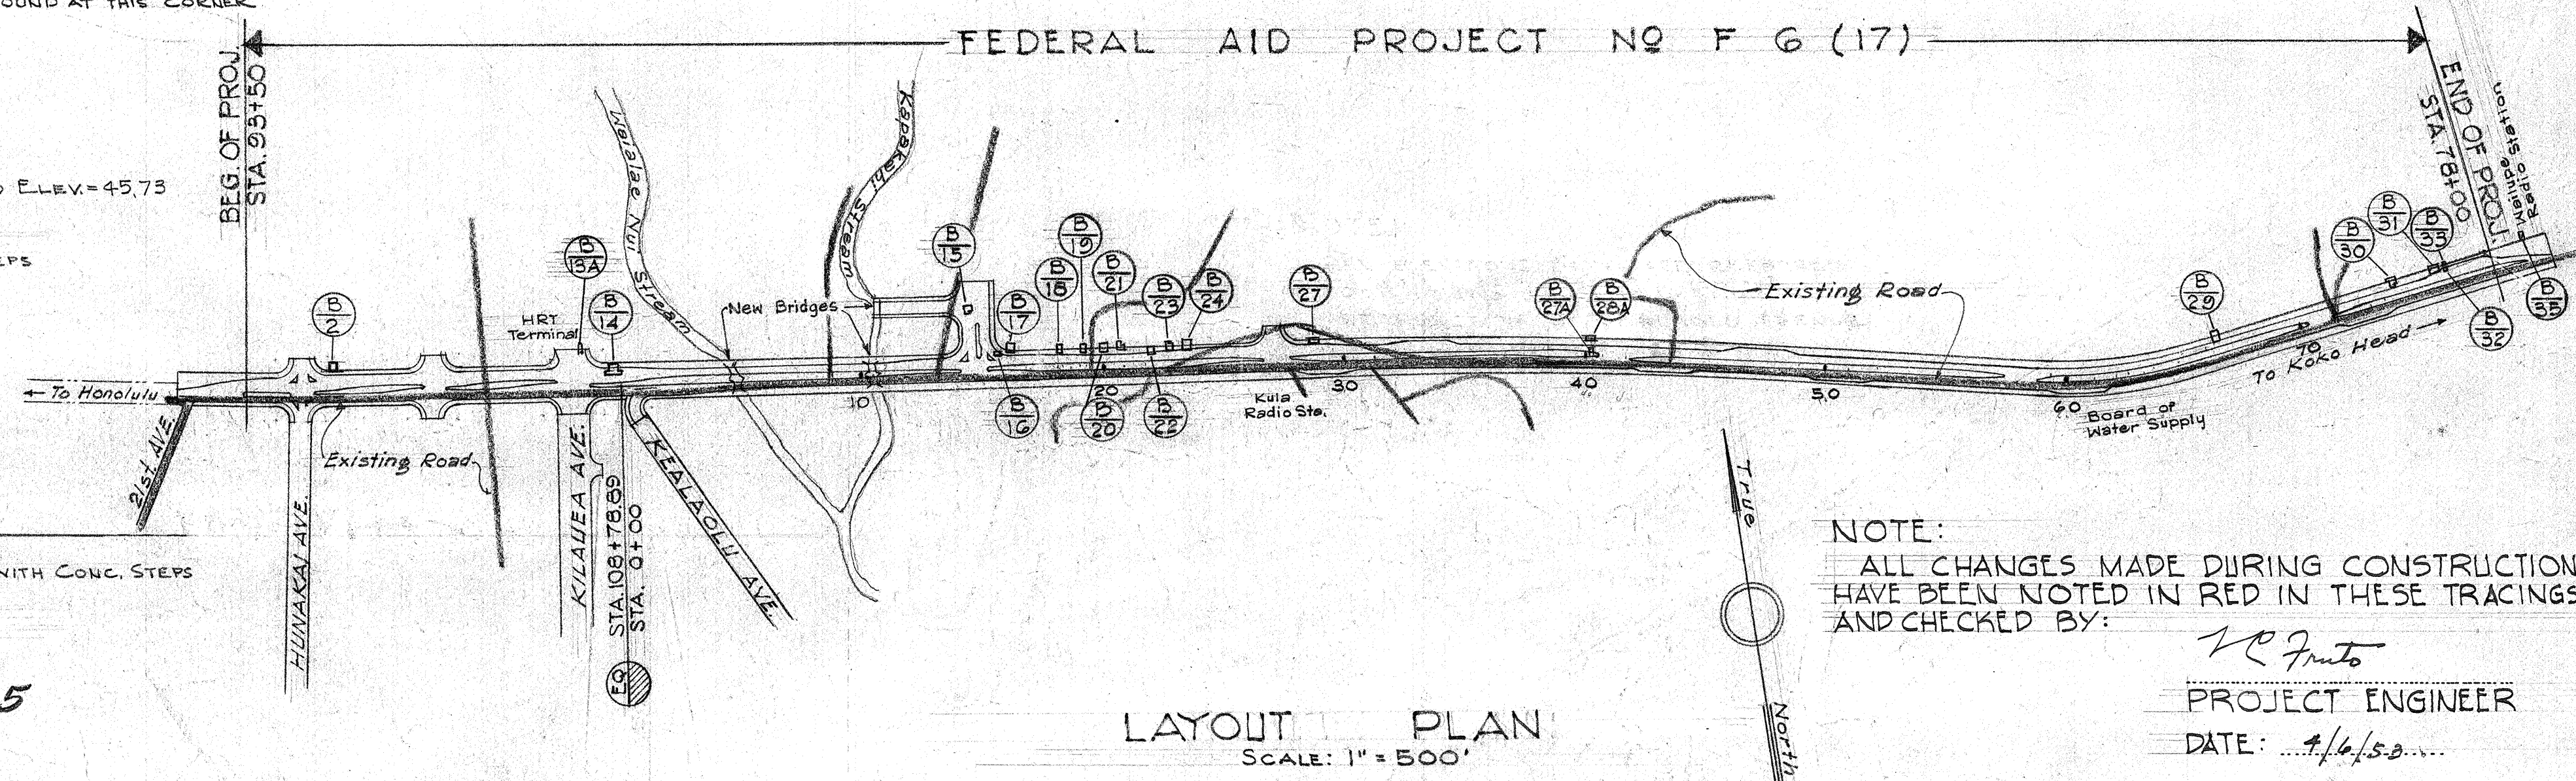

NOTE:
ALL ELEVATIONS SHOWN ARE REFERRED TO B.M. USGS K2 ELEVATION 37.61 AT INTERSECTION OF KEALAOLU AVENUE AND KALANIANA'OLE HIGHWAY. THE RELOCATION OF BUILDINGS, JOB NO 5622, IS DONE IN CONJUNCTION WITH THE IMPROVEMENT OF WAIALAE AVENUE AND KALANIANA'OLE HIGHWAY, JOB NO 5535-PROJECT NO FG (17).

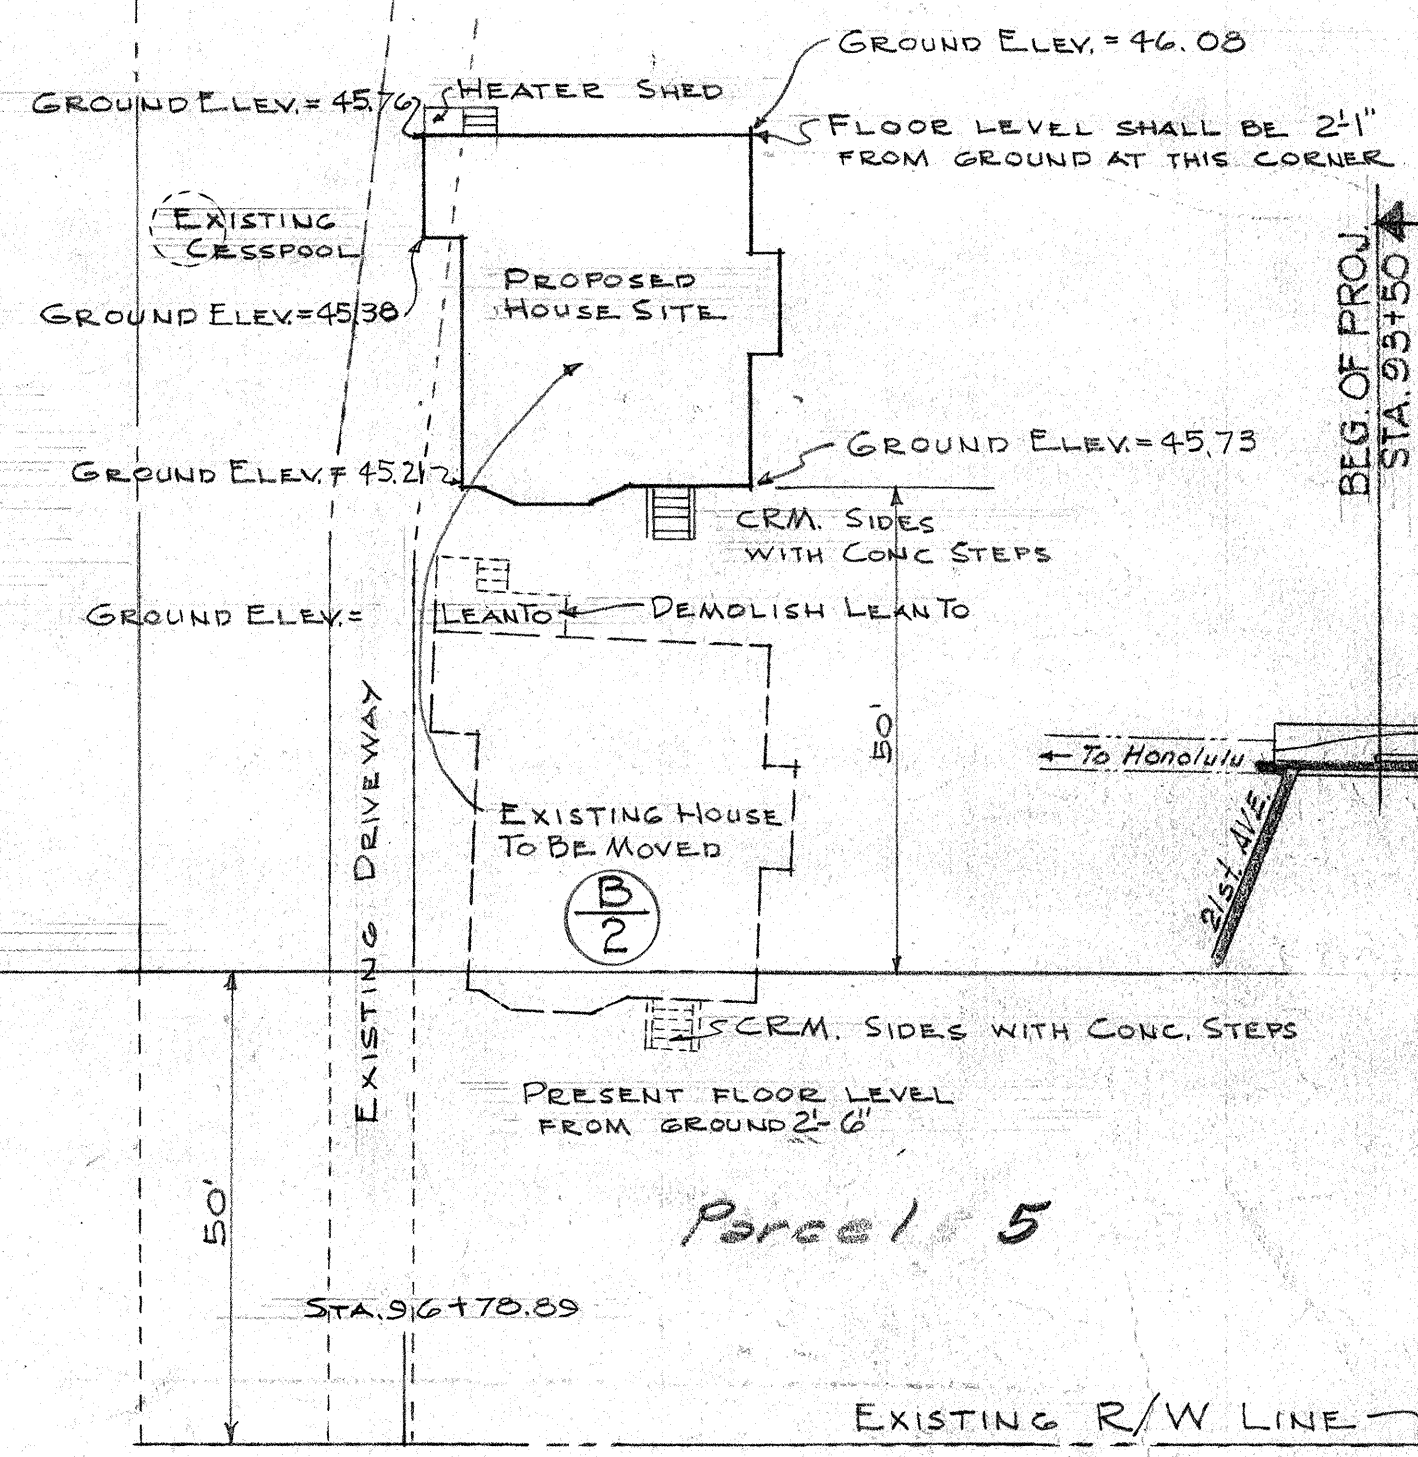

NOTE:
ALL CHANGES MADE DURING CONSTRUCTION HAVE BEEN NOTED IN RED IN THESE TRACINGS AND CHECKED BY: *J. J. J.*
PROJECT ENGINEER
DATE: 1/6/53

TERRITORIAL HIGHWAY DEPARTMENT
TERRITORY OF HAWAII
RELOCATION AND DEMOLITION OF CERTAIN FRAME BUILDINGS AND OTHER IMPROVEMENTS OUTSIDE THE NEW HIGHWAY RIGHTS-OF-WAY REQUIRED FOR THE WIDENING OF KALANIANA'OLE HWY, PROJECT NO FG (17)
Scale: As Noted
SHEET NO. 1 OF 6 SHEETS

5622.1

GROUND ELEV. = 52.27

FLOOR LEVEL SHALL BE 2'-1" FROM GROUND AT THIS CORNER

CONC. LANDING

GROUND ELEV. = 51.96

[illegible]

PROVED: Shinichi Pao.
DATE: 3/28/52

EXISTING DRIVEWAY
 GROUND ELEV. = 48.67
 EXISTING HOUSE TO BE MOVED
 EXISTING CREEPSPOOL
 (B 15)
 LEANTO
 OWNER TO MOVE LEANTO
 PRESENT FLOOR LEVEL FROM GROUND 7'-0"
 120'
 GROUND ELEV. = 44.53
 GROUND ELEV. = 45.1
 FLOOR LEVEL SHALL BE 2'-1" FROM GROUND AT THIS CORNER
 10'
 PROPOSED HOUSE SITE
 GROUND ELEV. = 44.07
 PROPOSED DRIVEWAY
 PROPOSED CREEPSPOOL
 10'
 0 0
 NEW R/W LINE
 STA. 14+68

GROUND ELEV. = 42.26

FLOOR LEVEL SHALL BE 7'-0" FROM GROUND AT THIS CORNER

GROUND ELEV. = 41.91

GROUND ELEV. = 41.88

EXISTING WASH HOUSE TO REMAIN

PROPOSED GARAGE SITE

PROPOSED HOUSE SITE

GROUND ELEV. = 40.59

EXISTING CELESTIAL POOL

GROUND ELEV. = 40.32

GROUND ELEV. = 40.38

GROUND ELEV. = 40.42

GROUND ELEV. = 41.02

PROPOSED DRIVEWAY

NEW RA

LEAN TO GARAGE

DEMOLISH LEAN TO

EXISTING GARAGE

EXISTING DRIVEWAY

EXISTING HOUSE TO BE MOVED

GROUND ELEV. = 40.29

STA. 16+00

Parcel 39

PROPOSE WASH. HSE. SITE
GROUND ELEV.=48.9
FLOOR LEVEL SHALL BE 2'-1" FROM GROUND AT THIS CORNER
NEW WASH HSE.
PROPOSED HOUSE SITE
PROPOSED CESSPOOL 10'
GROUND ELEV. 43.2
EXISTING WASH HOUSE TO BE MOVED
GROUND ELEV.=37.2
EXISTING HOUSE TO BE MOVED
GROUND ELEV.=33.8
PRESENT FLOOR LEVEL FROM GROUND 6'-0"

GROUND ELEV.=47.4
GROUND ELEV.=46.5
GROUND ELEV.=45.12
GROUND ELEV.=43.5
GROUND ELEV.=42.8
GROUND ELEV.=42.5
PROPOSED DRIVEWAY
EXISTING GARAGE TO REMAIN
KIWEE
ORANGE
GROUND ELEV.=37.8
EXISTING HOUSE TO BE MOVED
GROUND ELEV.=34.1
PRESENT FLOOR LEVEL FROM GROUND 4'-6"
EXISTING CESSPOOL
STA. 20+38
Parcel 44
EXISTING R/W LINE

GROUND ELEV.=45.7
PROPOSED HOUSE SITE
FLOOR LEVEL SHALL BE 2'-1" FROM GROUND AT THIS CORNER
GROUND ELEV.=47.6
PROPOSED CESSPOOL 10'
GROUND ELEV.=45.4
PROPOSED HOUSE SITE
GROUND ELEV.=42.2
EXISTING HOUSE TO REMAIN
PROPOSED CESSPOOL 10'
GROUND ELEV.=40.2
EXISTING WASH HOUSE TO BE MOVED
GROUND ELEV.=35.6
SOUR SAP EXISTING CESSPOOL
GROUND ELEV.=32.0
Parcel 46

GROUND ELEV.=43.2
FLOOR LEVEL SHALL BE 2'-1" FROM GROUND AT THIS CORNER
GROUND ELEV.=43.1
GROUND ELEV.=41.3
GROUND ELEV.=39.4
GROUND ELEV.=35.9
GROUND ELEV.=32.3
GROUND ELEV.=35.8
GROUND ELEV.=28.6
GROUND ELEV.=31.7
PRESENT FLOOR LEVEL FROM GROUND 4'-5"
Parcel 47
STA. 22+95


FLOOR LEVEL SHALL BE 2'-1" FROM GROUND AT THIS CORNER
FLOOR LEVEL SHALL BE 2'-1" FROM GROUND AT THIS CORNER
CONC. LANDING
KIWEE
GROUND ELEV.=40.5
EXISTING HOUSE TO REMAIN
GROUND ELEV.=34.7
SOUR SAP
PROPOSED CESSPOOL 10'
EXISTING HOUSE TO BE MOVED
GROUND ELEV.=27.2
EXISTING DRIVEWAY
EXISTING CESSPOOL

NEW R/W LINE

APPROVED: Shinichi Pao.
DATE: 3/28/52

BY AGREEMENT WITH THE CONTRACTOR THE OWNER DELETED THIS WASH-HOUSE AND BATH-TUB IN THE MAIN HOUSE.

APPROVED : Adeline Ferreira
DATE : 3/27/12

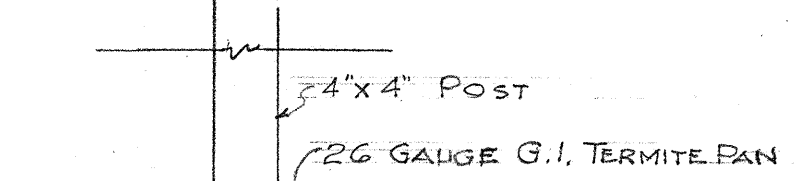


TERRITORIAL HIGHWAY DEPARTMENT
TERRITORY OF HAWAII

RELOCATION AND DEMOLITION OF
CERTAIN FRAME BUILDINGS AND OTHER
IMPROVEMENTS OUTSIDE THE NEW
HIGHWAY RIGHTS-OF-WAY REQUIRED
FOR THE WIDENING OF
KALANIANA'OLE HWY., PROJECT NO. F G (17)


Scale: As Noted Sept. 1952

5622.2


ORIGINAL PLAN	SURVEY PLOTTED BY _____	DATE _____
	DESIGNED BY _____	" _____
	DRAWN BY _____	" _____
	TRACED BY _____	" _____
NOTE BOOK No. _____	QUANTITIES BY _____	" _____
	QUANTITIES CHECKED BY _____	" _____
	CHECKED BY _____	" _____

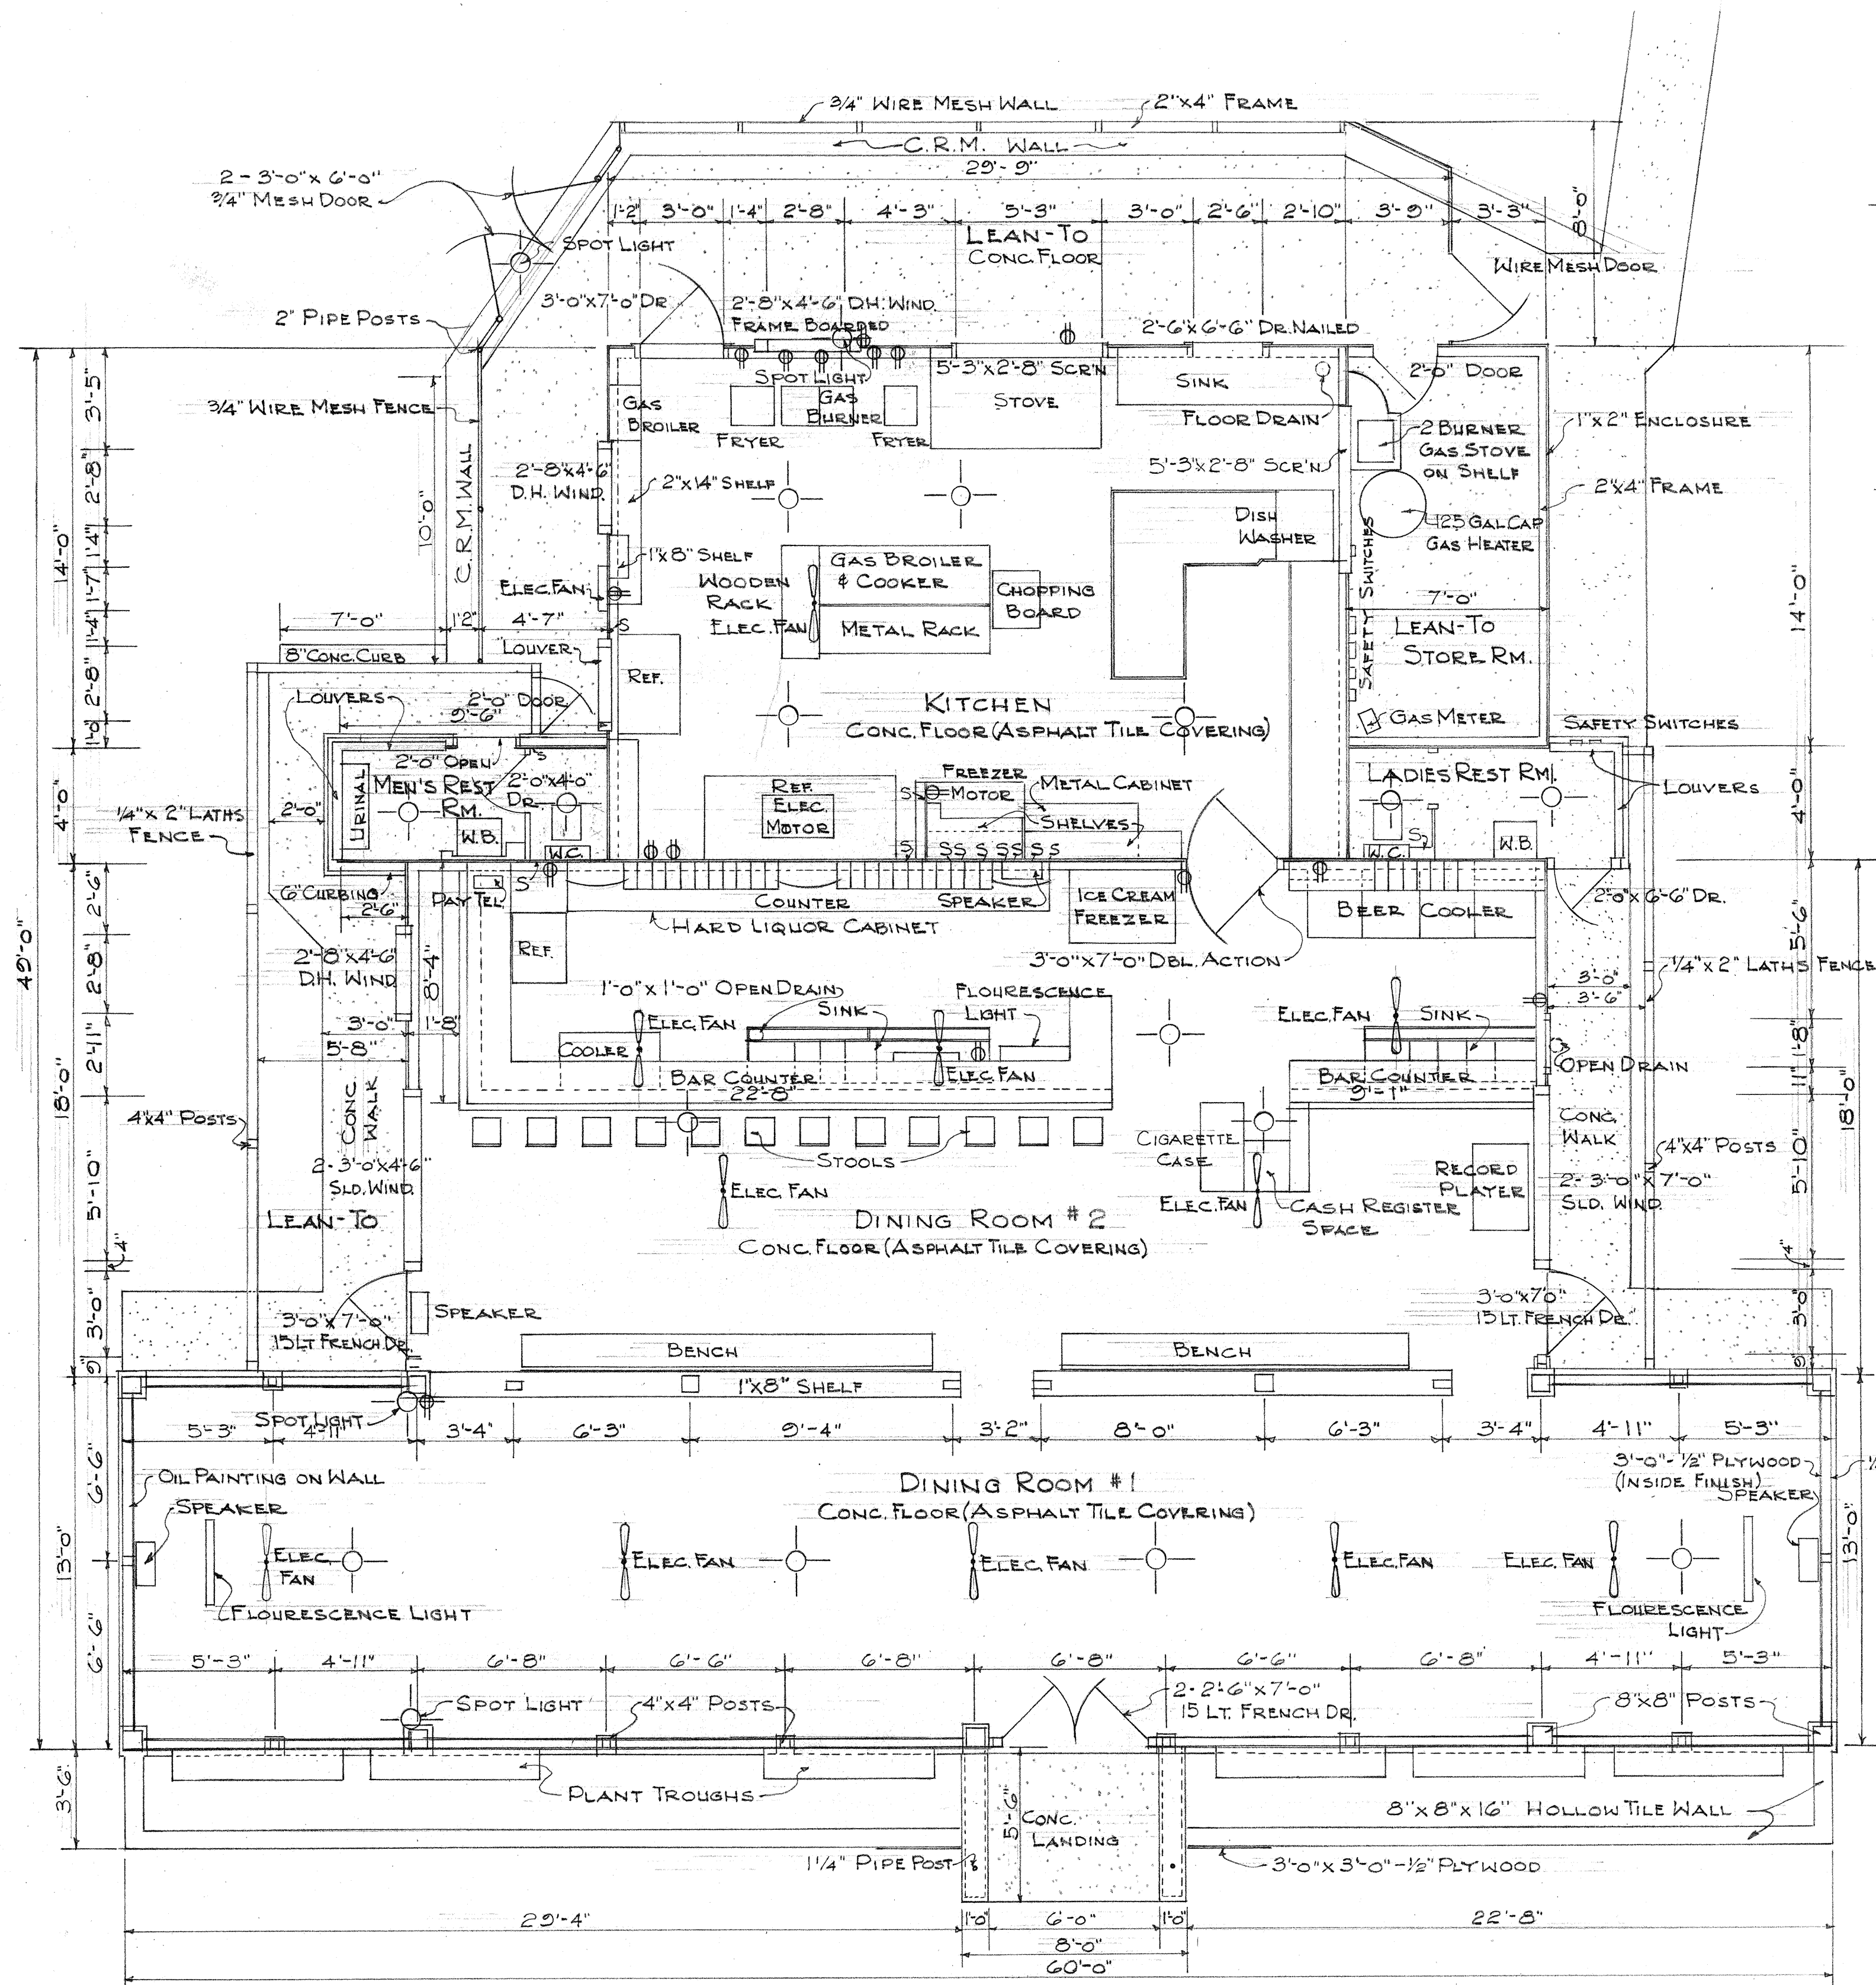


FLOOR PLAN
SCALE: 1/4" = 1'-0"

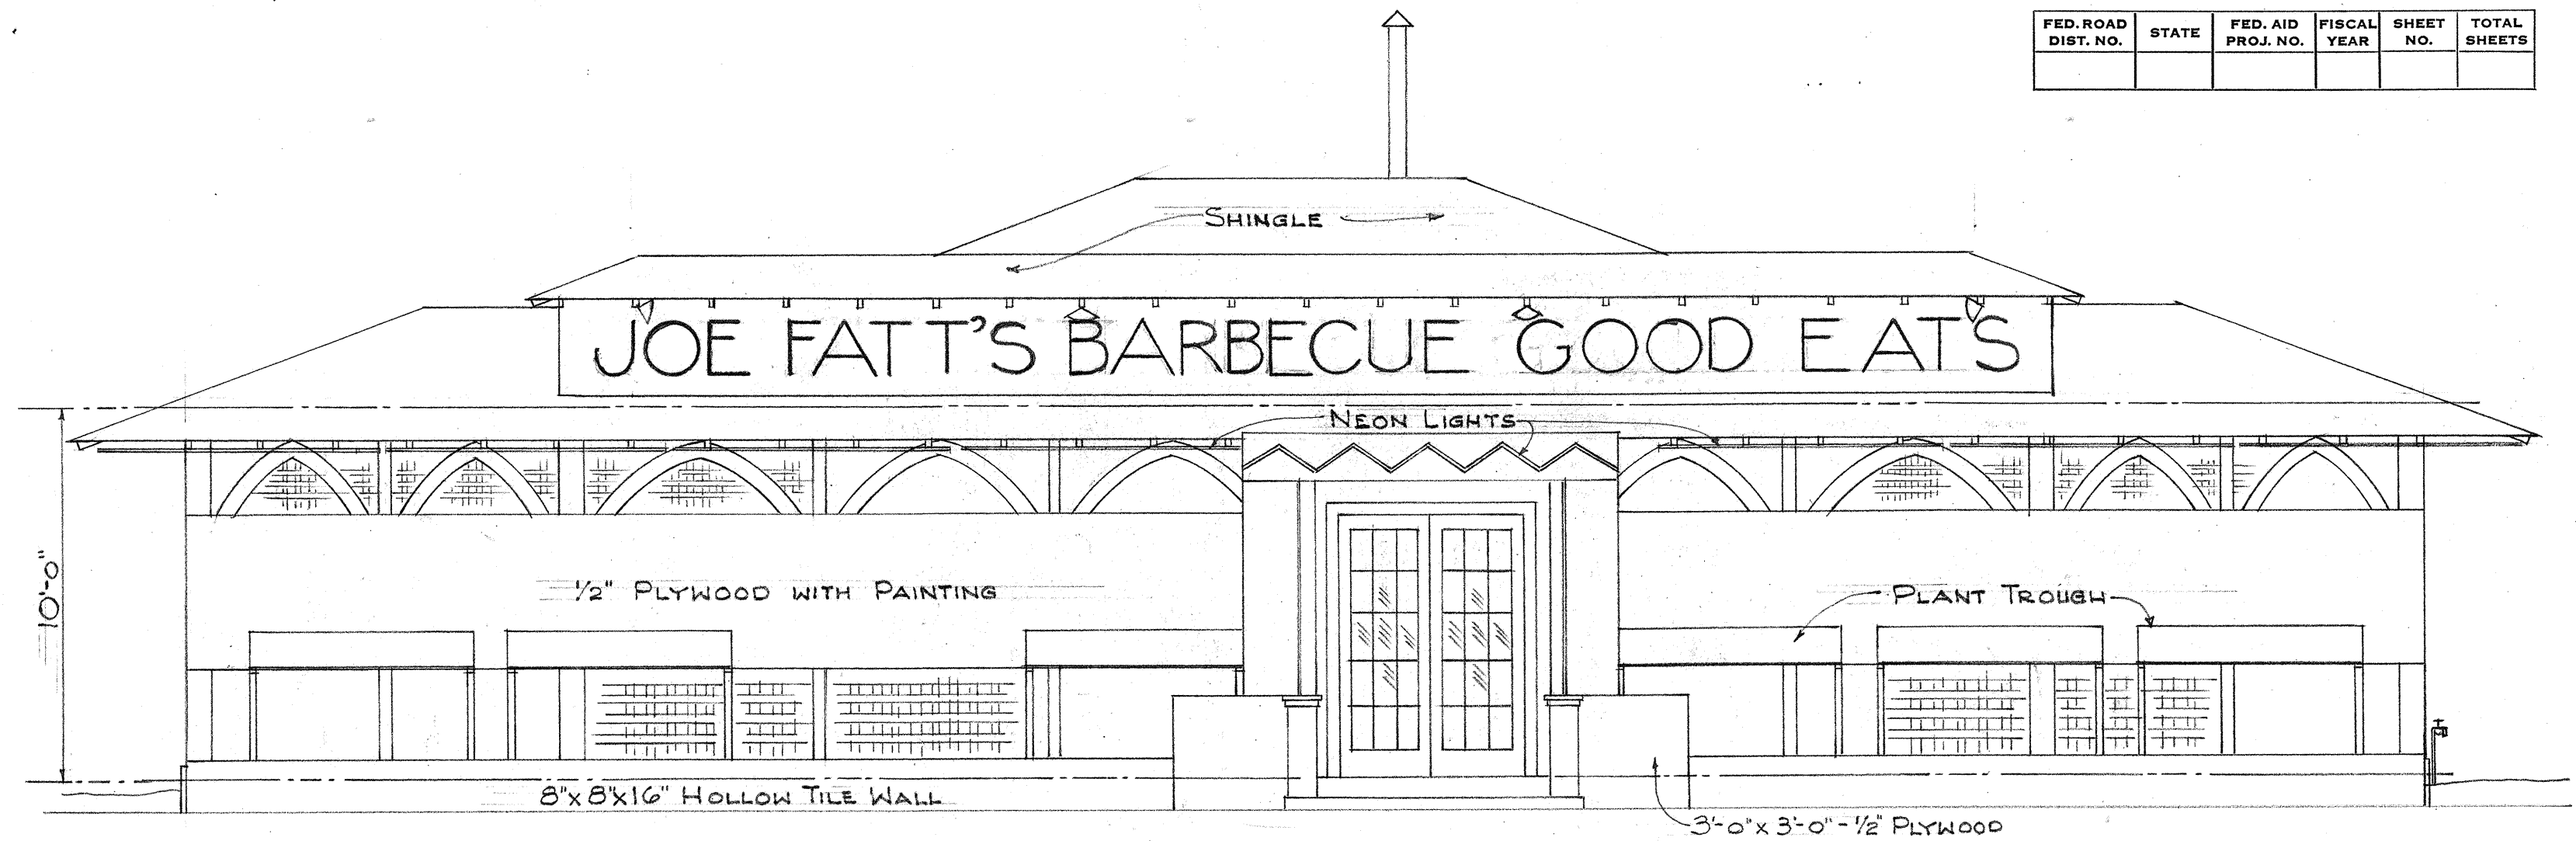

FRONT ELEVATION
SCALE: 1/4" = 1'-0"

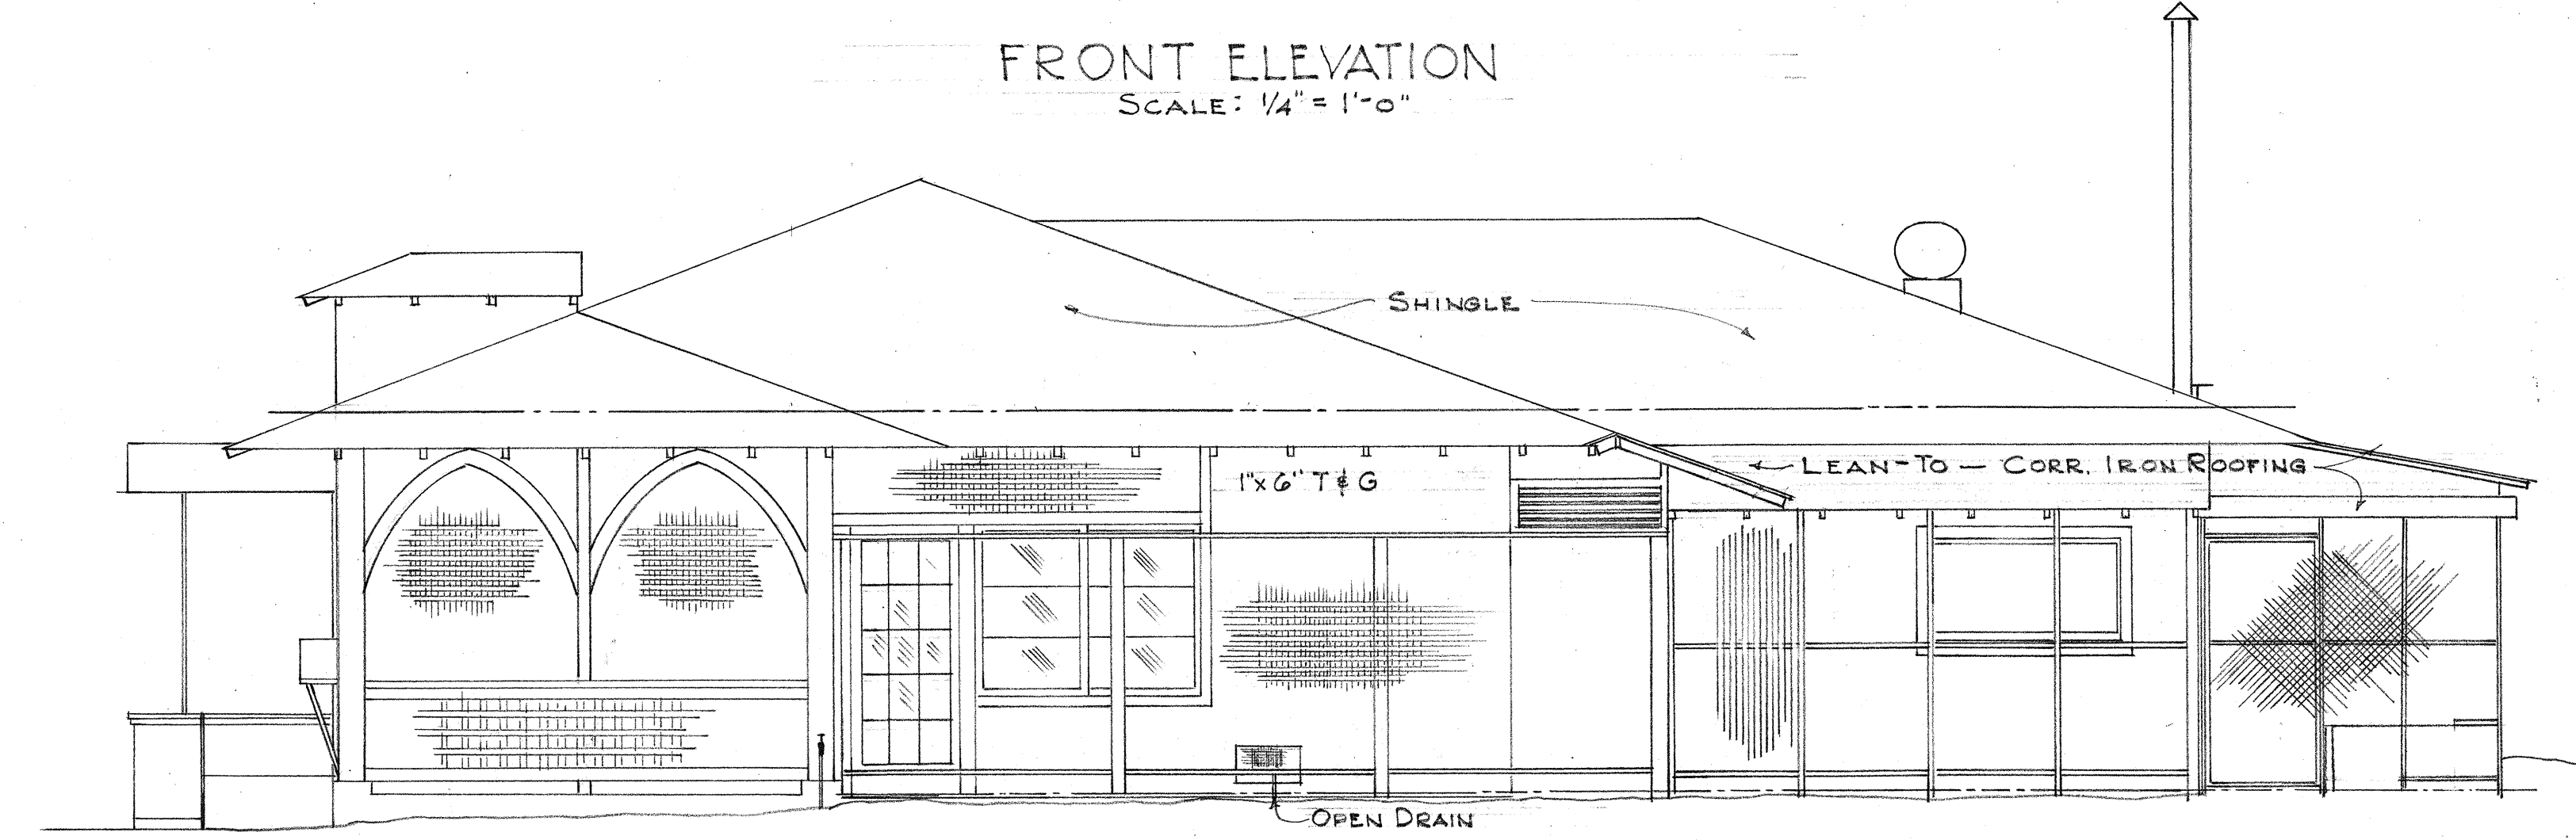

RIGHT SIDE ELEVATION
SCALE: 1/4" = 1'-0"

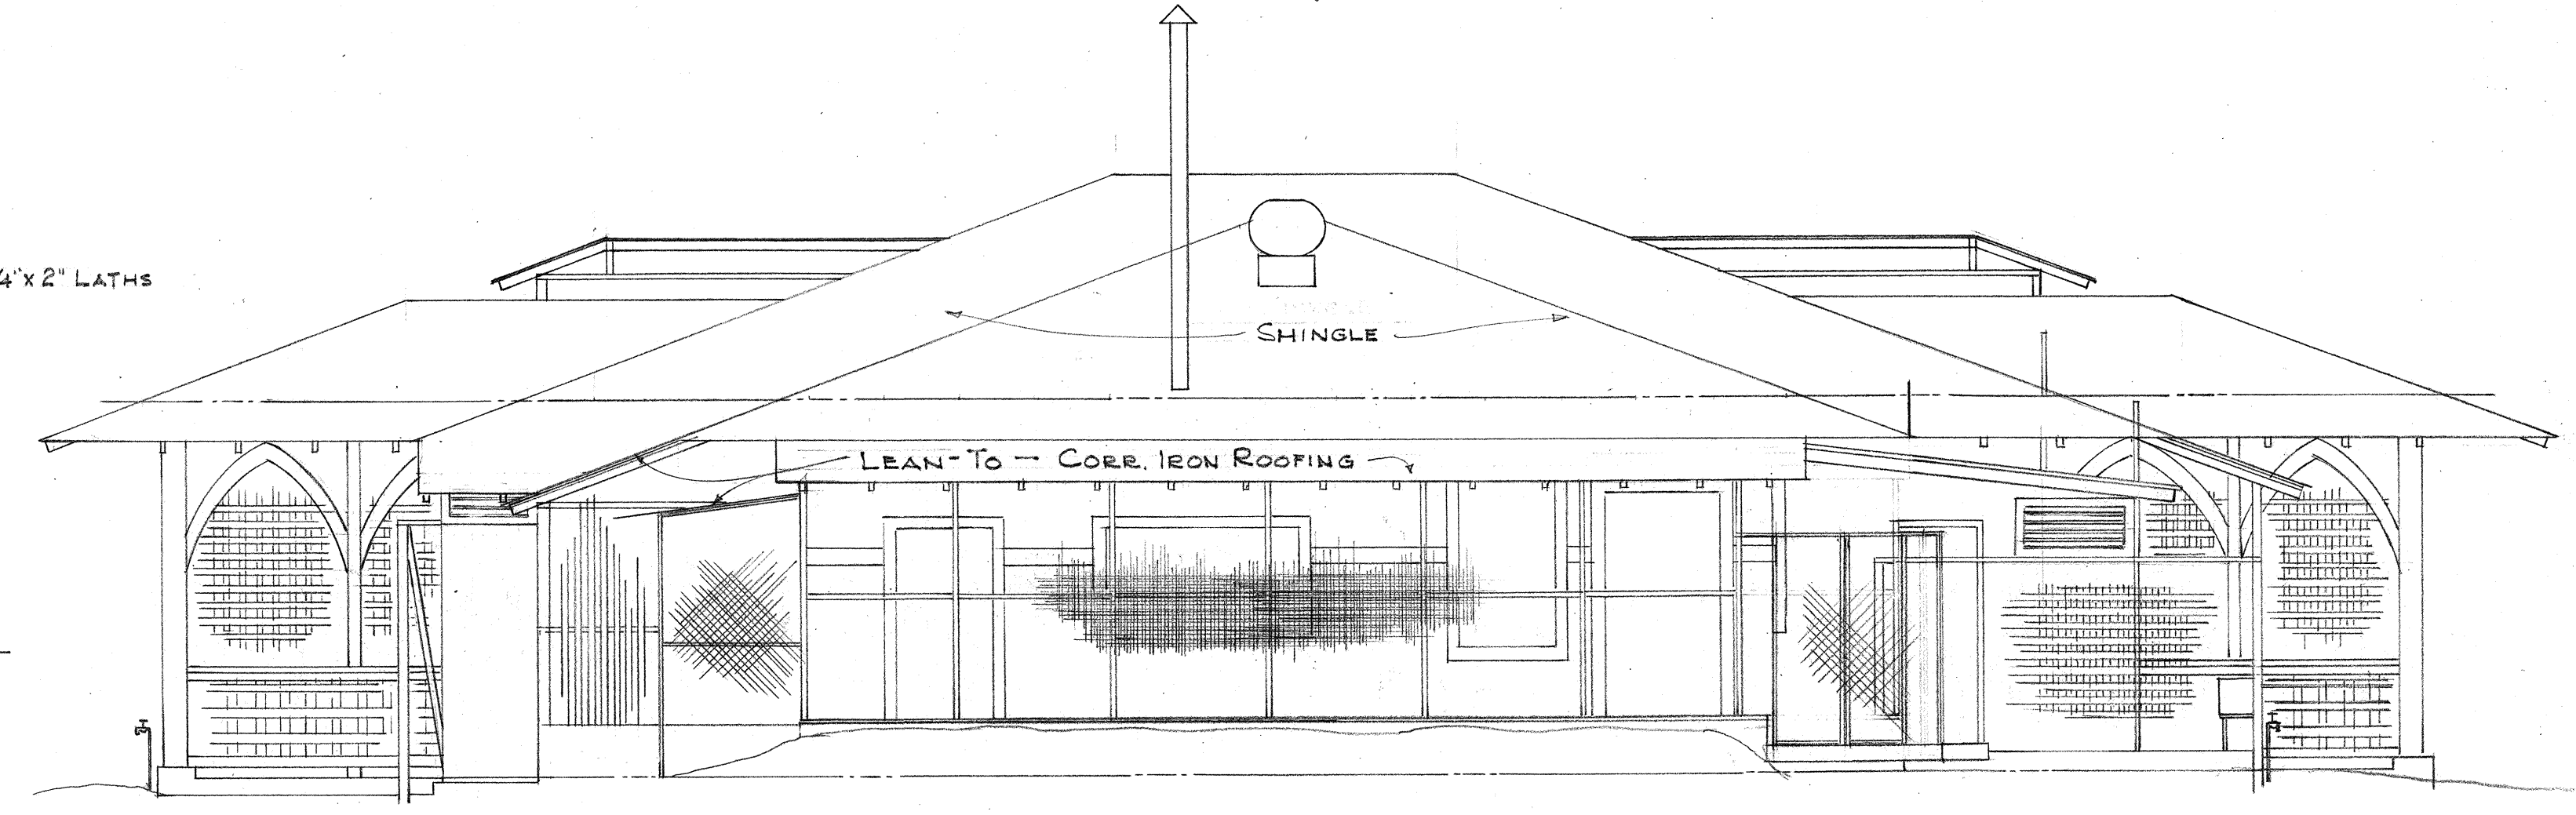

REAR ELEVATION
SCALE: 1/4" = 1'-0"

APPROVED: *[Signature]* 1/2/52
By *[Signature]* Date

TERRITORIAL HIGHWAY DEPARTMENT
TERRITORY OF HAWAII
RELOCATION AND DEMOLITION OF CERTAIN FRAME BUILDINGS AND OTHER IMPROVEMENTS OUTSIDE THE NEW HIGHWAY RIGHTS-OF-WAY REQUIRED FOR THE WIDENING OF KALANIANAOLE HWY, PROJECT No. F G (17)
Scale: As Shown Sept. 1952

SHEET NO. 3 OF 6 SHEETS


5622.3

DATE: _____
DESIGNED BY: _____
DRAWN BY: _____
CHECKED BY: _____
NOTED BY: _____
QUANTITIES CHECKED BY: _____

Architectural drawing of a house with a gabled roof. Annotations include:

- LEAN-TO - CORE. IRON ROOFING?
- SHINGLE
- LEAN-TO - COMPOSITION MINERAL PAPER ROOFING

NOTE: ELEVATIONS THUS SHOWN ON THIS DRAWING ARE EXISTING.
NEW FLOOR ELEVATION FOR BUILDING B-14 SHALL BE ELEV. 430'.
BARBECUE PIT, SIMILAR TO EXISTING SHALL BE CONSTRUCTED BY THE CONTRACTOR ON THE PROPOSED SITE.
ELEVATION OF BUILDING B-13A SHALL HAVE A MINIMUM OF 20" BETWEEN THE BOTTOM OF JOISTS OF THE LOWER FLOOR AND THE HIGHER POINT OF GROUND THEREUNDER.

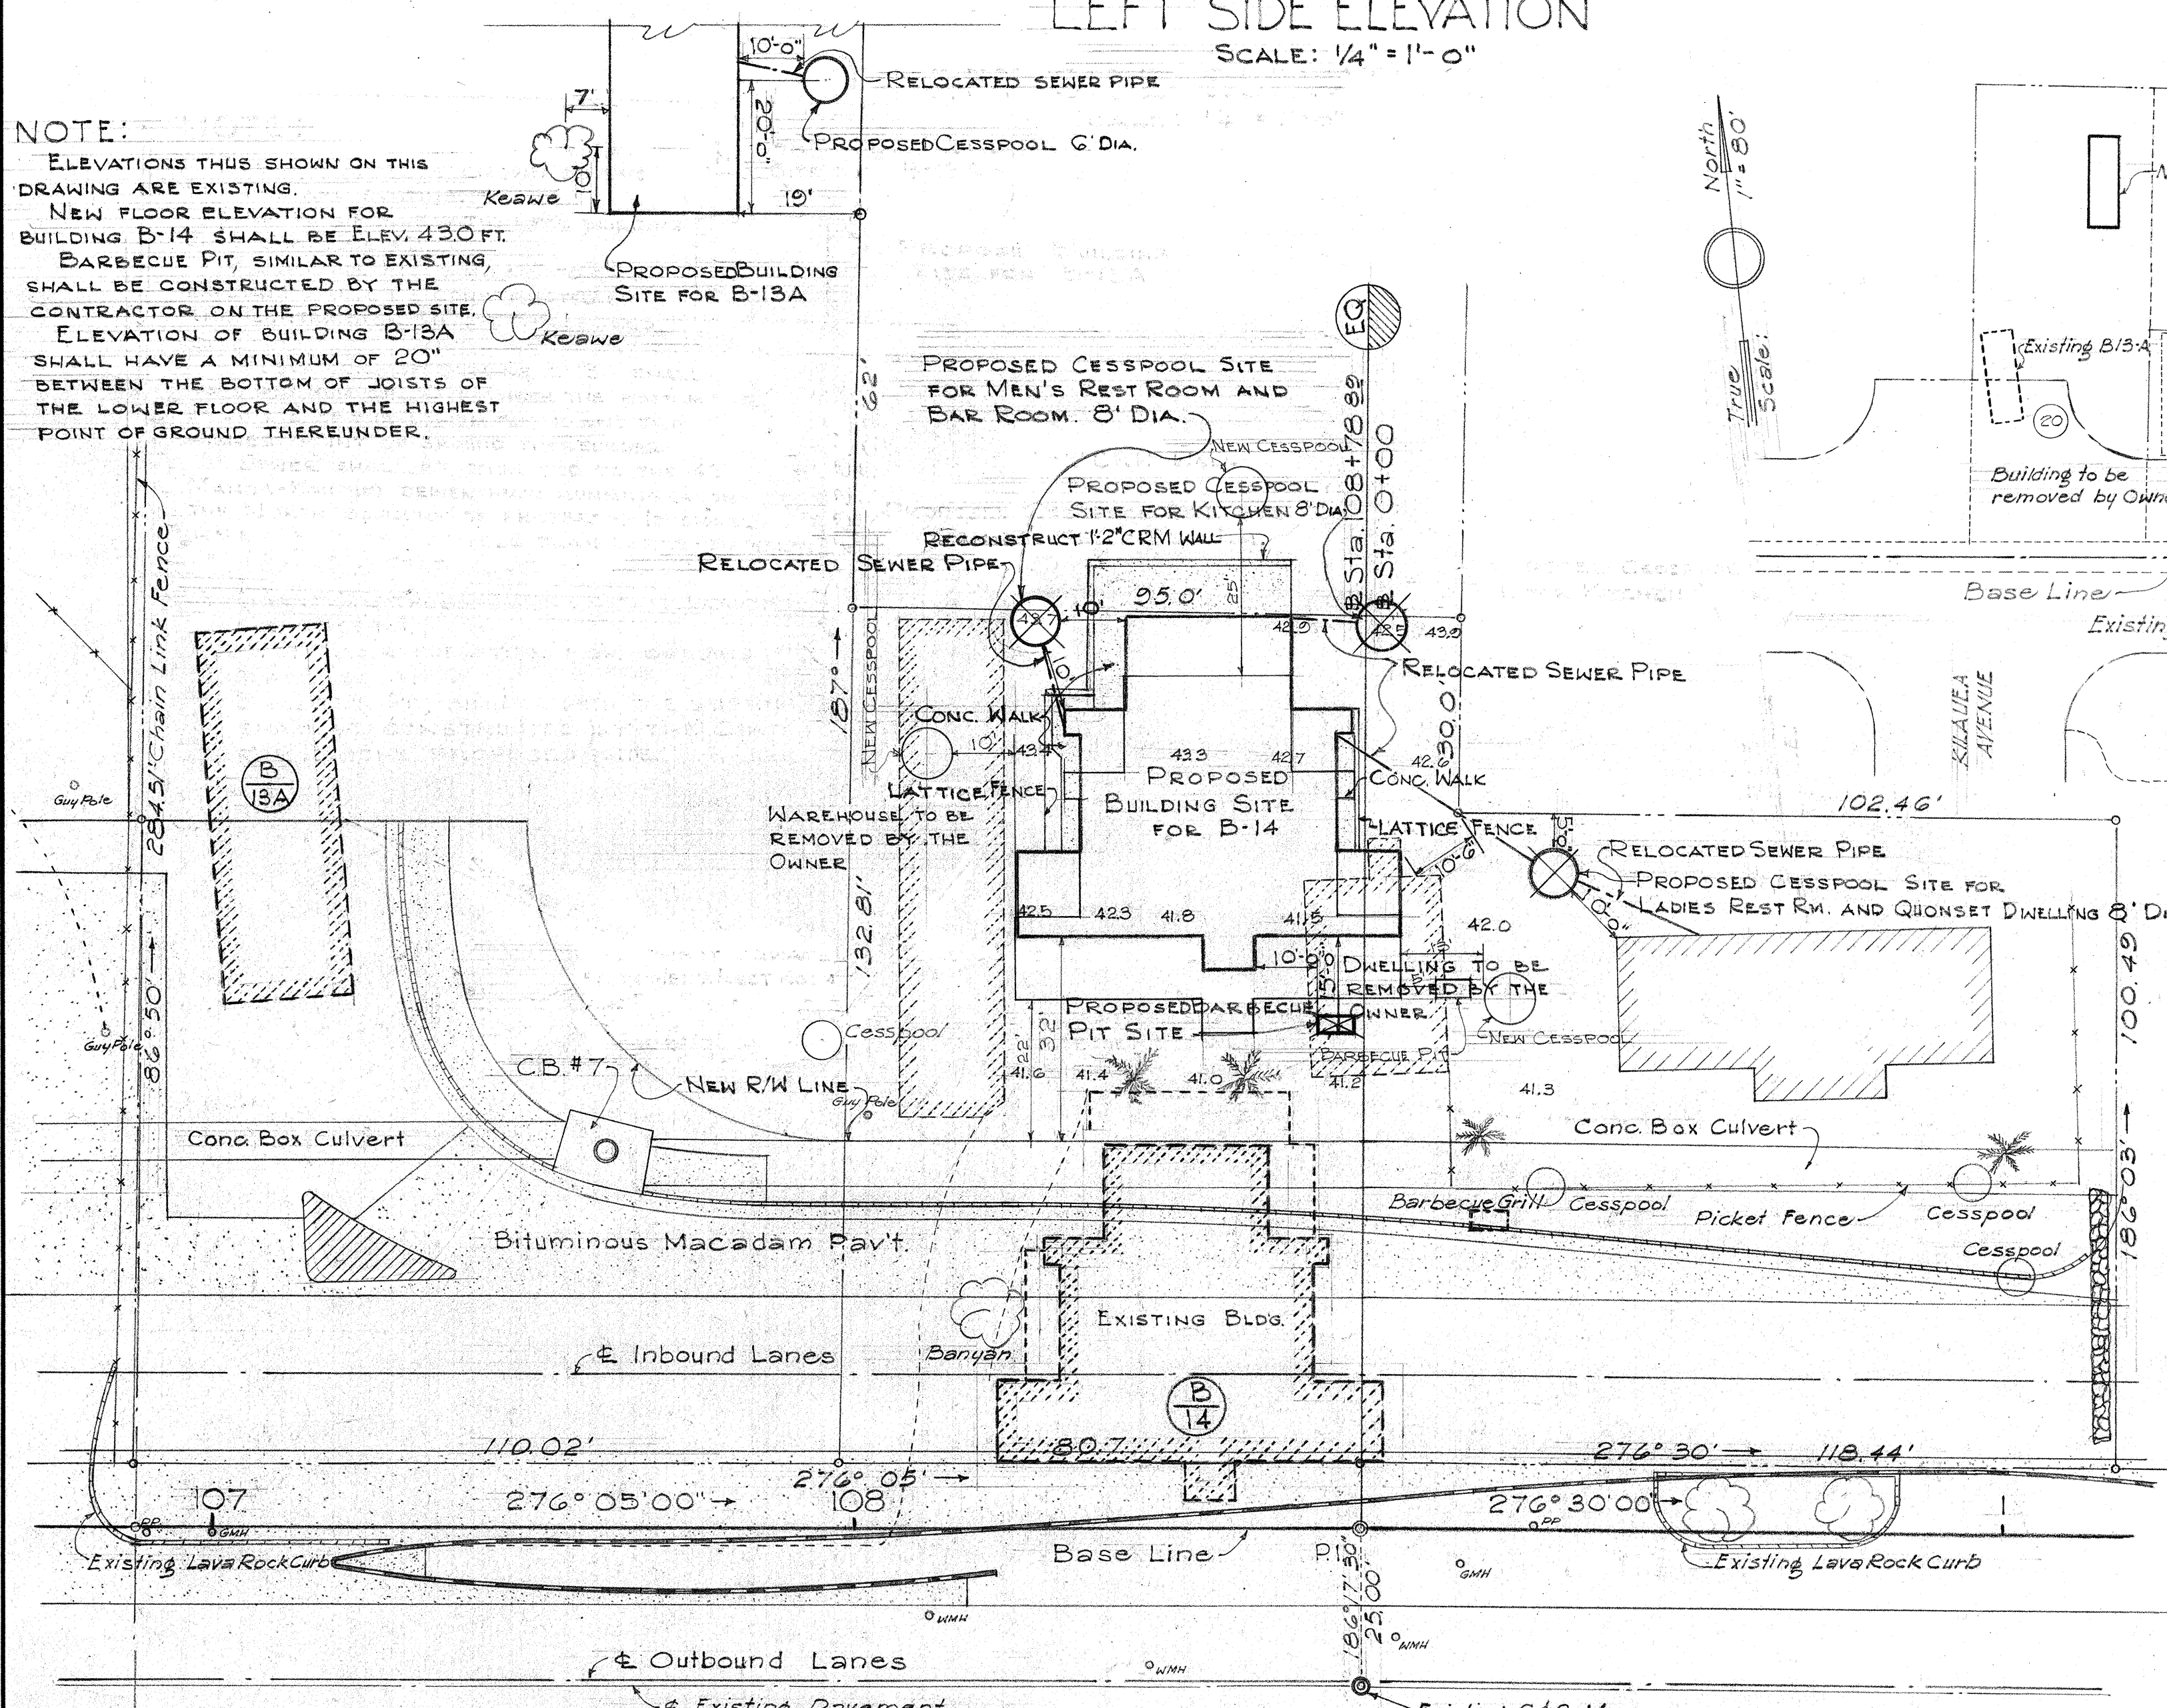

North
1" = 80'

True Scale: 1" = 80'

New Location B13A

New Location B14

Existing B13A

Dwelling to remain

Building to be removed by Owner

Existing B14

Base Line

Existing Edge of Pavt.

Existing CTC Men

KALANIANA'OLE HWY.

KEALAOLU AVE.

KILAUEA AVENUE

102.46'

LOCATION PLAN

1" = 80'

"A"

LEAN-TO (CORR. IRON ROOFING)
TO BE REMOVED BY THE OWNER

SHINGLE

LEAN-TO (COMPOSITION
MINERAL PAPER ROOFING)
TO BE REMOVED BY THE
OWNER.

2"x4" RAFTER

SHINGLE

1" x 6" T&G CEILING

6"x12" BEAM

8"x 8" POST

1/4"x2" LATHS

1/2" PLYWOOD

2"x 4"

3"x 4"

1/2"x 2 1/2" L

4"x 4"

12"x 4"x 12" CONC FLOOR LINE

[illegible]

COUNTERTOP DETAIL

APPROVED: *[Signature]* 11/2/02
B7 Date:

RELOCATION AND DEMOLITION OF
CERTAIN FRAME BUILDINGS AND OTHER
IMPROVEMENTS OUTSIDE THE NEW
HIGHWAY RIGHTS-OF-WAY, REQUIRED
FOR THE WIDENING OF
KALANIANA'OLE HWY., PROJECT No. F G (17)


Scale: As Noted Sept. 1952

SHEET No. 4 OF 6 SHEETS


5622.4

" No. 195T K&E CO., N.Y. "


FED. ROAD DIST. NO.	STATE	FED. AID PROJ. NO.	FISCAL YEAR	SHEET NO.	TOTAL SHEETS

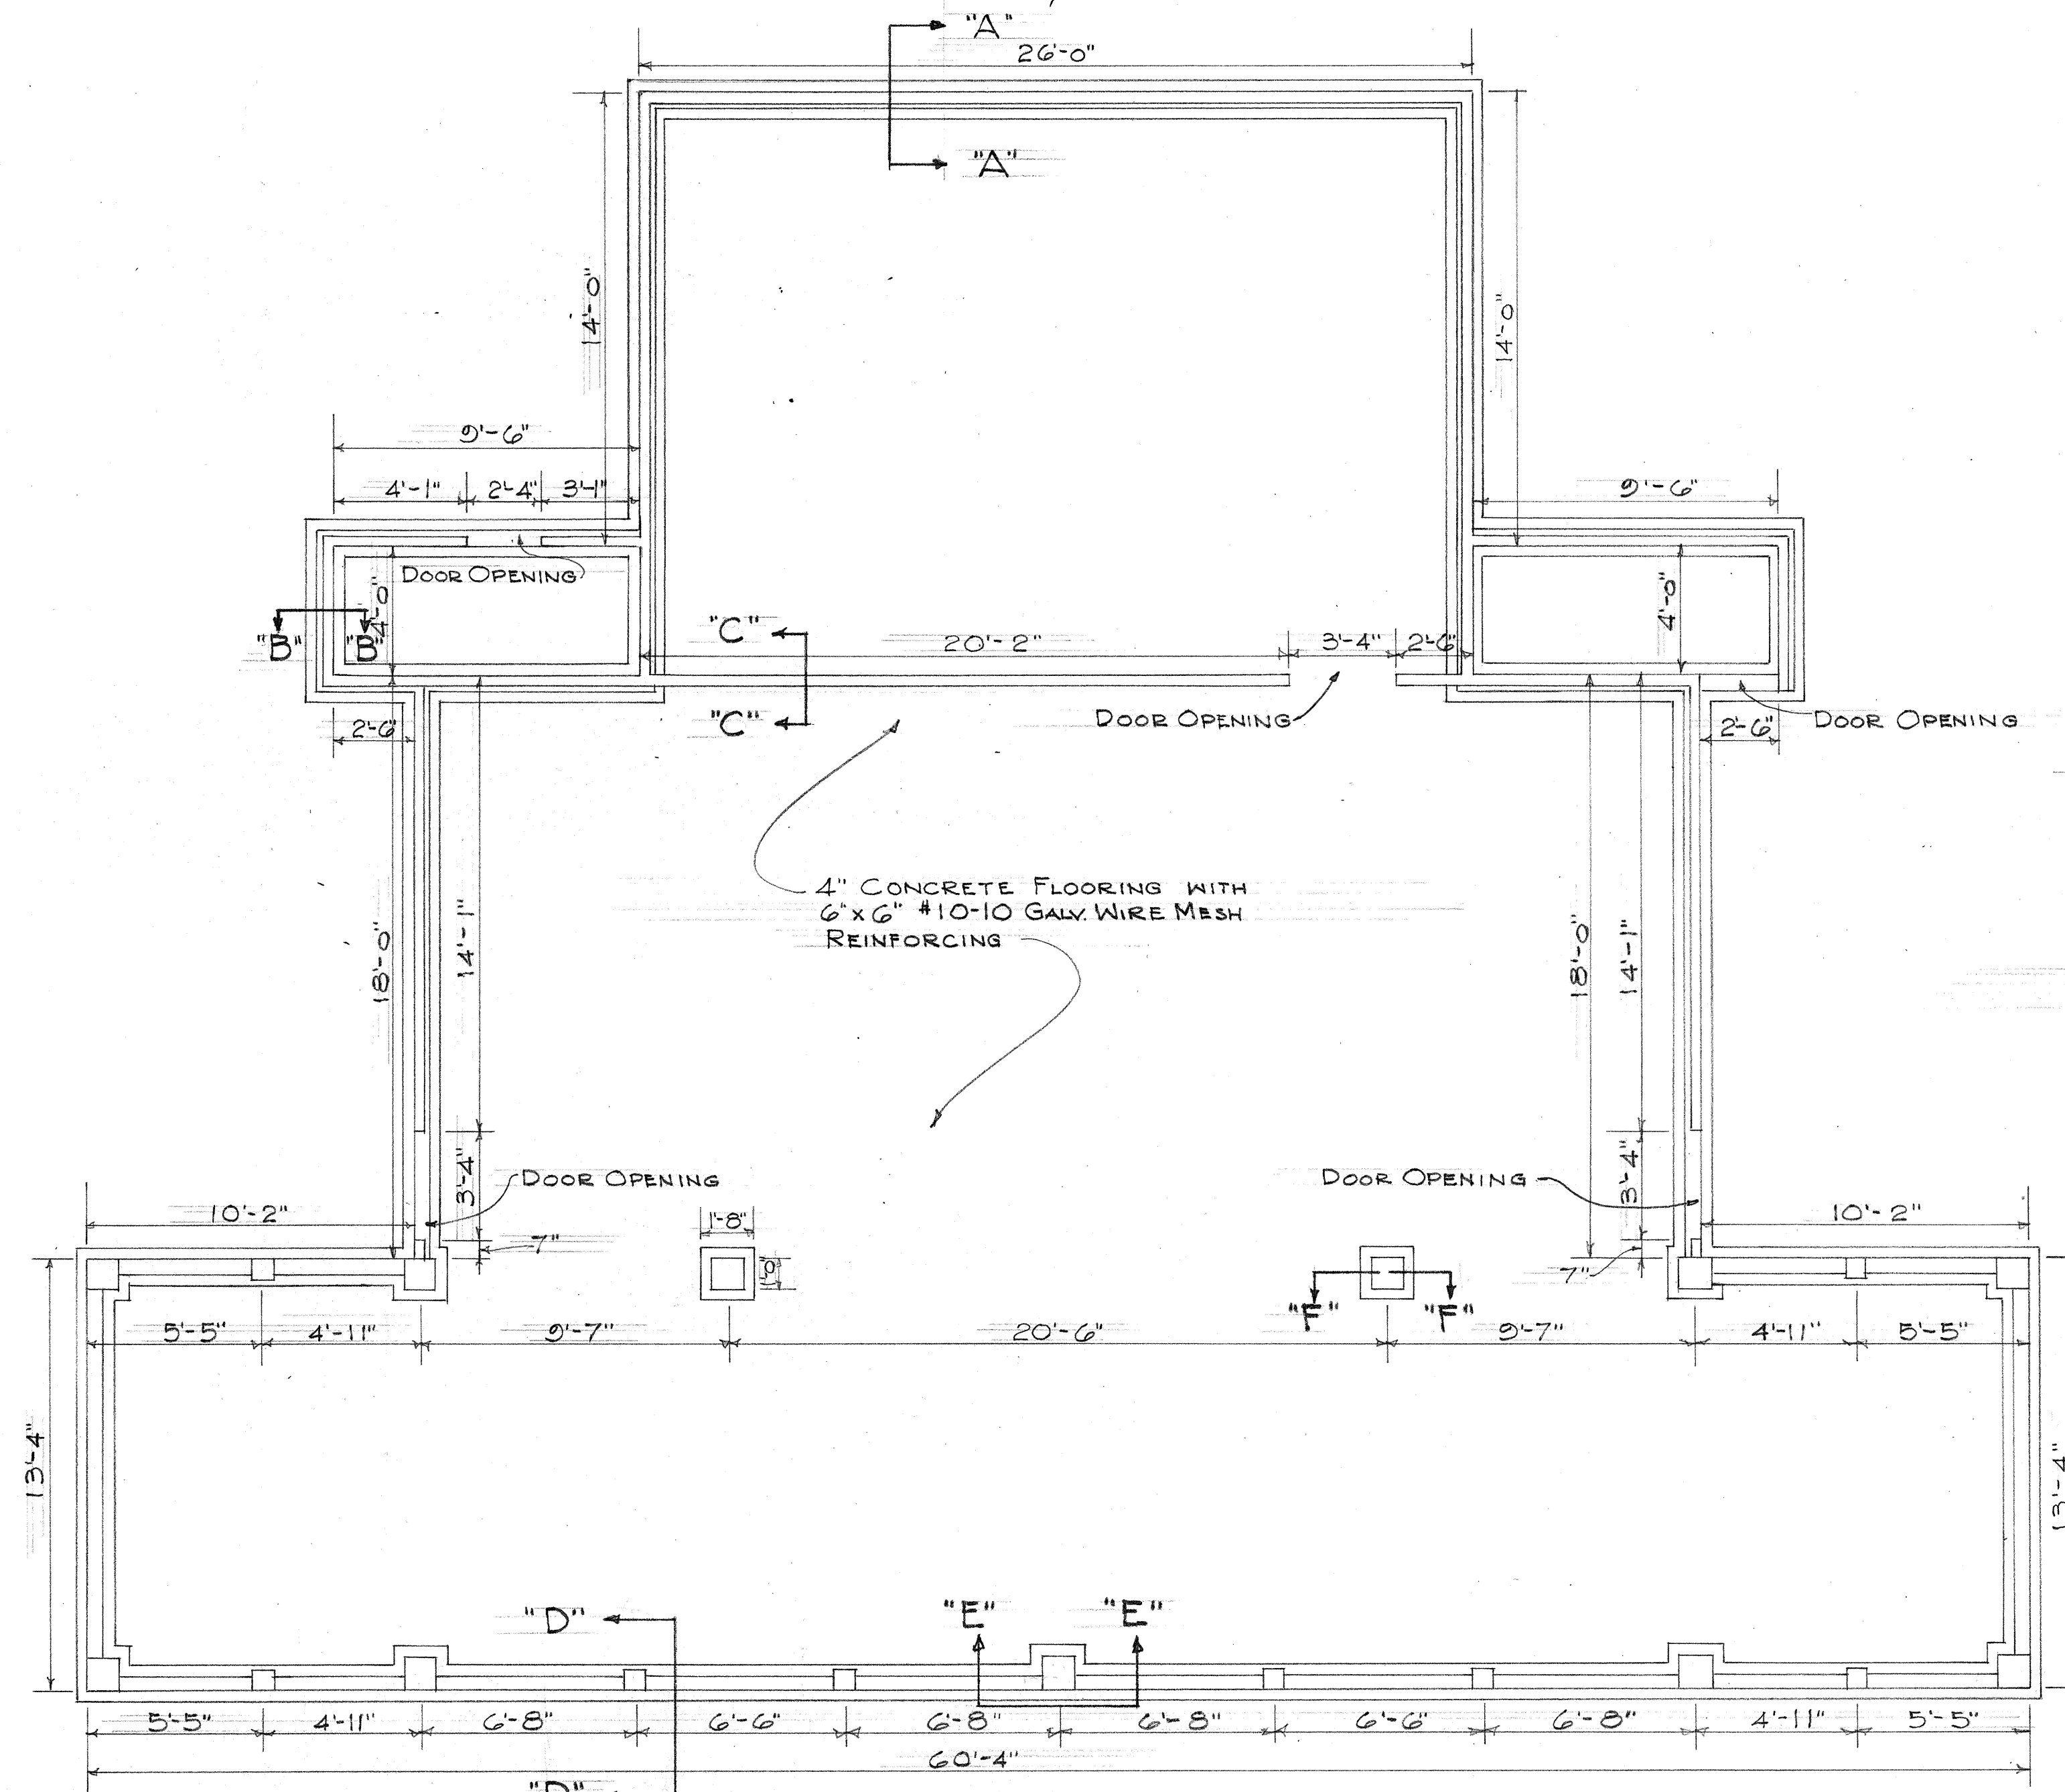


FOUNDATION PLAN
SCALE: 1/4" = 1'-0"

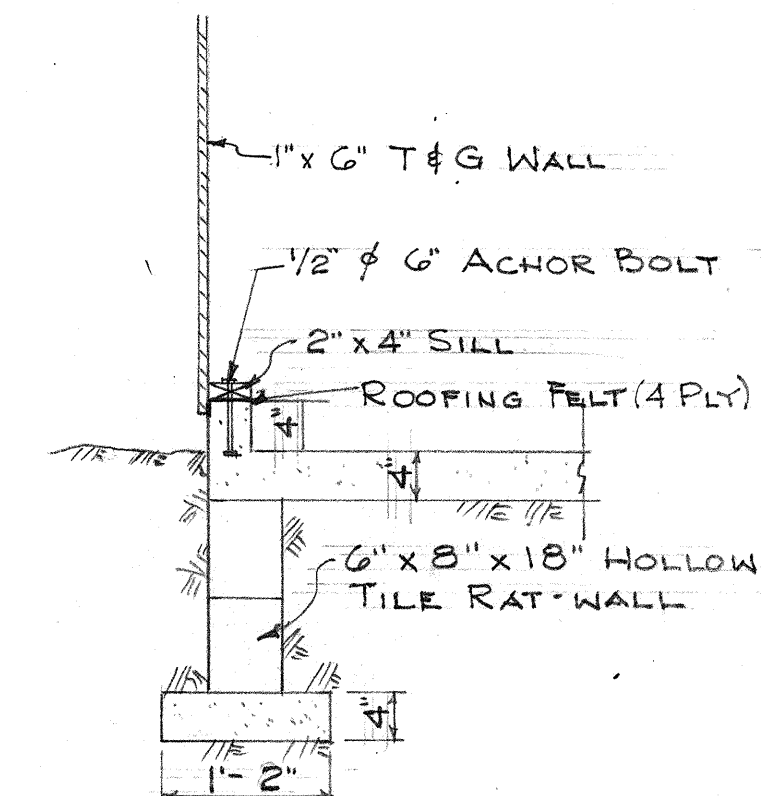


DETAIL OF SECTION "A"-A
SCALE: 3/4" = 1'-0"

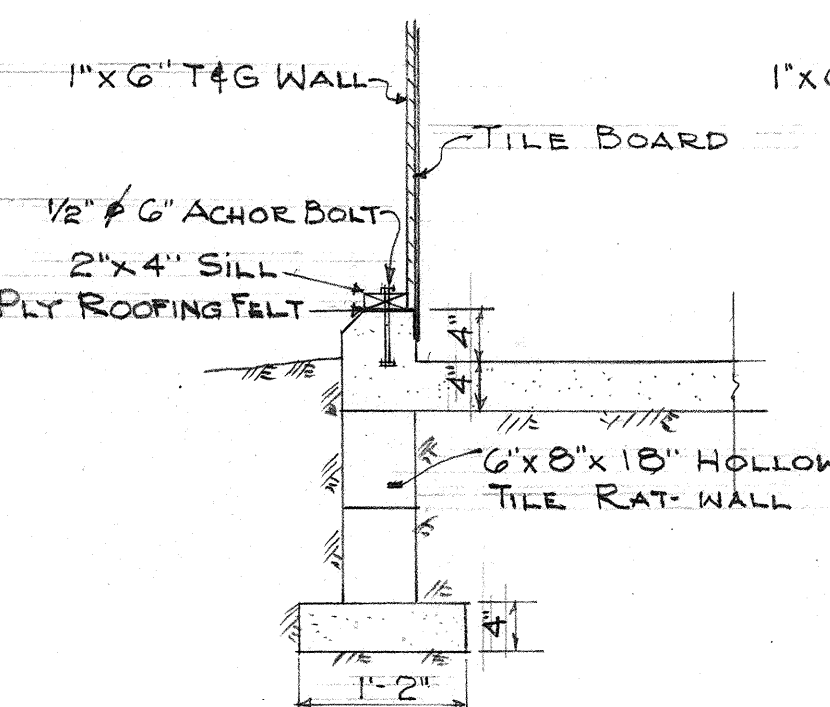


DETAIL OF SECTION "B"-B
SCALE: 3/4" = 1'-0"

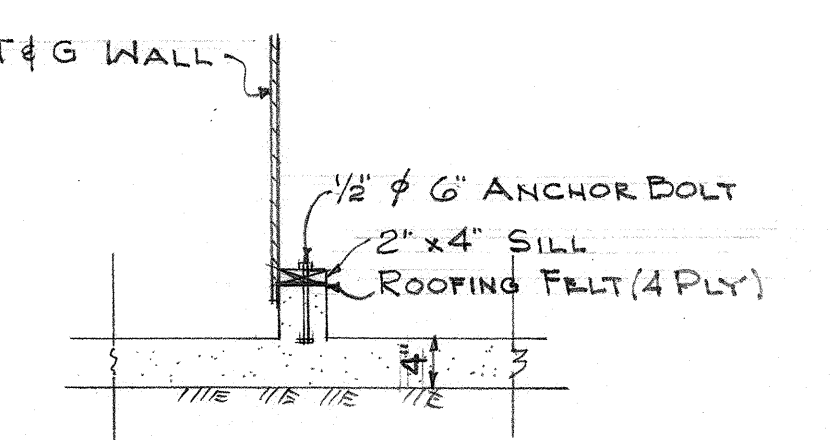


DETAIL OF SECTION "C"-C
SCALE: 3/4" = 1'-0"

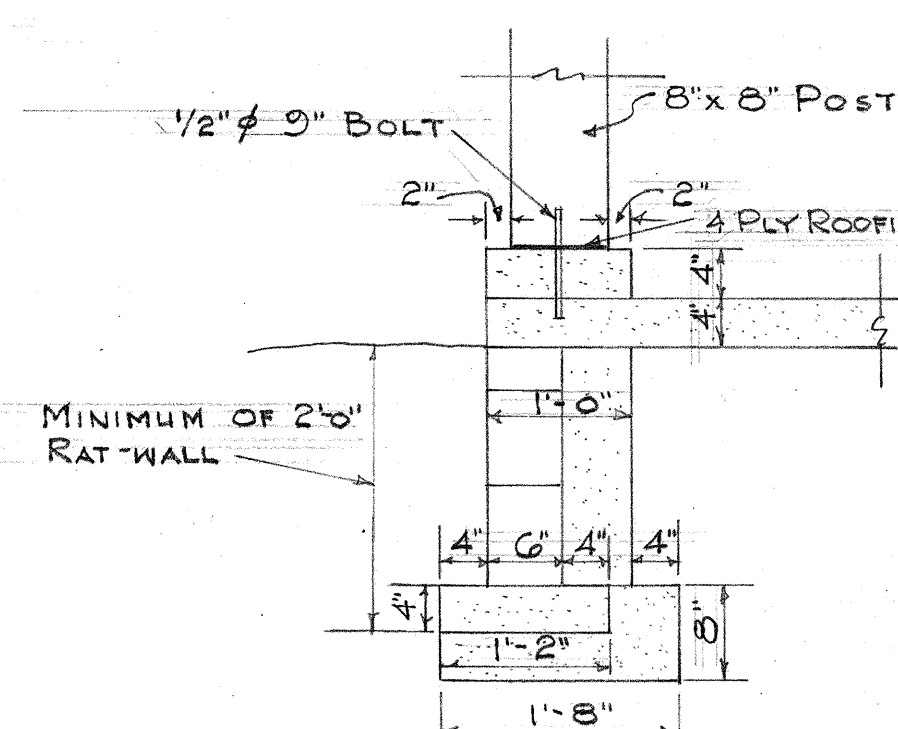

DETAIL OF SECTION "D"-D
SCALE: 3/4" = 1'-0"

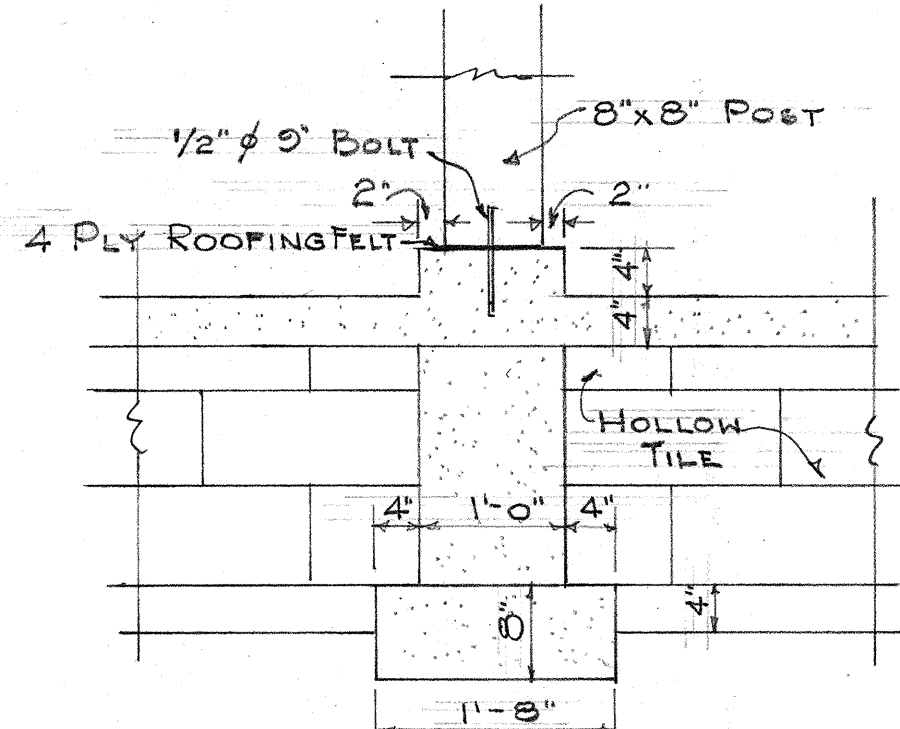

DETAIL OF SECTION "E"-E
SCALE: 3/4" = 1'-0"

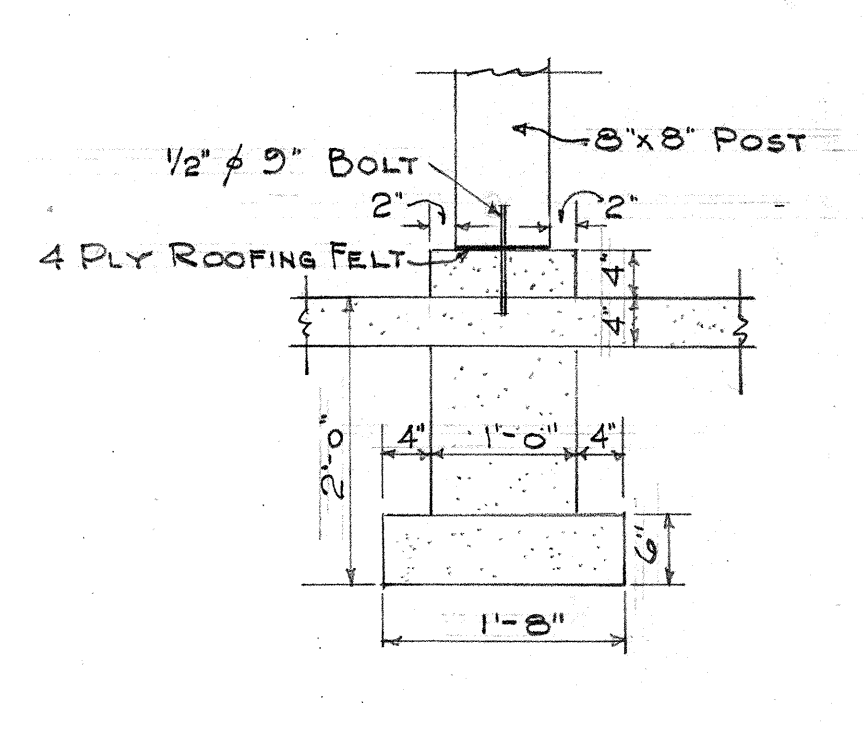

DETAIL OF SECTION "F"-F
SCALE: 3/4" = 1'-0"

NOTE:
CONTRACTOR SHALL CHECK AND VERIFY ALL DIMENSIONS ON JOB AND BE RESPONSIBLE FOR THE SAME.

APPROVED: *[Signature]* 11/2/52
By *[Signature]* Date:




TERRITORIAL HIGHWAY DEPARTMENT
TERRITORY OF HAWAII
RELOCATION AND DEMOLITION OF CERTAIN FRAME BUILDINGS AND OTHER IMPROVEMENTS OUTSIDE THE NEW HIGHWAY RIGHTS-OF-WAY REQUIRED FOR THE WIDENING OF KALANIANA'OLE HWY, PROJECT No. F.G. (17)
Scale: As Noted Sept. 1952

SHEET No. 5 OF 6 SHEETS

5622.5

SURVEY PLOTTED BY	DATE
DRAWN BY	...
CHECKED BY	...
QUANTITIES CHECKED BY	...
NOTE BOOK No.	

FED. ROAD DIST. NO.	STATE	FED. AID PROJ. NO.	FISCAL YEAR	SHEET NO.	TOTAL SHEETS

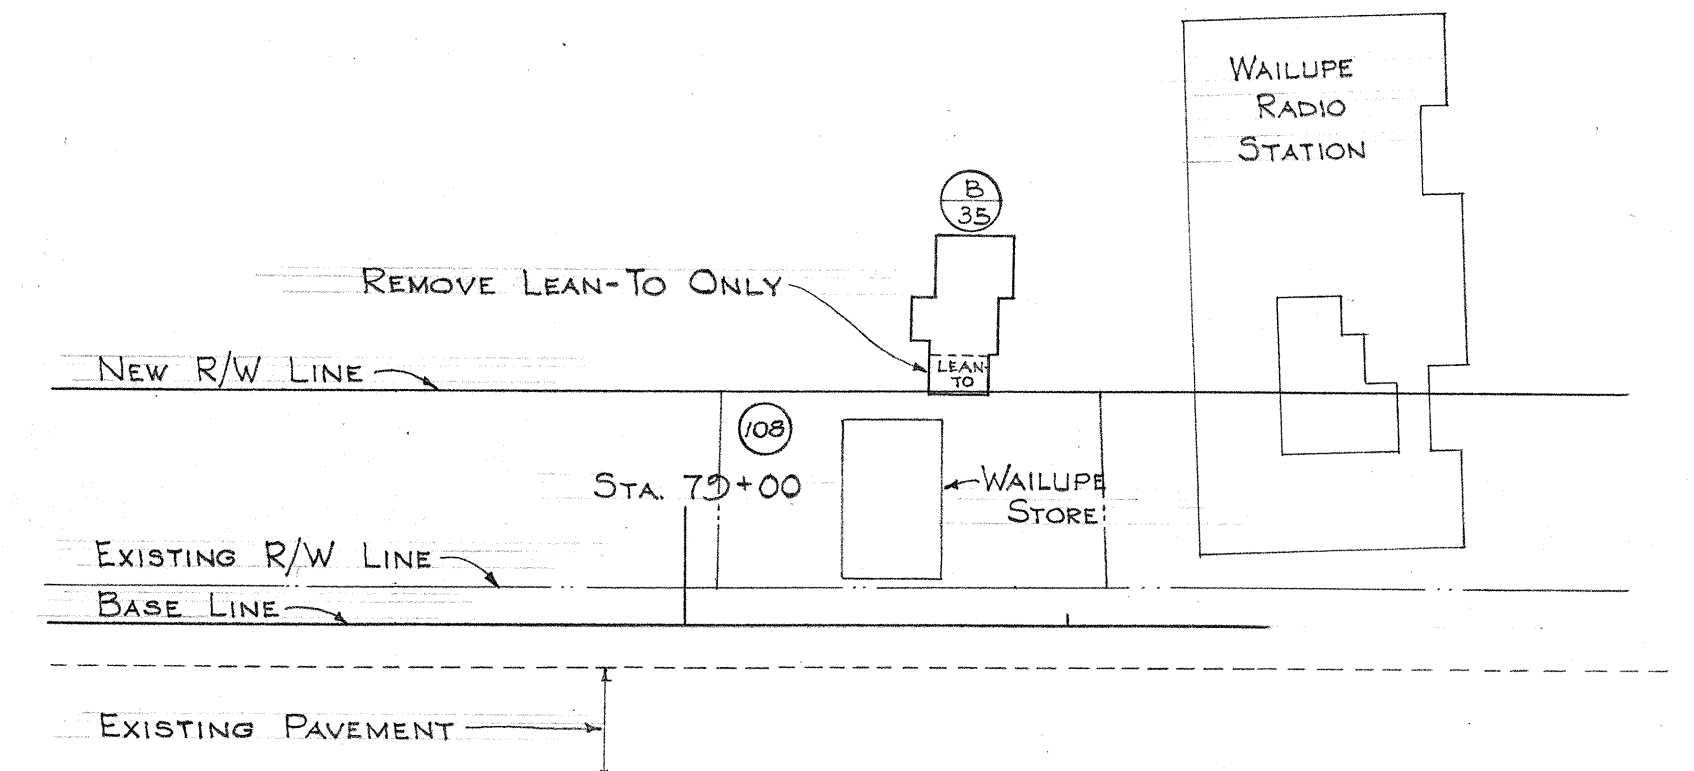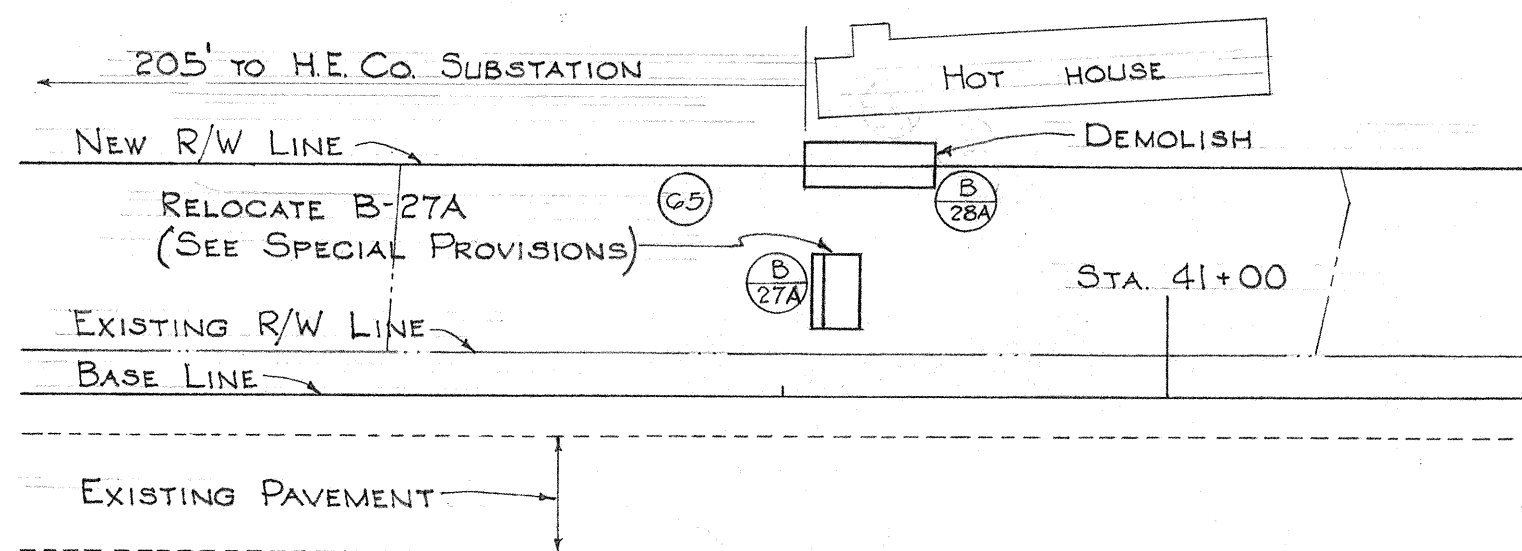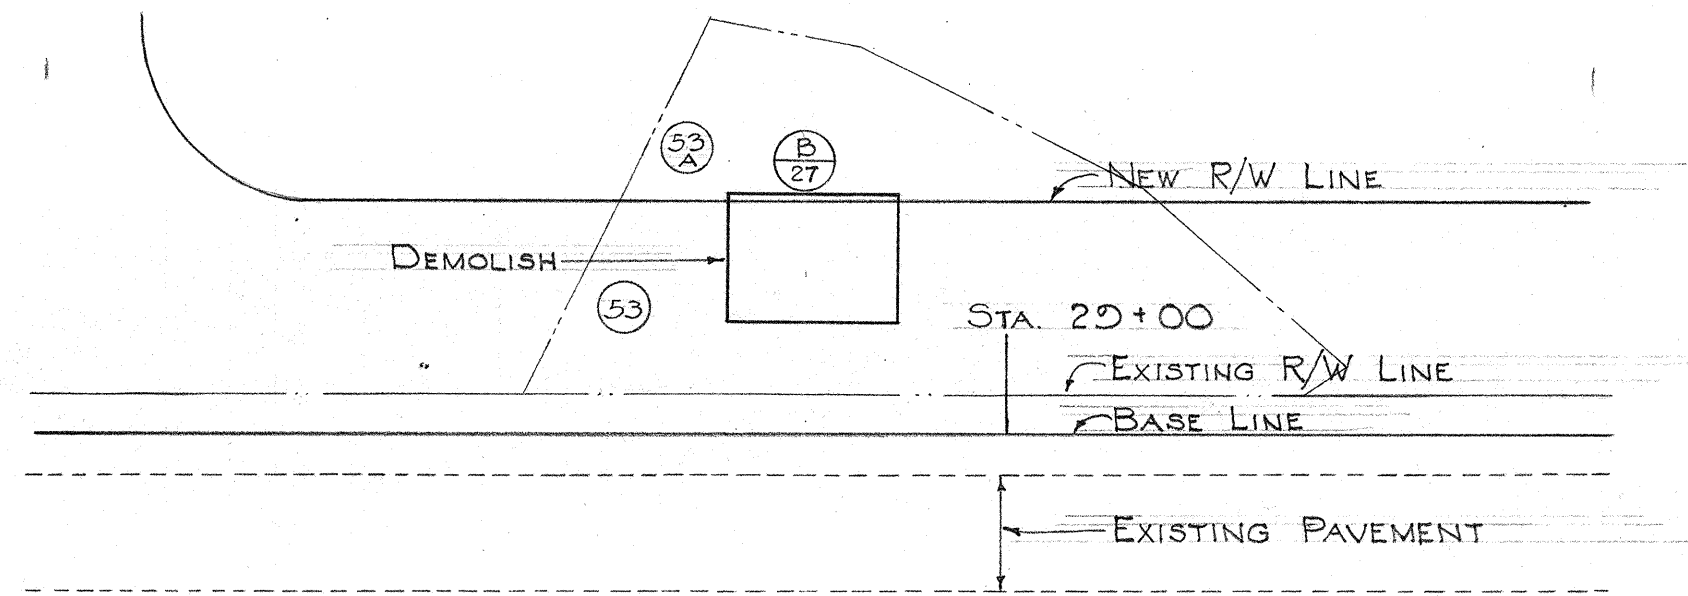

ORIGINAL PLAN	NO.
SURVEY PLOTTED BY	DATE
DESIGNED BY	"
DRAWN BY	"
CHECKED BY	"
QUANTITIES CHECKED BY	"
NOTED BY	"
CHECKED BY	"

TERRITORIAL HIGHWAY DEPARTMENT
TERRITORY OF HAWAII

RELCOATION AND DEMOLITION OF CERTAIN FRAME BUILDINGS AND OTHER IMPROVEMENTS OUTSIDE THE NEW HIGHWAY RIGHTS-OF-WAY REQUIRED FOR THE WIDENING OF KALANIANA'OLE HWY., PROJECT No. F.G. (17)

Scale: As Noted Sept. 1952

SHEET NO. 6 OF 6 SHEETS

5622.6