


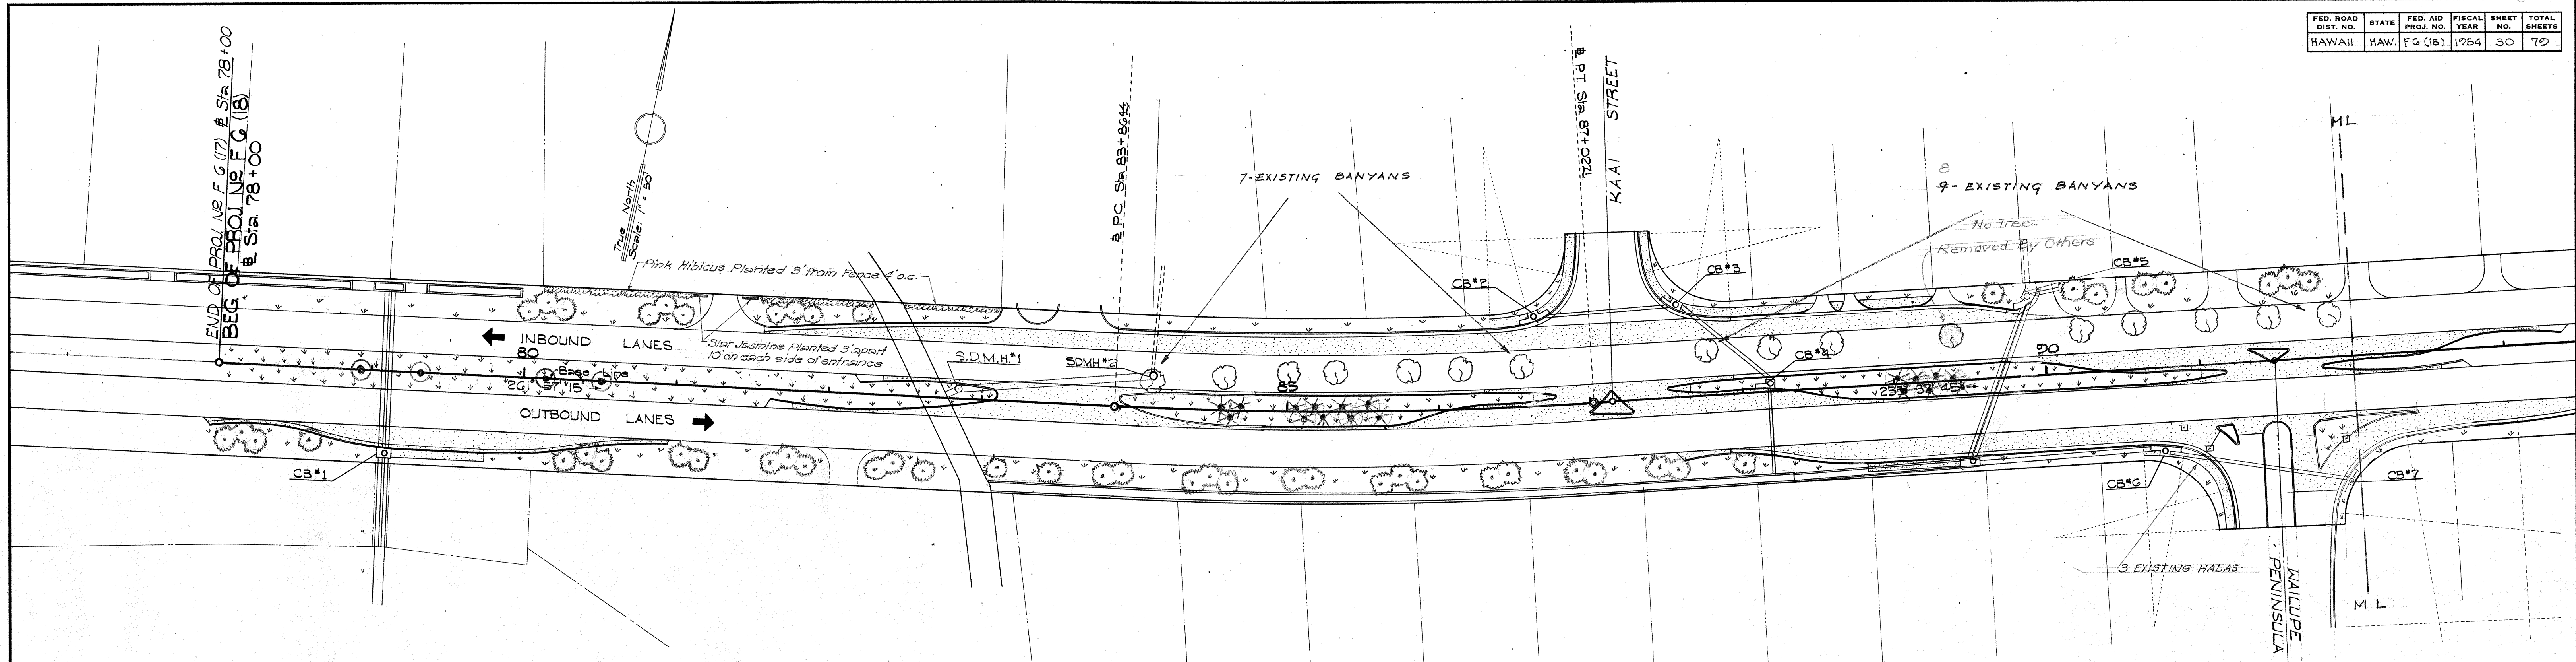

• PLANT LIST •

SYM.	BOTANICAL NAME	COMMON NAME	QUANTITIES SHOWN	QUANTITIES NEEDED	REMARKS
—	JASMINUM RUBESCENS	STAR JASMINE	8	8	1-GAL. STOCK - 10"-18" HIGH
—	HIBISCUS HYBRIDS	PINK HIBISCUS	64	64	1-GAL. STOCK - 1'-2' HIGH

NOTE

EXISTING TREES THAT WILL INTERFERE WITH THE NEW LANDSCAPING OR NEW CONSTRUCTION SHALL BE REMOVED AND DISPOSED OF OUTSIDE THE HIGHWAY RIGHT-OF-WAY AT THE CONTRACTORS EXPENSE.

• PLANT LIST •


SYM.	BOTANICAL NAME	COMMON NAME	QUANTITIES SHOWN	QUANTITIES NEEDED	REMARKS
*	COCOS NUCIFERA	COCONUT	142	56	5-GAL. STOCK - 4-6 MATURE LEAVES
•	PANDANUS ODORATISSIMUS	HALA	240	216	5-GAL. STOCK - 4'-6' TALL
•	CYNODON DACTYLON	BERMUDA GRASS			IN ALL ISLANDS, SHOULDERS, & MEDIAL STRIP
•	FICUS BENJAMINA	BENJAMINA BANYAN	24	-	SEE NOTE BELOW.

TO BE TRANSPLANTED

SYM.	BOTANICAL NAME	COMMON NAME	QUANT.	LOCATIONS
▲	COCOS NUCIFERA	COCONUT	86	EXISTING COCONUTS & HALAS TO BE TRANSPLANTED TO THE NEAREST LOCATIONS SHOWN ON PLAN
□	PANDANUS ODORATISSIMUS	HALA	24	CALLING FOR SAME TYPE OF PLANT
•	FICUS BENJAMINA	BENJAMINA BANYAN	24	SEE NOTE BELOW.

NOTE

THE 24 BANYANS ON MAUKA SIDE OF HWY. AT BEGINNING OF PROJECT SHALL BE TRANSPLANTED IN PROJ. FG(17) (SEE SHT. NO. 5686.2 TO 35) AND AT BEG. OF PROJ. FG(18)

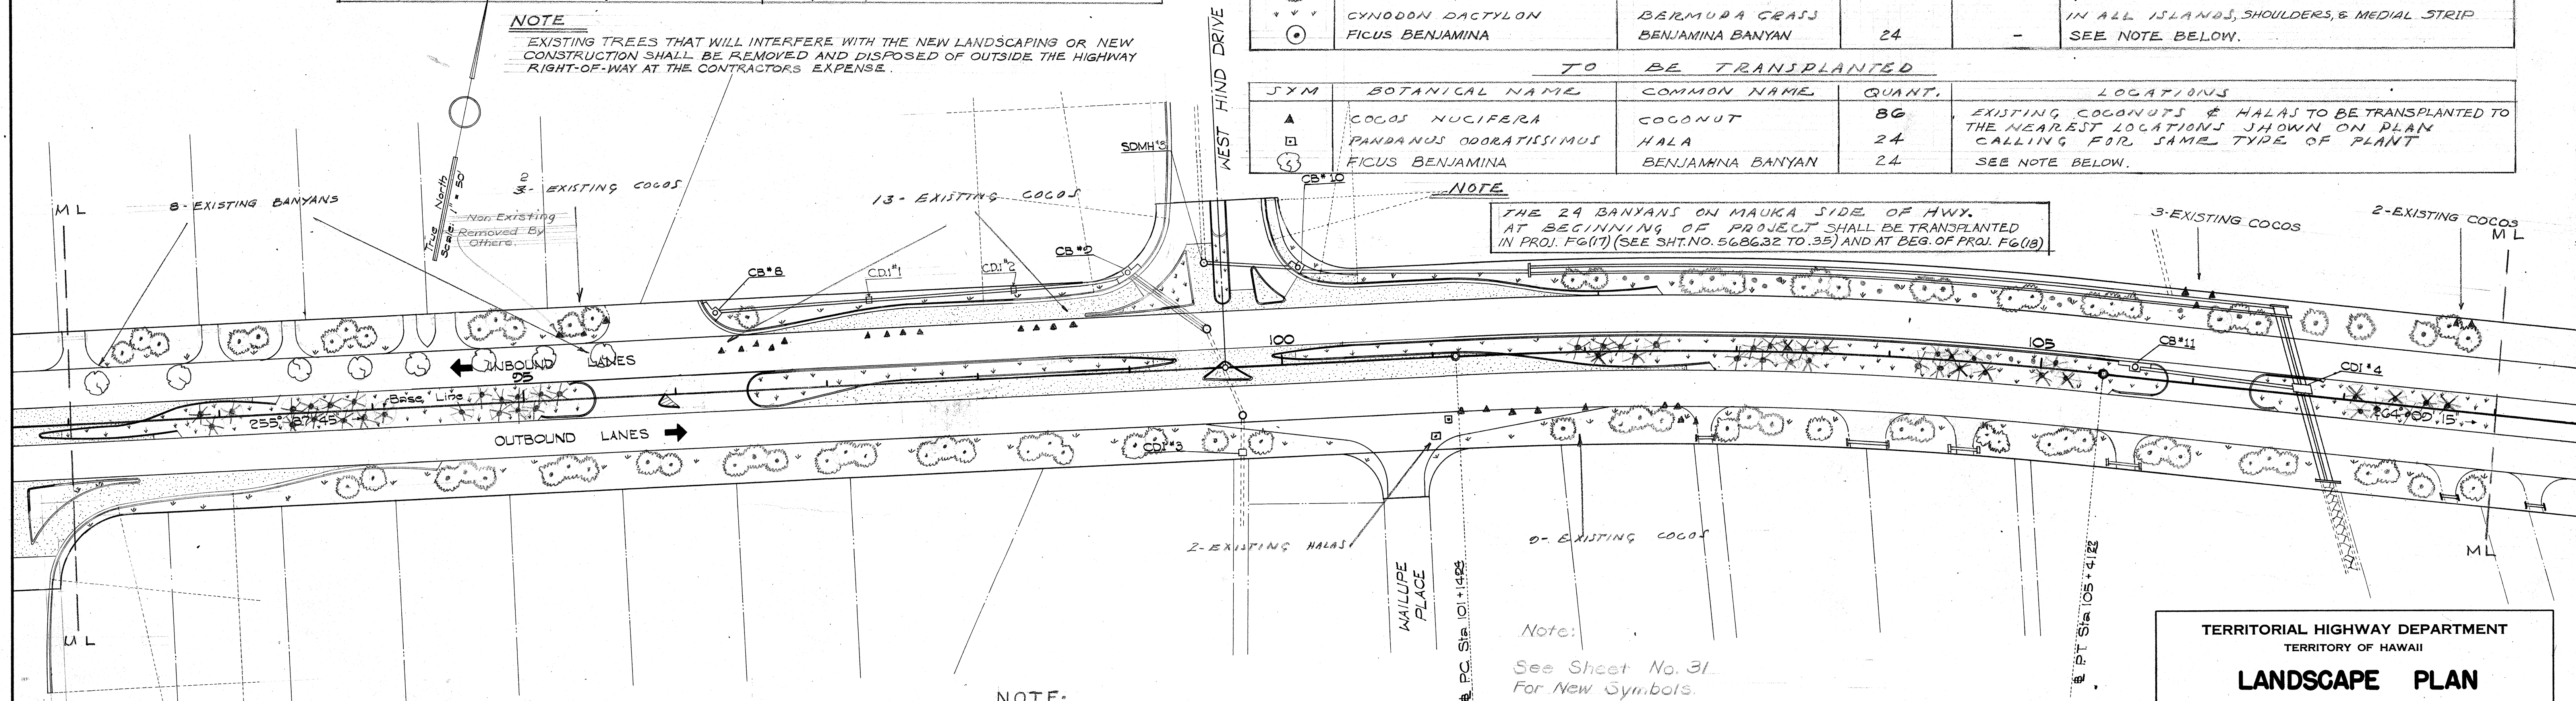

NOTE:

See Sheets No. 5686.4 to 5686.9 for final plans of acceleration and deceleration lanes.

Note:

See Sheet No. 31 For New Symbols.

THOMPSON & THOMPSON
LANDSCAPE ARCHITECTS - A.S.L.A.
HONOLULU

TERRITORIAL HIGHWAY DEPARTMENT
TERRITORY OF HAWAII



LANDSCAPE PLAN

KALANIANA'OLE HWY.
PROJECT NO. F 6 (18)


Scale: As Noted

SHEET NO. 1 OF 2 SHEETS

5686.30

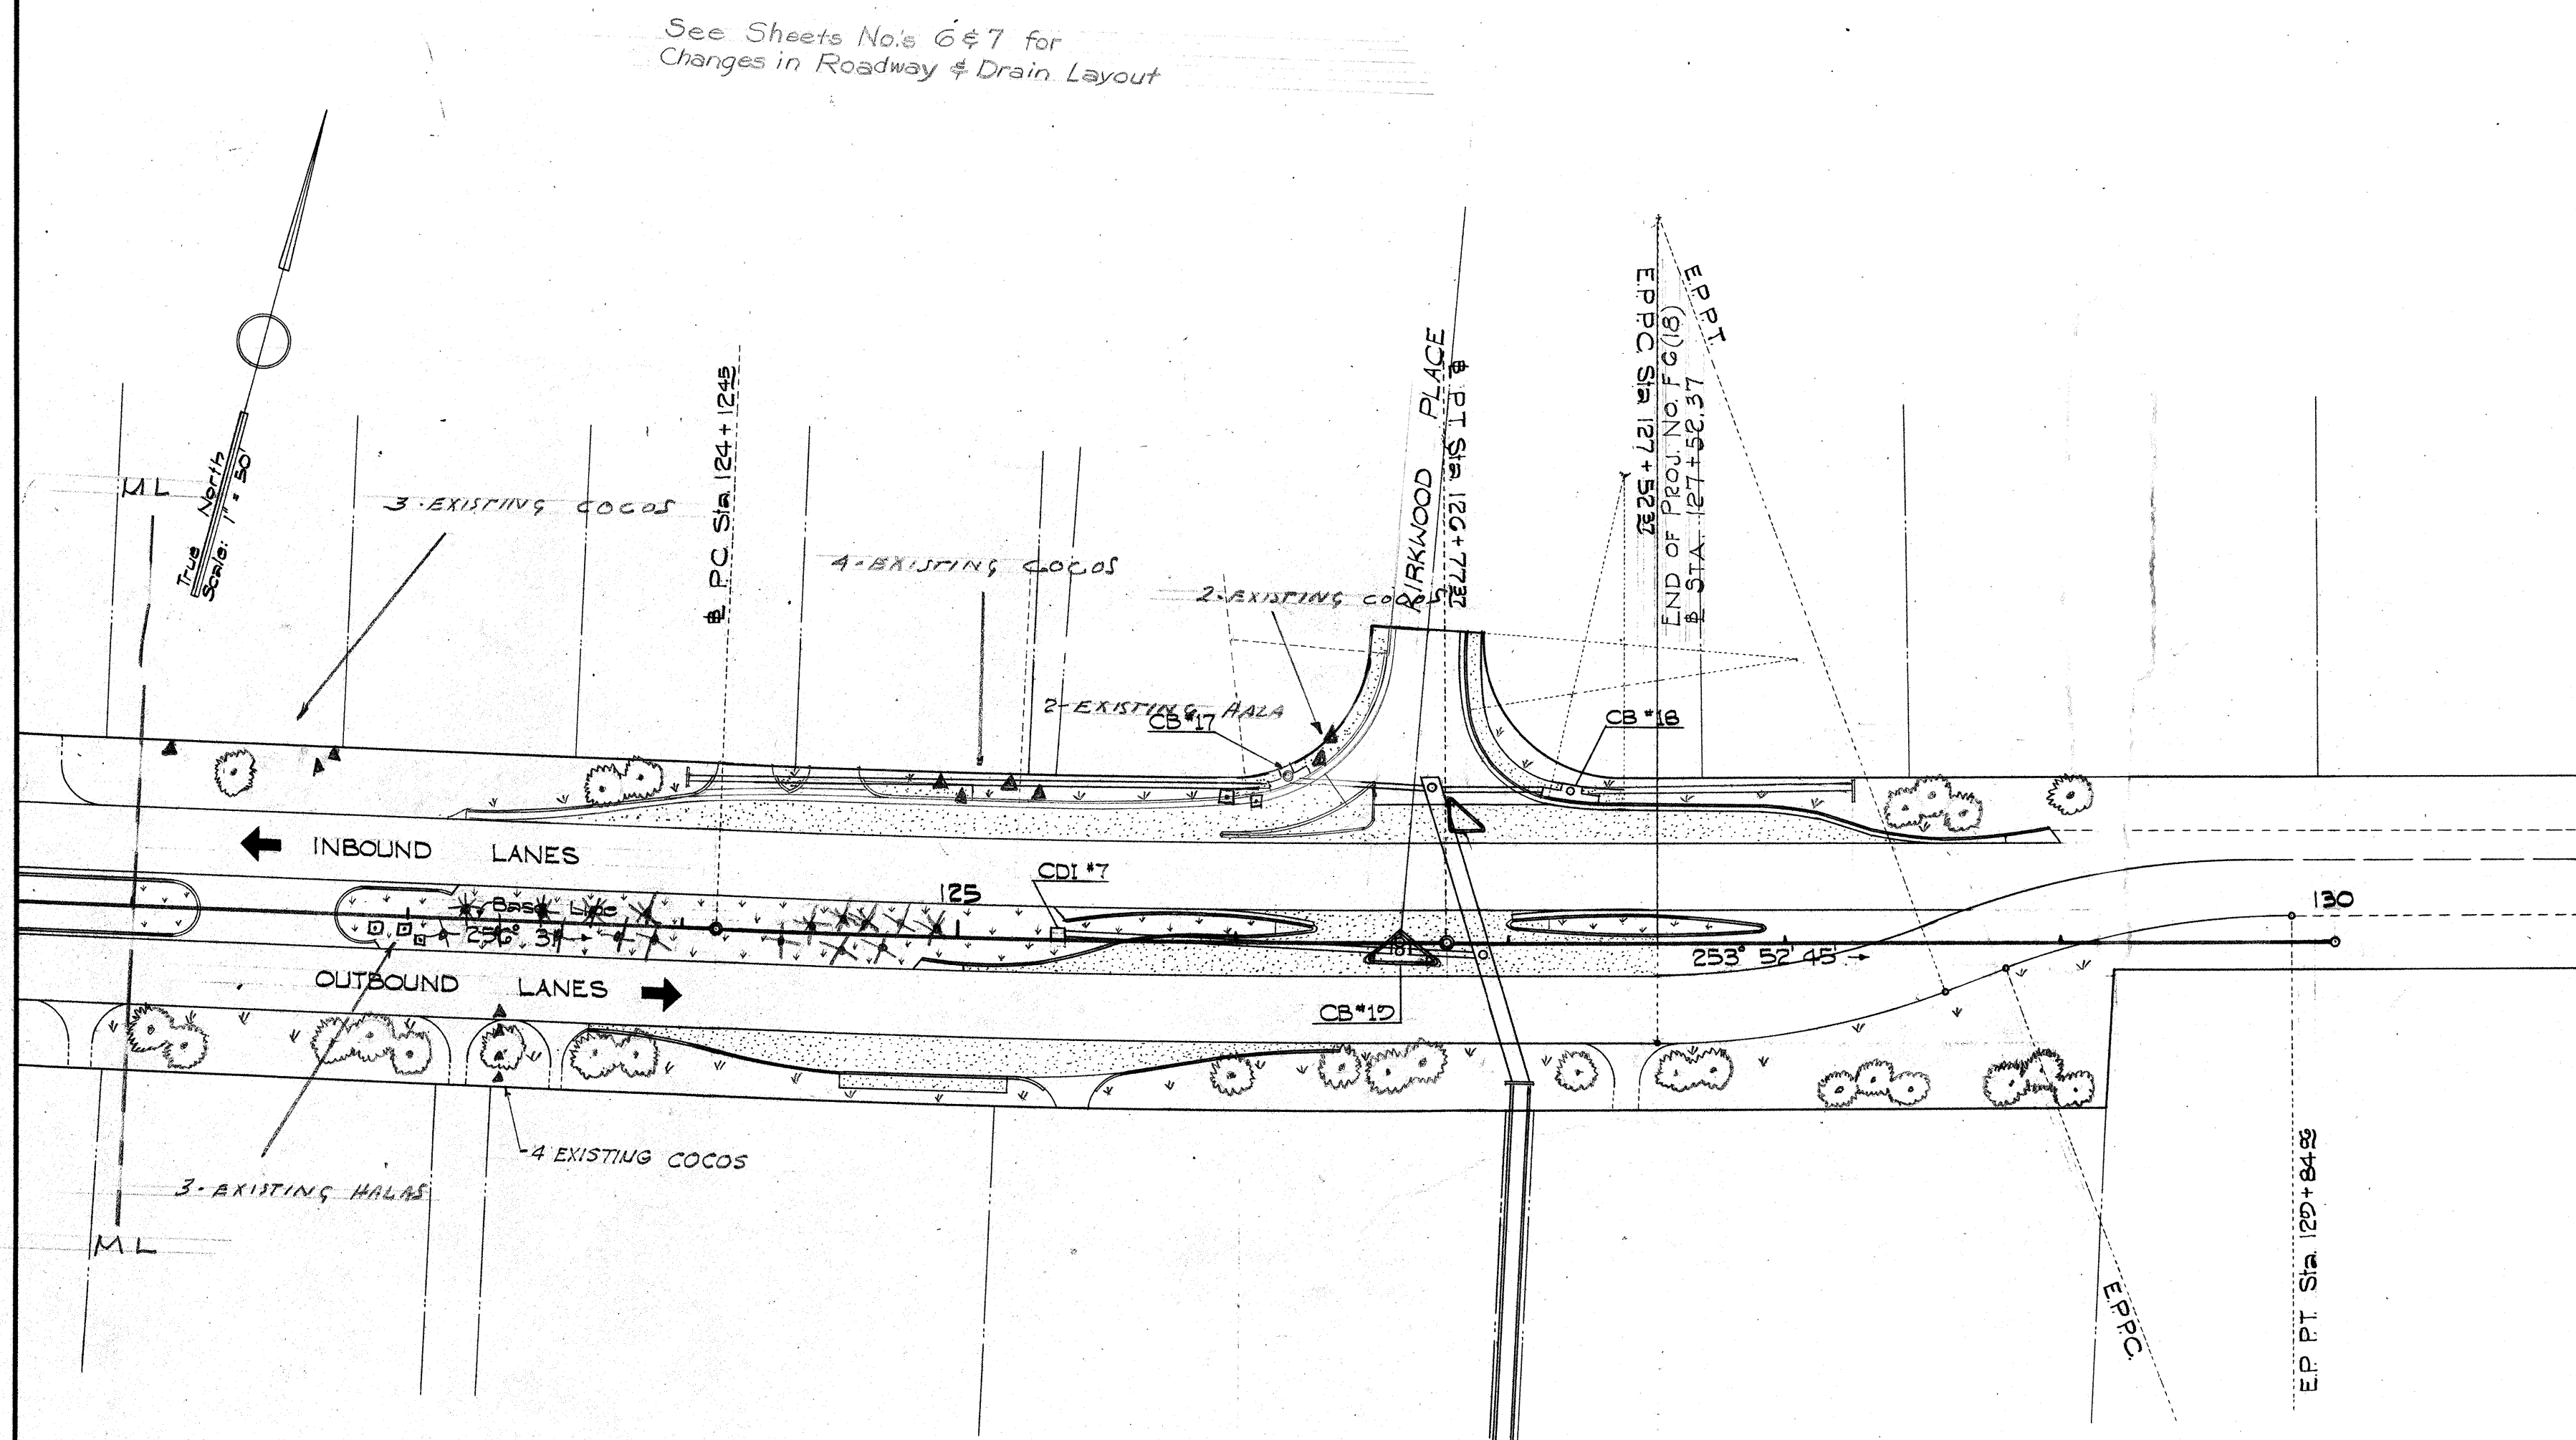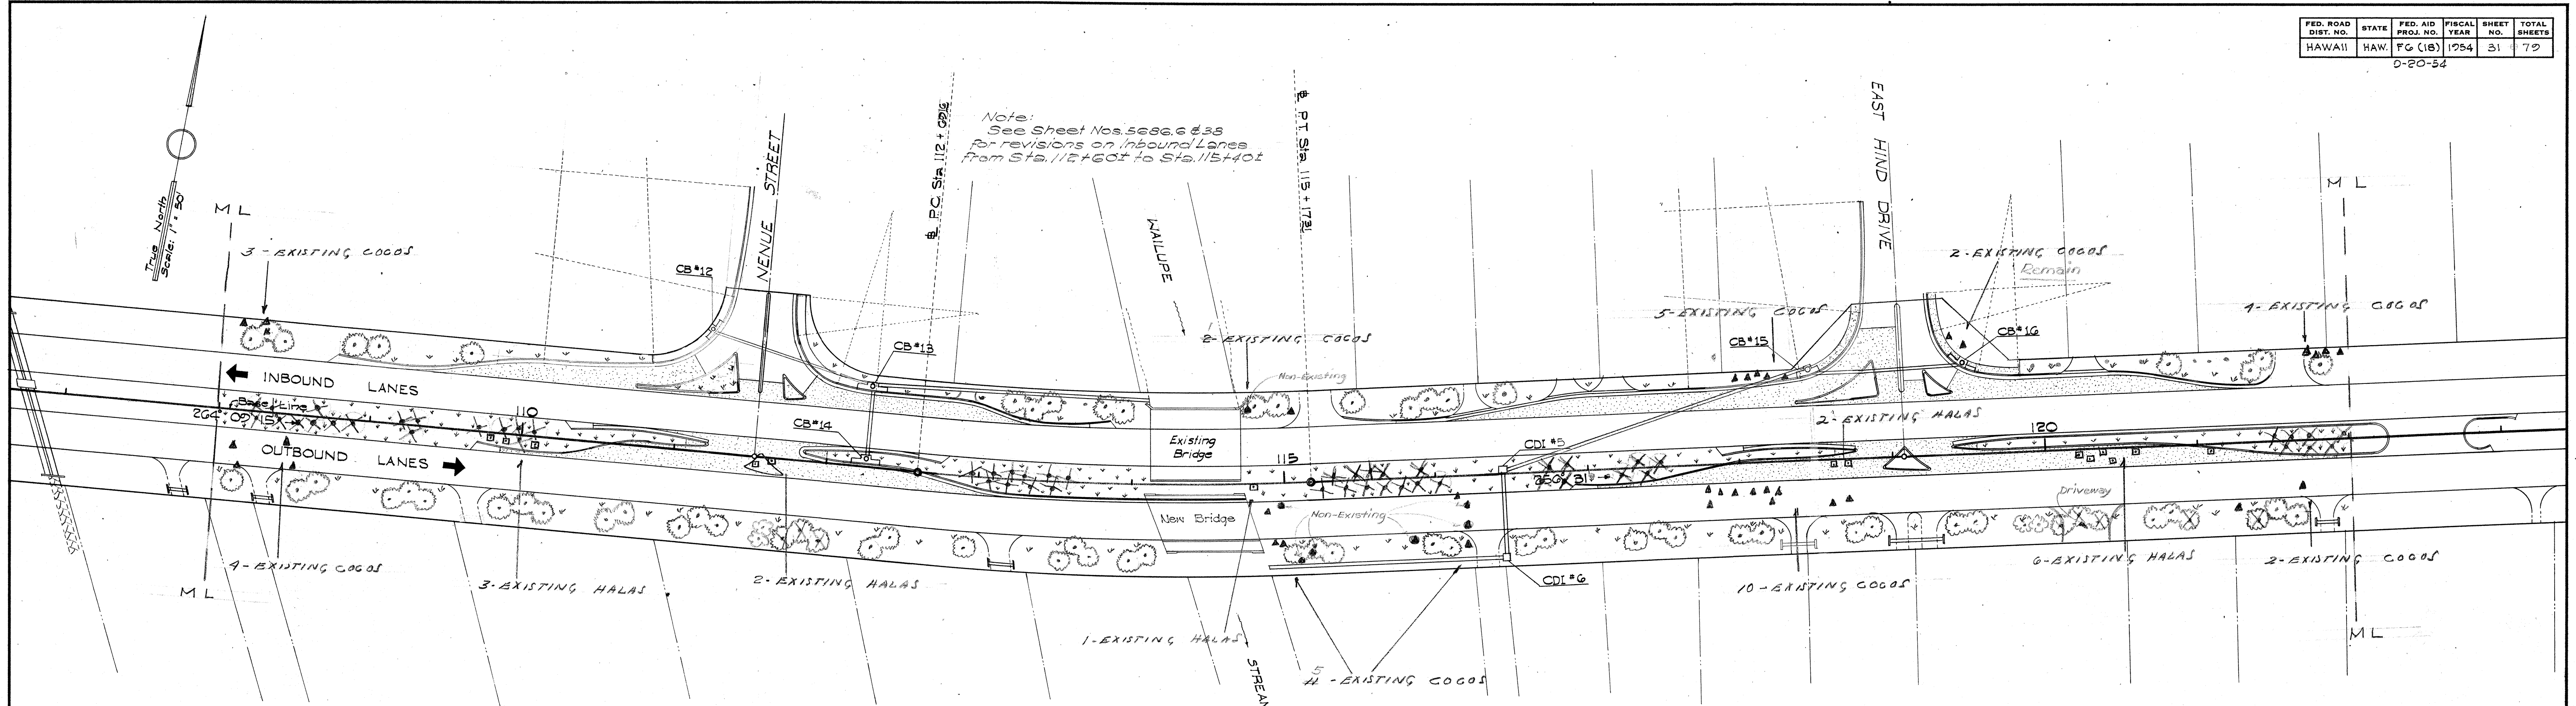

- Note:
- Coconut Planted in New Location.
 - Halas Planted in New Location.
 - Coconuts Not Planted in Location Shown.
 - Halas Not Planted in Location Shown.

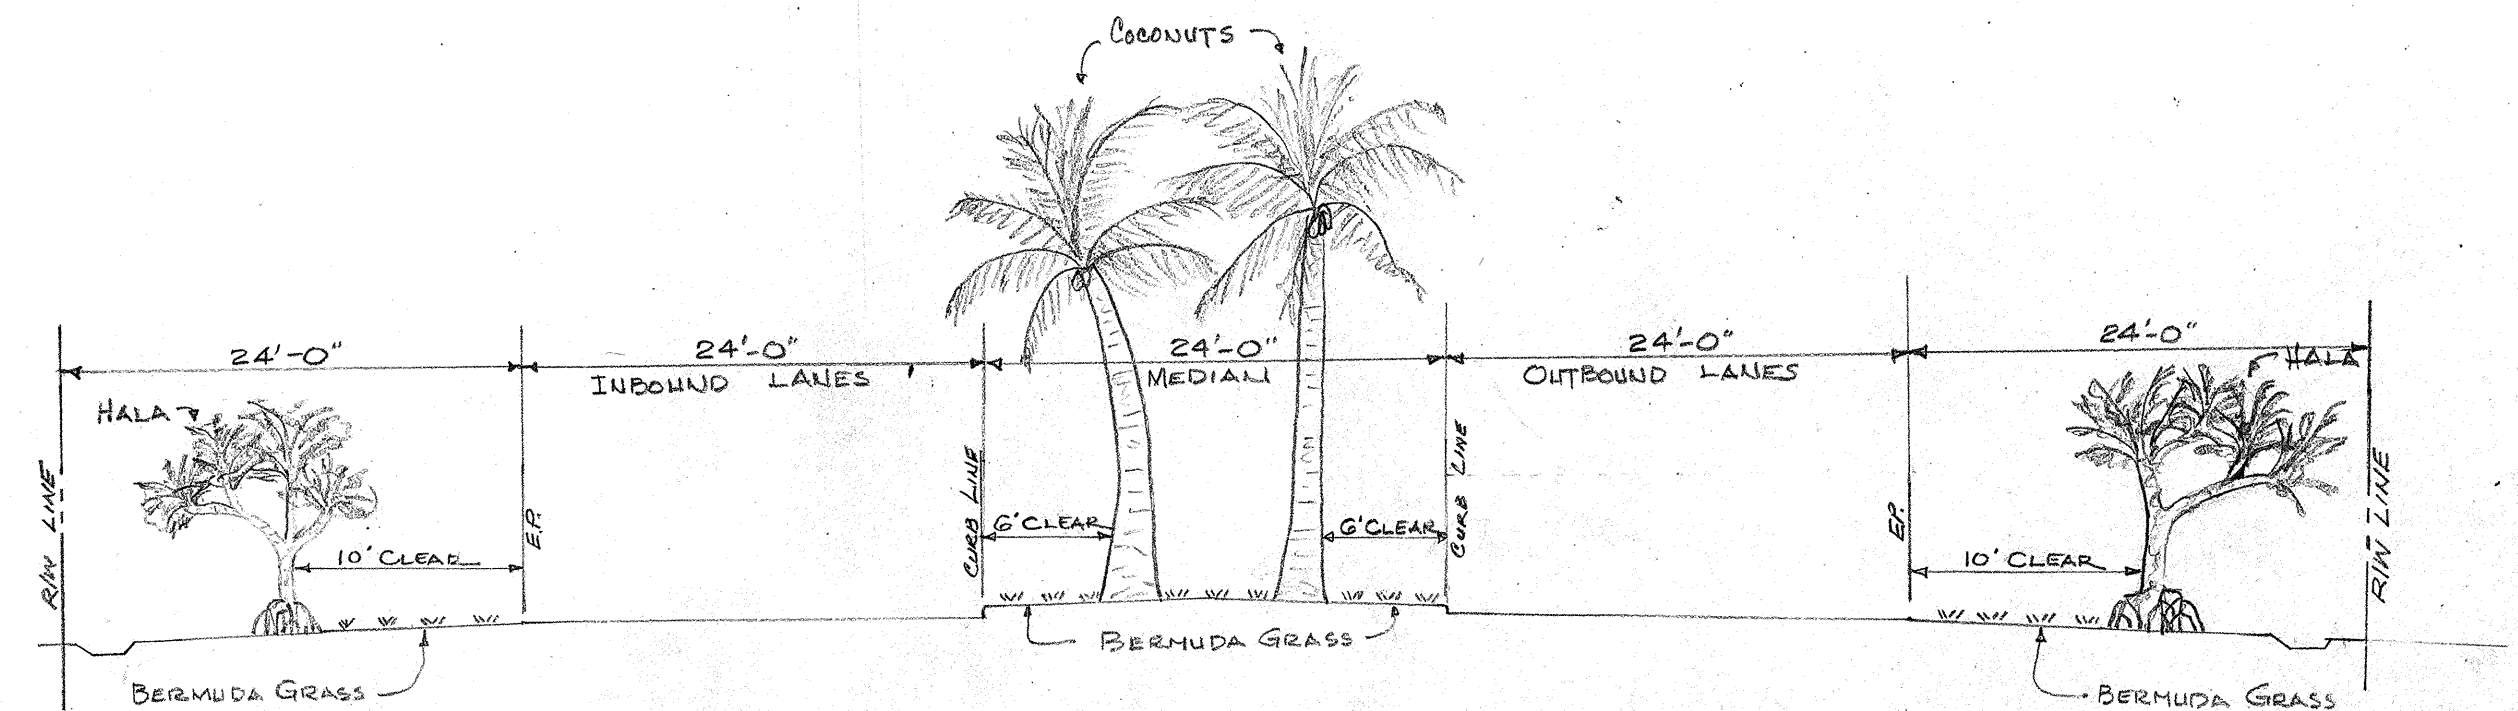

TYPICAL LANDSCAPING SECTION
Scale: 1" = 10'-0"

NOTE:
See Sheets No. 5686.4 to 5686.9 for final plan of acceleration and deceleration lanes

THOMPSON & THOMPSON
LANDSCAPE ARCHITECTS-A.S.L.A.
HONOLULU

TERRITORIAL HIGHWAY DEPARTMENT
TERRITORY OF HAWAII

LANDSCAPE PLAN

KALANIANA'OLE HWY.
PROJECT No F 6 (18)

Scale: As Noted

SHEET No 2 OF 2 SHEETS


5686.31

DESIGNED BY	DATE
DRAWN BY	
CHECKED BY	
NOTED BY	
QUANTITIES BY	
REVISIONS BY	
ORIGINAL PLAN	
NOTE BOOK	
No.	

FED. ROAD DIST. NO.	STATE	FED. AID PROJ. NO.	FISCAL YEAR	SHEET NO.	TOTAL SHEETS
HAWAII	HAW.	FG (18)	1954	32	72

LEGEND & NOTES
 ○ INDICATES LOCATION OF BANYAN TO BE TRANSPLANTED FROM PROJ. FG (18).

SURVEY PLOTTED BY	DATE
DESIGNED BY	
TRACED BY	
QUANTITIES BY	
CHECKED BY	
NOTE BOOK No.	

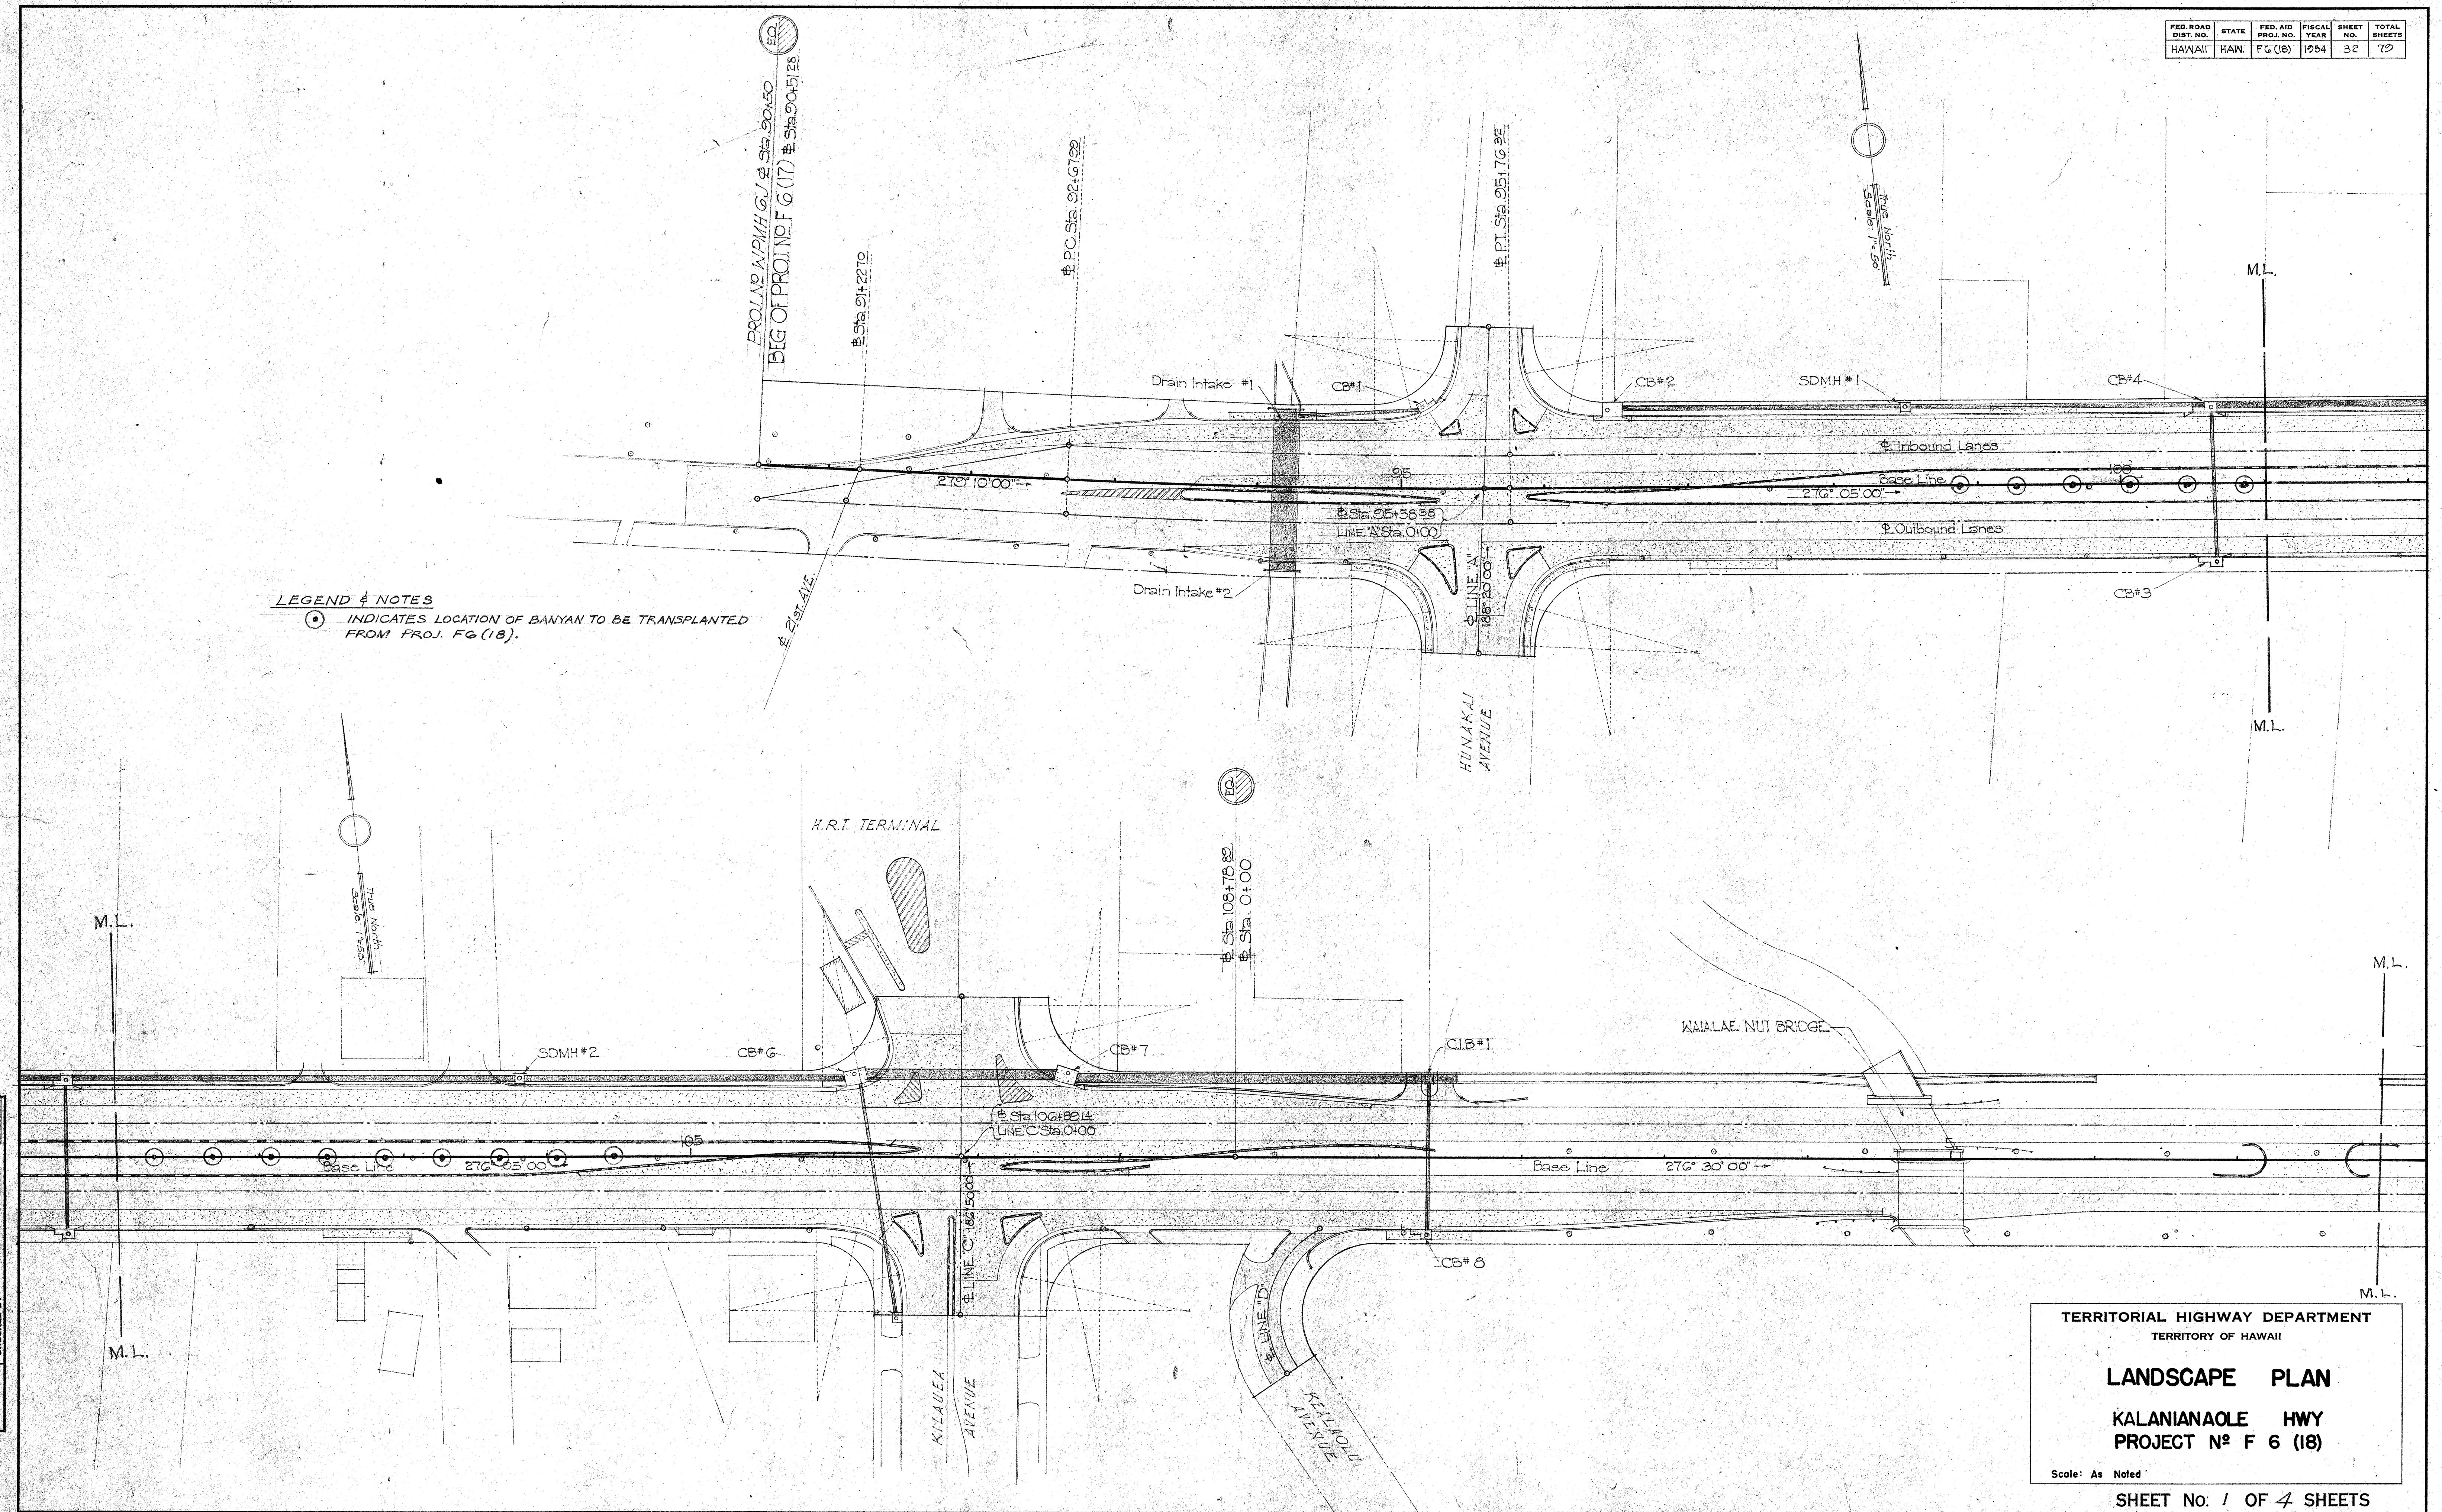


TERRITORIAL HIGHWAY DEPARTMENT
 TERRITORY OF HAWAII
LANDSCAPE PLAN
 KALANIANA'OLE HWY
 PROJECT N° F 6 (18)
 Scale: As Noted

SHEET No. 1 OF 4 SHEETS

5686.32

FED. ROAD DIST. NO.	STATE	FED. AID PROJ. NO.	FISCAL YEAR	SHEET NO.	TOTAL SHEETS
HAWAII	HAW.	FG (18)	1954	33	70

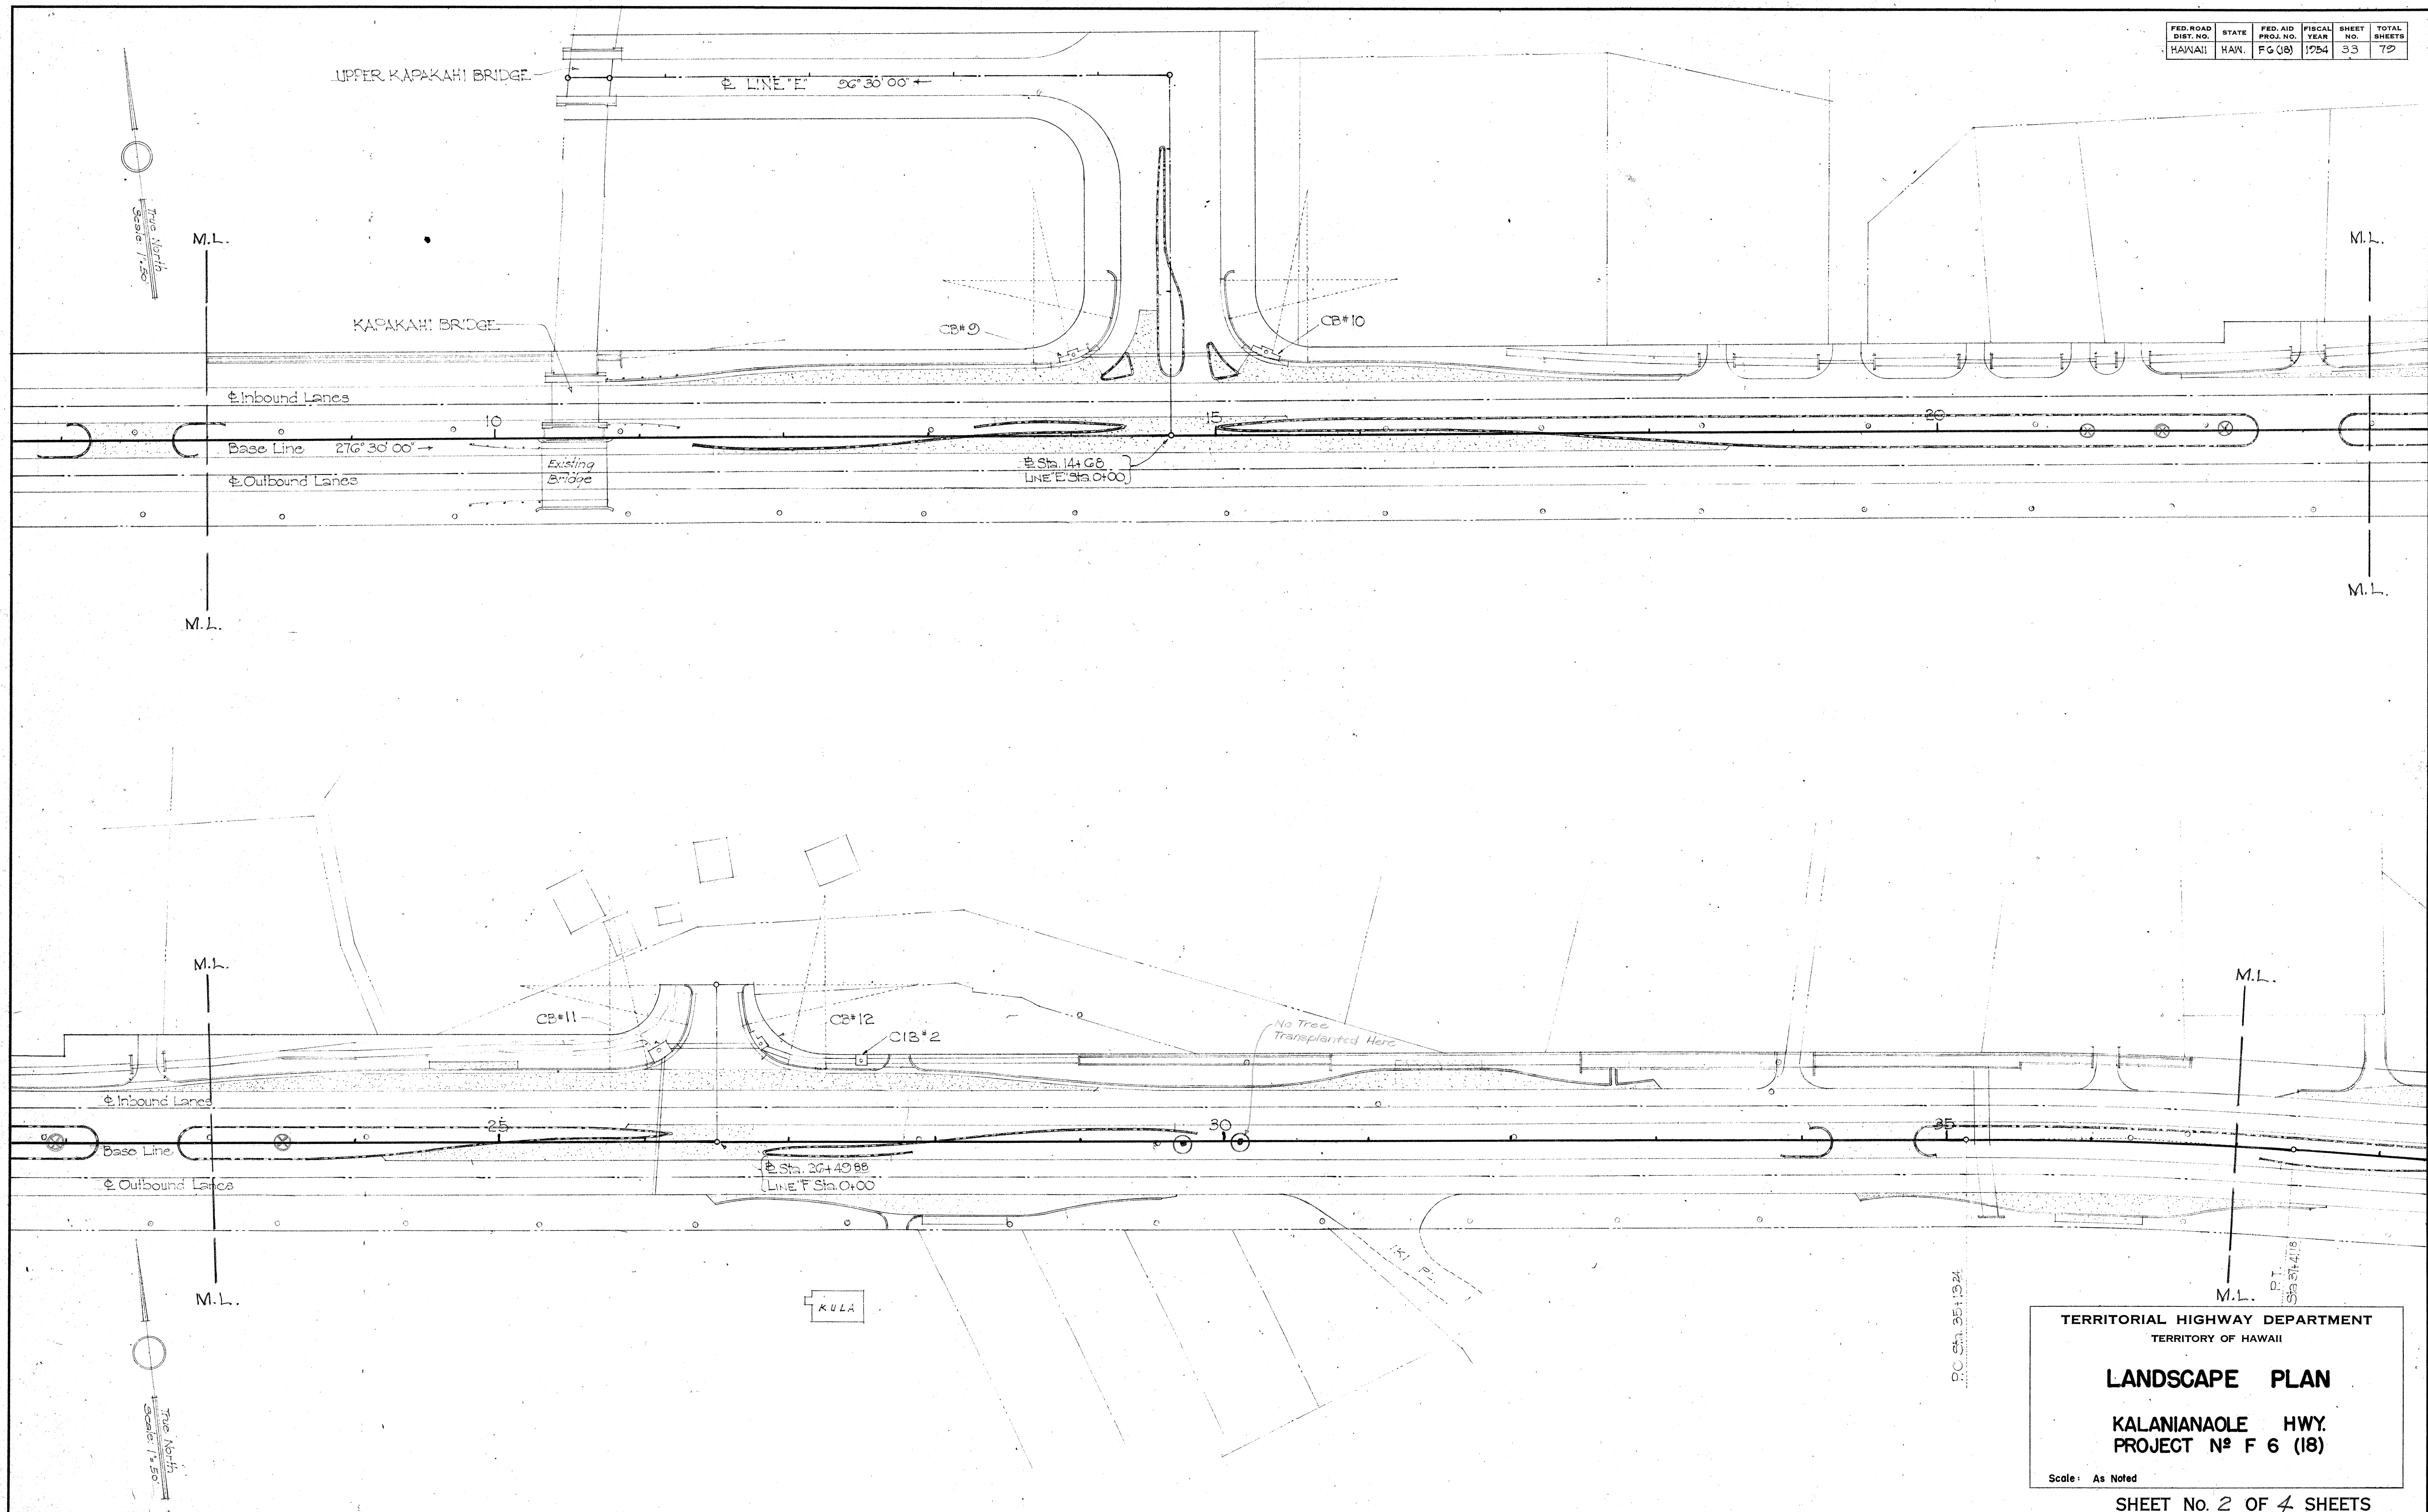

DATE	BY
DESIGNED BY	
DRAWN BY	
CHECKED BY	
QUANTITIES CHECKED BY	
NOTE BOOK	
NO.	

TERRITORIAL HIGHWAY DEPARTMENT
TERRITORY OF HAWAII

LANDSCAPE PLAN


KALANIANAʻOLE HWY.
PROJECT N° F 6 (18)

Scale: As Noted

SHEET NO. 2 OF 4 SHEETS

5686.33

FED. ROAD DIST. NO.	STATE	FED. AID PROJ. NO.	FISCAL YEAR	SHEET NO.	TOTAL SHEETS
HAWAII	HAW	FG (18)	1954	35	79

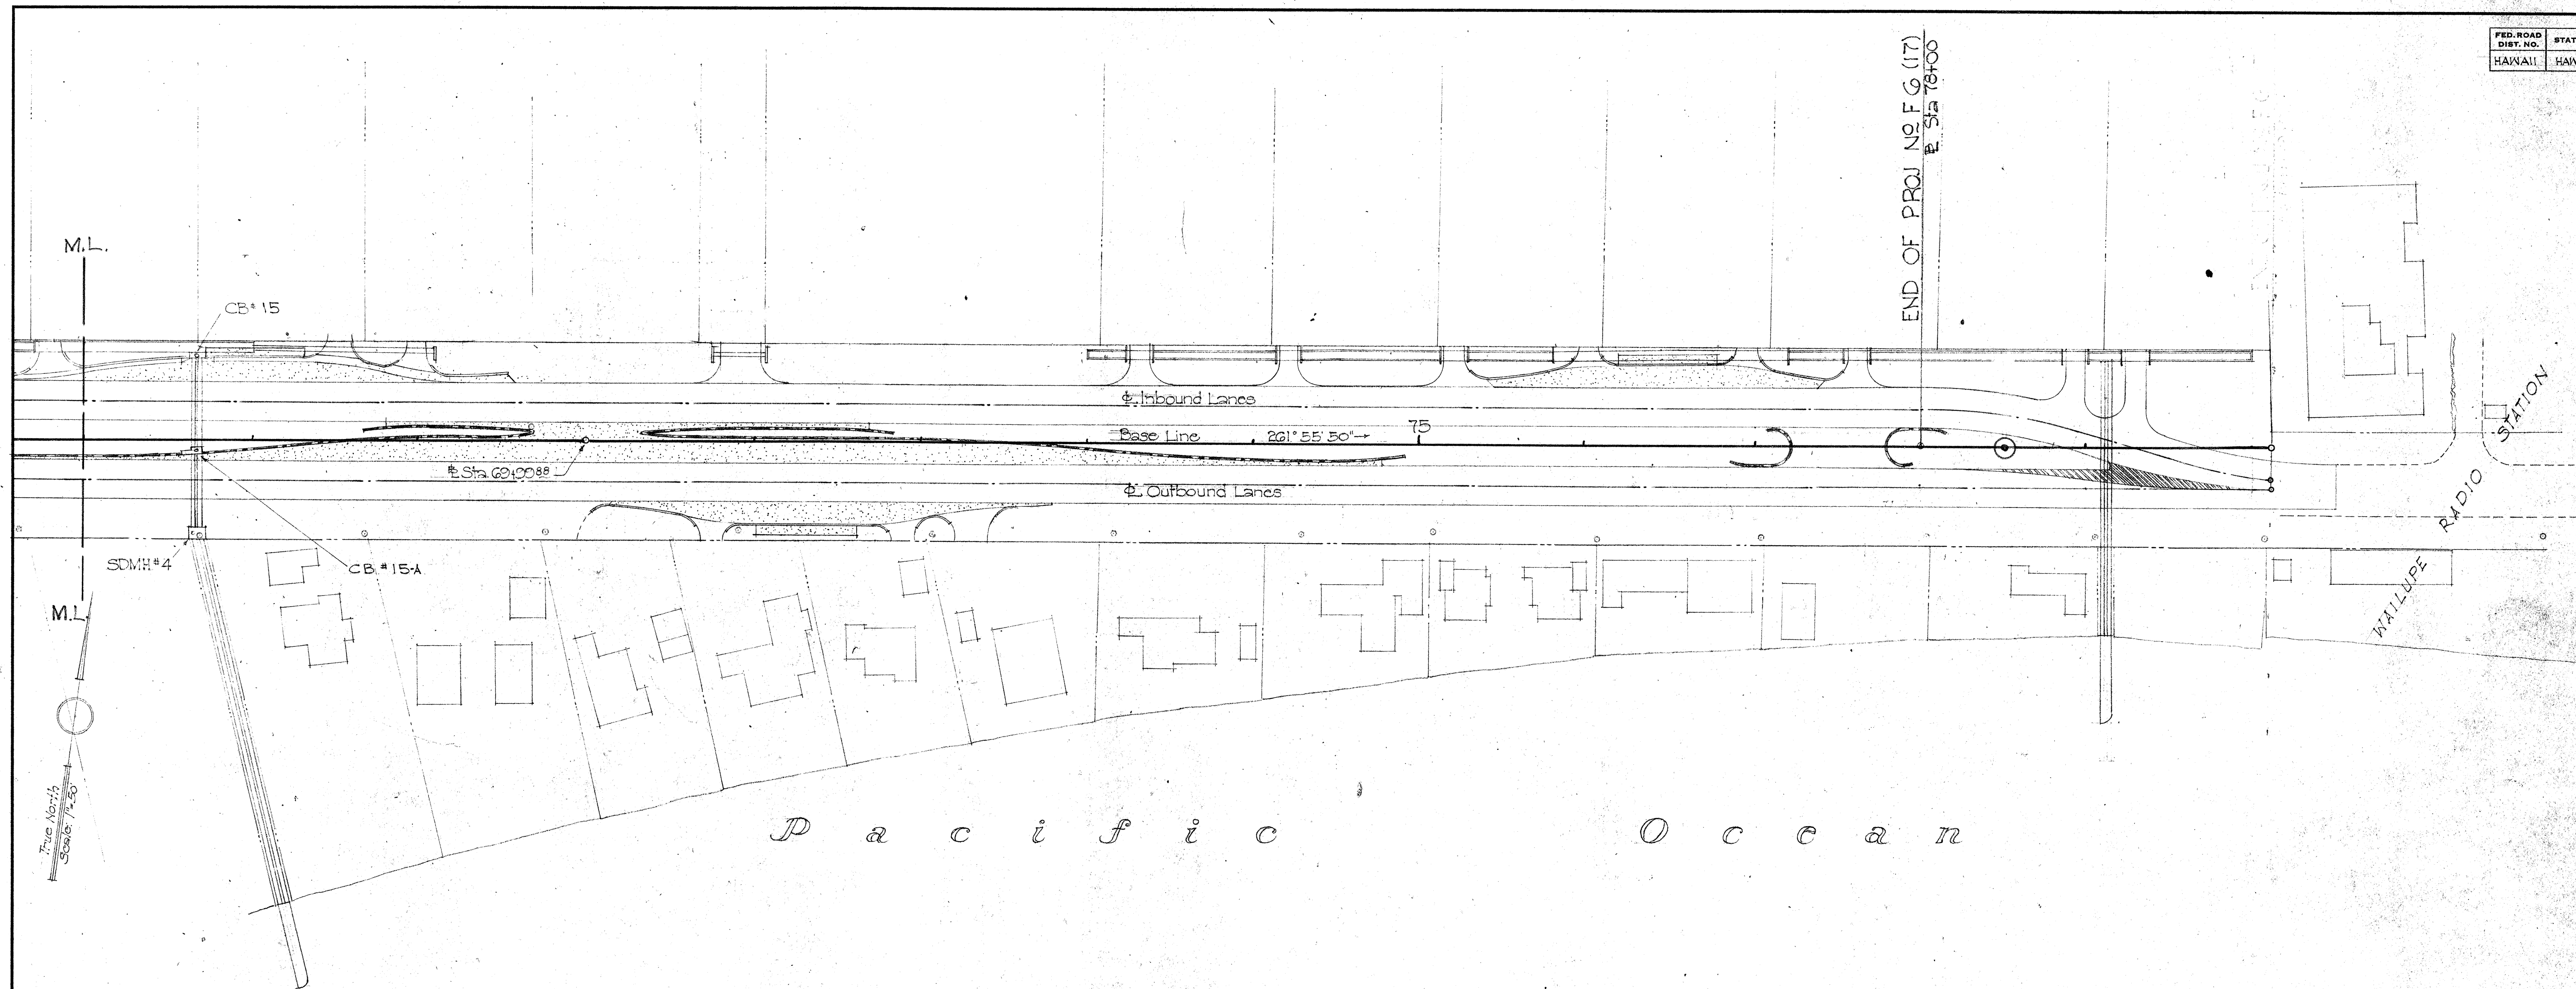

ORIGINAL PLAN	DATE
SURVEY PLOTTED BY	
DRAWN BY	
TRACED BY	
QUANTITIES CHECKED BY	
CHECKED BY	

TERRITORIAL HIGHWAY DEPARTMENT
TERRITORY OF HAWAII

LANDSCAPE PLAN

KALANIANA'OLE HWY
PROJECT N^o F 6 (18)

Scale - As Noted

SHEET No. 4 OF 4 SHEETS

5686.35