


FED. ROAD DIST. NO.	STATE	FED. AID PROJ. NO.	FISCAL YEAR	SHEET NO.	TOTAL SHEETS
HAWAII	HAW.	FG (18)	1954	12	70

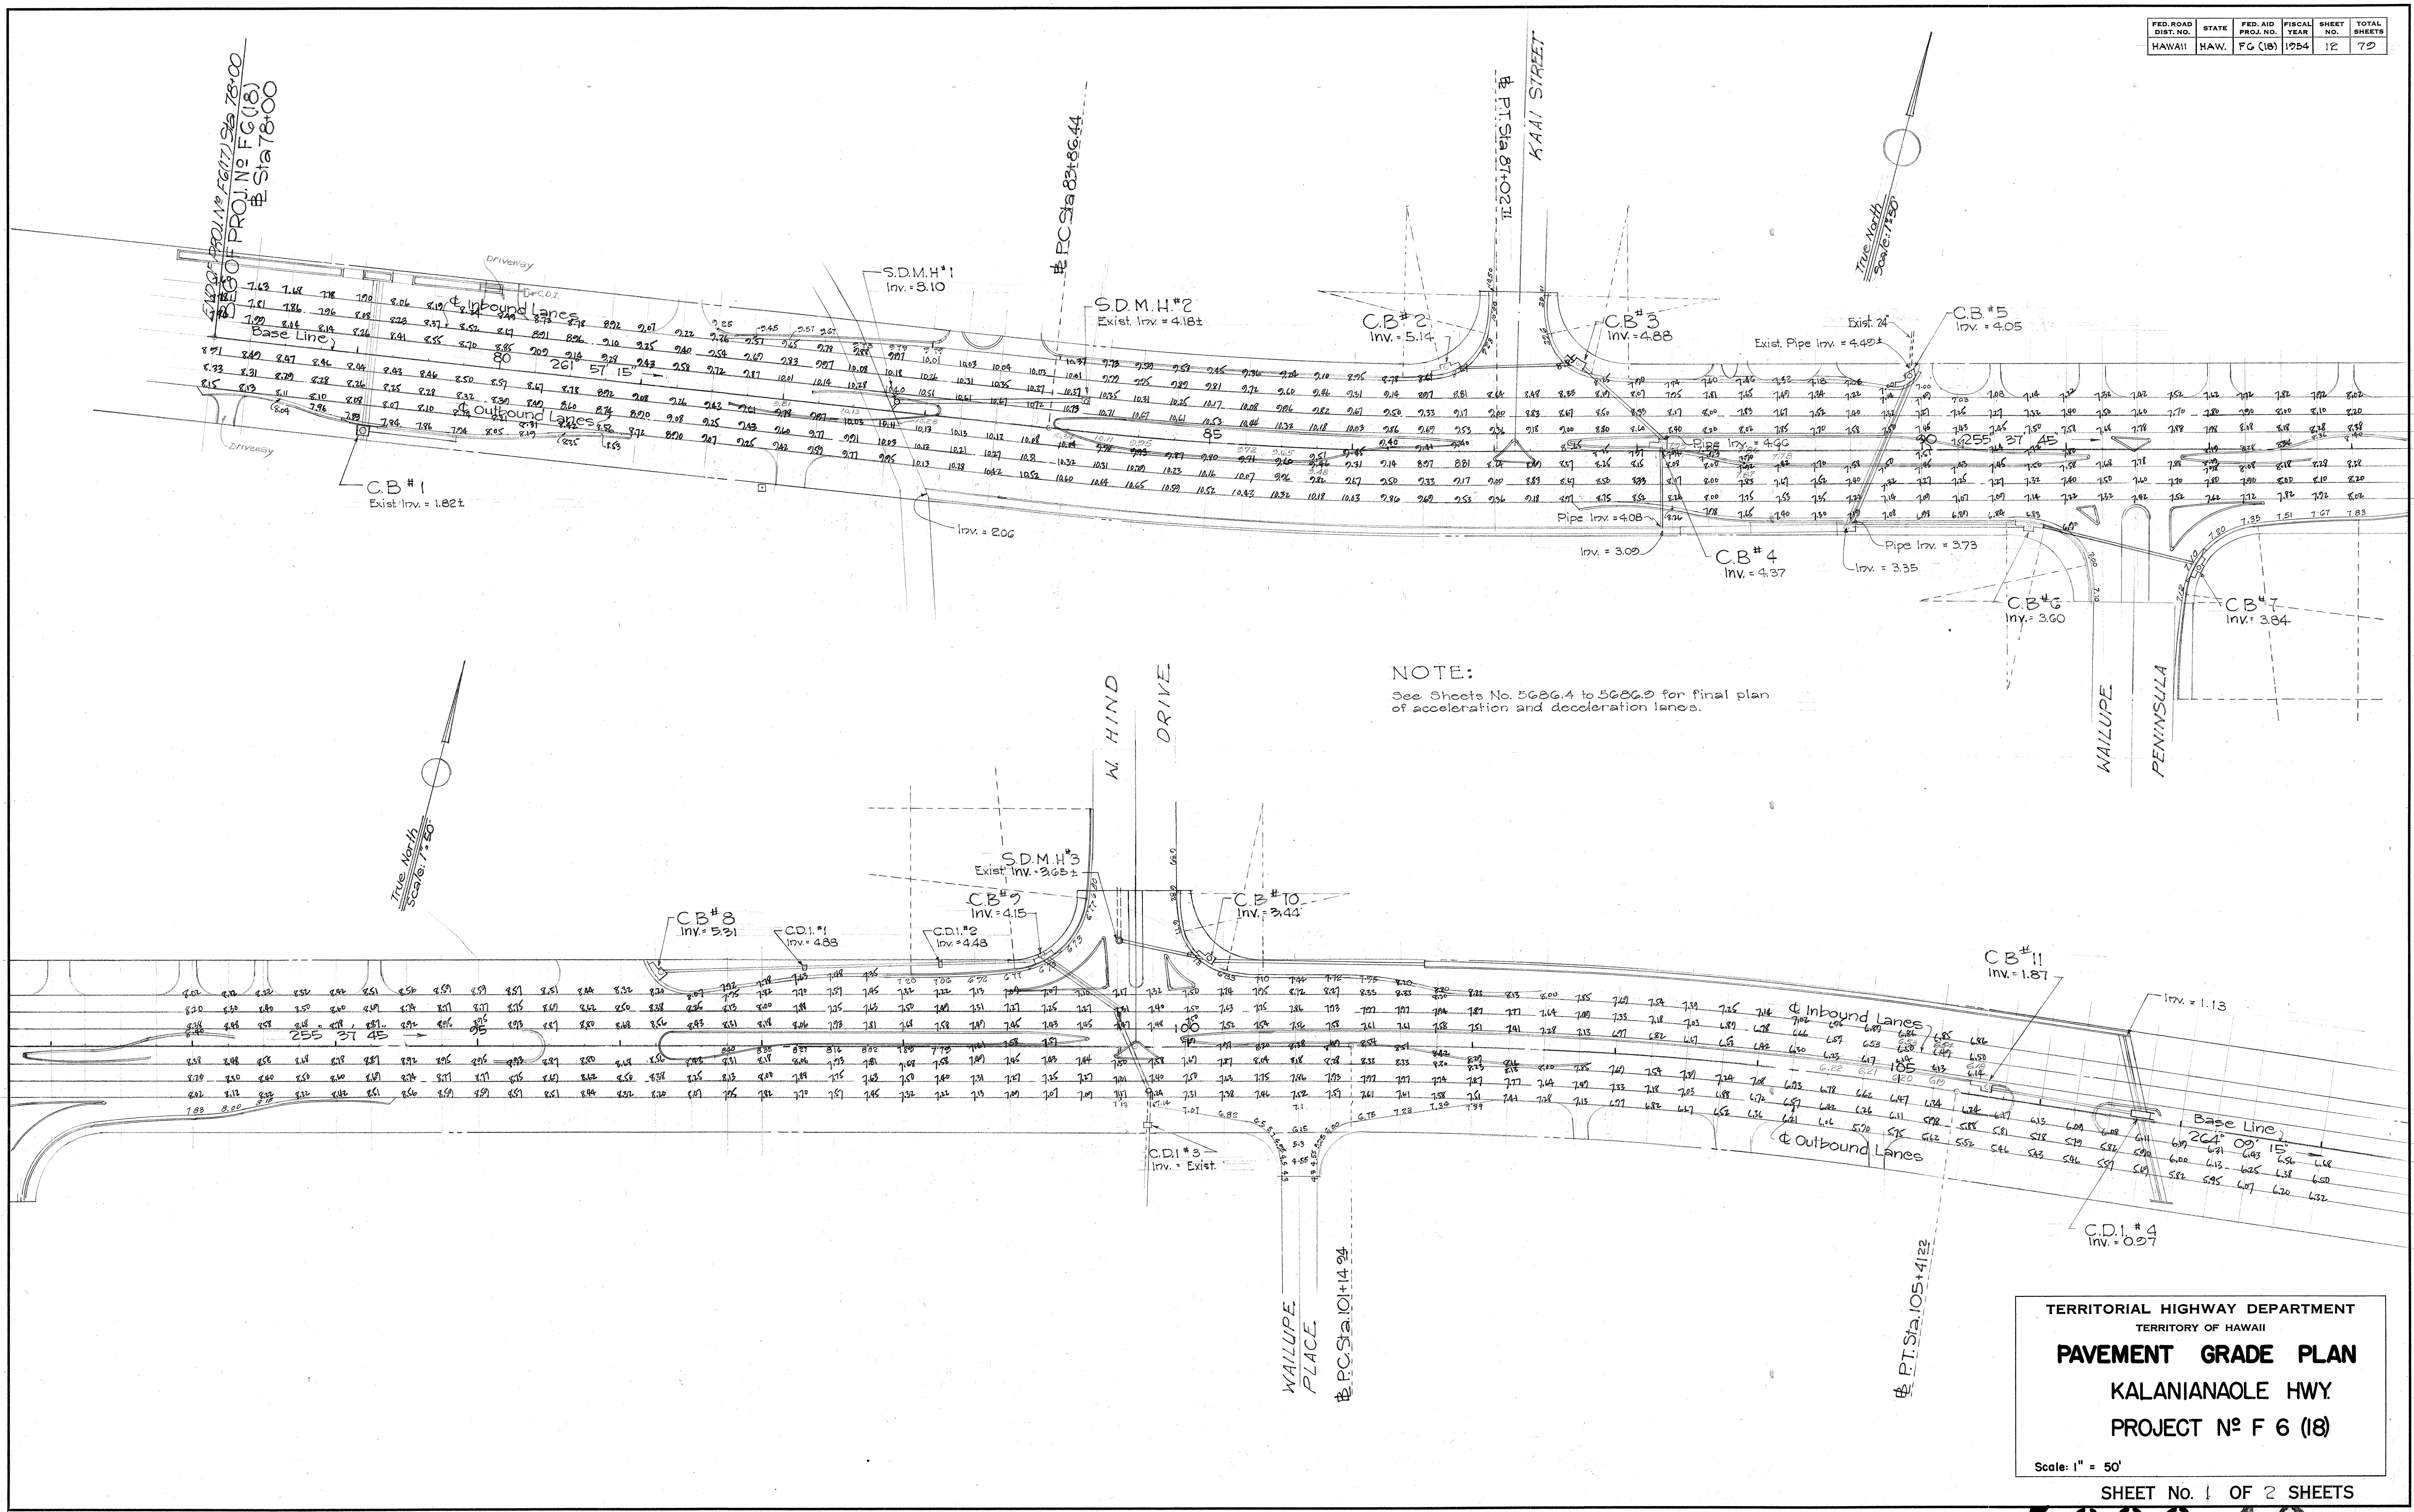

ORIGINAL PLAN	DATE
DESIGNED BY	
TRACED BY	
QUANTITIES BY	
CHECKED BY	
NOTE BOOK	
No.	

TERRITORIAL HIGHWAY DEPARTMENT
TERRITORY OF HAWAII
PAVEMENT GRADE PLAN
KALANIANA'OLE HWY.
PROJECT N° F 6 (18)
Scale: 1" = 50'
SHEET No. 1 OF 2 SHEETS

5686.12

