

INDEX TO DRAWINGS	
SHEET NO.	DESCRIPTION
1	Title Sheet
2 - 3	Typical Sections
4 - 7A	Plan & Profile (Stockpile Site)
8 - 9	Typical Curb Layout at Intersections
10 - 11	Alteration of Improvements
12 - 13	Pavement Grades
14 - 17	Utility Plan
18 - 22	Plan of Water System
23 - 25	Highway Lighting System
26	Traffic Signals
27 - 29	Traffic Signs
30 - 35	Landscape Plan
36 - 37A	Sprinkler System
38 - 50	Bridge and Drainage Structures
51 - 57	Standard Details
58 - 66	Cross Section
67 - 79	Sewer System

CONVENTIONAL SIGNS	
Centerline	125
Boundary Lines	—, or —
Fences (Named)	—
Existing Roadways	—
Circular Culvert	—
Box Culvert	—
Bridge	—
Telephone Pole	—
Electric Power Pole	—
Water Main	— W ₂ — W ₂ (W 4, 8, 12, Etc.)
Storm Drain	— SD ₁₂ — SD ₁₂ (SD 12, 24, Etc.)
Concrete Drop Intake	—
Standard Catch Basin	—
Standard Manhole	— M.H. 5 —
Sewer Manhole	— S ₈ — S ₈ — S ₈ —
Telephone Manhole	— T.M.H. —
Fire Hydrant	— F.H. —
Tree (Large, named)	— Mango —
Railroad	—
Haw'n Telephone Underground Cable	HTC
Water Meter	WM

TERRITORY OF HAWAII

TERRITORIAL HIGHWAY DEPARTMENT

HONOLULU, OAHU, T. H.

PLANS OF


KALANIANA'OLE HIGHWAY

FEDERAL AID PROJECT N^o F 6 (18)

DISTRICT OF HONOLULU

ISLAND OF OAHU

SCALES	
PLAN	1 INCH = 50 FEET
PROFILE	1 INCH = 50 FEET
CROSS SECTIONS	1 INCH = 5 FEET
	1 INCH = 10 FEET
	1 INCH = 5 FEET

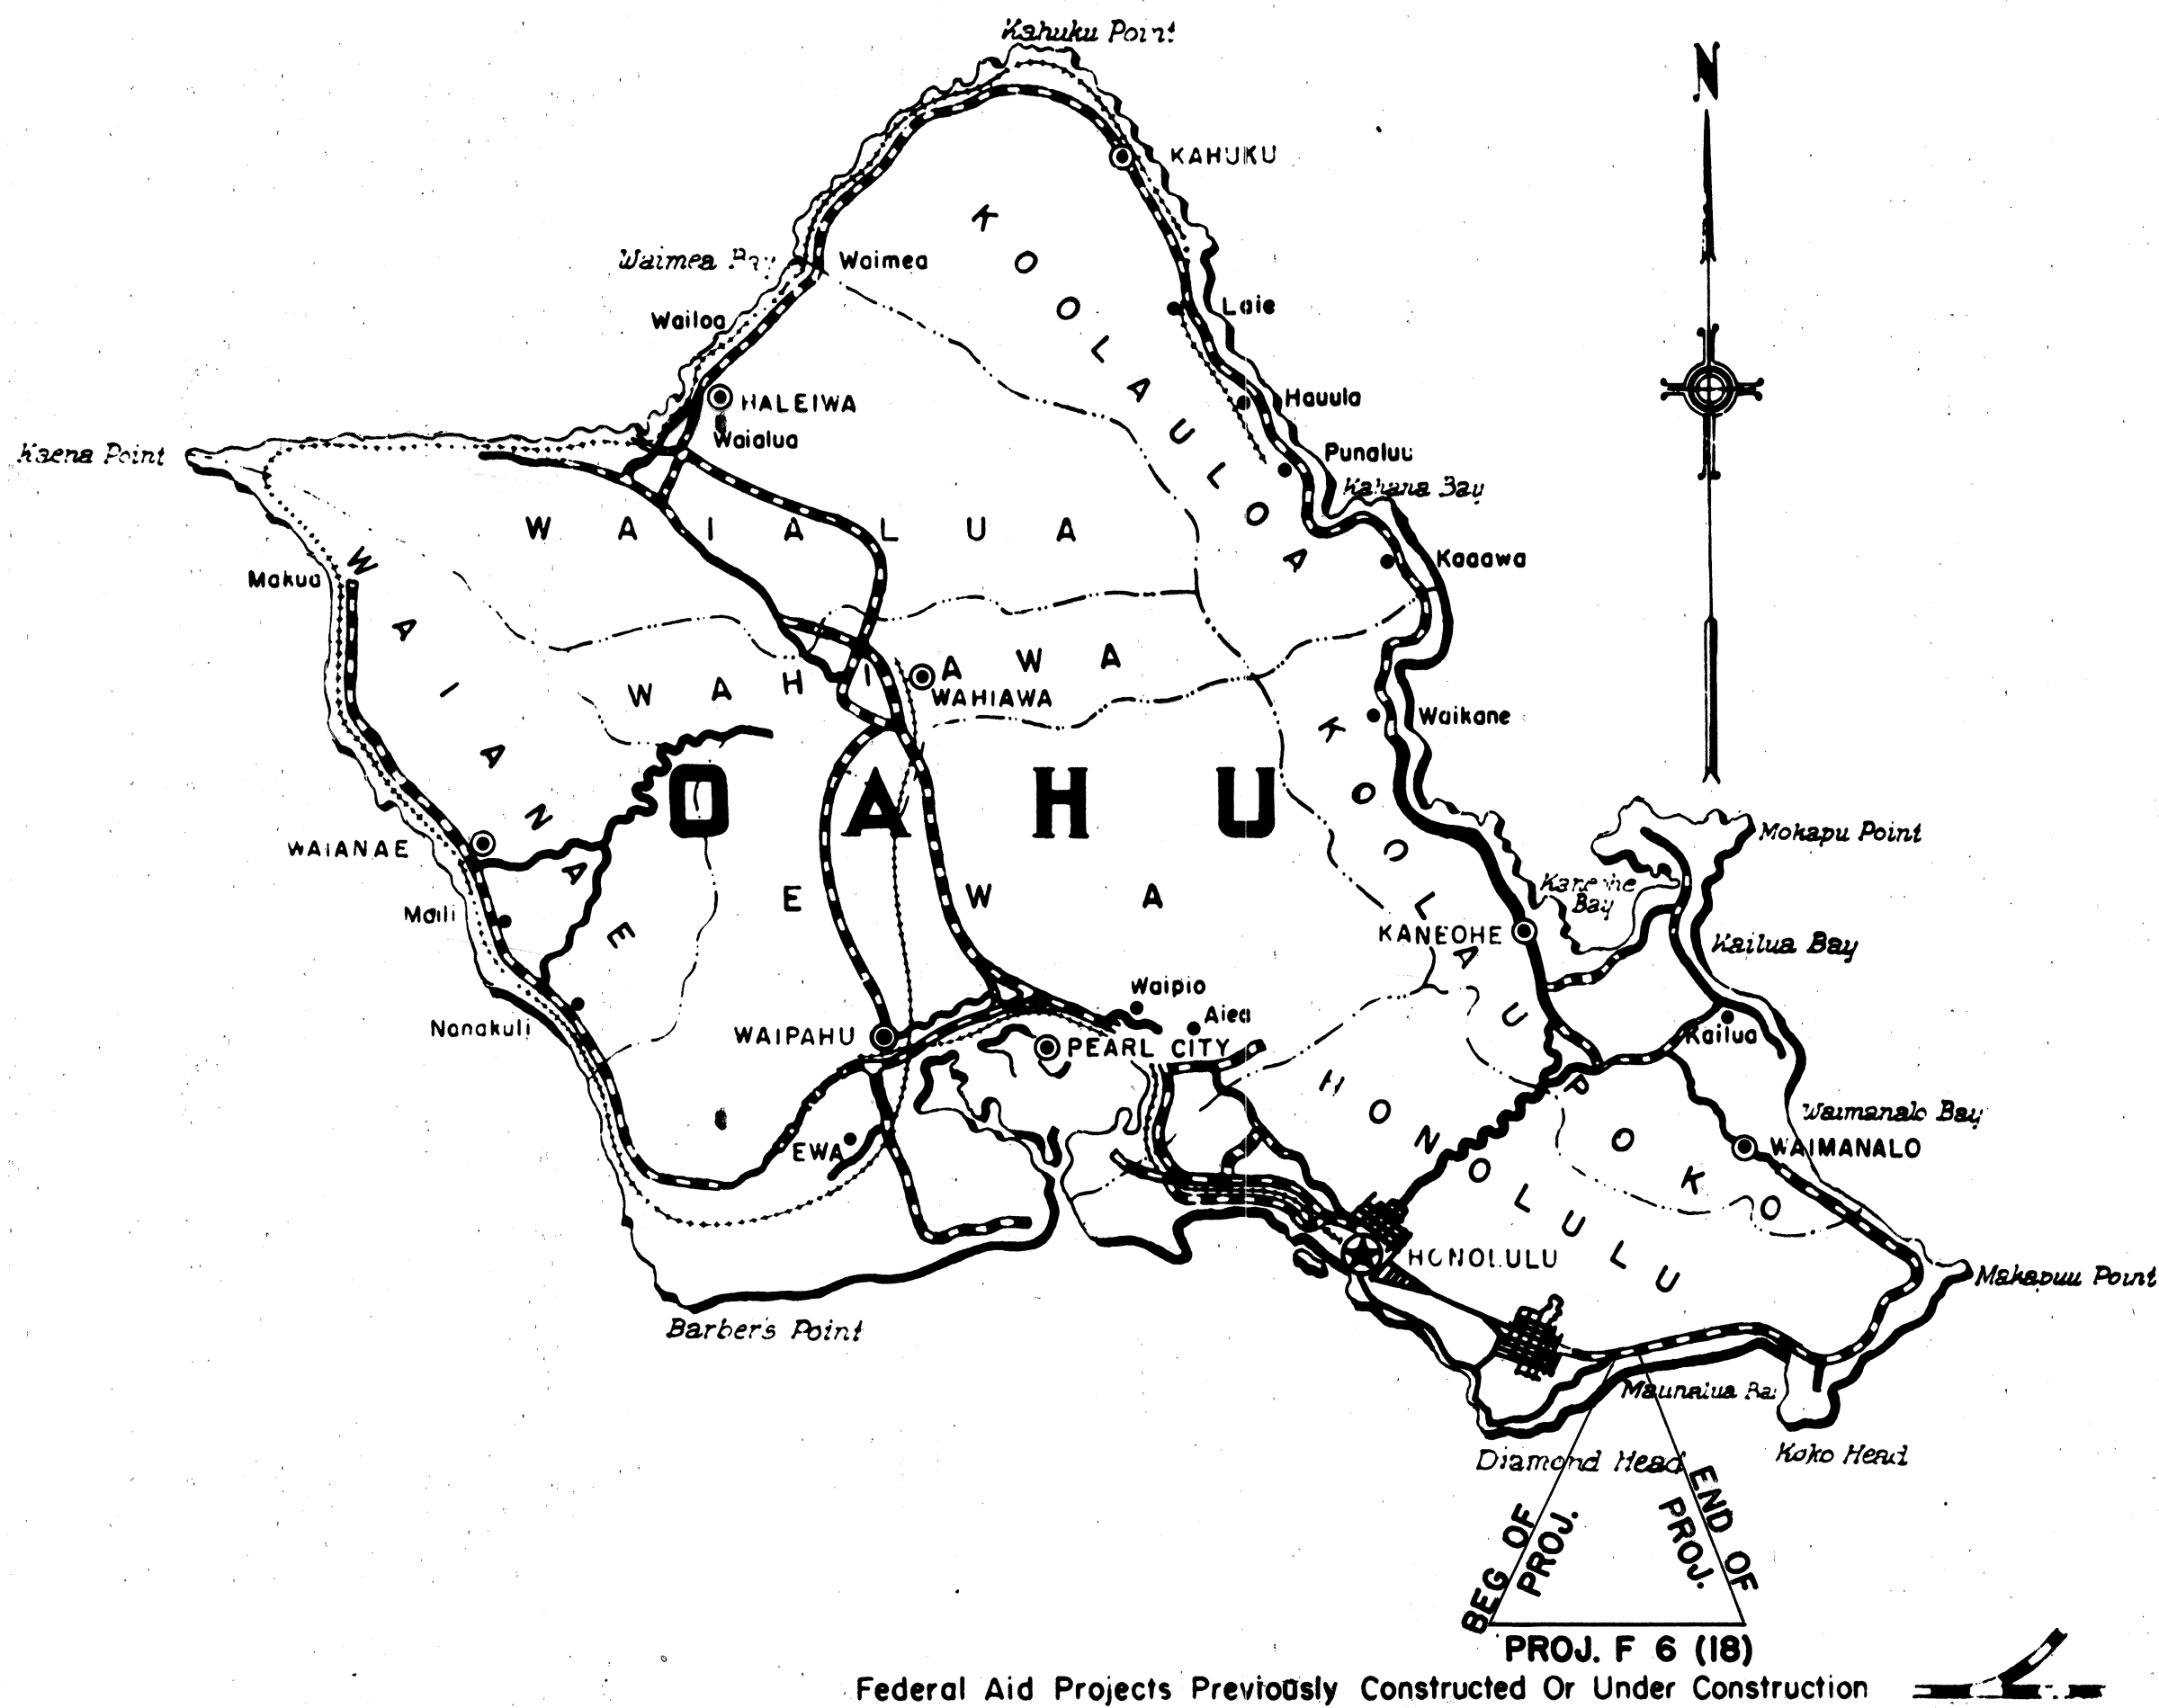


NOTE:

ALL CHANGES MADE DURING CONSTRUCTION HAVE BEEN NOTED IN RED ON THESE TRACINGS AND CHECKED BY:

Terry Watanabe
PROJECT ENGINEER

12/29/56
DATE

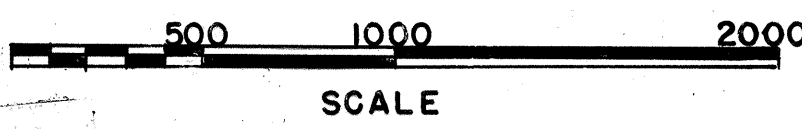

LAYOUT PLAN

GROSS LENGTH OF PROJECT = 0.938 MILE
BRIDGES OVER 20' SPAN = 0.012 MILE
NET LENGTH OF PROJECT = 0.926 MILE

APPROVED: *Ben E. Hutter*
TERRITORIAL HIGHWAY ENGINEER

DEPARTMENT OF COMMERCE
BUREAU OF PUBLIC ROADS

APPROVED: _____
DISTRICT ENGINEER

DATE: _____