


6" upper case letters
MOKULEIA
WAHIAWA
HONOLULU

FED. ROAD DIST. NO.	STATE	FED. AID PROJ. NO.	FISCAL YEAR	SHEET NO.	TOTAL SHEETS


ITEM NO.	ESTIMATED QUANTITIES
13	Roadway Excavation - - - - - 210 cu. yds.
18	Compacting Original Ground - 450 sq. yds.
23	Sprinkling - - - - - 4 #8 m. gals.
26	Untreated Base - - - - - 144.71 cu. yds.
39(2)	A. C. Mix No. III - - - - - 451 #4 tons
73	Lava Rock Curb - - - - - 44 30 lin. ft.
74	Reconstructed Lava Rock Curb 360 lin. ft. 281
104	Imported Topsoil - - - - - 45 cu. yds.
105	Sodding Surfaces - - - - - 2,350 sq. ft.
118	Scarifying Surfaces for Sodding - - - - - 220 sq. yds.

- NOTE:
1. Reconstructed Lava Rock Curb shall be constructed with Lava Rock Curb removed as ordered by the Engineer. Any additional Lava Rock Curb required to complete the work will be available at the Territorial Highway Department's Maintenance Yard in Honolulu. No additional compensation will be made for hauling and the cost therefore will be considered incidental to item 73 - Lava Rock Curb.
 2. Existing pavement in median shall be scarified prior to filling with top soil.
 3. New median and islands shall be filled with topsoil and sodded (Bermuda).
 4. Destination signs, Regulatory and Warning Signs and Pavement Markings to be done by others.

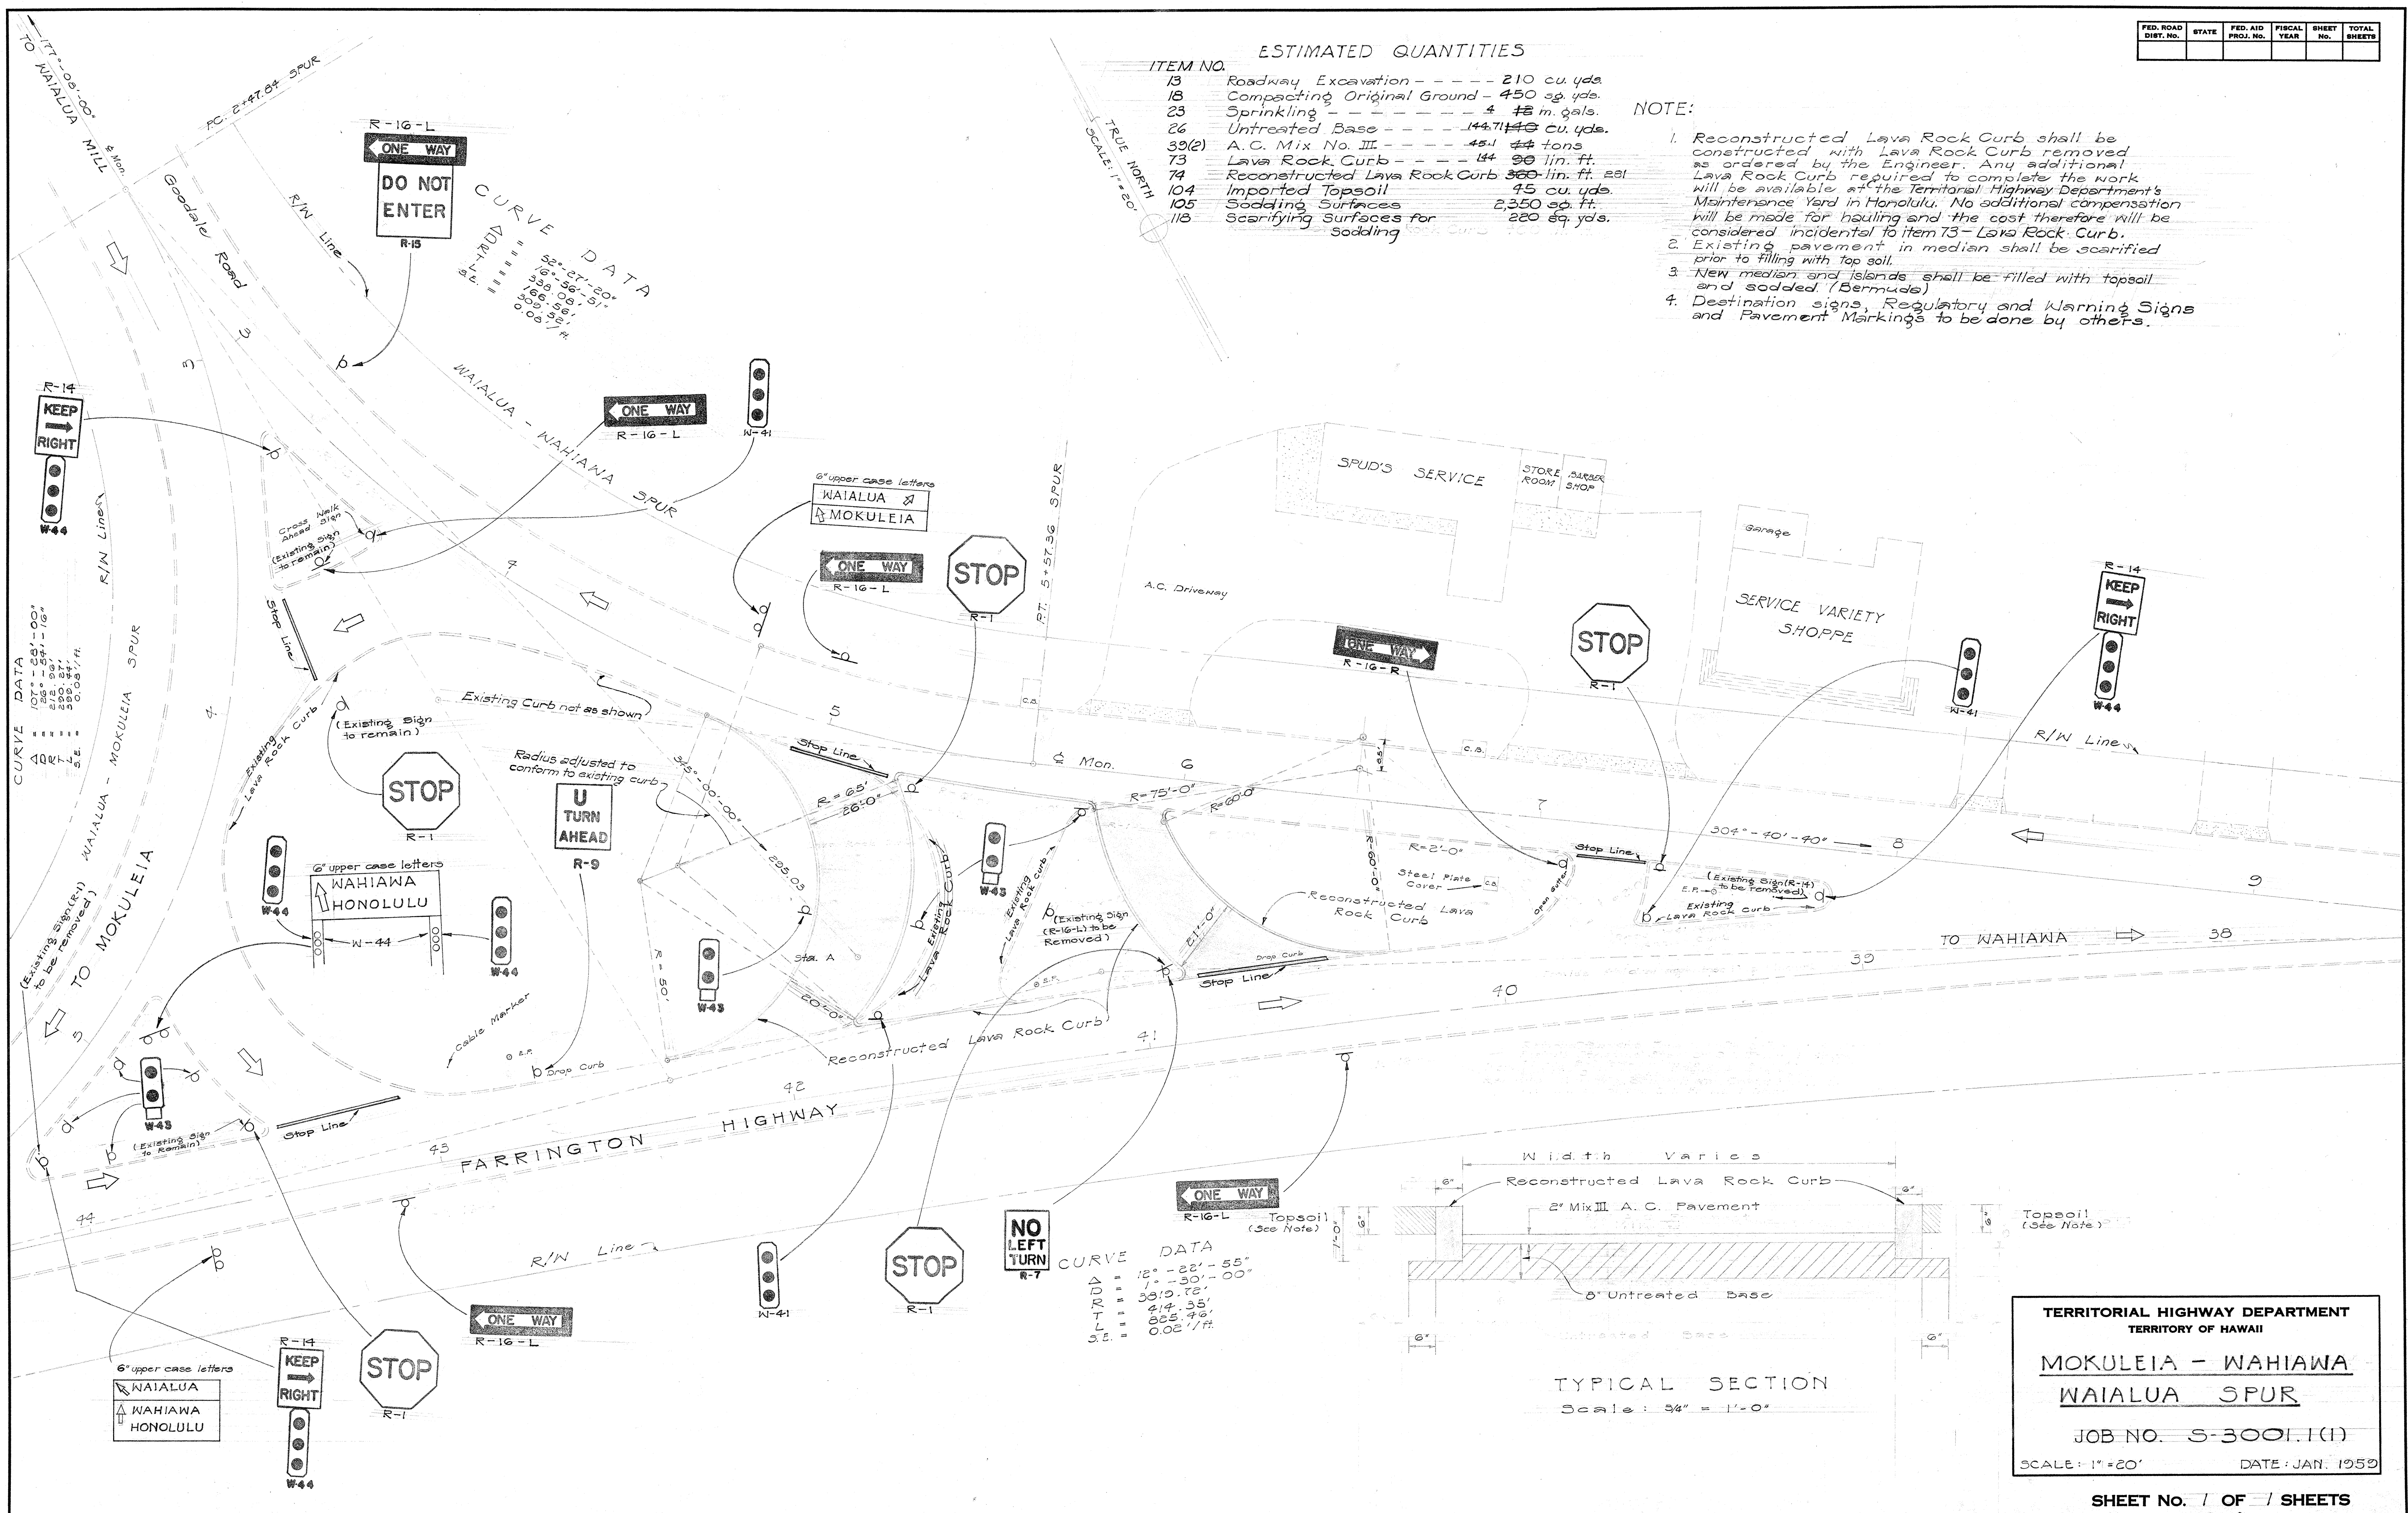

CURVE DATA

12° - 22' - 55"
1° - 50' - 00"
33° 10' 28"
41° 38'
85° 19'
0.02 1/ft.

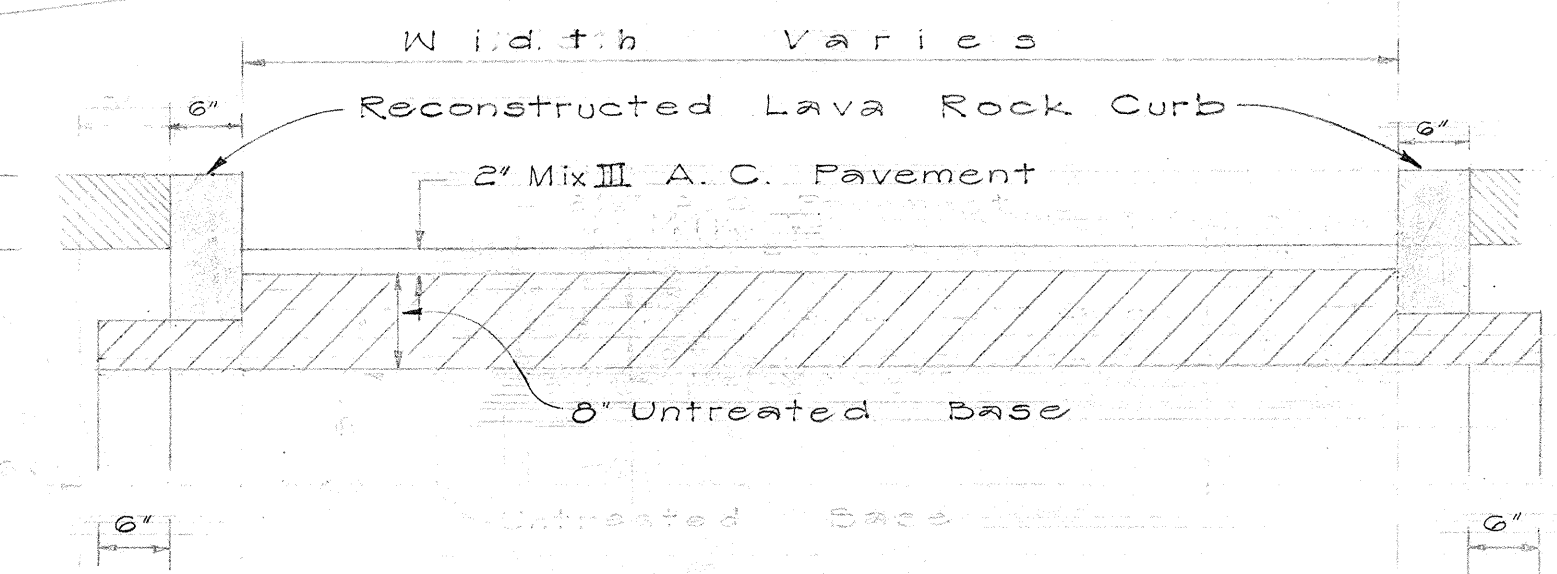

TYPICAL SECTION
Scale: 3/4" = 1'-0"

TERRITORIAL HIGHWAY DEPARTMENT
TERRITORY OF HAWAII

MOKULEIA - WAHIAWA
WAIALUA SPUR

JOB NO. S-3001.1(1)

SCALE: 1" = 20' DATE: JAN. 1959

DESIGNED BY	DATE
DRAWN BY	
CHECKED BY	
QUANTITIES CHECKED BY	
NOTE BOOK	
NO.	