


FED. ROAD DIST. NO.	STATE	FED. AID PROJ. NO.	FISCAL YEAR	SHEET NO.	TOTAL SHEETS

Revised: March 20, 1960
Sprinkler System


Revision Date:
Aug 27, 1959

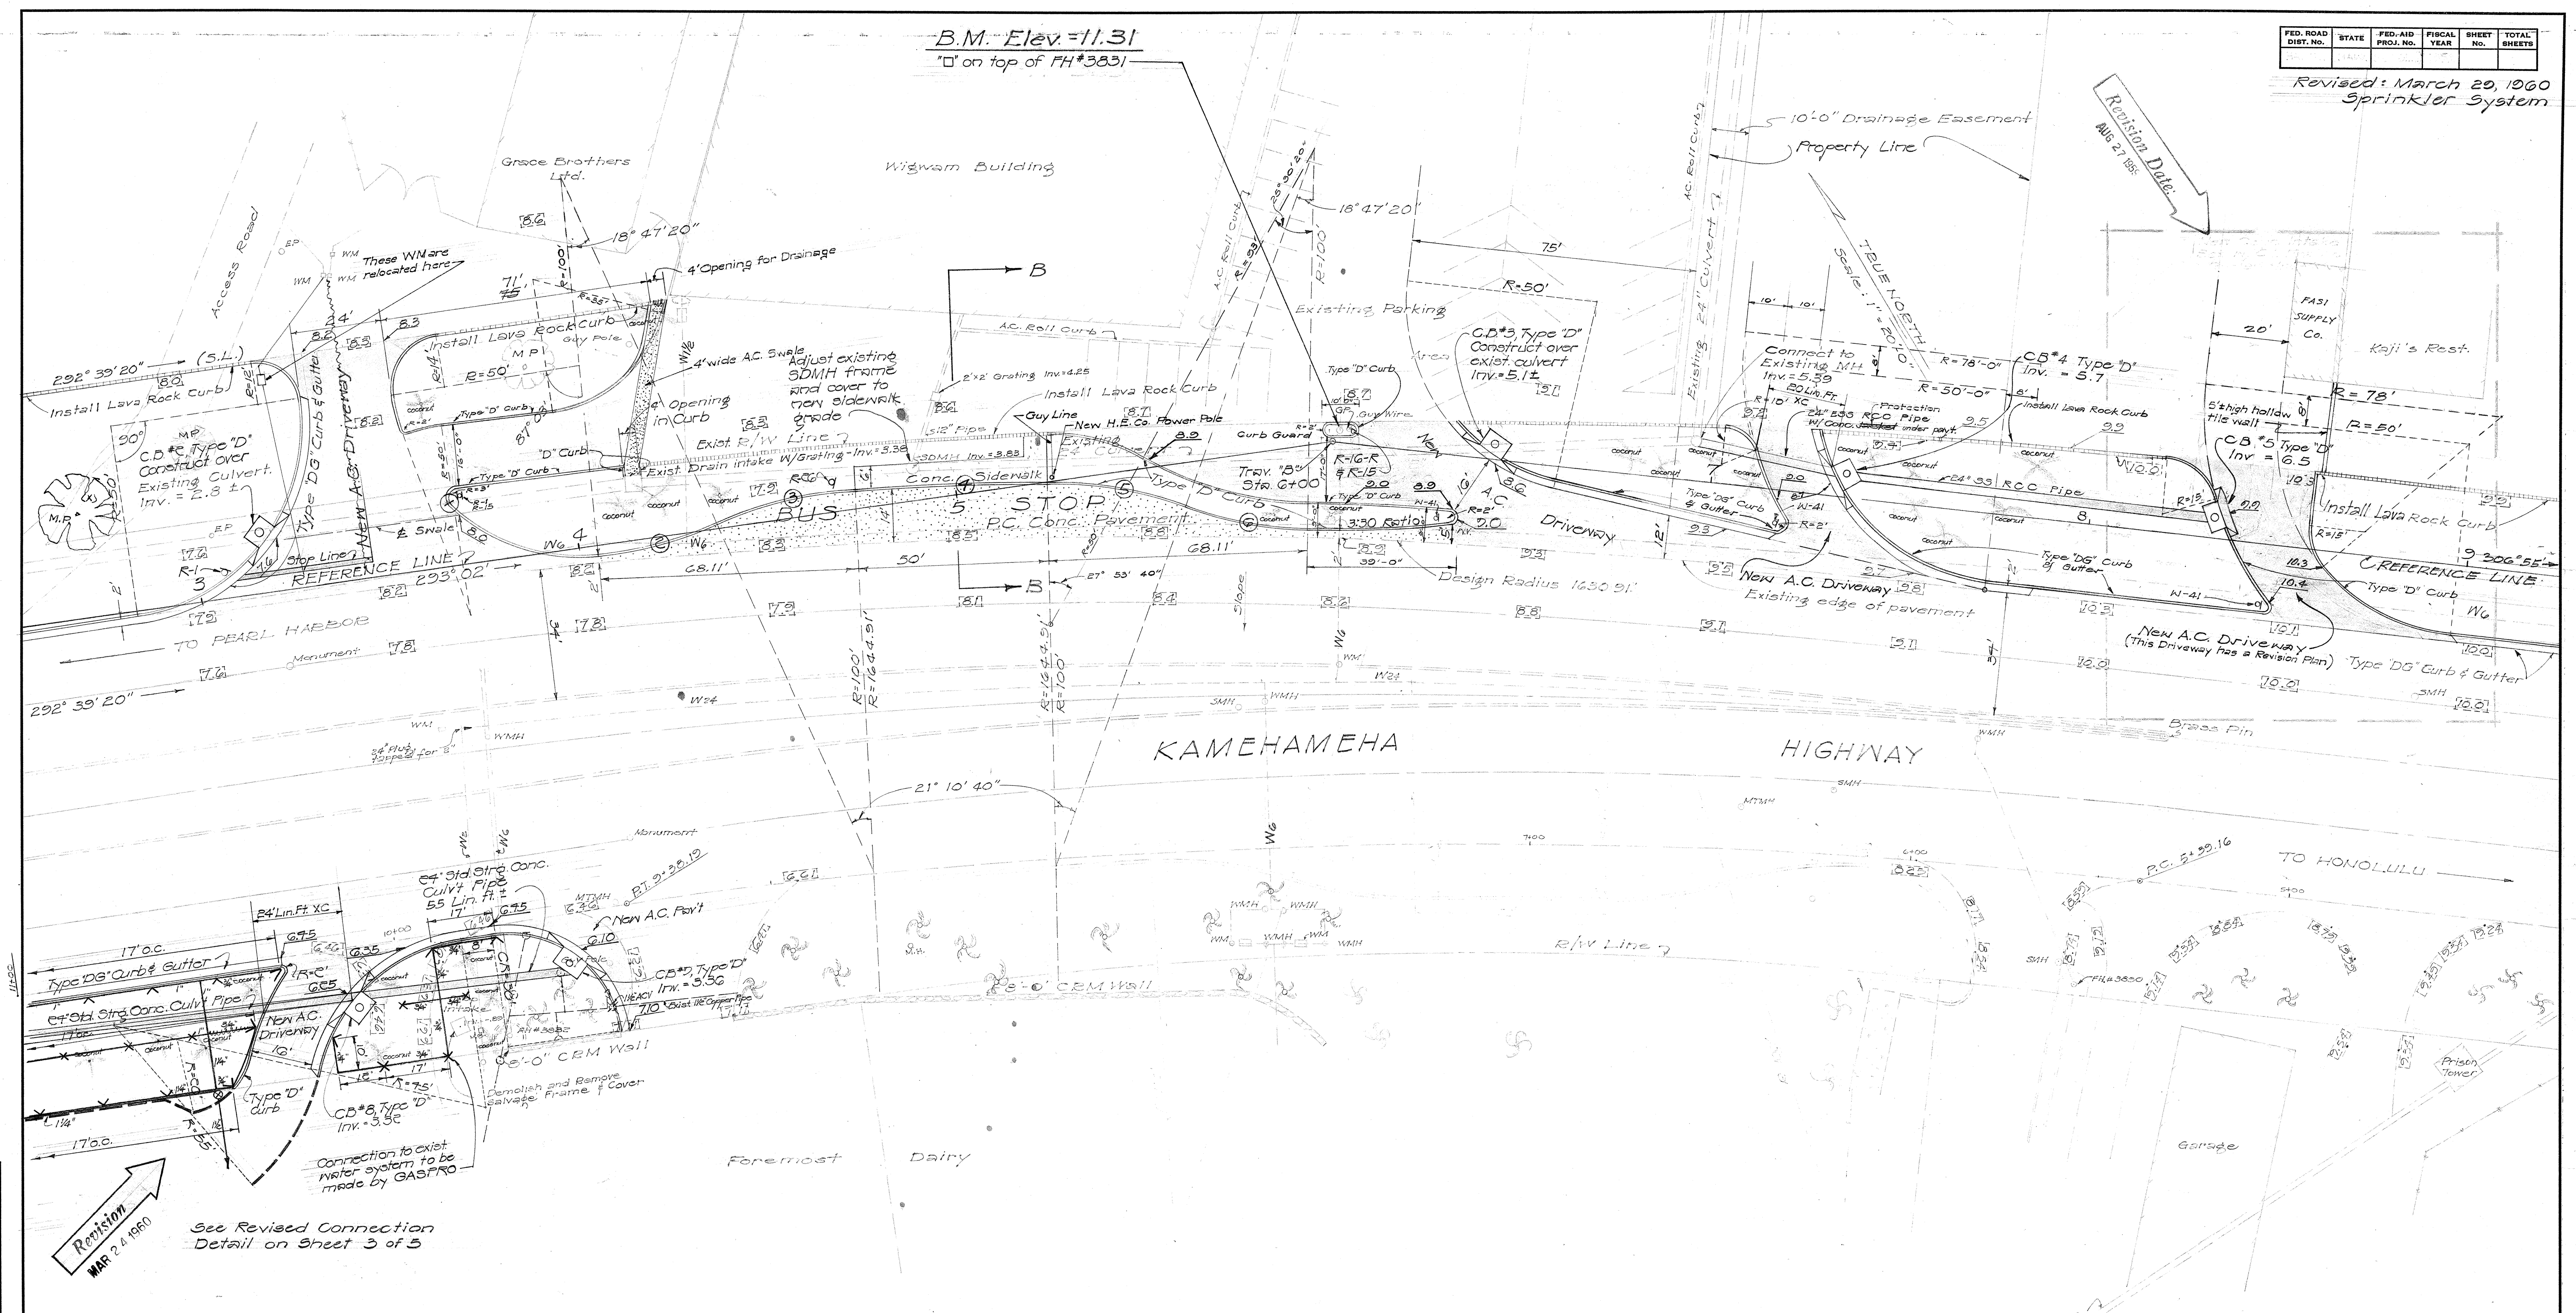

See Revised Connection Detail on Sheet 3 of 5

CURVE DATA

	①	② & ⑥	③ & ⑤	⑦
Δ	87° 03'	18° 47' 20"	21° 10' 40"	1° 44' 30"
R	50.00	100.00	100.00	1044.71
T	47.47	16.55	18.67	25.00
L	75.77	32.77	36.76	50.00

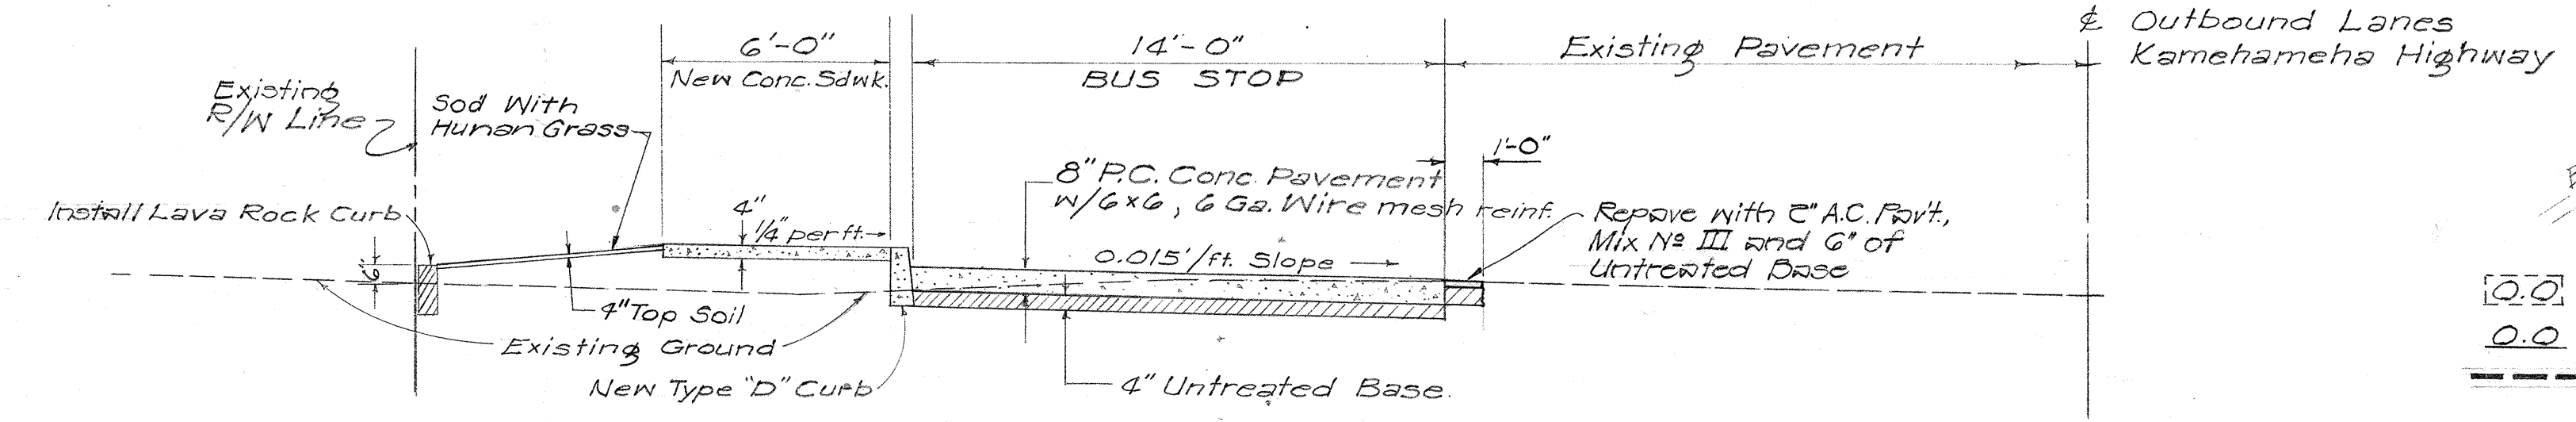

SECTION "B-B"
Scale: 1/4" = 1'-0"

Existing Grade
New Grade
Curb by others

THIS SHEET SUPERCEDES SHT. NO. S3001.1(1).3

TERRITORIAL HIGHWAY DEPARTMENT
TERRITORY OF HAWAII



ROADSIDE IMPROVEMENT
ON KAMEHAMEHA HIGHWAY
KALIHI STREAM TO LAUMAKA ST.
JOB NO. S 3001.1 (1)

Scale: As Noted
Aug. 27, 1959

DESIGNED BY	DATE
DRAWN BY	
CHECKED BY	
NOTE BOOK NO.	

FINAL SURVEY	SURVEYED	BY	DATE
	PLOTTED		
NOTE BOOK	TEMPLATE		
NO.	AREAS CHECKED		

ORIGINAL SURVEY	SURVEYED _____	BY _____	DATE _____
NOTE BOOK	TEMPLATED _____		
NO. _____	AREAS _____		
	AREAS CHECKED _____		

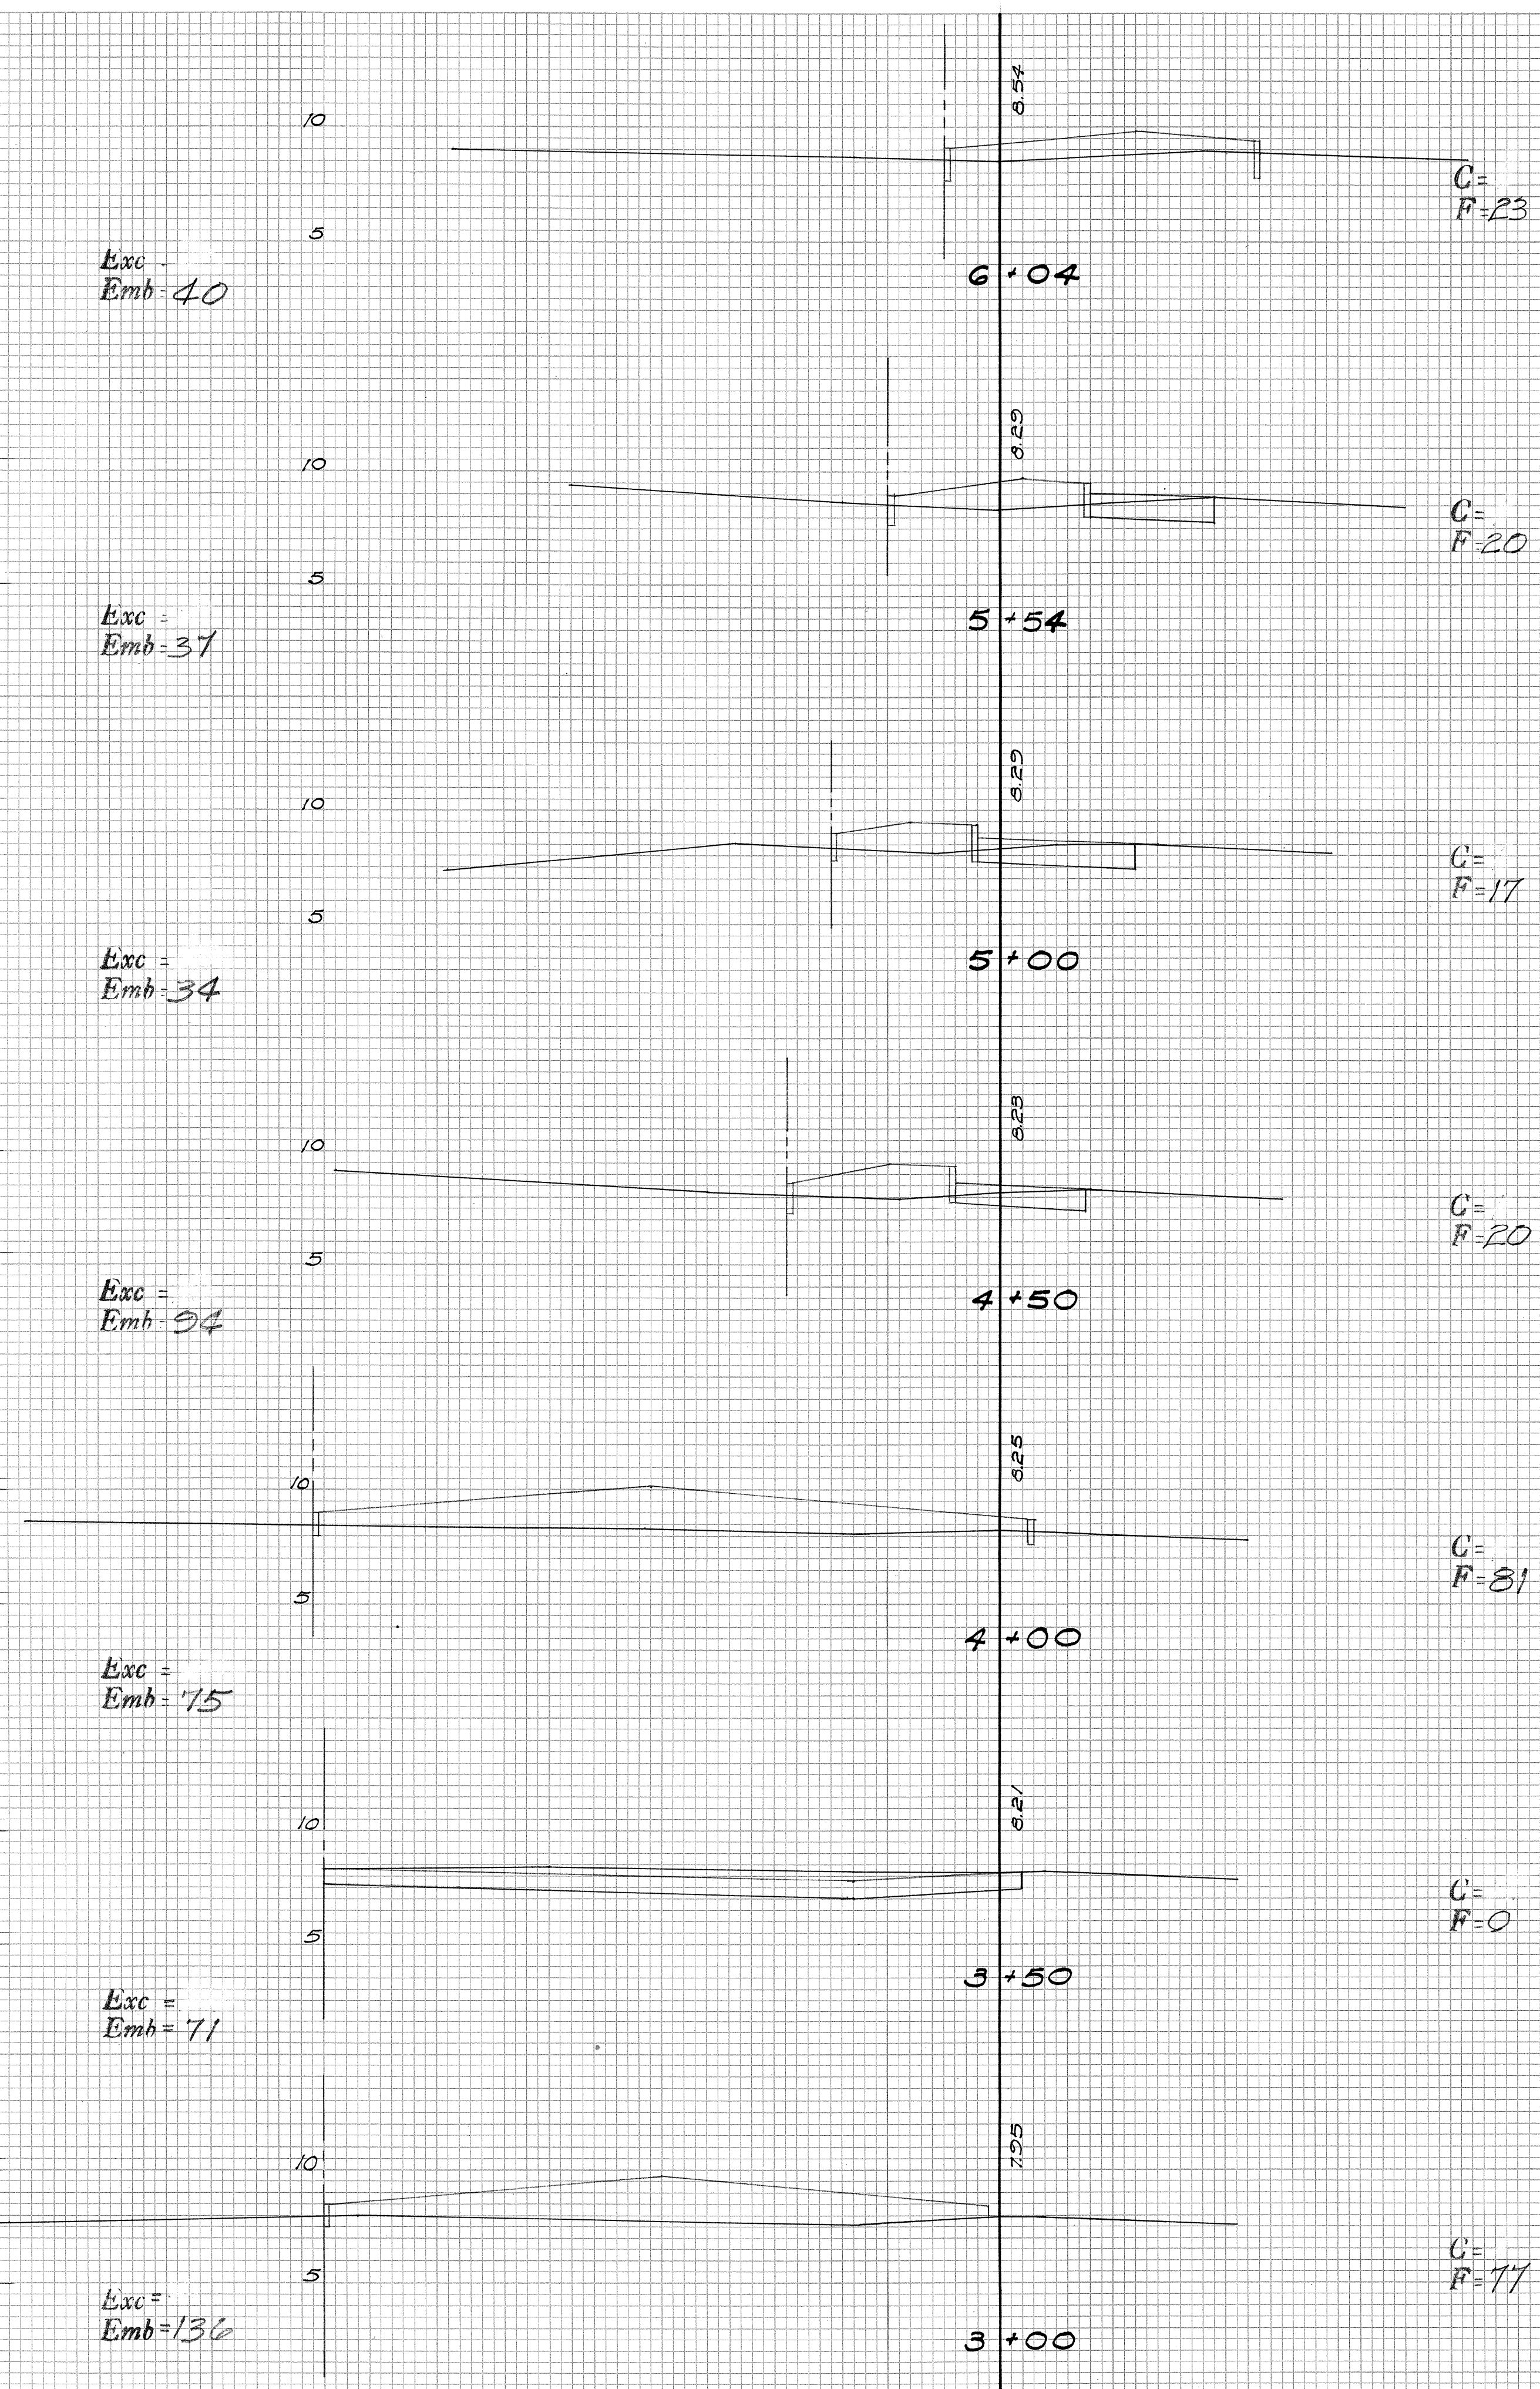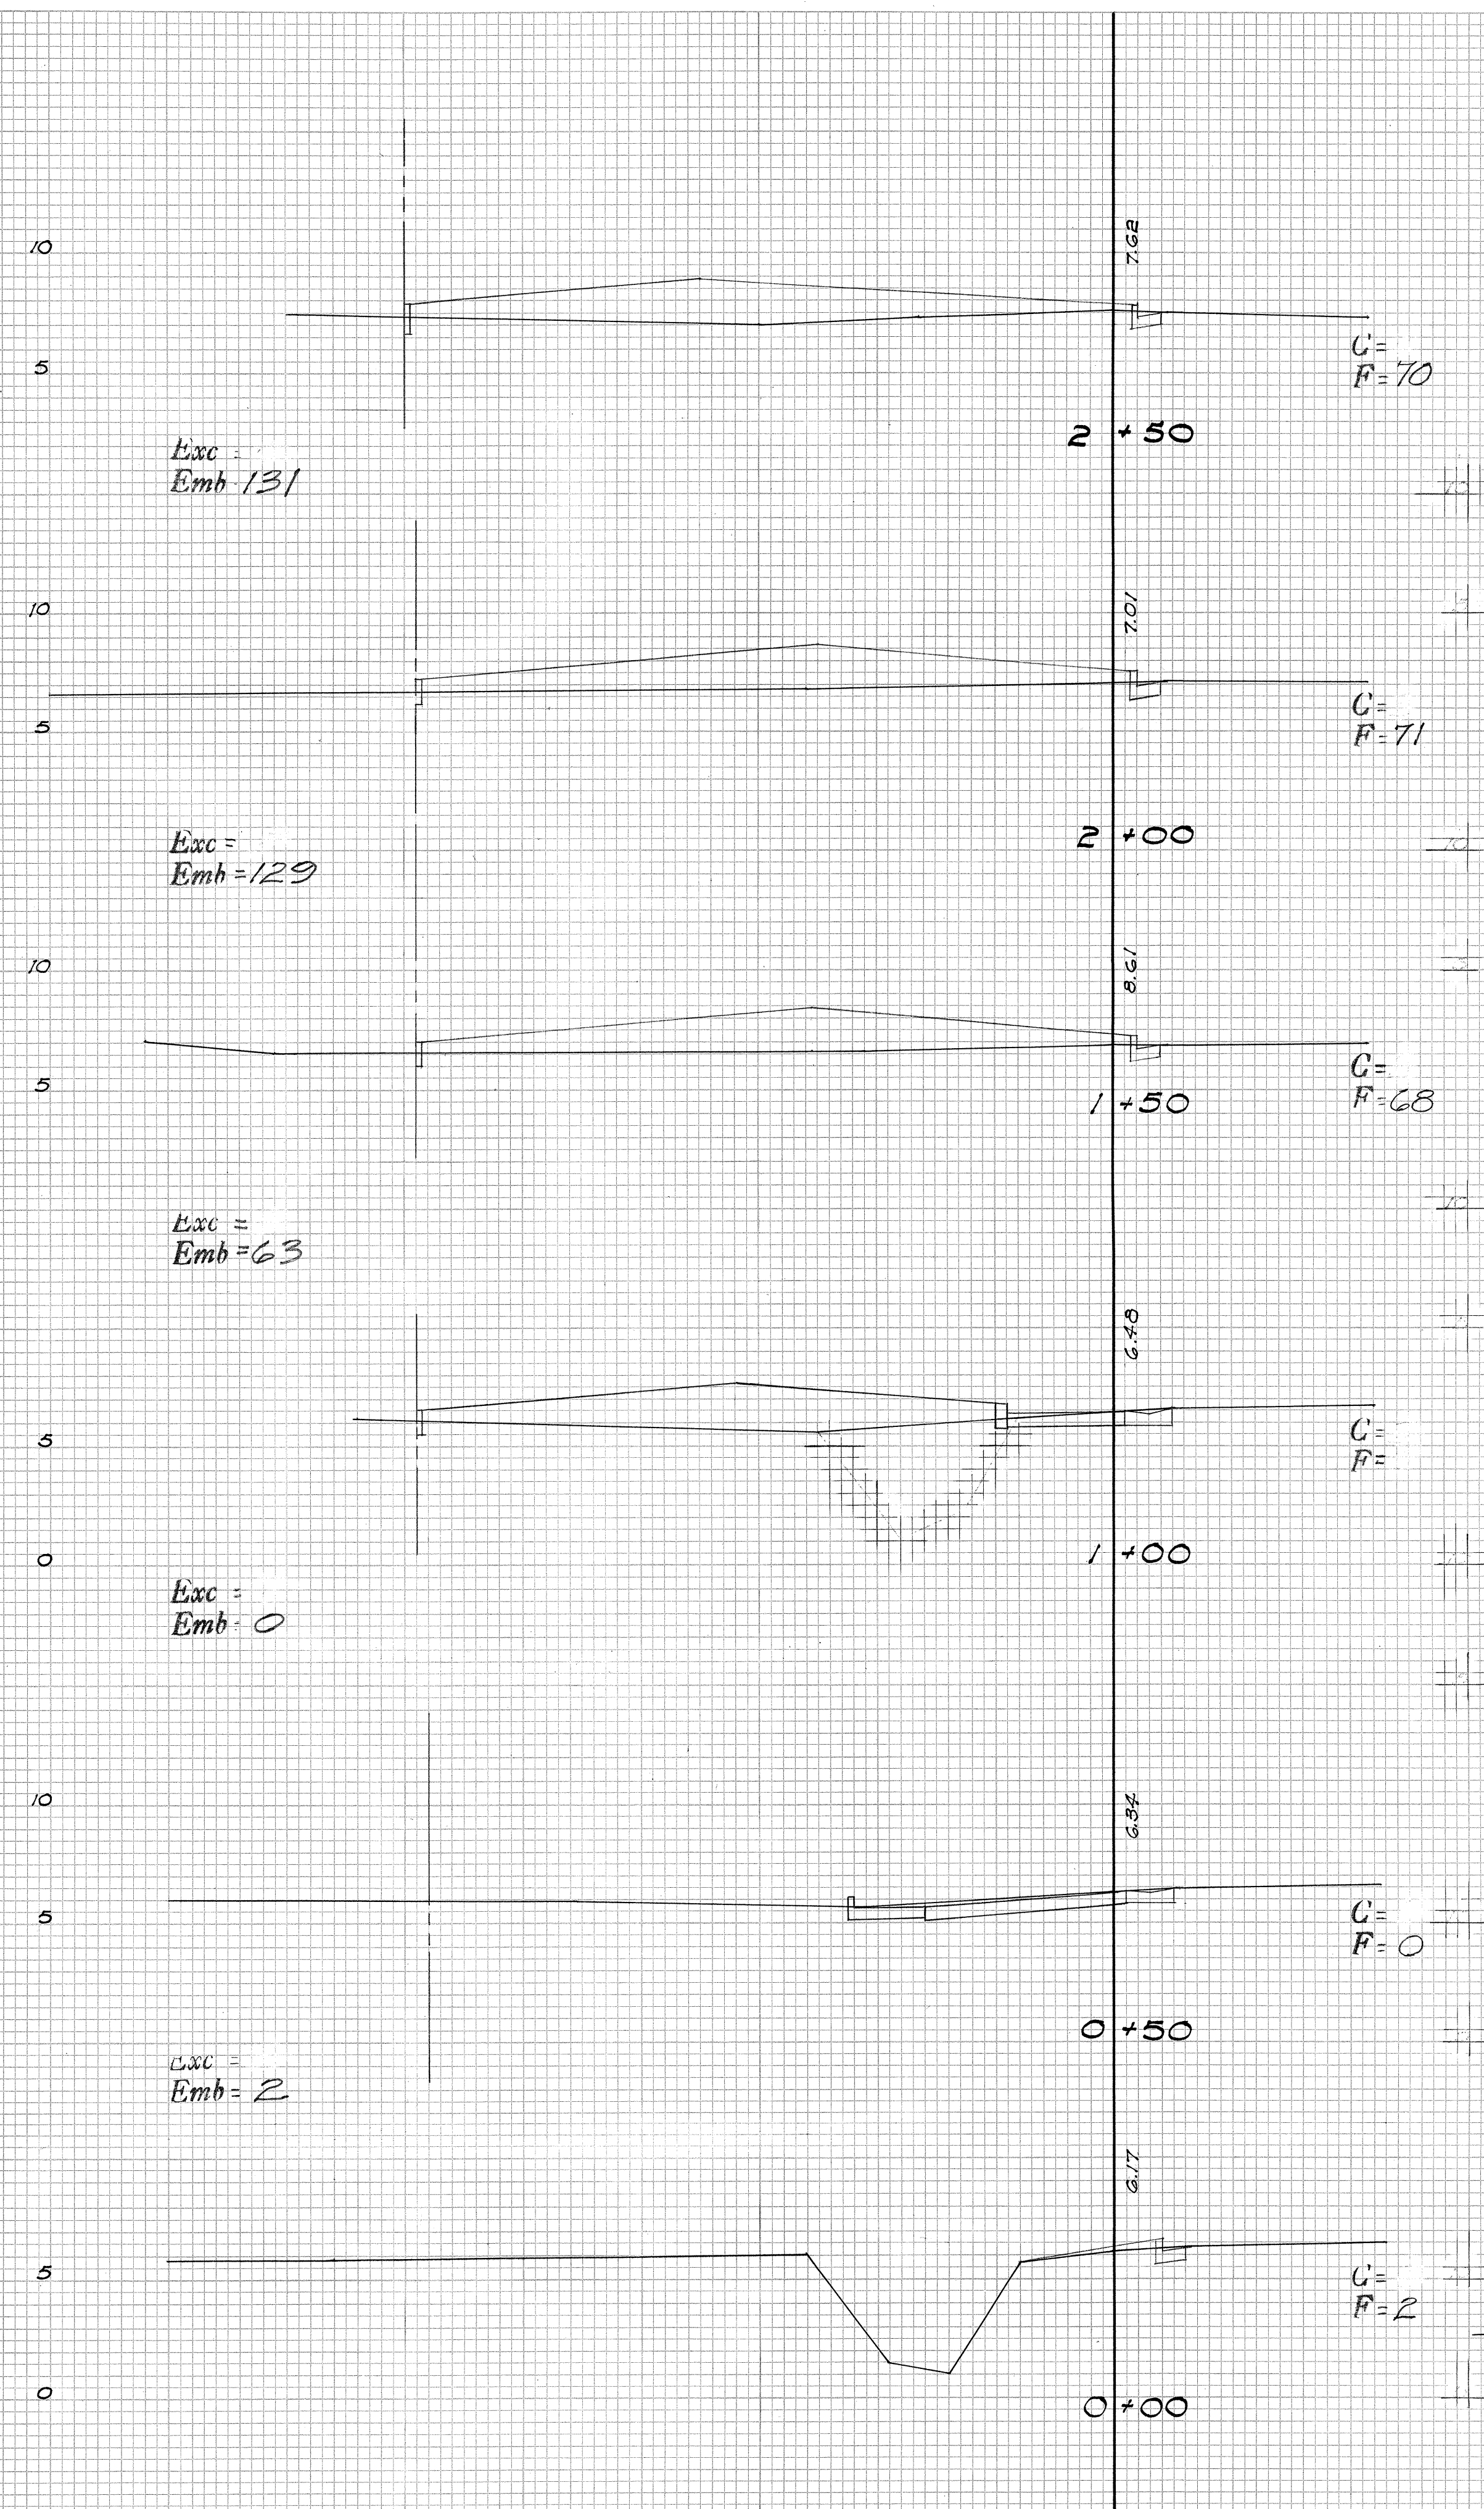


SHEET 4 OF 5 SHEETS

PLATE 3 CROSS SECTION O. P. R. & R. E. STANDARD
100% RAG PAPER—MADE AND PRINTED IN U. S. A.
EUGENE DIETZGEN CO.

\$3001.1(1).5

FED. ROAD DIST. No.	STATE	FED. AID PROJ. No.	FISCAL YEAR	SHEET No.	TOTAL SHEETS
100000000	1000000				

ORIGINAL	BY _____	DATE _____
SURVEY		
PLOTTED _____		
TEMPLATE _____		
AREAS _____		
NO. _____	AREAS CHECKED _____	

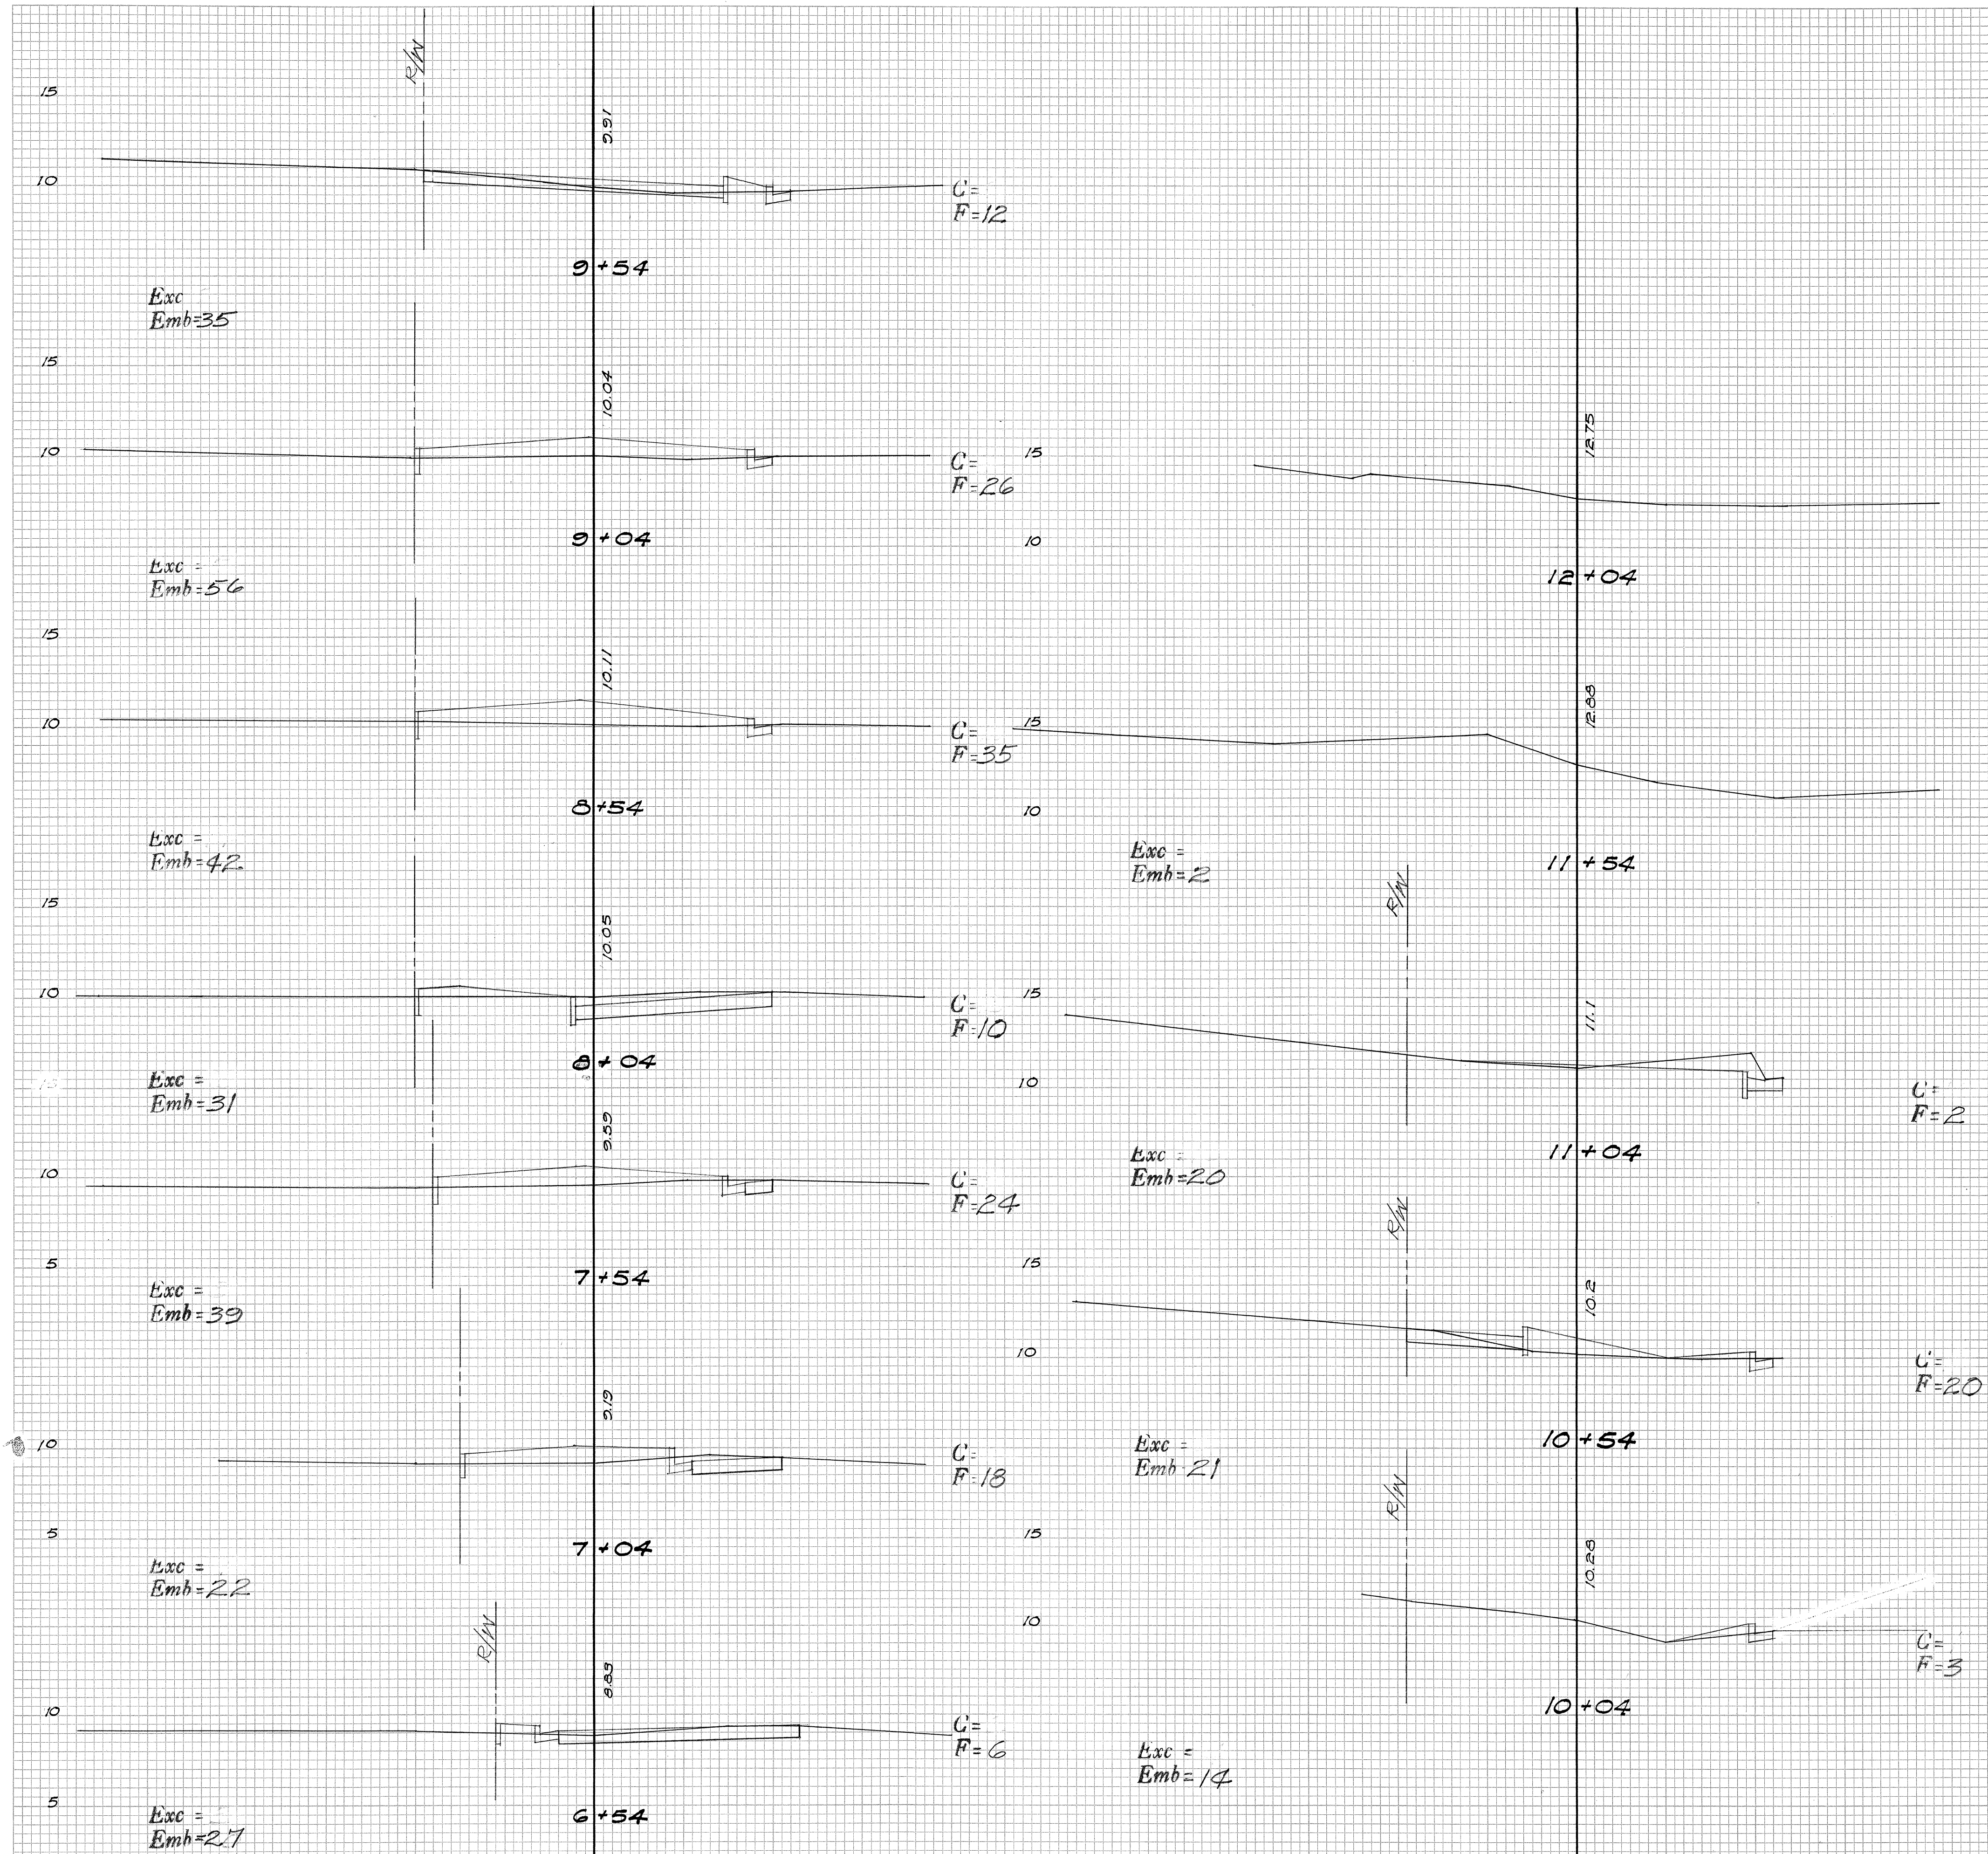

ROADSIDE IMPROVEMENTS ON KAMEHAMEHA HIGHWAY

S 3 0 0 1.1(1).6