

"AS BUILT" PLAN

KALANIANA'OLE

HIGHWAY

(Federal Aid Project No. F-6(18))

St Mon.
6. PT 125-77.37
(Grass Pin)

True North
Scale 1 in = 50 ft

PAA
Lot 2
L. C. AW
4498

HAA



6175

LOTS

Lot 3

Kamaha

Malaea

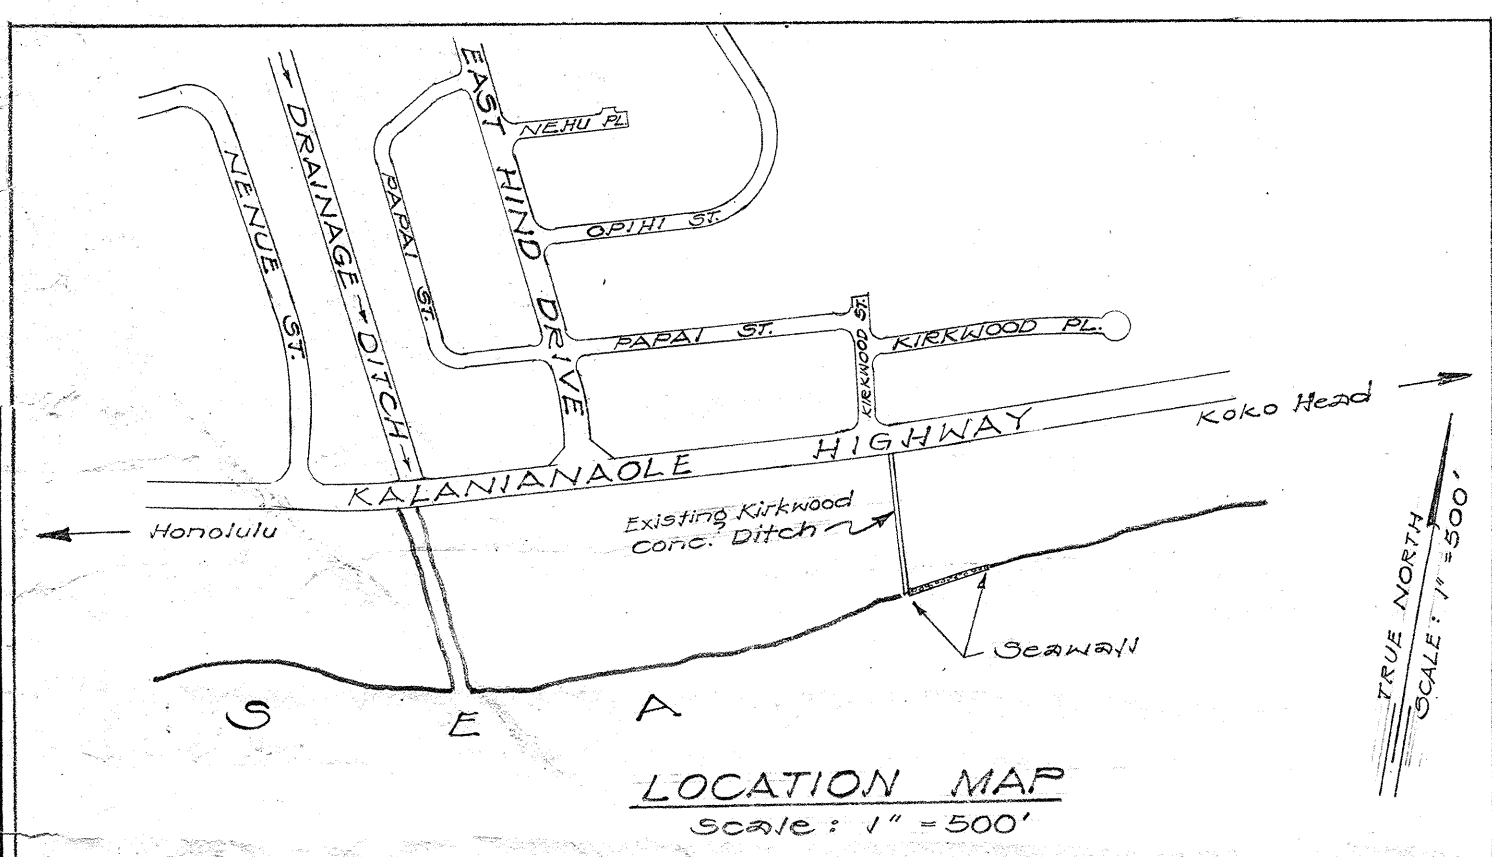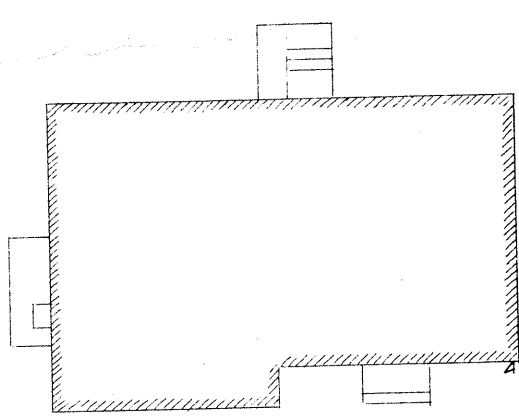

Base Tracing prepared by R/W Division
Aug. 25, 1959
R/W Field Book 157-C

NO CHANGE WAS MADE DURING
CONSTRUCTION OF THIS PROJECT.


R. T. James
RESIDENT ENGINEER
11-10-81
DATE

ESTIMATED QUANTITIES

Structure Exo. = 70 cu. yd.
Imported Borrow = 20 cu. yd.
Class A-1 Concrete
with 10% Extra Cement = 120 cu. yd.

TYPICAL SECTION SEAWALL

Scale: 1/2" = 1'-0"

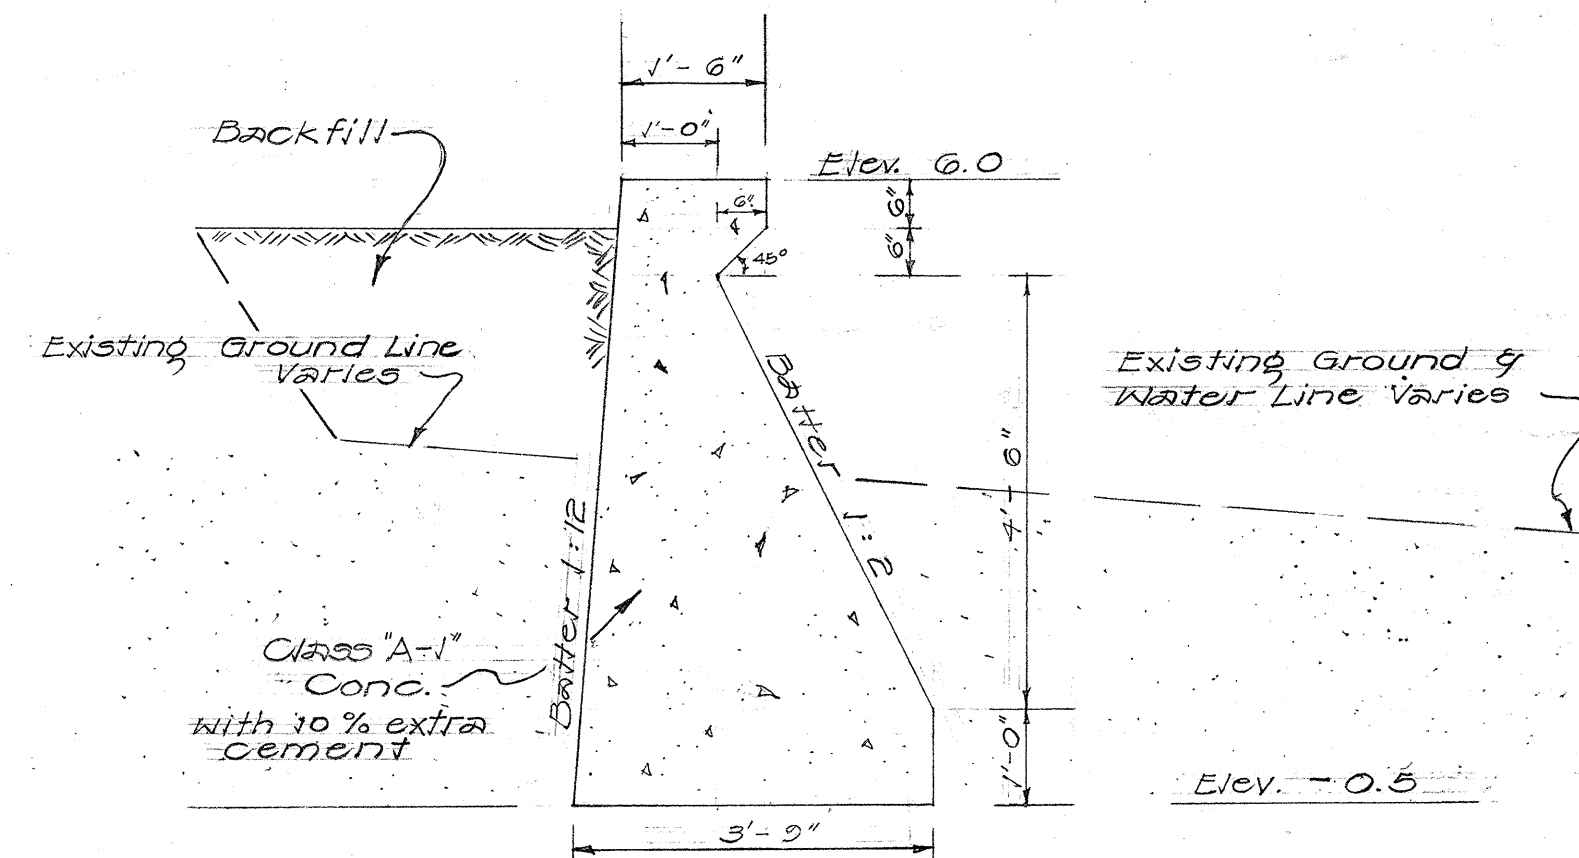

APPROVED:

J. J. Jenson
Bishop Trust Co. Ltd. Trustees
for Temple Bourke Test Trust
by J. J. Jenson
10/1/59
Date
State Highway Engineer
10/1/59
Date

HAWAII STATE HIGHWAY DEPARTMENT
STATE OF HAWAII

KIRKWOOD DRAIN SEAWALL

PROJECT NO. C 720259
KALANIANA'OLE HIGHWAY

JOB NO. 8536

SCALE: AS NOTED

SEPT. 1959